



GE
159 Plastics Avenue
Pittsfield, MA 01201
USA

Transmitted via Overnight Delivery

May 12, 2008

Mr. Richard Fisher
USEPA - New England
One Congress Street, Suite 1100 (MC HBO)
Boston, Massachusetts 02114-2023

**Re: GE-Pittsfield/Housatonic River Site
Former Oxbow Areas A and C (GECD410)
Final Completion Report for Former Oxbow Areas A and C Removal Action**

Dear Mr. Fisher:

Paragraph 88 of the Consent Decree (CD) for the GE-Pittsfield/Housatonic River Site provides for the submittal of a Final Completion Report and issuance of a Certification of Completion following the completion of a Removal Action which satisfies the Performance Standards provided in the CD. The enclosed *Final Completion Report for Former Oxbow Areas A and C Removal Action* (Final Completion Report) demonstrates that the Removal Action for this area required by the CD (excluding Post-Removal Site Control activities) has been completed in full satisfaction of the pertinent requirements of the CD and that the Performance Standards for that Removal Action have been achieved. Therefore, in accordance with Paragraph 88.a of the CD, the General Electric Company (GE) requests that EPA provide a Certification of Completion for the Former Oxbow Areas A and C Removal Action.

Please contact me with any questions or comments regarding the enclosed Final Completion Report.

Sincerely,

Richard W. Gates /MSB

Richard W. Gates
GE Project Coordinator,
Former Oxbow Areas A and C Removal Action

Enclosure

G:\GE\GE_Pittsfield_CD_Former_Oxbow_Areas_A_and_C\Reports and Presentations\Final Completion Report\167811324CvrLtr.doc

cc: D. Tagliaferro, EPA
T. Conway, EPA*
J. Kilborn, EPA*
H. Inglis, EPA
R. Howell, EPA*
L. Palmieri, Weston*
K.C. Mitkevicius, USACE*
A. Symington, MDEP*
J. Rothchild, MDEP*
S. Steenstrup, MDEP
N.E. Harper, MA AG*
D. Young, MA EOE
Mayor J. Ruberto, City of Pittsfield

M. Carroll, GE**
A. Silber, GE**
R. McLaren, Esq., GE**
J. Nuss, P.E., ARCADIS
J. Bieke, Esq., Goodwin Procter
Property Owner – Parcels I8-23-6, I9-5-1 &
I9-5-2**
Property Owner – Parcel I8-23-4**
Property Owner – Parcel I8-23-5**
Property Owner – Parcel I8-23-9**
Property Owner – Parcel I8-23-10**
Public Information Repositories
GE Internal Repository

* *with compact disk*

** *without enclosure*

Appendix C

As-Built Survey Drawings



REV.	DESCRIPTION	DATE
A	ISSUED FOR COMMENT	12-20-06
B	GENERAL REVISIONS	1-29-07
C	ADDED WELLS & REVISED NOTE	12-27-07
D	GENERAL REVISIONS	3-25-08

A COPY OF THE DATA IN THIS DRAWING FILE IS MAINTAINED AT THE OFFICE OF HILL-ENGINEERS, ARCHITECTS, PLANNERS, INC. IN DALTON, MASSACHUSETTS. THE USER SHALL BE RESPONSIBLE FOR THE ACCURACY AND CONSISTENCY OF THIS DATA TO THE BEST OF HIS/HER KNOWLEDGE.

GENERAL ELECTRIC COMPANY, INC.
159 PLASTICS AVENUE
PITTSFIELD, MA


AS-BUILT SITE PLAN

OXBOWS A & C AREA

DRAWN BY	JUM
DATE DRAWN	12-20-06
SCALE	1"=60'
AP'D BY	
CAD CODE:	DWG\MX-63-2(AS-BUILT).DWG
GRAPHIC SCALE:	0 60 120
PROJECT NUMBER:	MX-63-2
DRAWING NUMBER	C-101
REV.	D

LEGEND

- IRON PIN FOUND
- ⊙ RAILROAD SPIKE FOUND
- ⊕ GMA5 MONITORING PROGRAM WELL
- ⊕ ADJACENT MCP DISPOSAL SITE MONITORING PROGRAM WELL
- ⊕ DECOMMISSIONED MONITORING WELL
- BOUND
- ○ ○ ○ ○ STONE WALL
- APPROXIMATE PROPERTY LINE
- EDGE OF TRAVELED WAY
- - - - - EDGE OF GRAVEL
- ○ — GUARDRAIL
- ~ ~ ~ ~ ~ EDGE OF BRUSH/TREE LINE
- - - - - AS-BUILT CONTOURS
- ▨ NON-TSCA EXCAVATION
- ▩ TSCA EXCAVATION

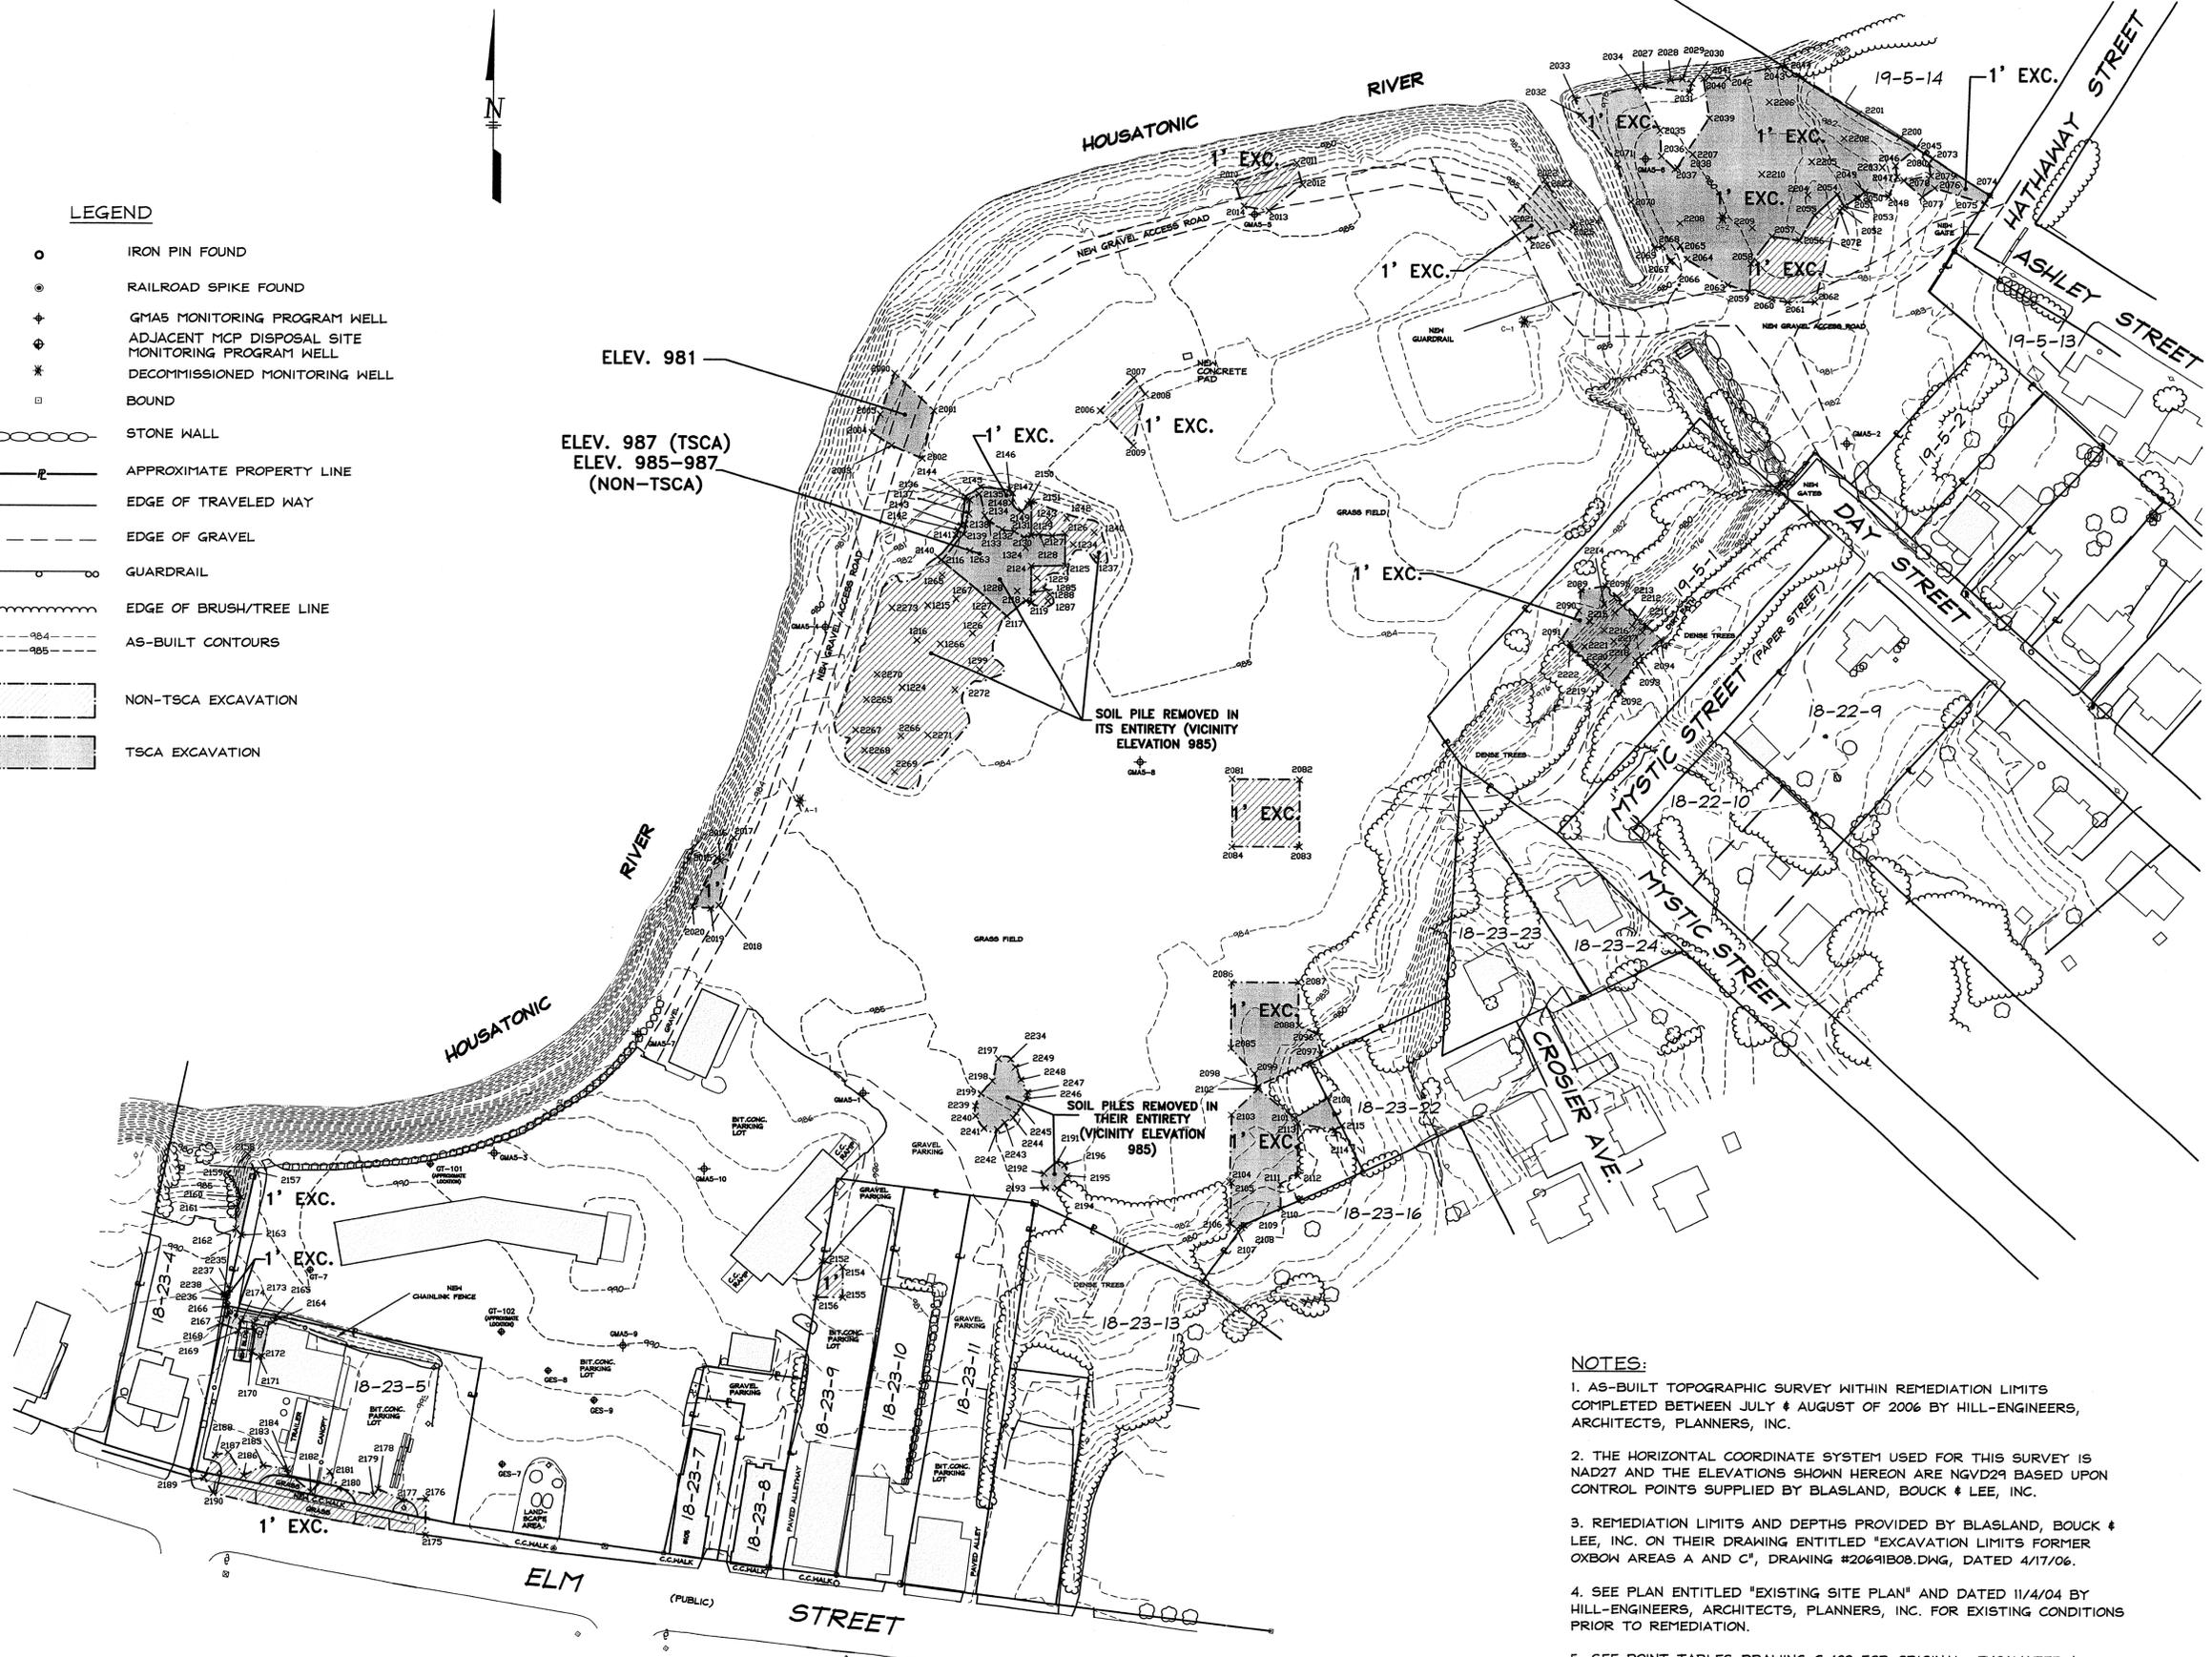

- NOTES:**
- AS-BUILT TOPOGRAPHIC SURVEY WITHIN REMEDIATION LIMITS COMPLETED BETWEEN JULY & AUGUST OF 2006 BY HILL-ENGINEERS, ARCHITECTS, PLANNERS, INC.
 - THE HORIZONTAL COORDINATE SYSTEM USED FOR THIS SURVEY IS NAD27 AND THE ELEVATIONS SHOWN HEREON ARE NGVD29 BASED UPON CONTROL POINTS SUPPLIED BY BLASLAND, BOUCK & LEE, INC.
 - REMEDICATION LIMITS AND DEPTHS PROVIDED BY BLASLAND, BOUCK & LEE, INC. ON THEIR DRAWING ENTITLED "EXCAVATION LIMITS FORMER OXBOW AREAS A AND C", DRAWING #20691B08.DWG, DATED 4/17/06.
 - SEE PLAN ENTITLED "EXISTING SITE PLAN" AND DATED 11/4/04 BY HILL-ENGINEERS, ARCHITECTS, PLANNERS, INC. FOR EXISTING CONDITIONS PRIOR TO REMEDIATION.
 - SEE POINT TABLES DRAWING C-102 FOR ORIGINAL, EXCAVATED & AS-BUILT ELEVATIONS, REMOVAL DEPTHS AND ELEVATION CHANGE.

POINT NUMBER	ORIGINAL ELEVATION	EXCAVATED ELEVATION	FINAL ELEVATION	DEPTH (FEET)	ELEVATION CHANGE (ORIGINAL - FINAL)
2015	981.5	980.5	981.5	1.0	---
2016	983.1	982.1	983.1	1.0	---
2017	983.6	982.4	983.5	1.2	+0.1
2018	985.1	984.1	985.1	1.0	---
2019	985.0	984.0	985.0	1.0	---
2020	984.0	982.8	983.9	1.2	+0.1
2021	986.1	984.2	986.1	1.9	---
2022	980.7	979.6	980.7	1.1	---
2023	981.6	979.9	981.1	1.7	+0.5
2024	982.6	981.2	982.5	1.4	+0.1
2025	982.8	981.3	982.7	1.5	+0.1
2026	986.8	984.8	986.8	1.9	---
2027	977.6	976.3	977.6	1.4	---
2028	977.3	976.1	977.2	1.2	+0.1
2029	977.6	976.2	977.5	1.4	+0.1
2030	977.9	976.6	977.8	1.3	+0.1
2031	977.9	976.9	977.9	1.1	---
2032	975.9	974.8	975.8	1.1	+0.1
2033	976.1	974.8	976.1	1.2	---
2034	977.5	976.1	977.4	1.4	+0.1
2035	978.7	977.5	978.7	1.2	---
2036	980.0	978.8	980.0	1.2	---
2037	979.7	978.4	979.6	1.3	+0.1
2038	979.6	978.4	979.5	1.2	+0.1
2039	978.8	976.9	978.8	1.9	---
2040	977.9	976.8	977.8	1.1	+0.1
2041	977.8	976.6	977.7	1.2	+0.1
2042	978.5	977.3	978.5	1.2	---
2043	978.0	976.9	977.9	1.1	+0.1
2044	978.7	977.6	978.6	1.1	+0.1
2045	984.3	982.9	984.3	1.4	---
2046	981.8	980.7	981.7	1.1	+0.1
2047	982.2	980.8	982.2	1.4	---
2048	980.5	979.3	980.5	1.2	---
2049	979.5	978.4	979.5	1.1	---
2050	979.3	978.3	979.3	1.0	---
2051	979.3	978.1	979.3	1.2	---
2053	978.7	977.6	978.7	1.1	---
2054	978.1	977.0	978.0	1.1	+0.1
2055	977.8	976.8	977.8	1.0	---
2056	977.5	976.1	977.9	1.4	+0.1
2057	978.9	977.7	978.9	1.3	---
2058	978.8	977.5	978.7	1.3	+0.1
2059	980.6	978.5	980.6	2.1	---
2063	980.1	978.8	980.0	1.3	+0.1
2064	978.8	977.6	978.7	1.2	+0.1
2065	979.2	977.9	979.2	1.3	---
2066	979.1	977.8	979.0	1.3	+0.1
2067	979.1	977.8	979.1	1.2	---
2068	979.0	977.2	979.0	1.8	---
2069	979.1	976.8	979.0	2.3	+0.1
2070	977.3	976.3	977.2	1.0	+0.1
2071	977.2	975.8	977.1	1.4	+0.1
2073	984.2	982.5	984.1	1.7	+0.1
2074	984.1	982.9	984.0	1.2	+0.1
2075	984.0	982.8	984.0	1.2	---
2076	982.2	980.9	982.2	1.3	---
2077	981.8	980.3	981.8	1.5	---
2078	982.1	980.7	982.0	1.4	+0.1
2079	981.9	980.5	981.9	1.4	---
2080	983.5	982.0	983.4	1.4	+0.1
2085	983.0	981.7	983.0	1.3	---
2086	983.4	982.4	983.3	1.0	+0.1
2087	983.2	982.1	983.1	1.1	+0.1
2088	982.2	980.9	982.1	1.3	+0.1
2089	981.2	979.7	981.2	1.5	---
2090	981.2	979.6	981.2	1.6	---
2091	980.9	978.7	980.9	2.2	---
2092	978.9	977.5	978.8	1.4	+0.1
2093	978.4	977.2	978.2	1.2	+0.1
2094	980.4	979.3	980.3	1.0	+0.1
2095	980.7	979.6	980.6	1.1	+0.1
2096	979.1	977.3	979.0	1.8	+0.1
2097	980.0	978.8	980.0	1.2	---
2098	982.3	980.2	982.2	2.1	+0.1
2099	982.5	980.3	982.5	2.2	---
2100	979.4	978.3	979.4	1.1	---
2101	981.4	979.9	981.4	1.5	---
2102	982.2	981.0	982.2	1.3	---
2103	981.9	980.9	981.9	1.0	---
2104	981.9	980.6	981.8	1.3	+0.1
2105	982.1	980.8	982.1	1.3	---
2106	978.7	977.5	978.7	1.2	---
2107	978.8	977.7	978.8	1.2	---
2108	979.0	977.8	979.0	1.3	---
2109	979.1	977.8	979.1	1.3	---
2110	980.0	978.9	980.0	1.1	---
2111	980.8	979.8	980.7	1.0	+0.1
2112	980.6	979.5	980.5	1.1	+0.1
2113	980.9	979.0	980.9	1.9	---
2114	979.9	978.3	982.8	1.6	-2.9
2115	979.5	978.3	979.4	1.2	+0.1
2116	987.3	982.3	982.3	5.2	+5.0
2130	987.1	985.7	984.9	1.4	+2.2
2131	986.6	985.4	984.6	1.2	+2.0
2132	988.7	987.0	985.0	1.7	+3.7
2133	987.0	985.9	984.9	1.1	+2.1
2134	986.5	985.3	985.0	1.2	+1.5
2135	987.1	985.7	984.6	1.4	+2.5
2136	985.9	984.7	983.4	1.2	+2.5
2137	988.2	986.2	985.0	2.0	+3.2
2138	987.7	986.4	985.0	1.3	+2.7
2139	987.7	986.4	985.0	1.3	+2.7
2140	987.7	986.4	985.0	1.3	+2.7
2141	984.3	982.5	982.5	1.8	+1.8
2142	984.2	982.9	982.9	1.3	+1.3
2143	985.7	982.6	982.6	3.1	+3.1
2144	983.3	982.3	982.3	1.0	+1.0
2145	984.4	983.1	983.1	1.3	+1.3
2146	984.1	982.9	982.9	1.2	+1.2
2147	985.1	982.8	982.8	2.3	+2.3
2148	984.6	983.3	983.3	1.3	+1.3
2149	984.5	983.2	983.2	1.3	+1.3
2150	983.6	982.1	982.1	1.5	+1.5
2151	983.7	982.5	982.5	1.2	+1.2

POINT NUMBER	ORIGINAL ELEVATION	EXCAVATED ELEVATION	FINAL ELEVATION	DEPTH (FEET)	ELEVATION CHANGE (ORIGINAL - FINAL)
2157	990.3	989.1	990.2	1.2	+0.1
2158	986.2	985.1	986.6	1.1	-0.4
2159	983.3	981.6	983.3	1.7	---
2160	988.4	987.3	988.4	1.1	---
2161	987.5	986.3	987.5	1.2	---
2162	990.0	988.7	989.0	1.3	+0.1
2163	991.2	990.0	991.1	1.2	+0.1
2164	993.6	992.3	993.5	1.3	+0.1
2165	992.1	990.9	992.0	1.2	+0.1
2166	992.0	990.8	992.0	1.2	---
2167	992.1	991.0	992.1	1.1	---
2168	991.9	990.7	991.8	1.2	+0.1
2169	993.1	992.0	992.7	1.1	+0.4
2170	993.6	992.1	993.6	1.5	---
2171	993.5	992.2	993.8	1.3	-0.3
2172	993.4	992.2	993.8	1.2	-0.4
2173	993.5	991.9	993.5	1.6	---
2174	993.1	991.8	993.0	1.3	+0.1
2200	984.5	983.0	985.0	1.5	-0.5
2201	984.5	983.1	984.4	1.4	+0.1
2202	981.2	979.8	981.2	1.4	---
2203	981.5	980.5	981.5	1.0	---
2204	977.4	976.3	977.2	1.0	+0.2
2205	977.8	976.8	977.8	1.0	---
2206	977.9	976.9	977.9	1.0	---
2207	979.2	977.9	979.1	1.3	+0.1
2208	979.2	978.2	979.2	1.0	---
2209	978.9	977.4	978.9	1.5	---
2210	979.2	978.0	979.1	1.2	+0.1
2211	980.0	977.7	979.9	2.3	+0.1
2212	975.6	974.5	975.6	1.1	---
2213	976.1	975.0	976.0	1.1	+0.1
2214	980.5	977.4	980.5	3.1	---
2215	980.3	977.8	980.2	2.5	+0.1
2216	976.0	974.9	975.9	1.1	+0.1
2217	975.5	974.4	975.4	1.1	+0.1
2218	979.1	977.7	979.0	1.4	+0.1
2219	978.7	976.6	978.7	2.1	---
2220	978.2	976.8	978.2	1.4	---
2221	976.2	975.2	976.2	1.0	+0.1
2222	980.2	977.2	980.1	3.0	+0.1
2235	991.3	990.0	991.2	1.3	+0.1
2236	991.6	990.1	991.6	1.5	---
2237	991.1	990.0	991.1	1.1	---
2238	991.2	990.1	991.1	1.1	+0.1

POINT NUMBER	ORIGINAL ELEVATION	EXCAVATED ELEVATION	FINAL ELEVATION	DEPTH (FEET)	ELEVATION CHANGE (ORIGINAL - FINAL)
2000	982.7	980.9	982.6	1.8	+0.1
2001	983.8	980.9	983.8	2.9	---
2002	984.2	981.0	983.8	3.2	+0.4
2003	984.8	980.9	984.7	3.9	+0.1
2004	982.7	980.9	982.7	1.9	---
2005	982.8	980.9	982.7	1.8	+0.1

POINT NUMBER	ORIGINAL ELEVATION	EXCAVATED ELEVATION	FINAL ELEVATION	DEPTH (FEET)	ELEVATION CHANGE (ORIGINAL - FINAL)
2191	985.2	984.2	984.2	1.0	+0.1
2192	985.6	984.5	984.5	1.1	+1.1
2193	985.7	984.5	984.5	1.2	+1.2
2194	985.5	984.5	984.5	1.0	+1.0
2195	985.4	984.4	984.4	1.0	+1.0
2196	985.6	984.2	984.2	1.4	+1.4
2197	985.9	984.6	984.6	1.3	+1.3
2198	986.0	984.7	984.7	1.3	+1.3
2199	985.9	984.7	984.7	1.2	+1.2
2234	986.0	984.6	984.6	1.4	+1.4
2235	986.1	984.9	984.9	1.2	+1.2
2240	985.9	984.9	984.9	1.0	+1.0
2241	986.2	985.0	985.0	1.2	+1.2
2242	986.0	985.0	985.0	1.0	+1.0
2243	986.0	984.8	984.8	1.2	+1.2
2244	986.1	984.7	984.7	1.4	+1.4
2245	986.1	984.7	984.7	1.4	+1.4
2246	985.9	984.6	984.6	1.3	+1.3
2247	986.0	984.6	984.6	1.4	+1.4
2248	985.9	984.4	984.4	1.5	+1.5
2249	986.2	984.3	984.3	1.9	+1.9

POINT NUMBER	ORIGINAL ELEVATION	EXCAVATED ELEVATION	FINAL ELEVATION	DEPTH (FEET)	ELEVATION CHANGE (ORIGINAL - FINAL)
1228	983.7	986.9	984.6	6.8	+9.1
1263	988.8	986.9	984.5	1.9	+4.3
1324	989.3	987.0	984.5	2.3	+4.8
2116	987.3	986.8	982.3	0.5	+5.0
2124	991.1	986.8	984.4	4.3	+6.7
2130	987.1	986.7	984.9	0.4	+2.2
2132	988.7	987.0	985.0	1.7	+3.7
2135	987.1	986.8	984.6	0.3	+2.5
2137	988.2	986.2	985.0	2.0	+3.2
2138	987.7	986.4	985.0	1.3	+2.7

POINT NUMBER	ORIGINAL ELEVATION	EXCAVATED ELEVATION	FINAL ELEVATION	DEPTH (FEET)	ELEVATION CHANGE (ORIGINAL - FINAL)
2006	984.7	983.			