



GE
159 Plastics Avenue
Pittsfield, MA 01201
USA

Transmitted via Overnight Delivery

May 13, 2008

Mr. Richard Hull
USEPA - New England
One Congress Street, Suite 1100
Boston, Massachusetts 02114-2023

**Re: GE-Pittsfield/Housatonic River Site
Former Oxbow Areas J and K (GECD420)
Final Completion Report for Former Oxbow Areas J and K Removal Action**

Dear Mr. Hull:

Paragraph 88 of the Consent Decree (CD) for the GE-Pittsfield/Housatonic River Site provides for the submittal of a Final Completion Report and issuance of a Certification of Completion following the completion of a Removal Action which satisfies the Performance Standards provided in the CD. The enclosed *Final Completion Report for Former Oxbow Areas J and K Removal Action* (Final Completion Report) demonstrates that the Removal Action for this area required by the CD (excluding Post-Removal Site Control activities) has been completed in full satisfaction of the pertinent requirements of the CD and that the Performance Standards for that Removal Action have been achieved. Therefore, in accordance with Paragraph 88.a of the CD, the General Electric Company (GE) requests that EPA provide a Certification of Completion for the Former Oxbow Areas J and K Removal Action.

Please contact me with any questions or comments regarding the enclosed Final Completion Report.

Sincerely,

Richard W. Gates /mrB

Richard W. Gates
GE Project Coordinator,
Former Oxbow Areas J and K Removal Action

Enclosure

G:\GE\GE_Pittsfield_CD_Former_Oxbow_Areas_J_and_K\Reports and Presentations\Final Completion Report\55811324CvrLtr.doc

cc: D. Tagliaferro, EPA
T. Conway, EPA*
J. Kilborn, EPA*
H. Inglis, EPA
R. Howell, EPA*
L. Palmieri, Weston*
K.C. Mitkevicius, USACE*
A. Symington, MDEP*
J. Rothchild, MDEP*
S. Steenstrup, MDEP
N.E. Harper, MA AG*
D. Young, MA EOE
Mayor J. Ruberto, City of Pittsfield
M. Carroll, GE**
A. Silfer, GE**
R. McLaren, Esq., GE**


J. Nuss, P.E., ARCADIS
J. Bieke, Esq., Goodwin Procter
Property Owner – Parcel K10-10-3**
Property Owner – Parcels K10-10-4, -5, & -6**
Property Owner – Parcel K10-10-33**
Property Owner – Parcel K10-11-1**
Property Owner – Parcel K10-11-2**
Property Owner – Parcel K10-11-3**
Property Owner – Parcel K10-11-5**
Property Owner – Parcel K10-12-1**
Property Owner – Parcel K10-13-1**
Public Information Repositories
GE Internal Repository

* *with compact disk*

** *without enclosure*

Appendix C

As-Built Survey Drawings

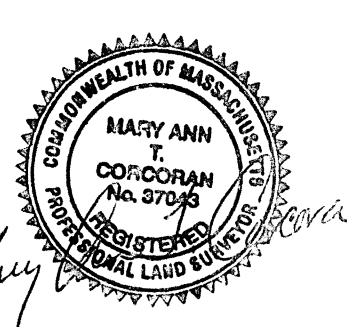

REV.	DESCRIPTION	DATE
A	ISSUED FOR COMMENT	10-20-06
B	GENERAL REVISIONS	1-25-07
C	GENERAL REVISIONS	12-18-07
D	GENERAL REVISIONS, REVISED RIP RAP	3-4-08


A COPY OF THE DATA IN THIS DRAWING FILE IS MAINTAINED AT THE OFFICE OF HILL-ENGINEERS, ARCHITECTS, PLANNERS, INC. THE INTERPRETATION, APPLICATION AND REVISION OF THIS DATA IS THE SOLE RESPONSIBILITY OF THE USER.

GENERAL ELECTRIC COMPANY, INC.
159 PLASTICS AVENUE
PITTSFIELD, MA

AS-BUILT SITE PLAN

OXBOWS J & K AREA

DRAWN BY	JJM
DATE DRAWN	10-20-06
SCALE	1"=40'
AP'D BY	
CAD CODE:	DWG\MX-63-1(AS-BUILT).DWG
GRAPHIC SCALE:	
PROJECT NUMBER:	MX-63-1
DRAWING NUMBER	C-101
REV.	D

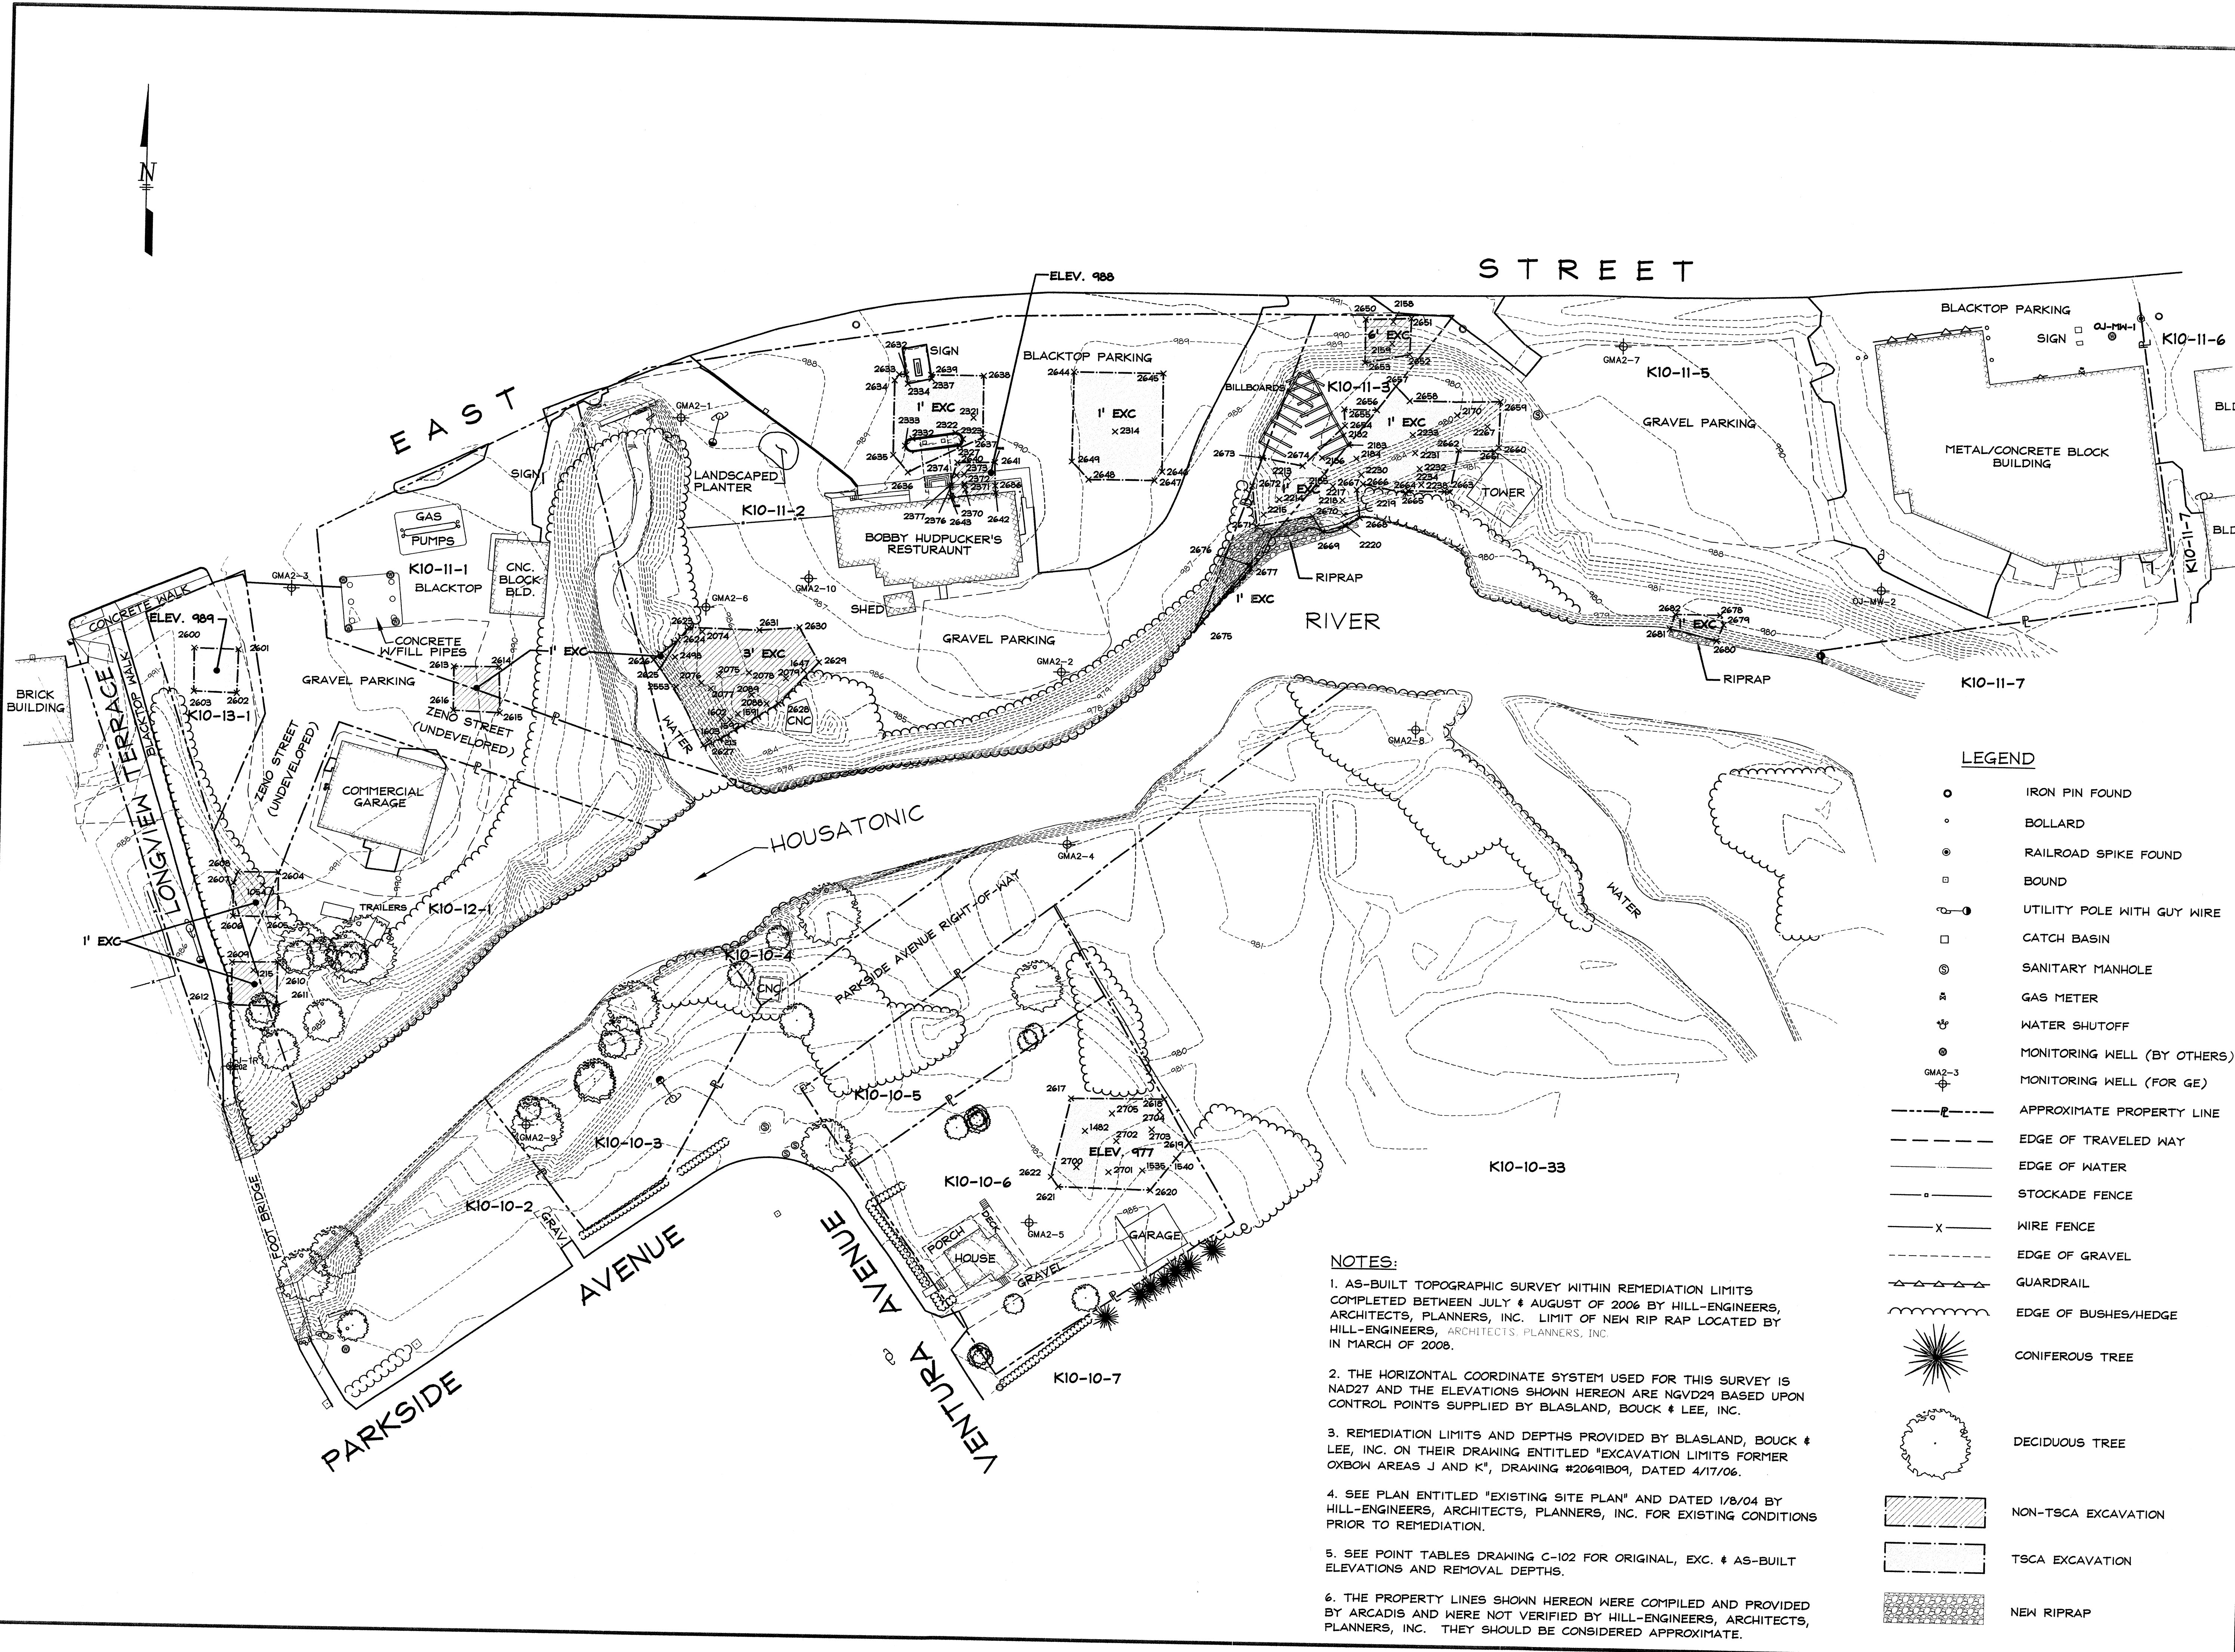


LEGEND

- IRON PIN FOUND
- BOLLARD
- ⊙ RAILROAD SPIKE FOUND
- BOUND
- ⊕ UTILITY POLE WITH GUY WIRE
- CATCH BASIN
- ⊙ SANITARY MANHOLE
- ⊙ GAS METER
- ⊕ WATER SHUTOFF
- ⊙ MONITORING WELL (BY OTHERS)
- ⊕ MONITORING WELL (FOR GE)
- APPROXIMATE PROPERTY LINE
- EDGE OF TRAVELED WAY
- EDGE OF WATER
- STOCKADE FENCE
- WIRE FENCE
- EDGE OF GRAVEL
- GUARDRAIL
- EDGE OF BUSHES/HEDGE
- ☼ CONIFEROUS TREE
- ☼ DECIDUOUS TREE
- ▨ NON-TSCA EXCAVATION
- ▨ TSCA EXCAVATION
- ▨ NEW RIPRAP

NOTES:

- AS-BUILT TOPOGRAPHIC SURVEY WITHIN REMEDIATION LIMITS COMPLETED BETWEEN JULY & AUGUST OF 2006 BY HILL-ENGINEERS, ARCHITECTS, PLANNERS, INC. LIMIT OF NEW RIP RAP LOCATED BY HILL-ENGINEERS, ARCHITECTS, PLANNERS, INC. IN MARCH OF 2008.
- THE HORIZONTAL COORDINATE SYSTEM USED FOR THIS SURVEY IS NAD27 AND THE ELEVATIONS SHOWN HEREON ARE NGVD29 BASED UPON CONTROL POINTS SUPPLIED BY BLASLAND, BOUCK & LEE, INC.
- REMEDIATION LIMITS AND DEPTHS PROVIDED BY BLASLAND, BOUCK & LEE, INC. ON THEIR DRAWING ENTITLED "EXCAVATION LIMITS FORMER OXBOW AREAS J AND K", DRAWING #20691B09, DATED 4/17/06.
- SEE PLAN ENTITLED "EXISTING SITE PLAN" AND DATED 1/8/04 BY HILL-ENGINEERS, ARCHITECTS, PLANNERS, INC. FOR EXISTING CONDITIONS PRIOR TO REMEDIATION.
- SEE POINT TABLES DRAWING C-102 FOR ORIGINAL, EXC. & AS-BUILT ELEVATIONS AND REMOVAL DEPTHS.
- THE PROPERTY LINES SHOWN HEREON WERE COMPILED AND PROVIDED BY ARCADIS AND WERE NOT VERIFIED BY HILL-ENGINEERS, ARCHITECTS, PLANNERS, INC. THEY SHOULD BE CONSIDERED APPROXIMATE.

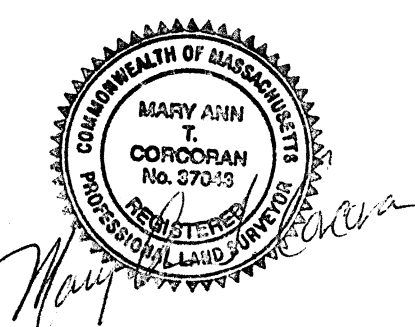

POINT NUMBER	ORIGINAL ELEVATION	EXCAVATED ELEVATION	FINAL ELEVATION	DEPTH (FEET)	ELEVATION CHANGE (ORIGINAL - FINAL)
2170	979.8	978.7	979.8	1.1	---
2182	979.5	978.4	979.5	1.1	---
2183	979.6	978.5	979.5	1.1	+0.1
2184	979.8	978.6	979.8	1.2	---
2185	980.1	979.0	980.0	1.1	+0.1
2186	979.8	978.7	979.8	1.1	---
2213	980.4	979.1	980.4	1.3	---
2214	981.4	980.3	981.3	1.1	+0.1
2215	984.3	983.3	984.3	1.0	---
2217	983.9	982.3	983.9	1.6	---
2218	983.9	982.3	983.8	1.6	+0.1
2219	979.9	978.6	979.8	1.3	+0.1
2220	979.0	977.9	978.5	1.1	+0.5
2230	984.2	982.7	984.2	1.5	---
2231	984.7	983.6	984.6	1.1	+0.1
2232	984.6	983.4	984.6	1.2	---
2233	979.2	977.9	979.2	1.3	---
2234	980.4	979.1	980.3	1.3	+0.1
2238	979.8	978.4	979.8	1.4	---
2267	986.6	983.1	986.6	3.5	---
2314	988.5	987.1	988.4	1.4	+0.1
2321	989.9	988.9	989.8	1.0	+0.1
2322	990.0	988.4	990.0	1.6	---
2323	990.1	988.5	990.1	1.6	---
2327	990.1	988.9	990.1	1.2	---
2332	989.8	987.8	989.7	2.0	+0.1
2333	989.8	988.7	989.8	1.1	---
2334	989.3	987.9	989.3	1.4	---
2337	989.7	988.1	989.6	1.6	+0.1
2632	989.2	987.8	989.2	1.4	---
2633	989.1	987.8	989.1	1.3	---
2634	989.0	987.7	989.0	1.3	---
2635	989.7	988.6	989.6	1.1	+0.1
2636	990.1	988.9	990.1	1.2	---
2637	990.0	988.2	990.0	1.8	---
2638	989.5	988.4	989.5	1.1	---
2639	989.5	988.2	989.5	1.3	---
2644	989.0	987.8	989.0	1.2	---
2645	988.2	986.5	988.2	1.7	---
2646	987.8	986.3	987.8	1.5	---
2647	987.9	986.7	987.9	1.2	---
2648	988.7	987.5	988.7	1.2	---
2649	989.1	987.8	989.0	1.3	+0.1
2654	979.4	978.3	979.4	1.1	---
2655	979.7	978.4	979.7	1.3	---
2656	979.0	977.9	978.9	1.1	+0.1
2657	979.0	978.0	979.0	1.0	---
2658	978.8	977.8	978.8	1.0	---
2659	984.1	983.1	984.1	1.0	---
2660	985.7	984.5	985.7	1.2	---
2661	984.5	983.5	984.5	1.0	---
2662	985.2	984.0	985.1	1.2	+0.1
2663	981.0	978.9	981.0	2.1	---
2664	979.9	978.9	979.9	1.0	---
2665	979.8	978.8	979.8	1.0	---
2666	984.2	983.1	984.2	1.1	---
2667	984.2	982.9	984.2	1.3	---
2668*	973.0	972.9	973.6	0.1	-0.6
2669*	972.3	972.3	974.9	0.0	-2.6
2670	982.1	981.0	982.1	1.1	---
2671	984.6	983.1	984.5	1.5	+0.1
2672	986.9	984.1	986.9	2.8	---
2673	982.9	980.9	982.9	2.0	---
2674	979.9	978.6	979.9	1.3	---
2675	975.3	974.3	975.3	1.0	---
2676	973.1	972.0	973.0	1.1	+0.1
2677	972.2	971.1	972.2	1.1	---
2678	974.7	973.3	974.7	1.4	---
2679	980.4	979.3	980.4	1.1	---
2680	974.9	973.8	974.8	1.1	+0.1
2681	973.3	972.3	973.3	1.0	---
2682	980.5	978.9	980.5	1.6	---

* DENOTES POINTS AT EDGE OF WATER WHERE EXCAVATION WAS MINIMAL.

POINT NUMBER	ORIGINAL ELEVATION	EXCAVATED ELEVATION	FINAL ELEVATION	DEPTH (FEET)	ELEVATION CHANGE (ORIGINAL - FINAL)
1482	984.0	977.0	983.4	7.0	+0.6
1535	984.0	977.0	983.4	7.0	+0.6
1540	983.7	977.0	982.8	6.7	+0.9
2617	984.3	977.0	983.8	7.3	+0.5
2618	981.6	977.0	981.0	4.6	+0.6
2619	982.1	977.0	981.6	5.1	+0.5
2620	984.5	977.0	984.4	7.5	+0.7
2621	985.0	977.0	984.4	8.0	+0.6
2622	985.0	977.0	984.5	8.0	+0.5
2700	984.8	977.0	984.3	7.8	+0.5
2701	984.2	977.0	983.6	7.2	+0.6
2702	984.2	977.0	983.7	7.2	+0.5
2703	983.9	977.0	983.4	6.9	+0.5
2704	983.8	976.9	983.3	6.9	+0.5
2705	984.0	977.0	983.4	7.0	+0.6

POINT NUMBER	ORIGINAL ELEVATION	EXCAVATED ELEVATION	FINAL ELEVATION	DEPTH (FEET)	ELEVATION CHANGE (ORIGINAL - FINAL)
2600	992.1	988.9	991.9	3.2	+0.2
2601	992.0	988.9	991.9	3.1	+0.1
2602	992.1	988.9	992.1	3.2	---
2603	992.2	989.0	992.2	3.2	---

POINT NUMBER	ORIGINAL ELEVATION	EXCAVATED ELEVATION	FINAL ELEVATION	DEPTH (FEET)	ELEVATION CHANGE (ORIGINAL - FINAL)
1054	991.2	989.9	991.2	1.3	---
1215	986.4	985.1	986.4	1.3	---
2604	991.3	990.1	991.2	1.2	+0.1
2605	990.6	989.5	990.6	1.1	---
2606	987.2	986.1	987.2	1.1	---
2607	988.2	987.2	988.1	1.0	+0.1
2608	990.8	989.4	990.8	1.4	---
2609	986.4	985.3	986.3	1.1	+0.1
2610	985.9	984.7	985.9	1.2	---
2611	985.9	984.8	985.8	1.1	---
2612	987.2	986.0	987.1	1.2	+0.1
2613	990.4	989.3	990.4	1.1	+0.1
2614	990.3	989.3	990.3	1.0	---
2615	990.2	989.2	990.2	1.0	---
2616	990.4	989.2	990.4	1.2	---
2624	984.0	982.2	984.0	1.8	---
2625	976.2	974.2	976.0	2.0	+0.2
2626	976.0	973.6	975.9	2.4	+0.1

POINT NUMBER	ORIGINAL ELEVATION	EXCAVATED ELEVATION	FINAL ELEVATION	DEPTH (FEET)	ELEVATION CHANGE (ORIGINAL - FINAL)
1591	987.6	981.7	987.6	5.9	---
1592	984.6	980.6	984.5	4.0	+0.1
1602	983.6	978.8	983.6	4.8	---
1603	976.5	971.7	976.4	4.8	+0.1
1647	986.3	982.6	986.3	3.7	---
2074	985.3	982.0	985.3	3.3	---
2075	985.7	982.0	985.7	3.7	---
2076	985.4	982.0	985.3	3.4	+0.1
2077	984.5	981.4	984.4	3.1	+0.1
2078	986.0	983.0	985.9	3.0	+0.1
2079	986.3	983.3	986.3	3.0	---
2088	988.1	984.3	988.1	3.8	---
2089	988.2	983.2	988.1	5.0	+0.1
2498	983.3	977.5	983.3	5.8	---
2553	977.0	972.0	977.0	5.0	---
2623	984.8	981.1	984.8	3.7	---
2624	984.0	979.9	984.0	4.1	---
2625	976.2	972.1	976.0	4.1	+0.2
2627	974.7	971.6	974.6	3.1	+0.1
2628	987.0	983.3	986.9	3.7	+0.1
2629	986.0	983.0	986.0	3.0	---
2630	986.7	983.6	986.6	3.1	+0.1
2631	986.3	983.1	986.3	3.2	---

POINT NUMBER	ORIGINAL ELEVATION	EXCAVATED ELEVATION	FINAL ELEVATION	DEPTH (FEET)	ELEVATION CHANGE (ORIGINAL - FINAL)
2158	991.5	985.3	991.5	6.2	---
2159	988.7	981.0	988.6	7.7	+0.1
2650	991.1	985.0	991.0	6.1	+0.1
2651	991.4	985.3	991.3	6.1	+0.1
2652	985.2	979.2	985.1	6.0	+0.1
2653	982.3	976.0	982.2	6.3	+0.1

POINT NUMBER	ORIGINAL ELEVATION	EXCAVATED ELEVATION	FINAL ELEVATION	DEPTH (FEET)	ELEVATION CHANGE (ORIGINAL - FINAL)
2370	991.6	987.8	991.5	3.8	+0.1
2371	991.2	987.9	991.1	3.3	+0.1
2372	990.6	987.9	990.5	2.7	+0.1
2373	990.6	987.9	990.5	2.7	+0.1
2374	990.6	988.0	990.6	2.6	---
2376	990.6	987.9	990.6	2.7	---
2377	991.0	987.9	991.0	3.1	---
2640	990.3	987.8	990.3	2.5	---
2641	990.3	988.0	990.2	2.3	+0.1
2642	991.5	987.9	991.4	3.6	+0.1
2643	991.2	987.9	990.6	3.3	+0.6
2686	990.8	987.9	990.8	2.9	---

+ IN ELEVATION CHANGE DENOTES POTENTIAL INCREASE (GAIN) IN FLOOD STORAGE.
- IN ELEVATION CHANGE DENOTES POTENTIAL DECREASE (LOSS) IN FLOOD STORAGE.

GENERAL ELECTRIC COMPANY, INC.
159 PLASTICS AVENUE
PITTSFIELD, MA

POINT TABLES

OXBOWS J & K AREA

DRN DCD	DATE	REV.	DESCRIPTION
JJM	10-20-06	A	ISSUED FOR COMMENT
JR	1-25-07	B	GENERAL REVISIONS
JR	12-17-07	C	REVISED POINT TABLES
JR	3-4-08	D	GENERAL REVISIONS, REVISED RIP RFP

DRAWING TITLE: POINT TABLES

DRAWN BY: JJM
DATE DRAWN: 10-20-06
SCALE: N/A
APV'D BY:

CAD CODE: DWG\MX-63-1(AS-BUILT).DWG
GRAPHIC SCALE:

PROJECT NUMBER: MX-63-1

DRAWING NUMBER	REV.
C-102	D

A COPY OF THE DATA IN THIS DRAWING FILE IS MAINTAINED AT THE OFFICES OF HILL ENGINEERS ARCHITECTS PLANNERS INC. THE INTERPRETATION, APPLICATION AND REVISION OF THIS DATA IS THE SOLE RESPONSIBILITY OF THE USER.