


PLANS FOR
LAKE PONTCHARTRAIN, LOUISIANA AND VICINITY
HIGH LEVEL PLAN


ORLEANS AVENUE OUTFALL CANAL
PHASE I-B
ORLEANS PARISH, LOUISIANA
ROBERT E. LEE BOULEVARD BRIDGE
MARCH 8, 2000

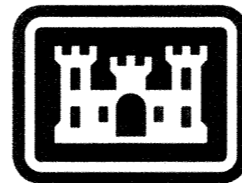

US Army Corps
of Engineers
New Orleans District

H-4-44776
DACW29-00-B-0094


AS BUILT PLANS
DATE RECEIVED 3/15/02
DATE TRACINGS CORRECTED 4/18/02

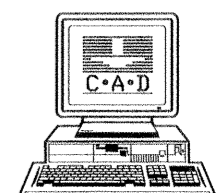


DACW29-00-B-0094

AS BUILT PLANS

DATE RECEIVED 3/15/02
DATE TRACINGS CORRECTED 4/18/02


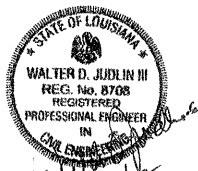


LAKE PONTCHARTRAIN

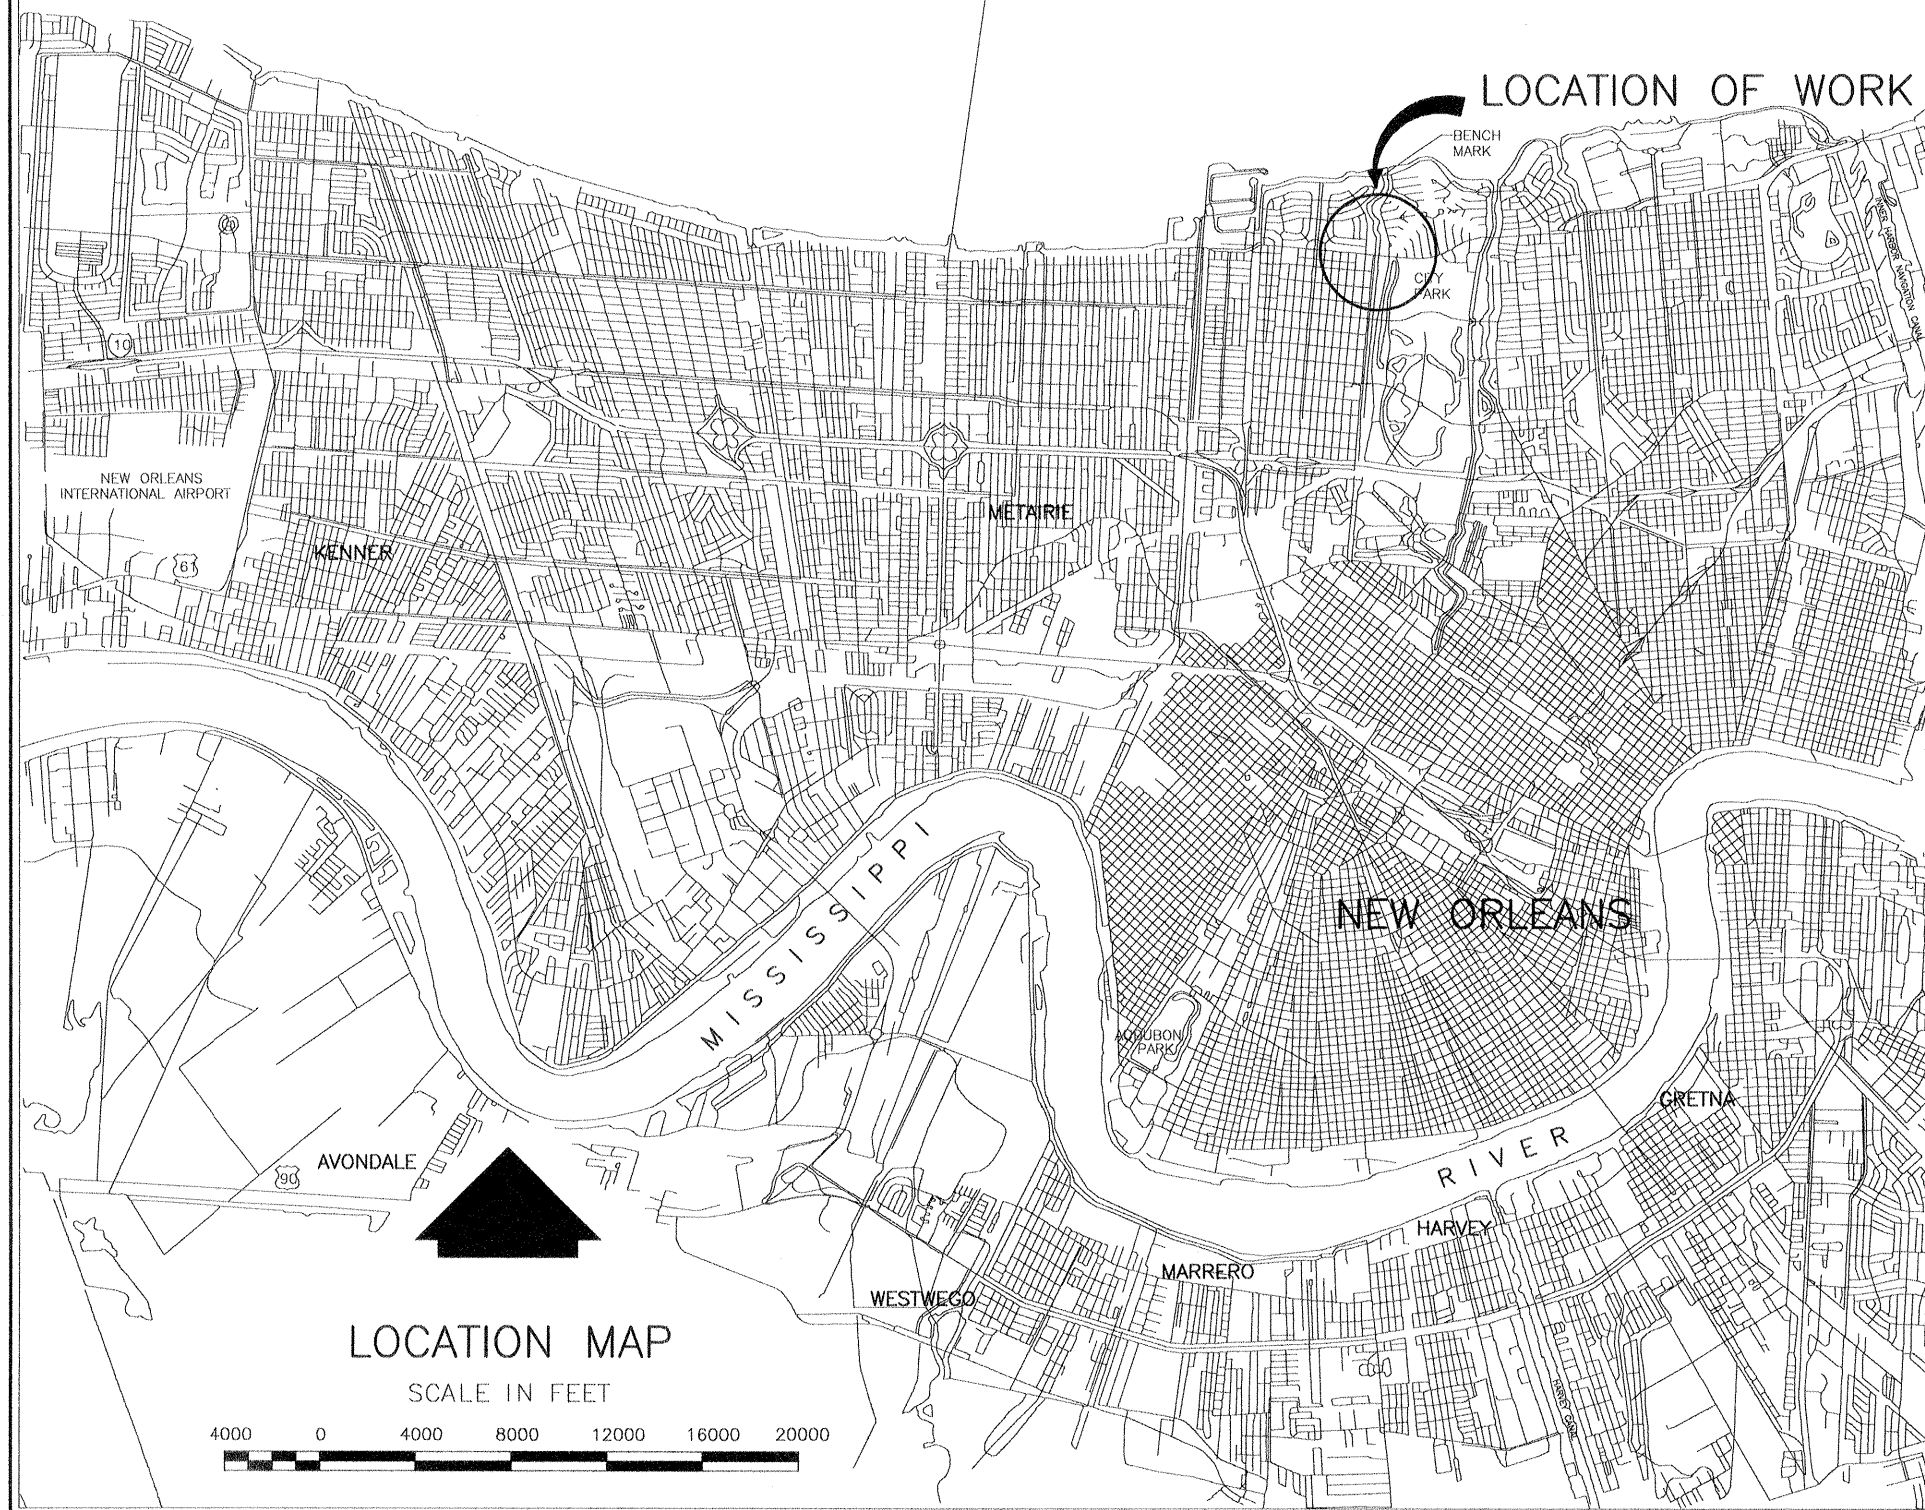


LOCATION MAP

SCALE IN FEET

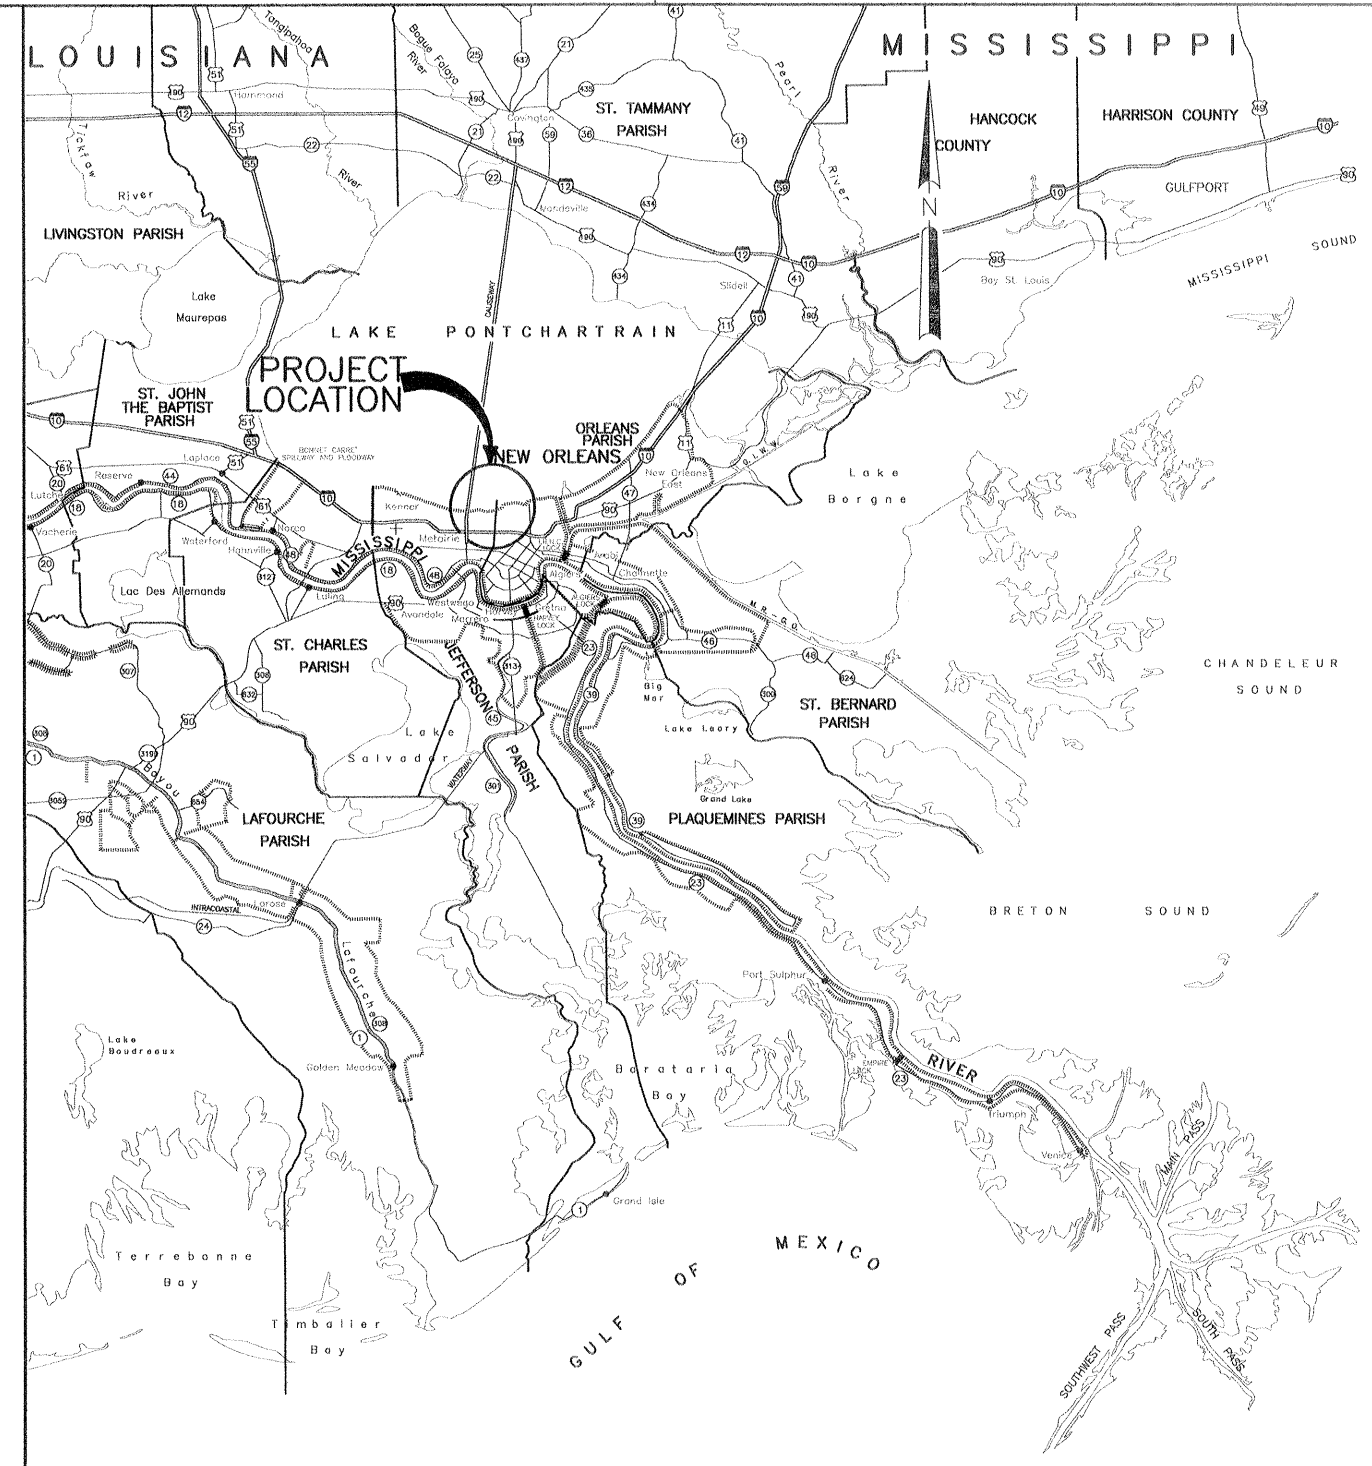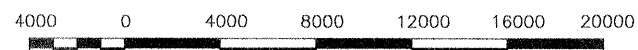

VICINITY MAP

SCALE IN MILES

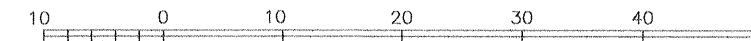

TABULATION OF BENCH MARKS

DESIGNATION	DESCRIPTION	ELEVATION
CHRYSLER RM 1983 EPOCH	C.G.S. REFERENCE MARK DISK AT NEW ORLEANS, ABOUT 0.45 MILE EAST ALONG LAKESHORE DRIVE FROM JUNCTION OF CANAL BOULEVARD, 125 YARDS NORTHWEST OF THE NORTHWEST CORNER OF LAKESHORE DRIVE BRIDGE OVER ORLEANS CANAL, SET IN THE TOP OF THE CONCRETE SEA WALL ALONG SHORE OF LAKE PONTCHARTRAIN, 33 FEET NORTHEAST OF THE NORTH ONE OF A GROUP OF PALM TREES, 66 FEET WEST OF CHRYSLER STATION DESCRIBED, 270 FEET NORTH OF THE CENTER LINE OF LAKESHORE DRIVE AND ABOUT 2 FEET ABOVE THE LEVEL OF THE LAKESHORE DRIVE.	7.11 N.G.V.D.

THIS PROJECT WAS DESIGNED BY THE FIRM OF HARTMAN ENGINEERING, INC. FOR THE NEW ORLEANS DISTRICT OF U.S. ARMY CORPS OF ENGINEERS. THE INITIALS OR SIGNATURES AND REGISTRATION DESIGNATIONS OF USAGE EMPLOYEES APPEARING ON THESE PROJECT DOCUMENTS ARE WITHIN THE SCOPE OF THEIR EMPLOYMENT AS REQUIRED BY ER 1110-1-8152.

INDEX TO DRAWINGS

DWG.	TITLE	DWG.	TITLE	DWG.	TITLE
1	INDEX, LOCATION AND VICINITY MAP	24	JOINT DETAILS	47	ROADWAY CROSS SECTIONS
2	LEGEND AND ABBREVIATIONS	25	JOINT DETAILS	48	ROADWAY CROSS SECTIONS
3	GENERAL NOTES	26	TYPICAL WALL JOINTS	49	ROADWAY CROSS SECTIONS
4	LIMITS OF CONSTRUCTION	27	I-WALL REINFORCING & DETAILS	50	BORING LOGS
5	BRIDGE PLAN - PROFILE	28	I-WALL TREATMENT - WEST SIDE	51	BORING LOGS
6	TRAFFIC CONTROL NOTES	29	I-WALL TREATMENT - EAST SIDE	52	CORING LOGS
7	TRAFFIC CONTROL DEVICES, PLAN AND NOTES	30	BRIDGE PLAN AND ELEVATION	LADOTD STANDARD PLANS	
8	EXISTING BRIDGE	31	PRESTRESSED CONCRETE PILES		
9	DEMOLITION PLAN	32	WEST APPROACH SLAB		
10	EXISTING ORLEANS AVE. CANAL - SECTIONS	33	EAST APPROACH SLAB		
11	UTILITY PLAN	34	APPROACH SLAB DETAILS		
12	UTILITY RELOCATIONS	35	ABUTMENT PLAN & ELEVATION		
13	UTILITY RELOCATIONS	36	ABUTMENT DETAILS		
14	FLOODWALL PLAN	37	BENTS 2 & 3		
15	DETAILED FLOODWALL PLAN	38	TYPICAL SUPERSTRUCTURE SECTION		
16	DETAILED FLOODWALL PLAN	39	ROADWAY ELEVATIONS		
17	DETAILED FLOODWALL PLAN	40	SLAB SPAN 1	53	YEAR PLATES
18	FLOODWALL PROFILE - WEST SIDE	41	SLAB SPAN 2	54	STRIP SEAL JOINT DETAILS
19	FLOODWALL PROFILE - EAST SIDE	42	SLAB SPAN 3	55	STRIP SEAL JOINT DETAILS
20	TYPICAL WALL SECTIONS SOUTHWEST OF BRIDGE	43	BRIDGE FLOODWALL DETAILS	56	BAR SUPPORTS FOR REINFORCING STEEL
21	SHEET PILE DETAILS	44	TYPICAL ROADWAY SECTIONS	57	HWY. SIGN AND BARRICADE DETAILS FOR CONSTRUCTION
22	SHEET PILE DETAILS & JOINT DETAILS	45	TYP. ROADWAY AND SIDEWALK DETAILS	58	HWY. SIGN AND BARRICADE DETAILS FOR CONSTRUCTION
23	SHEET PILE DETAILS & JOINT DETAILS	46	PERMANENT PAVEMENT MARKINGS	59	HWY. SIGN AND BARRICADE DETAILS FOR CONSTRUCTION

SYMBOL	DESCRIPTION	DATE	APPROVED
REVISIONS			
U.S. ARMY ENGINEER DISTRICT, NEW ORLEANS CORPS OF ENGINEERS NEW ORLEANS, LOUISIANA			
BOARD OF LEVEE COMMISSIONERS ORLEANS LEVEE DISTRICT NEW ORLEANS, LOUISIANA		HARTMAN ENGINEERING, INC. CONSULTING ENGINEERS KENNER, LOUISIANA	
LAKE PONTCHARTRAIN, LOUISIANA AND VICINITY HIGH LEVEE PLAN ORLEANS AVENUE OUTFALL CANAL PHASE IB ORLEANS PARISH, LOUISIANA ROBERT E. LEE BOULEVARD BRIDGE INDEX, LOCATION, AND VICINITY MAP			
DESIGNED BY: W.D.L. DRAWN BY: L.A.C. CHECKED BY: W.D.L. DATE: MARCH 8, 2000	APPROVED BY: CHIEF, STRUCTURES BRANCH	CADD FILE: S-111.DWG PLOT DATE: MAR 8, 2000 PLOT SCALE: 400	SUBMITTED BY: HARTMAN ENGINEERING DESIGN ENGINEER
HARTMAN ENGINEERING DESIGN ENGINEER	APPROVED BY: CHIEF, ENGINEERING DIVISION	FILE NO. H-4-44776	APPROVED BY: HARTMAN ENGINEERING DESIGN ENGINEER
	COLONEL, C. E. DISTRICT ENGINEER	DWG. 1 OF 59	

Safety is a Part
of Your Contract




ABBREVIATIONS

ABT	ABOUT
ADJ	ADJACENT
ACP	ASPHALTIC CONCRETE PAVEMENT
B/L	BASE LINE
BM	BENCH MARK
CIP	CAST IN PLACE
CB	CATCH BASIN
C/L	CENTER LINE
CL	CLEARANCE
CONC	CONCRETE
CJ	CONSTRUCTION JOINT
C.R.S	CORROSION RESISTANT STEEL
CY	CUBIC YARD
DIA OR Ø	DIAMETER
D/W	DRIVEWAY
DI	DROP INLET
D.I.	DUCTILE IRON
DPW	DEPARTMENT OF PUBLIC WORKS
DWG	DRAWING
E.F.	EACH FACE
E.B.	EASTBOUND
E B/L	EAST BASELINE
EL OR ELEV	ELEVATION
E.S.	EQUAL SPACES
EXIST	EXISTING
EXP	EXPANSION
F.S.	FAR SIDE
FND	FOUND
FT	FOOT
HDG	HOT DIP GALVANIZED
H.P.	HIGH PRESSURE
HWY	HIGHWAY
H OR HORIZ	HORIZONTAL
ID	INTERNAL DIAMETER
INV	INVERT
IR	IRON ROD
JT	JOINT
KIP	1000 LBS.
LT	LEFT
LF	LINEAR FEET
LG	LONG
LDOTD	LOUISIANA DEPARTMENT OF TRANSPORTATION AND DEVELOPMENT
MH	MANHOLE
MAX	MAXIMUM
MSL	MEAN SEA LEVEL
MIN	MINIMUM
NGVD	NATIONAL GEODETIC VERTICAL DATUM
NIC	NOT IN CONTRACT
N.S.	NEAR SIDE
N.T.S.	NOT TO SCALE
OC	ON CENTER
OLB	ORLEANS LEVEE BOARD
OD	OUTSIDE DIAMETER
PL	PLATE
PI	POINT OF INTERSECTION
PVC	POINT OF VERTICAL CURVATURE
PVT	POINT OF VERTICAL TANGENCY
PVC	POLYVINYL CHLORIDE PIPE
PGL	PROFILE GRADE LINE
R	RADIUS
REINF	REINFORCING
REQ'D.	REQUIRED
RET	RETAINING
R/W	RIGHT-OF-WAY
RT	RIGHT
RD	ROAD
SECT	SECTION
S&WB	SEWERAGE AND WATER BOARD
SH.	SHEET(S)
SP	SPACE(S)
STA	BASELINE STATION
STD	STANDARD
STR	STRAIGHT
ST	STREET
SYMM.	SYMMETRICAL
TEL	TELEPHONE
TBM	TEMPORARY BENCH MARK
T&B	TOP & BOTTOM
TC	TOP OF CURB OR TOP OF CASTING
TYP	TYPICAL
UG	UNDERGROUND
USACE	U.S. ARMY CORPS OF ENGINEERS
V OR VERT	VERTICAL
W/L	WALL LINE
W.S.	WATERSTOP
WS	WATER SURFACE
W B/L	WEST BASELINE
W.B.	WESTBOUND
W/	WITH

LEGEND

	TREE		WATER VALVE
	BUSH		FIRE HYDRANT
	CORING AND NUMBER		GAS MANHOLE
	BANK OR SLOPE LINES		GAS METER
	FENCE		GAS VALVE
	GAS LINE AND SIZE		TRAFFIC LIGHT
	SEWER LINE AND SIZE		POWER POLE OR TELEPHONE POLE
	DRAIN LINE AND SIZE		LIGHT POLE
	WATER LINE AND SIZE		STRUCTURE (HOUSE, GARAGE)
	TELEPHONE LINE		GRADE
	UNDERGROUND TELEPHONE LINE		ELECTRIC MANHOLE
	SEWER MANHOLE		FLOW DIRECTION
	DRAIN CLEANOUT		SIGN
	SEWER CLEANOUT		GUARD POST
	UNDERGROUND ELECTRIC LINE		REMOVAL
	ELECTRIC LINE (OVERHEAD)		ELECTRICAL JUNCTION BOX
	CATCH BASIN		TRAFFIC ELECTRICAL JUNCTION BOX
	DROP INLET		TRAFFIC ELECTRICAL MANHOLE
	TELEPHONE MANHOLE		CABLE TV JUNCTION BOX
	TELEPHONE JUNCTION BOX		STEEL SHEET PILING
	WATER METER		REQ'D. BANK OR SLOPE LINES
	WATER MANHOLE		REQ'D. GRADE (BOLD)
	DRAIN MANHOLE		REQ'D. GRASS AREA
			REQ'D. CONCRETE PAVEMENT
			REQ'D. ASPHALT PAVEMENT


SECTION AND DETAIL CROSS REFERENCES

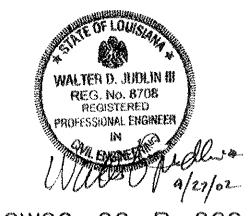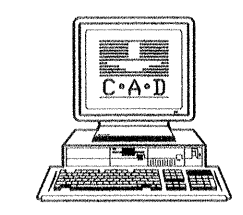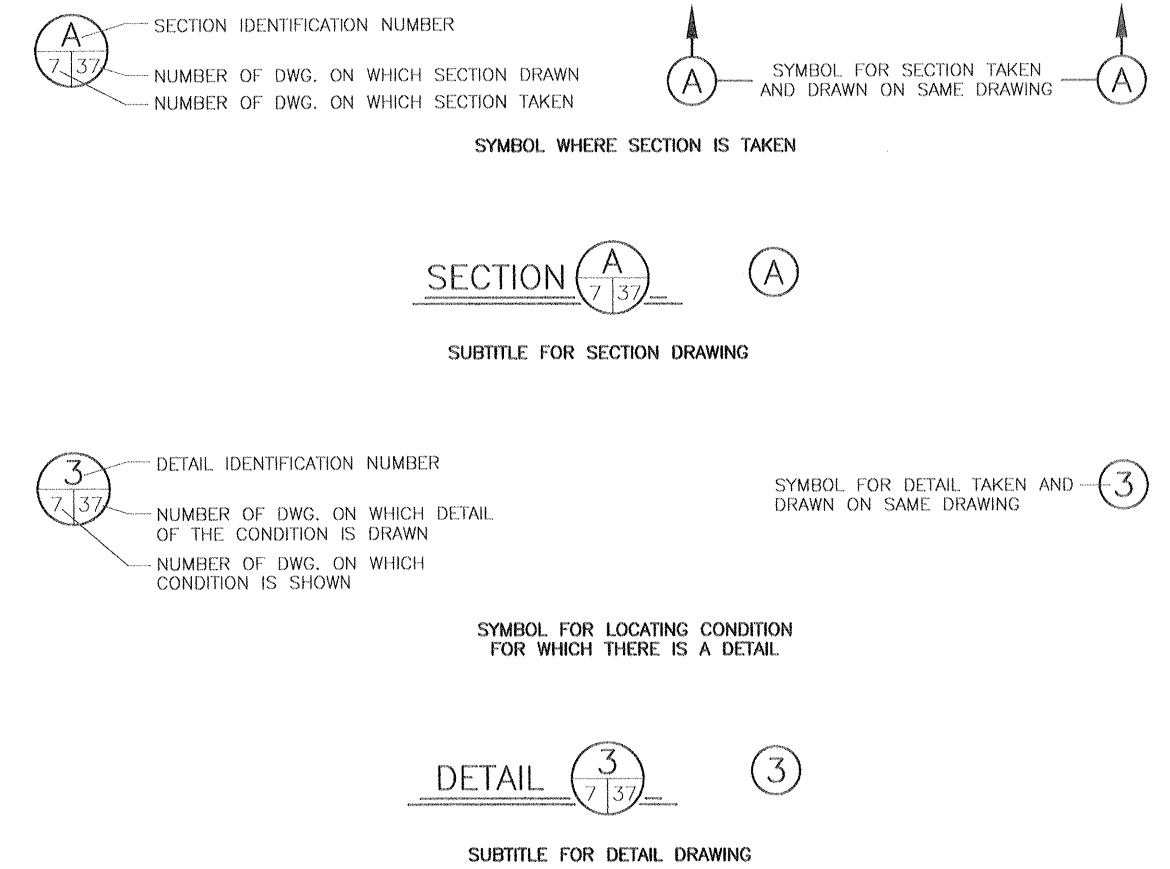

DACW29-00-B-0094

AS BUILT PLANS
 DATE RECEIVED 3/15/02
 DATE TRACINGS CORRECTED 4/18/02

SYMBOL	DESCRIPTION	DATE	APPROVED
REVISIONS			
U.S. ARMY ENGINEER DISTRICT, NEW ORLEANS CORPS OF ENGINEERS NEW ORLEANS, LOUISIANA			
BOARD OF LEVEE COMMISSIONERS ORLEANS LEVEE BOARD NEW ORLEANS, LOUISIANA		HARTMAN ENGINEERING, INC. CONSULTING ENGINEERS KENNER, LOUISIANA	
LAKE PONTCHARTRAIN, LA. AND VICINITY HIGH LEVEL PLAN ORLEANS AVENUE OUTFALL CANAL PHASE 1B ORLEANS PARISH LOUISIANA			
ROBERT E. LEE BOULEVARD BRIDGE LEGEND AND ABBREVIATIONS			
DESIGNED BY: W.D.J.	DATE: MAR. 8, 2000	PLOT SCALE: 1	PLOT DATE: MARCH 8, 2000
DRAWN BY: C.R.H.	CADD FILE: SHT2.DGN	FILE NO. H-4-44776	
CHECKED BY: P.J.H.	SOLICITATION NO. DACW29-00-B-0094	DWG. 2 OF 59	
SUBMITTED BY: HARTMAN ENGINEERING DESIGN ENGINEER			

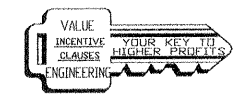

Safety is a Part
of Your Contract

GENERAL NOTES

A. GENERAL DESIGN NOTES

1. BRIDGE DESIGN SPECIFICATIONS:


- a. THE 1992 STANDARD SPECIFICATIONS FOR HIGHWAY BRIDGES OF THE AMERICAN ASSOCIATION OF STATE HIGHWAY AND TRANSPORTATION OFFICIALS (AASHTO) FIFTEENTH EDITION AS AMENDED BY THE CURRENT AASHTO INTERIM SPECIFICATIONS FOR BRIDGES.
- b. THE 1987 BRIDGE DESIGN MANUAL PREPARED BY THE BRIDGE DESIGN SECTION OF THE LOUISIANA DEPARTMENT OF TRANSPORTATION AND DEVELOPMENT 3RD EDITION AS AMENDED BY THE CURRENT BRIDGE DESIGN MEMORANDA.

2. CONSTRUCTION SPECIFICATION: U.S. ARMY CORPS OF ENGINEERS GUIDE SPECIFICATIONS AND THE PROJECT TECHNICAL SPECIFICATIONS.

3. DESIGN SPEED: ROBERT E. LEE BOULEVARD BRIDGE = 20 M.P.H.

4. DESIGN LOADS:

- a. DEAD LOADS - ESTIMATED WEIGHT OF COMPLETED STRUCTURE INCLUDING AN ALLOWANCE OF 12 PSF FOR FUTURE WEARING SURFACE.
- b. LIVE LOADS - HS20-44 LOADING AS SHOWN ON THIS SHEET.
- c. ALL OTHER LOADS SHALL BE IN ACCORDANCE WITH AASHTO SPECIFICATIONS.

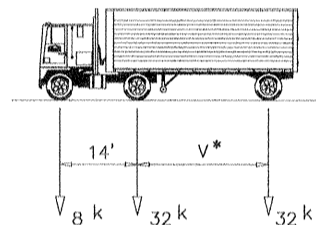

LADOTD HS-20-44 TRUCK
* V = VARIABLE 14-30FT

5. DESIGN CANAL WATER ELEVATION HIGH LEVEL PLAN:

- a. STILL WATER LEVEL - EL. 11.90 N.G.V.D. (100% OF DESIGN FORCES USED.)

6. STATIONS: ALL STATIONS REFER TO THE PROJECT BASELINE STATIONS UNLESS OTHERWISE NOTED.

7. ELEVATIONS: ALL ELEVATIONS ARE IN FEET AND REFER TO NATIONAL GEODETIC VERTICAL DATUM (N.G.V.D.). ELEVATION BENCH MARK IS BM "CHRYSLER RM", EL. 7.11 (1983 EPOCH), C.G.S. REFERENCE MARK DISK AT NEW ORLEANS, ABOUT 0.45 MILE EAST ALONG LAKESHORE DRIVE FROM JUNCTION OF CANAL BOULEVARD, 125 YARDS NORTHWEST OF THE NORTHWEST CORNER OF LAKESHORE DRIVE BRIDGE OVER ORLEANS CANAL SET IN THE TOP OF THE CONCRETE SEA WALL ALONG SHORE OF LAKE PONTCHARTRAIN, 33 FEET NORTHEAST OF THE NORTH ONE OF A GROUP OF PALM TREES, 66 FEET WEST OF CHRYSLER STATION DESCRIBED, 270 FEET NORTH OF THE CENTER LINE OF LAKESHORE DRIVE AND ABOUT 2 FEET ABOVE THE LEVEL OF THE LAKESHORE DRIVE.

8. DESIGN CRITERIA: ALL STRUCTURAL MEMBERS ARE DESIGNED BY LOAD FACTOR METHOD UNLESS OTHERWISE NOTED.

9. DIMENSIONS: DIMENSIONS AND/OR ELEVATIONS MARKED THUS (±) ARE APPROXIMATE. CONTRACTOR SHALL VERIFY ACTUAL DIMENSIONS IN FIELD. DIMENSIONS AND/OR ELEVATIONS MARKED THUS (N.T.S.) ARE NOT SHOWN TO SCALE. DRAWINGS ARE GENERALLY TO SCALE, BUT SHOULD NOT BE SCALED. N.T.S. IS SHOWN ONLY WHERE DRAWING IS OBVIOUSLY OUT OF SCALE.

B. GEOTECHNICAL NOTES

- 1. SOILS INVESTIGATION: A SOILS INVESTIGATION WAS PERFORMED FOR THIS PROJECT. BORING LOGS ARE INCLUDED IN THESE CONTRACT DRAWINGS.
- 2. PILES: ALL PILE REQUIREMENTS INCLUDING SIZE AND TYPE ARE LOCATED WITHIN THE DRAWINGS AND SPECIFICATIONS.

C. STRUCTURAL STEEL NOTES

- 1. ANCHOR BOLTS SHALL BE ASTM A-307 RODS.
- 2. STRUCTURAL STEEL SHALL CONFORM TO ASTM A36 UNLESS OTHERWISE NOTED. FABRICATION SHALL MEET THE REQUIREMENTS OF THE PROJECT SPECIFICATIONS.

D. STRUCTURAL CONCRETE

- 1. CHAMFER ALL EXPOSED EDGES OF CONCRETE 3/4" EXCEPT ALL CORNERS OF BENTS WHICH SHALL BE CHAMFERED 1-1/2" UNLESS OTHERWISE NOTED. NO DEDUCTIONS ARE TO BE MADE IN CONCRETE QUANTITIES FOR CHAMFERS 1-1/2" OR LESS.
- 2. FINISH DESCRIPTIONS SHOWN HEREIN ARE DESCRIBED IN THE PROJECT SPECIFICATIONS.

E. REINFORCEMENT

- 1. ALL REINFORCING STEEL BARS SHALL BE DEFORMED STEEL BARS CONFORMING TO ASTM 615, ASTM 616, ASTM 617.
- 2. DIMENSIONS RELATING TO REINFORCING STEEL FABRICATION ARE OUT TO OUT OF BAR UNLESS OTHERWISE NOTED. DIMENSIONS RELATING TO REINFORCING STEEL SPACING ARE CENTER TO CENTER OF BAR. THE MINIMUM COVERING FROM THE SURFACE OF THE CONCRETE TO THE FACE OF ANY DEFORMED REINFORCING BAR SHALL NOT BE LESS THAN THE FOLLOWING:

TOP OF SLAB	=	2"
BOTTOM OF BRIDGE DECK	=	3"
HEADWALLS	=	3"

- 3. ALL OTHER REINFORCING STEEL COVER SHALL BE 3" UNLESS OTHERWISE NOTED IN THE PLANS.

- 4. MECHANICAL SPLICES FOR REINFORCING BARS SHALL BE APPROVED BY THE CONTRACTING OFFICER. THE EMBEDMENT AND LAP SPICE LENGTH TABLE ON THIS SHEET SHALL BE USED IN DETERMINING LAP SPLICES AND EMBEDMENT LENGTHS WHERE LENGTHS ARE NOT OTHERWISE INDICATED. SPLICE LENGTHS SHALL BE BASED ON THE SMALLER BAR BEING LAPPED. THE CONTRACTOR WILL BE ALLOWED TO MAKE SPLICES IN ADDITION TO THOSE INDICATED IN THE DRAWINGS, WHERE ESSENTIAL TO THOSE INDICATED IN THE DRAWINGS, WHERE ESSENTIAL TO CONSTRUCTIBILITY, SUBJECT TO APPROVAL BY THE CONTRACTING OFFICER. SPLICES OTHER THAN THOSE SHOWN ON THE DRAWINGS AND OTHER THAN ANY ADDITIONAL SPLICES REQUIRED BY THE CONTRACTING OFFICER, WILL BE AT THE CONTRACTOR'S EXPENSE.

REINFORCEMENT EMBEDMENT AND SPLICE TABLE

BAR SIZE	MINIMUM EMBEDMENT LENGTH, INCHES		MINIMUM LAP LENGTH INCHES	
	TOP	OTHER	TOP	OTHER
3	19	14	25	19
4	25	19	33	25
5	32	24	42	32
6	37	28	49	37
7	54	41	71	54
8	62	47	81	62
9	69	53	90	69
10	77	59	101	77
11	86	66	112	86

5. EMBEDMENT AND SPLICE NOTES:

- a. THE TABLE IS BASED ON THE FOLLOWING CONDITIONS:
 - i) CLEAR SPACING OF BARS BEING DEVELOPED OR SPLICED NOT LESS THAN THE BAR DIAMETER.
 - ii) CLEAR COVER NOT LESS THAN THE BAR DIAMETER.
 - iii) STIRRUPS OR TIES THROUGHOUT THE BAR DEVELOPMENT LENGTH NOT LESS THAN ACI CODE MINIMUM.
 - OR
 - iv) CLEAR SPACING OF BARS BEING DEVELOPED OR SPLICED NOT LESS THAN TWO BAR DIAMETERS.
 - v) CLEAR COVER NOT LESS THAN BAR DIAMETER.
- b. TOP BARS ARE HORIZONTAL BARS AND BARS INCLINED LESS THAN 45 DEGREES WITH RESPECT TO A HORIZONTAL PLANE, WHICH ARE PLACED SUCH THAT MORE THAN 12 INCHES OF CONCRETE IS CAST IN THE MEMBER BELOW THE BAR.

BRIDGE CONSTRUCTION SEQUENCE

PHASE I

- 1. ALL PILES ARE TO BE CAST AND READY FOR DELIVERY TO THE JOB SITE.
- 2. CLOSE ROBERT E. LEE BOULEVARD TO THROUGH TRAFFIC AND IMPLEMENT TRAFFIC CONTROL DEVICES PLAN.
- 3. DEMOLISH BRIDGE APPROACH SLABS TO ALLOW FOR RELOCATION OF GAS LINE.
- 4. DEMOLISH EXISTING "I"-WALL, SIDEWALK ON SOUTH SIDE OF BRIDGE, SOUTHWEST AND SOUTHEAST CORNERS OF THE EXISTING BRIDGE TO FACILITATE TELEPHONE LINE RELOCATIONS.
- 5. INSTALL TEMPORARY PILE SUPPORTS AND COORDINATE RELOCATION OF TELEPHONE LINE TO TEMPORARY SUPPORTS.
- 6. COORDINATE RELOCATION OF GAS LINE TO TEMPORARY SUPPORTS. CLOSE VALVES TO WATERLINE ATTACHED TO THE EXISTING BRIDGE.

PHASE II



- 7. DEMOLISH EXISTING BRIDGE SUBSTRUCTURE AND SUPERSTRUCTURE.

PHASE III

- 8. CONSTRUCT NEW BRIDGE SUBSTRUCTURE.
- 9. CONSTRUCT NEW BRIDGE SUPERSTRUCTURE. CONSTRUCTION OF THE SUPERSTRUCTURE SHOULD START WITH EITHER THE EAST OR WEST END BENTS. THE SLAB SPANS SHALL BE PLACED IN EITHER THE ORDER "1,3,2" OR "3,1,2".
- 10. COORDINATE PERMANENT RELOCATION OF GAS LINE AND TELEPHONE LINE. INSTALL NEW WATERLINE.
- 11. INSTALL NEW "I"-WALL SHEET PILING AT THE CORNERS OF THE NEW BRIDGE.
- 12. CAP EXISTING UNCAPPED SHEET PILING AND REMOVE TEMPORARY UTILITY SUPPORTS.
- 13. PERFORM GRADING AT NEW FLOODWALLS.

PHASE IV

- 14. DEMOLISH REMAINING APPROACH SLABS AND RECONSTRUCT REQUIRED APPROACH SLABS, CURBS AND GUTTERS, ROADWAY, SIDEWALKS, RAMPS, ANY OTHER INCIDENTAL CONSTRUCTION ITEMS AND FINAL GRADING.
- 15. REMOVE TEMPORARY CONSTRUCTION SIGNING AND TRAFFIC CONTROL DEVICES.

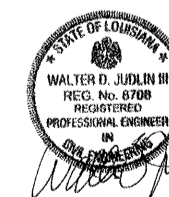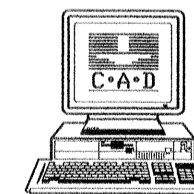


DAW29-00-B-0094

AS BUILT PLANS

DATE RECEIVED 3/15/02
DATE TRACINGS CORRECTED 4/18/02

SYMBOL	DESCRIPTION	DATE	APPROVED
REVISIONS			
U.S. ARMY ENGINEER DISTRICT, NEW ORLEANS CORPS OF ENGINEERS NEW ORLEANS, LOUISIANA			
BOARD OF LEVEE COMMISSIONERS ORLEANS LEVEE BOARD NEW ORLEANS, LOUISIANA		HARTMAN ENGINEERING, INC. CONSULTING ENGINEERS KENNER, LOUISIANA	
LAKE PONTCHARTRAIN, LA. AND VICINITY HIGH LEVEL PLAN ORLEANS AVENUE OUTFALL CANAL PHASE 1B ORLEANS PARISH LOUISIANA			
ROBERT E. LEE BOULEVARD BRIDGE GENERAL NOTES			
DESIGNED BY: W.D.L. DRAWN BY: L.A.C. CHECKED BY: P.J.H.	DATE: MAR. 8, 2000 CADD FILE: SH13.DGN	PLOT SCALE: 1	PLOT DATE: MARCH 8, 2000 FILE NO. H-4-44776
SUBMITTED BY: HARTMAN ENGINEERING DESIGN ENGINEER		SOLICITATION NO. DACW29-00-B-0094 DWG. 3 OF 59	

FILE: D:\SH13.DWG Last edited: AUG. 27, 02 @ 09:10 a.m. Scale: 1:1 R.L.C.

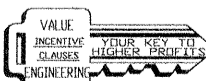

Safety is a Part of Your Contract

103+00

104+00

105+00

106+00

107+00

108+00

109+00

STA. 104+44.36 BFM B/L, 214.36' LT.
=STA. 93+00, OFFSET W B/L, 67.00' LT.

STA. 104+44.30 BFM B/L, 188.87' LT.
=STA. 92+74.51, OFFSET W B/L, 67.00' LT.

STA. 104+74.19 BFM B/L, 148.85' LT.
=STA. 92+34.57, OFFSET W B/L, 37.00' LT.

STA. 104+74.00 BFM B/L, 73.39' LT.
=STA. 91+59.11, OFFSET W B/L, 37.00' LT.

STA. 104+66 BFM B/L, 73.48' LT.

STA. 104+41.19 BFM B/L, 73.52' LT.
=STA. 91+59.16 OFFSET W B/L, 69.81' LT.

STA. 109+57.45 BFM B/L, 200.57' LT.
= STA. 93+00 E B/L, 230.00' RT.

STA. 108+38.55 BFM B/L, 80.46' LT.
STA. 91+76.34 E B/L, 115.00' LT.

STA. 109+53.59 BFM B/L, 79.99' LT.
STA. 91+79.55 E B/L, 230.00' LT.

C/L CONSTRUCTION SITE ACCESS GATE
STA. 108+35.36 BFM B/L,
12.06' LT.

ROBERT E. LEE BOULEVARD
(WESTBOUND LANES)
(ASPHALT)

ROBERT E. LEE BOULEVARD
(EASTBOUND LANES)
(ASPHALT)

ROBERT E. LEE BOULEVARD
(WESTBOUND LANES)
(ASPHALT)

ROBERT E. LEE BOULEVARD
(EASTBOUND LANES)
(ASPHALT)

STA. 104+40.84 BFM B/L, 61.57' RT.
=STA. 90+24.07 W B/L, 97.81' LT.

STA. 104+66 BFM B/L, 43.71' RT.

STA. 104+85.65 BFM B/L, 61.73' RT.
=STA. 90+24.00 W B/L, 53.00' LT.

STA. 104+85.63 BFM B/L, 70.75' RT.
=STA. 90+15.00 W B/L, 53.00' LT.

STA. 90+15 W B/L, 43.24' LT.

STA. 108+33.40 BFM B/L, 80.80' RT.=
STA. 90+15 E B/L, 115.00' RT.


- REFERENCE DRAWINGS
1. FOR GENERAL NOTES, SEE DWG. NO. 3.
 2. FOR PLAN/PROFILE, SEE DWG NO. 5.
 3. FOR DISPOSITION OF UTILITIES, SEE DWG NO'S. 11, 12 & 13.
 4. FOR UTILITY RELOCATION/MODIFICATION TABLE, SEE DWG NO. 13.

PLAN
SCALE: 1" = 20'



NOTES:



1. AREAS USED FOR CONSTRUCTION STAGING SHALL BE RESTORED TO PRE-CONSTRUCTION CONDITIONS, FERTILIZED AND SEEDDED AFTER UTILIZATION IS COMPLETED.

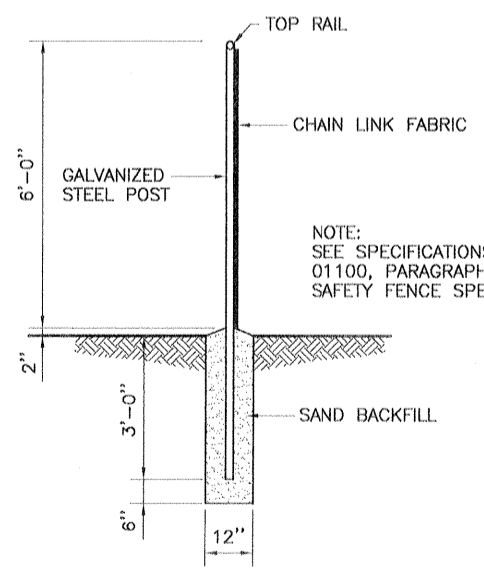

SAFETY FENCE DETAIL
SCALE: 1/2" = 1'-0"


LEGEND

- BASELINE
- LIMITS OF CONSTRUCTION
- CONTRACTOR'S STAGING AREA
- REQ'D. SAFETY FENCE

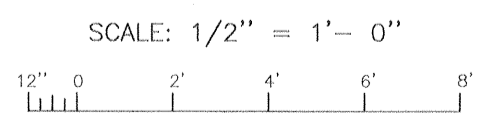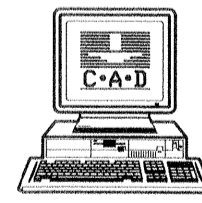


SCALE: 1/2" = 1'-0"

AS BUILT PLANS
DATE RECEIVED 3/15/02
DATE TRACINGS CORRECTED 4/18/02

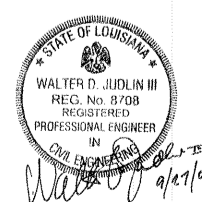

SYMBOL	DESCRIPTION	DATE	APPROVED
REVISIONS			
U.S. ARMY ENGINEER DISTRICT, NEW ORLEANS CORPS OF ENGINEERS NEW ORLEANS, LOUISIANA			
BOARD OF LEVEE COMMISSIONERS ORLEANS LEVEE BOARD NEW ORLEANS, LOUISIANA		HARTMAN ENGINEERING, INC. CONSULTING ENGINEERS KENNER, LOUISIANA	
LAKE PONTCHARTRAIN, LA. AND VICINITY HIGH LEVEL PLAN ORLEANS AVENUE OUTFALL CANAL PHASE 1B ORLEANS PARISH LOUISIANA			
ROBERT E. LEE BOULEVARD BRIDGE LIMITS OF CONSTRUCTION			
DESIGNED BY: M.K.R.	DATE: MAR. 8, 2000	PLOT SCALE: 20	PLOT DATE: MARCH 8, 2000
DRAWN BY: C.R.N.	CHECKED BY: W.D.L.	CADD FILE: SH74.DGN	FILE NO. H-4-44776
SUBMITTED BY: HARTMAN ENGINEERING DESIGN ENGINEER	SOLICITATION NO. DACW29-00-B-0094	DWG. 4 OF 59	

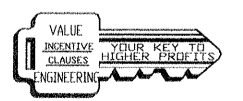

103+00

104+00


105+00

106+00


107+00

108+00


Safety is a Part of Your Contract

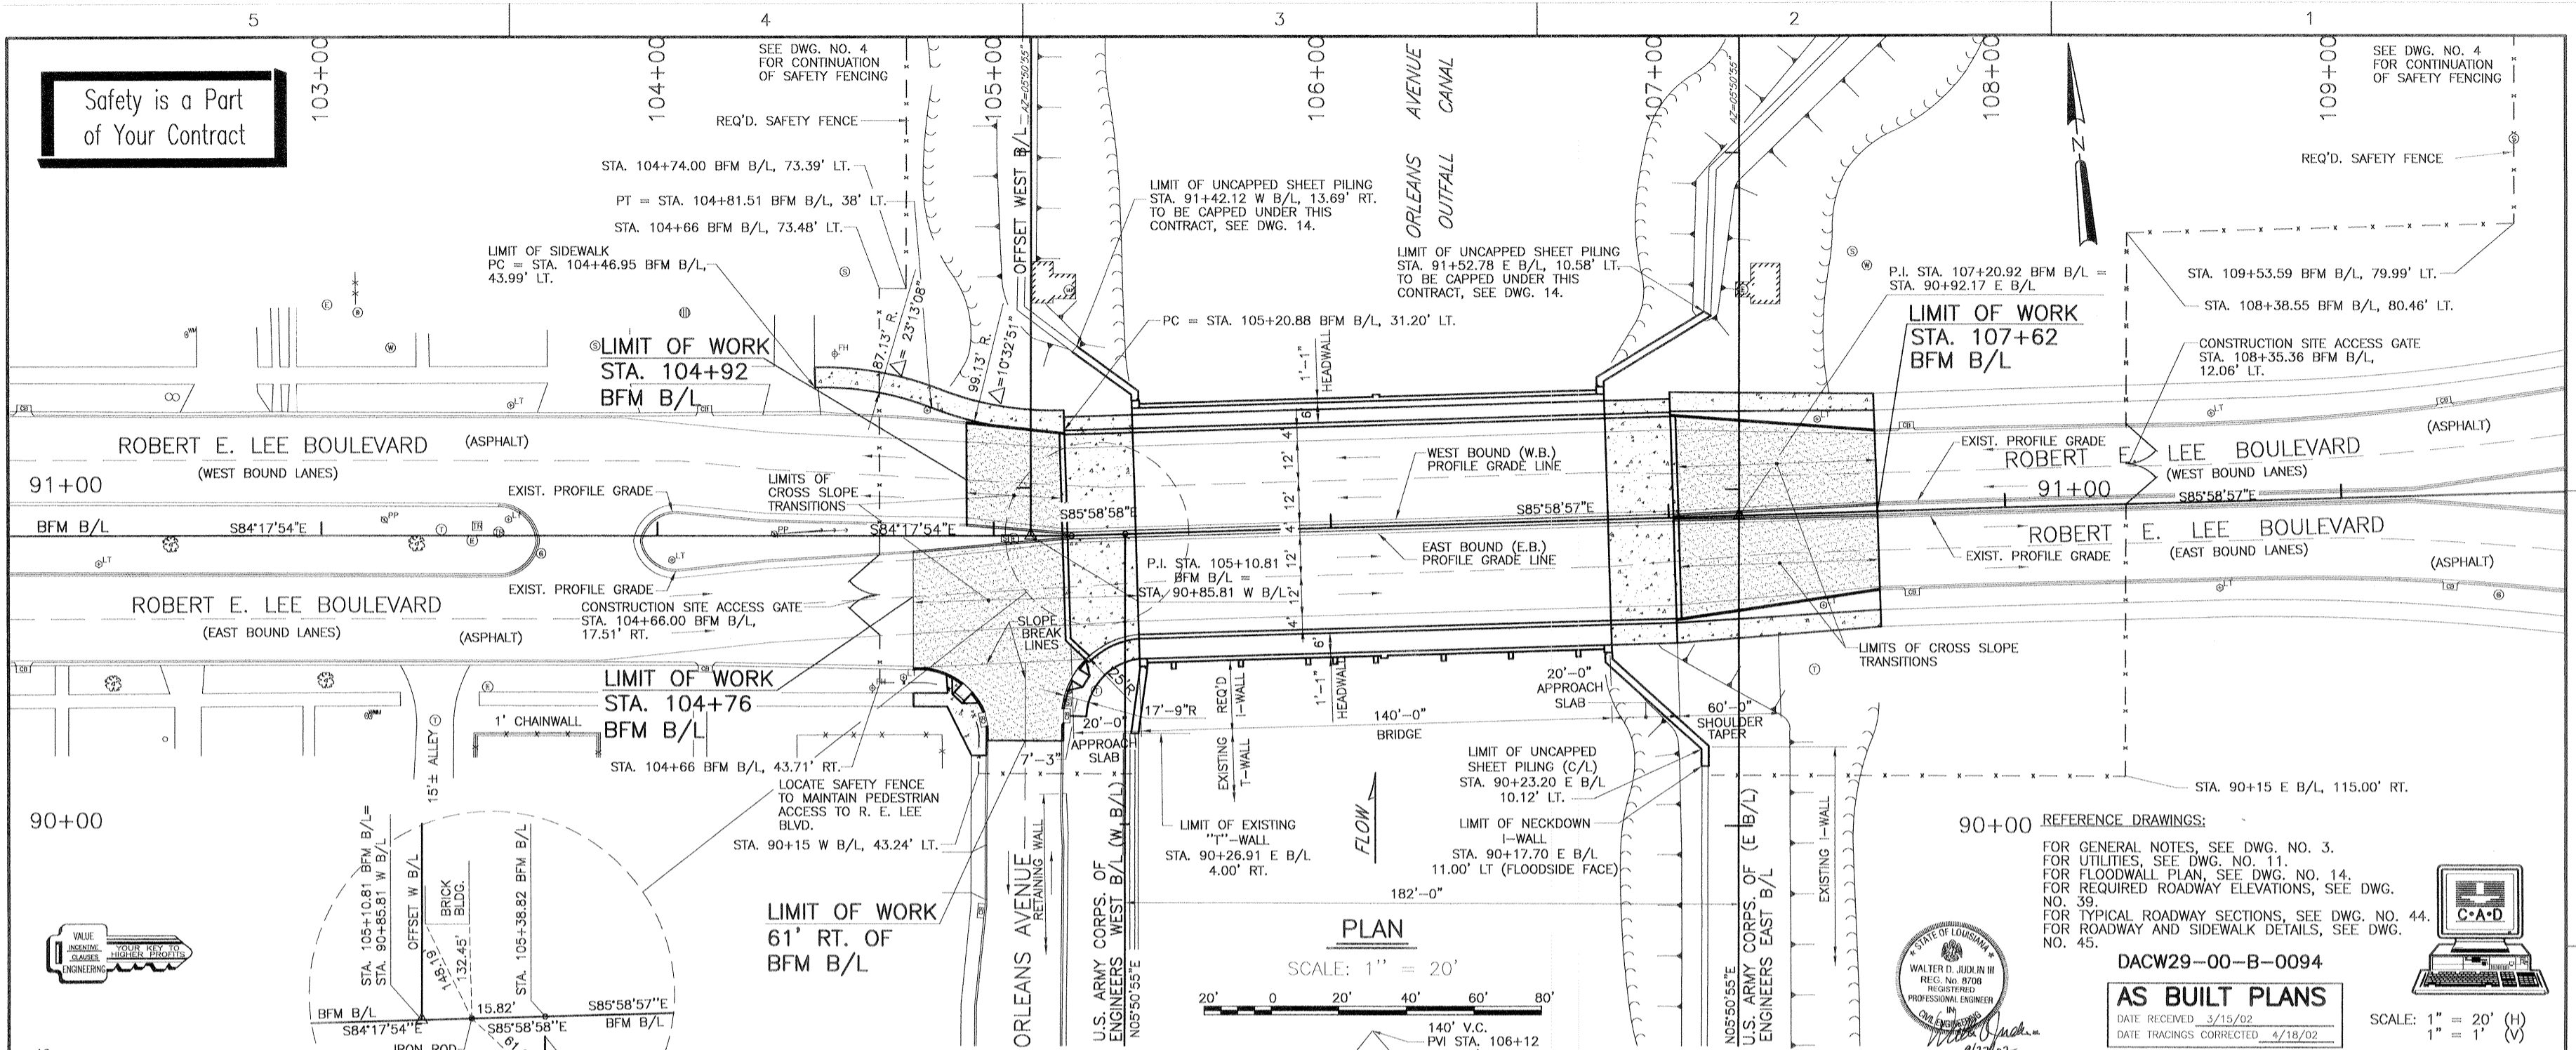

79+00 REFERENCE DRAWINGS:
 FOR GENERAL NOTES, SEE DWG. NO. 3.
 FOR UTILITIES, SEE DWG. NO. 11.
 FOR FLOODWALL PLAN, SEE DWG. NO. 14.
 FOR REQUIRED ROADWAY ELEVATIONS, SEE DWG. NO. 39.
 FOR TYPICAL ROADWAY SECTIONS, SEE DWG. NO. 44.
 FOR ROADWAY AND SIDEWALK DETAILS, SEE DWG. NO. 45.

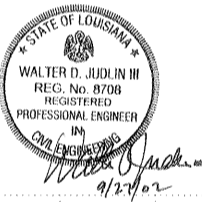

DACW29-00-B-0094
AS BUILT PLANS
 DATE RECEIVED 3/15/02
 DATE TRACINGS CORRECTED 4/18/02

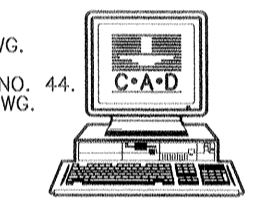



SCALE: 1" = 20' (H)
 1" = 1' (V)



HYDRAULIC DATA

	WATER SURFACE ELEVATION	FLOW RATE	FREQUENCY
NORMAL WATER LEVEL	1.0 N.G.V.D.	0 CFS	-
DESIGN FLOOD	11.90 N.G.V.D.	3250 CFS	300 YR.

VERTICAL CONTROL
 ALL ELEVATIONS ARE IN FEET AND REFER TO NATIONAL GEODETIC VERTICAL DATUM (N.G.V.D.). ELEVATION BENCH IS BM "CHRYSLER RM", EL. 7.11 (1983 EPOCH), LOCATED IN TOP OF CONCRETE SEAWALL IN NORTHWEST CORNER OF LAKESHORE DRIVE BRIDGE OVER ORLEANS AVENUE CANAL.
 PROFILE GRADE LINE (PGL) WITHIN LIMITS OF BRIDGE IS LOCATED ONE (1) FOOT FROM THE FACE OF NEW JERSEY BARRIER AND TWO (2) FEET FROM THE BASELINE AND CENTERLINE OF PROJECT.

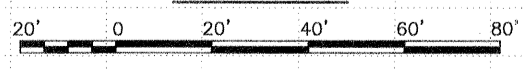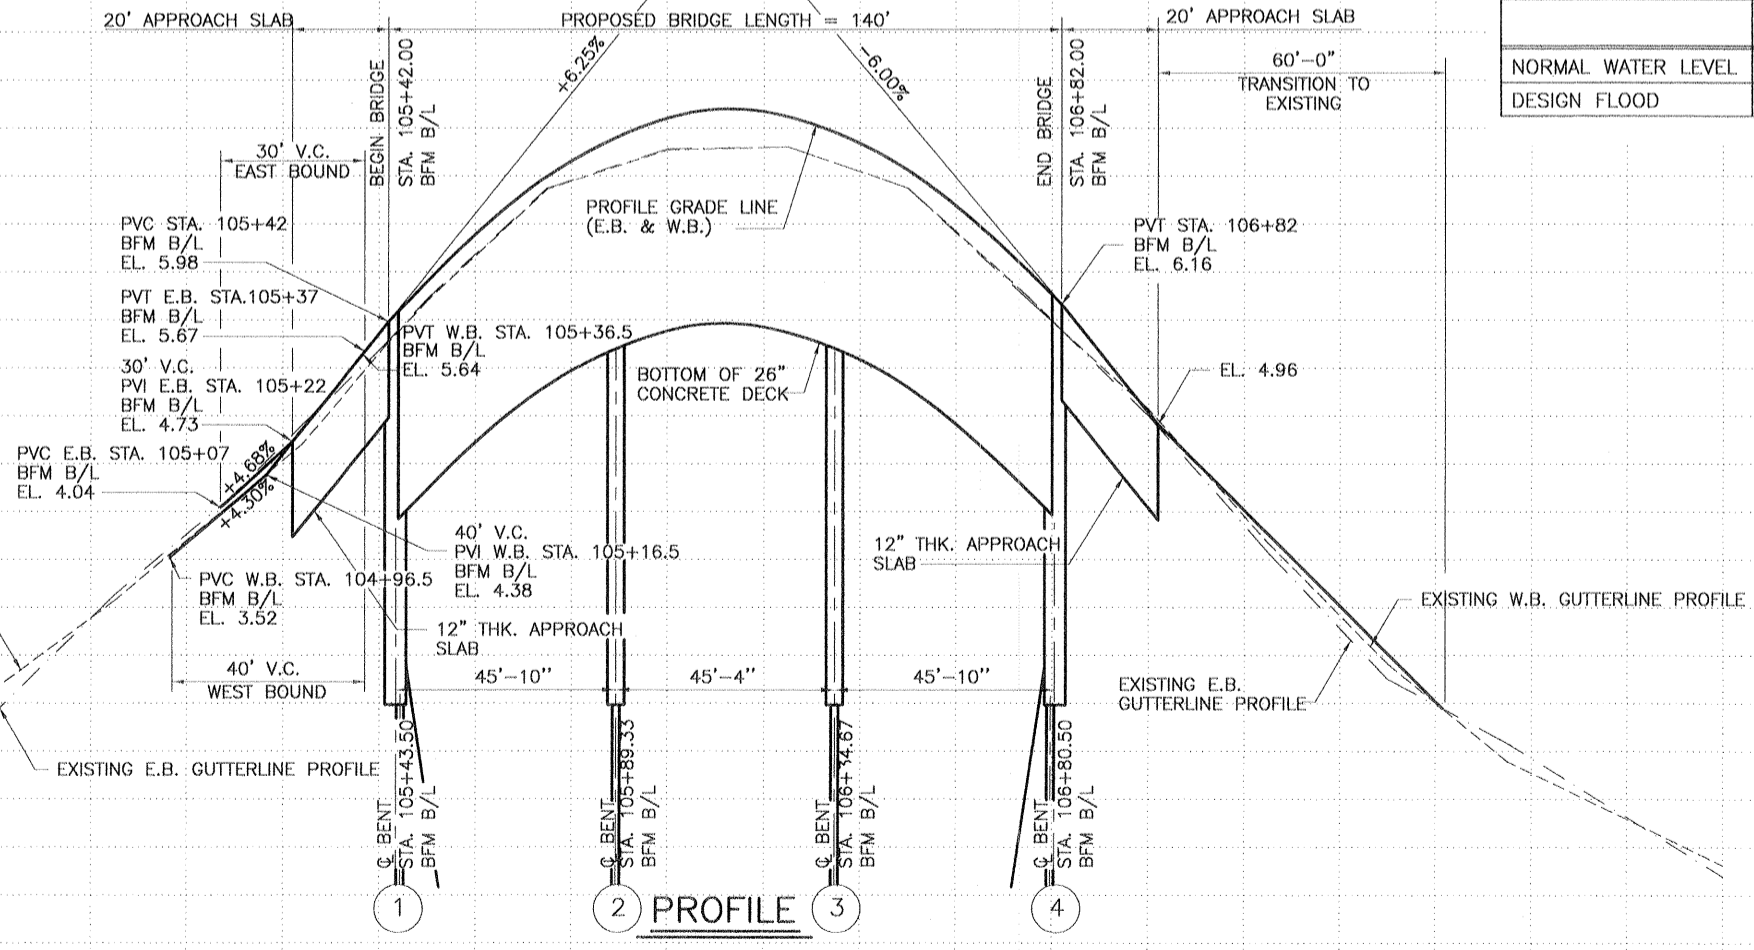

SYMBOL	DESCRIPTION	DATE	APPROVED
REVISIONS U.S. ARMY ENGINEER DISTRICT, NEW ORLEANS CORPS OF ENGINEERS NEW ORLEANS, LOUISIANA			
BOARD OF LEVEE COMMISSIONERS ORLEANS LEVEE BOARD NEW ORLEANS, LOUISIANA		HARTMAN ENGINEERING, INC. CONSULTING ENGINEERS KENNER, LOUISIANA	
LAKE PONTCHARTRAIN, LA. AND VICINITY HIGH LEVEL PLAN ORLEANS AVENUE OUTFALL CANAL PHASE 1B ORLEANS PARISH LOUISIANA			
ROBERT E. LEE BOULEVARD BRIDGE BRIDGE PLAN - PROFILE			
DESIGNED BY: W.D.L.	DATE: MAR. 8, 2000	PLOT SCALE: 20	PLOT DATE: MARCH 8, 2000
DRAWN BY: L.A.C.	CHECKED BY: P.J.H.	CAD FILE: SHTS5.DGN	FILE NO. H-4-44776
SUBMITTED BY: HARTMAN ENGINEERING	SOLICITATION NO. DACW29-00-B-0094	DWG. 5 OF 59	

Safety is a Part
of Your Contract

TRAFFIC CONTROL NOTES

- THE DESIGN AND APPLICATION OF ALL SIGNALS, PAVEMENT MARKINGS, CHANNELIZING DEVICES, AND WARNING SIGNS SHALL CONFORM TO "MANUAL ON UNIFORM TRAFFIC CONTROL DEVICES", 1988 EDITION AS REVISED.
- CHANNELIZING AND DELINEATION DEVICES SHALL BE USED TO MARK ALL CONSTRUCTION AREAS. THESE SHALL BE TYPE III BARRICADES, AND/OR BARRELS, ALL FULLY REFLECTORIZED WITH FLASHING LIGHTS.
- ANY EXISTING TRAFFIC CONTROL DEVICE THAT IS NOT REQUIRED SHALL IMMEDIATELY BE REMOVED, COVERED AND/OR RELOCATED.
- SIGNS, BARRELS, BARRICADES, STRIPING, BARRIERS AND ALL OTHER TRAFFIC CONTROL DEVICES SHOWN ON THESE DRAWINGS ARE REQUIRED FOR CONSTRUCTION OF THE PROJECT AND SHALL BE PROVIDED AND MAINTAINED BY THE CONTRACTOR.
- ALL CONSTRUCTION MATERIAL AND EQUIPMENT SHALL BE STORED OUTSIDE OF THE ROADWAY SURFACE, CREATING NO SIGHT DISTANCE PROBLEMS, AND FULLY DELINEATED AS IN NOTE 2.
- YELLOW, HIGH VISIBILITY PENNANT BARRIER FLAGGING (NYLON ROPE WITH PLASTIC PENNANTS) SHALL BE STRUNG BETWEEN TYPE II BARRICADES AND BARRELS/DRUMS. YELLOW PENNANT FLAGGING SHALL BE USED ONLY WHERE PEDESTRIAN ACTIVITY IS TO BE PROHIBITED. THIS MATERIAL SHALL NOT BE USED OR PLACED NEAR VEHICULAR TRAFFIC LANES OR USED TO WARN OR DIRECT VEHICULAR TRAFFIC.
- THIS TRAFFIC CONTROL DEVICE PLAN INDICATES GENERAL TRAFFIC CONTROL DEVICES TO BE USED ON THIS PROJECT. IT IS ANTICIPATED THAT CONDITIONS WILL VARY DEPENDING ON THE PHASE UNDER CONSTRUCTION AND THAT THE ARRANGEMENT OF THOSE DEVICES WILL BE REVIEWED ON A DAY TO DAY BASIS.
- THE CONTRACTOR SHALL MAINTAIN ACCESS TO FIRE STATION.
- ALL EXCAVATION SHALL BE COVERED, BACKFILLED, OR PROTECTED AND FULLY DELINEATED (SEE NOTE 2) AT NIGHT AND WHEN WORK IS NOT IN PROGRESS. EXCAVATION PITS, ETC. SHALL BE FULLY FENCED OR BARRICADED (SEE NOTE 2) TO PREVENT ACCESS BY PEDESTRIANS.
- ALL TRAFFIC SIGNS SHALL BE STAKED OUT BY THE CONTRACTOR IN ACCORDANCE WITH THE TRAFFIC CONTROL PLAN AND APPROVED BY THE CONTRACTING OFFICER PRIOR TO INSTALLATION.
- THE CONTRACTOR SHALL NOTIFY THE FOLLOWING AGENCIES BY CERTIFIED MAIL AT LEAST 14 WORKING DAYS PRIOR TO CLOSING ROBERT E. LEE BLVD. BRIDGE: COPIES OF THESE NOTIFICATIONS ARE TO BE PROVIDED TO CONTRACTING OFFICER AT THAT TIME.
 - NEW ORLEANS DEPT. OF STREETS, TRAFFIC ADMINISTRATION DIVISION: 565-6840 (ELMER DARWIN)
 - ORLEANS PARISH SCHOOL BOARD: 286-2700
 - NEW ORLEANS POLICE DEPARTMENT: 821-2222
 - NEW ORLEANS FIRE DEPARTMENT: 565-7800
 - ENTERGY: 593-3460 (NORMAN SILES)
 - U.S. ARMY CORPS OF ENGINEERS: 862-1200 (ADMINISTRATIVE CONTRACTING OFFICER)
 - ORLEANS LEVEE DISTRICT: 243-4045 (STEPHEN G. SPENCER)
- DETOUR ROUTES MUST BE ADVERTISED IN THE TIMES-PICTAYUNE AS A "PUBLIC NOTICE" AT LEAST ONE (1) WEEK PRIOR TO BRIDGE CLOSURE. THE ADVERTISEMENT MUST BE A MINIMUM OF TWO COLUMNS BY TWO INCHES.



M4-9L(1) *



M4-9L(4) *



M4-9R(1) *



M4-8A *



M4-9S *



M4-9R(2) *



M4-9L(2) *



M4-9L(3) *



M4-9R(3) *

* "R.E. LEE" PORTION OF SIGN MAY BE ON SEPARATE PLATE, MOUNTED ABOVE M4-9 SIGN

MINIMUM SIGN SIZES


- M SERIES - 30"x 30"
- * W SERIES - 36"x 36"
- R3-1 - 24"x 24"
- R3-2 - 24"x 24"
- R11-2 - 48"x 30"
- R11-4 - 60"x 60"
- S-1 - 36"x 24"
- S-2 - 48"x 24"
- * AUXILIARY STREET NAME - 30"x 8"



W20-3(1)



W20-3(2)

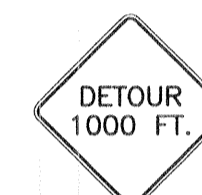


(R.E. LEE BLVD.)

W20-2(1)



(R.E. LEE BLVD.)

W20-2(2)

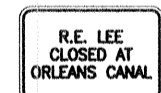

S-1



R3-2



R3-1



R11-4



R11-2




S-2

REFERENCE DRAWINGS


- FOR GENERAL NOTES, SEE DWG NO. 3.
- FOR PLAN/PROFILE, SEE DWG. NO. 5.
- FOR TRAFFIC CONTROL DEVICES PLAN AND NOTES, SEE DWG. NO. 7.
- FOR HIGHWAY SIGN AND BARRICADES DETAILS, SEE DWG. NOS. 57, 58 AND 59.

TRAFFIC CONTROL SIGNS

SCALE: 1/2" = 1'-0"

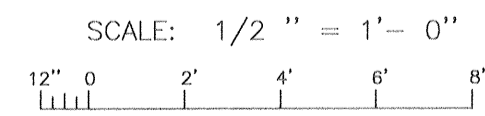


SCALE: 1/2" = 1'-0"

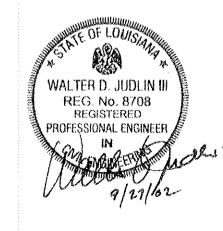


DACW29-00-B-0094



AS BUILT PLANS
DATE RECEIVED 3/15/02
DATE TRACINGS CORRECTED 4/18/02

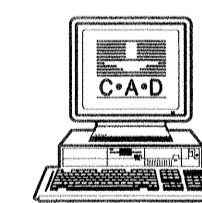

SYMBOL	DESCRIPTION	DATE	APPROVED
REVISIONS			
U.S. ARMY ENGINEER DISTRICT, NEW ORLEANS CORPS OF ENGINEERS NEW ORLEANS, LOUISIANA			
BOARD OF LEVEE COMMISSIONERS ORLEANS LEVEE BOARD NEW ORLEANS, LOUISIANA		HARTMAN ENGINEERING, INC. CONSULTING ENGINEERS KENNER, LOUISIANA	
LAKE PONTCHARTRAIN, LA. AND VICINITY HIGH LEVEL PLAN ORLEANS AVENUE OUTFALL CANAL PHASE 1B ORLEANS PARISH LOUISIANA			
ROBERT E. LEE BOULEVARD BRIDGE TRAFFIC CONTROL NOTES			
DESIGNED BY: R.R.C.	DATE: MAR. 8, 2000	PLOT SCALE: 1	PLOT DATE: MARCH 8, 2000
DRAWN BY: L.A.C.	CADD FILE: SHT6.DGN	FILE NO. H-4-44776	
CHECKED BY: W.D.L.	SUBMITTED BY: HARTMAN ENGINEERING DESIGN ENGINEER		
SOLICITATION NO. DACW29-00-B-0094		DWG. 6 OF 59	

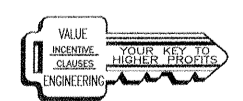

Safety is a Part of Your Contract

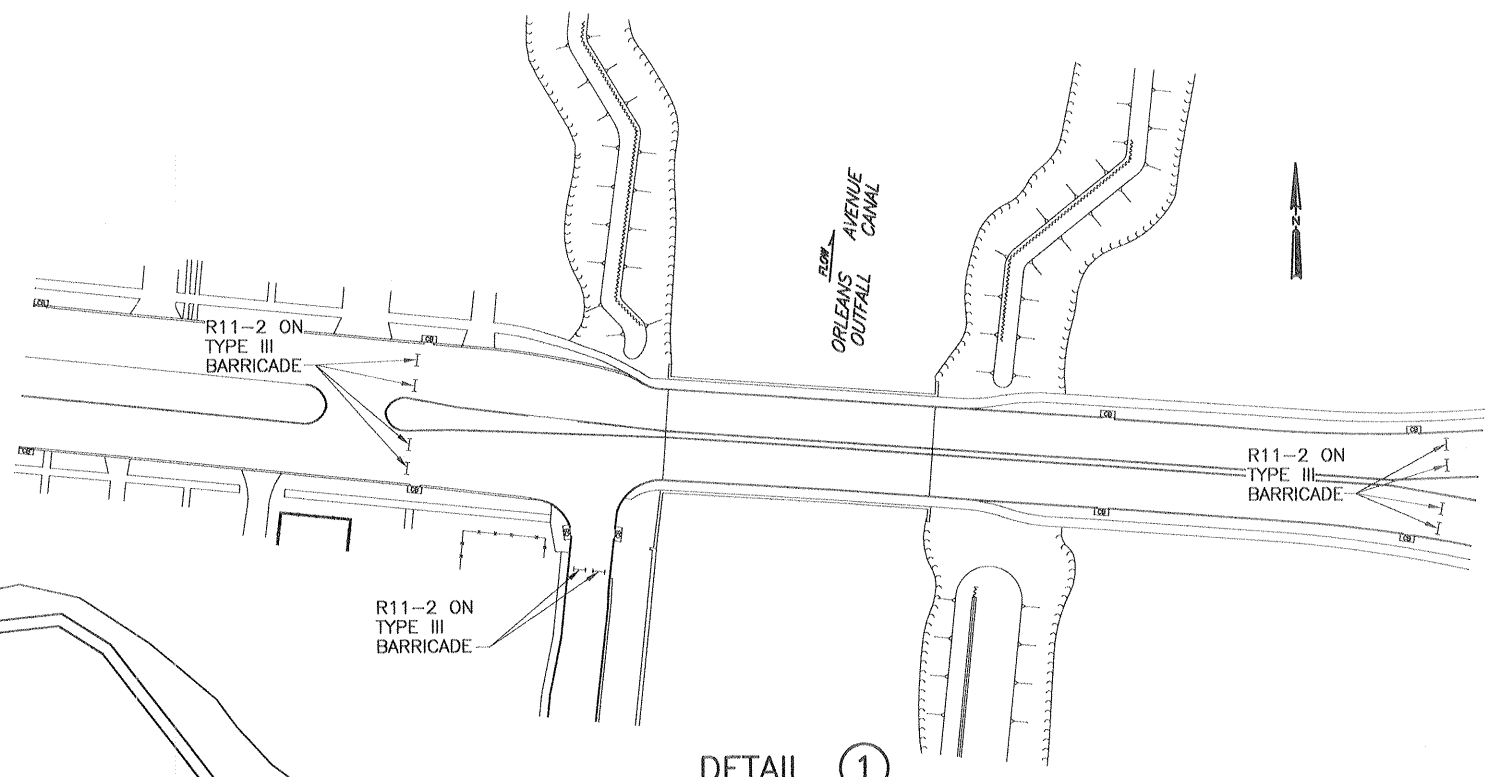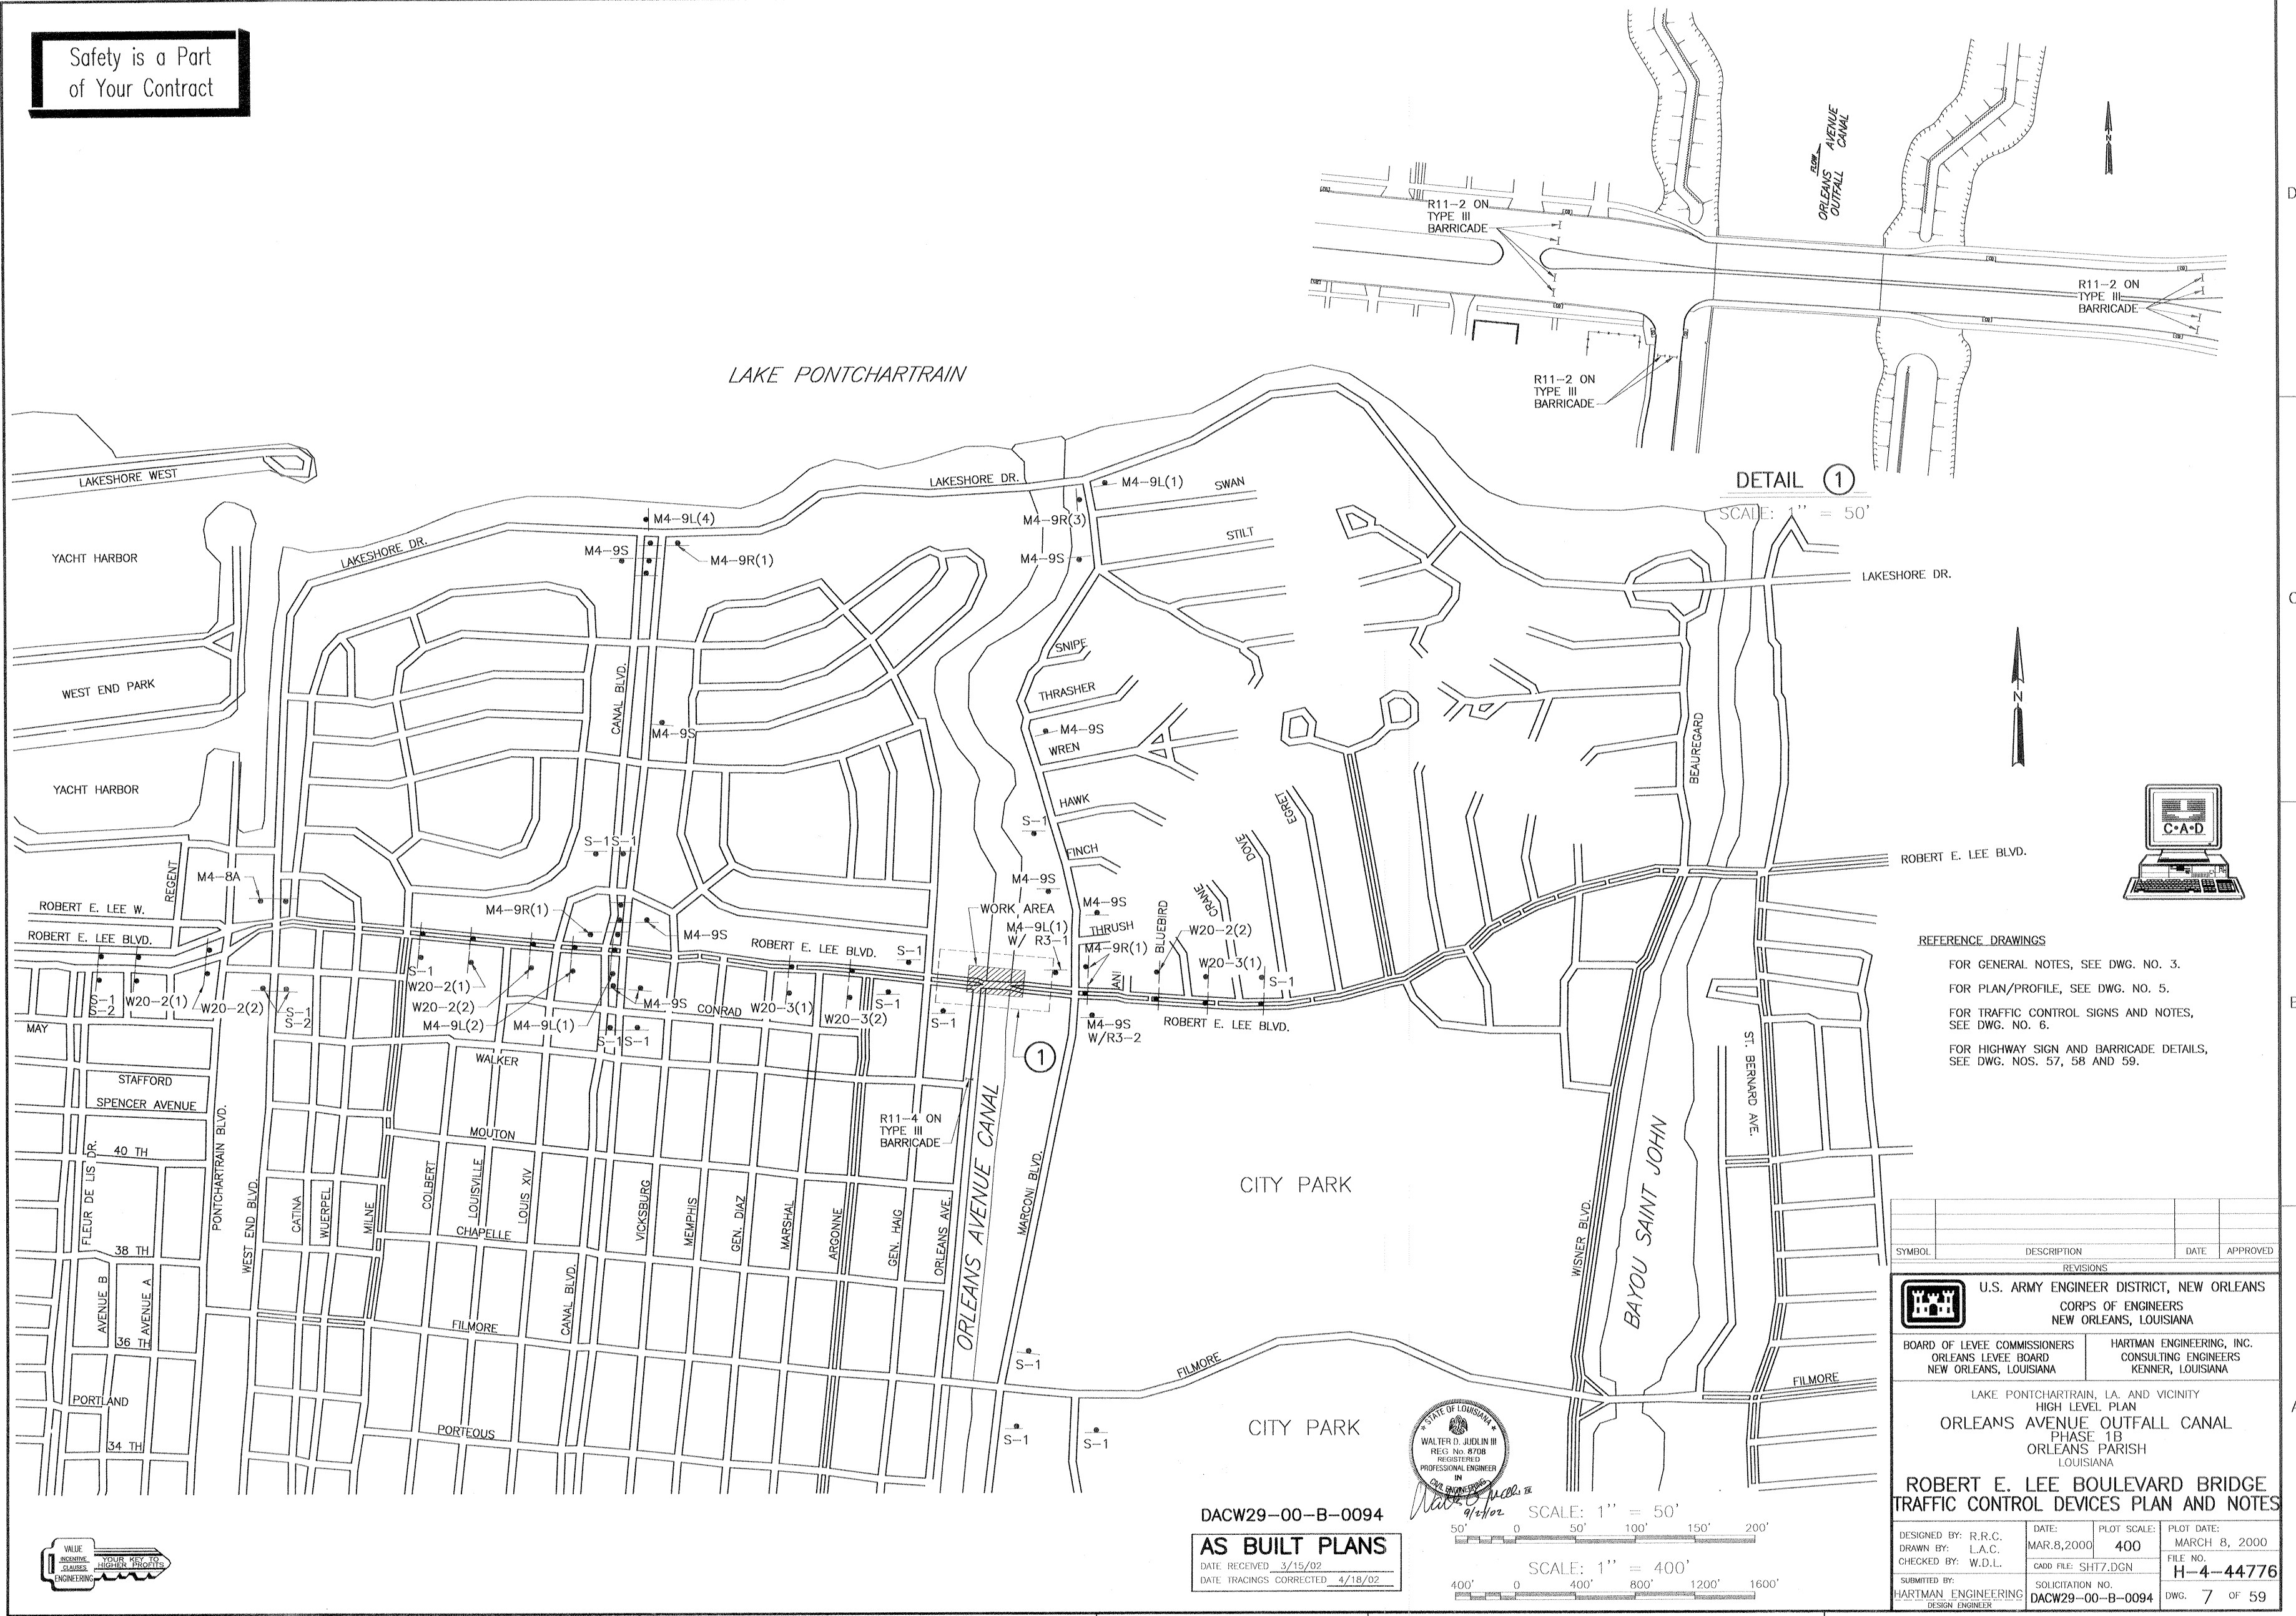

DETAIL 1
SCALE: 1" = 50'

- REFERENCE DRAWINGS
- FOR GENERAL NOTES, SEE DWG. NO. 3.
 - FOR PLAN/PROFILE, SEE DWG. NO. 5.
 - FOR TRAFFIC CONTROL SIGNS AND NOTES, SEE DWG. NO. 6.
 - FOR HIGHWAY SIGN AND BARRICADE DETAILS, SEE DWG. NOS. 57, 58 AND 59.



SYMBOL	DESCRIPTION	DATE	APPROVED
REVISIONS			

U.S. ARMY ENGINEER DISTRICT, NEW ORLEANS
CORPS OF ENGINEERS
NEW ORLEANS, LOUISIANA

BOARD OF LEVEE COMMISSIONERS
ORLEANS LEVEE BOARD
NEW ORLEANS, LOUISIANA

HARTMAN ENGINEERING, INC.
CONSULTING ENGINEERS
KENNER, LOUISIANA



LAKE PONTCHARTRAIN, LA. AND VICINITY
HIGH LEVEL PLAN
ORLEANS AVENUE OUTFALL CANAL
PHASE 1B
ORLEANS PARISH
LOUISIANA

**ROBERT E. LEE BOULEVARD BRIDGE
TRAFFIC CONTROL DEVICES PLAN AND NOTES**


DESIGNED BY: R.R.C.	DATE: MAR. 8, 2000	PLOT SCALE: 400	PLOT DATE: MARCH 8, 2000
DRAWN BY: L.A.C.	CADD FILE: SHT7.DGN	FILE NO. H-4-44776	
CHECKED BY: W.D.L.	SUBMITTED BY: HARTMAN ENGINEERING	SOLICITATION NO. DACW29-00-B-0094	DWG. 7 OF 59




DACW29-00-B-0094
AS BUILT PLANS
DATE RECEIVED: 3/15/02
DATE TRACINGS CORRECTED: 4/18/02

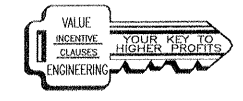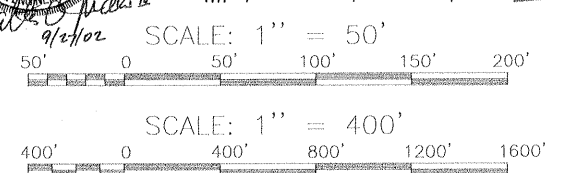


Safety is a Part of Your Contract

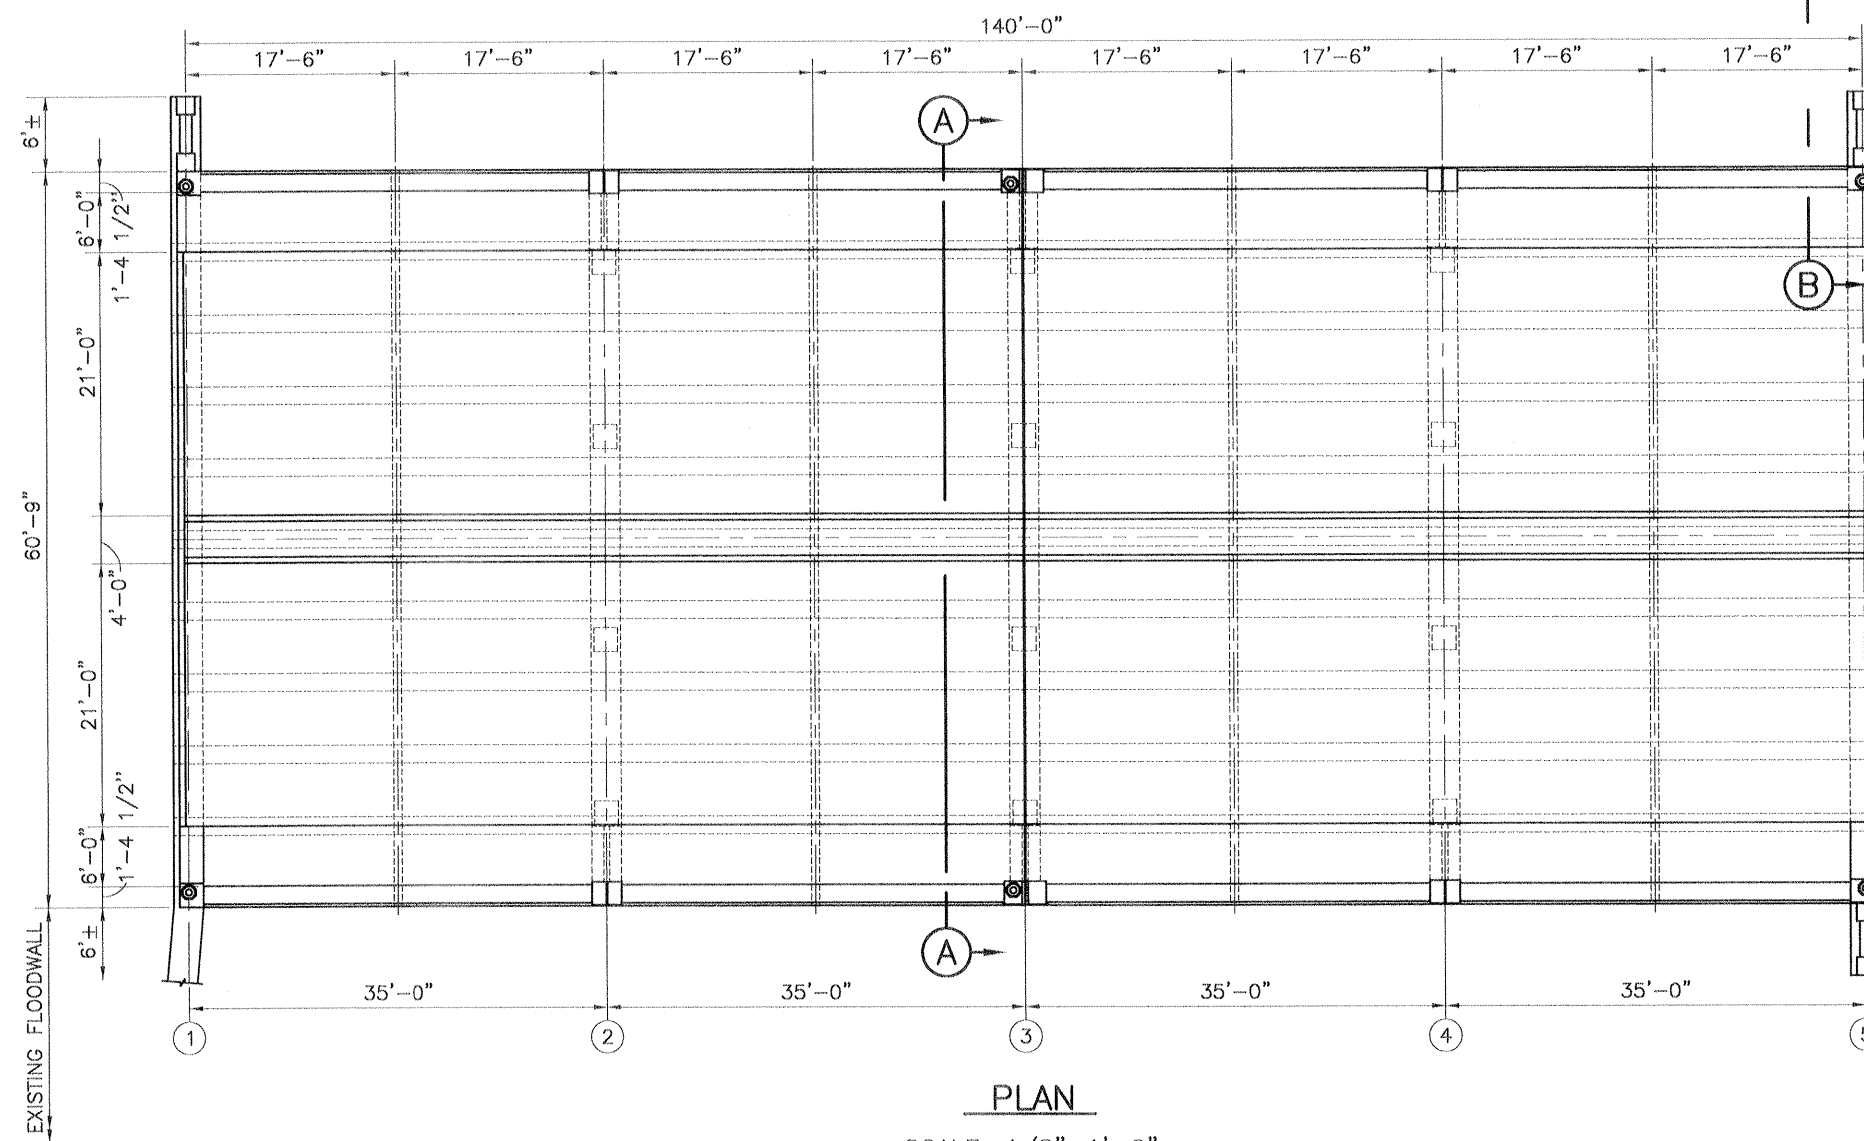

PLAN
SCALE: 1/8"=1'-0"

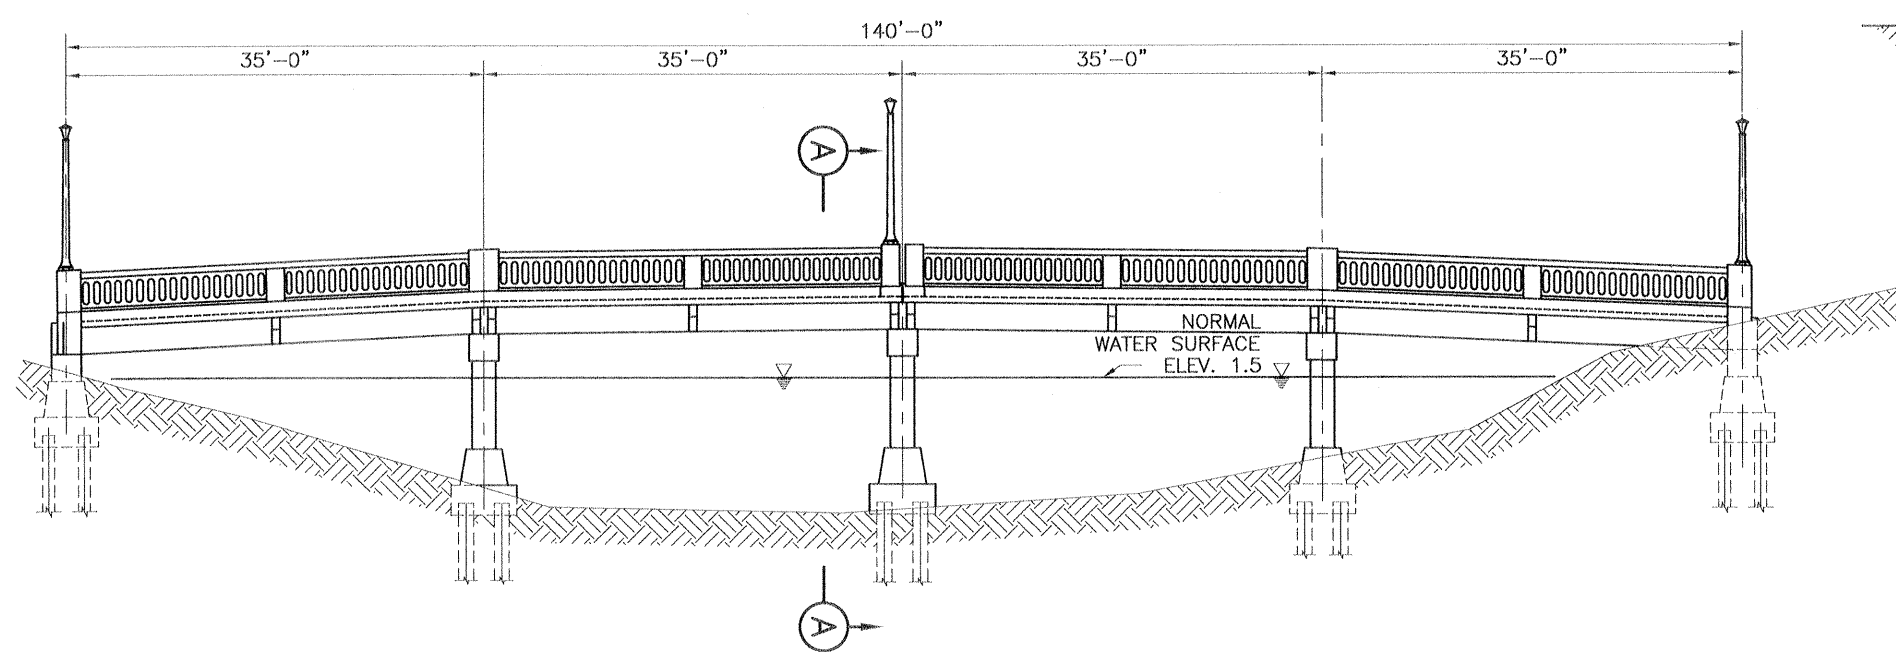


ELEVATION
SCALE: 1/8"=1'-0"

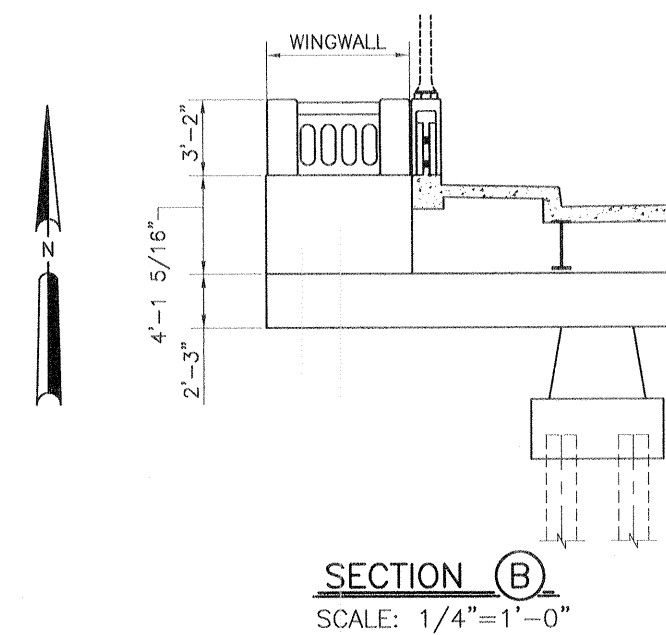

SECTION B
SCALE: 1/4"=1'-0"

PLAN OF EXISTING FOOTING
SCALE: 1/4"=1'-0"



NOTE:
BENTS 2-3-4 (64 FT. ROUND UNTREATED TIMBER PILES.)
BENTS 1-5 (35 FT. ROUND UNTREATED TIMBER PILES.)

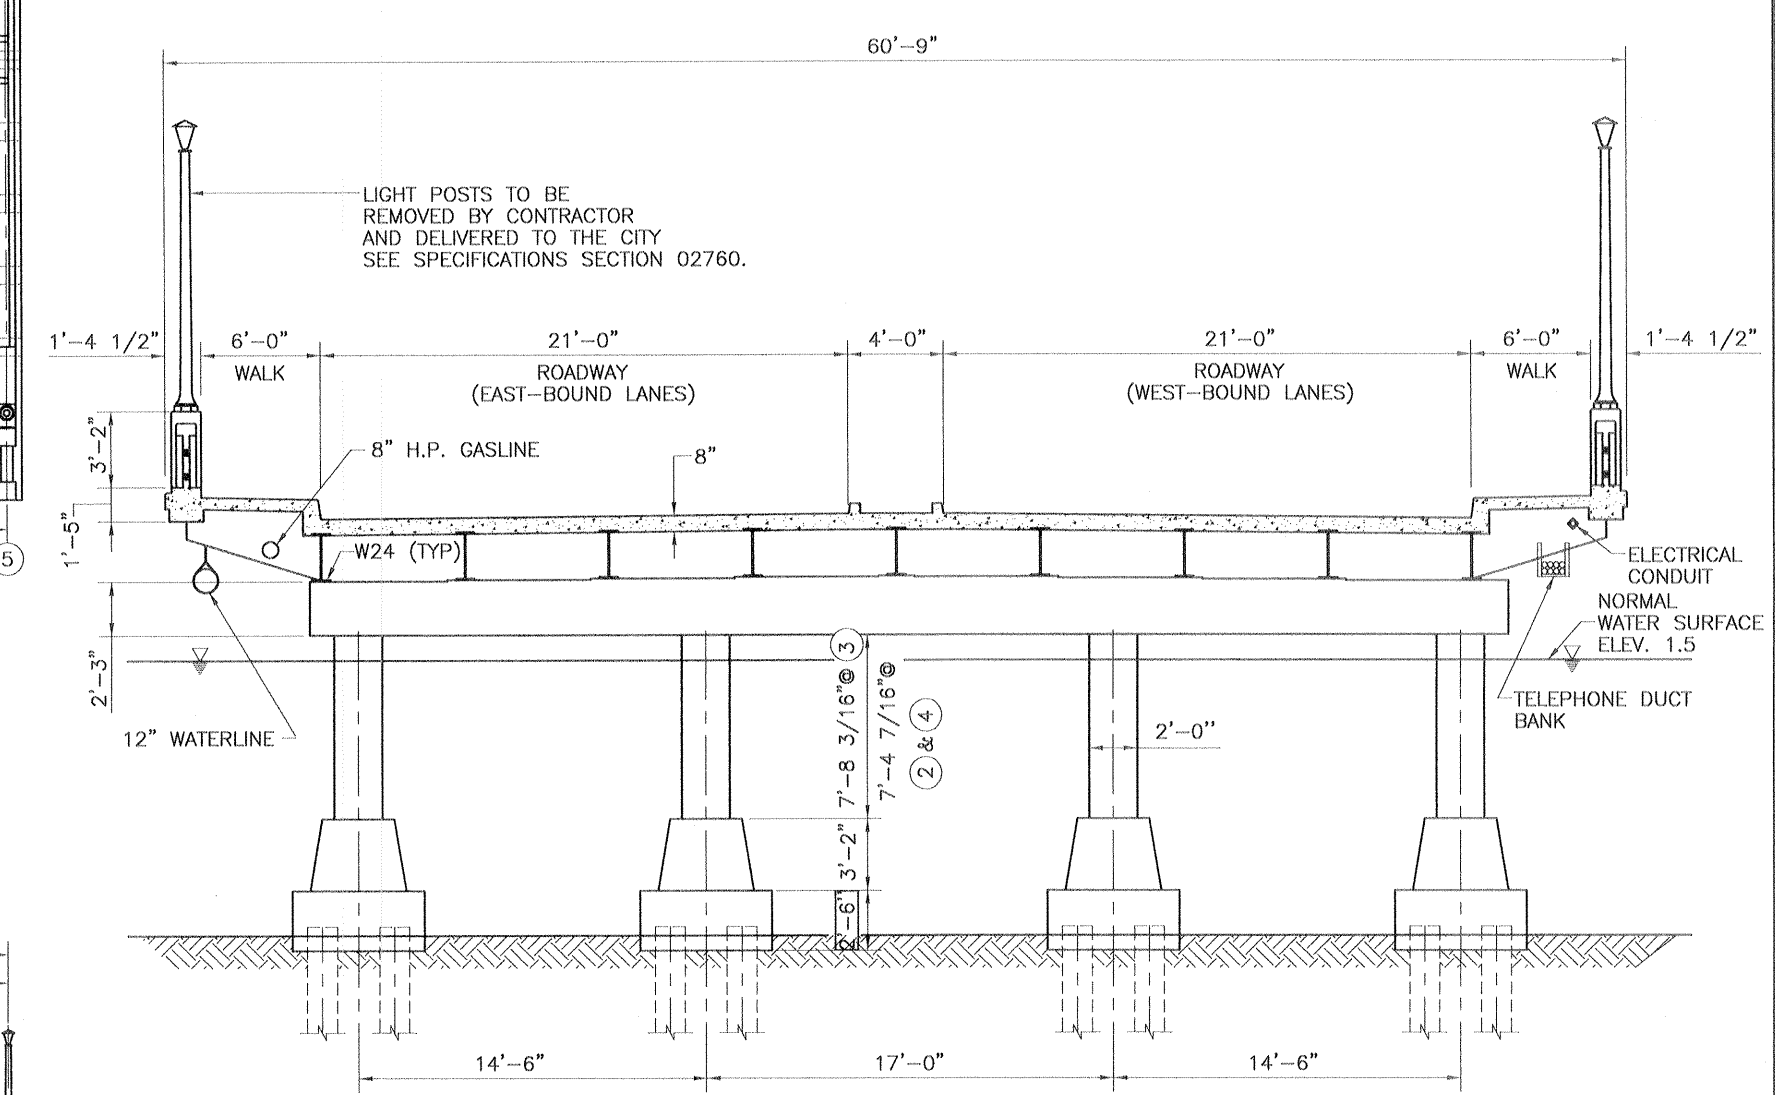

SECTION A
SCALE: 1/4"=1'-0"


- REFERENCE DRAWINGS
- FOR GENERAL NOTES, SEE DWG. NO. 3.
 - FOR DEMOLITION PLAN, SEE DWG. NO. 9.
 - FOR UTILITY PLAN, SEE DWG. NO. 11.
 - FOR EXISTING I-WALL, SEE DWG. NO. 20.

DEMOLITION NOTE
DEMOLITION OF EXISTING BRIDGE INCLUDES REMOVAL OF BRIDGE SUPERSTRUCTURE AND SUBSTRUCTURE. THIS INCLUDES REMOVAL OF ALL EXISTING FOOTINGS. THE PILING BENEATH FOOTINGS THAT ARE NOT IN CONFLICT WITH NEW BRIDGE CAN REMAIN.

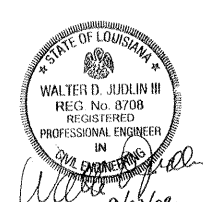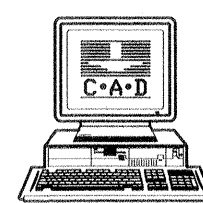


AS BUILT PLANS
DATE RECEIVED 3/15/02
DATE TRACINGS CORRECTED 4/18/02

SYMBOL	DESCRIPTION	DATE	APPROVED
REVISIONS			
U.S. ARMY ENGINEER DISTRICT, NEW ORLEANS CORPS OF ENGINEERS NEW ORLEANS, LOUISIANA			
BOARD OF LEVEE COMMISSIONERS ORLEANS LEVEE BOARD NEW ORLEANS, LOUISIANA		HARTMAN ENGINEERING, INC. CONSULTING ENGINEERS KENNER, LOUISIANA	
LAKE PONCHATRTRAIN, LA. AND VICINITY HIGH LEVEL PLAN ORLEANS AVENUE OUTFALL CANAL PHASE 1B ORLEANS PARISH LOUISIANA			
ROBERT E. LEE BOULEVARD BRIDGE EXISTING BRIDGE			
DESIGNED BY: W.D.L.	DATE: MAR. 8, 2000	PLOT SCALE: 96	PLOT DATE: MARCH 8, 2000
DRAWN BY: L.A.C.	CADD FILE: SHTB.DGN		FILE NO. H-4-44776
CHECKED BY: P.J.H.			
SUBMITTED BY: HARTMAN ENGINEERING DESIGN ENGINEER	SOLICITATION NO. DACW29-00-B-0094		DWG. 8 OF 59

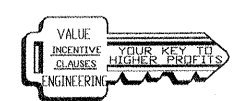

Safety is a Part of Your Contract

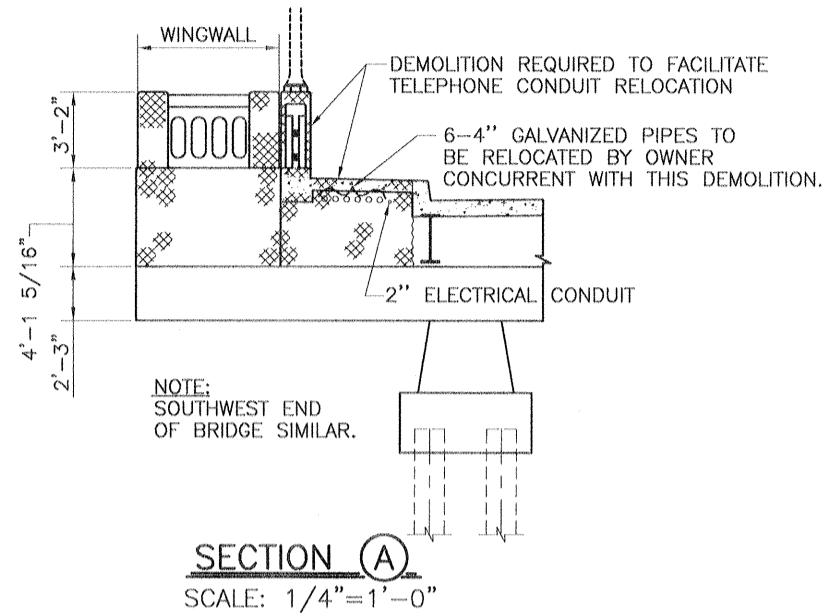

ROBERT E. LEE BOULEVARD (WESTBOUND LANES) (ASPHALT)

ROBERT E. LEE BOULEVARD (EASTBOUND LANES) (ASPHALT)


DEMOLITION REQUIREMENTS

- SEE DWG. 3 FOR SEQUENCE OF DEMOLITION.
- SEE UTILITY RELOCATION PLAN FOR DISPOSITION OF EXISTING UTILITIES. THE CONTRACTOR IS REQUIRED TO PERFORM DEMOLITION IN A SEQUENCE THAT FACILITATES RELOCATION OF THE GAS LINE AND TELEPHONE CONDUITS. THIS INCLUDES REMOVING EXISTING PAVING FOR THE TEMPORARY GAS LINE AND REMOVING THE EXISTING I-WALL AND SECTIONS OF THE EXISTING BRIDGE FOR THE TELEPHONE CONDUIT RELOCATION.
- THE OWNERS OF THE GAS AND TELEPHONE UTILITIES WILL USE CRANES TO RELOCATE THEIR UTILITIES TO THE TEMPORARY SUPPORTS. THE BRIDGE DEMOLITION MUST BE PHASED TO FACILITATE ACCESS ONTO THE BRIDGE FOR THE RELOCATIONS.
- REMOVE EXISTING BRIDGE SUPERSTRUCTURE AND SUBSTRUCTURE. PULL EXISTING BRIDGE PILING IN CONFLICT WITH NEW BRIDGE PILING.
- SAWCUT AND REMOVE EXISTING ROADWAY AND SIDEWALKS WITHIN THE LIMITS SHOWN ON THIS SHEET.
- REMOVE EXISTING PAVEMENT WITHIN LIMITS SHOWN.
- BRIDGE SUPERSTRUCTURE AND SUBSTRUCTURE, BRIDGE PILING, ROADWAY, CONCRETE WALL, ABANDONED UTILITIES AND SHEET PILING DEMOLISHED AS A PART OF THIS PROJECT SHALL BECOME THE PROPERTY OF THE CONTRACTOR.
- AN ABANDONED METAL PIPE LOCATED BENEATH THE NORTHWEST CORNER OF THE BRIDGE SHALL BE REMOVED AND DISPOSED OF BY THE CONTRACTOR TO THE EXTENT IT DOES NOT INTERFERE WITH EXCAVATION FOR THE NEW ABUTMENT AND FINAL GRADING FOR THE RIPRAP.
- A LARGE BLOCK OF CONCRETE LOCATED AT THE SOUTHWEST CORNER OF THE BRIDGE SHALL BE REMOVED AND DISPOSED OF BY THE CONTRACTOR.
- THE CONTRACTOR SHALL CUT, REMOVE AND DISPOSE OF ABANDONED CABLES LOCATED SOUTH OF THE BRIDGE, AS NECESSARY TO CONSTRUCT THE NEW BRIDGE AND FLOODWALLS.

EQUATION:
STA. 105+10.81
BFM B/L =
STA. 90+85.81
OFFSET W B/L

PLAN



SCALE: 1" = 20'

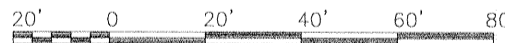

LEGEND
CURB, PAVEMENT AND SIDEWALK REMOVAL

REFERENCE DRAWINGS






- FOR GENERAL NOTES, SEE DWG. NO. 3.
- FOR PLAN/PROFILE, SEE DWG. NO. 5.
- FOR EXISTING BRIDGE, SEE DWG. NO. 8.
- FOR DISPOSITION OF UTILITIES, SEE DWG. NO'S. 11, 12 & 13.
- FOR TYPICAL ROADWAY SECTIONS, SEE DWG. NO. 44.
- FOR LOG OF CORINGS B-1 THRU B-4, SEE DWG. NO. 52.

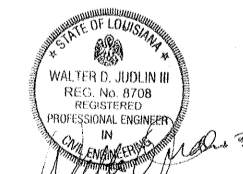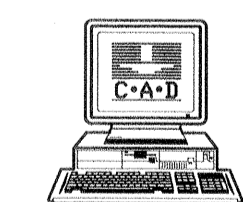

DACW29-00-B-0094
AS BUILT PLANS
DATE RECEIVED 3/15/02
DATE TRACINGS CORRECTED 4/18/02


SYMBOL	DESCRIPTION	DATE	APPROVED
REVISIONS			
U.S. ARMY ENGINEER DISTRICT, NEW ORLEANS CORPS OF ENGINEERS NEW ORLEANS, LOUISIANA			
BOARD OF LEVEE COMMISSIONERS ORLEANS LEVEE BOARD NEW ORLEANS, LOUISIANA		HARTMAN ENGINEERING, INC. CONSULTING ENGINEERS KENNER, LOUISIANA	
LAKE PONTCHARTRAIN, LA. AND VICINITY HIGH LEVEL PLAN ORLEANS AVENUE OUTFALL CANAL PHASE 1B ORLEANS PARISH LOUISIANA			
ROBERT E. LEE BOULEVARD BRIDGE DEMOLITION PLAN			
DESIGNED BY: W.D.L.	DATE: MAR. 8, 2000	PLOT SCALE: 20	PLOT DATE: MARCH 8, 2000
DRAWN BY: L.A.C.	CADD FILE: SH19.DGN	FILE NO. H-4-44776	
CHECKED BY: P.J.H.	SUBMITTED BY: HARTMAN ENGINEERING	DESIGN ENGINEER: DACW29-00-B-0094	DWG. 9 OF 59

Safety is a Part of Your Contract

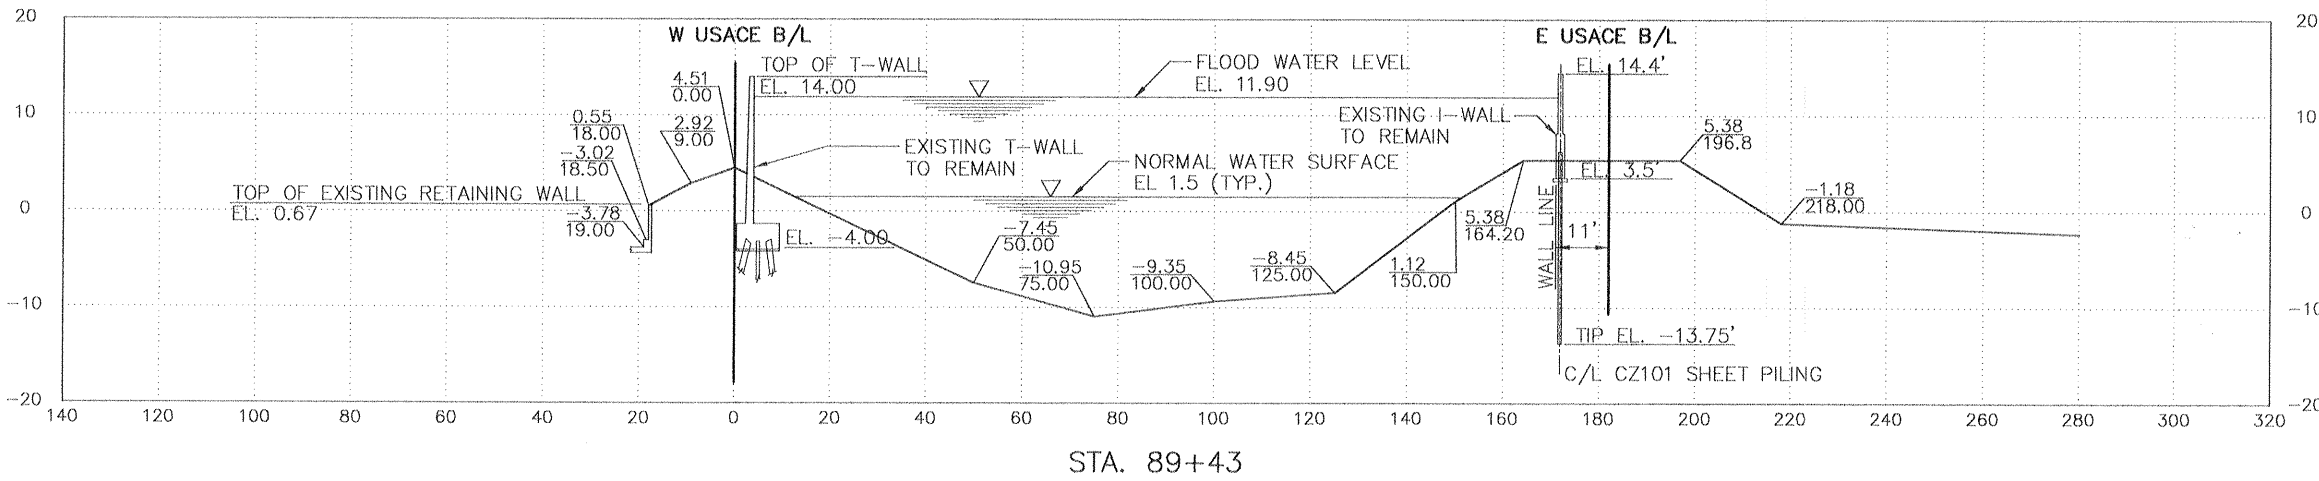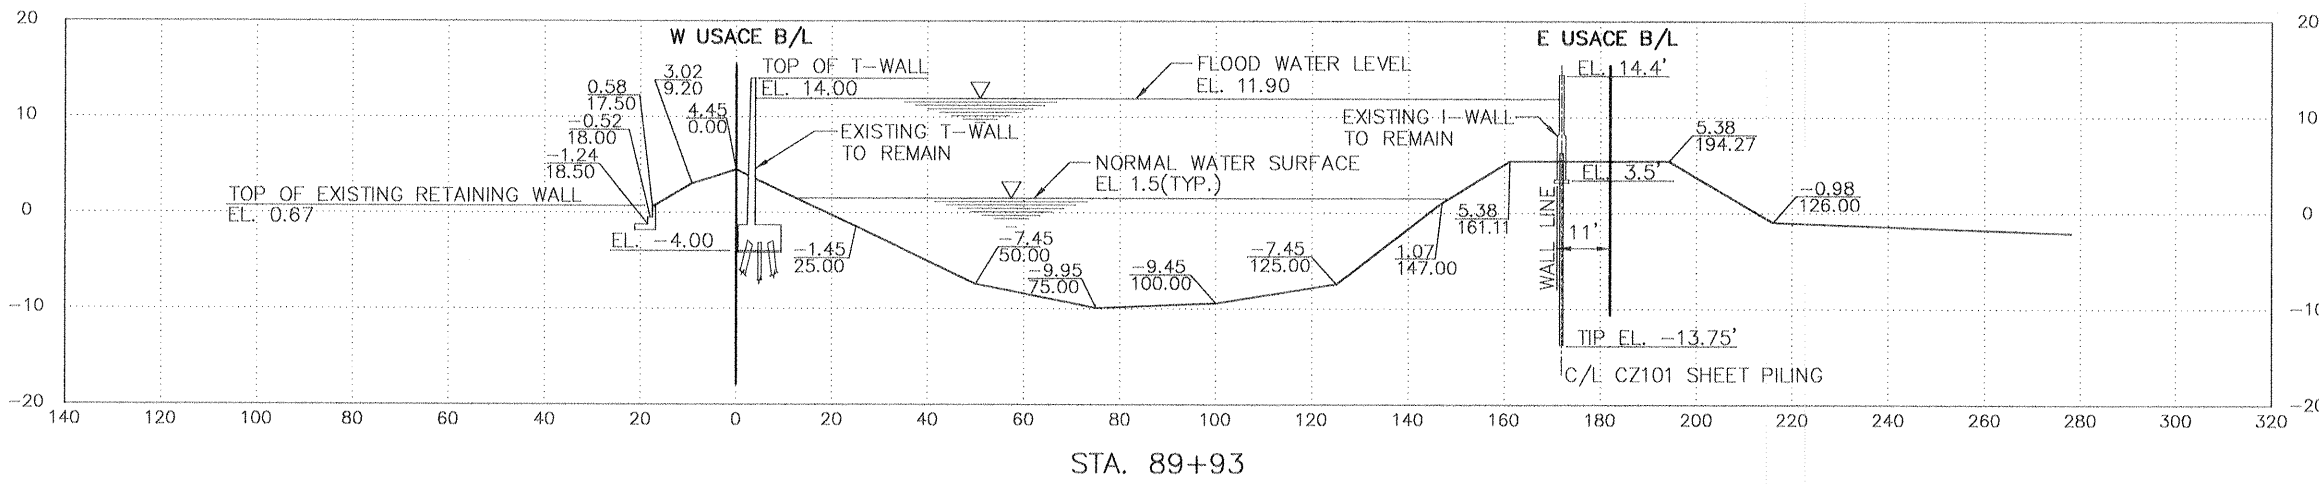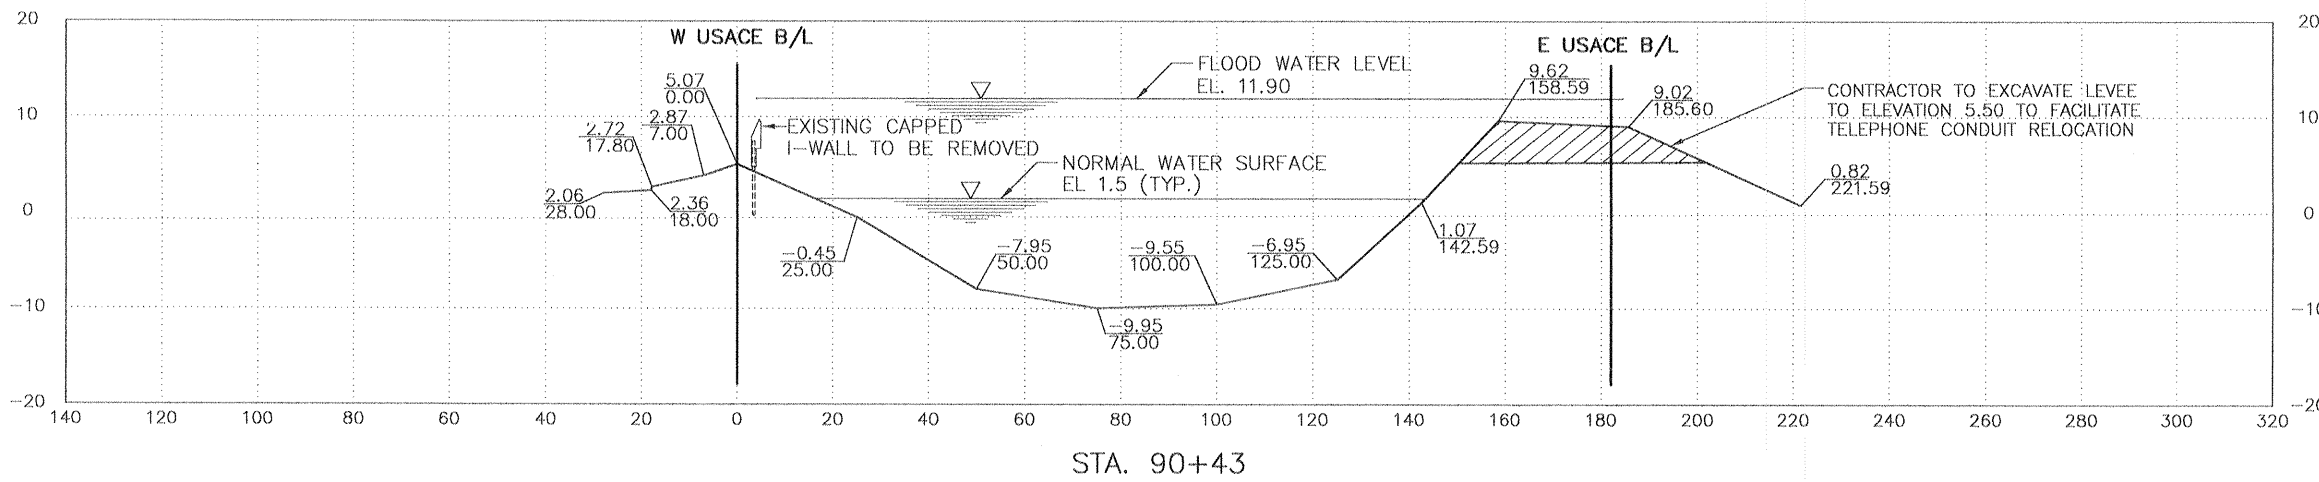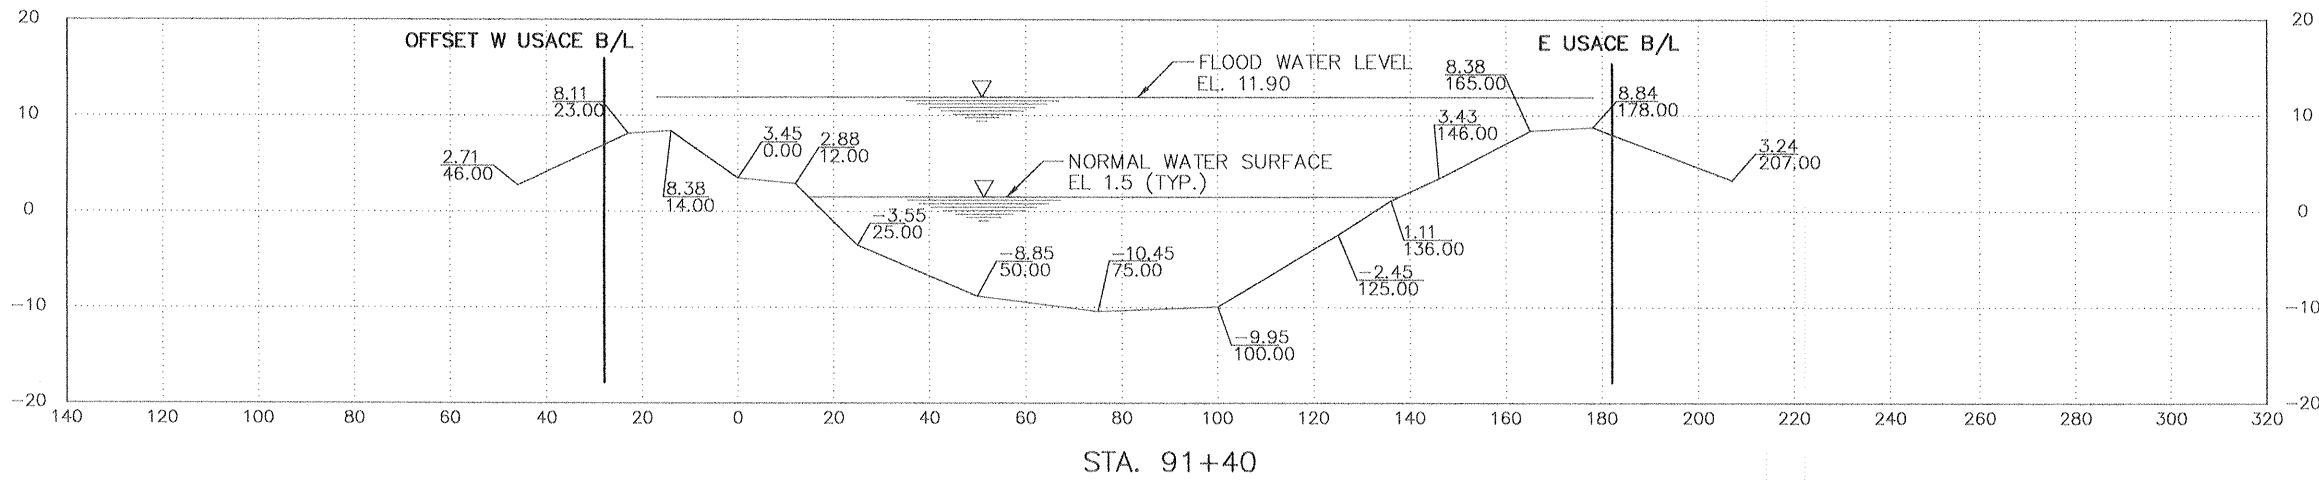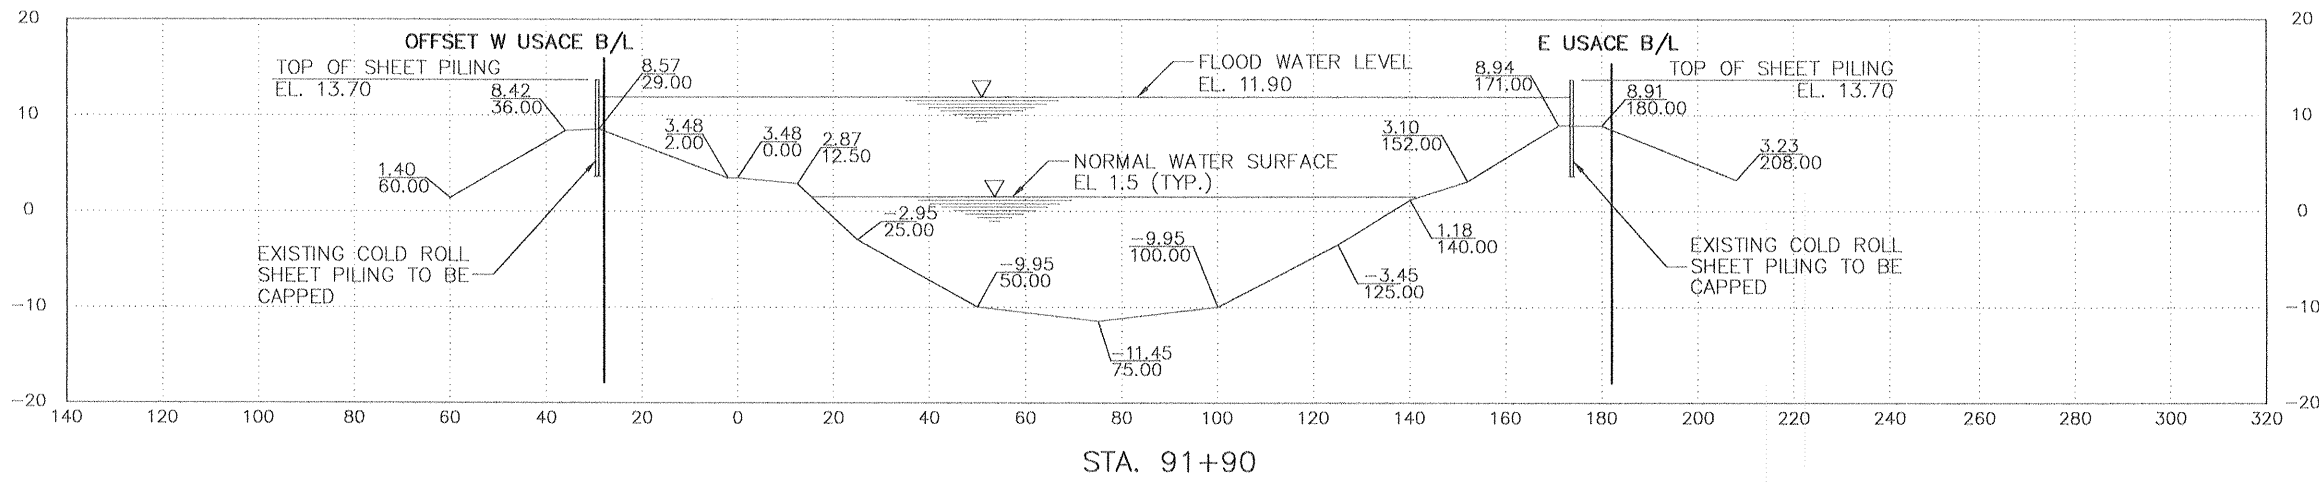


NOTE:
ALL STATIONS REFER TO USACE W B/L AND E B/L.

REFERENCE DRAWINGS
FOR GENERAL NOTES, SEE DWG. NO. 3
FOR FLOODWALL PLAN, SEE DWG. NO. 14

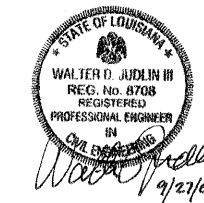

DACW29-00-B-0094
AS BUILT PLANS
DATE RECEIVED 3/15/02
DATE TRACINGS CORRECTED 4/18/02

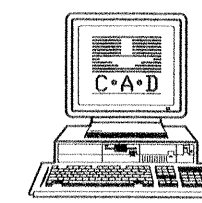


SYMBOL	DESCRIPTION	DATE	APPROVED
REVISIONS			
U.S. ARMY ENGINEER DISTRICT, NEW ORLEANS CORPS OF ENGINEERS NEW ORLEANS, LOUISIANA			
BOARD OF LEVEE COMMISSIONERS ORLEANS LEVEE BOARD NEW ORLEANS, LOUISIANA		HARTMAN ENGINEERING, INC. CONSULTING ENGINEERS KENNER, LOUISIANA	
LAKE PONTCHARTRAIN, LA. AND VICINITY HIGH LEVEL PLAN ORLEANS AVENUE OUTFALL CANAL PHASE 1B ORLEANS PARISH LOUISIANA			
ROBERT E. LEE BOULEVARD BRIDGE EXISTING ORLEANS AVE. CANAL - SECTIONS			
DESIGNED BY: W.D.L.	DATE: MAR. 8, 2000	PLOT SCALE: 20	PLOT DATE: MARCH 8, 2000
DRAWN BY: L.A.C.	CADD FILE: SH110.DGN	FILE NO. H-4-44776	
CHECKED BY: P.J.H.	SOLICITATION NO. DACW29-00-B-0094	DWG. 10 OF 59	
SUBMITTED BY: HARTMAN ENGINEERING DESIGN ENGINEER			

SCALE: 1" = 20' (H)
1" = 10' (V)



Safety is a Part of Your Contract

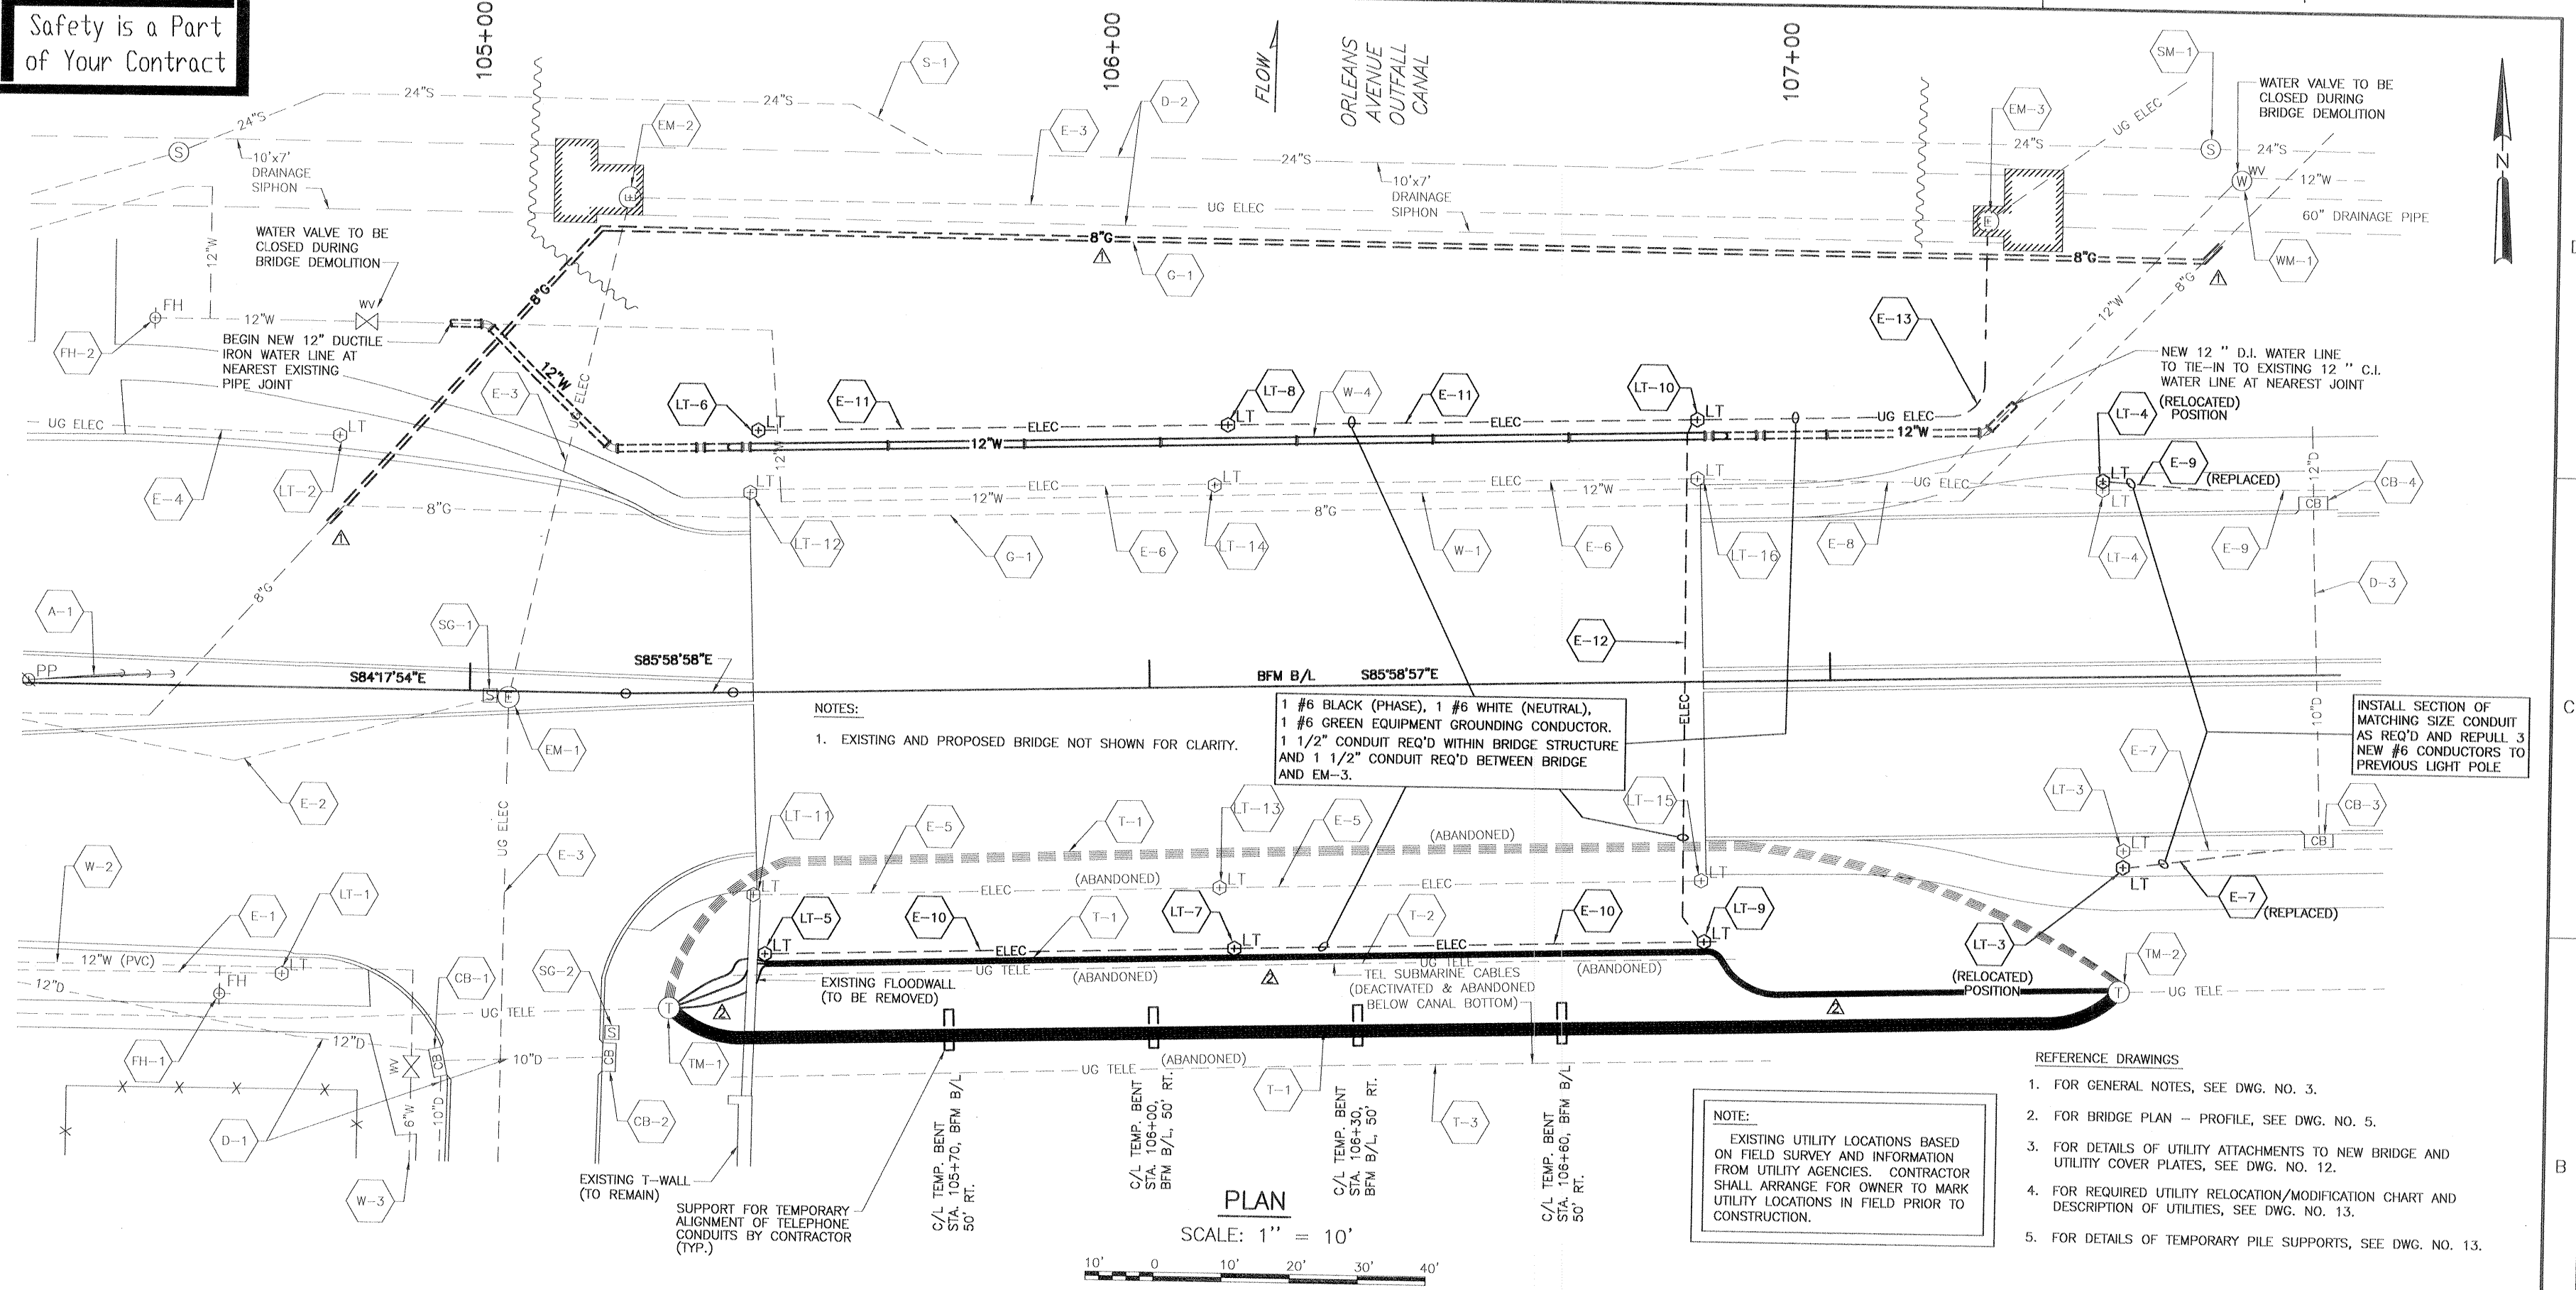


NOTES:
 1. EXISTING AND PROPOSED BRIDGE NOT SHOWN FOR CLARITY.
 1 #6 BLACK (PHASE), 1 #6 WHITE (NEUTRAL), 1 #6 GREEN EQUIPMENT GROUNDING CONDUCTOR. 1 1/2\"/>

NOTE:
 EXISTING UTILITY LOCATIONS BASED ON FIELD SURVEY AND INFORMATION FROM UTILITY AGENCIES. CONTRACTOR SHALL ARRANGE FOR OWNER TO MARK UTILITY LOCATIONS IN FIELD PRIOR TO CONSTRUCTION.

- REFERENCE DRAWINGS**
- FOR GENERAL NOTES, SEE DWG. NO. 3.
 - FOR BRIDGE PLAN - PROFILE, SEE DWG. NO. 5.
 - FOR DETAILS OF UTILITY ATTACHMENTS TO NEW BRIDGE AND UTILITY COVER PLATES, SEE DWG. NO. 12.
 - FOR REQUIRED UTILITY RELOCATION/MODIFICATION CHART AND DESCRIPTION OF UTILITIES, SEE DWG. NO. 13.
 - FOR DETAILS OF TEMPORARY PILE SUPPORTS, SEE DWG. NO. 13.

UTILITIES RELOCATION NOTES

- THE CONTRACTOR SHALL FURNISH ALL LABOR, MATERIAL, EQUIPMENT AND TOOLS AND PERFORM ALL OPERATIONS IN CONNECTION WITH THE RELOCATION OF THE 12\"/>
- PRIOR TO DEMOLISHING THE BRIDGE, THE TELEPHONE CONDUITS SHALL BE TEMPORARILY RELOCATED BY OTHERS ON TEMPORARY PILE SUPPORTS FURNISHED AND INSTALLED BY CONTRACTOR. THE CONTRACTOR SHALL FURNISH AND INSTALL ALL WOOD BLOCKING AND MISCELLANEOUS HARDWARE REQUIRED TO ANCHOR THE TELEPHONE CONDUITS TO THE TEMPORARY PILE SUPPORTS. THE CONTRACTOR SHALL COORDINATE WITH THE UTILITY OWNERS TO PERFORM DEMOLITION OF THE EXISTING ROADWAY, BRIDGE AND T-WALL TO FACILITATE TEMPORARY UTILITY RELOCATION.
- THE TELEPHONE CONDUITS SHALL BE RELOCATED TO THEIR PERMANENT LOCATION BY OTHERS. THE CONTRACTOR SHALL FURNISH THE REQUIRED BRACKETS AND ANCHOR BOLTS.
- TEMPORARY PILE SUPPORTS SHALL BE REMOVED BY CONTRACTOR UPON COMPLETION OF PERMANENT RELOCATION OF TELEPHONE CONDUIT BY OTHERS.

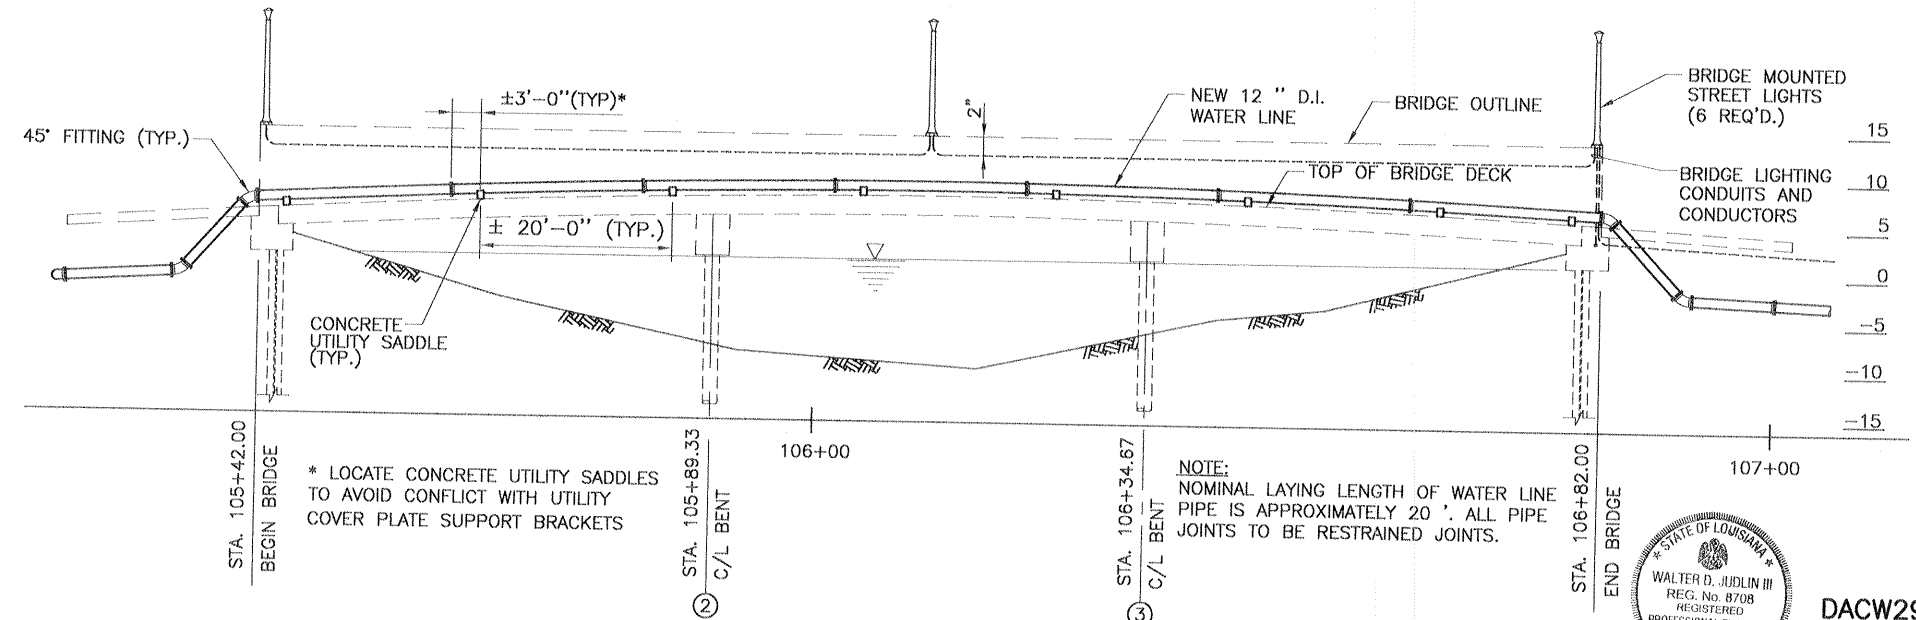

PROFILE
 SCALE: 1" = 10' (H & V)

SYMBOL	DESCRIPTION	DATE	APPROVED
▲	ADDED PERMANENT TELEPHONE CONDUITS	05/25/00	W.D.L.
▲	RELOCATED PERMANENT 8" GAS LINE	05/25/00	W.D.L.

REVISIONS

U.S. ARMY ENGINEER DISTRICT, NEW ORLEANS
 CORPS OF ENGINEERS
 NEW ORLEANS, LOUISIANA

BOARD OF LEVEE COMMISSIONERS
 ORLEANS LEVEE BOARD
 NEW ORLEANS, LOUISIANA



HARTMAN ENGINEERING, INC.
 CONSULTING ENGINEERS
 KENNER, LOUISIANA

LAKE PONTCHARTRAIN, LA. AND VICINITY
 HIGH LEVEL PLAN
 ORLEANS AVENUE OUTFALL CANAL
 PHASE 1B
 ORLEANS PARISH
 LOUISIANA


**ROBERT E. LEE BOULEVARD BRIDGE
 UTILITY PLAN**

DESIGNED BY: M.R.K. DATE: MAR. 8, 2000 PLOT SCALE: 10 PLOT DATE: MARCH 8, 2000
 DRAWN BY: C.R.N. CHECKED BY: W.D.L. CAD FILE: SH111.DGN FILE NO.: H-4-44776
 SUBMITTED BY: SOLICITATION NO.: DACW29-00-B-0094 DWG. 11 OF 59
 HARTMAN ENGINEERING DESIGN ENGINEER


AS BUILT PLANS
 DATE RECEIVED: 3/15/02
 DATE TRACINGS CORRECTED: 4/18/02

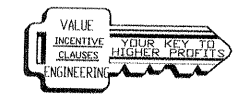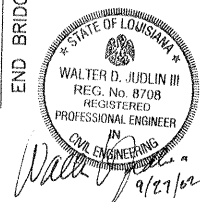


Safety is a Part of Your Contract

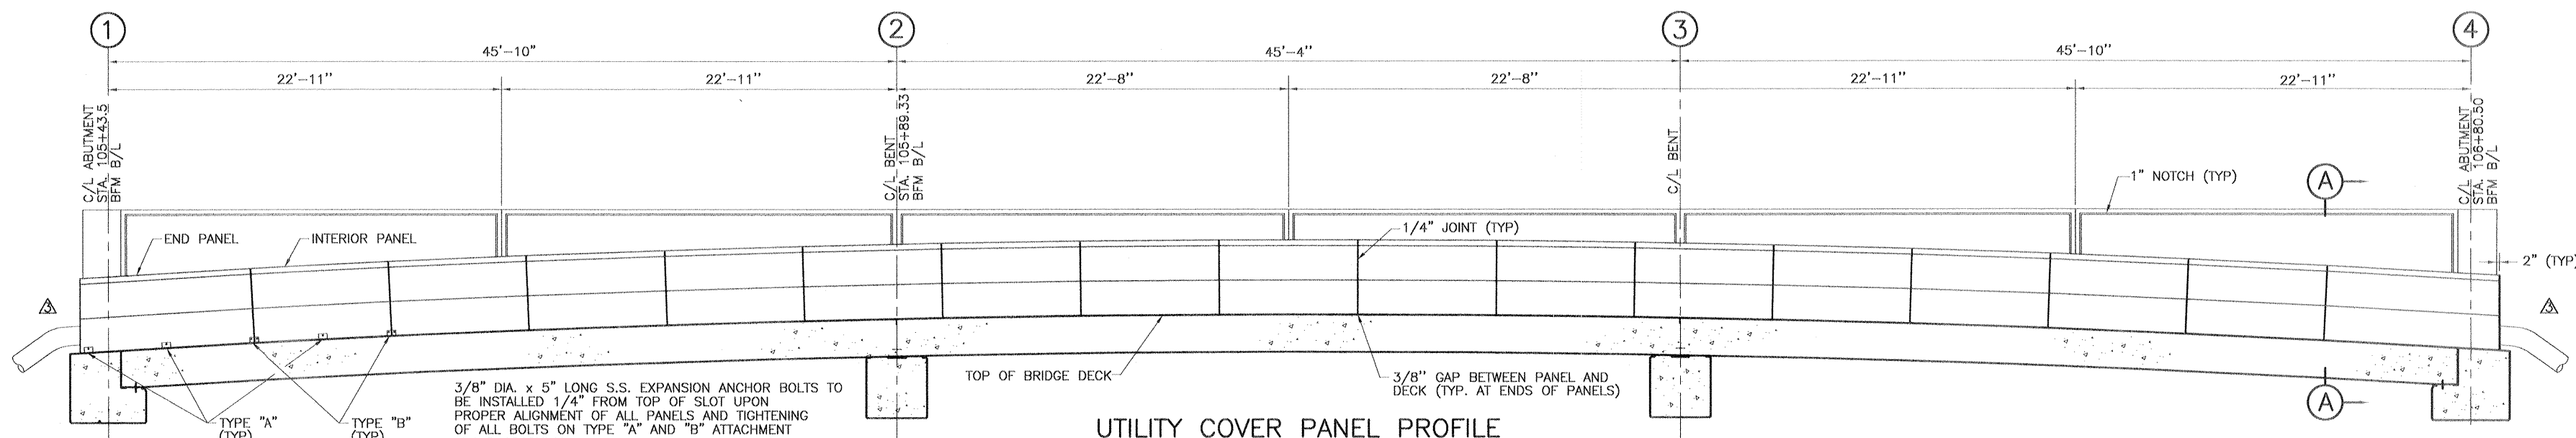


UTILITY COVER PANEL PROFILE
SCALE: 1/4" = 1'-0"

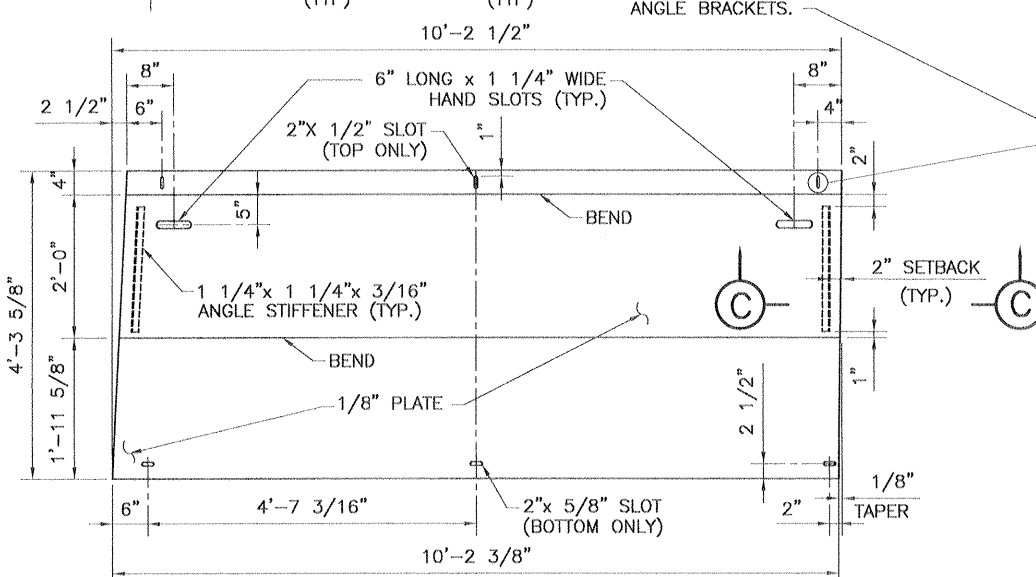


**ONE AS SHOWN
ONE OPPOSITE HAND
UTILITY COVER END PANEL**
SCALE: 3/4" = 1'-0"

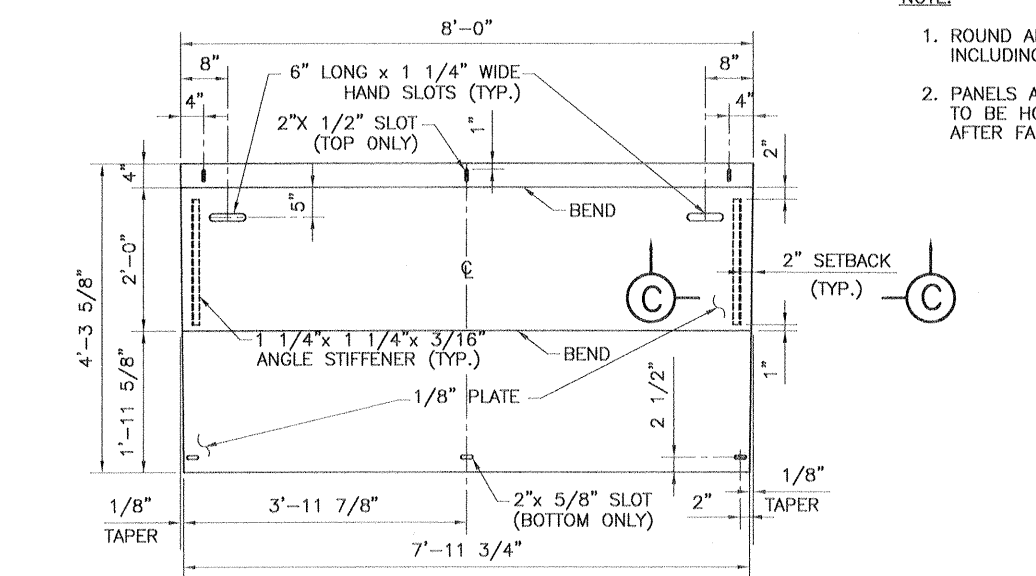

**15 REQUIRED
UTILITY COVER INTERIOR PANEL**
SCALE: 3/4" = 1'-0"

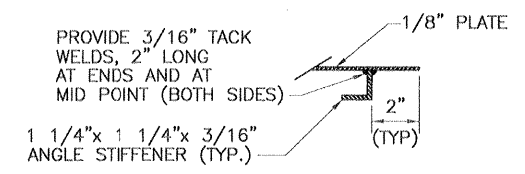


SECTION C
SCALE: 3" = 1'-0"

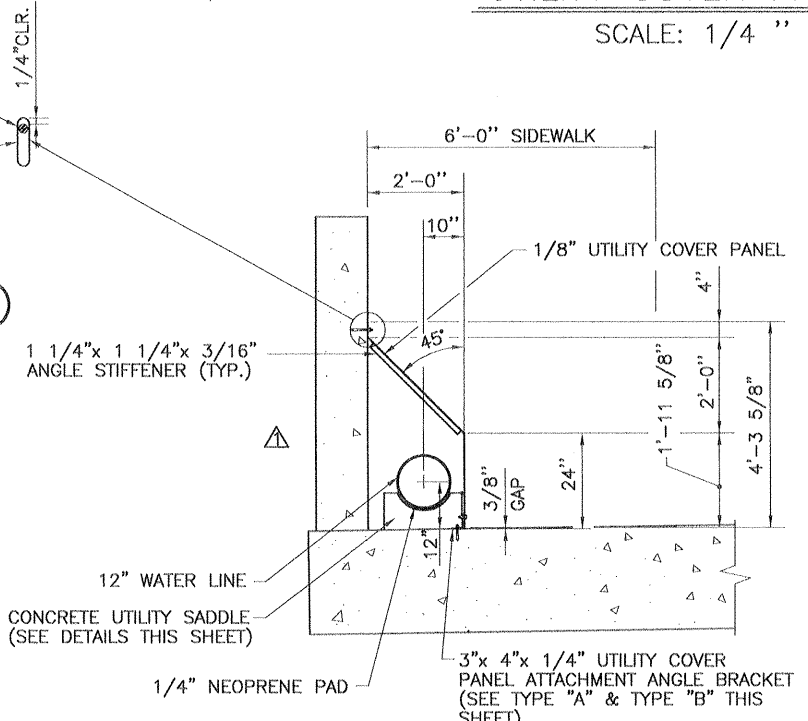


SECTION A
SCALE: 1/2" = 1'-0"


- NOTE:**
1. ROUND ALL EDGES TO 1/8" DIA. INCLUDING HAND SLOTS.
 2. PANELS AND METAL BRACKETS AND BOLTS TO BE HOT DIPPED GALVANIZED AFTER FABRICATION.

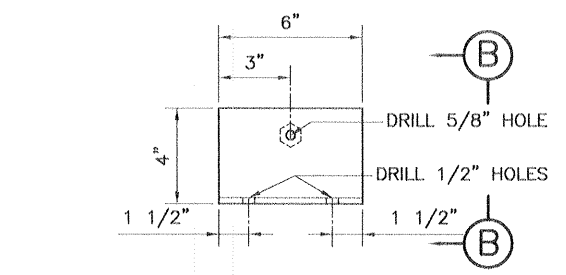


**19 REQUIRED
TYPE 'A'
ATTACHMENT ANGLE BRACKET**
SCALE: 3" = 1'-0"

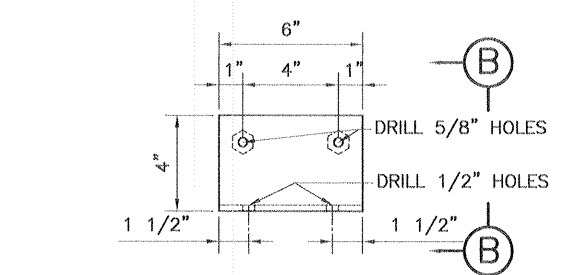

**16 REQUIRED @ JOINTS
TYPE 'B'
ATTACHMENT ANGLE BRACKET**
SCALE: 3" = 1'-0"

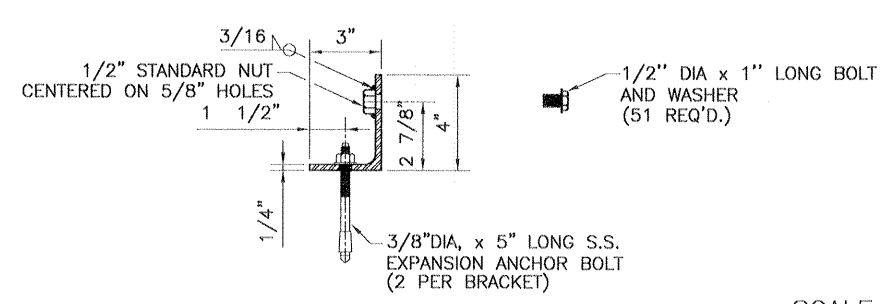


SECTION B
SCALE: 3" = 1'-0"

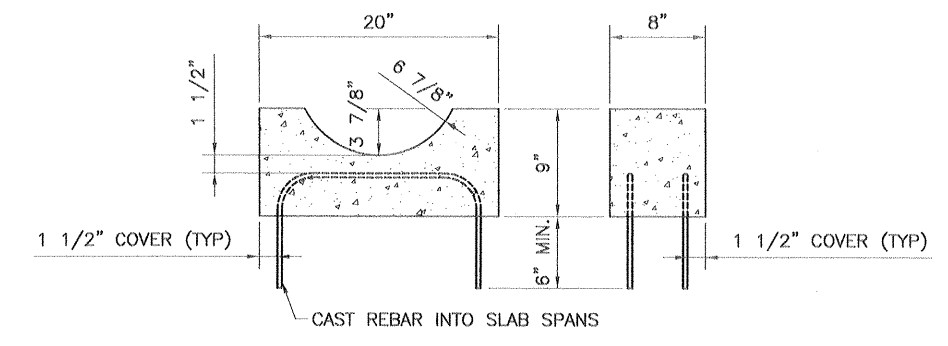

CONCRETE UTILITY SADDLE
SCALE: 1 1/2" = 1'-0"

REFERENCE DRAWINGS

FOR GENERAL NOTES, SEE DWG. NO. 3
FOR PLAN/PROFILE, SEE DWG. NO. 5
FOR ABUTMENT DETAILS, SEE DWG. NO. 35 AND NO. 36
FOR TYPICAL BRIDGE FLOODWALL DETAIL SEE DWG. NO. 38 AND 43
FOR SLAB SPAN DETAILS, SEE DWG. NO. 40, 41 AND 42

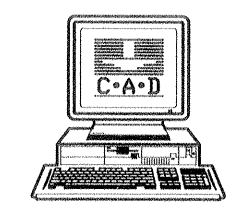

SYMBOL	DESCRIPTION	DATE	APPROVED
△	DELETE GAS LINE AT BOTH ENDS OF BRIDGE	08/14/00	W.D.J.
△	DELETE STEEL UTILITY BRACKET DETAIL IN ITS ENTIRETY	08/14/00	W.D.J.
△	DELETE STEEL UTILITY BRACKET & 8" GAS LINE	08/14/00	W.D.J.

U.S. ARMY ENGINEER DISTRICT, NEW ORLEANS
CORPS OF ENGINEERS
NEW ORLEANS, LOUISIANA

BOARD OF LEVEE COMMISSIONERS
ORLEANS LEVEE BOARD
NEW ORLEANS, LOUISIANA

HARTMAN ENGINEERING, INC.
CONSULTING ENGINEERS
KENNER, LOUISIANA

LAKE PONTCHARTRAIN, LA. AND VICINITY
HIGH LEVEL PLAN
ORLEANS AVENUE OUTFALL CANAL
PHASE 1B
ORLEANS PARISH
LOUISIANA

**ROBERT E. LEE BOULEVARD BRIDGE
UTILITY RELOCATIONS**



DESIGNED BY: P.J.H.	DATE: MAR. 8, 2000	PLOT SCALE: 4B	PLOT DATE: MARCH 8, 2000
DRAWN BY: C.R.N.	CADD FILE: SHT12.DGN		FILE NO. H-4-44776
CHECKED BY: W.D.L.			DWG. 12 OF 59
SUBMITTED BY: HARTMAN ENGINEERING DESIGN ENGINEER	SOLICITATION NO. DACW29-00-B-0094		

AS BUILT PLANS

DATE RECEIVED 3/15/02
DATE TRACINGS CORRECTED 4/18/02

STATE OF LOUISIANA
WALTER D. JUDLIN III
REG. NO. 8708
REGISTERED PROFESSIONAL ENGINEER
IN
CIVIL ENGINEERING
4/27/02

DACW29-00-B-0094

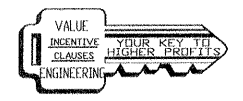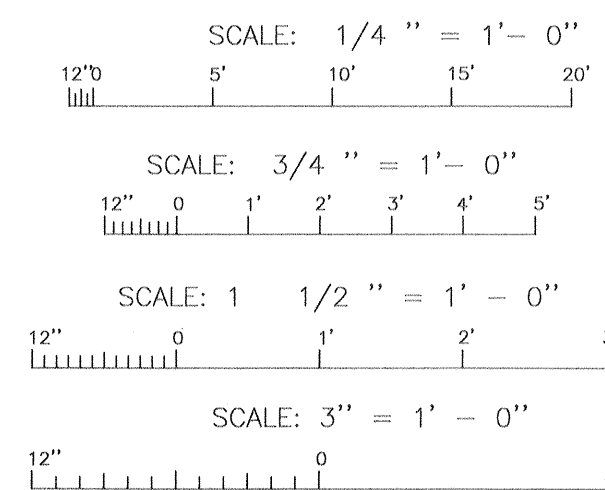


Safety is a Part of Your Contract


REQUIRED UTILITY RELOCATION/MODIFICATION

ITEM NO.	DESCRIPTION	LOCATION/B/L STATION	OWNER	DISPOSITION
A-1	GUY ANCHORS	STA. 104+56.40 BFM B/L, 1.70 LT.	ENTERGY	TO REMAIN, DO NOT DISTURB.
CB-1	CATCH BASINS	STA. 104+97.58 BFM B/L, 54.53 RT. STA. 105+20.50 BFM B/L, 53.60 RT.	NEW ORLEANS DPW	CONTRACTOR TO ADJUST HEIGHT OF CATCH BASINS TO MATCH NEW CURB GRADES.
CB-2	CATCH BASINS	STA. 107+71.60 BFM B/L, 24.32 RT. STA. 107+71.40 BFM B/L, 25.81 LT.	NEW ORLEANS DPW	TO REMAIN, DO NOT DISTURB.
D-1	DRAIN LINES - 10" DIA AND 12" DIA.	ALONG ROBERT E. LEE E.B. SIDEWALK SIDE AND CROSSING ORLEANS AVE.	NEW ORLEANS DPW	TO REMAIN, DO NOT DISTURB.
D-2	10"x7" DRAINAGE SIPHON AND 60" DRAINAGE PIPE	ALONG ROBERT E. LEE 72'± LT. OF BFM B/L (NORTH OF R.E. LEE BRIDGE)	S&WB	TO REMAIN, DO NOT DISTURB.
D-3	DRAIN LINES - 10" DIA. AND 12" DIA.	CROSSING ROBERT E. LEE AT STA. 107+71 BFM B/L	NEW ORLEANS DPW	TO REMAIN, DO NOT DISTURB.
E-1	UG ELECTRICAL - STREET LIGHT UG BURIED	ALONG ROBERT E. LEE E.B LANES - WEST OF BRIDGE, SIDEWALK SIDE	NEW ORLEANS UTILITIES DEPT.	TO REMAIN, DO NOT DISTURB.
E-2	UG ELECTRICAL - 3-WIRE LINE PRIMARY IN CONDUIT	ROBERT E. LEE E.B LANES - WEST OF BRIDGE	ENTERGY	TO REMAIN, DO NOT DISTURB.
E-3	UG ELECTRICAL - 3-WIRE LINE PRIMARY IN CONDUIT	ALONG ROBERT E. LEE 71'± LT. OF BFM B/L (N. OF R.E. LEE BRIDGE)-CROSSES R.E. LEE AT STA. 105+06± BFM B/L	ENTERGY	TO REMAIN, DO NOT DISTURB.
E-4	UG ELECTRICAL - STREET LIGHT UG BURIED	ROBERT E. LEE W.B LANES - WEST OF BRIDGE, SIDEWALK SIDE	NEW ORLEANS UTILITIES DEPT.	TO REMAIN, DO NOT DISTURB.
E-5	ELECTRICAL - STREET LIGHTS IN CONDUIT	ATTACHED TO UNDERSIDE OF EXISTING BRIDGE	NEW ORLEANS UTILITIES DEPT.	OWNER TO DE-ENERGIZE AND CONTRACTOR TO DEMOLISH WITH BRIDGE
E-6	ELECTRICAL - STREET LIGHTS IN CONDUIT	ATTACHED TO UNDERSIDE OF EXISTING BRIDGE	NEW ORLEANS UTILITIES DEPT.	OWNER TO DE-ENERGIZE AND CONTRACTOR TO DEMOLISH WITH BRIDGE
E-7	UG ELECTRICAL - STREET LIGHT UG BURIED	ROBERT E. LEE E.B. LANES. EAST OF BRIDGE, SIDEWALK SIDE	NEW ORLEANS DPW/ENTERGY	CONTRACTOR TO REMOVE AND REPLACE PORTION OF CONDUIT AS NEEDED FOR LIGHT POLE RELOCATION AND INSTALL NEW CONDUCTORS TO PREVIOUS LIGHT POLE.
E-8	UG ELECTRICAL - STREET LIGHT UG BURIED	ROBERT E. LEE W.B. LANES. EAST OF BRIDGE, SIDEWALK SIDE	NEW ORLEANS UTILITIES DEPT.	OWNER TO DE-ENERGIZE AND ABANDON
E-9	UG ELECTRICAL - STREET LIGHT UG BURIED	ROBERT E. LEE W.B. LANES. EAST OF BRIDGE, SIDEWALK SIDE	NEW ORLEANS UTILITIES DEPT.	CONTRACTOR TO REMOVE AND REPLACE PORTION OF CONDUIT AS NEEDED FOR LIGHT POLE RELOCATION AND INSTALL NEW CONDUCTORS TO PREVIOUS LIGHT POLE.
E-10	ELECTRICAL LINE FOR STREET LIGHTS 1 1/2" CONDUIT	ALONG SOUTH SIDE OF ROBERT E. LEE BRIDGE	NEW ORLEANS UTILITIES DEPT.	CONDUIT AND CONDUCTORS TO BE FURNISHED, INSTALLED, AND CONNECTED BY CONTRACTOR
E-11	ELECTRICAL LINE FOR STREET LIGHTS 1 1/2" CONDUIT	ALONG NORTH SIDE OF ROBERT E. LEE BRIDGE AND ROBERT E. LEE BLVD.	NEW ORLEANS UTILITIES DEPT.	CONDUIT AND CONDUCTORS TO BE FURNISHED, INSTALLED, AND CONNECTED BY CONTRACTOR
E-12	ELECTRICAL LINE FOR STREET LIGHTS 1 1/2" CONDUIT	EAST ABUTMENT	NEW ORLEANS UTILITIES DEPT.	CONDUIT AND CONDUCTORS TO BE FURNISHED, INSTALLED, AND CONNECTED BY CONTRACTOR
E-13	UG ELECTRICAL FOR STREET LIGHT 2" CONDUIT	NORTHEAST CORNER OF ROBERT E. LEE BRIDGE TO EM-3	NEW ORLEANS UTILITIES DEPT.	CONDUIT AND CONDUCTORS TO BE FURNISHED, INSTALLED, AND CONNECTED BY CONTRACTOR
EM-1	ELECTRICAL MANHOLES	STA. 105+05.72 BFM B/L, 0.89 RT. STA. 105+22.41 BFM B/L, 72.89 LT. STA. 107+24.03 BFM B/L, 67.09 LT.	ENTERGY ENTERGY ENTERGY	TO REMAIN, DO NOT DISTURB. TO REMAIN, DO NOT DISTURB. TO REMAIN, CONTRACTOR TO ROUTE NEW E-13 INTO MANHOLE. SPLICE INTO 120 V STREET LIGHT CIRCUIT USING WATERPROOF SPLICES AS SPECIFIED.
FH-1	FIRE HYDRANTS	STA. 104+63.55 BFM B/L, 45.33 RT. STA. 104+52.76 BFM B/L, 53.98 LT.	S&WB	TO REMAIN, DO NOT DISTURB.
G-1	8" H.P. GAS LINE	ATTACHED TO NORTH SIDE OF EXISTING BRIDGE	ENTERGY GAS OPERATIONS	CONTRACTOR TO DEMOLISH ABANDONED LINE WITH BRIDGE DEMOLITION.

ITEM NO.	DESCRIPTION	LOCATION/B/L STATION	OWNER	DISPOSITION
G-1	8" H.P. GAS LINE	ATTACHED TO PROTECTED SIDE FACE OF NORTH BRIDGE WALL	ENTERGY GAS OPERATIONS	TO REMAIN. GAS LINE LOCATED APPROXIMATED 3 FEET BELOW EXISTING GRADE. UPON NOTIFICATION BY CONTRACTOR, OWNER SHALL TEMPORARILY REMOVE THE SECTION OF GAS LINE IN CONFLICT WITH NEW SHEET PILING. OWNER WILL RE-INSTALL LINE AFTER CONTRACTOR INSTALLS STEEL CASING.
LT-1	LIGHT POLES	STA. 104+72.55 BFM B/L, 42.30 RT. STA. 104+80.27 BFM B/L, 37.22 LT.	NEW ORLEANS UTILITIES DEPT.	TO REMAIN, DO NOT DISTURB.
LT-3	LIGHT POLES	STA. 107+42.83 BFM B/L, 25.56 RT. STA. 107+40.41 BFM B/L, 27.48 LT.	NEW ORLEANS UTILITIES DEPT.	TO BE RELOCATED BY CONTRACTOR TO STA.107+45.00, 28'RT. AND STA.107+45.00, 28'LT. RESPECTIVELY
LT-5	STREET LIGHTS WITH POLES MOUNTED TO NEW BRIDGE	STA. 105+43.00 BFM B/L, 38.50 RT. STA. 105+43.00 BFM B/L, 38.50 LT. STA. 106+12.00 BFM B/L, 38.50 RT. STA. 106+12.00 BFM B/L, 38.50 LT. STA. 106+81.00 BFM B/L, 38.50 RT. STA. 106+81.00 BFM B/L, 38.50 LT.	NEW ORLEANS UTILITIES DEPT.	LIGHT POLES AND FIXTURES TO BE FURNISHED AND INSTALLED BY CONTRACTOR
LT-11	LIGHT POLES MOUNTED ON EXISTING BRIDGE	STA. 105+42.29 BFM B/L, 29.52 RT. STA. 105+40.83 BFM B/L, 29.38 LT. STA. 106+09.91 BFM B/L, 29.52 RT. STA. 106+09.94 BFM B/L, 29.66 LT. STA. 106+80.69 BFM B/L, 29.25 RT. STA. 106+80.91 BFM B/L, 29.83 LT.	NEW ORLEANS UTILITIES DEPT.	OWNER TO DE-ENERGIZE AND CONTRACTOR TO REMOVE AND DELIVER TO THE CITY OF NEW ORLEANS. CONTRACTOR MUST REMOVE LT-11, LT-13 AND LT-15 PRIOR TO RELOCATION OF G-1.
S-1	12" SEWER LINE	78'± LT. OF BFM B/L ALONG ROBERT E. LEE (NORTH OF R.E. LEE BRIDGE)	S&WB	TO REMAIN, DO NOT DISTURB.
SG-1	STREET SIGNS	STA. 105+04.72 BFM B/L, 0.89 LT. STA. 105+21.76 BFM B/L, 49.64 RT.	NEW ORLEANS DPW	REMOVE AND STORE DURING CONSTRUCTION, REINSTALL DURING FINAL SIGNING AND STRIPING
SM-1	SEWER MANHOLE	STA. 107+56.94 BFM B/L, 77.36 LT.	S&WB	TO REMAIN, DO NOT DISTURB.
T-1	TELEPHONE CONDUITS (SIX 4" CONDUITS)	ALONG ROBERT E. LEE E.B. LANES SIDEWALK SIDE AND ATTACHED TO SOUTH SIDE OF EXISTING BRIDGE	BELLSOUTH	TO BE RELOCATED BY OWNER AFTER CONTRACTOR INSTALLS TEMPORARY SUPPORTS AND DEMOLISHES EXISTING SOUTHWEST FLOODWALL AND A SECTION OF THE BRIDGE.
T-1	TELEPHONE CONDUITS (SIX 4" CONDUITS)	ATTACHED TO TEMPORARY PILE SUPPORTS SOUTH OF ROBERT E. LEE BRIDGE	BELLSOUTH	TEMPORARY RELOCATION BY OWNER WITHIN 28 CALENDAR DAYS OF COMPLETION OF TEMPORARY SUPPORTS AND REQUIRED DEMOLITION BY CONTRACTOR.
T-1	TELEPHONE CONDUITS (SIX 4" CONDUITS)	ATTACHED TO FLOOD SIDE FACE OF SOUTH BRIDGE WALL	BELLSOUTH	TO BE INSTALLED BY OWNER WITHIN 28 CALENDAR DAYS AFTER WRITTEN NOTICE FROM CONTRACTOR
T-2	ABANDONED SUBMARINE CABLES	41'± AND 56'± RT. OF BFM B/L (SOUTH OF R.E. LEE BRIDGE)	BELLSOUTH	ABANDONED, DO NOT DISTURB.
TM-1	ABANDONED TELEPHONE MANHOLES	STA. 103+30.33 BFM B/L, 46.50 RT. STA. 107+41.90 BFM B/L, 46.31 RT.	BELLSOUTH	TO BE DEMOLISHED AND RE-CONSTRUCTED BY OWNER
W-1	12" WATER MAIN	ATTACHED TO NORTH SIDE OF EXISTING BRIDGE	S&WB	VALVES ON THE EAST AND WEST CANAL BANKS TO BE SHUT OFF BY S&WB DURING CONSTRUCTION. LINE TO BE REMOVED IN CONJUNCTION WITH BRIDGE DEMOLITION. WORK TO BE PERFORMED BY CONTRACTOR.
W-2	12" PVC WATER MAIN	ALONG ROBERT E. LEE E/B LANES, SIDEWALK SIDE	S&WB	TO REMAIN, DO NOT DISTURB.
W-3	6" WATER LINE	ALONG ORLEANS AVENUE AT STA. 104+93± BFM B/L	S&WB	TO REMAIN, DO NOT DISTURB.
W-4	12" WATER LINE	SUPPORTED ON SIDEWALK OF NEW BRIDGE	S&WB	CONTRACTOR TO FURNISH AND INSTALL NEW LINE
WM-1	WATER MANHOLE	STA. 107+61.17 BFM B/L, 73.11 LT.	S&WB	UPON NOTIFICATION BY CONTRACTOR, THE S&WB SHALL SHUT OFF VALVES DURING WATER LINE RELOCATION. MANHOLE TO REMAIN.

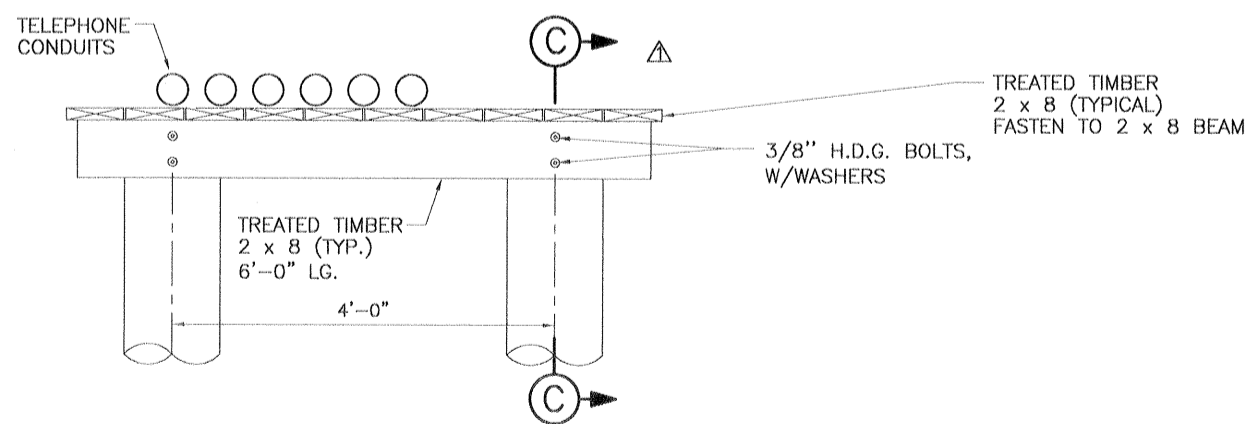


ELEVATION
TEMPORARY PILE SUPPORT DETAILS
SCALE: 1" = 1'-0"

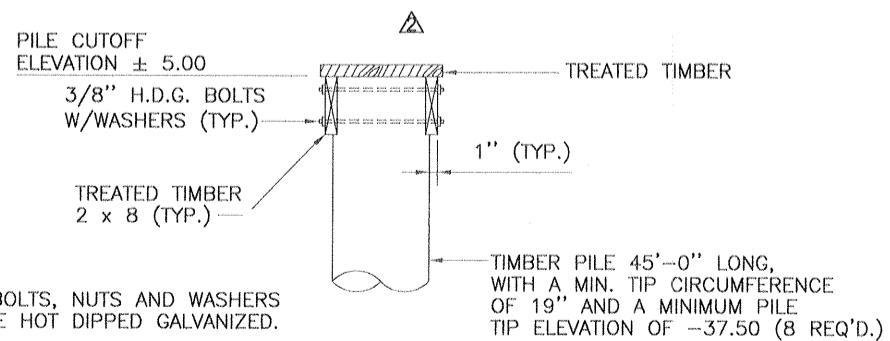

- NOTES:
- ALL BOLTS, NUTS AND WASHERS TO BE HOT DIPPED GALVANIZED.
 - CONTRACTOR TO COORDINATE TEMPORARY AND PERMANENT RELOCATION WITH THE OWNER. (ENTERGY)

SECTION C
SCALE: 1" = 1'-0"

- REFERENCE DRAWINGS
- FOR GENERAL NOTES, SEE DWG. NO. 3.
 - FOR UTILITY PLAN, SEE DWG. NO. 11.
 - FOR UTILITY COVER PANEL, SEE DWG. NO. 12.
 - FOR PERMANENT TELEPHONE SUPPORT BRACKETS, SEE DWG. NO. 30.

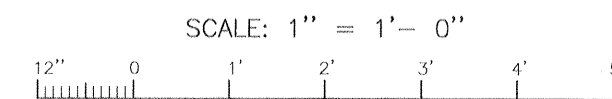

SYMBOL	DESCRIPTION	DATE	APPROVED
△	CHANGES TO ITEMS G-1 IN TABLE	08/14/00	W.D.J.
△	DELETE GAS LINE FROM SECTION VIEW	08/14/00	W.D.J.
△	DELETE GAS LINE FROM ELEVATION VIEW	08/14/00	W.D.J.

REVISIONS

U.S. ARMY ENGINEER DISTRICT, NEW ORLEANS
CORPS OF ENGINEERS
NEW ORLEANS, LOUISIANA

BOARD OF LEVEE COMMISSIONERS
ORLEANS LEVEE BOARD
NEW ORLEANS, LOUISIANA

HARTMAN ENGINEERING, INC.
CONSULTING ENGINEERS
KENNER, LOUISIANA


LAKE PONTCHARTRAIN, LA. AND VICINITY
HIGH LEVEL PLAN
ORLEANS AVENUE OUTFALL CANAL
PHASE 1B
ORLEANS PARISH
LOUISIANA

ROBERT E. LEE BOULEVARD BRIDGE
UTILITY RELOCATIONS

DESIGNED BY: M.K.R.
DRAWN BY: L.A.C.
CHECKED BY: W.D.L.

DATE: MAR. 8, 2000
CADD FILE: SH113.DGN
SOLICITATION NO. DACW29-00-B-0094

PLOT SCALE: 12
PLOT DATE: MARCH 8, 2000
FILE NO. H-4-44776
DWG. 13 OF 59

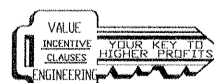

DACW29-00-B-0094
AS BUILT PLANS
DATE RECEIVED 3/15/02
DATE TRACINGS CORRECTED 4/18/02

Safety is a Part of Your Contract


5

4

3

2


1

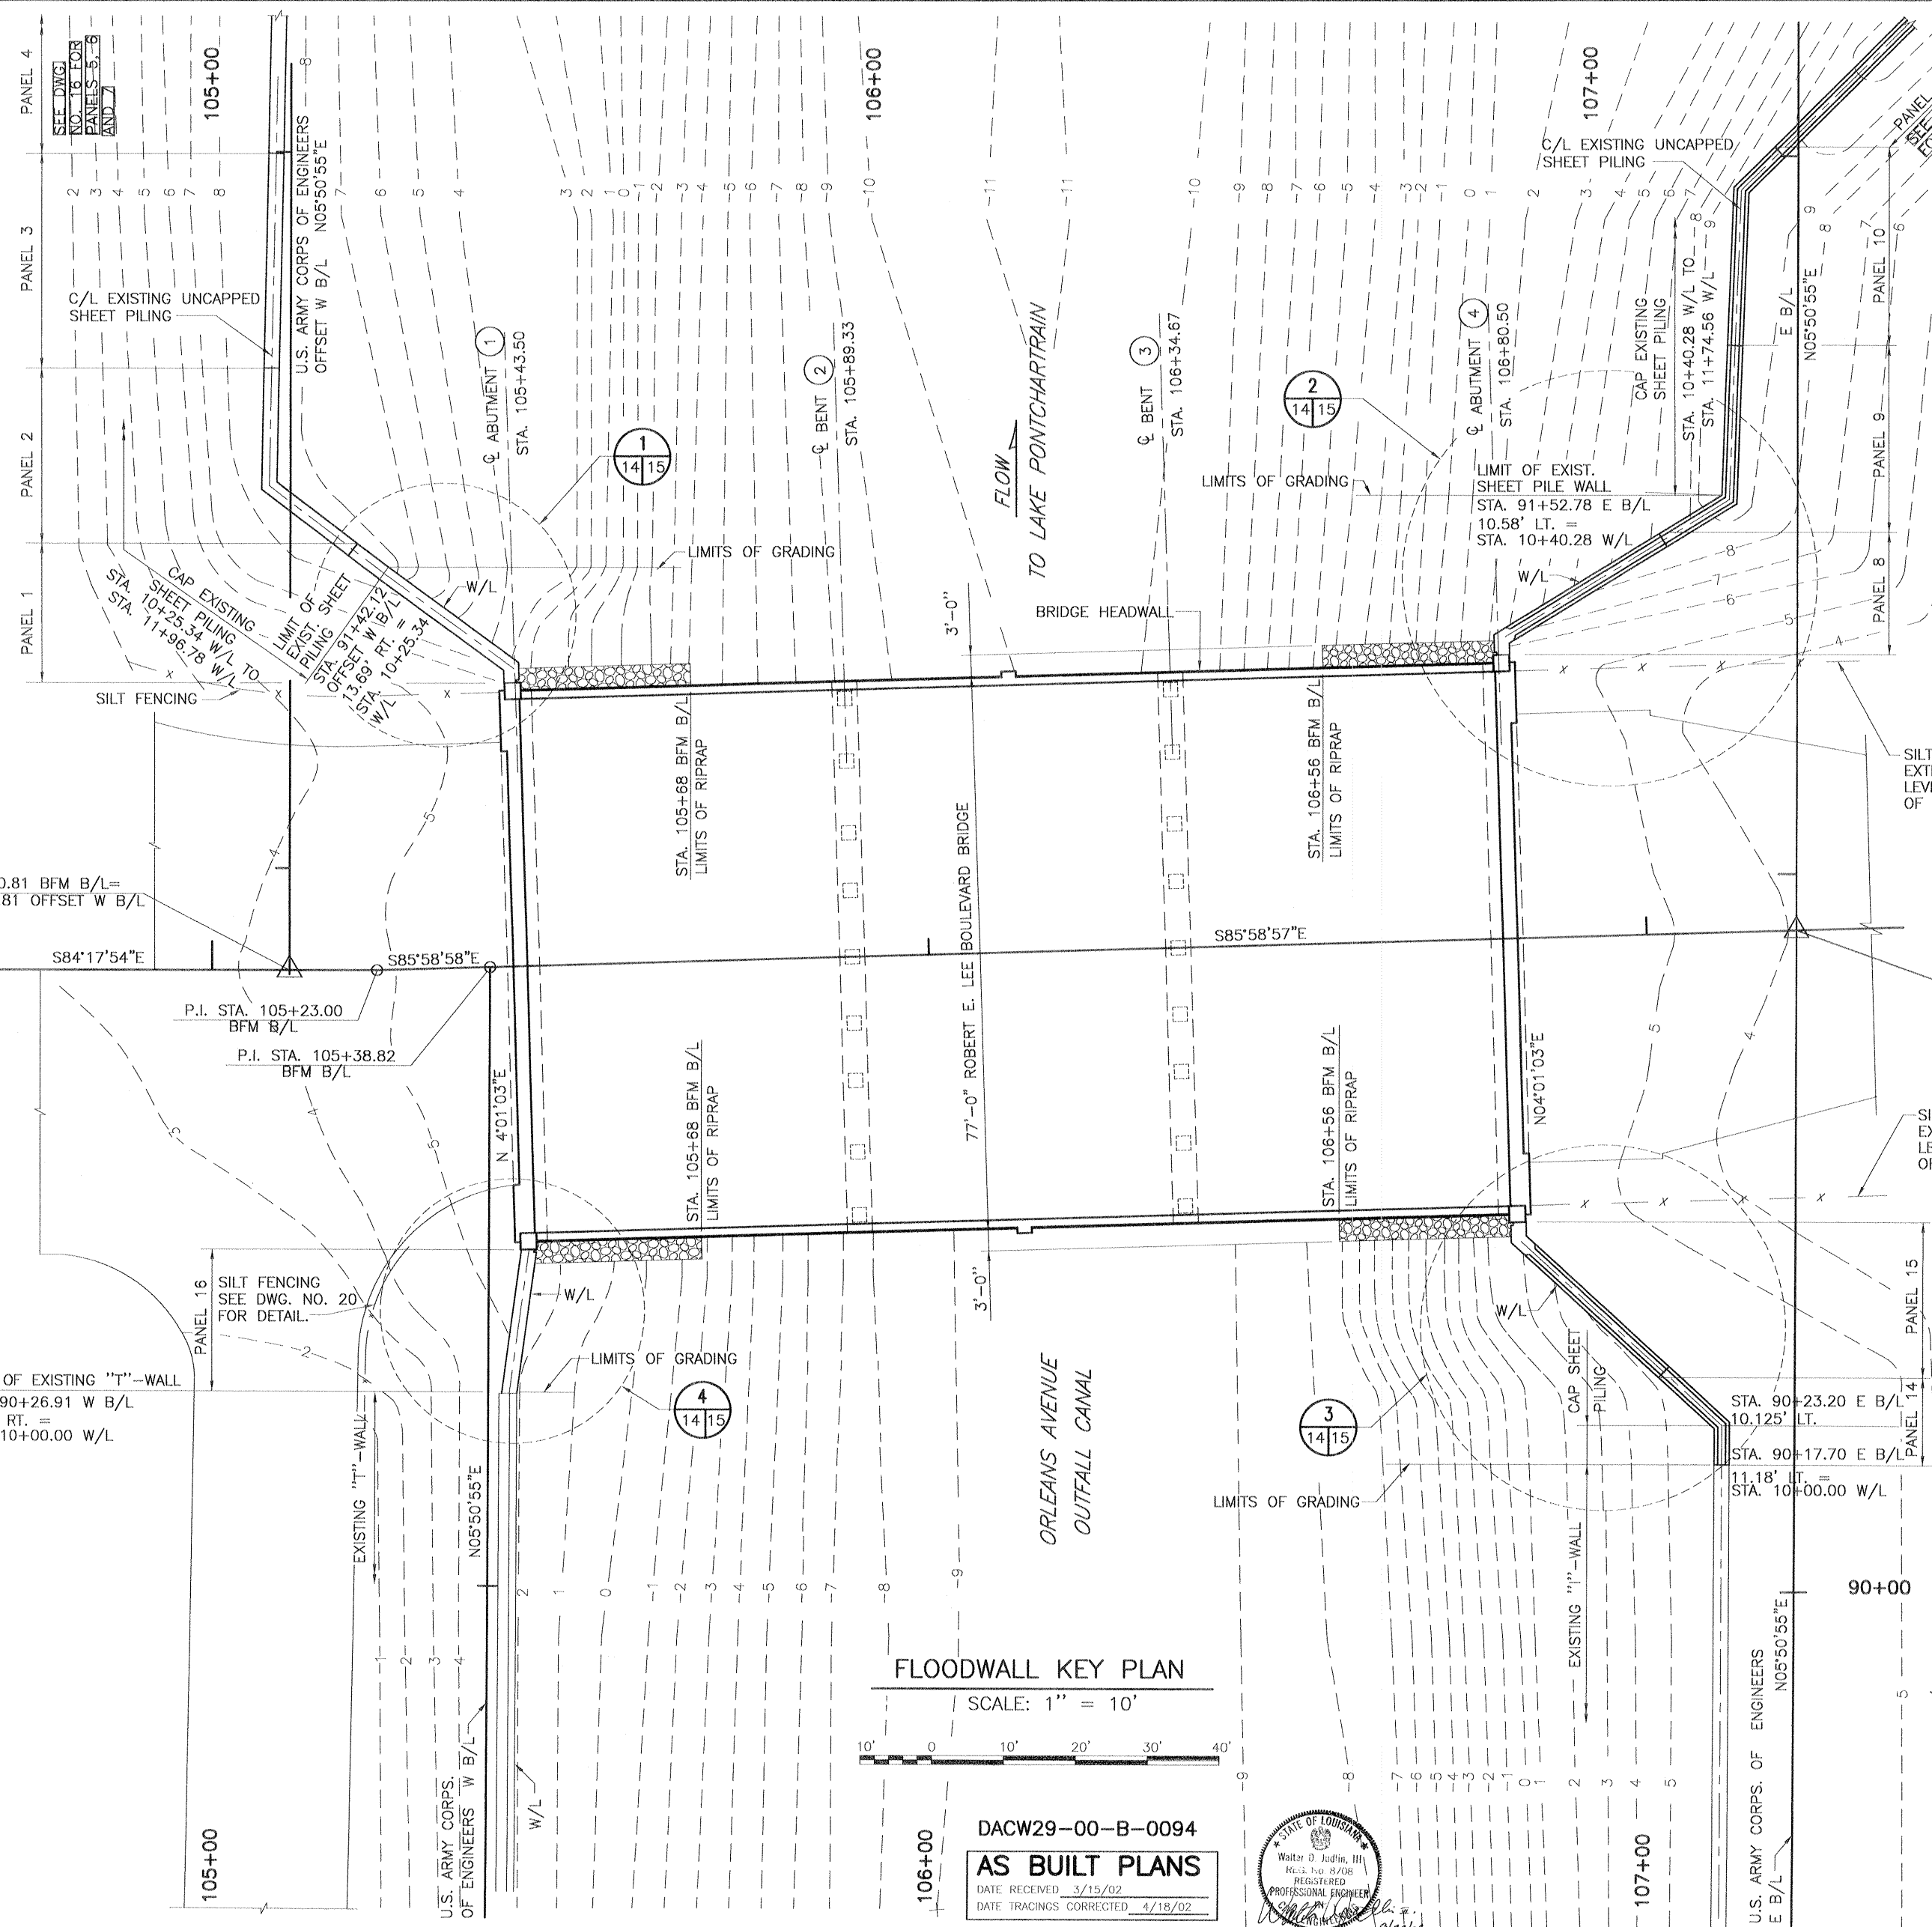

EQUATION:
 STA. 105+10.81 BFM B/L=
 STA. 90+85.81 OFFSET W B/L

LIMIT OF EXISTING "T"-WALL
 STA. 90+26.91 W B/L
 4.00' RT. =
 STA. 10+00.00 W/L

REFERENCE DRAWINGS
 FOR GENERAL NOTES, SEE DWG. NO. 3.
 FOR PLAN AND PROFILE, SEE DWG. NO. 4.
 FOR LIMITS AND ALIGNMENT OF UNCAPPED SHEET PILING, SEE DWG. NOS. 17 AND 18.

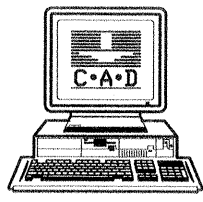

FLOODWALL KEY PLAN
 SCALE: 1" = 10'

DACW29-00-B-0094
AS BUILT PLANS
 DATE RECEIVED 3/15/02
 DATE TRACINGS CORRECTED 4/18/02



SYMBOL	DESCRIPTION	DATE	APPROVED
REVISIONS			

U.S. ARMY ENGINEER DISTRICT, NEW ORLEANS
 CORPS OF ENGINEERS
 NEW ORLEANS, LOUISIANA

BOARD OF LEVEE COMMISSIONERS
 ORLEANS LEVEE BOARD
 NEW ORLEANS, LOUISIANA

HARTMAN ENGINEERING, INC.
 CONSULTING ENGINEERS
 KENNER, LOUISIANA

LAKE PONTCHARTRAIN, LA. AND VICINITY
 HIGH LEVEL PLAN
ORLEANS AVENUE OUTFALL CANAL
 PHASE 1B
 ORLEANS PARISH
 LOUISIANA

ROBERT E. LEE BOULEVARD BRIDGE
FLOODWALL PLAN

DESIGNED BY: M.K.R.	DATE: MAR. 8, 2000	PLOT SCALE: 10	PLOT DATE: MARCH 8, 2000
DRAWN BY: L.A.C.	CHECKED BY: W.D.L.	GADD FILE: SHT14.DGN	FILE NO. H-4-44776
SUBMITTED BY: HARTMAN ENGINEERING	SOLICITATION NO. DACW29-00-B-0094	DESIGN ENGINEER	DWG. 14 OF 59



5



4

3

2

1

Safety is a Part of Your Contract

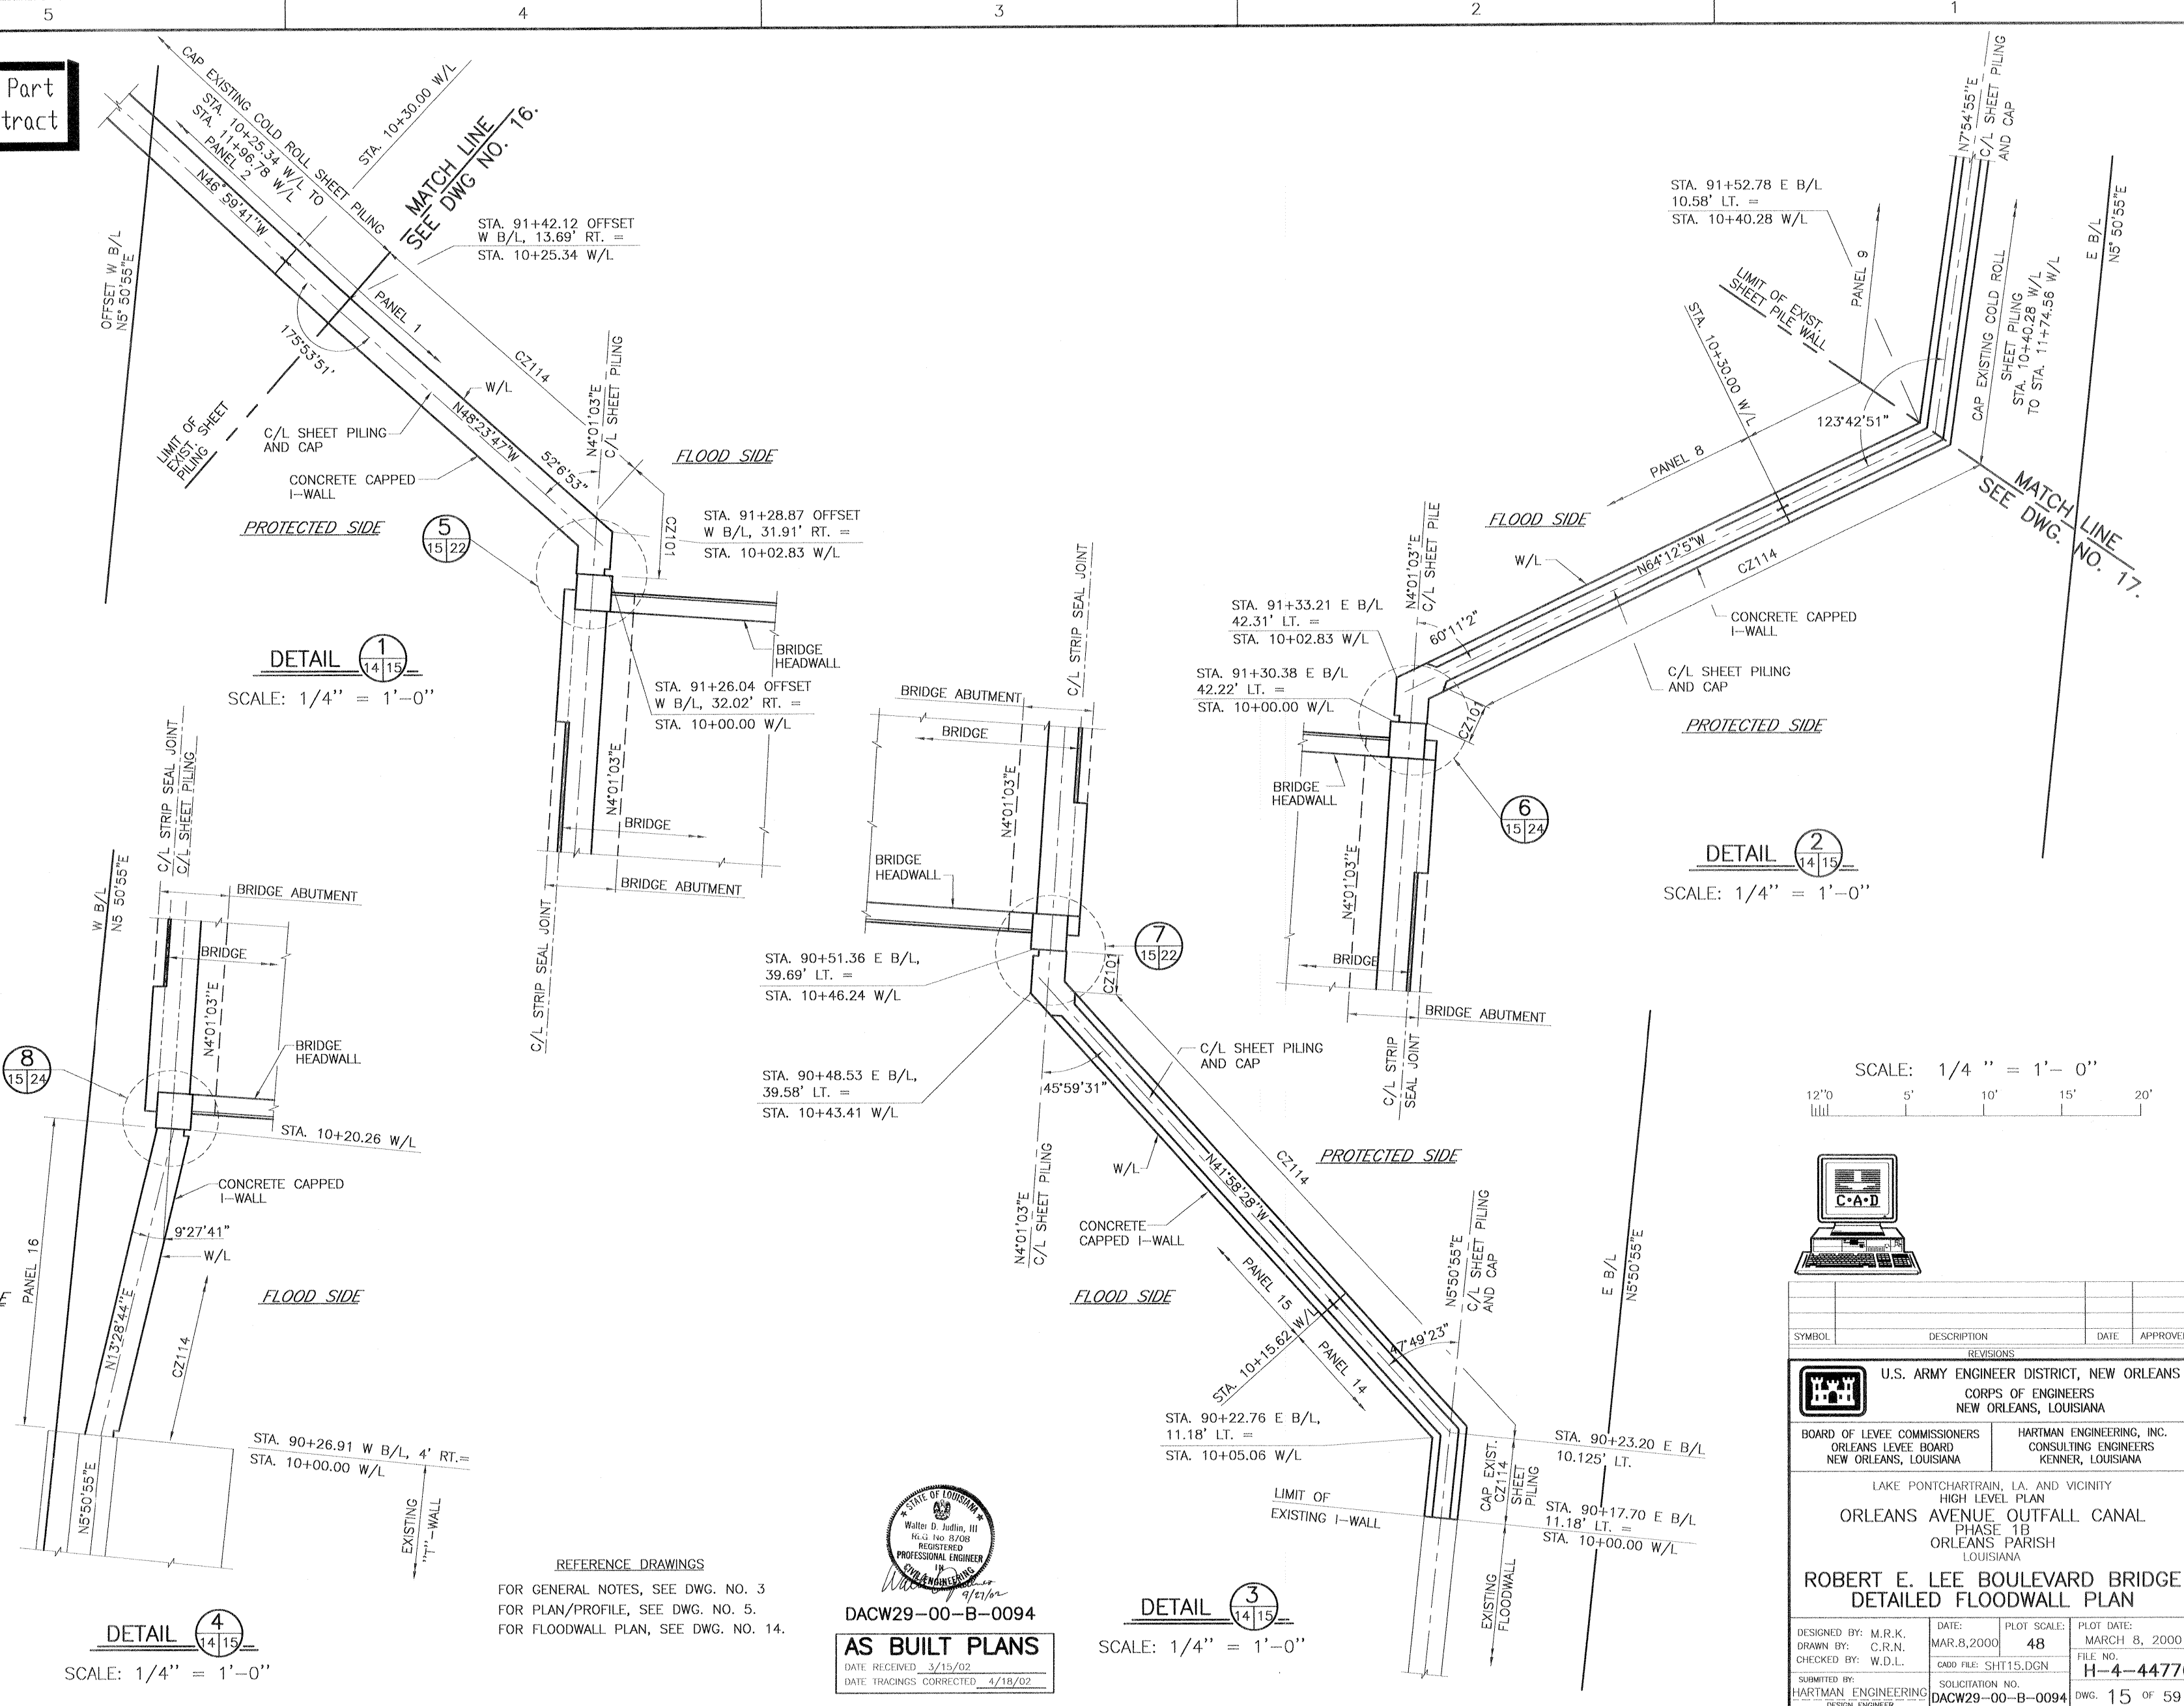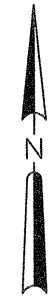

DETAIL 1
SCALE: 1/4" = 1'-0"

DETAIL 2
SCALE: 1/4" = 1'-0"


SCALE: 1/4" = 1'-0"
12' 0" 5' 10' 15' 20'

DETAIL 4
SCALE: 1/4" = 1'-0"

DETAIL 3
SCALE: 1/4" = 1'-0"

REFERENCE DRAWINGS
FOR GENERAL NOTES, SEE DWG. NO. 3
FOR PLAN/PROFILE, SEE DWG. NO. 5.
FOR FLOODWALL PLAN, SEE DWG. NO. 14.


STATE OF LOUISIANA
Walter B. Justice, III
REG. NO. 9708
REGISTERED PROFESSIONAL ENGINEER
IN MECHANICAL ENGINEERING
DATE RECEIVED: 3/15/02
DATE TRACINGS CORRECTED: 4/18/02
AS BUILT PLANS
DACW29-00-B-0094

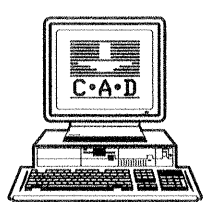

SYMBOL	DESCRIPTION	DATE	APPROVED
REVISIONS			
U.S. ARMY ENGINEER DISTRICT, NEW ORLEANS CORPS OF ENGINEERS NEW ORLEANS, LOUISIANA			
BOARD OF LEVEE COMMISSIONERS ORLEANS LEVEE BOARD NEW ORLEANS, LOUISIANA		HARTMAN ENGINEERING, INC. CONSULTING ENGINEERS KENNER, LOUISIANA	
LAKE PONTCHARTRAIN, LA. AND VICINITY HIGH LEVEL PLAN ORLEANS AVENUE OUTFALL CANAL PHASE 1B ORLEANS PARISH LOUISIANA			
ROBERT E. LEE BOULEVARD BRIDGE DETAILED FLOODWALL PLAN			
DESIGNED BY: M.R.K.	DATE: MAR. 8, 2000	PLOT SCALE: 48	PLOT DATE: MARCH 8, 2000
DRAWN BY: C.R.N.	CADD FILE: SHT15.DGN		FILE NO.
CHECKED BY: W.D.L.			H-4-44776
SUBMITTED BY: HARTMAN ENGINEERING	SOLICITATION NO. DACW29-00-B-0094		DWG. 15 OF 59




Safety is a Part of Your Contract

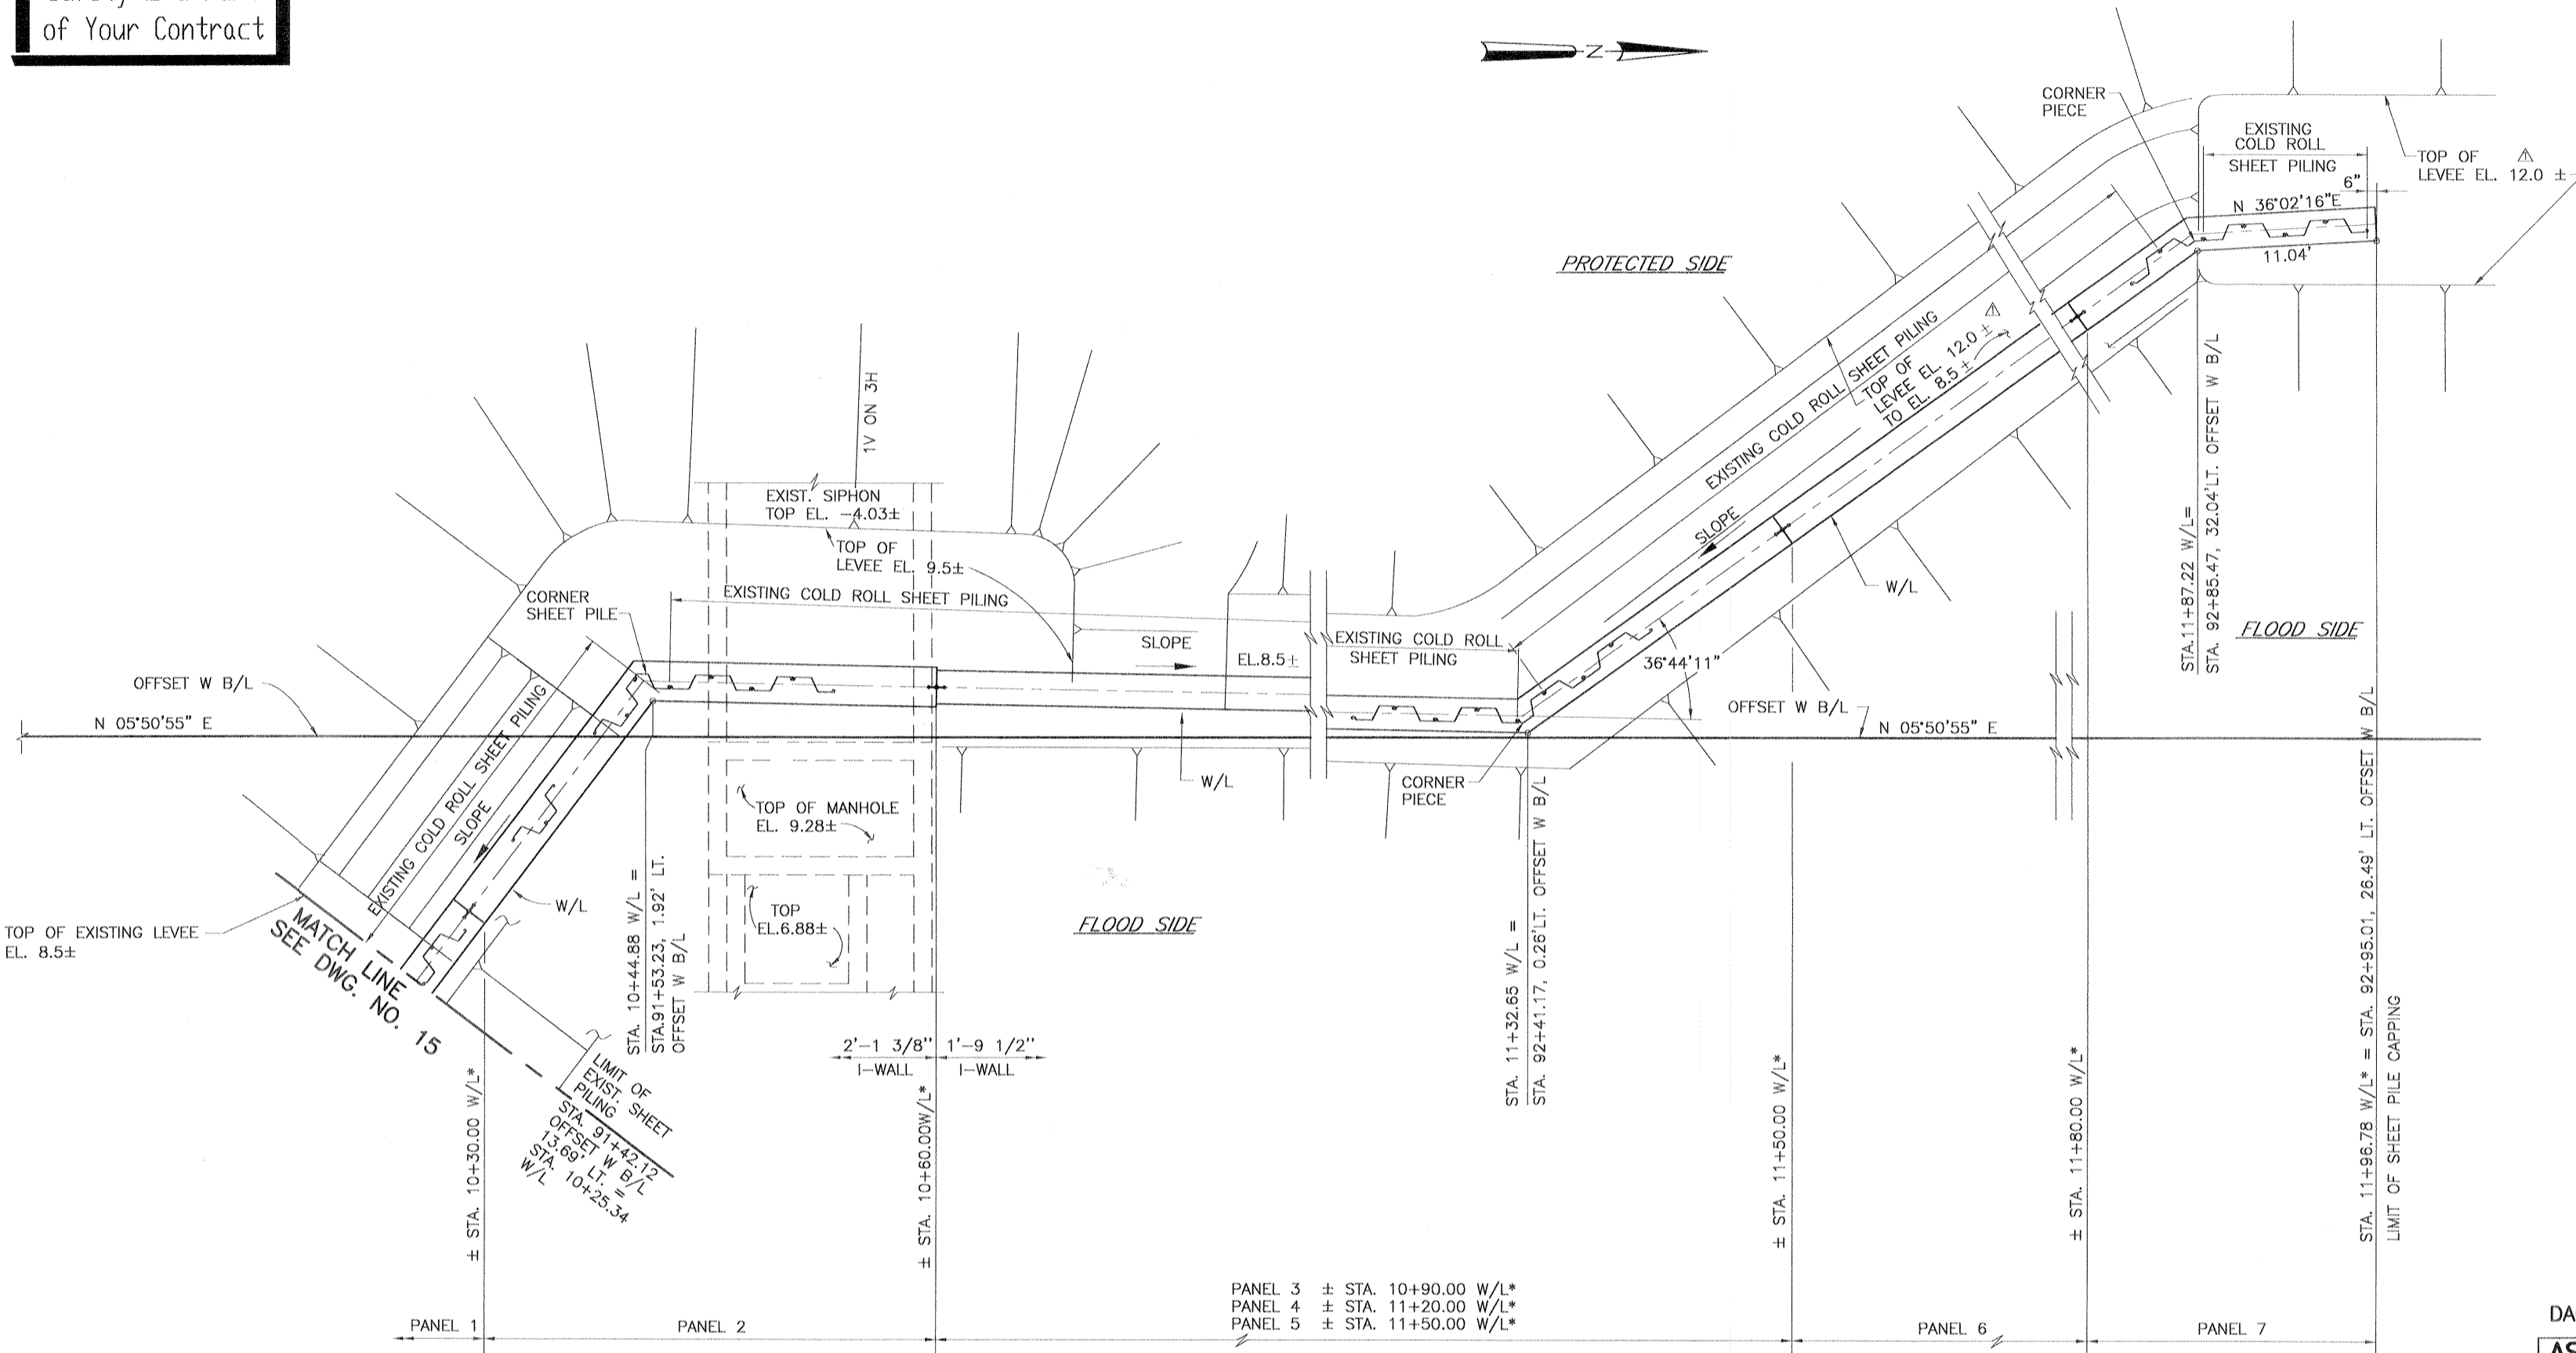

PANEL 3 ± STA. 10+90.00 W/L*
 PANEL 4 ± STA. 11+20.00 W/L*
 PANEL 5 ± STA. 11+50.00 W/L*


*PANELS TO END AT SHEET PILE INTERLOCK NEAREST TO THE WALL LINE STATION CALLED OUT ON THE DRAWING.

PLAN

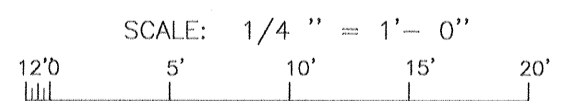

REFERENCE DRAWINGS

- FOR GENERAL NOTES, SEE DWG. NO. 3.
- FOR PLAN/PROFILE, SEE DWG. NO. 5.
- FOR FLOODWALL PLAN, SEE DWG. NO. 14.
- FOR WALL REINFORCEMENT, SEE DWG. NO. 27.
- FOR FLOODWALL PROFILES, SEE DWG. NOS. 18 AND 19.
- FOR OFFSET BASELINE, SEE DWG. NOS. 5 AND 14.

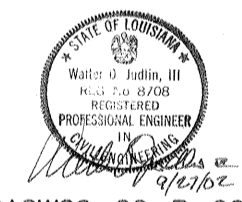

DACW29-00-B-0094
AS BUILT PLANS
 DATE RECEIVED 3/15/02
 DATE TRACINGS CORRECTED 4/18/02

SYMBOL	DESCRIPTION	DATE	APPROVED
△	CHANGED CONCRETE CAP & EXIST. SHEET PILE	04/03/01	W.D.J.

REVISIONS

U.S. ARMY ENGINEER DISTRICT, NEW ORLEANS
CORPS OF ENGINEERS
NEW ORLEANS, LOUISIANA


BOARD OF LEVEE COMMISSIONERS
 ORLEANS LEVEE BOARD
 NEW ORLEANS, LOUISIANA

HARTMAN ENGINEERING, INC.
 CONSULTING ENGINEERS
 KENNER, LOUISIANA


LAKE PONTCHARTRAIN, LA. AND VICINITY
 HIGH LEVEL PLAN
ORLEANS AVENUE OUTFALL CANAL
 PHASE 1B
 ORLEANS PARISH
 LOUISIANA

ROBERT E. LEE BOULEVARD BRIDGE
DETAILED FLOODWALL PLAN

DESIGNED BY: M.K.R.	DATE: MAR. 8, 2000	PLOT SCALE: 48	PLOT DATE: MARCH 8, 2000
DRAWN BY: L.A.C.	CADD FILE: SHT116.DGN	FILE NO. H-4-44776	
CHECKED BY: W.D.L.	SUBMITTED BY: HARTMAN ENGINEERING	SOLICITATION NO. DACW29-00-B-0094	DWG. 16 OF 59

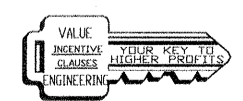

Safety is a Part
of Your Contract

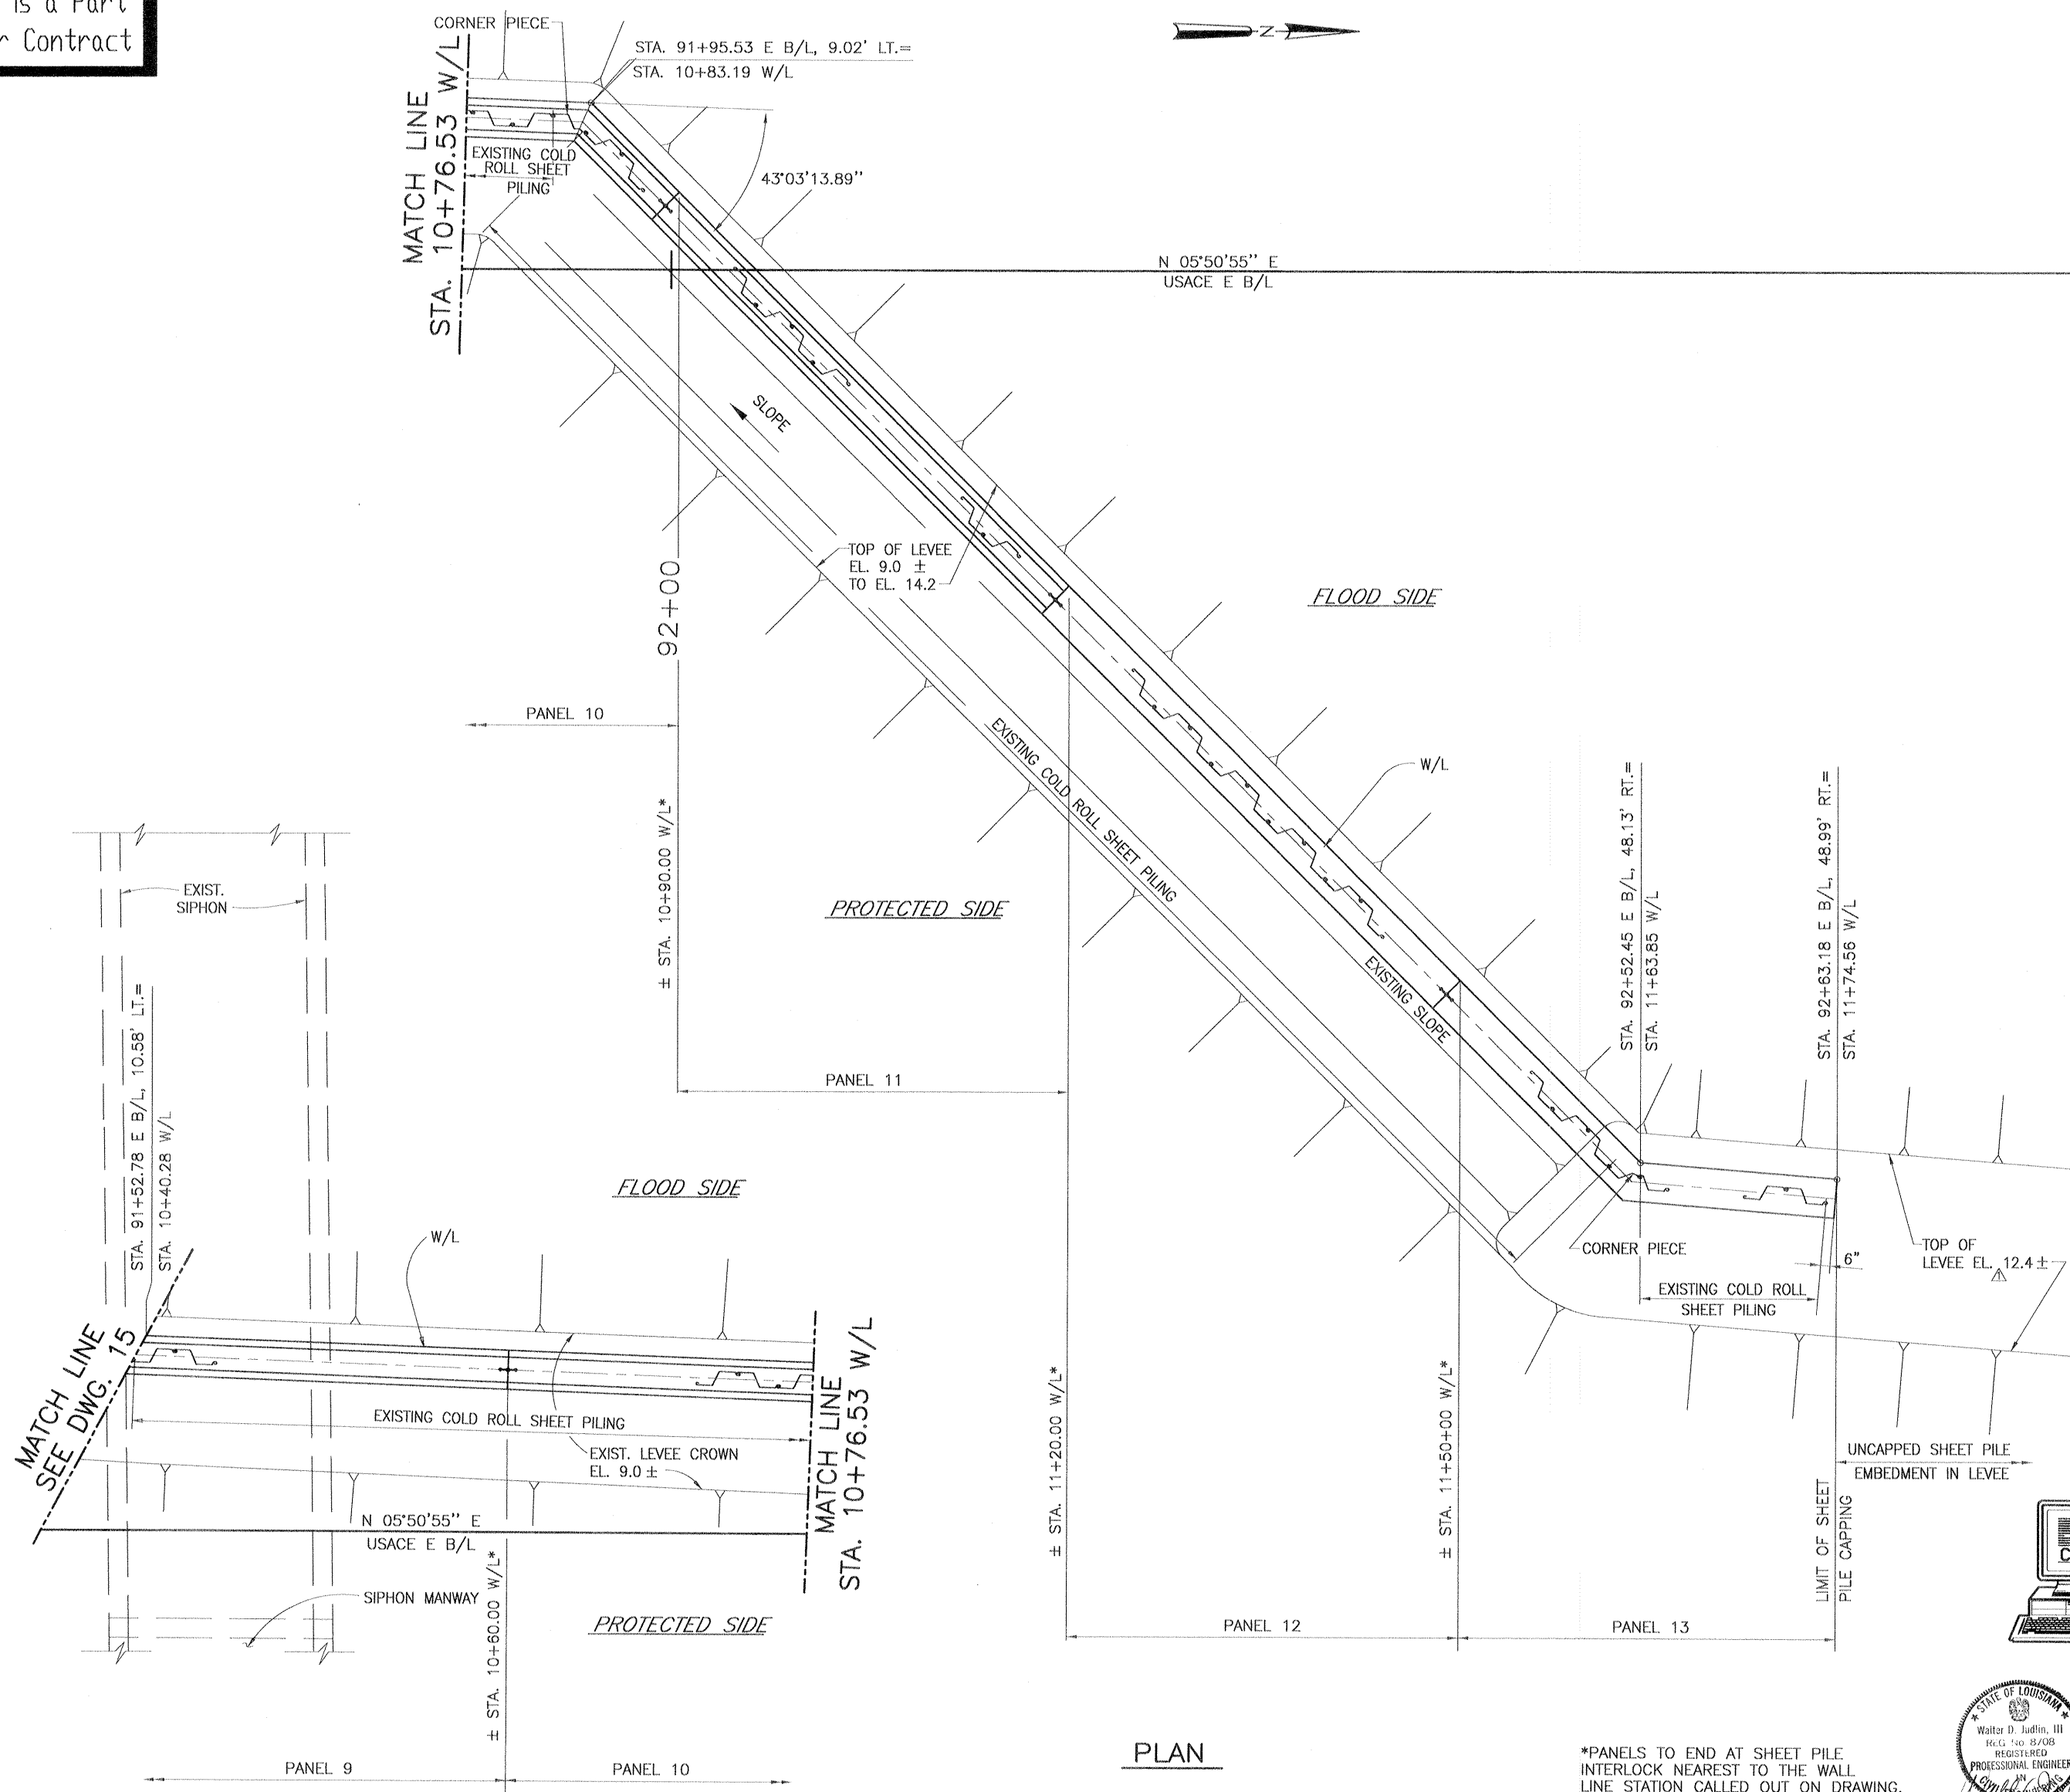

PLAN

SCALE: 1/4" = 1'-0"
12' 0" 5' 10' 15' 20'

*PANELS TO END AT SHEET PILE INTERLOCK NEAREST TO THE WALL LINE STATION CALLED OUT ON DRAWING.

REFERENCE DRAWINGS
FOR GENERAL NOTES, SEE DWG. NO. 3.
FOR PLAN/PROFILE, SEE DWG. NO. 5.
FOR FLOODWALL PLAN, SEE DWG. NO. 14.
FOR WALL REINFORCEMENT, SEE DWG. NO. 27.
FOR FLOODWALL PROFILES, SEE DWG. NOS. 18 AND 19.

SYMBOL	DESCRIPTION	DATE	APPROVED
△	CHANGED CONCRETE CAP & EXIST. SHEET PILE	03/13/01	W.D.J.

REVISIONS

U.S. ARMY ENGINEER DISTRICT, NEW ORLEANS CORPS OF ENGINEERS NEW ORLEANS, LOUISIANA	HARTMAN ENGINEERING, INC. CONSULTING ENGINEERS KENNER, LOUISIANA
------------------------------------------------------------------------------------------	------------------------------------------------------------------------


LAKE PONTCHARTRAIN, LA. AND VICINITY
HIGH LEVEL PLAN
ORLEANS AVENUE OUTFALL CANAL
PHASE 1B
ORLEANS PARISH
LOUISIANA

ROBERT E. LEE BOULEVARD BRIDGE
DETAILED FLOODWALL PLAN


DESIGNED BY: M.K.R.	DATE: MAR. 8, 2000	PLOT SCALE: 48	PLOT DATE: MARCH 8, 2000
DRAWN BY: C.R.N.	CADD FILE: SHT17.DGN	SOLICITATION NO. DACW29-00-B-0029	FILE NO. H-4-44776
CHECKED BY: W.D.L.	DATE TRACINGS CORRECTED: 4/18/02	DATE RECEIVED: 3/15/02	DWG. NO. 17 OF 59



DACW29-00-B-0094
AS BUILT PLANS
DATE RECEIVED: 3/15/02
DATE TRACINGS CORRECTED: 4/18/02

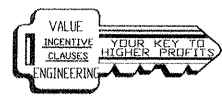


Safety is a Part of Your Contract

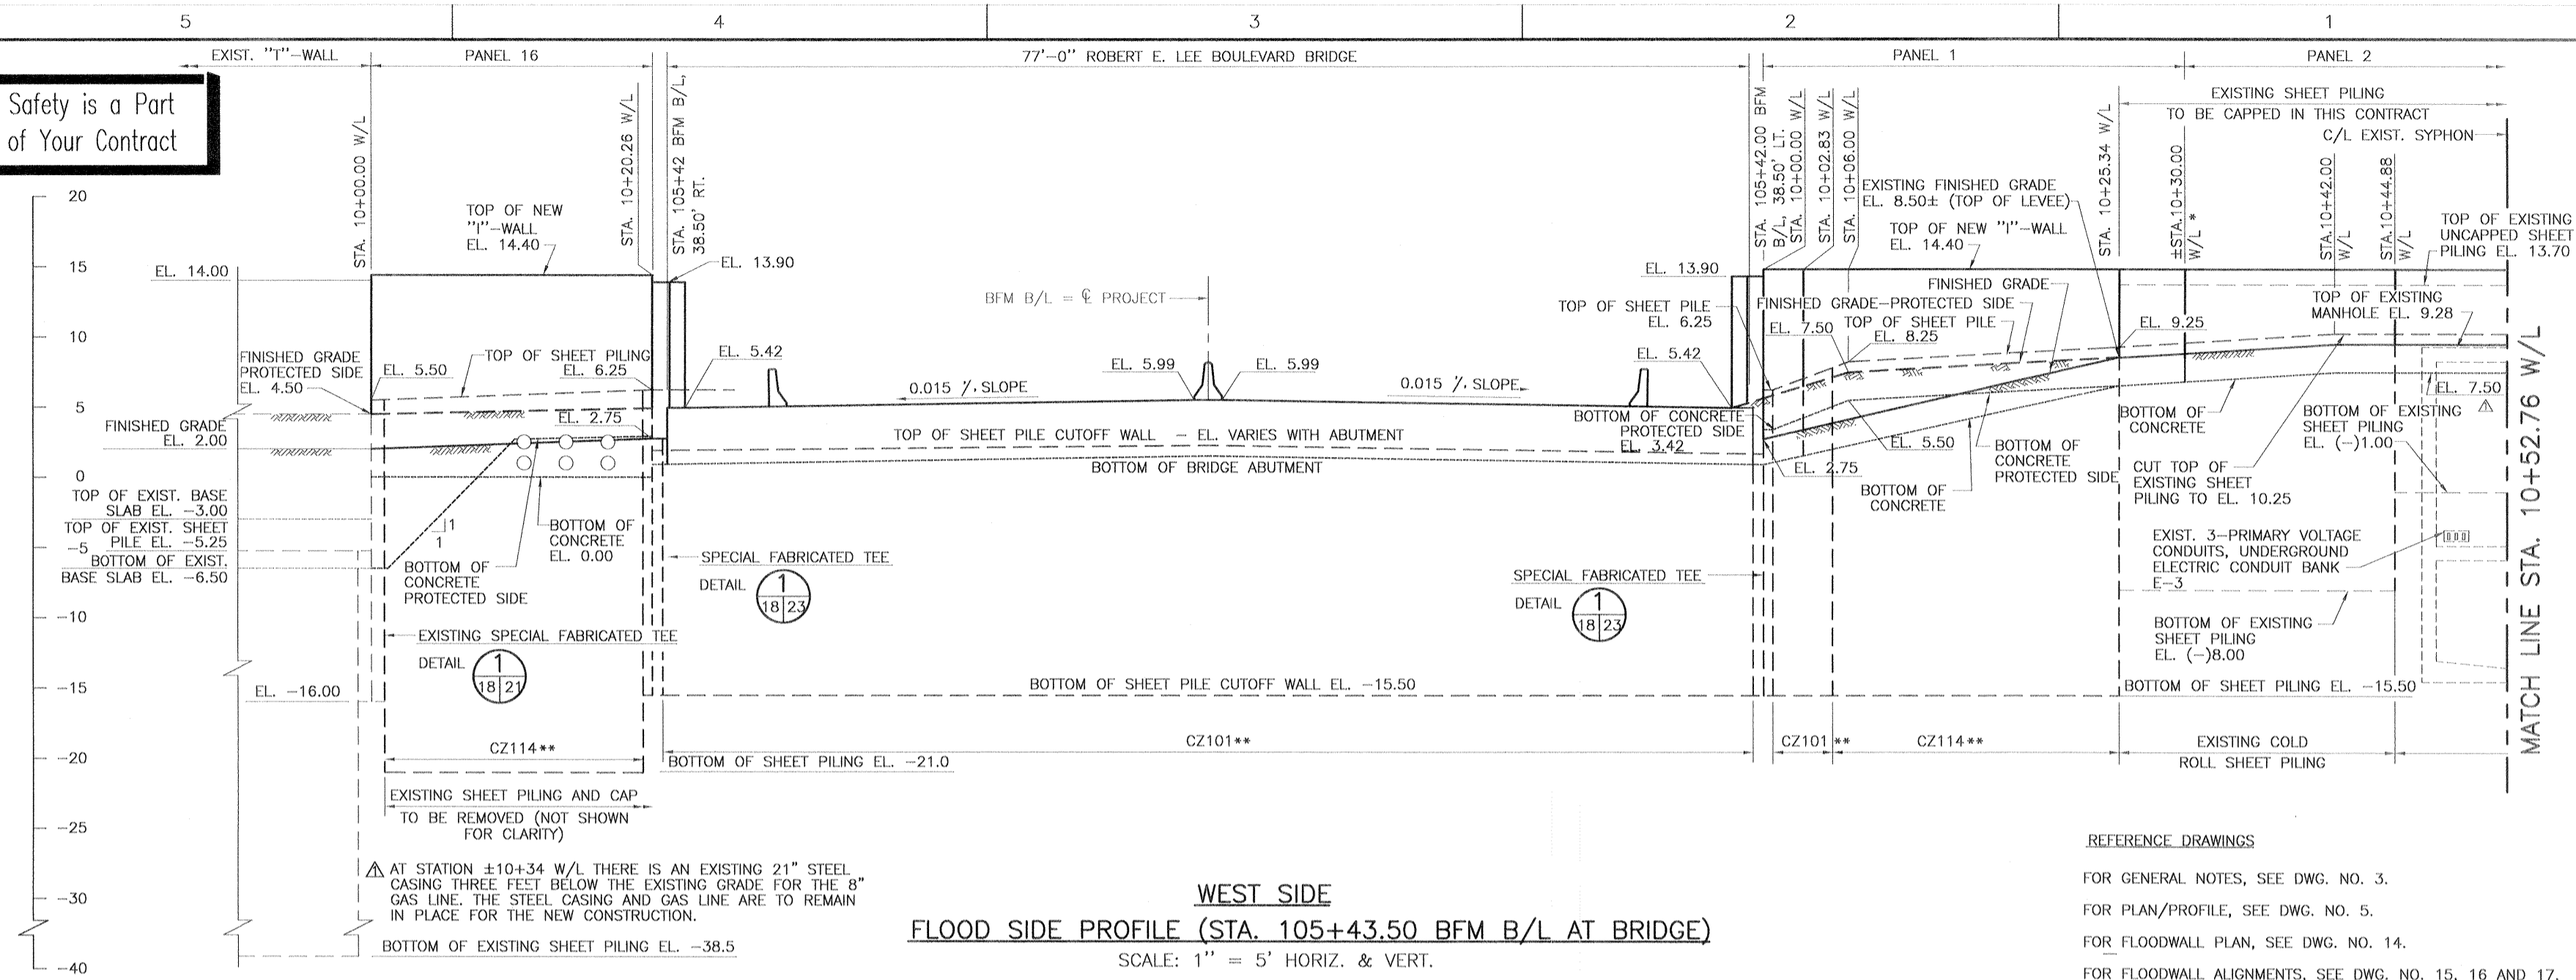

**WEST SIDE
FLOOD SIDE PROFILE (STA. 105+43.50 BFM B/L AT BRIDGE)**
SCALE: 1" = 5' HORIZ. & VERT.


REFERENCE DRAWINGS
 FOR GENERAL NOTES, SEE DWG. NO. 3.
 FOR PLAN/PROFILE, SEE DWG. NO. 5.
 FOR FLOODWALL PLAN, SEE DWG. NO. 14.
 FOR FLOODWALL ALIGNMENTS, SEE DWG. NO. 15, 16 AND 17.
 FOR FLOODWALL PLAN OF UNCAPPED SHEET PILING, SEE DWG. NOS. 16 AND 17.

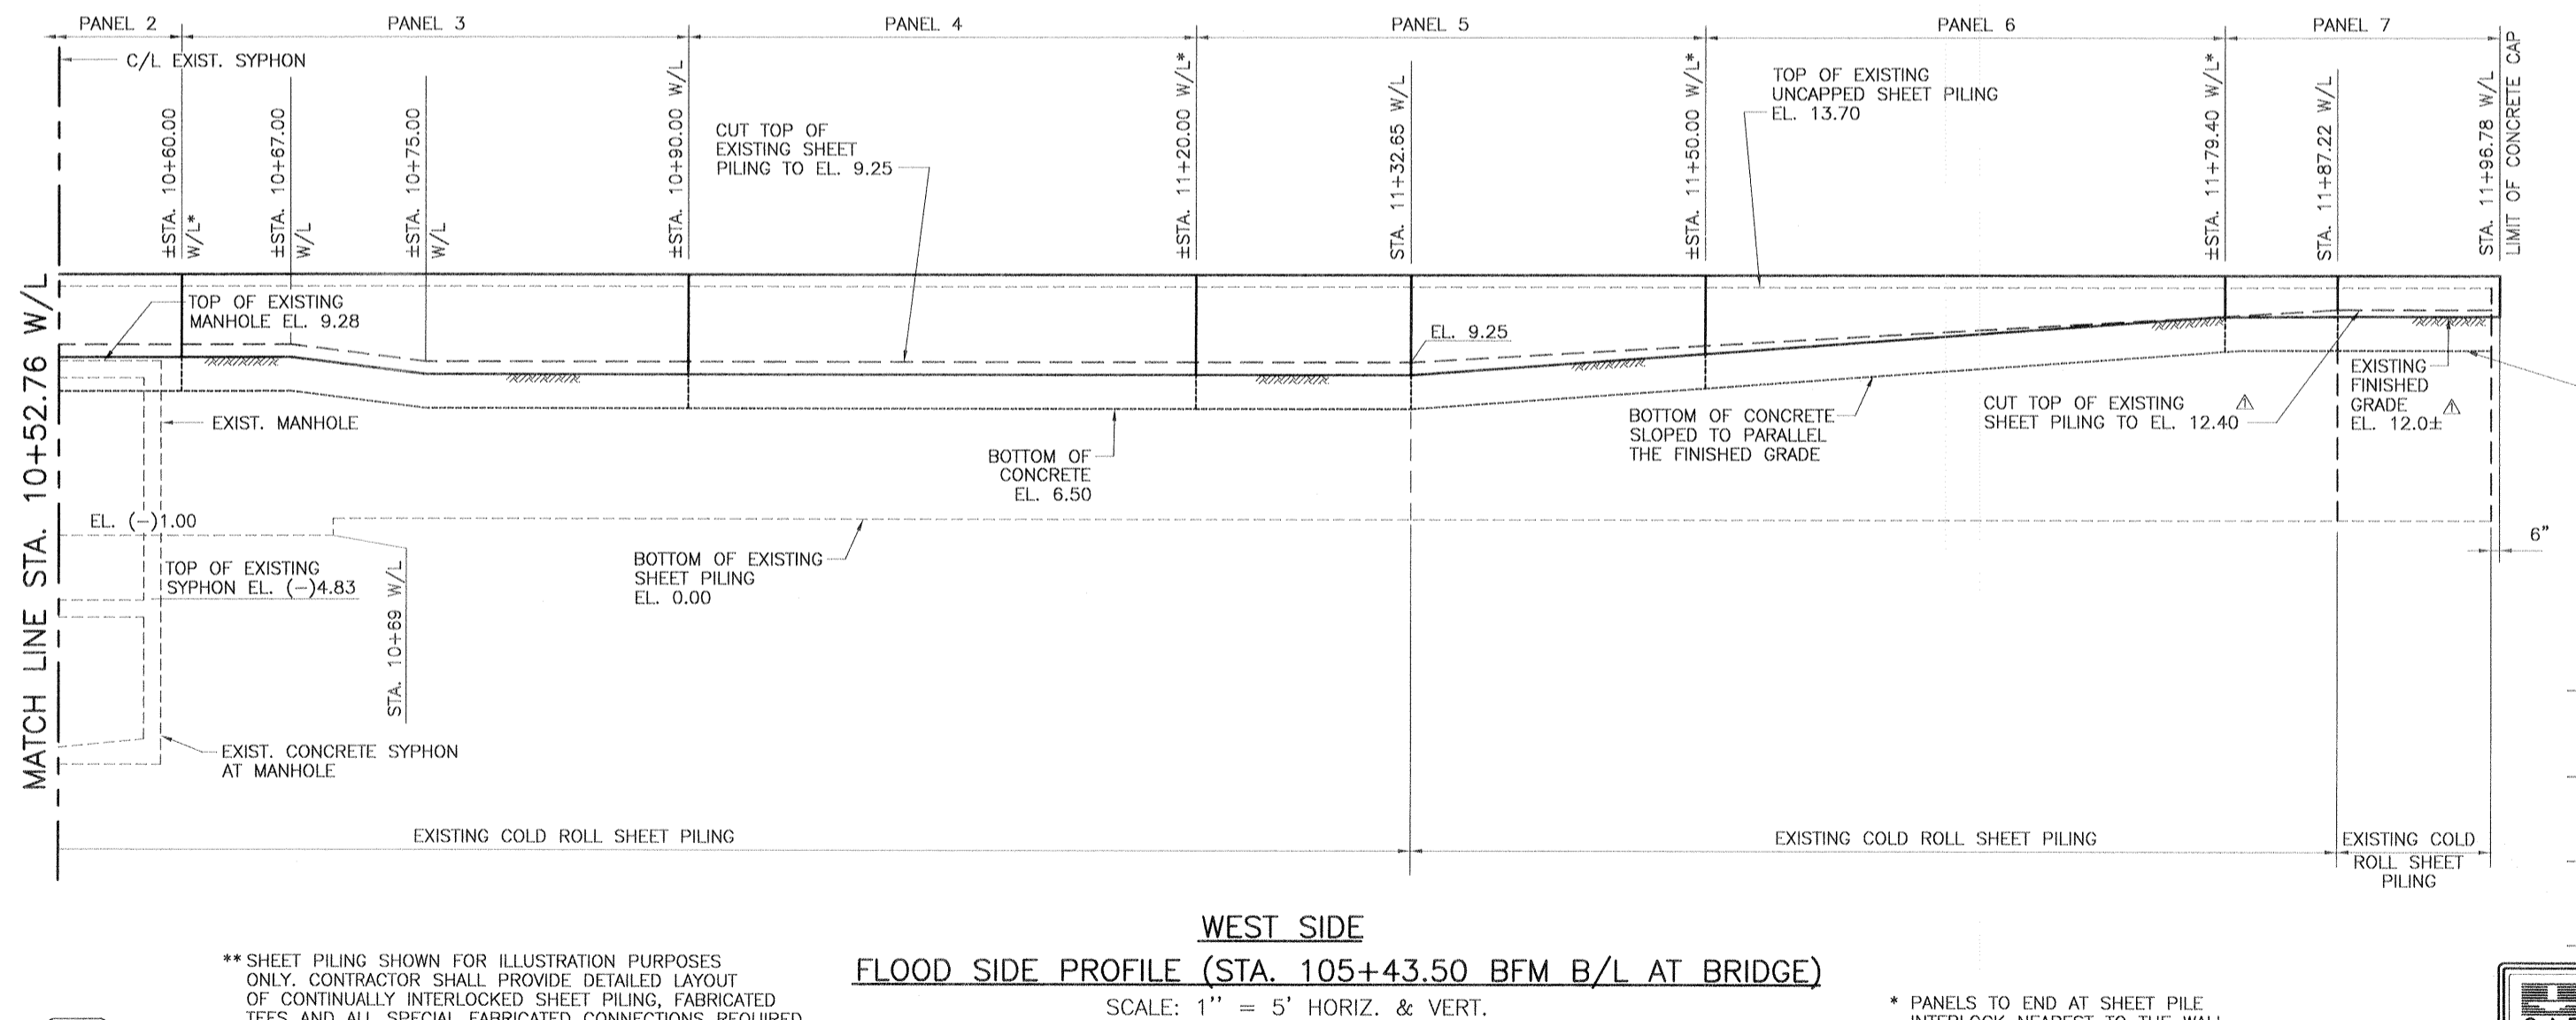

**WEST SIDE
FLOOD SIDE PROFILE (STA. 105+43.50 BFM B/L AT BRIDGE)**
SCALE: 1" = 5' HORIZ. & VERT.

** SHEET PILING SHOWN FOR ILLUSTRATION PURPOSES ONLY. CONTRACTOR SHALL PROVIDE DETAILED LAYOUT OF CONTINUALLY INTERLOCKED SHEET PILING, FABRICATED TEES AND ALL SPECIAL FABRICATED CONNECTIONS REQUIRED.

* PANELS TO END AT SHEET PILE INTERLOCK NEAREST TO THE WALL LINE STATION CALLED OUT ON THE DRAWING.

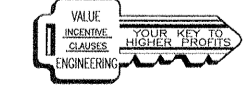

DACW29-00-B-0094
AS BUILT PLANS
 DATE RECEIVED 3/15/02
 DATE TRACINGS CORRECTED 4/18/02

SYMBOL	DESCRIPTION	DATE	APPROVED
△	CHANGED CONCRETE CAP & EXIST. SHEET PILE	03/13/01	W.D.J.

U.S. ARMY ENGINEER DISTRICT, NEW ORLEANS
CORPS OF ENGINEERS
NEW ORLEANS, LOUISIANA

BOARD OF LEVEE COMMISSIONERS
 ORLEANS LEVEE BOARD
 NEW ORLEANS, LOUISIANA


HARTMAN ENGINEERING, INC.
 CONSULTING ENGINEERS
 KENNER, LOUISIANA

LAKE PONTCHARTRAIN, LA. AND VICINITY
 HIGH LEVEL PLAN
ORLEANS AVENUE OUTFALL CANAL
 PHASE 1B
 ORLEANS PARISH
 LOUISIANA

ROBERT E. LEE BOULEVARD BRIDGE
FLOODWALL PROFILE - WEST SIDE


DESIGNED BY: M.K.R.	DATE: MAR. 8, 2000	PLOT SCALE: 60	PLOT DATE: MARCH 8, 2000
DRAWN BY: L.A.C.	CADD FILE: SHT18.DGN	FILE NO. H-4-44776	
CHECKED BY: W.D.L.	SOLICITATION NO. DACW29-00-B-0094	DWG. 18	OF 59

Safety is a Part of Your Contract

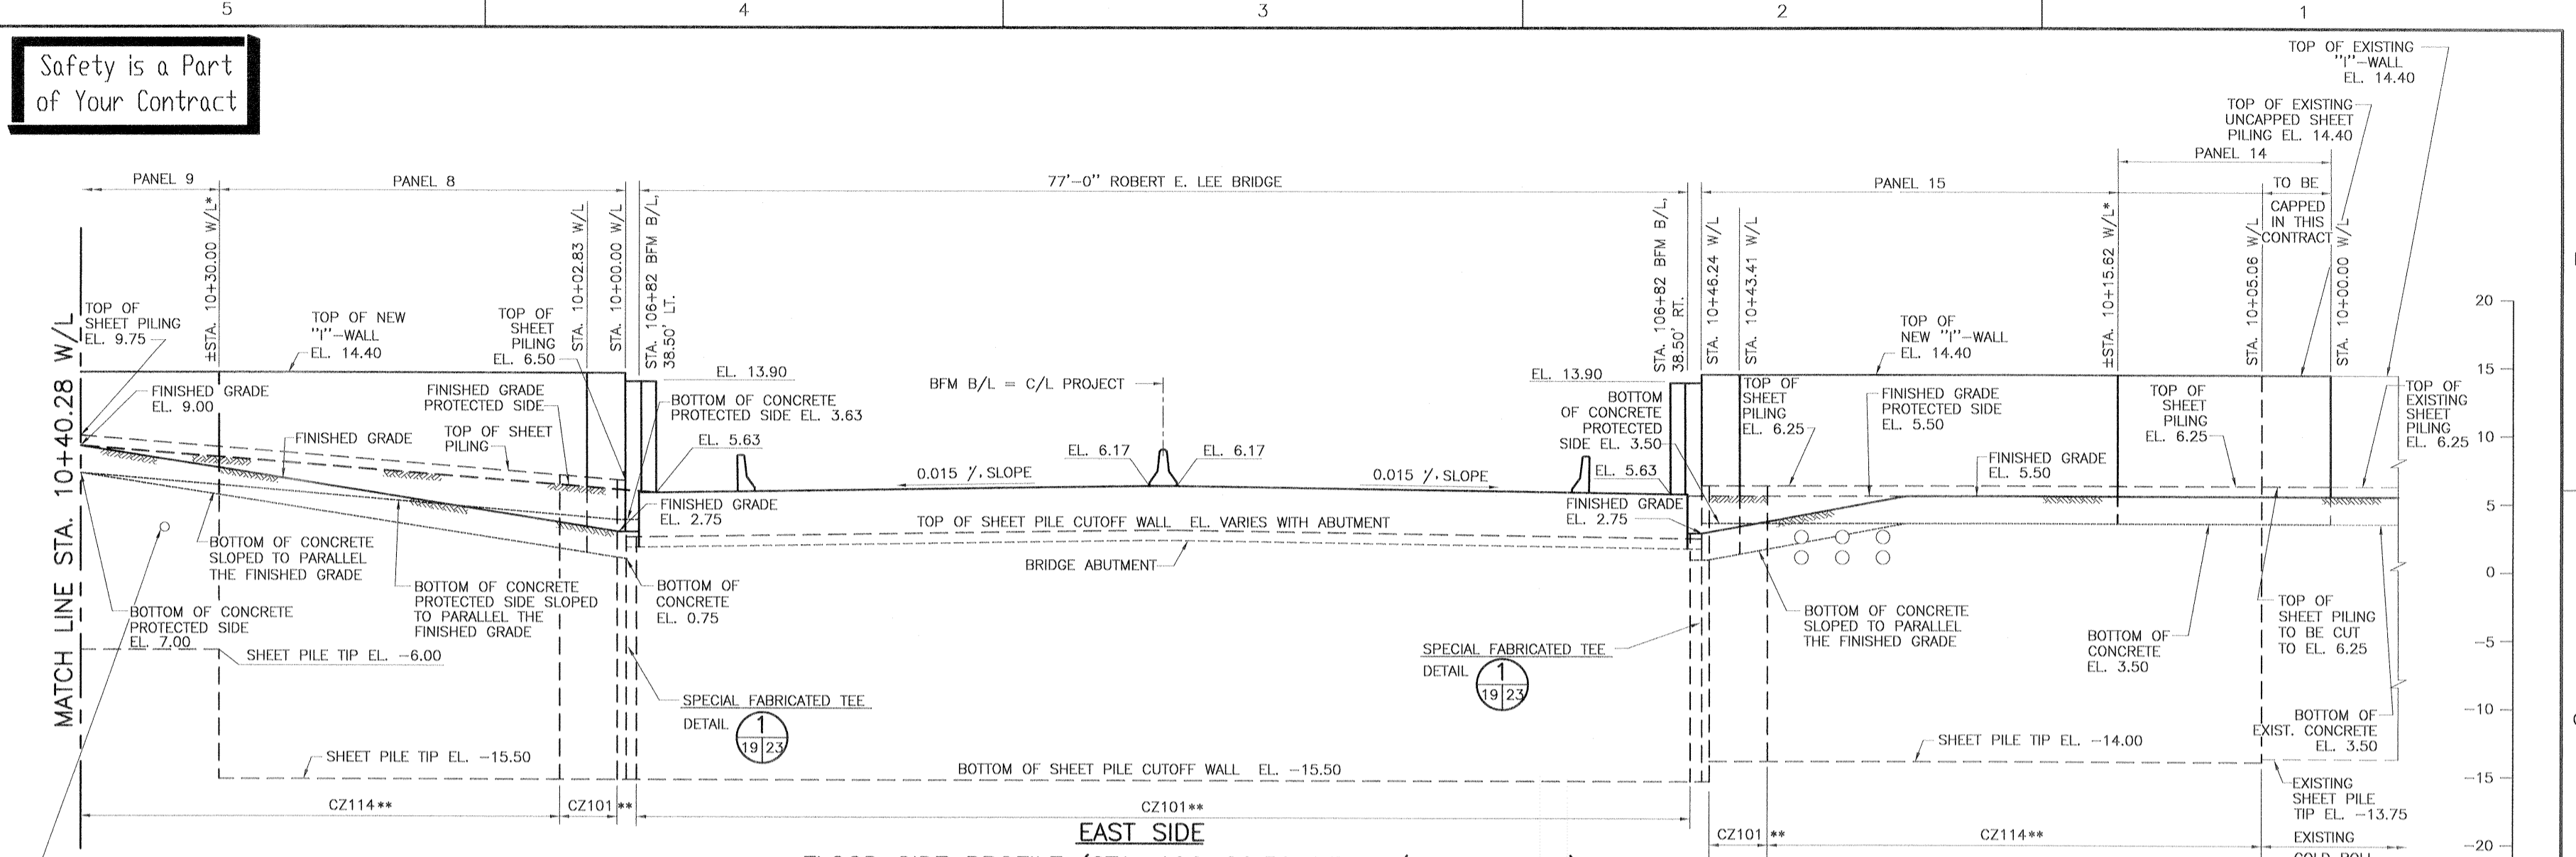

EAST SIDE
FLOOD SIDE PROFILE (STA. 106+80.50 BFM B/L AT BRIDGE)
 SCALE: 1" = 5' (HOR. & VERT.)

AT STATION ±10+41 W/L THERE IS AN EXISTING 8" GAS LINE THREE FEET BELOW THE EXISTING GRADE. THE CONTRACTOR IS REQUIRED TO INSTALL A 21" STEEL CASING FOR THIS GAS LINE. THE UTILITY OWNER WILL REMOVE THE GAS LINE WHILE THE CONTRACTOR INSTALLS THE SHEET PILING AND CASING.

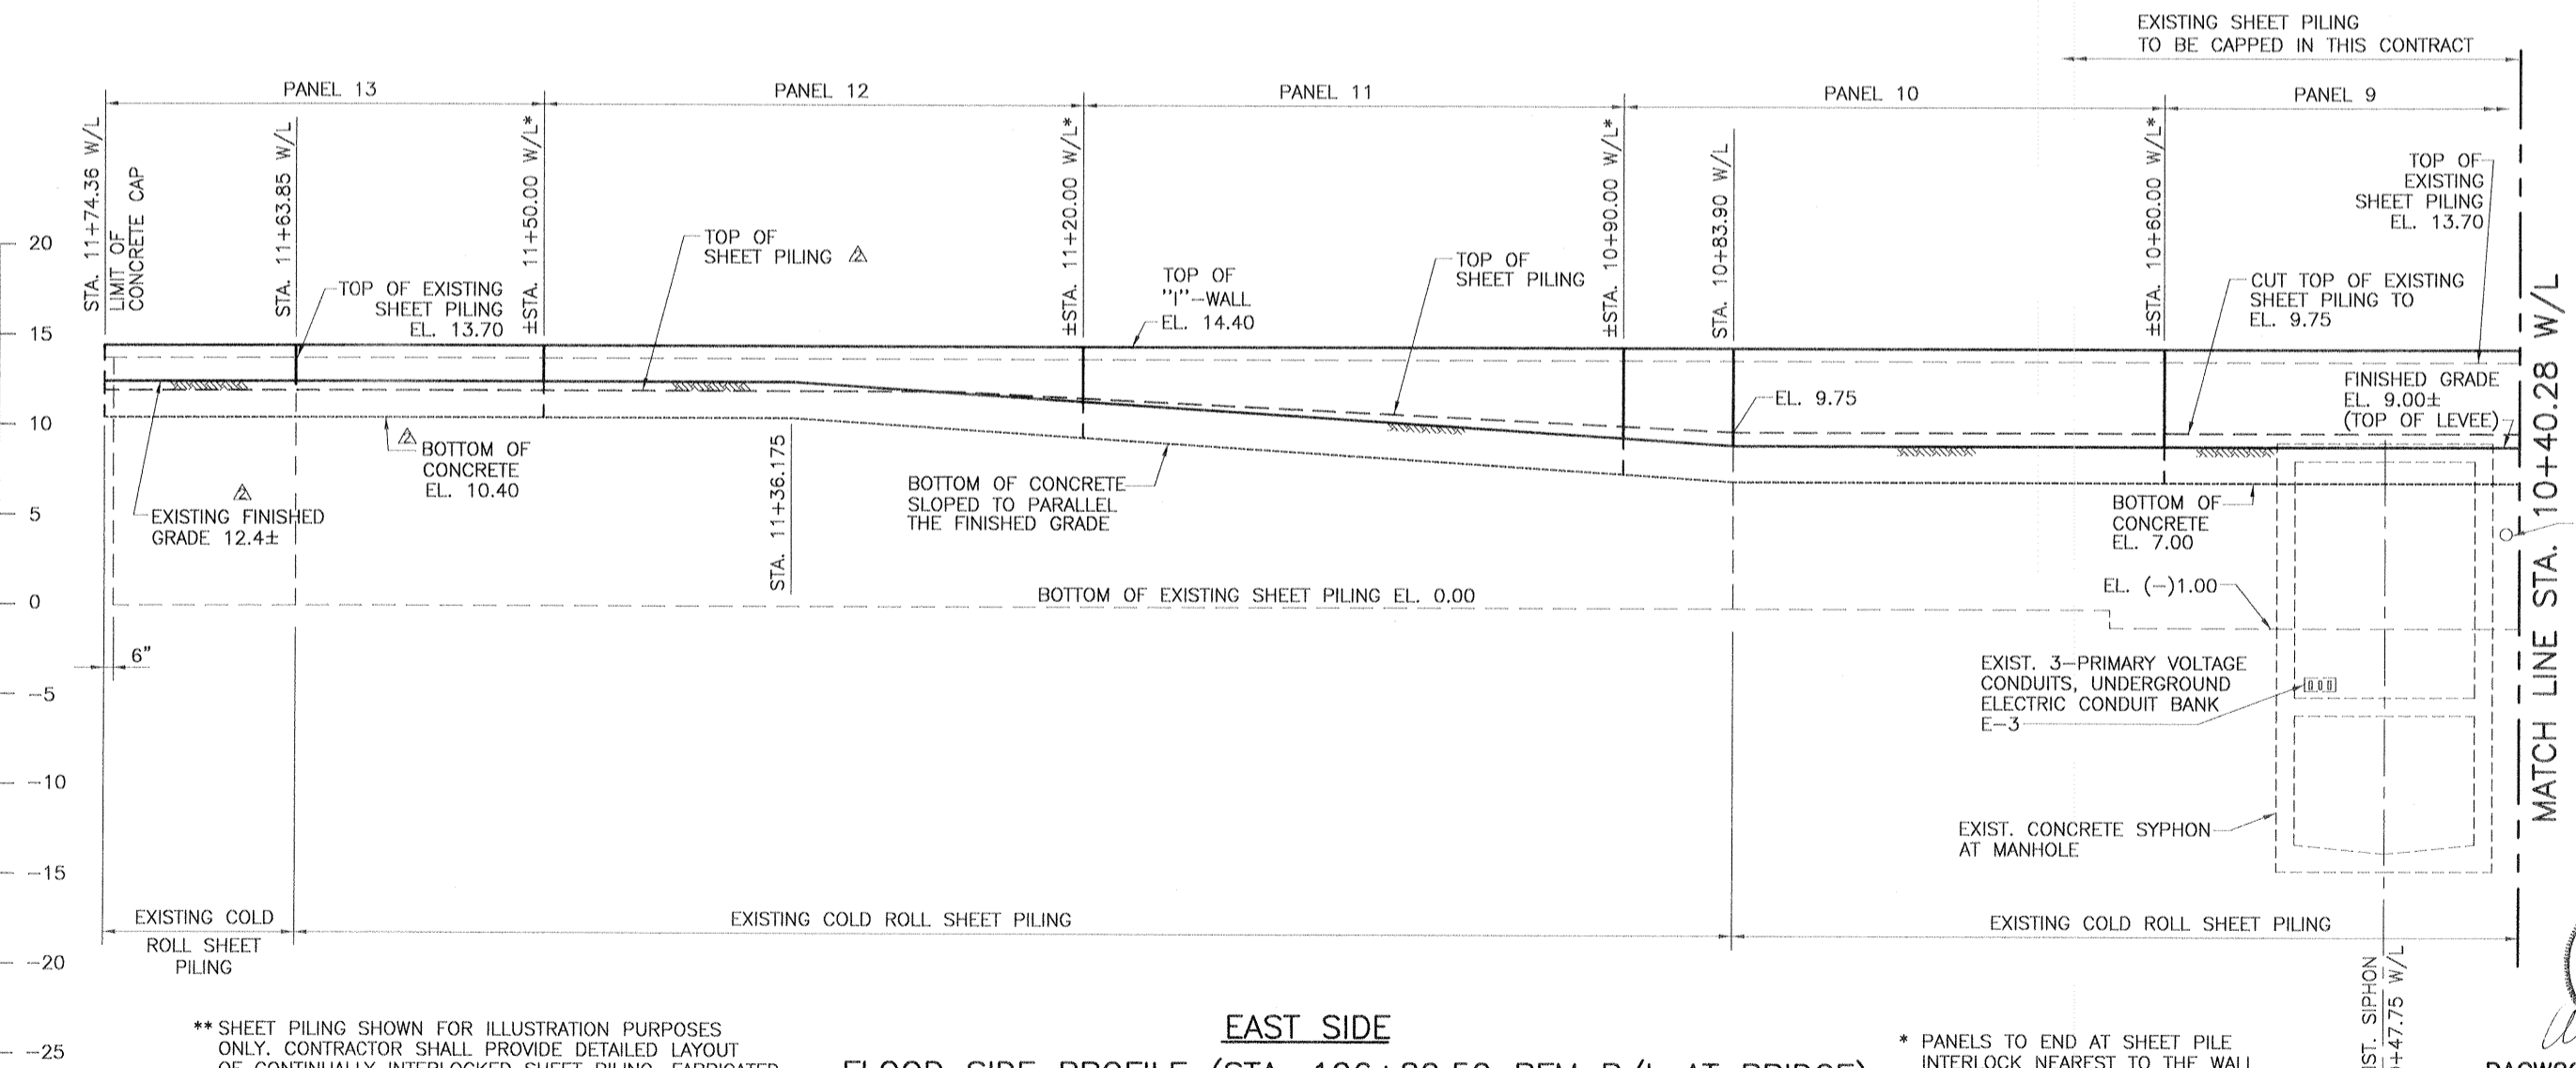


EAST SIDE
FLOOD SIDE PROFILE (STA. 106+80.50 BFM B/L AT BRIDGE)
 SCALE: 1" = 5' (HOR. & VERT.)

** SHEET PILING SHOWN FOR ILLUSTRATION PURPOSES ONLY. CONTRACTOR SHALL PROVIDE DETAILED LAYOUT OF CONTINUALLY INTERLOCKED SHEET PILING, FABRICATED TEES AND ALL SPECIAL FABRICATED CONNECTIONS REQUIRED.

- REFERENCE DRAWINGS**
- FOR GENERAL NOTES, SEE DWG. NO. 3.
 - FOR PLAN/PROFILE, SEE DWG. NO. 5.
 - FOR FLOODWALL PLAN, SEE DWG. NO. 14.
 - FOR FLOODWALL ALIGNMENTS, SEE DWG. NO. 15, 16 AND 17.
 - FOR FLOODWALL PLAN OF UNCAPPED SHEET PILING, SEE DWG. NOS. 16 AND 17.

RELOCATED 8" GAS PIPELINE
 107+14.62 BFM BL 62.98' LT.
 T.O.P. EL. 4.60

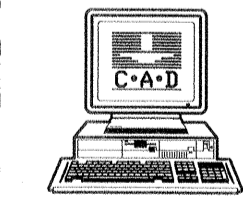

SYMBOL	DESCRIPTION	DATE	APPROVED
△	CHANGED CONCRETE CAP & EXIST. SHEET PILE	03/15/01	W.D.J.
△	NOTE FOR INSTALLATION OF 21" STEEL CASING	08/14/00	W.D.J.

U.S. ARMY ENGINEER DISTRICT, NEW ORLEANS
 CORPS OF ENGINEERS
 NEW ORLEANS, LOUISIANA

BOARD OF LEVEE COMMISSIONERS
 ORLEANS LEVEE BOARD
 NEW ORLEANS, LOUISIANA


HARTMAN ENGINEERING, INC.
 CONSULTING ENGINEERS
 KENNER, LOUISIANA

LAKE PONCHARTRAIN, LA. AND VICINITY
 HIGH LEVEL PLAN
 ORLEANS AVENUE OUTFALL CANAL
 PHASE 1B
 ORLEANS PARISH
 LOUISIANA


ROBERT E. LEE BOULEVARD BRIDGE
FLOODWALL PROFILE - EAST SIDE

DACW29-00-B-0094
AS BUILT PLANS
 DATE RECEIVED: 3/15/02
 DATE TRACINGS CORRECTED: 4/18/02

DESIGNED BY: M.K.R.	DATE: MAR. 8, 2000	PLOT SCALE: 60	PLOT DATE: MARCH 8, 2000
DRAWN BY: C.R.N.	CADD FILE: SHT19.DGN	FILE NO. H-4-44776	
CHECKED BY: W.D.L.	SUBMITTED BY: HARTMAN ENGINEERING	SOLICITATION NO. DACW29-00-B-0094	DWG. 19 OF 59

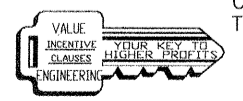


Safety is a Part of Your Contract

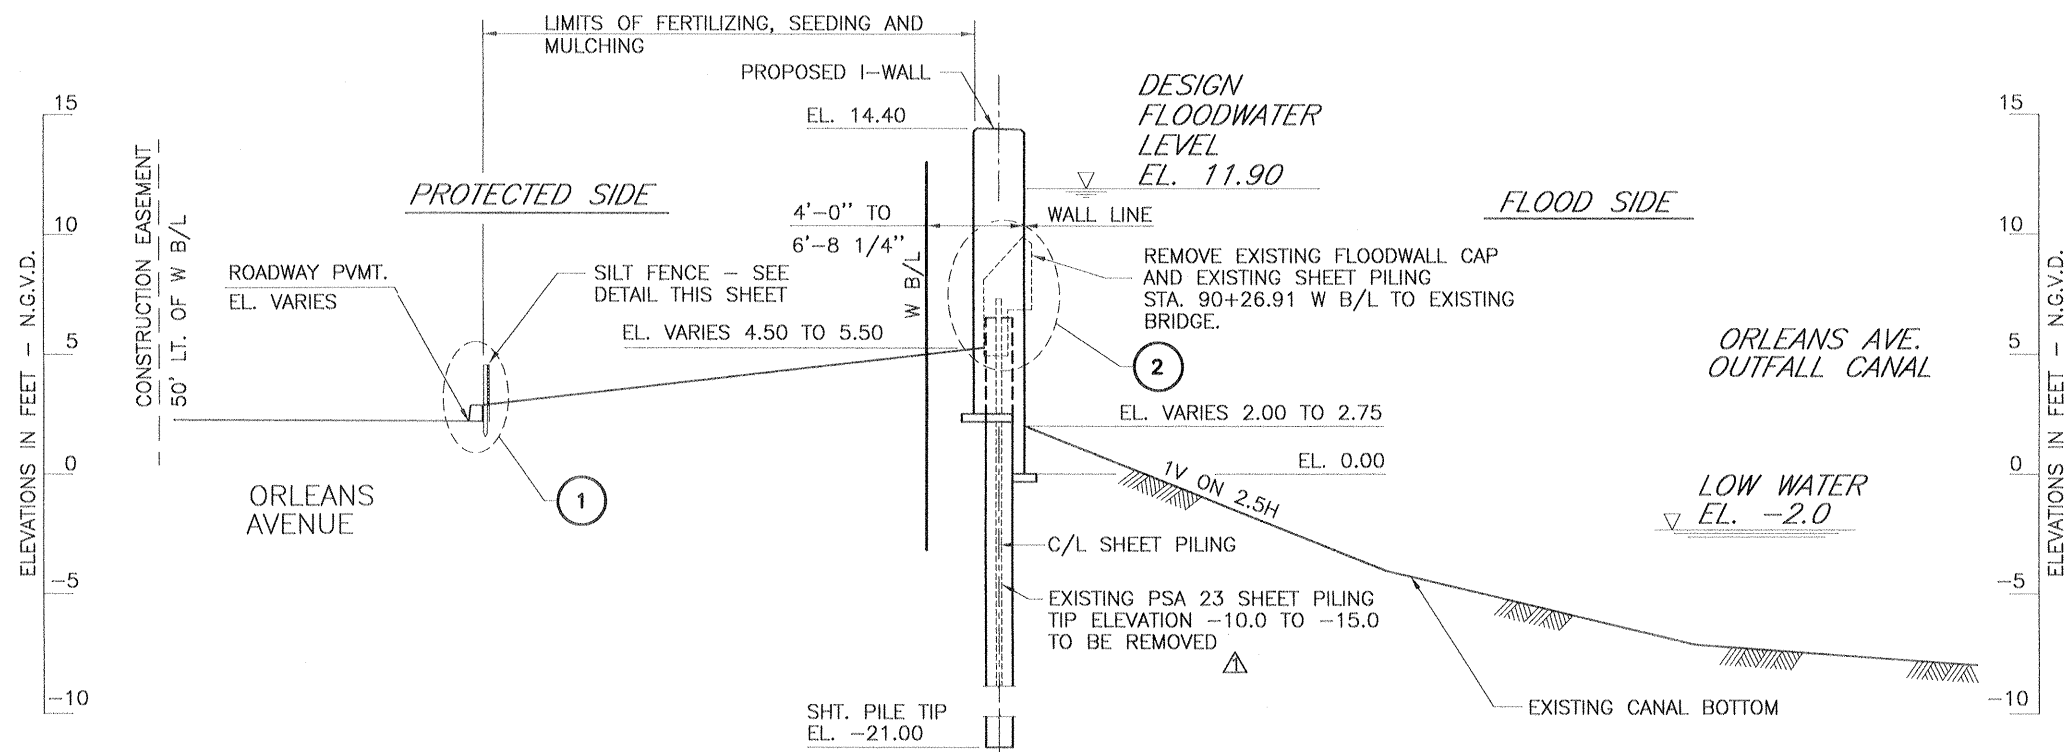

STATION 90+26.91 W B/L TO STATION 90+46.80 W B/L
STATION 10+00.00 W/L TO STATION 10+20.26 W/L

I-WALL SECTION


SCALE: 1/4" = 1' - 0"

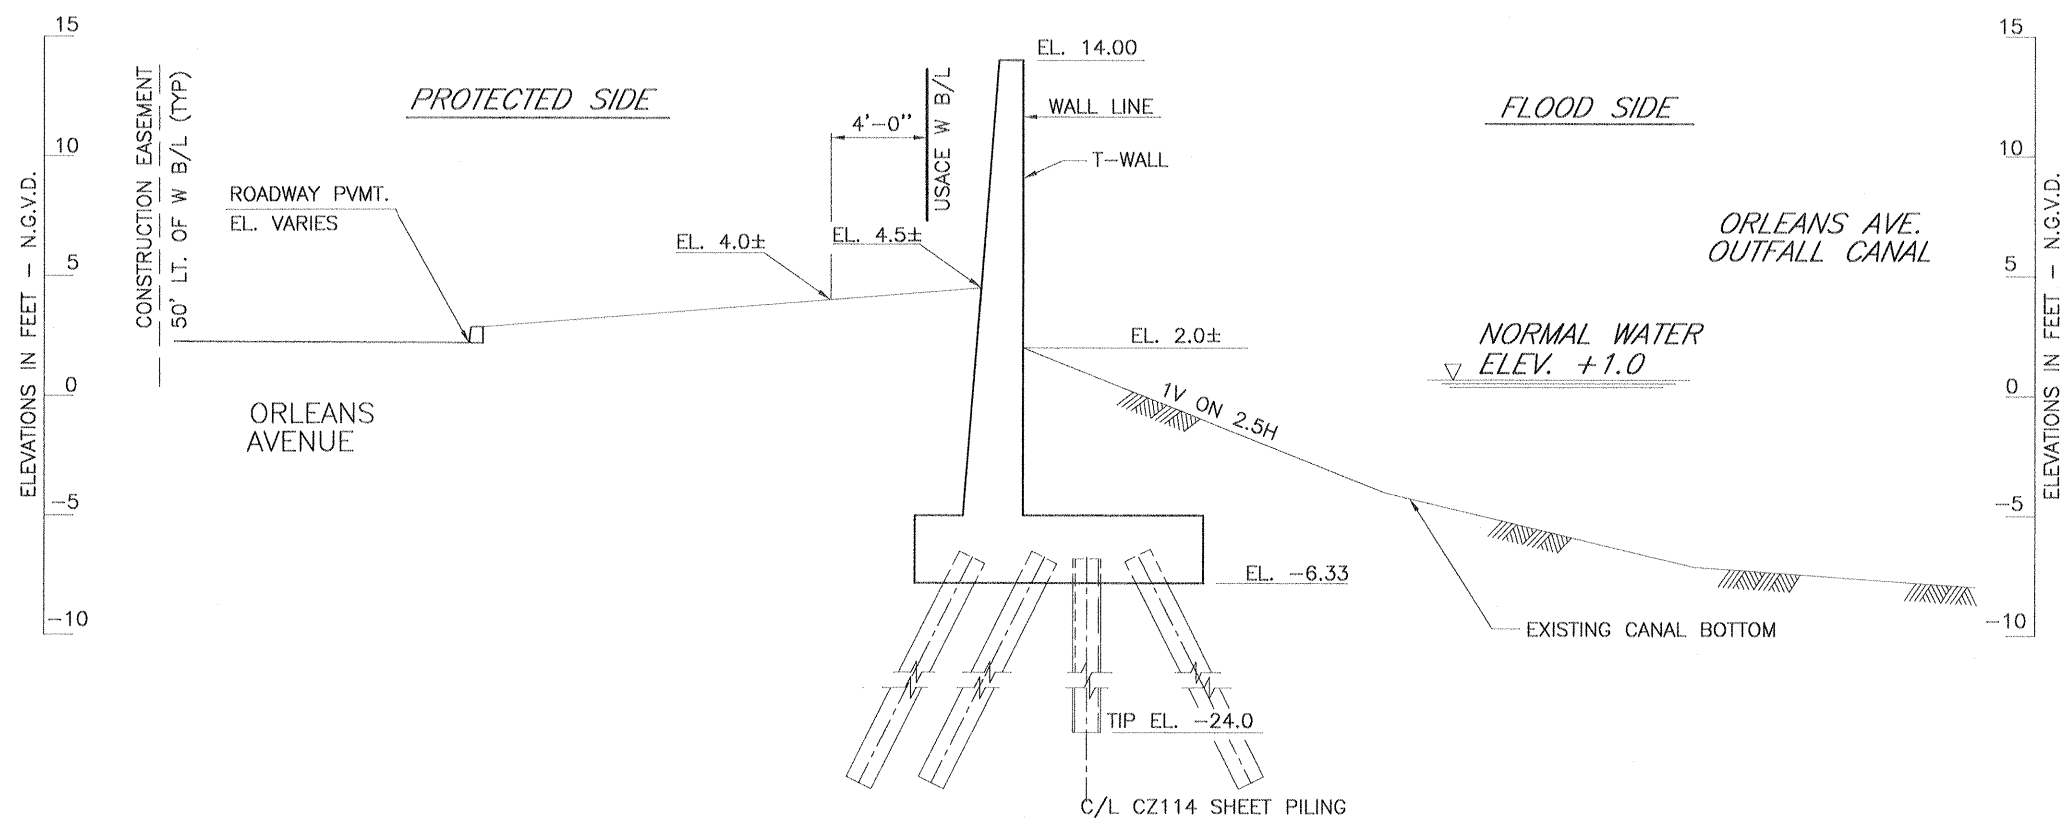

STATION 64+51.53 W B/L TO STATION 90+26.91 W B/L

EXISTING T-WALL SECTION

SCALE: 1/4" = 1' - 0"

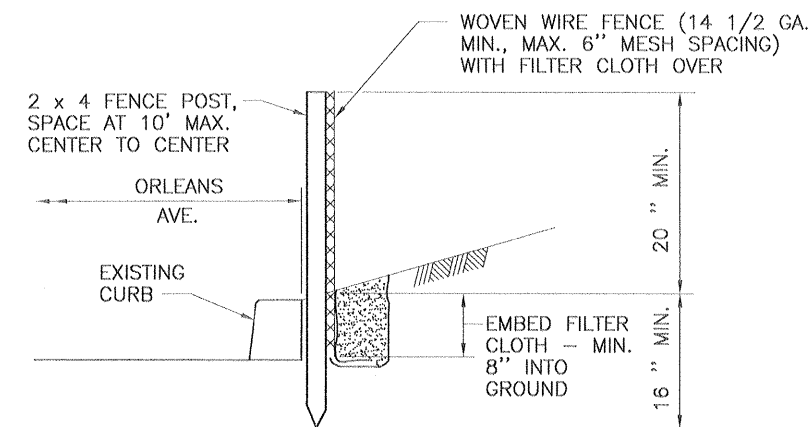


SILT FENCE

DETAIL (1)

N.T.S.

FILTER CLOTH REQUIREMENTS


PROPERTY	TEST METHOD	REQUIREMENTS
AOS, U. S. SIEVE, MIN.	ASTM D 4751	20
GRAB TENSILE, LB, MIN.	ASTM D 4632	90
PERMITTIVITY, SEC-1, MIN.	ASTM D 4491	0.01
WEATHEROMETER, %, MIN.	DOTD TR 611	70

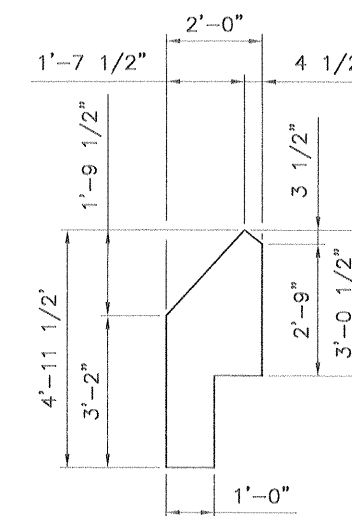

EXISTING FLOODWALL CAP



DETAIL (2)

SCALE: 1/2" = 1' - 0"

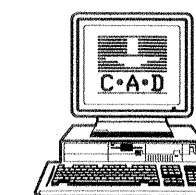

REFERENCE DRAWINGS

FOR GENERAL NOTES, SEE DWG. NO. 3.
FOR FLOODWALL PLAN, SEE DWG. NO. 14.
FOR FLOODWALL PROFILE - WEST SIDE, SEE DWG. NO. 18.

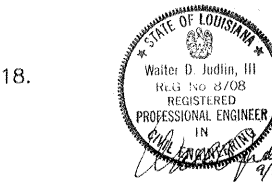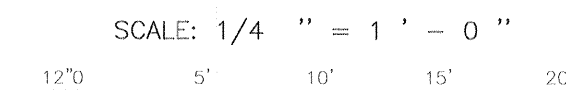

DACW29-00-B-0094

AS BUILT PLANS

DATE RECEIVED 3/15/02
DATE TRACINGS CORRECTED 4/18/02

SYMBOL	DESCRIPTION	DATE	APPROVED
△	SUBSTITUTE "TIP ELEVATION" FOR "TOP ELEVATION"	08/14/00	W.D.L.

REVISIONS

U.S. ARMY ENGINEER DISTRICT, NEW ORLEANS
CORPS OF ENGINEERS
NEW ORLEANS, LOUISIANA


BOARD OF LEVEE COMMISSIONERS
ORLEANS LEVEE BOARD
NEW ORLEANS, LOUISIANA

HARTMAN ENGINEERING, INC.
CONSULTING ENGINEERS
KENNER, LOUISIANA


LAKE PONTCHARTRAIN, LA. AND VICINITY
HIGH LEVEL PLAN
ORLEANS AVENUE OUTFALL CANAL
PHASE 1B
ORLEANS PARISH
LOUISIANA

ROBERT E. LEE BOULEVARD BRIDGE
TYPICAL WALL SECTIONS
SOUTHWEST OF BRIDGE

DESIGNED BY: M.K.R.	DATE: MAR. 8, 2000	PLOT SCALE: 48	PLOT DATE: MARCH 8, 2000
DRAWN BY: C.R.N.	CADD FILE: SH120.DGN	FILE NO. H-4-44776	
CHECKED BY: W.D.L.	SUBMITTED BY: HARTMAN ENGINEERING	SOLICITATION NO. DACW29-00-B-0094	DWG. 20 OF 59

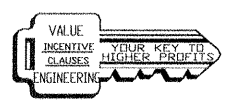


Safety is a Part of Your Contract

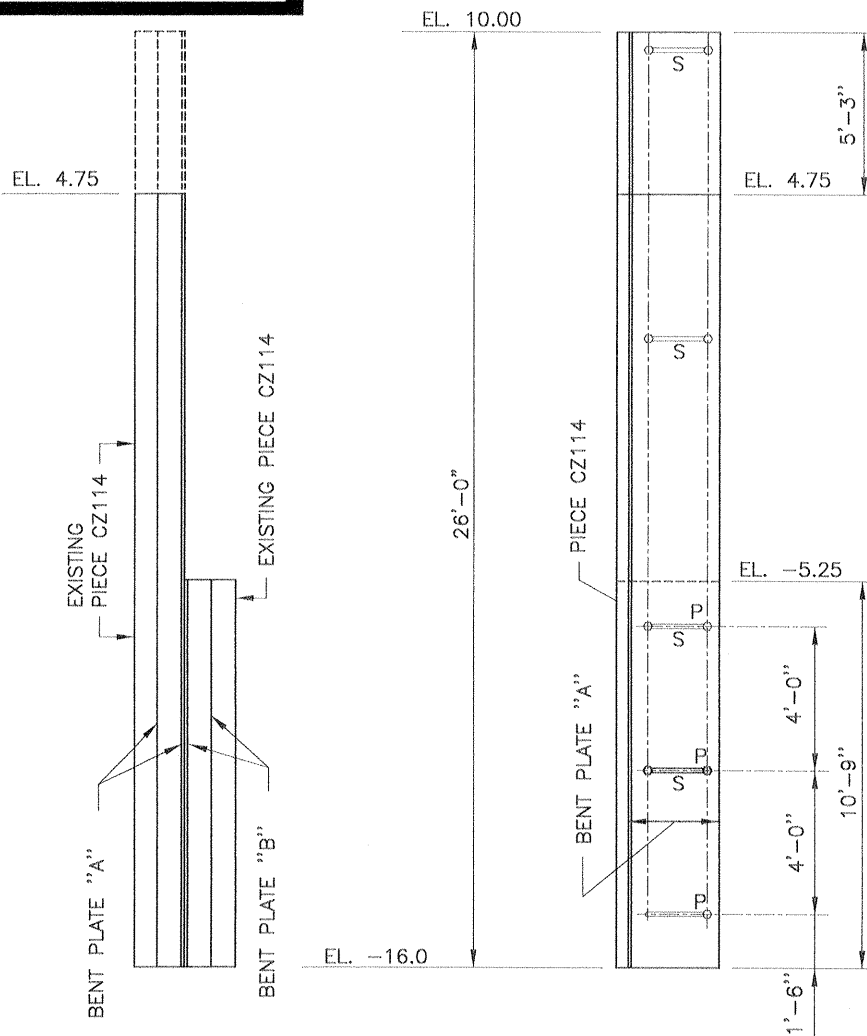


PROTECTED SIDE ELEVATION
NEW I-WALL SIDE ELEVATION
ELEVATION OF SPECIAL CZ114 TEE
SHOWING BENT PLATES BOLT SPACING
 SCALE: 3/4" = 1'-0" (HORZ.)
 3/8" = 1'-0" (VERT.)


LEGEND
 P = PERMANENT BOLT
 S = SLOTTED HOLE (PLATE "A" ONLY)

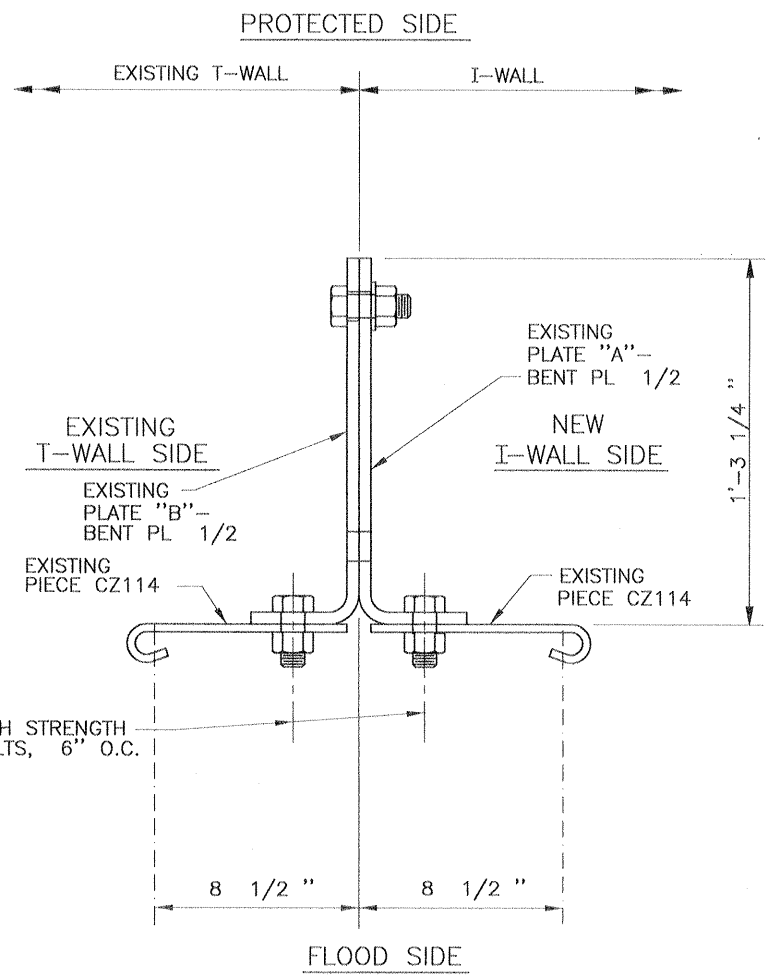


DETAIL 1
EXISTING SPECIAL CZ114 TEE
 SCALE: 3" = 1'-0"

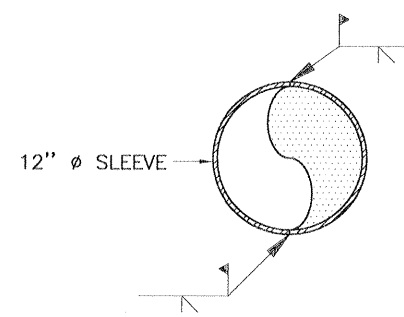

NOTE:
 THE TELEPHONE CONDUITS MUST PASS THROUGH THE SHEET PILING WITHOUT CUTTING THE CONDUITS. THE CONTRACTOR WILL DRIVE SHEET PILING AND INSTALL SPLIT SLEEVES. AFTER INSTALLATION OF NEW SPLIT SLEEVES BY CONTRACTOR, BELLSOUTH WILL MOVE CONDUITS INTO SLEEVES TO ALLOW CONTRACTOR TO COMPLETE THE INSTALLATION OF SPLIT SLEEVES AND SHEET PILING.

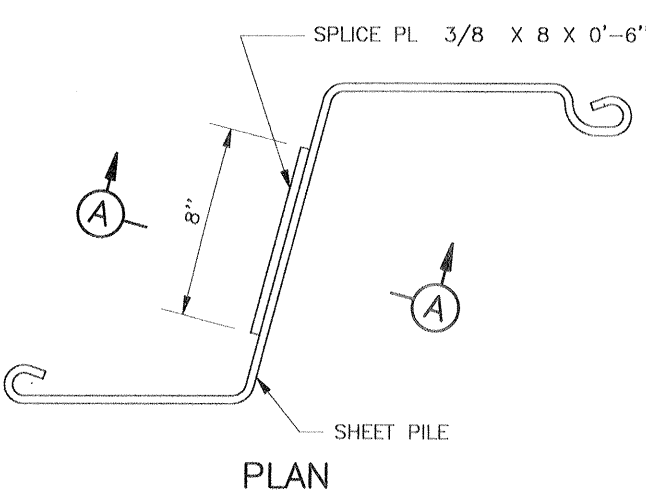

SHEET PILE SPICE DETAIL
 SCALE: 3" = 1'-0"

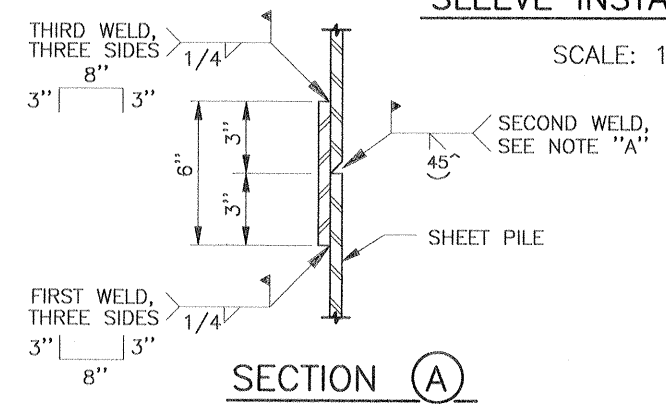


SLEEVE INSTALLATION IN HALVES
 SCALE: 1 1/2" = 1'-0"


NOTE "A"
 GROOVE WELD SHALL EXTEND THE FULL LENGTH OF THE SHEET PILE WEB AND FLANGES EXCLUDING THE INTERLOCKS.

PIPE TABULATION AND SLEEVE TABLE


UTILITY MARK	APPROX. W/L STA.	PANEL NUMBER	MINIMUM SLEEVE SIZE		
			NOMINAL SIZE	INSIDE DIAMETER	OUTSIDE DIAMETER
T-1	10+16.00	16	12"φ	12.000"φ	12.750"φ
T-1	10+37.00	15	12"φ	12.000"φ	12.750"φ
G-1	10+40.00	9	22"φ	21.250"φ	22.000"φ

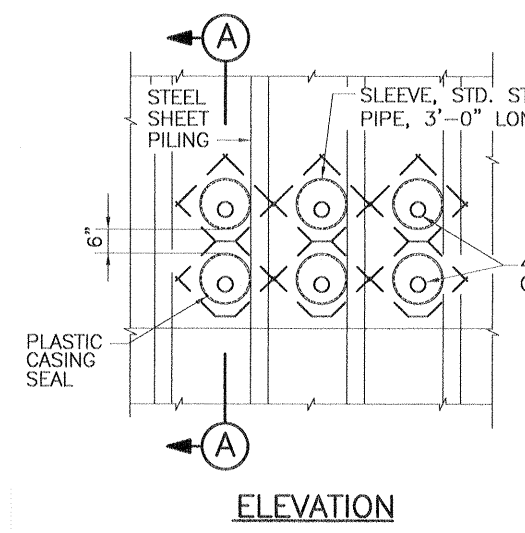


ELEVATION

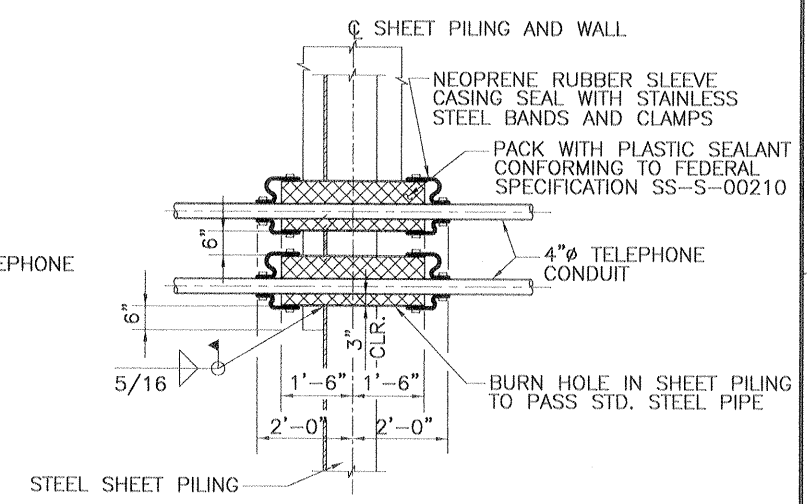

SECTION "A" THRU STEEL SHEET PILING
SHEET PILE TELEPHONE CONDUIT PENETRATION DETAIL
PANEL 16 SHOWN, PANEL 15 SIMILAR
 SCALE: 1/2" = 1'-0"

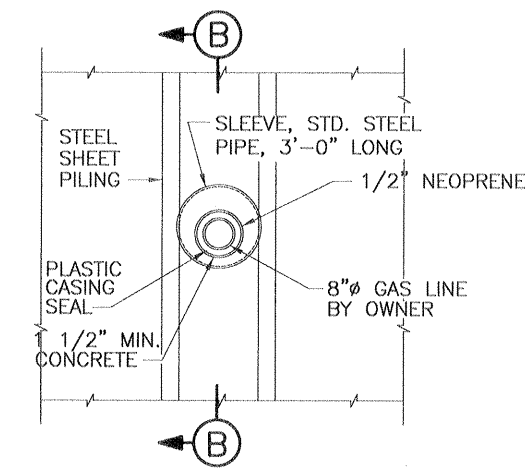


ELEVATION

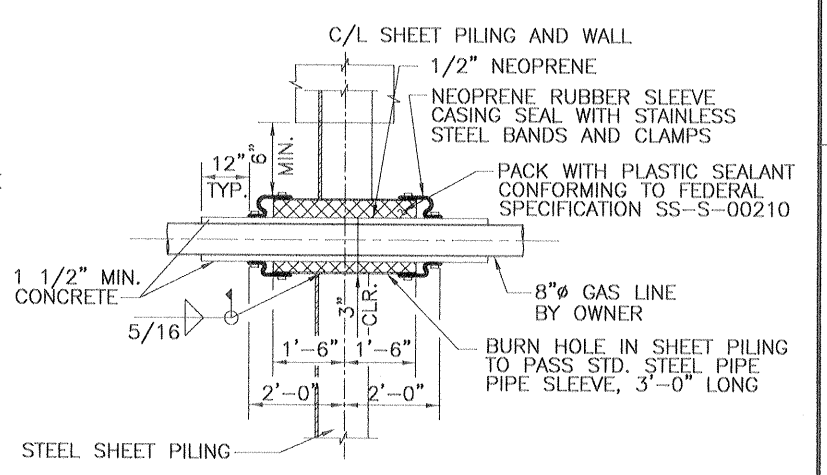

SECTION "B" THRU STEEL SHEET PILING
SHEET PILE GAS LINE PENETRATION DETAIL
 SCALE: 1/2" = 1'-0"

REFERENCE DRAWINGS
 FOR GENERAL NOTES, SEE DWG. NO. 3.
 FOR UTILITY RELOCATIONS, SEE DWG. NOS. 11, 12, AND 13.
 FOR FLOODWALL PLAN, SEE DWG. NO. 14.
 FOR FLOODWALL ALIGNMENTS, SEE DWG. NO. 15, 16 AND 17.
 FOR FLOODWALL PROFILES, SEE DWG. NOS. 18 AND 19.

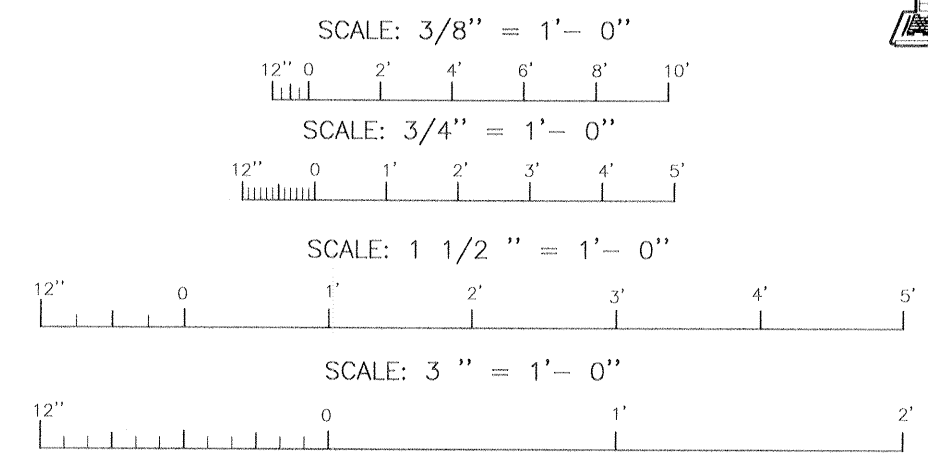

DACW29-00-B-0094
AS BUILT PLANS
 DATE RECEIVED 3/15/02
 DATE TRACINGS CORRECTED 4/18/02


SYMBOL	DESCRIPTION	DATE	APPROVED
▲	ADDED GAS PIPE THRU STEEL SHEET PILING	05/30/00	W.D.L.


REVISIONS
 U.S. ARMY ENGINEER DISTRICT, NEW ORLEANS
 CORPS OF ENGINEERS
 NEW ORLEANS, LOUISIANA

BOARD OF LEVEE COMMISSIONERS
 ORLEANS LEVEE BOARD
 NEW ORLEANS, LOUISIANA

LAKE PONTCHARTRAIN, LA. AND VICINITY
 HIGH LEVEL PLAN
 ORLEANS AVENUE OUTFALL CANAL
 PHASE 1B
 ORLEANS PARISH
 LOUISIANA

ROBERT E. LEE BOULEVARD BRIDGE SHEET PILE DETAILS
 DESIGNED BY: M.K.R.
 DRAWN BY: L.A.C.
 CHECKED BY: W.D.L.
 DATE: MAR. 8, 2000
 PLOT SCALE: 3
 PLOT DATE: MARCH 8, 2000
 FILE NO. H-4-44776
 SOLICITATION NO. DACW29-00-B-0094
 DWG. 21 OF 59

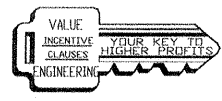


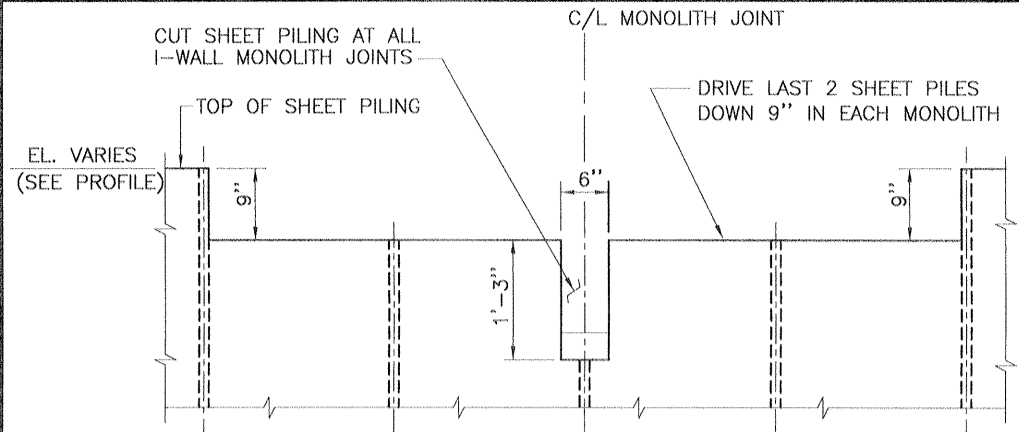

**SHEET PILING DETAILS
I-WALL MONOLITH JOINTS**

SCALE: 1" = 1'-0"

**Safety is a Part
of Your Contract**

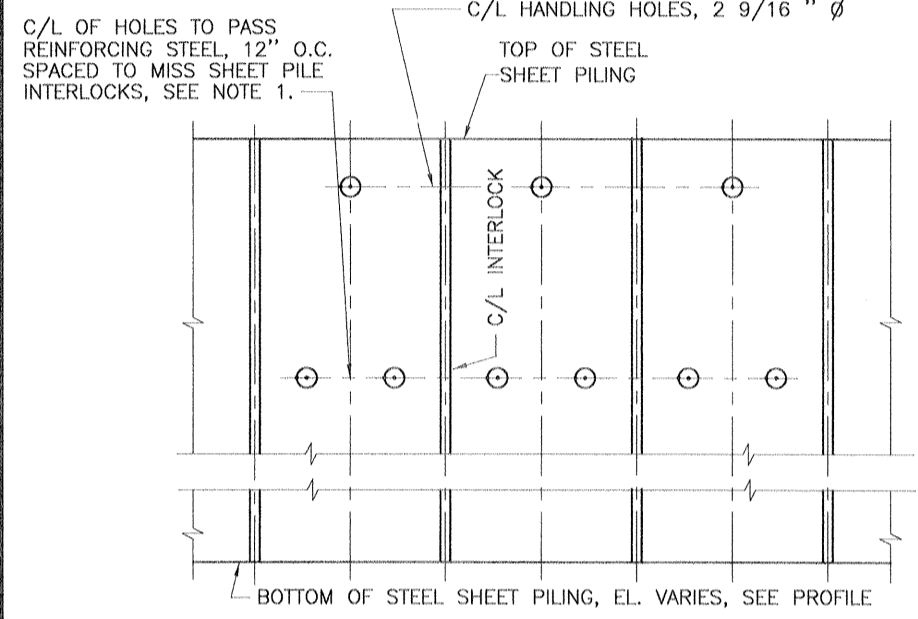


DETAILS OF HOLES IN SHEET PILING


SCALE: 1" = 1'-0"

SHEET PILE NOTES:

- Holes cut in steel sheet piling for passing reinforcing bars shall not exceed 2"Ø. Where holes fall within the web of the steel sheet pile, the hole shall be slotted 4" horizontally to accommodate passing the reinforcing bars.
- Any substitutions shall be submitted to the contracting officer for approval.
- Steel sheet pile surface preparation and painting shall be in accordance with section 09940 of the specifications.

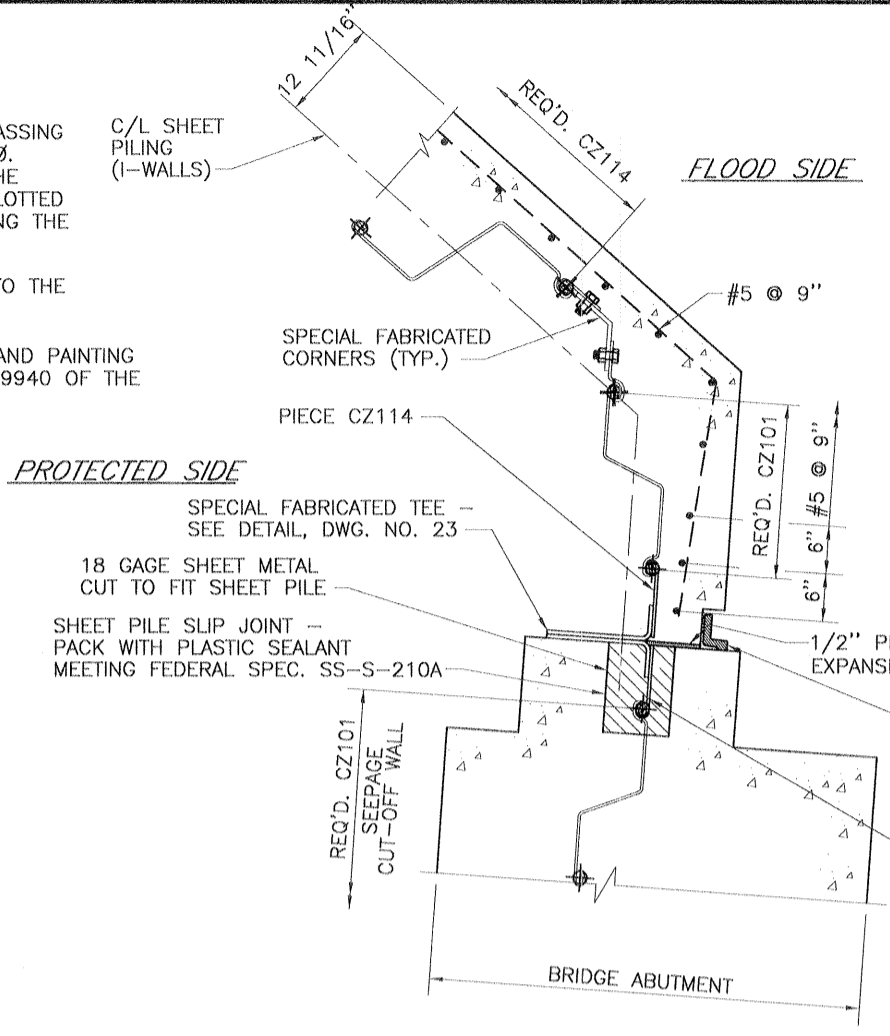


SECTION THROUGH SHEET PILE

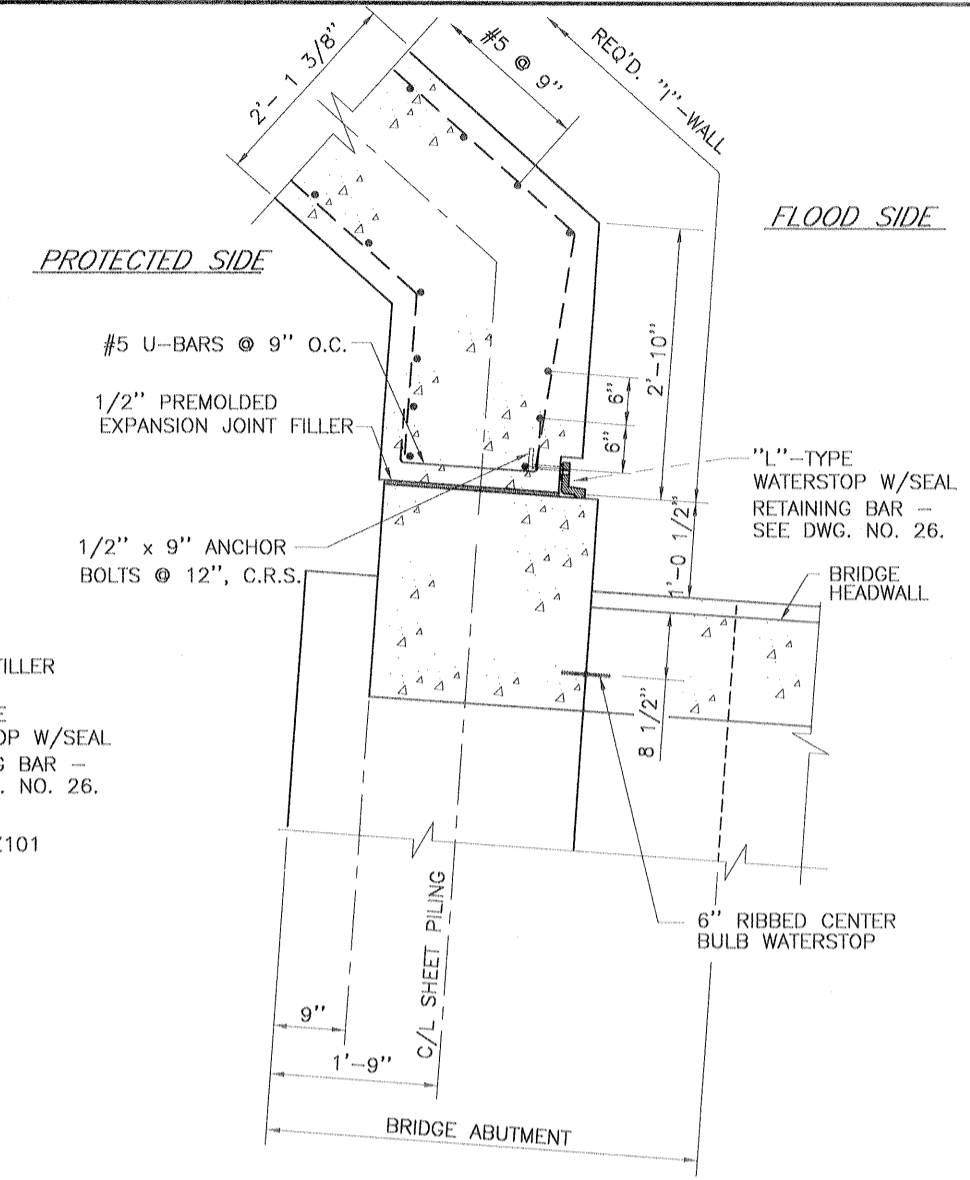


SECTION ABOVE SHEET PILE

DETAIL 5
SCALE: 1" = 1'-0"

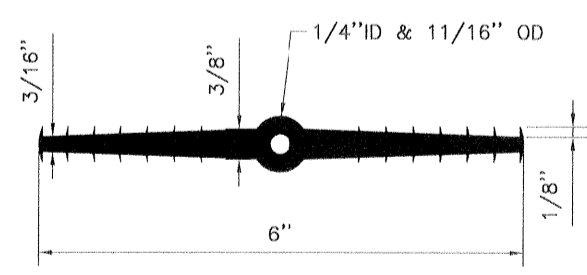


RIBBED CENTER BULB WATERSTOP
N.T.S.

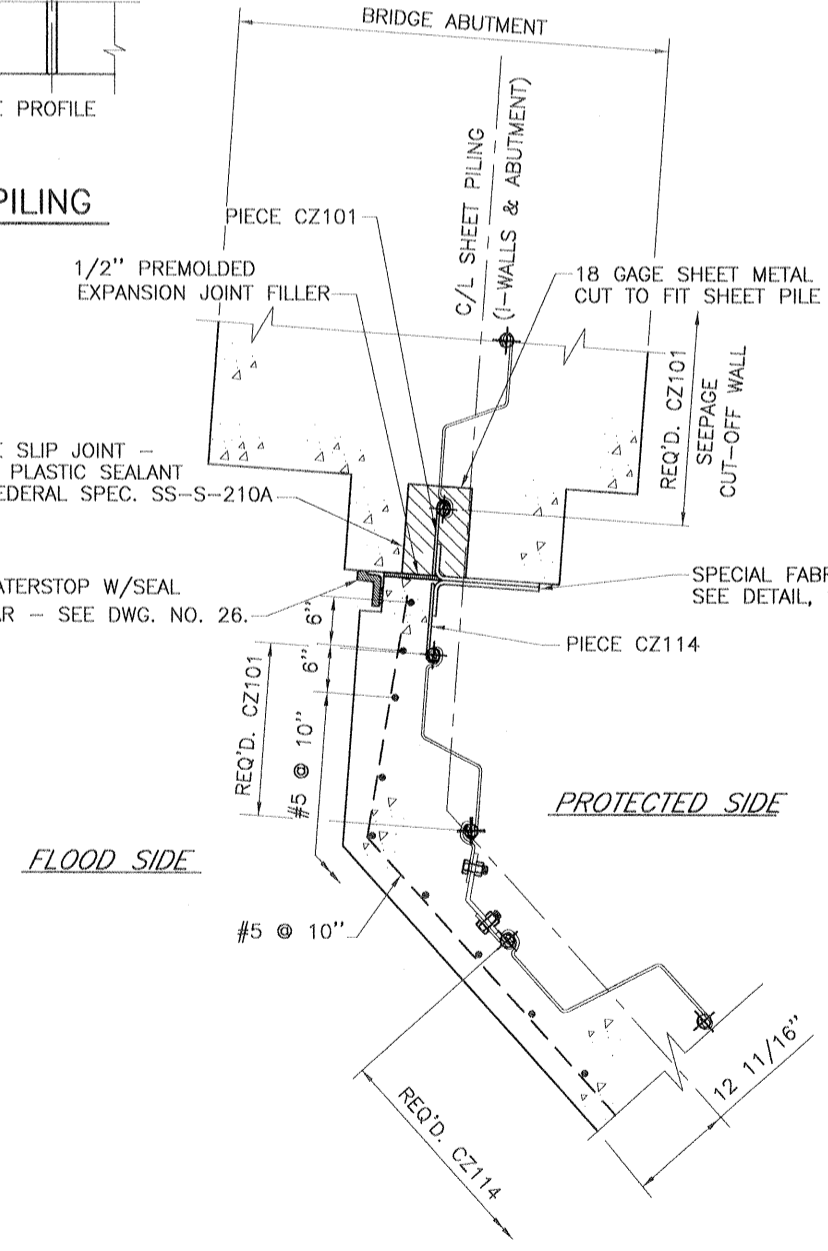

SECTION THROUGH SHEET PILE

DETAIL 7
SCALE: 1" = 1'-0"

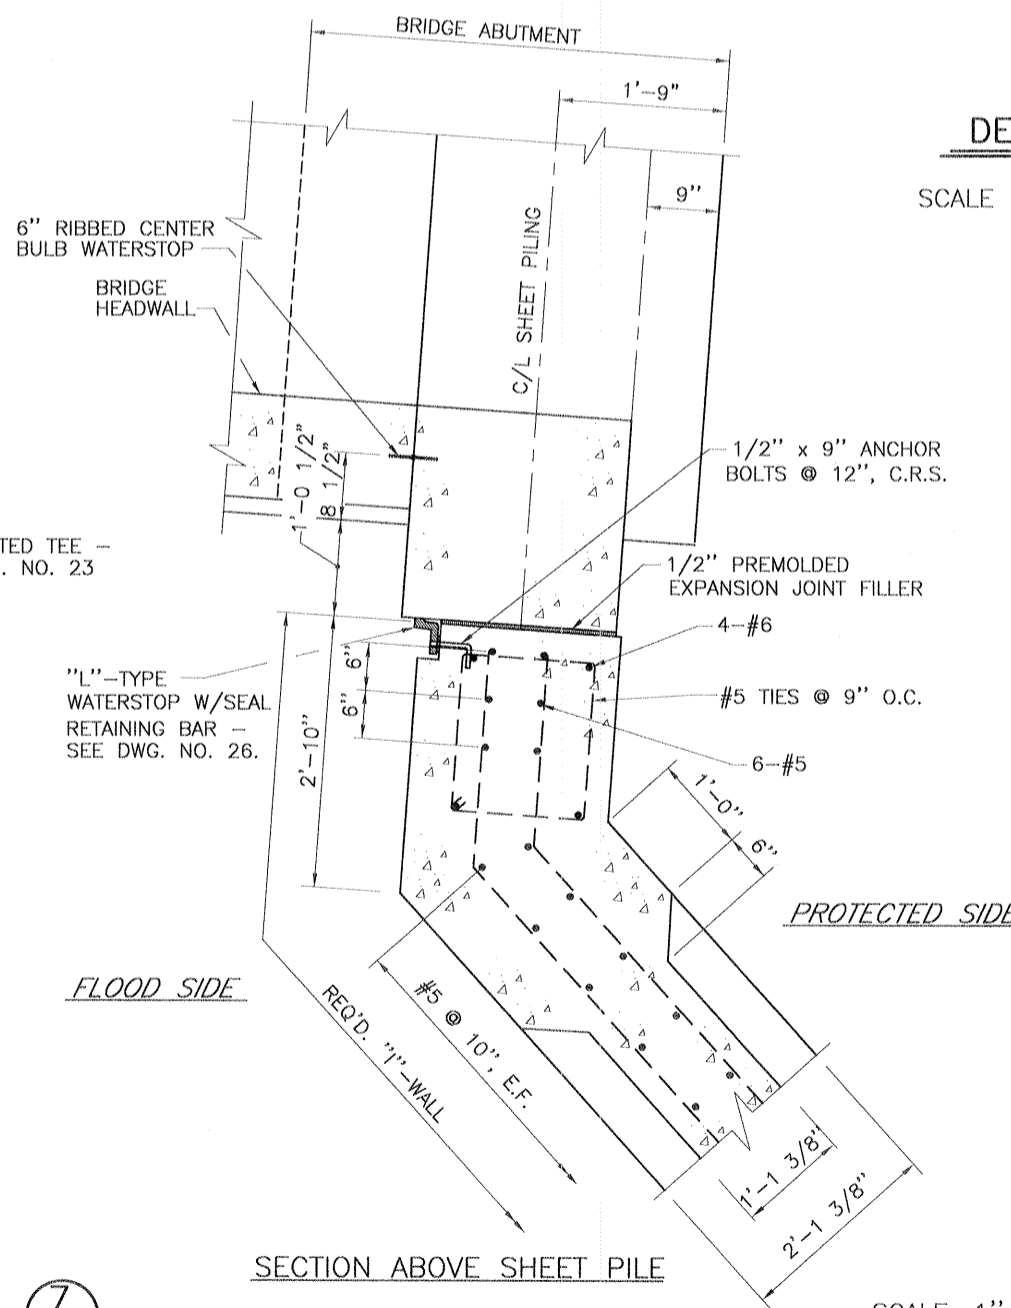


SECTION ABOVE SHEET PILE


SCALE: 1" = 1'-0"

REFERENCE DRAWINGS

- FOR GENERAL NOTES, SEE DWG. NO. 3
- FOR PLAN AND PROFILE, SEE DWG. NO. 5.
- FOR TYPICAL WALL SECTIONS, SEE DWG. NO. 27.

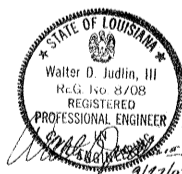



DACW29-00-B-0094
AS BUILT PLANS
DATE RECEIVED 3/15/02
DATE TRACINGS CORRECTED 4/18/02

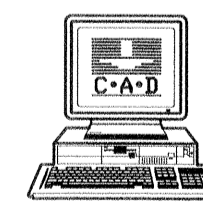

SYMBOL	DESCRIPTION	DATE	APPROVED
REVISIONS			
U.S. ARMY ENGINEER DISTRICT, NEW ORLEANS CORPS OF ENGINEERS NEW ORLEANS, LOUISIANA			
BOARD OF LEVEE COMMISSIONERS ORLEANS LEVEE BOARD NEW ORLEANS, LOUISIANA		HARTMAN ENGINEERING, INC. CONSULTING ENGINEERS KENNER, LOUISIANA	
LAKE PONTCHARTRAIN, LA. AND VICINITY HIGH LEVEL PLAN ORLEANS AVENUE OUTFALL CANAL PHASE 1B ORLEANS PARISH LOUISIANA			
ROBERT E. LEE BOULEVARD BRIDGE SHEET PILE DETAILS & JOINT DETAILS			
DESIGNED BY: M.K.R.	DATE: MAR. 8, 2000	PLOT SCALE: 12	PLOT DATE: MARCH 8, 2000
DRAWN BY: C.R.N.	CHECKED BY: W.D.L.	CADD FILE: SHT22.DGN	FILE NO. H-4-44776
SUBMITTED BY: HARTMAN ENGINEERING	SOLICITATION NO. DACW29-00-B-0094	DWG. 22	OF 59




**Safety is a Part
of Your Contract**

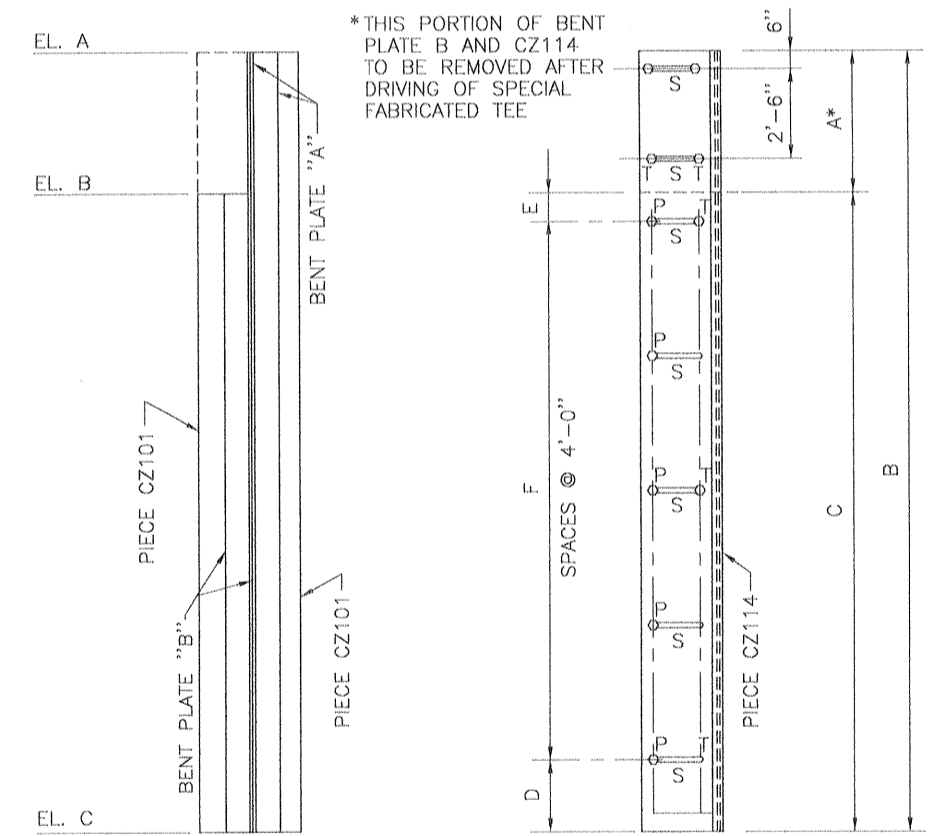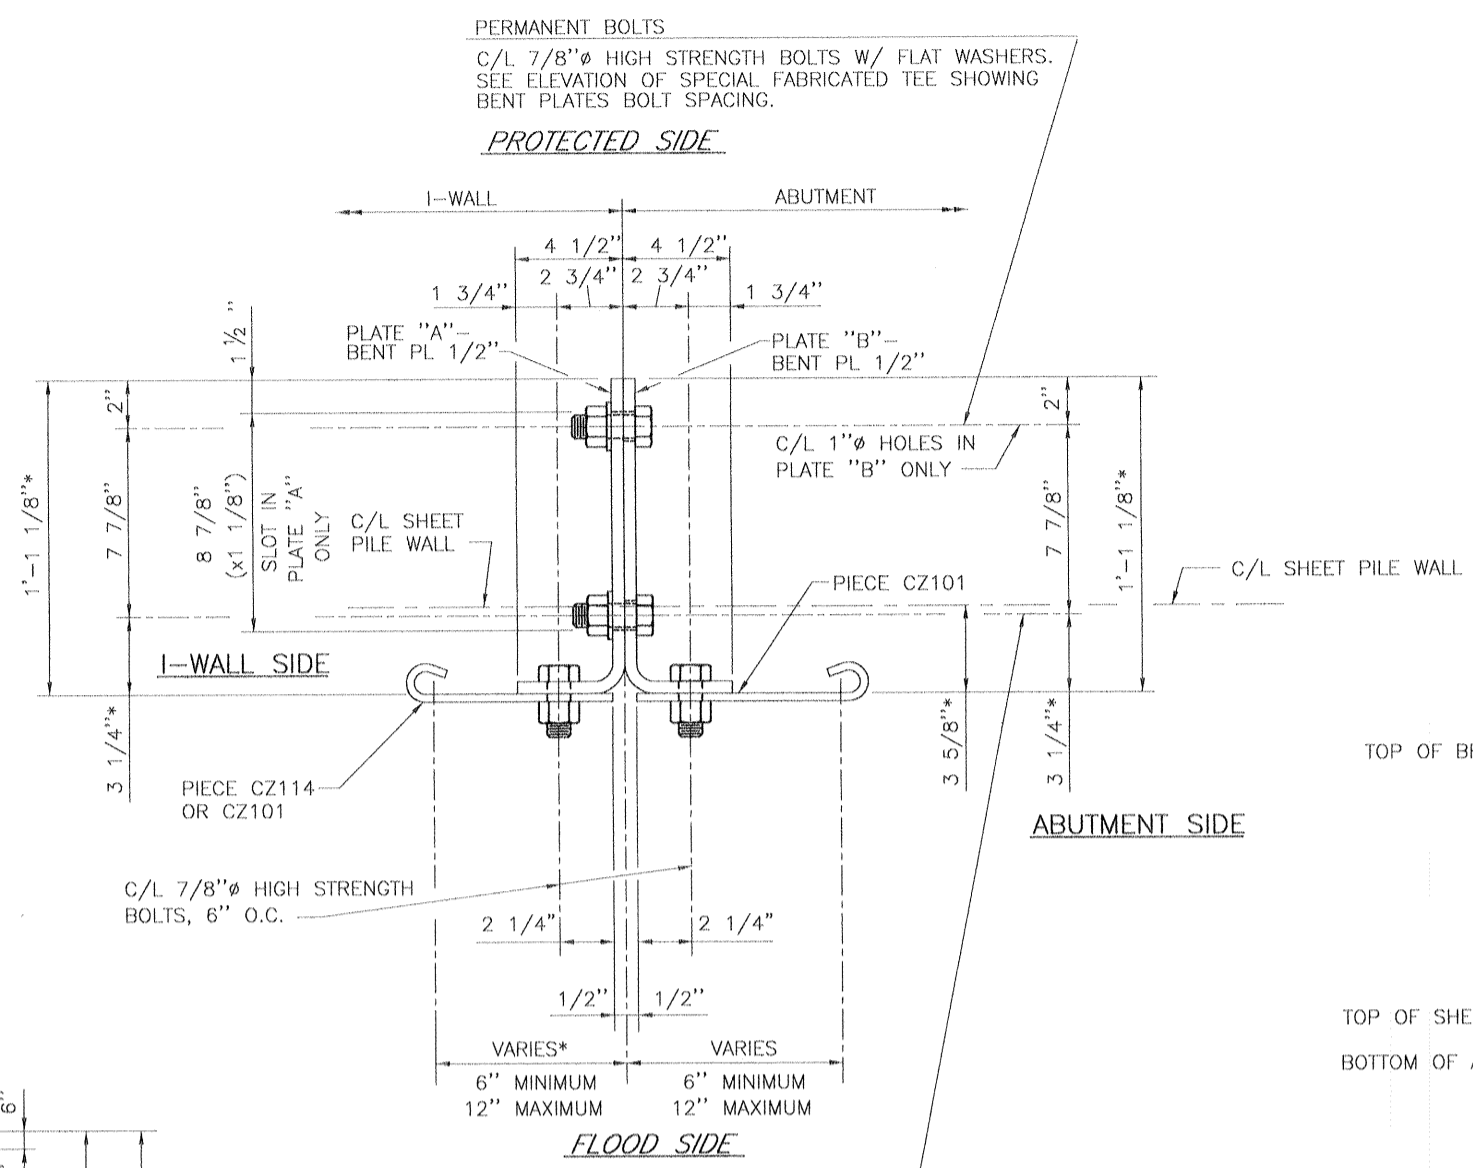

TEMPORARY DRIVING BOLTS
C/L 7/8"Ø HIGH STRENGTH BOLTS W/ FLAT WASHERS.
SEE ELEVATION OF SPECIAL FABRICATED TEE SHOWING BENT PLATES BOLT SPACING.
THESE BOLTS ARE TO BE REMOVED AS SPECIAL FABRICATED TEE IS DRIVEN,
SO THAT UPON COMPLETION OF DRIVING NO TEMPORARY BOLTS SHALL REMAIN.





*DIMENSION VARIES WITH SHEET PILE MANUFACTURER. CONFIRM OR REVISE ON SHOP DRAWING SUBMITTAL AS REQ'D.

DETAIL 1
SPECIAL FABRICATED TEE
(SOUTHEAST CORNER SHOWN, OTHERS SIMILAR)
SCALE: 3" = 1'-0"

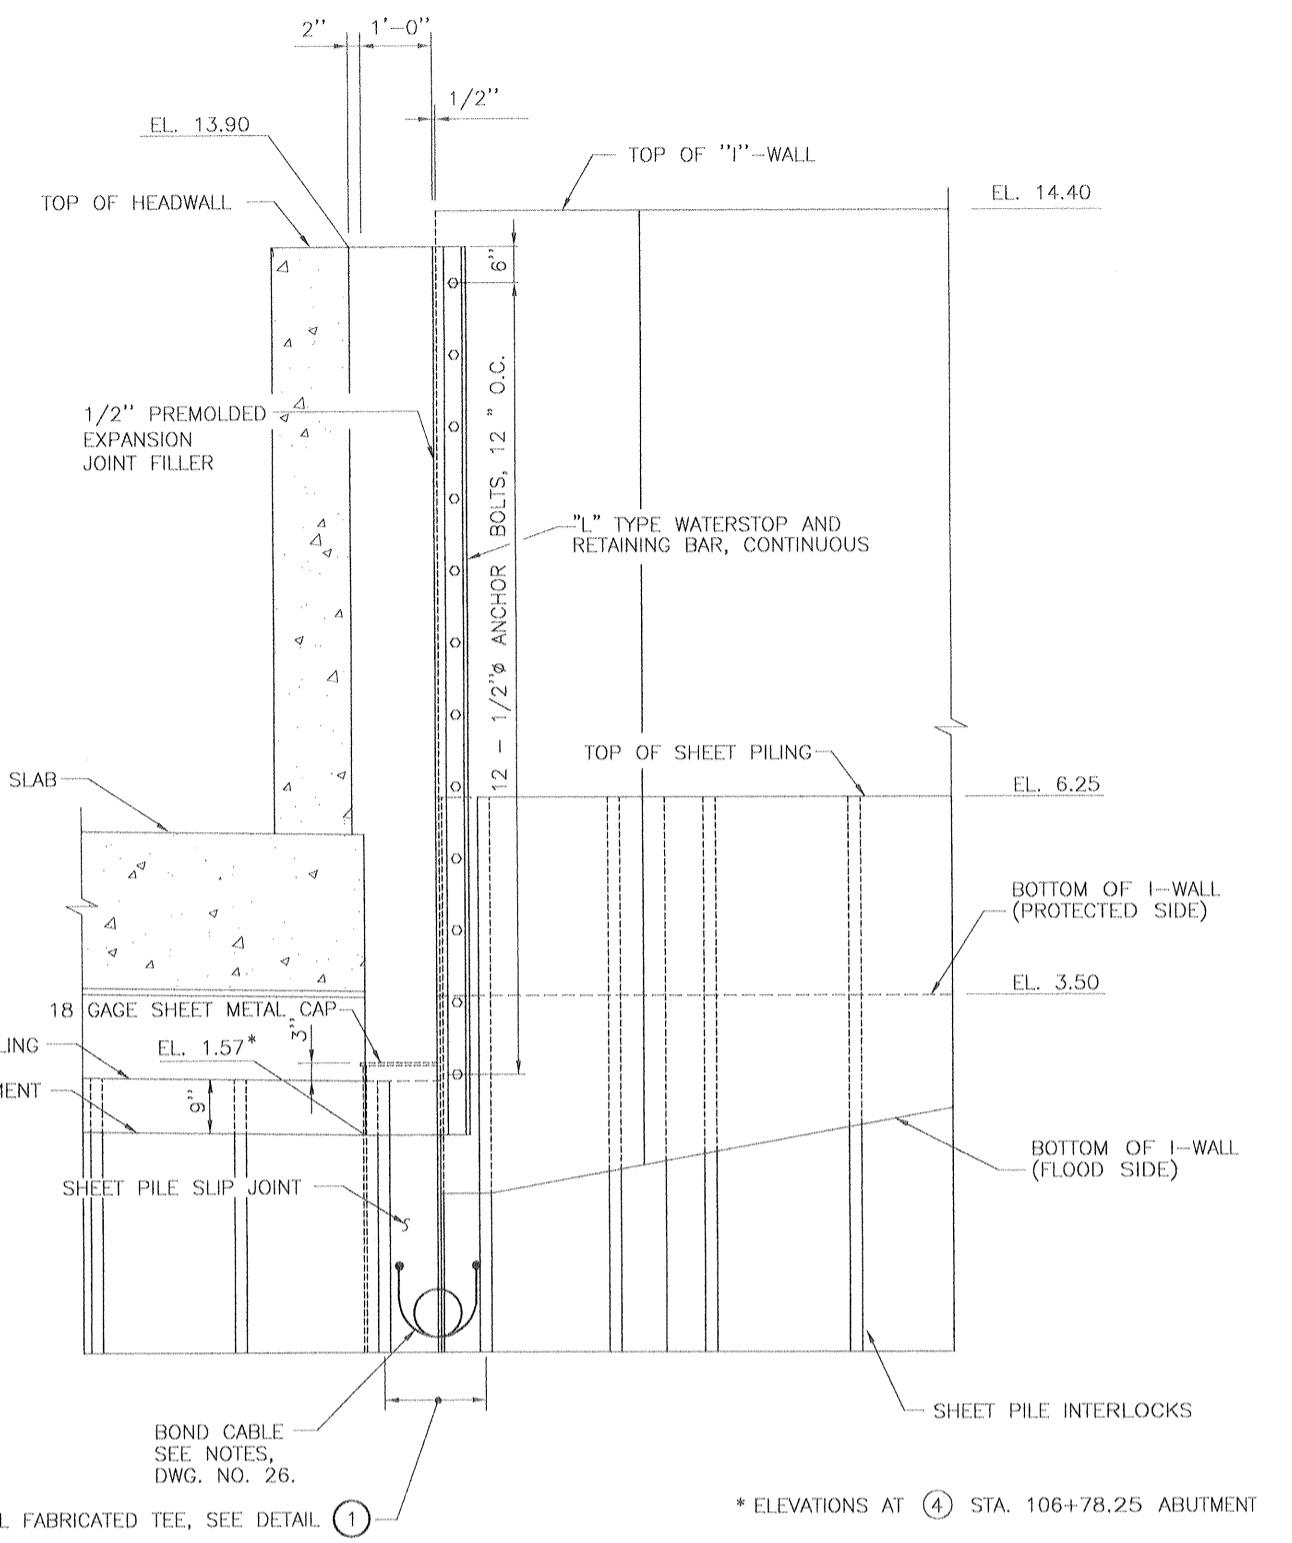

**FLOOD SIDE ELEVATION
"I"-WALL TO ABUTMENT**
(SOUTHEAST CORNER SHOWN, OTHERS SIMILAR)
SCALE: 3/4" = 1'-0"

REFERENCE DRAWINGS
FOR GENERAL NOTES, SEE DWG. NO. 3.
FOR FLOODWALL PLAN, SEE DWG. NO. 14.
FOR FLOODWALL PROFILES, SEE DWG. NOS. 18 AND 19.

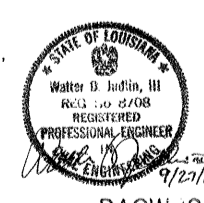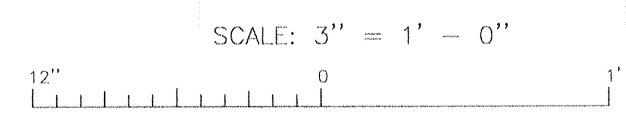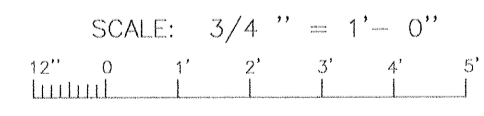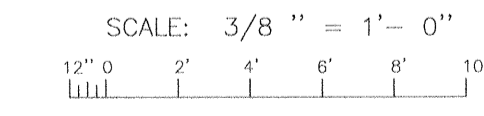


DACW29-00-B-0094

AS BUILT PLANS
DATE RECEIVED 3/15/02
DATE TRACINGS CORRECTED 4/18/02





**PROTECTED SIDE
ELEVATION**
**I-WALL SIDE
ELEVATION**
**ELEVATION OF SPECIAL FABRICATED TEE
SHOWING BENT PLATES BOLT SPACING**
(SOUTHEAST CORNER SHOWN, OTHERS SIMILAR)
SCALE: HORIZ. 3/4" = 1'-0"
VERT. 3/8" = 1'-0"

LOCATION	ELEV. A	ELEV. B	ELEV. C	DIM. A	DIM. B	DIM. C	DIM. D	DIM. E	F
SOUTHWEST	6.25	2.14	-15.5	4'-1 3/8"	21'-9"	17'-7 5/8"	9"	10 5/8"	4
NORTHWEST	6.25	2.14	-15.5	4'-1 3/8"	21'-9"	17'-7 5/8"	9"	10 5/8"	4
SOUTHEAST	6.25	2.32	-15.5	3'-11 1/8"	21'-9"	17'-9 7/8"	1'-0"	9 7/8"	4
NORTHEAST	6.50	2.32	-15.5	4'-2 1/8"	22'-0"	17'-9 7/8"	1'-0"	9 7/8"	4

SYMBOL	DESCRIPTION	DATE	APPROVED
REVISIONS			
U.S. ARMY ENGINEER DISTRICT, NEW ORLEANS CORPS OF ENGINEERS NEW ORLEANS, LOUISIANA			
BOARD OF LEVEE COMMISSIONERS ORLEANS LEVEE BOARD NEW ORLEANS, LOUISIANA		HARTMAN ENGINEERING, INC. CONSULTING ENGINEERS KENNER, LOUISIANA	
LAKE PONCHARTRAIN, LA. AND VICINITY HIGH LEVEL PLAN ORLEANS AVENUE OUTFALL CANAL PHASE 1B ORLEANS PARISH LOUISIANA			
ROBERT E. LEE BOULEVARD BRIDGE SHEET PILE DETAILS AND JOINT DETAILS			
DESIGNED BY: M.K.R.	DATE: MAR. 8, 2000	PLOT SCALE: 16	PLOT DATE: MARCH 8, 2000
DRAWN BY: C.R.N.	CADD FILE: SHIT23.DGN	FILE NO. H-4-44776	
CHECKED BY: W.D.L.	SUBMITTED BY: HARTMAN ENGINEERING	SOLICITATION NO. DACW29-00-B-0094	DWG. 23 OF 59

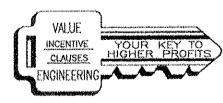


Safety is a Part of Your Contract

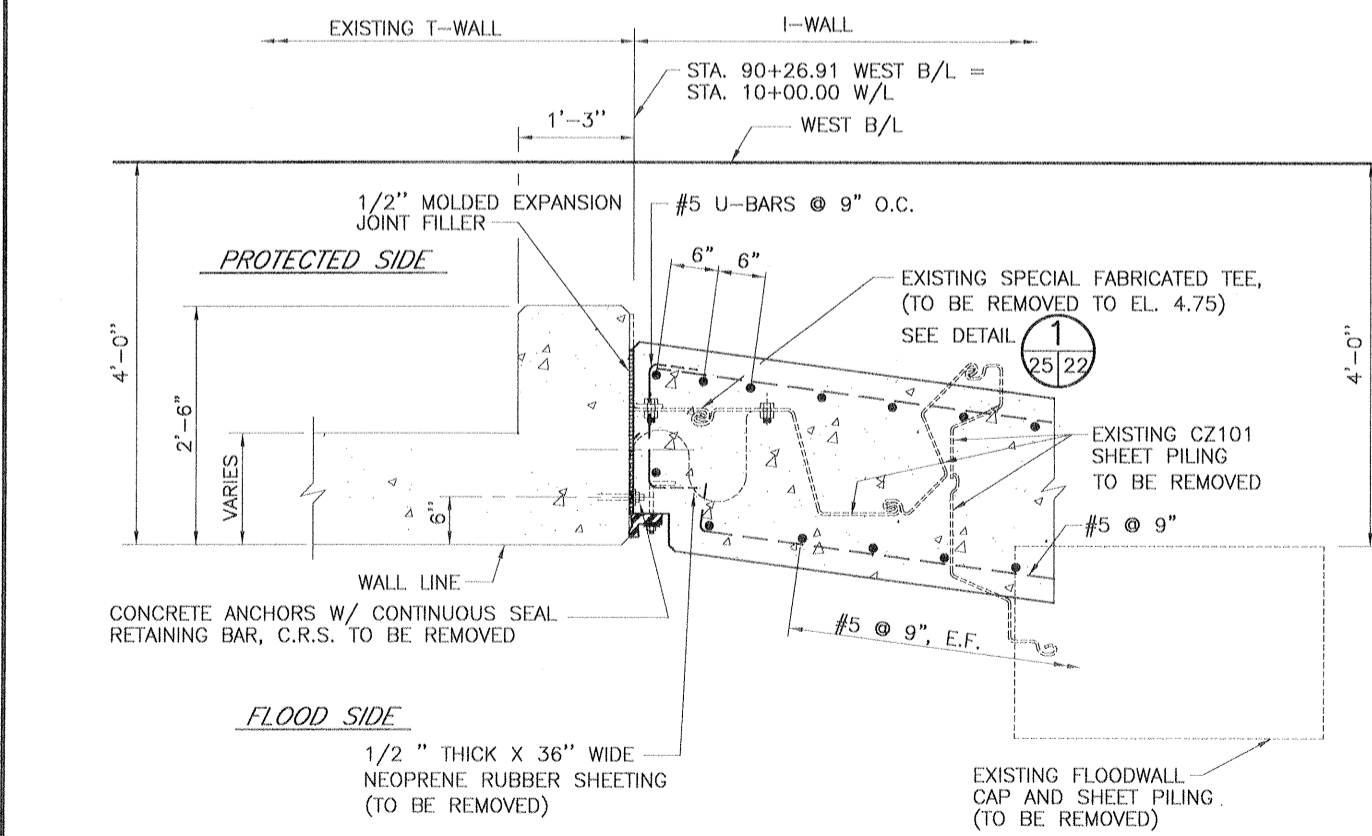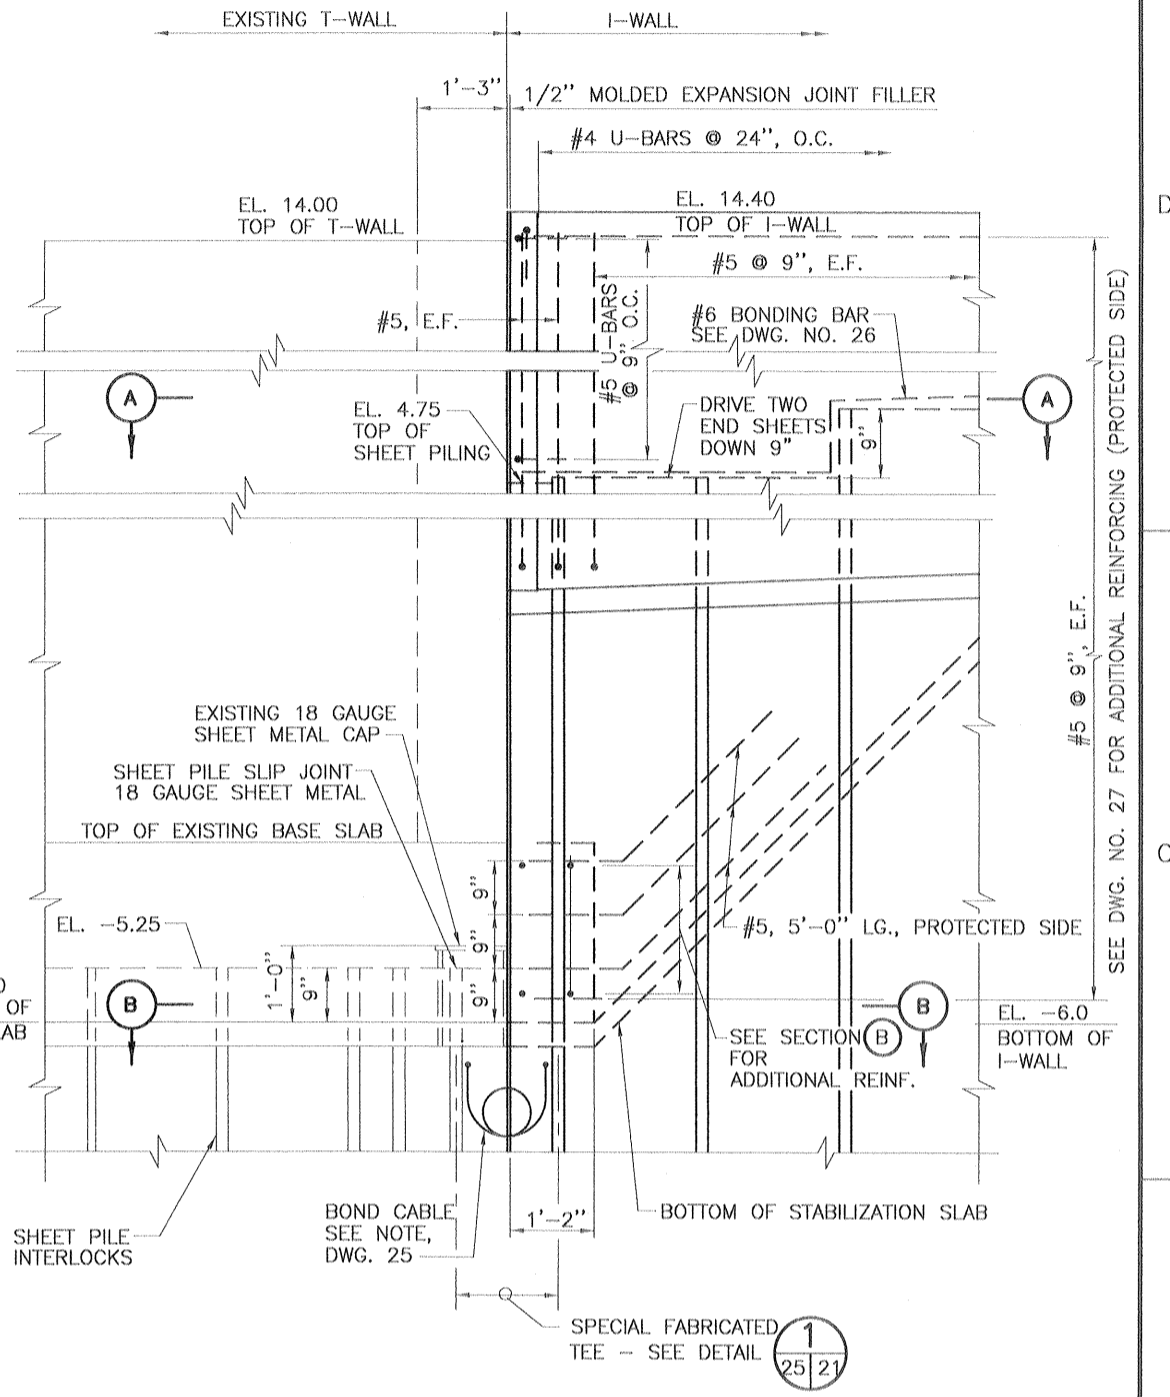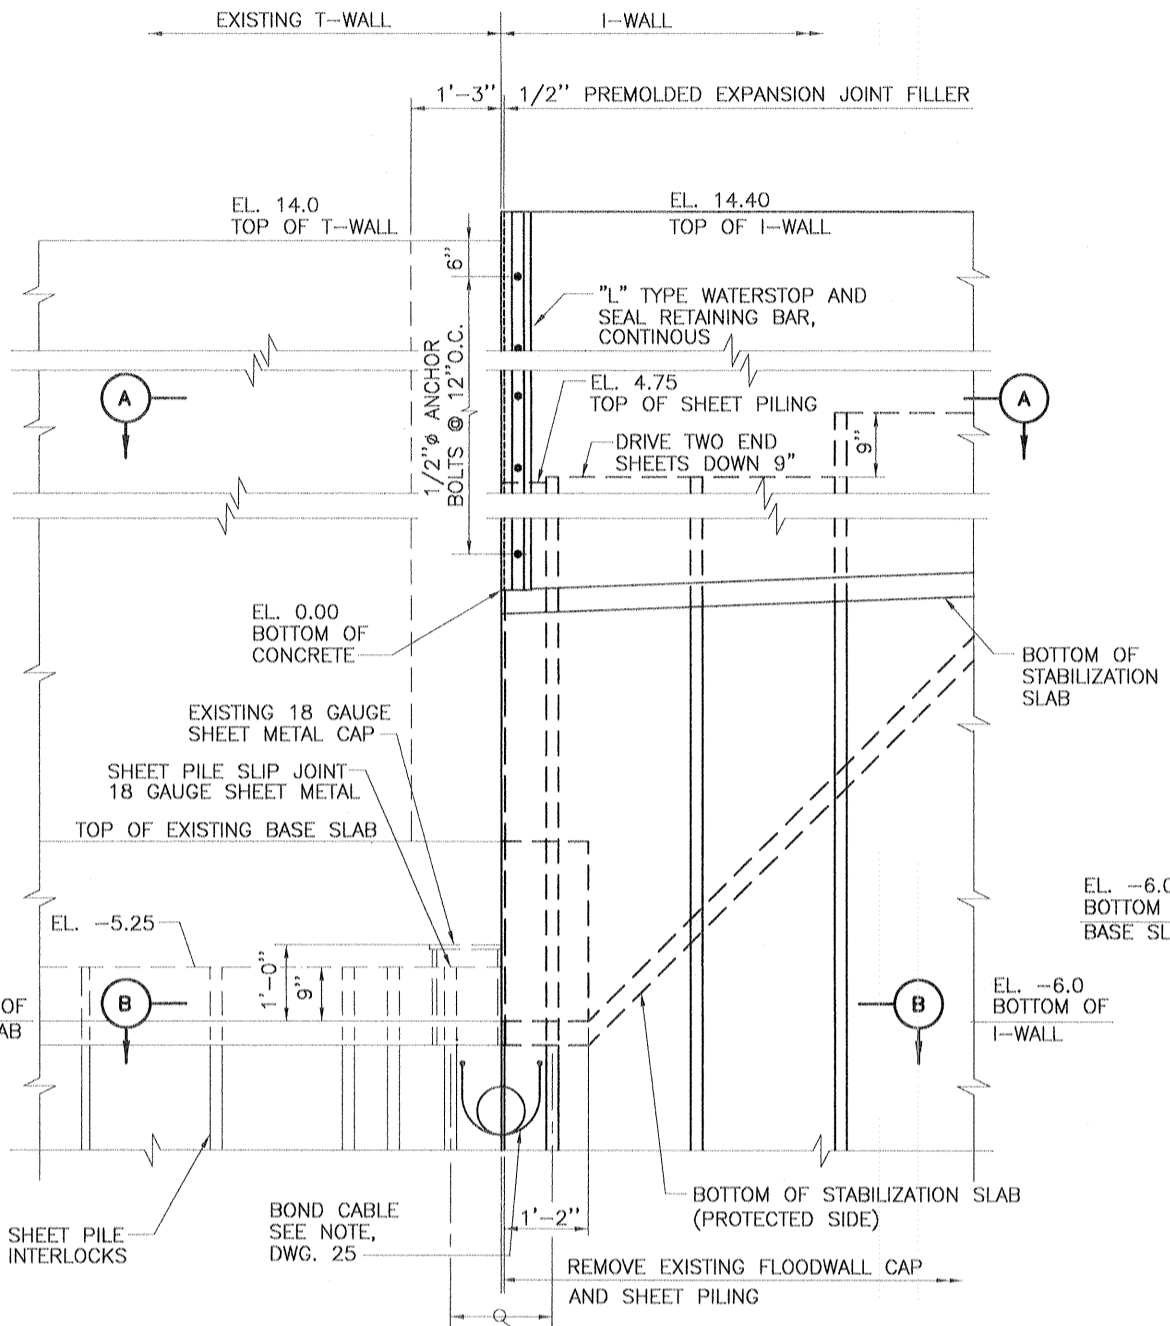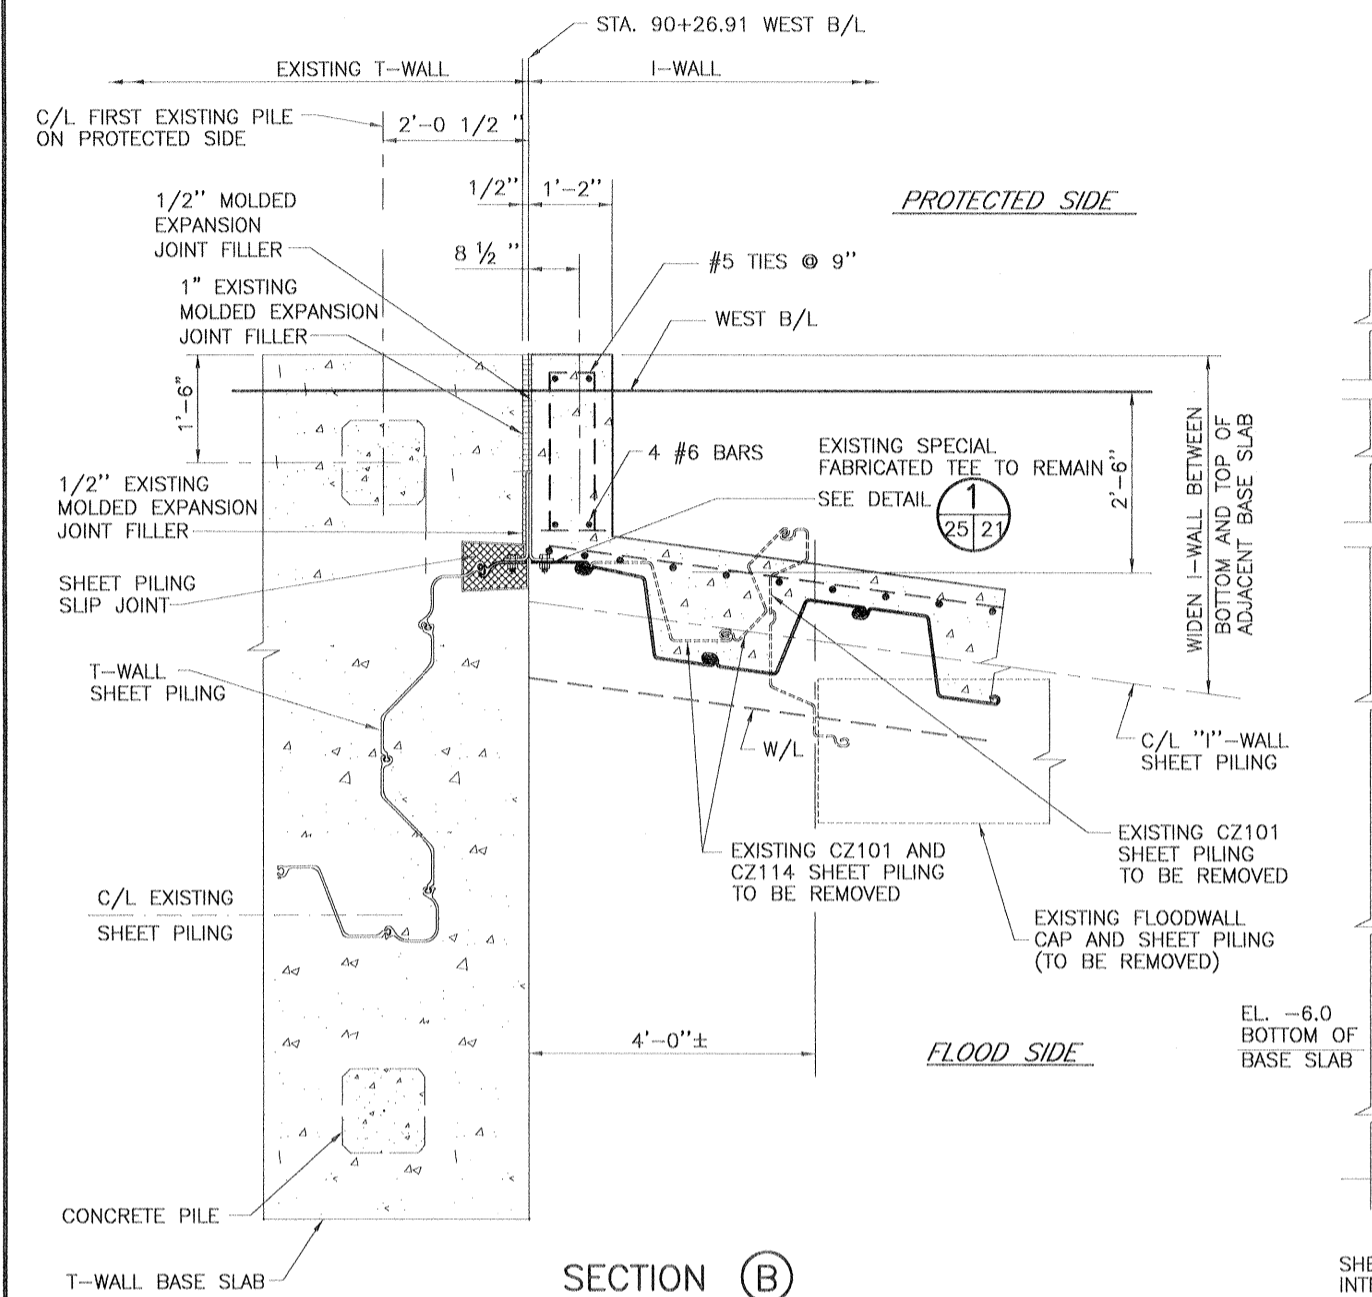


FLOOD SIDE ELEVATION
T-WALL TO I-WALL
(STA. 90+26.91 W B/L)
SCALE: 3/4" = 1'-0"


REFERENCE DRAWINGS
 FOR GENERAL NOTES, SEE DWG. NO. 3
 FOR PLAN/PROFILE, SEE DWG. NO. 5
 FLOODWALL PLAN, SEE DWG. NO. 14
 FOR FLOODWALL ALIGNMENTS, SEE DWG. NO. 15, 16 AND 17.
 FOR FLOODWALL PROFILES, SEE DWG. NO'S. 18 AND 19
 FOR I-WALL REINFORCEMENT DETAILS, SEE DWG. NO. 27

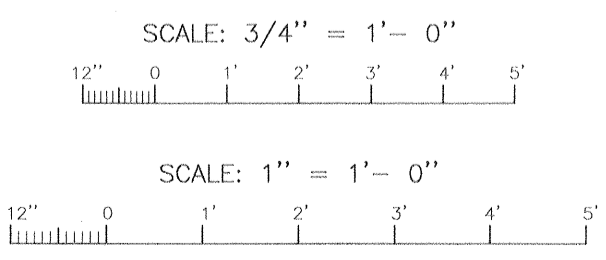

DACW29-00-B-0094
AS BUILT PLANS
 DATE RECEIVED 3/15/02
 DATE TRACINGS CORRECTED 4/18/02

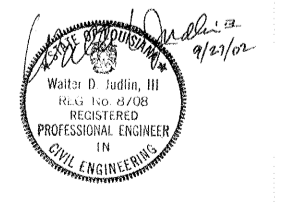


SYMBOL	DESCRIPTION	DATE	APPROVED
REVISIONS			
U.S. ARMY ENGINEER DISTRICT, NEW ORLEANS CORPS OF ENGINEERS NEW ORLEANS, LOUISIANA			
BOARD OF LEVEE COMMISSIONERS ORLEANS LEVEE BOARD NEW ORLEANS, LOUISIANA		HARTMAN ENGINEERING, INC. CONSULTING ENGINEERS KENNER, LOUISIANA	
LAKE PONTCHARTRAIN, LA. AND VICINITY HIGH LEVEL PLAN ORLEANS AVENUE OUTFALL CANAL PHASE 1B ORLEANS PARISH LOUISIANA			
ROBERT E. LEE BOULEVARD BRIDGE JOINT DETAILS			
DESIGNED BY: M.K.R.	DATE: MAR. 8, 2000	PLOT SCALE: 1	PLOT DATE: MARCH 8, 2000
DRAWN BY: C.R.N.	CADD FILE: SHT25.DGN	FILE NO. H-4-44776	
CHECKED BY: W.D.L.	SOLICITATION NO. DACW29-00-B-0094	DWG. NO. 25	OF 59
SUBMITTED BY: HARTMAN ENGINEERING DESIGN ENGINEER			

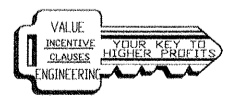

Safety is a Part of Your Contract


BONDING NOTES

- #6 REINFORCING BAR TO BE WELDED TO THE TOP OF EACH STEEL SHEET PILE. #6 REINFORCING BAR SHALL NOT EXTEND ACROSS THE MONOLITH JOINT. INSTALL BOND CABLE AT ALL EXPANSION JOINTS. BOND CABLE SHALL HAVE AN 7" DIAMETER LOOP TO ALLOW FOR STRESSES. BOND CABLES SHALL BE WELDED AS SPECIFIED TO ADJACENT STEEL PILES 3" BELOW THE BOTTOM OF CONCRETE CAP. WELDED CONNECTIONS SHALL BE COATED WITH SPLICING EPOXY TO OBTAIN MOISTURE PROOF JOINT. SEE SPECIFICATIONS.
- #6 REINFORCING BARS SHALL BE WELDED TO THE LAST THREE SHEET PILING AT EACH END OF THE MONOLITH AS SHOWN FOR CONTINUITY.
- SPLICING OF THE #6 REINFORCING BAR WILL NOT BE ALLOWED.

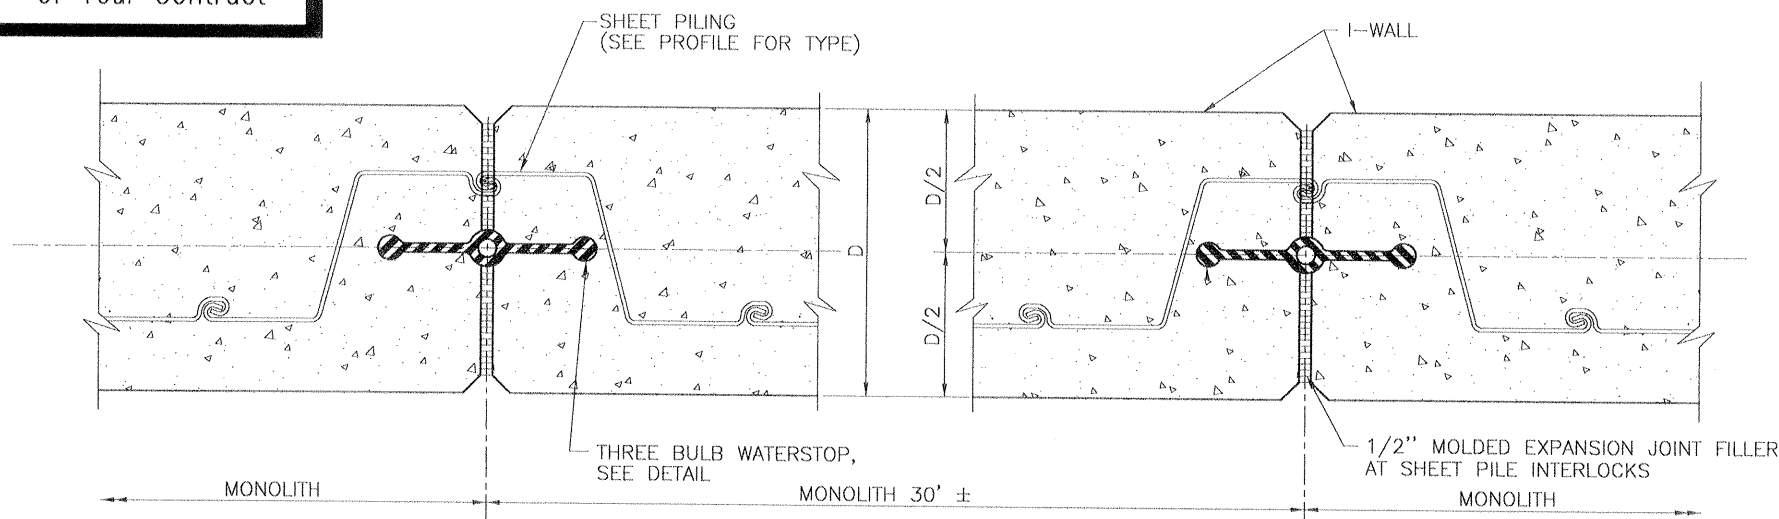


TYPICAL I-WALL AT SHEET PILE INTERLOCKS
SCALE: 3" = 1'-0"


NOTE: EACH I-WALL MONOLITH SHALL END AT THE CENTER OF THE NEAREST SHEET PILE INTERLOCK.

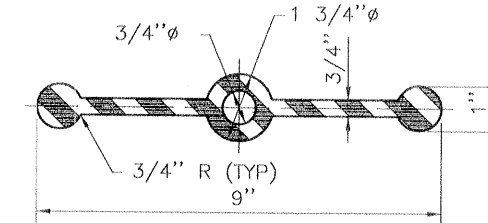


THREE BULB WATERSTOP DETAIL
N.T.S.

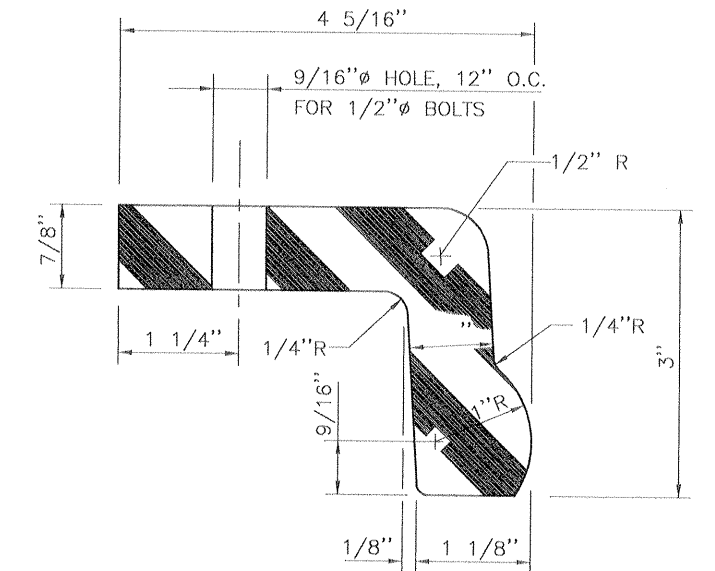

"L" TYPE WATERSTOP
SCALE: 12" = 1'-0"

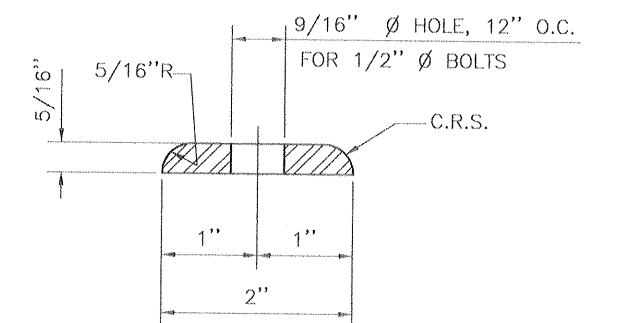


SEAL RETAINING BAR
SCALE: 12" = 1'-0"

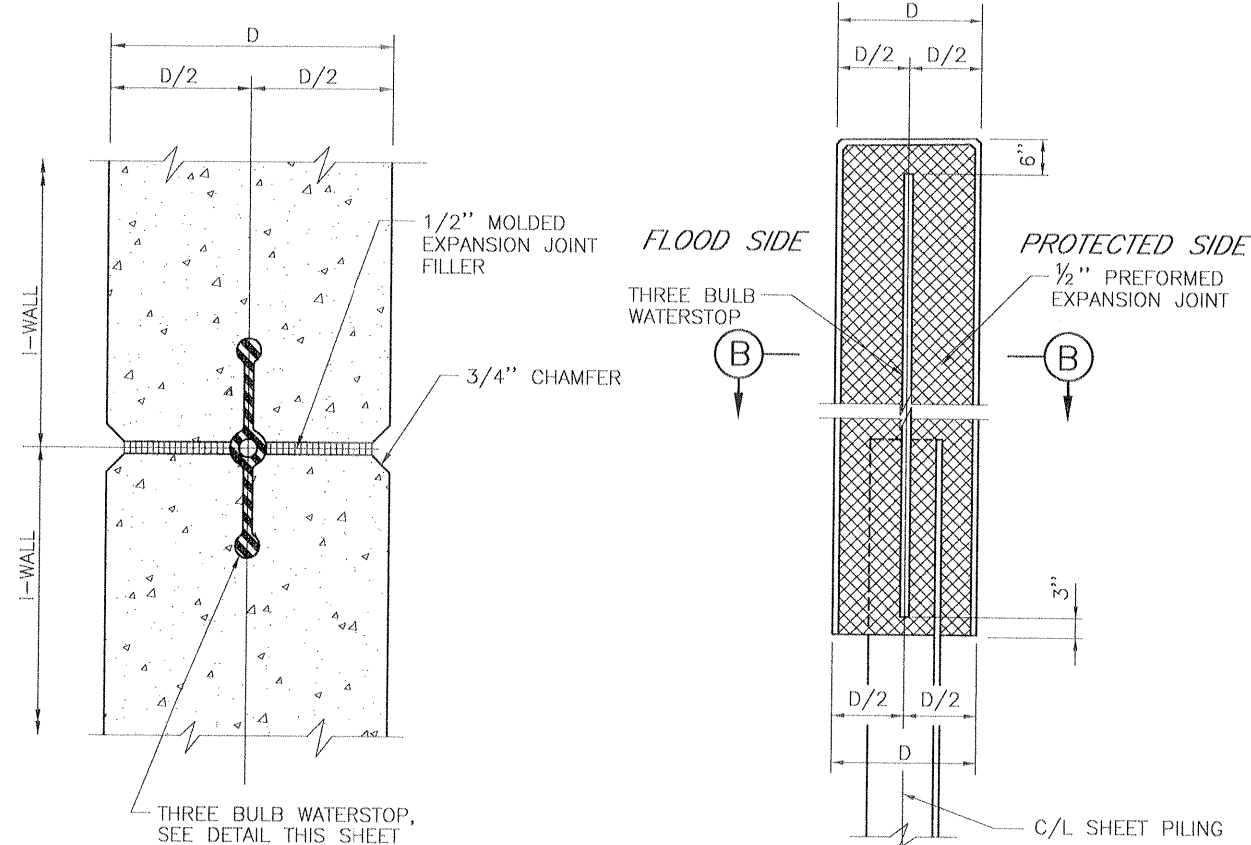


SECTION B
SCALE: 3" = 1'-0"




TYPICAL I-WALL JOINT (TYPE I WALL)
SCALE: 3/4" = 1'-0"

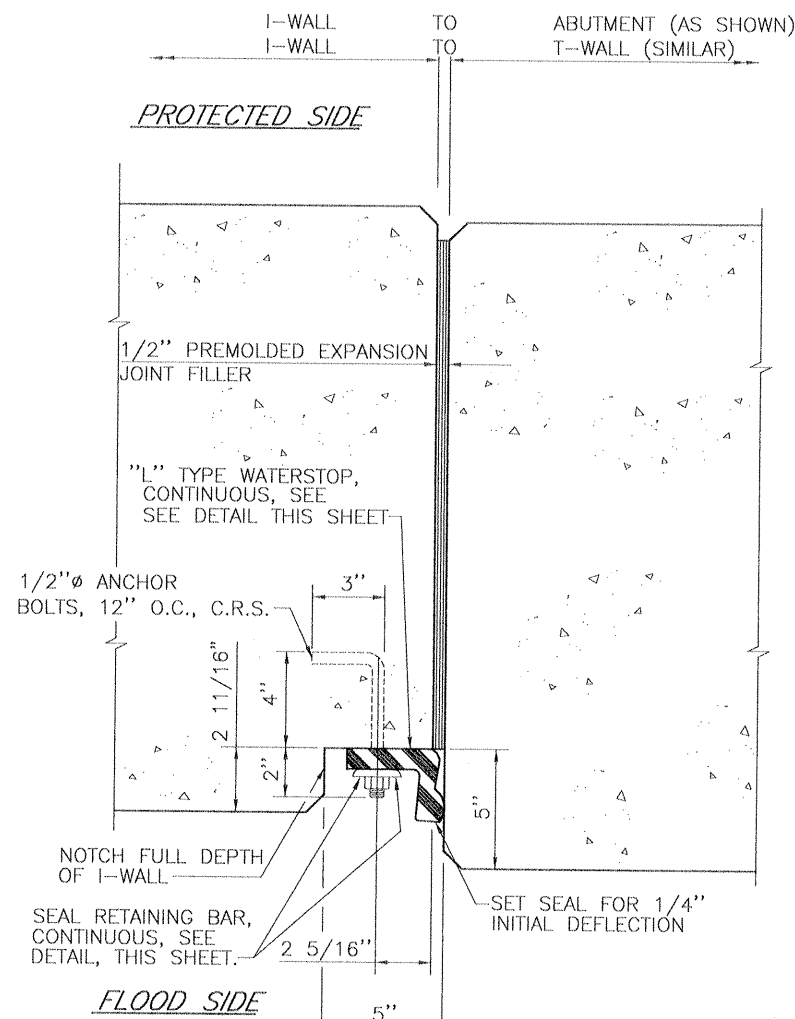

PLAN
I-WALL TO ABUTMENT
(I-WALL TO T-WALL SIMILAR)
SCALE: 3" = 1'-0"

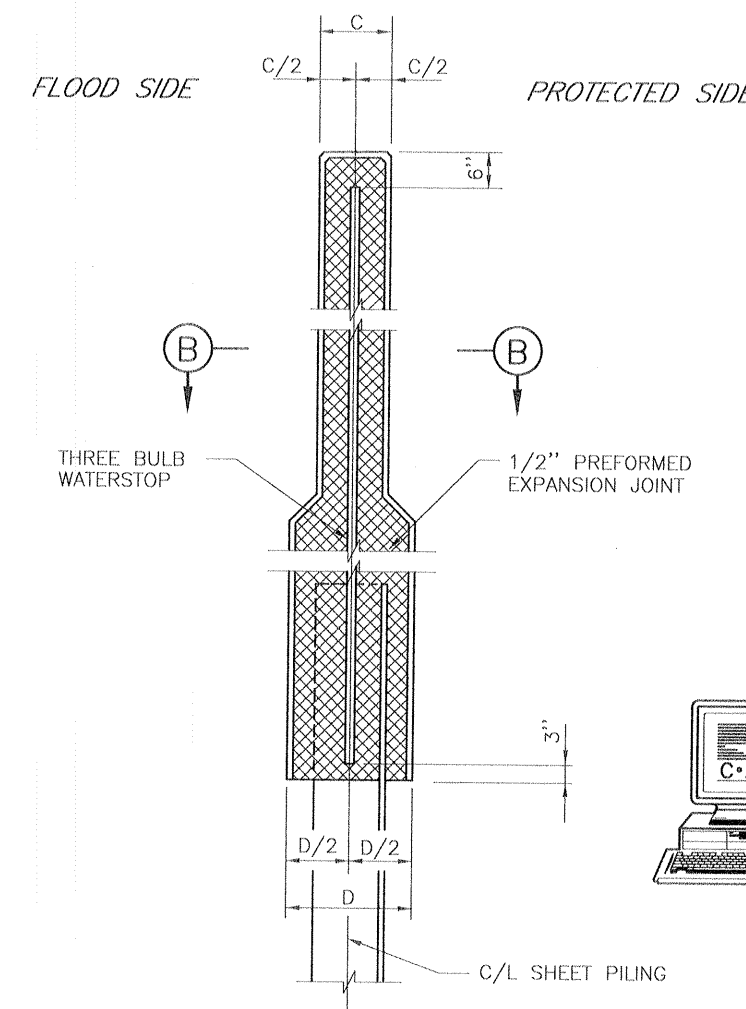


TYPICAL I-WALL JOINT (TYPE II WALL)
SCALE: 3/4" = 1'-0"

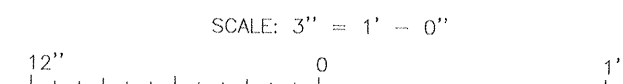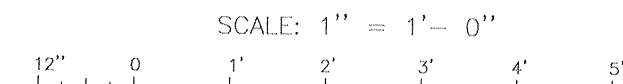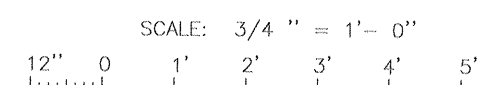

REFERENCE DRAWINGS

FOR GENERAL NOTES, SEE DWG. NO. 3
FOR FLOODWALL PLAN, SEE DWG. NO. 14
FOR FLOODWALL ALIGNMENTS, SEE DWG. NO. 15, 16 AND 17.
FOR FLOODWALL PROFILES, SEE DWG. NO.'S 18 AND 19

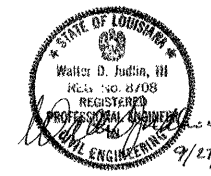

DACW29-00-B-0094

AS BUILT PLANS
DATE RECEIVED 3/15/02
DATE TRACINGS CORRECTED 4/18/02

SYMBOL	DESCRIPTION	DATE	APPROVED
REVISIONS			

U.S. ARMY ENGINEER DISTRICT, NEW ORLEANS
CORPS OF ENGINEERS
NEW ORLEANS, LOUISIANA

BOARD OF LEVEE COMMISSIONERS
ORLEANS LEVEE BOARD
NEW ORLEANS, LOUISIANA


HARTMAN ENGINEERING, INC.
CONSULTING ENGINEERS
KENNER, LOUISIANA

LAKE PONTCHARTRAIN, LA. AND VICINITY
HIGH LEVEL PLAN
ORLEANS AVENUE OUTFALL CANAL
PHASE 1B
ORLEANS PARISH
LOUISIANA



ROBERT E. LEE BOULEVARD BRIDGE
TYPICAL WALL JOINTS

DESIGNED BY: M.K.R.	DATE: OCT. 1999	PLOT SCALE: 1	PLOT DATE: OCTOBER, 1999
DRAWN BY: L.A.C.	CADD FILE: SHT26.DGN	FILE NO. H-4-44776	
CHECKED BY: W.D.L.	SUBMITTED BY: HARTMAN ENGINEERING	SOLICITATION NO. DACW29-	DWG. 26 OF 59



FILE: D:\SHT26.DWG Date: 08/06/02 10:57 a.m. Scale: 1:1, B.L.C.

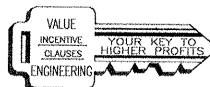



Safety is a Part of Your Contract

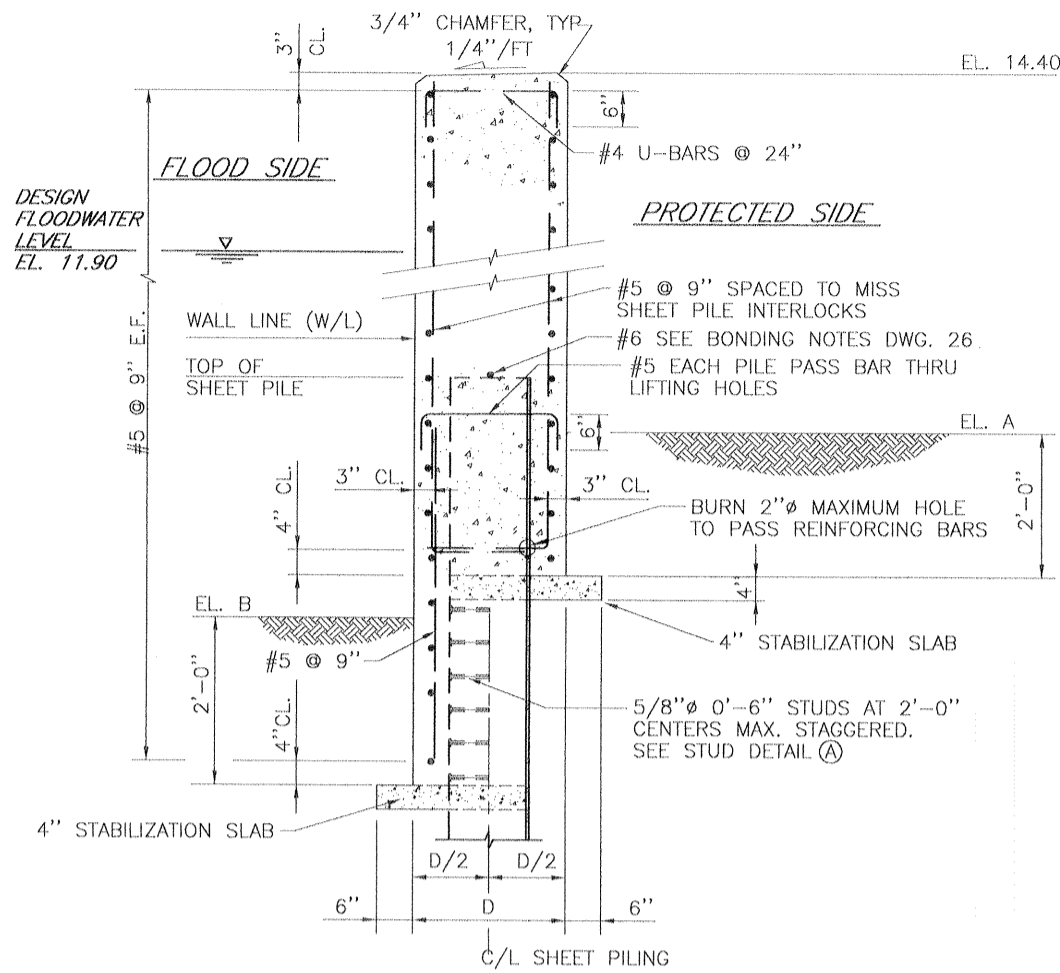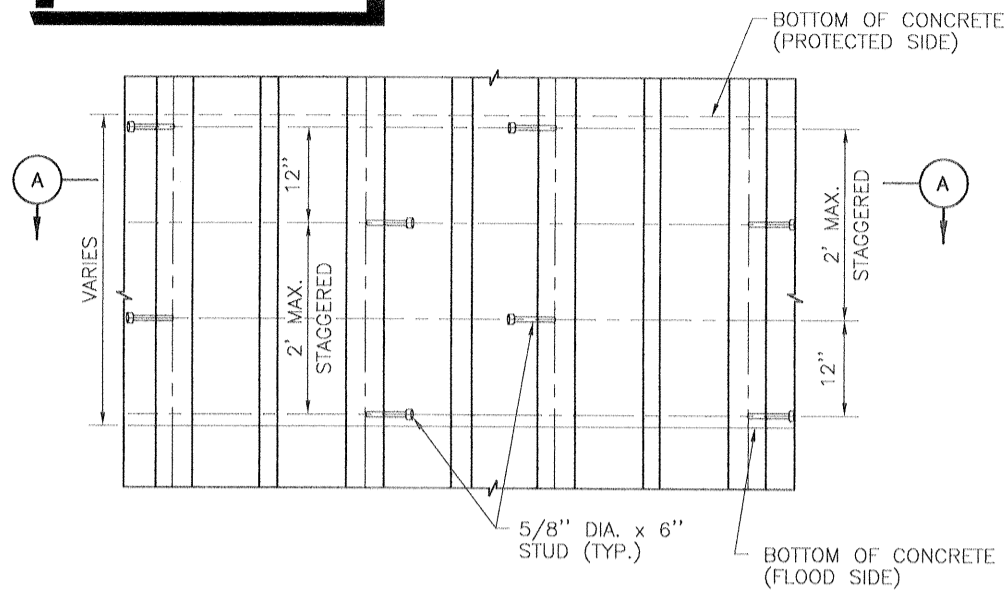

PANEL NO.	WALL LENGTH	WALL TYPE	ELEV. A	ELEV. B	C	D	X	S.P. TYPE	ELEV.
1	30'-0"	I	5.4± TO 8.8±	2.8± TO 8.8±		2'-1 3/8"			-15.50 TO -8.00
2	30'-0"	I	8.8± TO 9.5±	8.8± TO 9.5±		2'-1 3/8"			-8.00 TO -1.00
3	30'-0"	I	9.5± TO 8.5±	9.5± TO 8.5±		1'-9 1/2"			-1.00 TO 0.00
4	30'-0"	I	8.5±	8.5±		1'-9 1/2"			0.00
5	30'-0"	I	8.5± TO 9.8±	8.5± TO 9.8±		1'-9 1/2"			0.00
6	30'-0"	I	9.8± TO 12.0±	9.8± TO 12.0±		1'-9 1/2"			0.00
7	16'-0 1/8"	I	△ 12.0±	△ 12.0±		1'-9 1/2"			0.00
8	30'-0"	II	5.6± TO 8.2±	2.8± TO 7.5±	1'-1 3/8"	2'-1 3/8"	5'-4 3/4"		-15.50
9	30'-0"	II	8.2± TO 9.0±	7.5± TO 9.0±	1'-1 3/8"	2'-1 3/8"	3'-4 3/4"		-6.00 TO -1.00
10	30'-0"	II	9.0± TO 9.5±	9.0± TO 9.5±	1'-1 3/8"	2'-1 3/8"	3'-4 3/4"		-1.00 TO 0.00
11	30'-0"	II	9.5± TO 11.4±	9.5± TO 11.4±	1'-1 3/8"	2'-1 3/8"	3'-4 3/4"		0.00
12	30'-0"	I	11.4± TO △ 12.4±	11.4± TO △ 12.4±		2'-1 3/8"			0.00
13	23'-6"	I	△ 12.4± TO △ 14.2±	△ 12.4± TO △ 14.2±		2'-1 3/8"			0.00
14	15'-7 1/4"	II	5.5±	5.5±	1'-1 3/8"	2'-1 3/8"	6'-10 3/4"		-13.75 TO -14.00
15	30'-0"	II	5.5± TO 5.5±	2.8± TO 5.5±	1'-1 3/8"	2'-1 3/8"	6'-10 3/4"		-14.00
16	20'-3 1/8"	I	4.5± TO 5.4±	2.0± TO 2.8±		2'-1 3/8"			-21.00

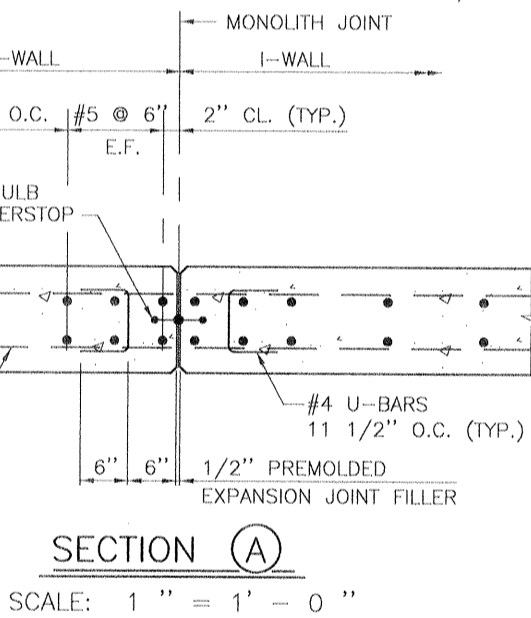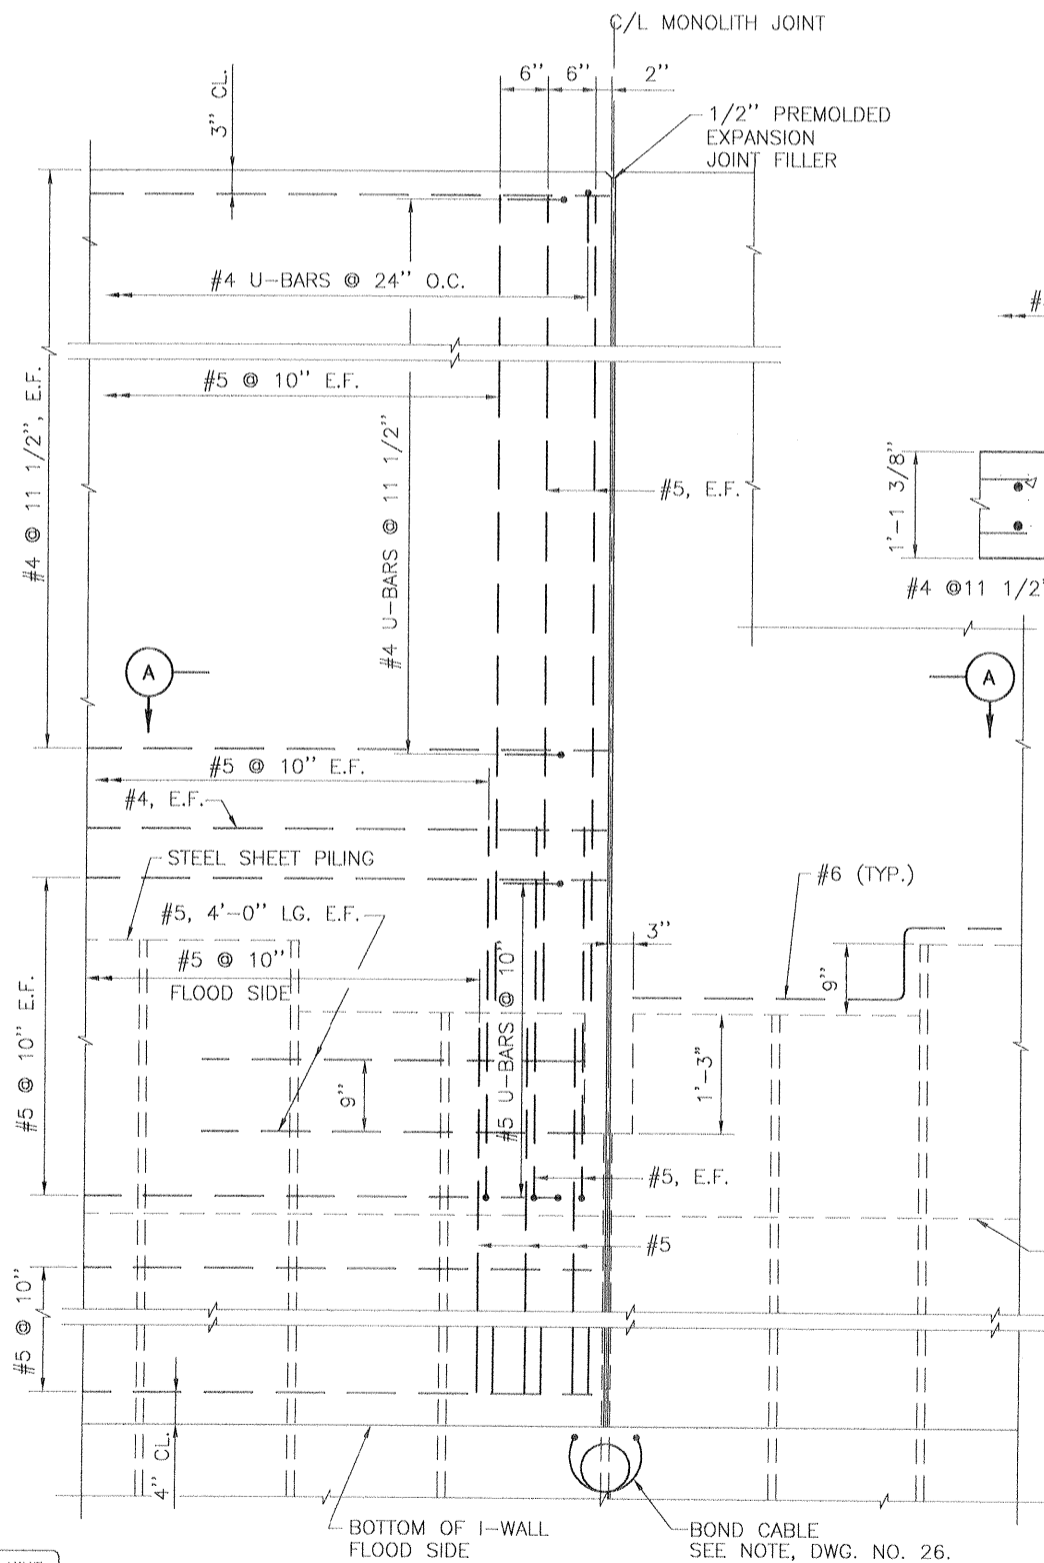

NOTE: STUDS NOT REQ'D ON FLOOD SIDE CONCRETE FOR PANELS 2-7 AND 10-14. SEE FLOODWALL PROFILES FOR SLOPING OF BOTTOM OF CONCRETE AT SLOPING GROUND.

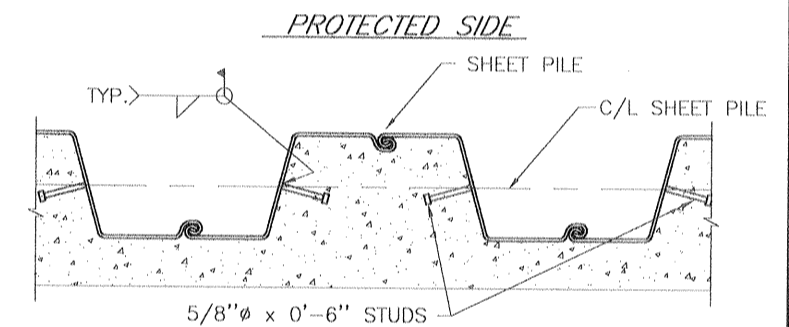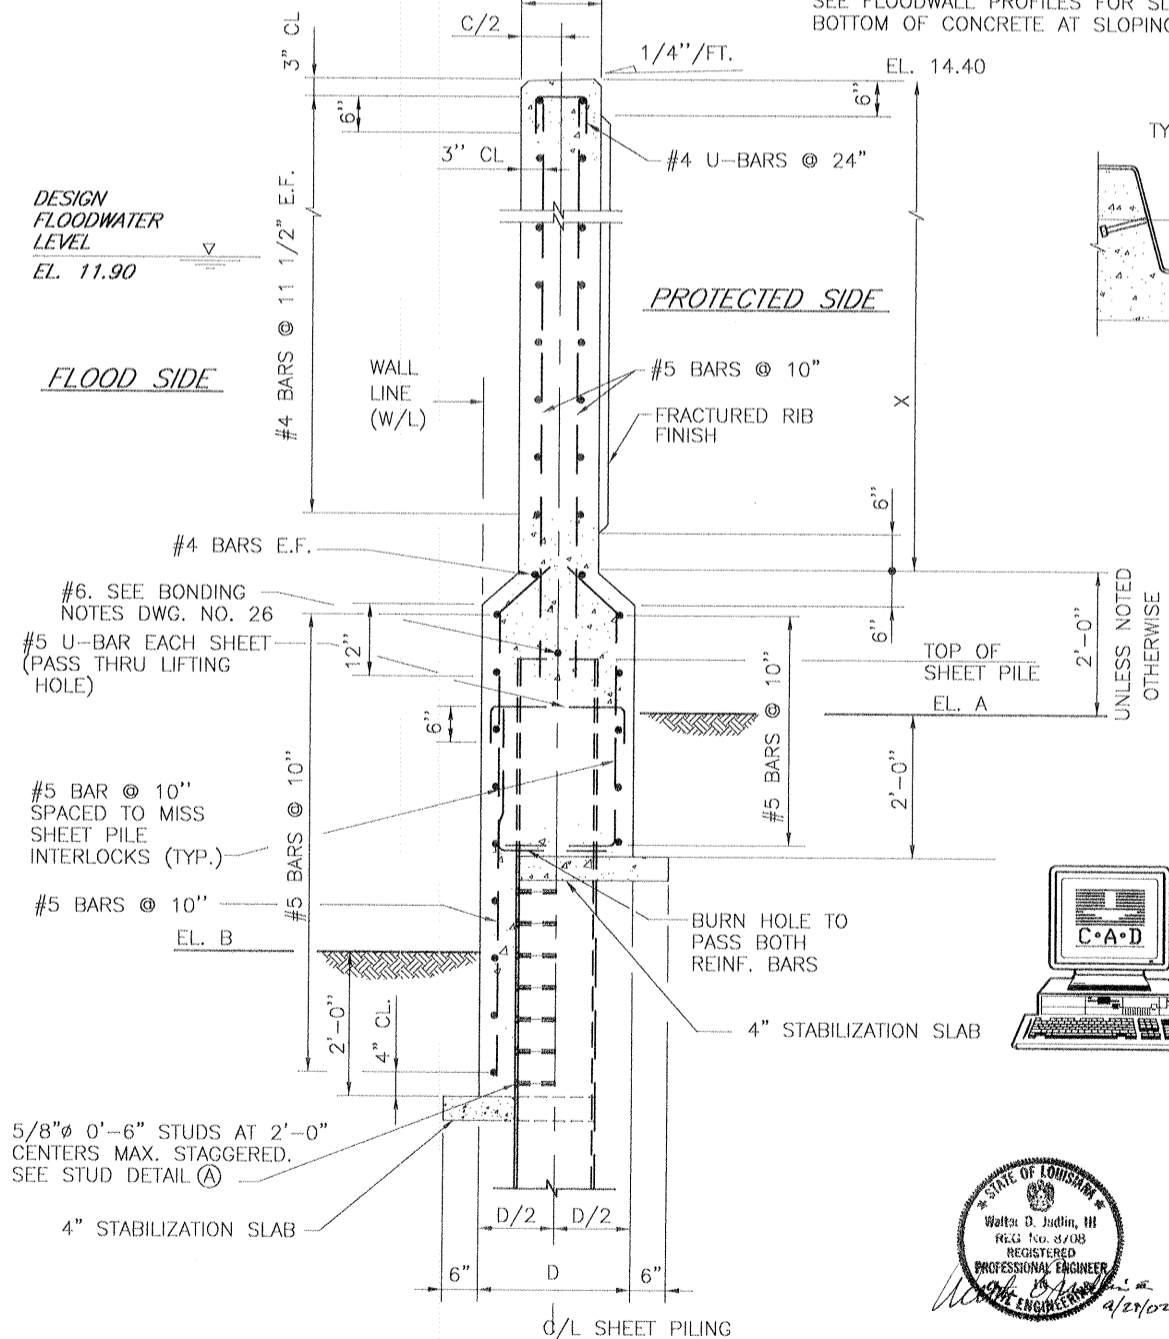

REFERENCE DRAWINGS
FOR GENERAL NOTES, SEE DWG. NO. 3
FOR FLOODWALL PLAN, SEE DWG. NO. 14
FOR FLOODWALL ALIGNMENTS, SEE DWG. NOS. 15, 16 AND 17.
FOR FLOODWALL PROFILES, SEE DWG. NOS. 18 AND 19


DACW29-00-B-0094

AS BUILT PLANS

DATE RECEIVED 3/15/02
DATE TRACINGS CORRECTED 4/18/02

CHANGED CONCRETE CAP & EXIST. SHEET PILE	03/15/02	W.D.J.
DESCRIPTION	DATE	APPROVED
REVISIONS		
U.S. ARMY ENGINEER DISTRICT, NEW ORLEANS CORPS OF ENGINEERS NEW ORLEANS, LOUISIANA		
BOARD OF LEVEE COMMISSIONERS ORLEANS LEVEE BOARD NEW ORLEANS, LOUISIANA	HARTMAN ENGINEERING, INC. CONSULTING ENGINEERS KENNER, LOUISIANA	
LAKE PONCHARTRAIN, LA. AND VICINITY HIGH LEVEL PLAN ORLEANS AVENUE OUTFALL CANAL PHASE 1B ORLEANS PARISH LOUISIANA		
ROBERT E. LEE BOULEVARD BRIDGE I-WALL REINFORCING & DETAILS		
DESIGNED BY: M.K.R.	DATE: MAR. 8, 2000	PLOT SCALE: 1
DRAWN BY: L.A.C.	CHECKED BY: W.D.L.	FILE NO. H-4-44776
SUBMITTED BY: HARTMAN ENGINEERING	DESIGN ENGINEER	DACW29-00-B-0094
DWG. 27 OF 59		


Safety is a Part of Your Contract

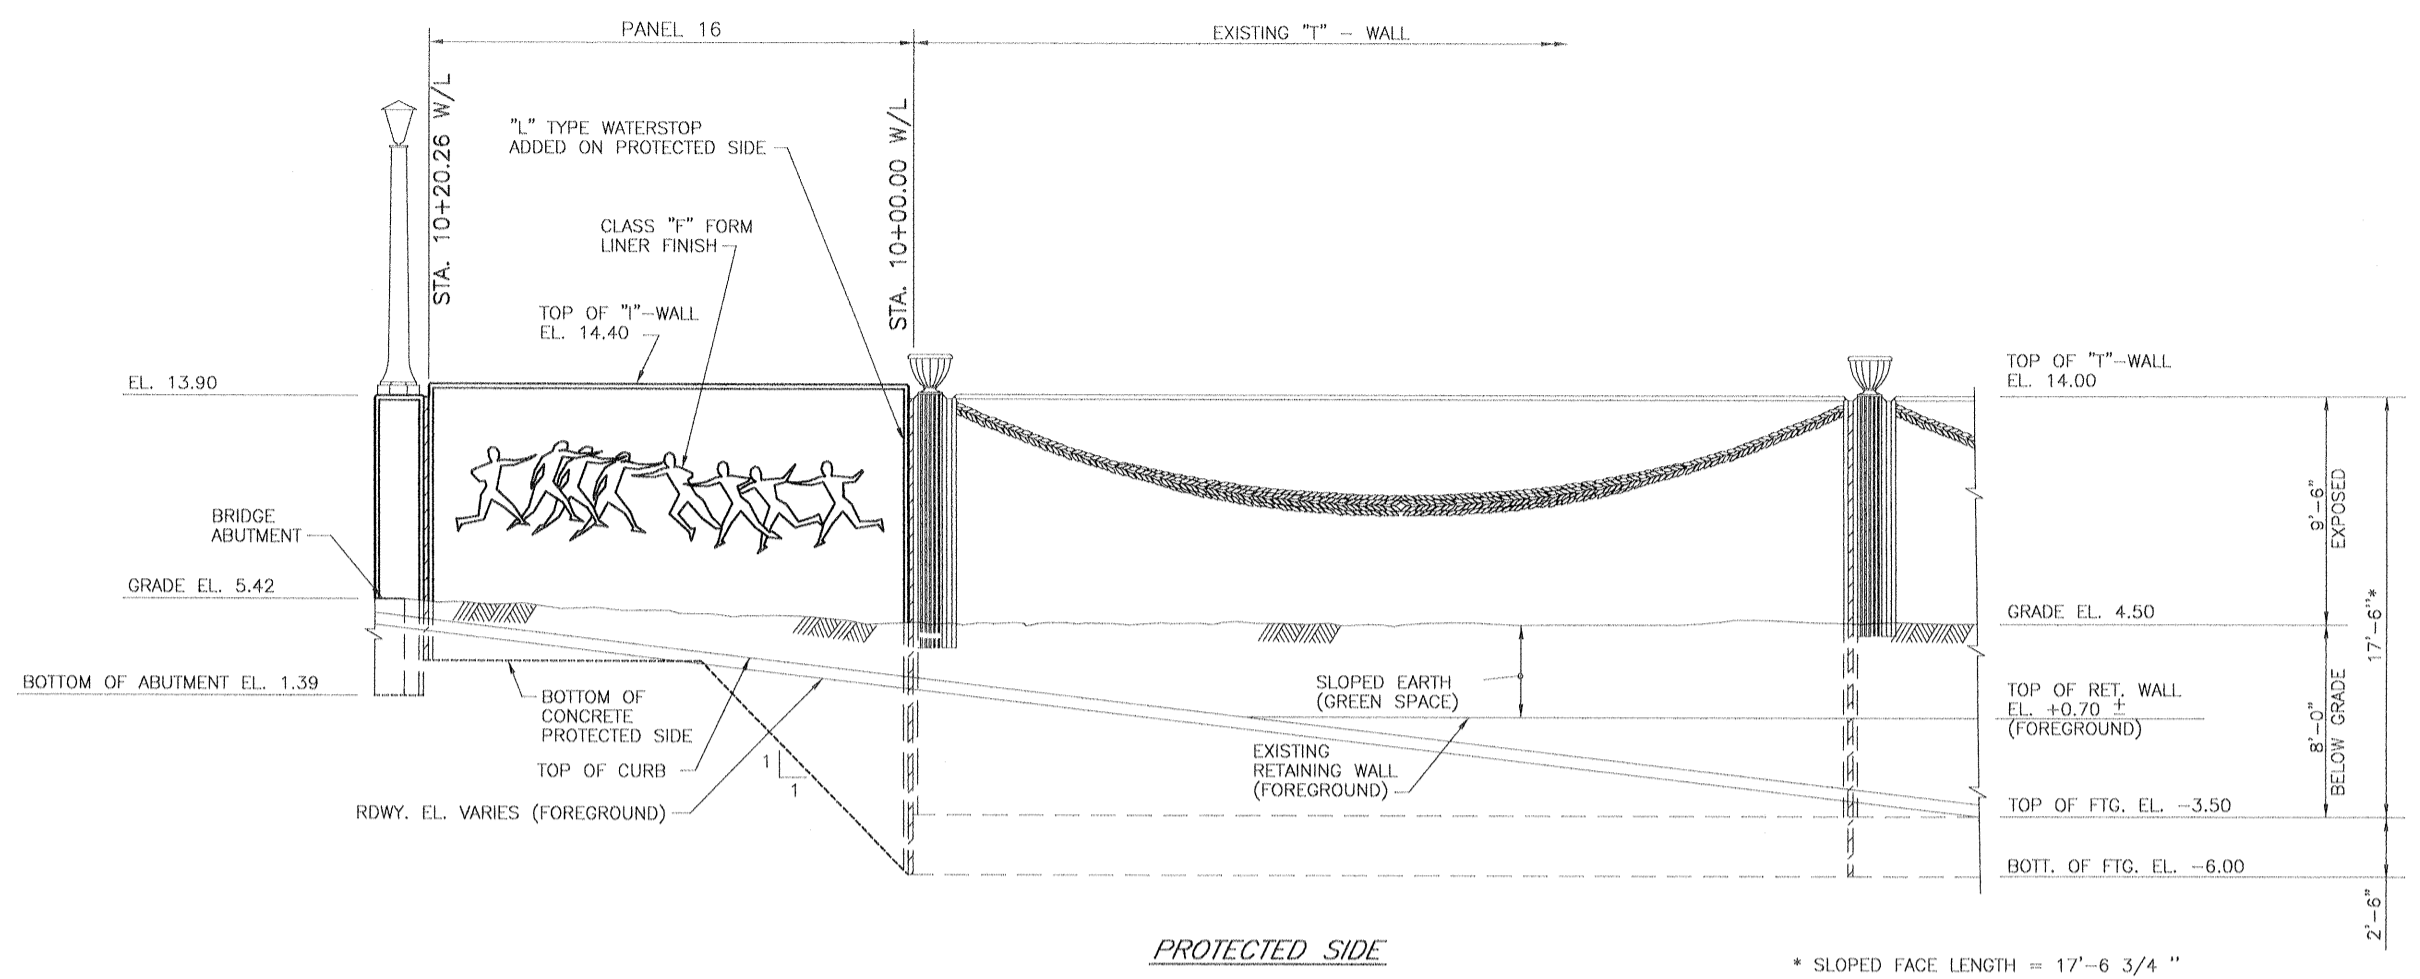


SOUTHWEST "I" WALL TREATMENT
SCALE: 1/4" = 1'-0"

NOTES

1. THE FOOTBALL MURALS ARE TO BE FURNISHED BY THE GOVERNMENT AS PRECAST FIBERGLASS NEGATIVE MOLDS AND INCORPORATED INTO THE PROJECT BY THE CONTRACTOR. SEE THE SPECIFICATIONS FOR IDENTIFICATION OF GOVERNMENT FURNISHED PROPERTY.
2. CONTRACTOR SHALL SUBMIT DRAWINGS SHOWING THE LOCATION OF ALL JOINTS IN ALL FORMS USED FOR CONSTRUCTION FOR PRIOR APPROVAL.

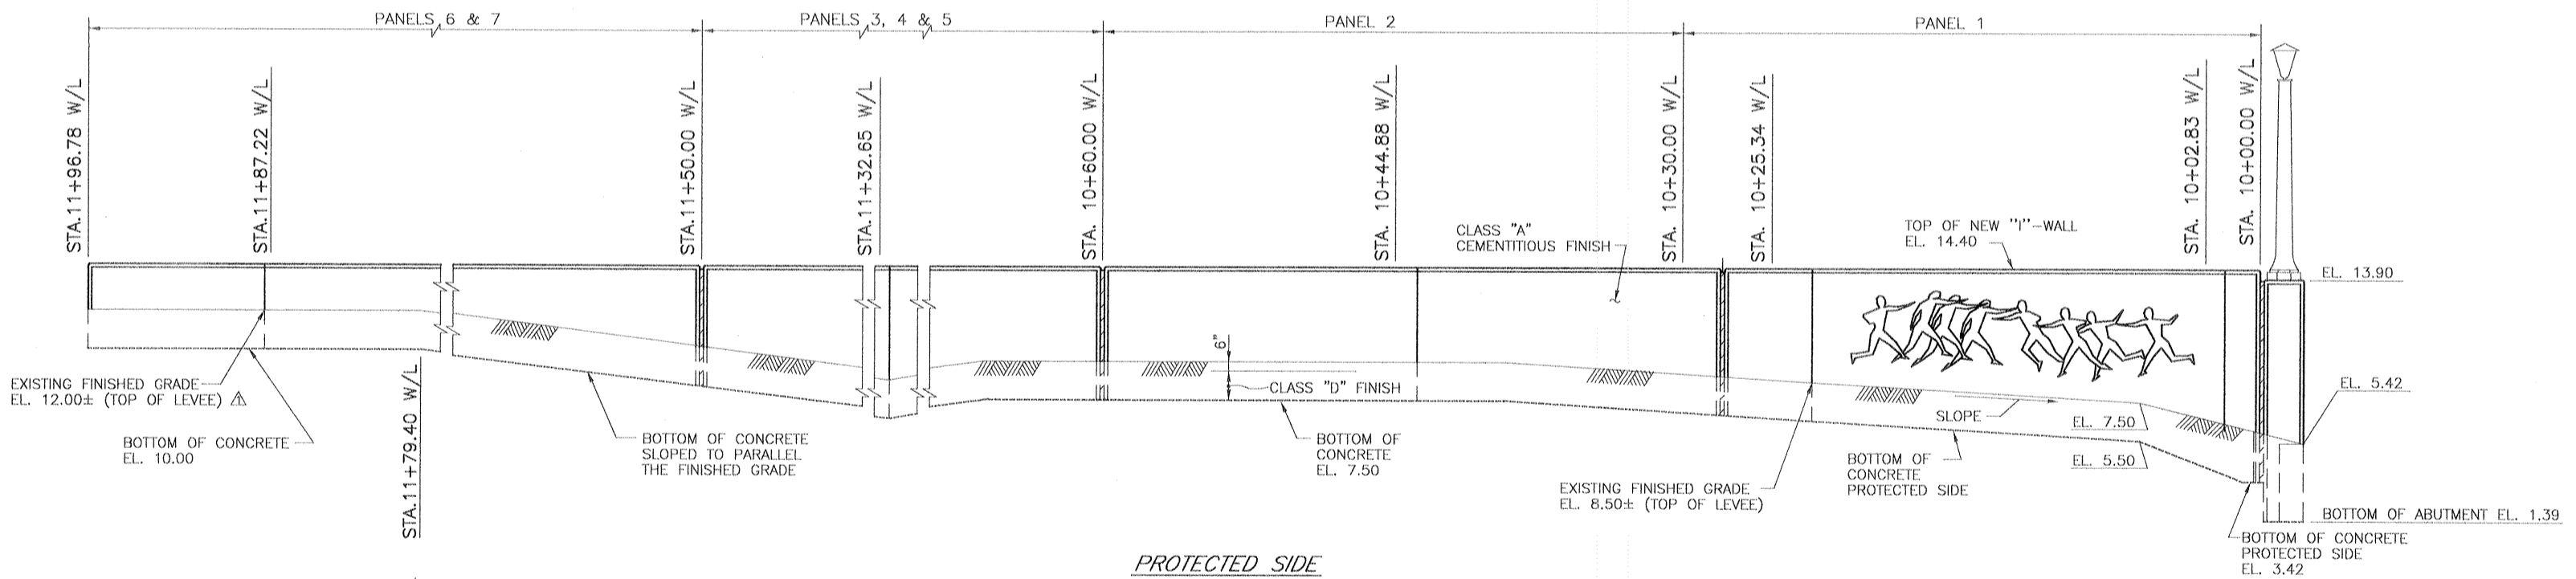

NORTHWEST "I" WALL TREATMENT
SCALE: 1/4" = 1'-0"

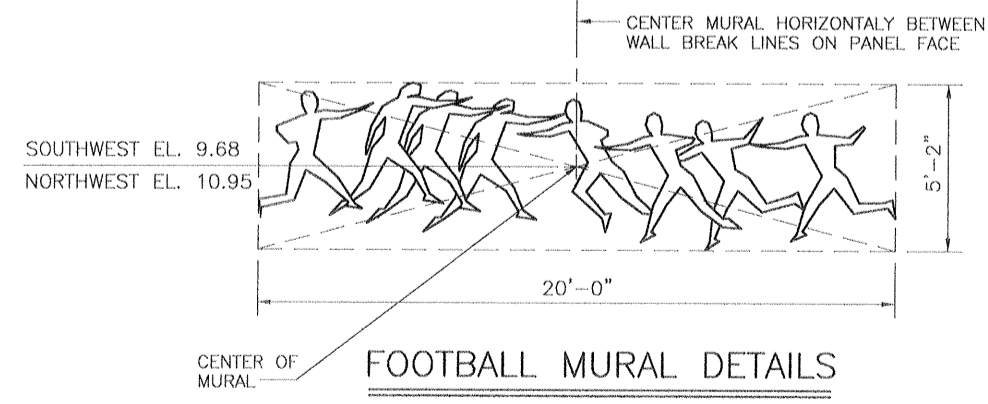


NOTE: IMAGE SHOWN MAY NOT REFLECT ACTUAL IMAGE.


- REFERENCE DRAWINGS**
- FOR GENERAL NOTES, SEE DWG. NO. 3.
 - FOR FLOODWALL PLAN, SEE DWG. NO. 14.
 - FOR FLOODWALL ALIGNMENTS, SEE DWG. NO. 15, 16 AND 17.
 - FOR FLOODWALL PROFILES, SEE DWG. NOS. 18 AND 19.
 - FOR FLOODWALL REINFORCING AND DETAILS, SEE DWG. NO. 27.

DACW29-00-B-0094

AS BUILT PLANS
DATE RECEIVED 3/15/02
DATE TRACINGS CORRECTED 4/18/02

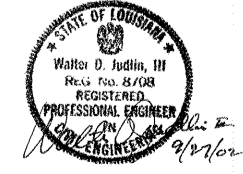

SCALE: 1/4" = 1'-0"

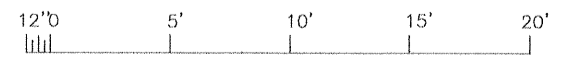

SYMBOL	DESCRIPTION	DATE	APPROVED
△	CHANGED CONCRETE CAP& EXIST. SHEET PILE HIGH LEVEL PLAN	03/15/02	W.D.J.

U.S. ARMY ENGINEER DISTRICT, NEW ORLEANS
CORPS OF ENGINEERS
NEW ORLEANS, LOUISIANA

BOARD OF LEVEE COMMISSIONERS
ORLEANS LEVEE BOARD
NEW ORLEANS, LOUISIANA

HARTMAN ENGINEERING, INC.
CONSULTING ENGINEERS
KENNER, LOUISIANA


LAKE PONTCHARTRAIN, LA. AND VICINITY
HIGH LEVEL PLAN
ORLEANS AVENUE OUTFALL CANAL
PHASE 1B
ORLEANS PARISH
LOUISIANA

ROBERT E. LEE BOULEVARD BRIDGE
I-WALL TREATMENT - WEST SIDE


DESIGNED BY: M.K.R.	DATE: MAR. 8, 2000	PLOT SCALE: 4	PLOT DATE: MARCH 8, 2000
DRAWN BY: L.A.C.	CHECKED BY: W.D.L.	GADD FILE: SHT28.DGN	FILE NO. H-4-44776
SUBMITTED BY: HARTMAN ENGINEERING DESIGN ENGINEER	SOLICITATION NO. DACW29-00-B-0094	DWG. 28 OF 59	

File: D:\SHT28.DWG Last revised: AUG. 28, 02 @ 1:28 p.m. Scale: 1/4" = 1'-0"


Safety is a Part of Your Contract

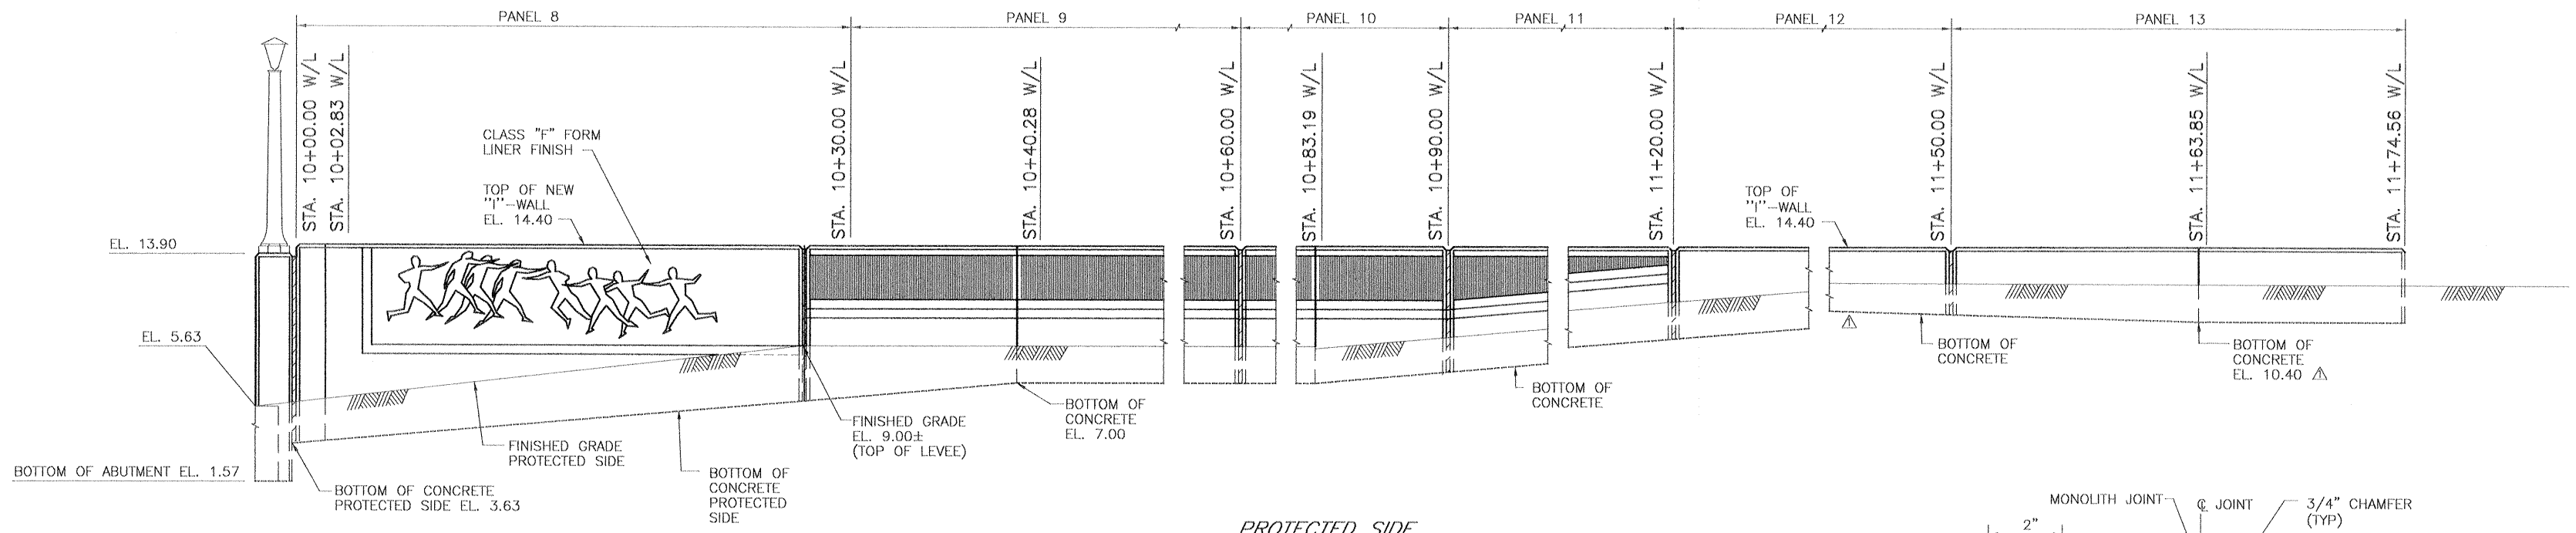


PROTECTED SIDE
NORTHEAST "I" WALL TREATMENT
 SCALE: 1/4" = 1'-0"

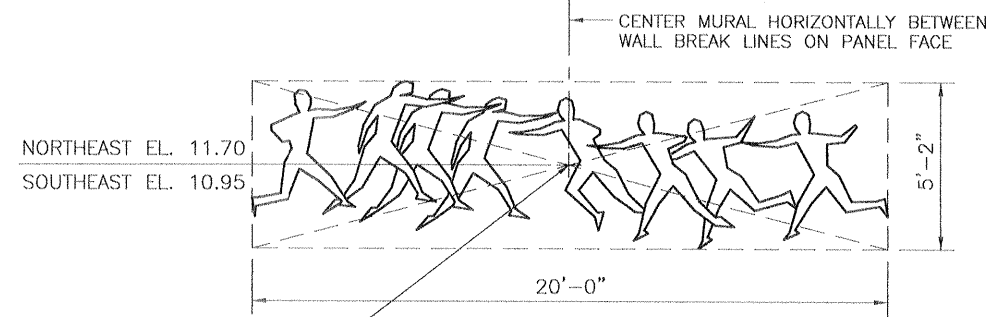


FOOTBALL MURAL DETAILS
 N.T.S.
 NOTE: IMAGE SHOWN MAY NOT REFLECT ACTUAL IMAGE.

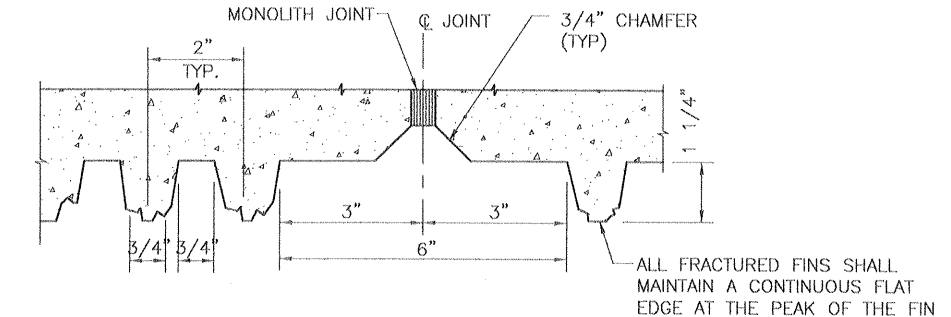

FRACTURED FIN FINISH AT TYPICAL MONOLITH JOINT
 SCALE: 6" = 1'-0"

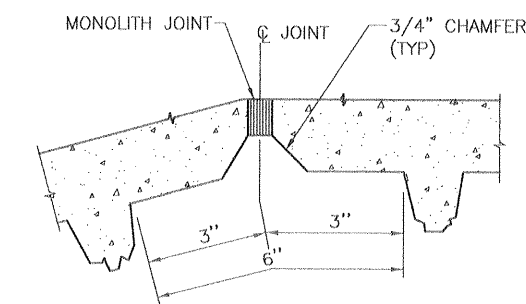

FRACTURED FIN FINISH AT P.I. OR JOINT
 SCALE: 6" = 1'-0"

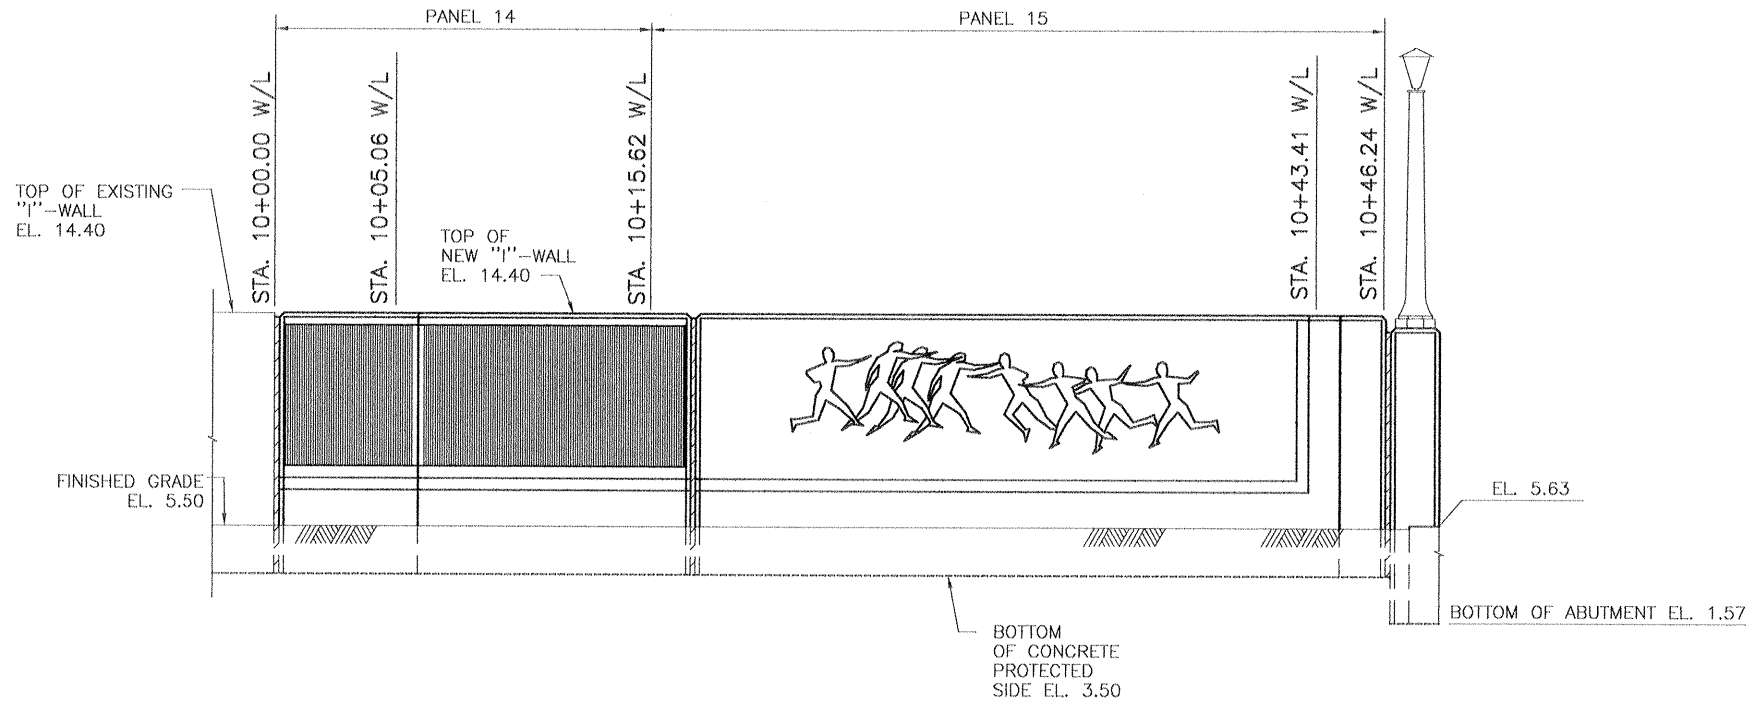


PROTECTED SIDE
SOUTHEAST "I" WALL TREATMENT
 SCALE: 1/4" = 1'-0"

NOTES

1. THE FOOTBALL MURALS ARE TO BE FURNISHED BY THE GOVERNMENT AS PRECAST FIBERGLASS NEGATIVE MOLDS AND INCORPORATED INTO THE PROJECT BY THE CONTRACTOR. SEE THE SPECIFICATIONS FOR IDENTIFICATION OF GOVERNMENT FURNISHED PROPERTY.
2. CONTRACTOR SHALL SUBMIT DRAWINGS SHOWING THE LOCATION OF ALL JOINTS IN ALL FORMS USED FOR CONSTRUCTION FOR PRIOR APPROVAL.
3. NO HORIZONTAL SPLICING OF FRACTURED FIN FORM LINER SHALL BE ALLOWED.

REFERENCE DRAWINGS
 FOR GENERAL NOTES, SEE DWG. NO. 3.
 FOR FLOODWALL PLAN, SEE DWG. NO. 14.
 FOR FLOODWALL ALIGNMENTS, SEE DWG. NO. 15, 16 AND 17.
 FOR FLOODWALL PROFILES, SEE DWG. NO'S. 18 AND 19.
 FOR FLOODWALL REINFORCING AND DETAILS, SEE DWG. NO. 27.

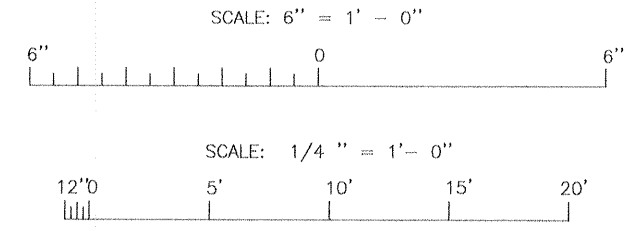

DACW29-00-B-0094
AS BUILT PLANS
 DATE RECEIVED 3/15/02
 DATE TRACINGS CORRECTED 4/18/02

SYMBOL	DESCRIPTION	DATE	APPROVED
△	CHANGED CONCRETE CAP & EXIST. SHEET FILE	03/15/01	W.D.J.


U.S. ARMY ENGINEER DISTRICT, NEW ORLEANS
 CORPS OF ENGINEERS
 NEW ORLEANS, LOUISIANA

ORLEANS AVENUE OUTFALL CANAL
 PHASE 1B
 ORLEANS PARISH
 LOUISIANA


ROBERT E. LEE BOULEVARD BRIDGE
 I-WALL TREATMENT - EAST SIDE

DESIGNED BY: M.K.R.	DATE: MAR. 8, 2000	PLOT SCALE: 4	PLOT DATE: MARCH 8, 2000
DRAWN BY: L.A.C.	CHECKED BY: W.D.L.	CADD FILE: SHIT29.DWG	FILE NO. H-4-44776
SUBMITTED BY: HARTMAN ENGINEERING DESIGN ENGINEER	SOLICITATION NO. DACW29-00-B-0094	DWG. 29 OF 59	


FILE: D:\S\2729.DWG LAST EDITED: AUG. 28. 02 @ 11:40 P.M. SCALE: 1/4" = 1'-0"

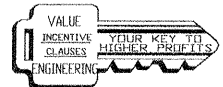


Safety is a Part of Your Contract

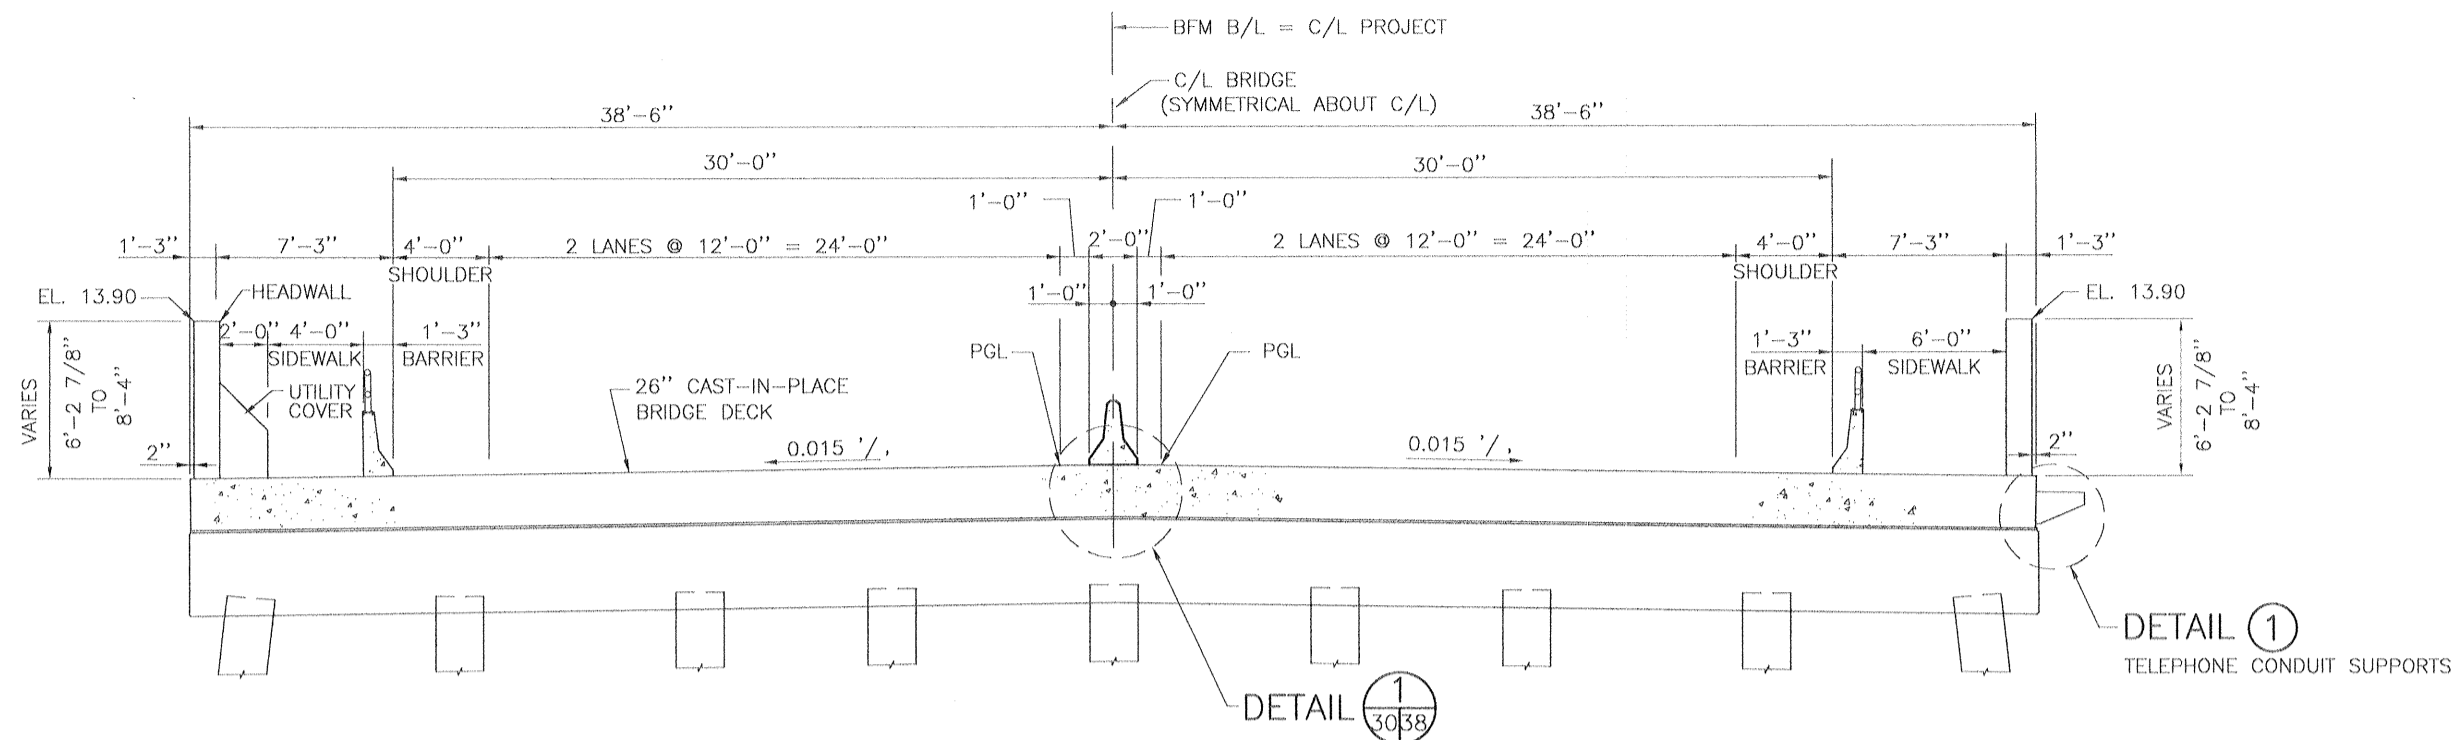


SECTION (A)
SCALE: 1/4" = 1'-0"

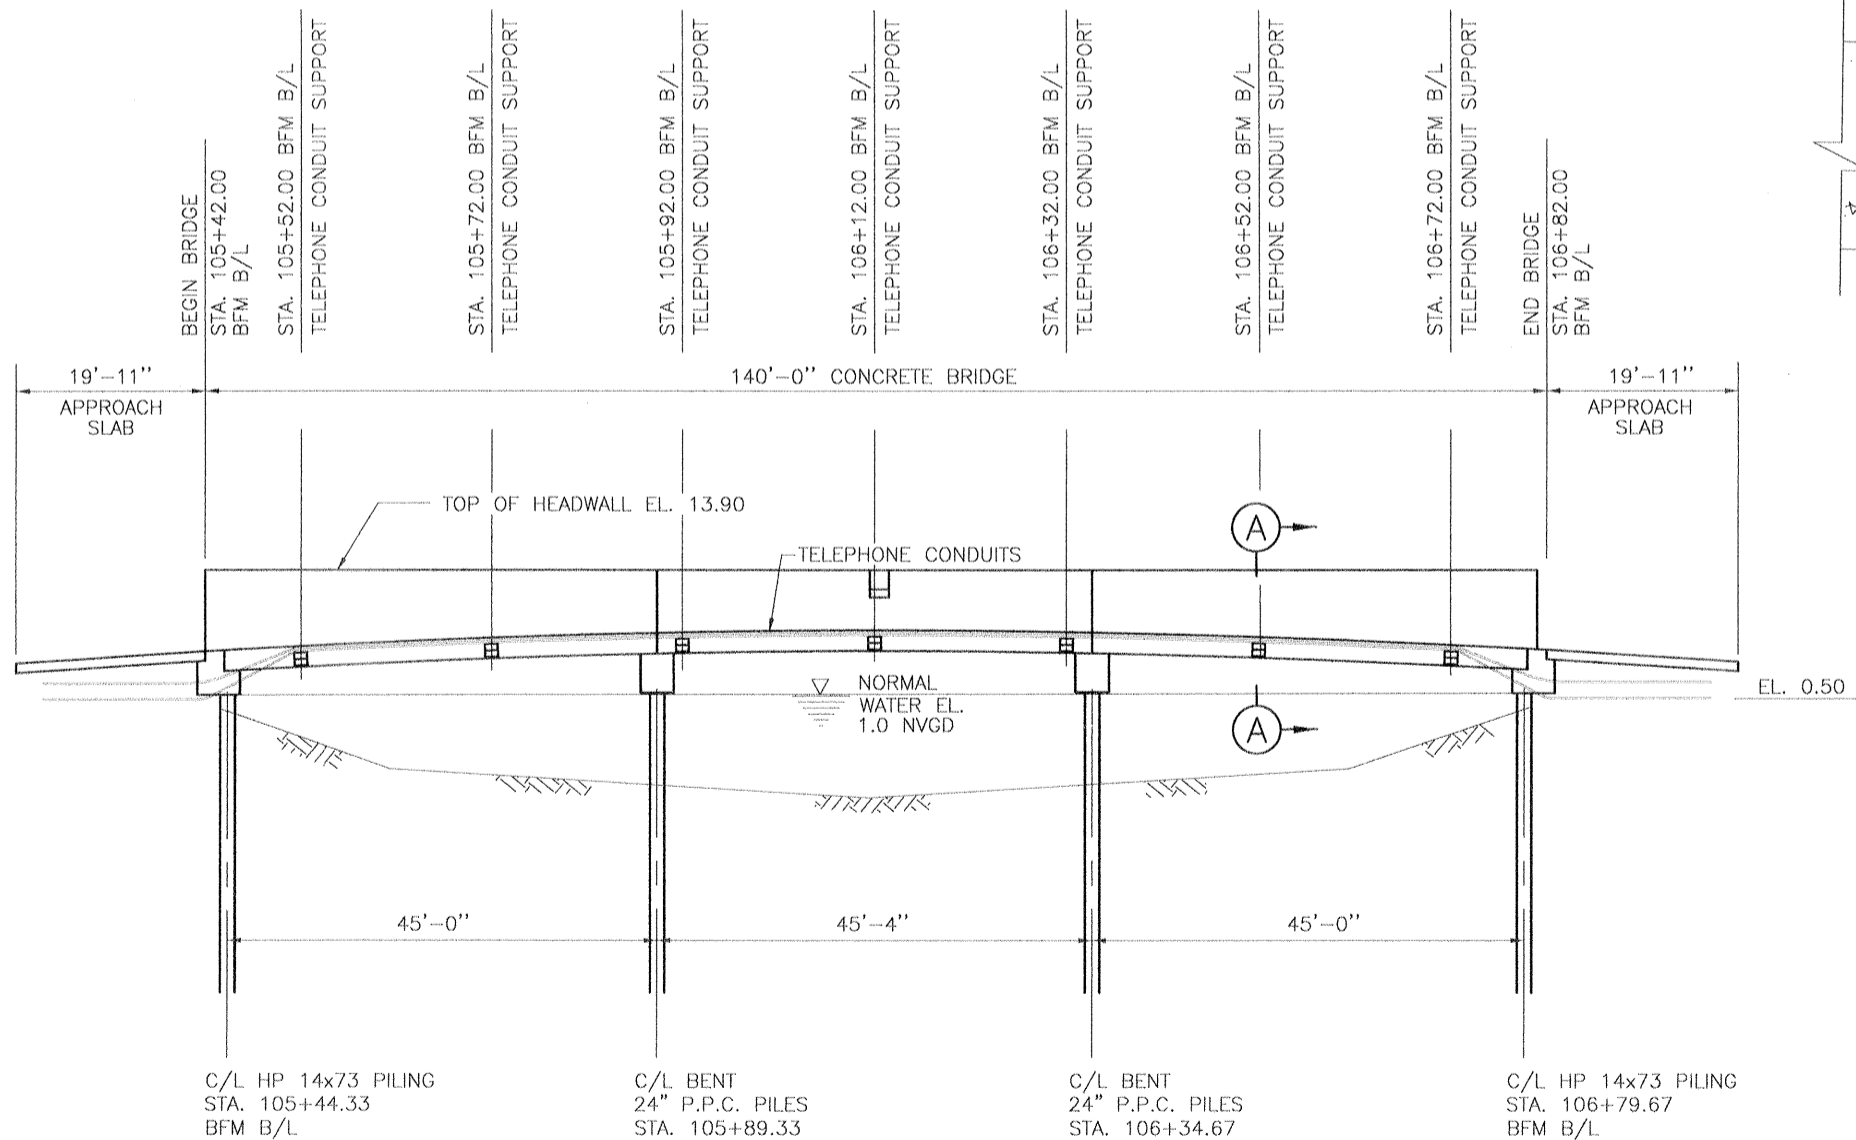

BRIDGE ELEVATION
SCALE: 1" = 10'

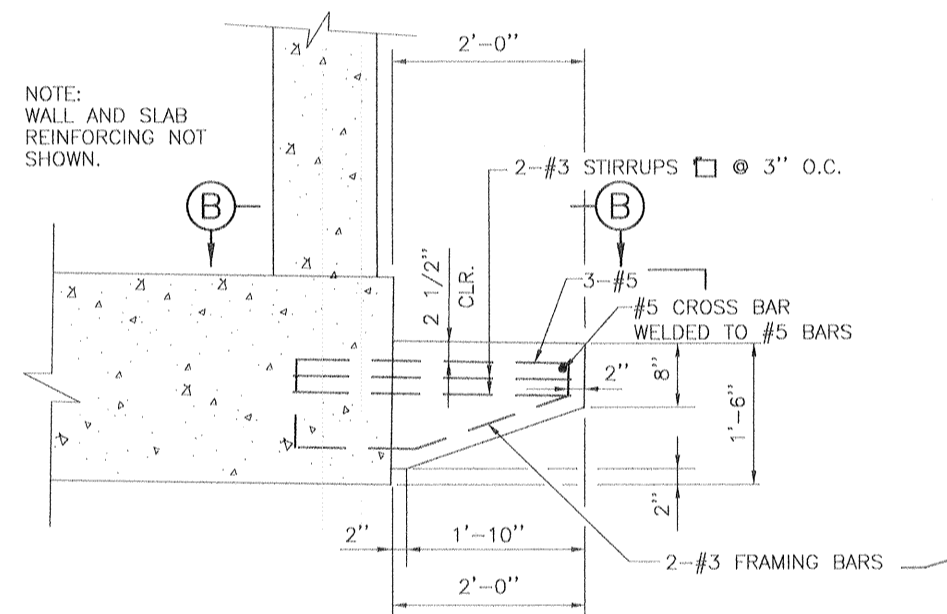



DETAIL (1)
SCALE: 1" = 1'-0"

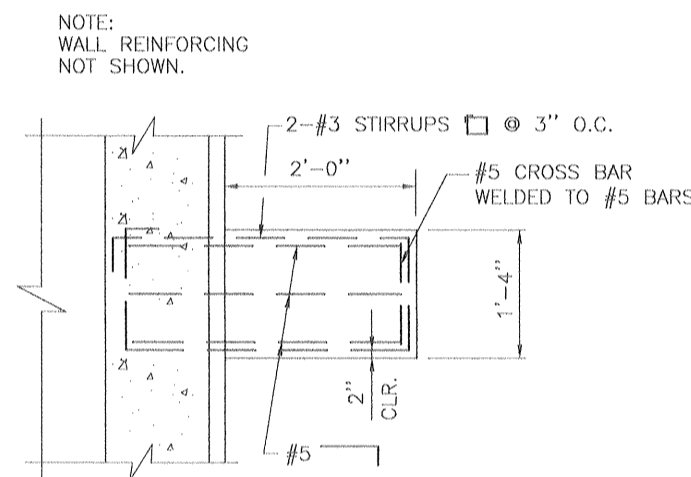

SECTION (B)
SCALE: 1" = 1'-0"

REFERENCE DRAWINGS

1. FOR GENERAL NOTES, SEE DWG. NO. 3.
2. FOR PLAN/PROFILE, SEE DWG. NO. 5.
3. FOR UTILITY PLAN AND DETAILS, SEE DWG. NO. 11, 12 AND 13.
4. FOR FLOODWALL PLAN, SEE DWG. NO. 14.

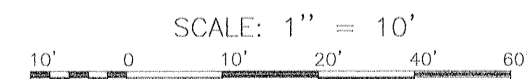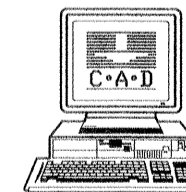

DACW29-00-B-0094

AS BUILT PLANS

DATE RECEIVED 3/15/02
DATE TRACINGS CORRECTED 4/18/02

SYMBOL	DESCRIPTION	DATE	APPROVED
REVISIONS			

U.S. ARMY ENGINEER DISTRICT, NEW ORLEANS
CORPS OF ENGINEERS
NEW ORLEANS, LOUISIANA


BOARD OF LEVEE COMMISSIONERS
ORLEANS LEVEE BOARD
NEW ORLEANS, LOUISIANA

HARTMAN ENGINEERING, INC.
CONSULTING ENGINEERS
KENNER, LOUISIANA


LAKE PONTCHARTRAIN, LA. AND VICINITY
HIGH LEVEL PLAN
ORLEANS AVENUE OUTFALL CANAL
PHASE 1B
ORLEANS PARISH
LOUISIANA

ROBERT E. LEE BOULEVARD BRIDGE
BRIDGE PLAN AND ELEVATION

DESIGNED BY: N.P.	DATE: MAR-8, 2000	PLOT SCALE: 10	PLOT DATE: MARCH 8, 2000
DRAWN BY: C.R.N.	CHECKED BY: W.D.L.	CADD FILE: SHT30.DGN	FILE NO. H-4-44776
SUBMITTED BY: HARTMAN ENGINEERING	SOLICITATION NO. DACW29-00-B-0094	DWG. 30 OF 59	

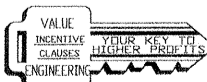


Safety is a Part of Your Contract

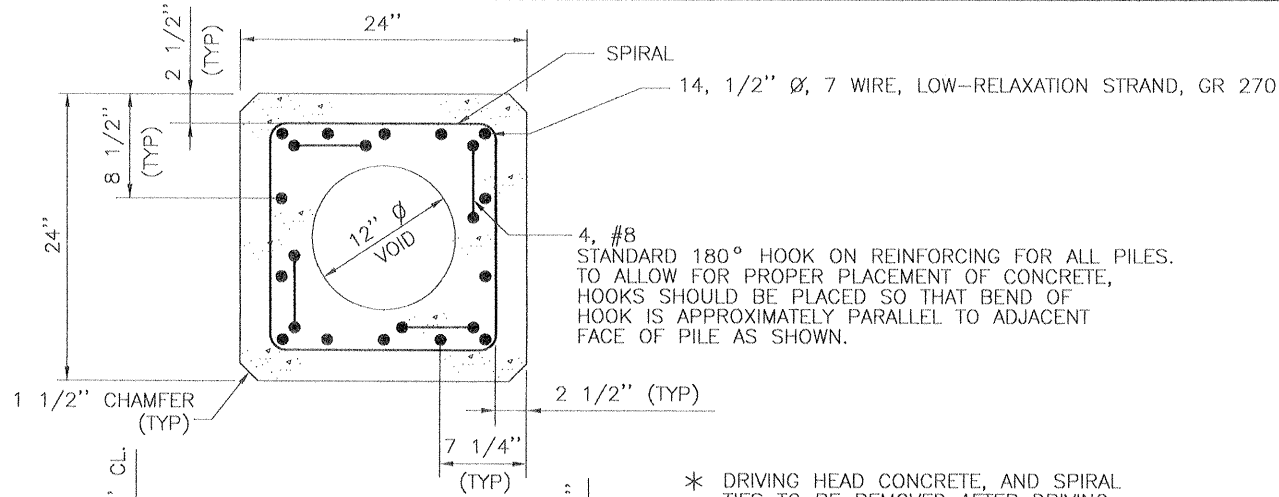


4 #8 STANDARD 180° HOOK ON REINFORCING FOR ALL PILES. TO ALLOW FOR PROPER PLACEMENT OF CONCRETE, HOOKS SHOULD BE PLACED SO THAT BEND OF HOOK IS APPROXIMATELY PARALLEL TO ADJACENT FACE OF PILE AS SHOWN.

* DRIVING HEAD CONCRETE, AND SPIRAL TIES TO BE REMOVED AFTER DRIVING TO EXPOSE HOOKS AND PRE-STRESSING STRANDS. BEND STRANDS 90° WITH TAIL APPROXIMATELY 5" ABOVE PILE CONCRETE. (NO PAYMENT)

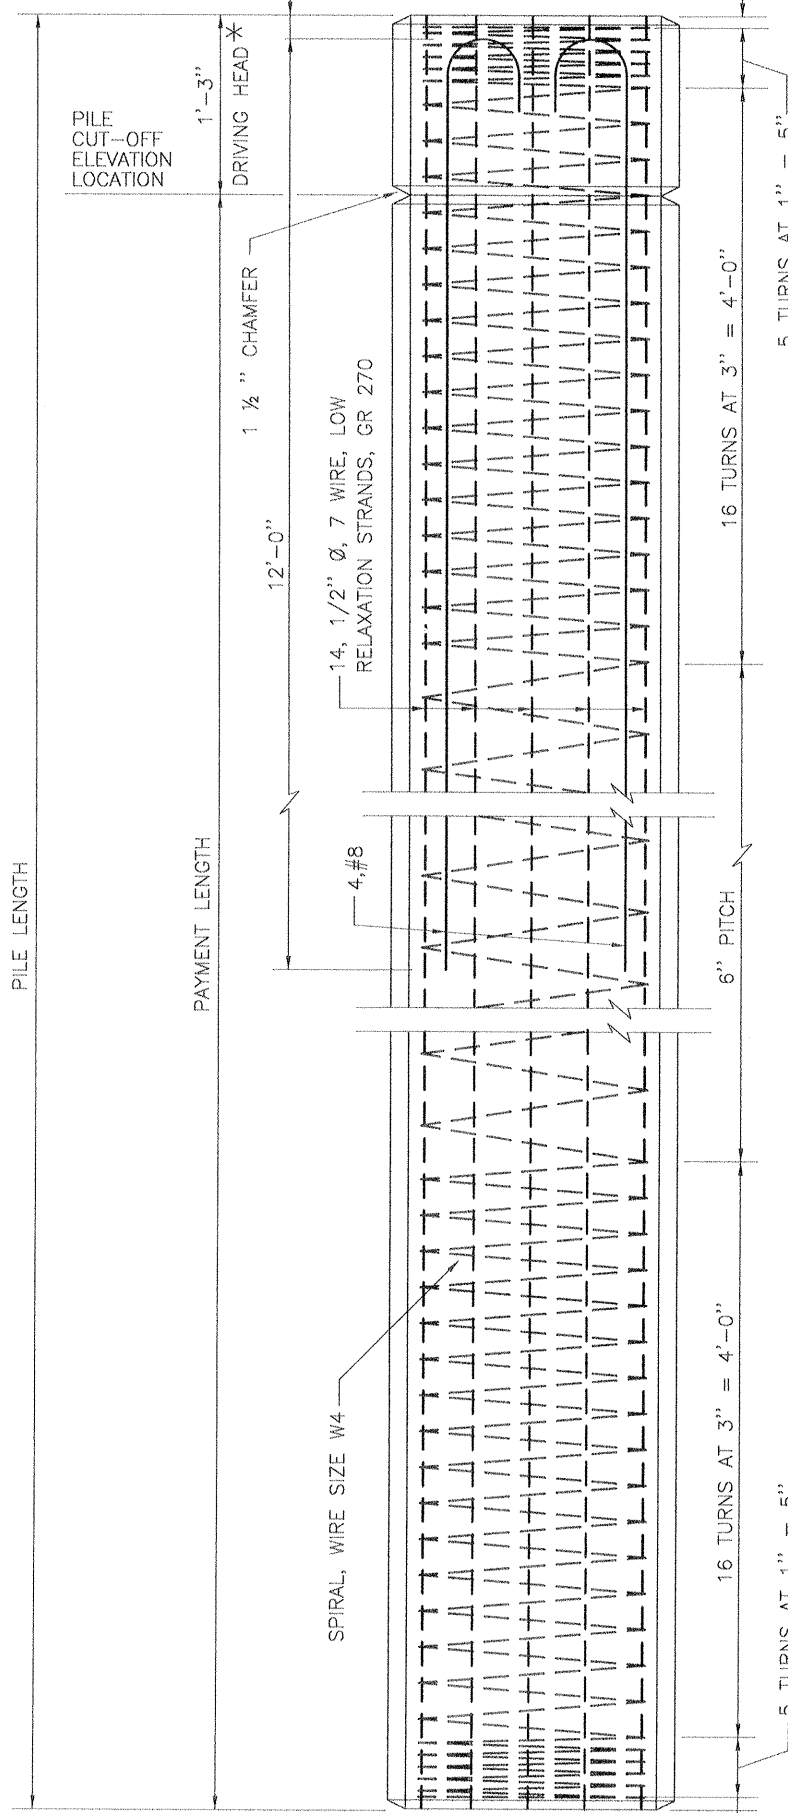

NOTE: GRIND PRESTRESSED STRANDS FLUSH WITH PILE HEAD AND PILE TIP.

24" X 24" PRESTRESSED PRECAST CONCRETE PILE

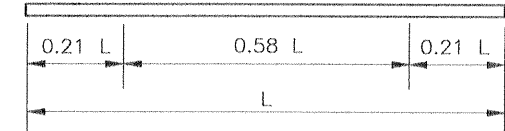

2 POINT PICKUP (≤ 117') 24" X 24" PILE

NOTE: PICKUP POINTS TO BE PLAINLY MARKED ON PILES

PILE SCHEDULE				
BFM B/L STATIONS	PILE SIZE	NUMBER OF PILES	PILE LENGTH *	PILE BATTER
105+89.33 (BENT ②)	24" x 24"	7	88.5'	VERTICAL
		2	88.5'	12V on 1H
106+34.67 (BENT ③)	24" x 24"	7	88.5'	VERTICAL
		2	88.5'	12V on 1H



* PILE LENGTH INCLUDES 1'-3" DRIVING HEAD

NOTES:

- PILES SHALL BE DRIVEN TO ACHIEVE REQUIRED EMBEDMENT IN PILE CAPS AND TO THE TOLERANCES SPECIFIED IN SECTION 02365 OF THE SPECIFICATIONS.
- PILE LENGTH BASED ON MINIMUM REQUIRED TIP ELEVATION OF -84.0 NGVD..

REFERENCE DRAWINGS

- FOR GENERAL NOTES, SEE DWG. NO. 3
- FOR PLAN/PROFILE, SEE DWG. NO. 5
- FOR BENT DETAILS, SEE DWG. NO. 37

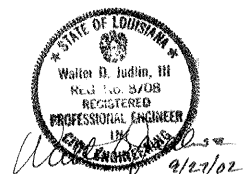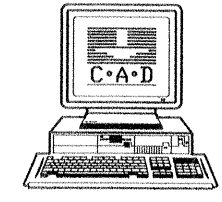


DACW29-00-B-0094

AS BUILT PLANS


DATE RECEIVED 3/15/02
DATE TRACINGS CORRECTED 4/18/02

SYMBOL	DESCRIPTION	DATE	APPROVED
REVISIONS			
 U.S. ARMY ENGINEER DISTRICT, NEW ORLEANS CORPS OF ENGINEERS NEW ORLEANS, LOUISIANA			
BOARD OF LEVEE COMMISSIONERS ORLEANS LEVEE BOARD NEW ORLEANS, LOUISIANA		HARTMAN ENGINEERING, INC. CONSULTING ENGINEERS KENNER, LOUISIANA	
LAKE PONTCHARTRAIN, LA. AND VICINITY HIGH LEVEL PLAN ORLEANS AVENUE OUTFALL CANAL PHASE 1B ORLEANS PARISH LOUISIANA			
ROBERT E. LEE BOULEVARD BRIDGE PRESTRESSED CONCRETE PILES			
DESIGNED BY: N.P.	DATE: MAR. 8, 2000	PLOT SCALE: 8	PLOT DATE: MARCH 8, 2000
DRAWN BY: C.R.N.	CHECKED BY: W.D.L.	CADD FILE: SHT31.DGN	FILE NO. H-4-44776
SUBMITTED BY: HARTMAN ENGINEERING DESIGN ENGINEER		SOLICITATION NO. DACW29-00-B-0094	
			DWG. 31 OF 59

FILE: D:\AS\BUILT.DWG LAST EDITED: AUG. 02 @ 8:40 P.M. SCALE: 1:8 R.L.C.

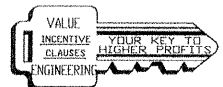


Safety is a Part of Your Contract

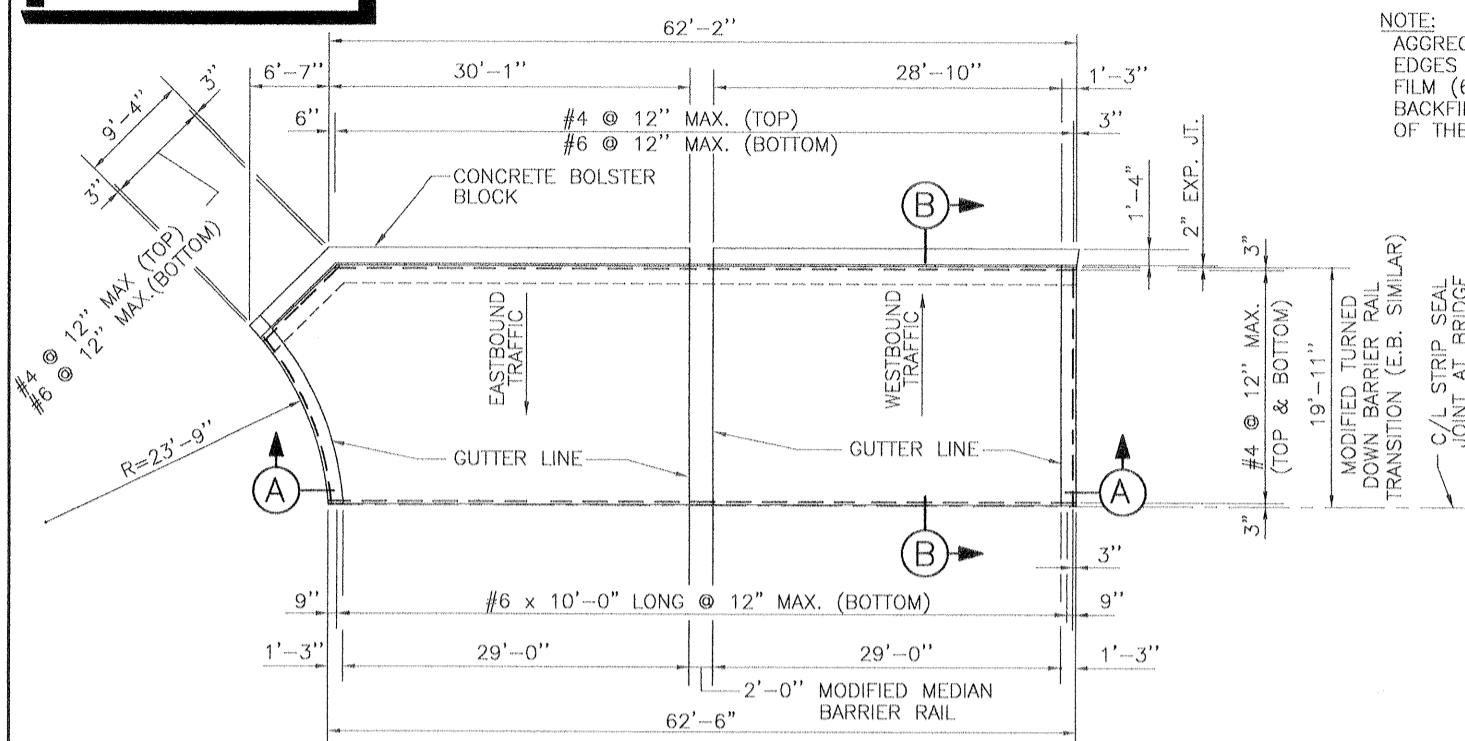

APPROACH SLAB PLAN


SCALE: 1/8" = 1'-0"

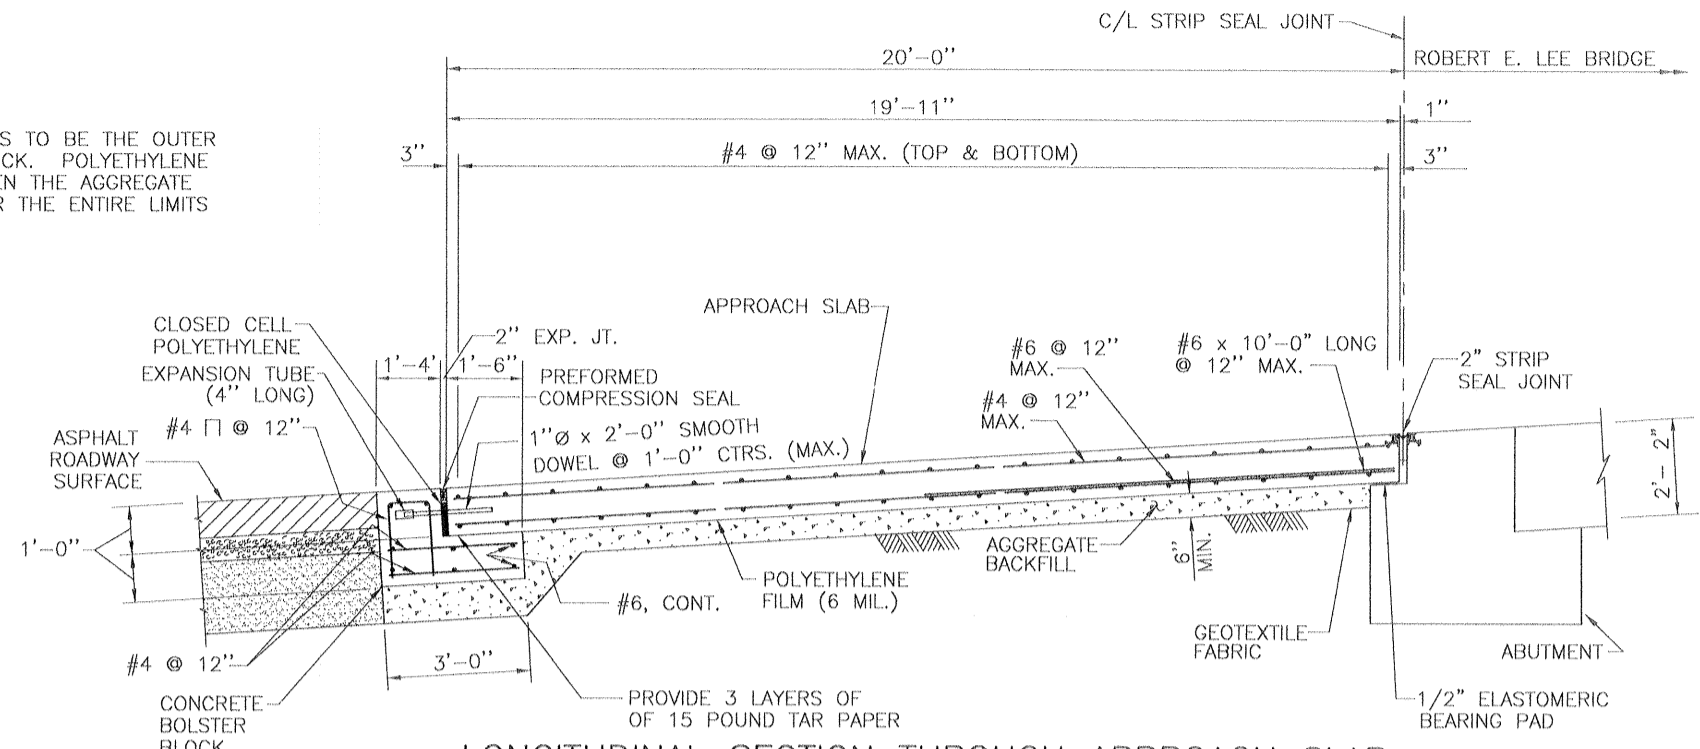

LONGITUDINAL SECTION THROUGH APPROACH SLAB


SECTION (B)

SCALE: 1/2" = 1'-0"

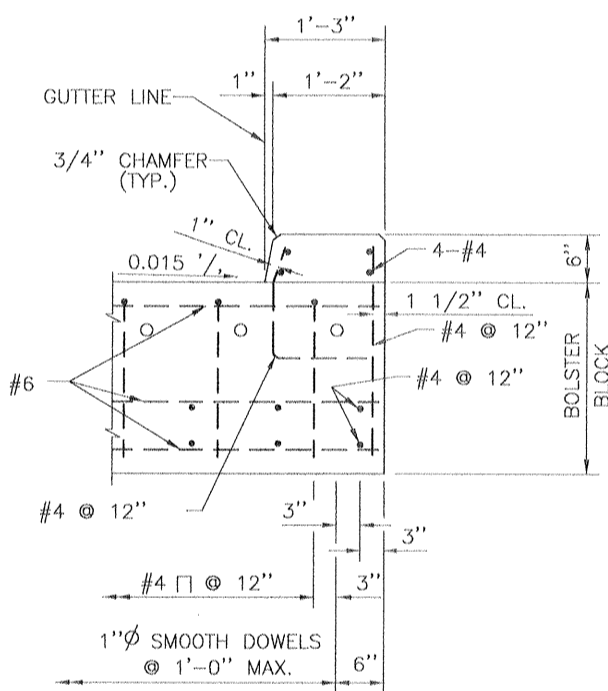


SECTION (C)

SCALE: 1" = 1'-0"

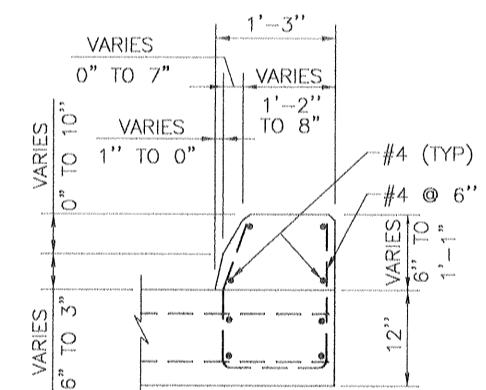


SECTION (D)

SCALE: 1" = 1'-0"

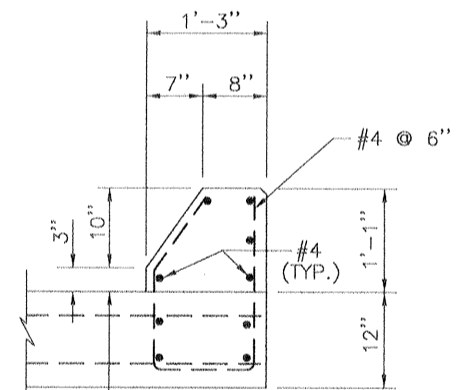


SECTION (E)

SCALE: 1" = 1'-0"

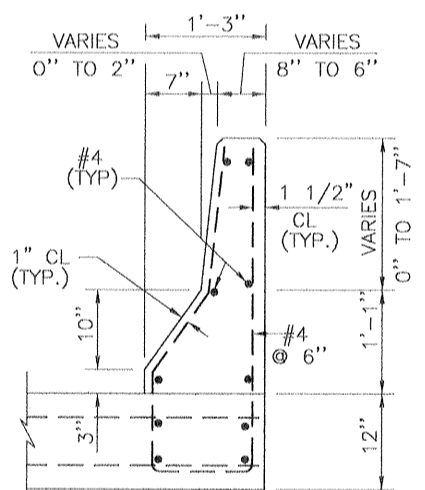

SECTION (F)



SCALE: 1" = 1'-0"

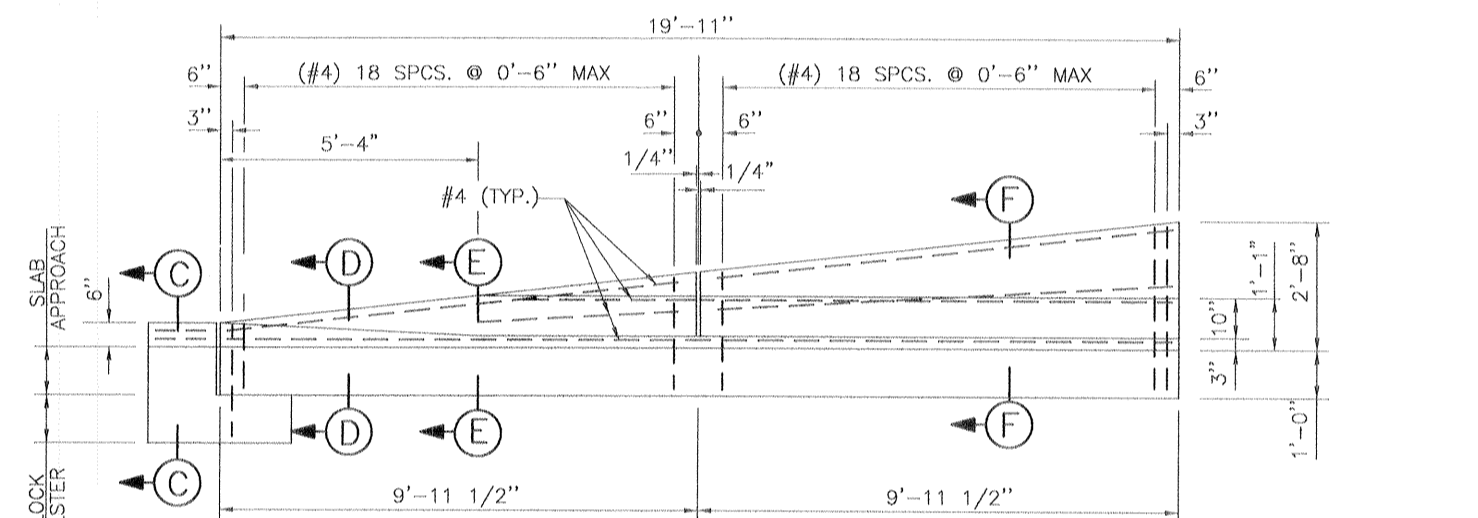

MODIFIED TURNED-DOWN BARRIER RAIL TRANSITION - WESTBOUND LANES ONLY

SCALE: 1/2" = 1'-0"
(NOTE: EASTBOUND TRANSITION SIMILAR)

REFERENCE DRAWINGS:
FOR GENERAL NOTES, SEE DWG. NO. 3
FOR PLAN/PROFILE, SEE DWG. NO. 5
FOR YEAR PLATE DETAILS, SEE DWG. NO. 53
FOR STRIP SEAL JOINT DETAILS, SEE DWG. NOS. 54 AND 55.

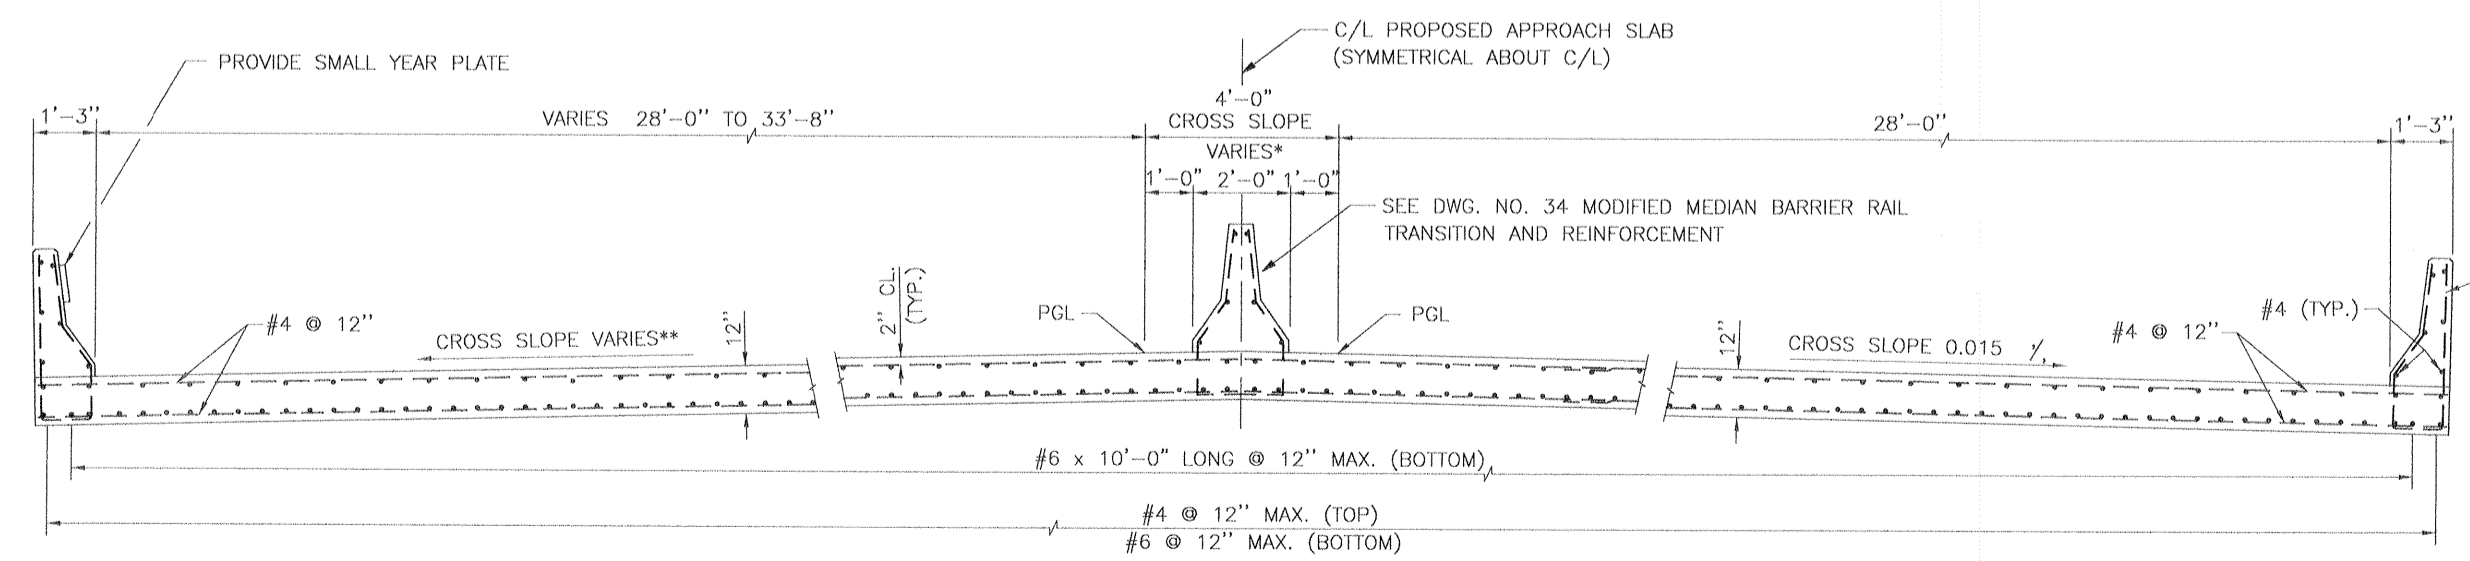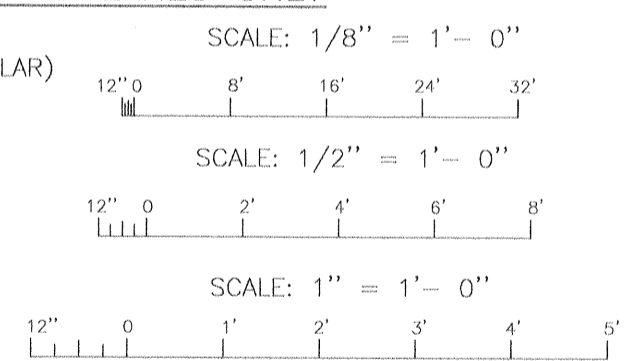

SECTION (A)

SCALE: 1/2" = 1'-0"

* SEE DWG. NO. 42 FOR CROWN DETAIL

**FOR LIMITS OF CROSS SLOPE TRANSITION, SEE DWG. NO. 5

DACW29-00-B-0094

AS BUILT PLANS


DATE RECEIVED 3/15/02
DATE TRACINGS CORRECTED 4/18/02

SYMBOL	DESCRIPTION	DATE	APPROVED
REVISIONS			
U.S. ARMY ENGINEER DISTRICT, NEW ORLEANS CORPS OF ENGINEERS NEW ORLEANS, LOUISIANA			
BOARD OF LEVEE COMMISSIONERS ORLEANS LEVEE BOARD NEW ORLEANS, LOUISIANA		HARTMAN ENGINEERING, INC. CONSULTING ENGINEERS KENNER, LOUISIANA	
LAKE PONTCHARTRAIN, LA. AND VICINITY HIGH LEVEL PLAN ORLEANS AVENUE OUTFALL CANAL PHASE 1B ORLEANS PARISH LOUISIANA			
ROBERT E. LEE BOULEVARD BRIDGE WEST APPROACH SLAB			
DESIGNED BY: W.D.L.	DATE: MAR. 8, 2000	PLOT SCALE: 24	PLOT DATE: MARCH 8, 2000
DRAWN BY: L.A.C.	CHECKED BY: P.J.H.	FILE NO. H-4-44776	
SUBMITTED BY: HARTMAN ENGINEERING DESIGN ENGINEER		SOLICITATION NO. DACW29-00-B-0094	DWG. 32 OF 59

File: D:\ASBUILT\2900\2900.dwg User: wjg Date: 3/15/02 2:41 p.m. Scale: 1/2" = 1'-0"


Safety is a Part of Your Contract

NOTE:
AGGREGATE BACKFILL AND GEOTEXTILE FABRIC LIMITS TO BE THE OUTER EDGES OF THE APPROACH SLAB AND BOLSTER BLOCK. POLYETHYLENE FILM (6 MIL. THICKNESS) TO BE INSTALLED BETWEEN THE AGGREGATE BACKFILL AND THE CONCRETE APPROACH SLAB FOR THE ENTIRE LIMITS OF THE AGGREGATE BACKFILL.

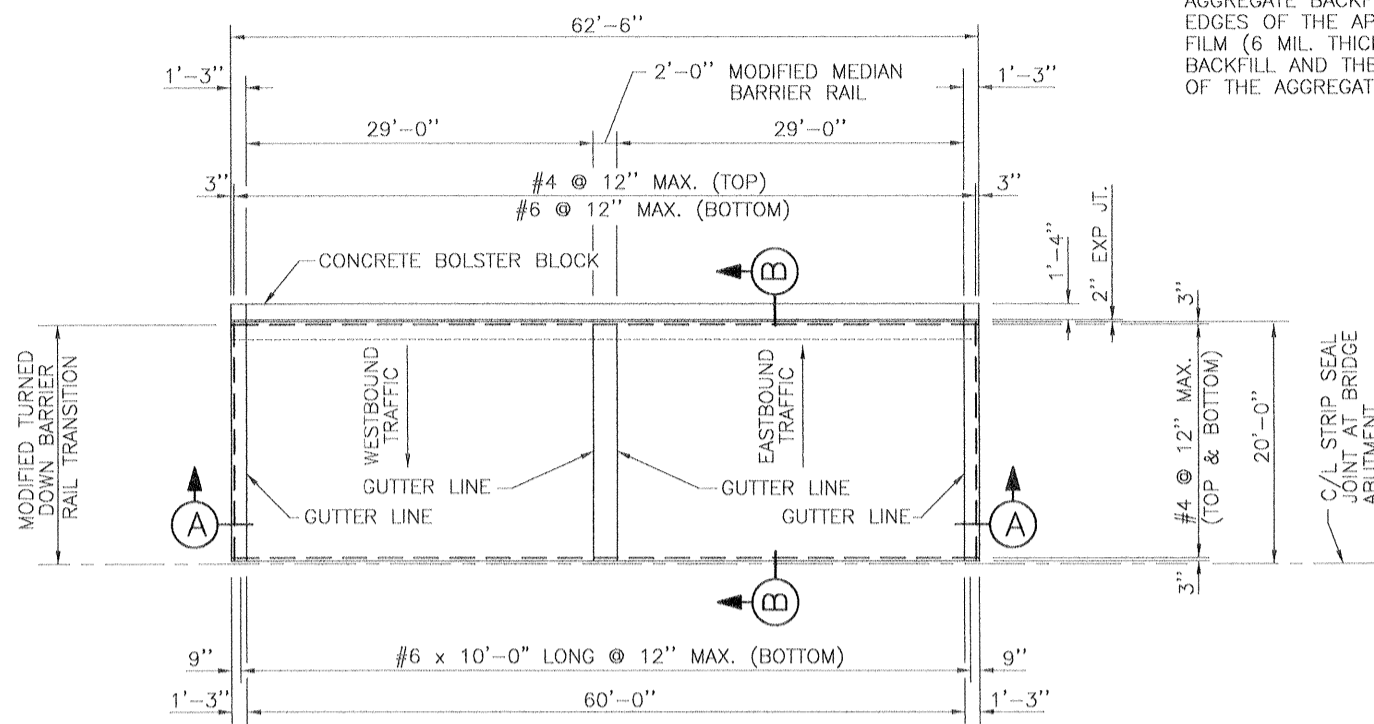

APPROACH SLAB PLAN

SCALE: 1/8" = 1'-0"

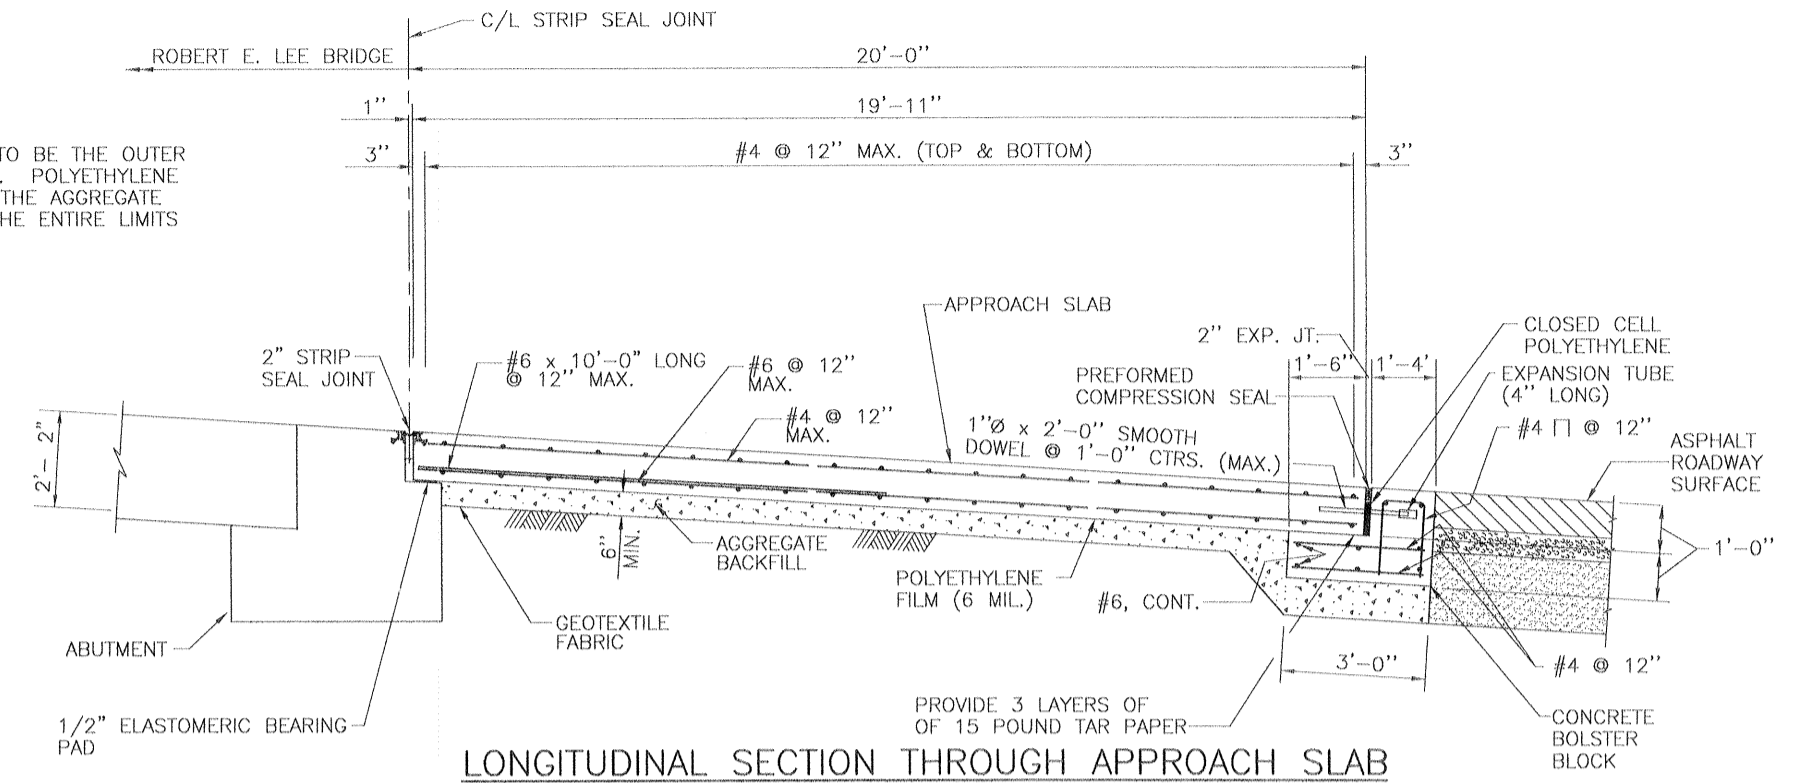


LONGITUDINAL SECTION THROUGH APPROACH SLAB

SECTION (B)


SCALE: 1/2" = 1'-0"

NOTE: CENTER BARRIER NOT SHOWN FOR CLARITY

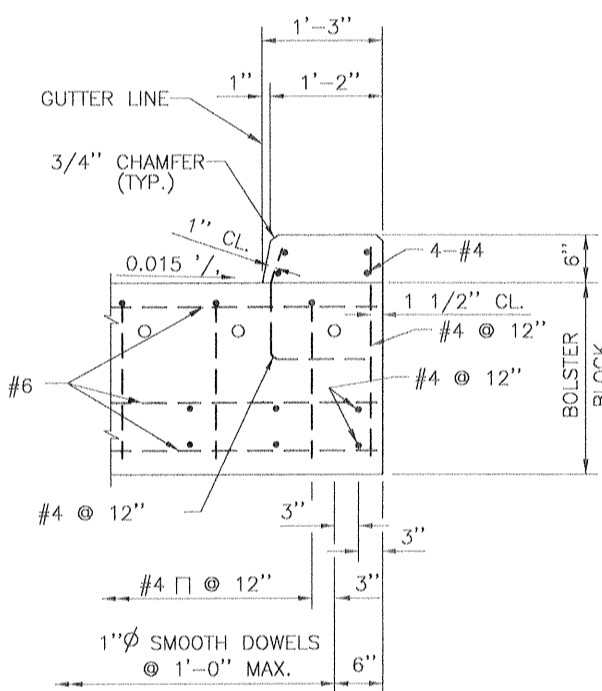


SECTION (C)

SCALE: 1" = 1'-0"

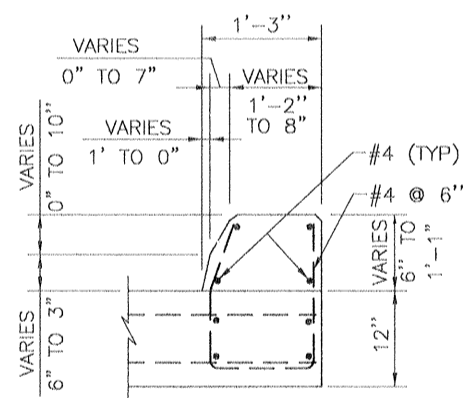


SECTION (D)

SCALE: 1" = 1'-0"

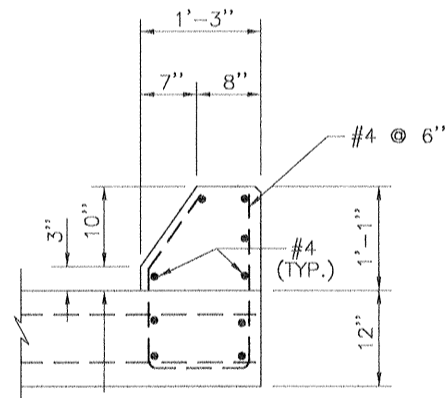


SECTION (E)

SCALE: 1" = 1'-0"

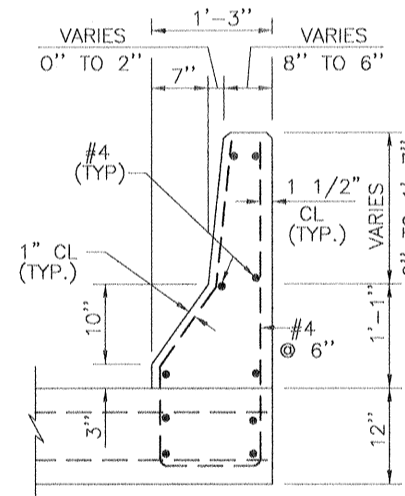

SECTION (F)

SCALE: 1" = 1'-0"

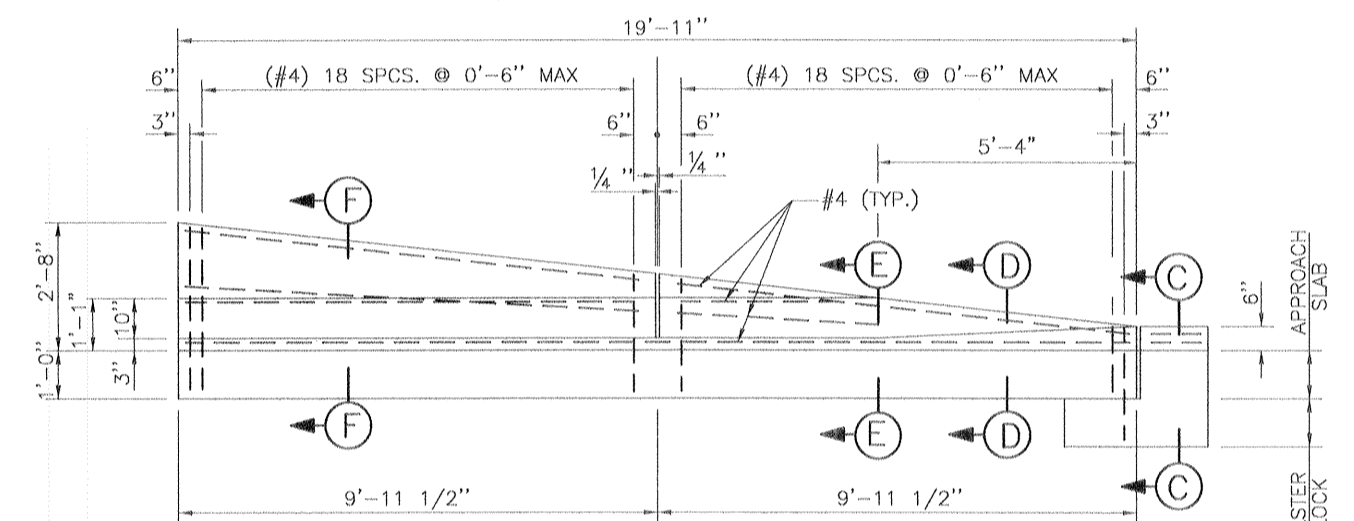

MODIFIED TURNED-DOWN BARRIER RAIL TRANSITION


SCALE: 1/2" = 1'-0"

SCALE: 1/8" = 1'-0"

SCALE: 1/2" = 1'-0"

SCALE: 1" = 1'-0"


REFERENCE DRAWINGS:
FOR GENERAL NOTES, SEE DWG. NO. 3
FOR PLAN/PROFILE, SEE DWG. NO. 5
FOR YEAR PLATE DETAILS, SEE DWG. NO. 53
FOR STRIP SEAL JOINT DETAILS, SEE DWG. NOS. 54 AND 55.

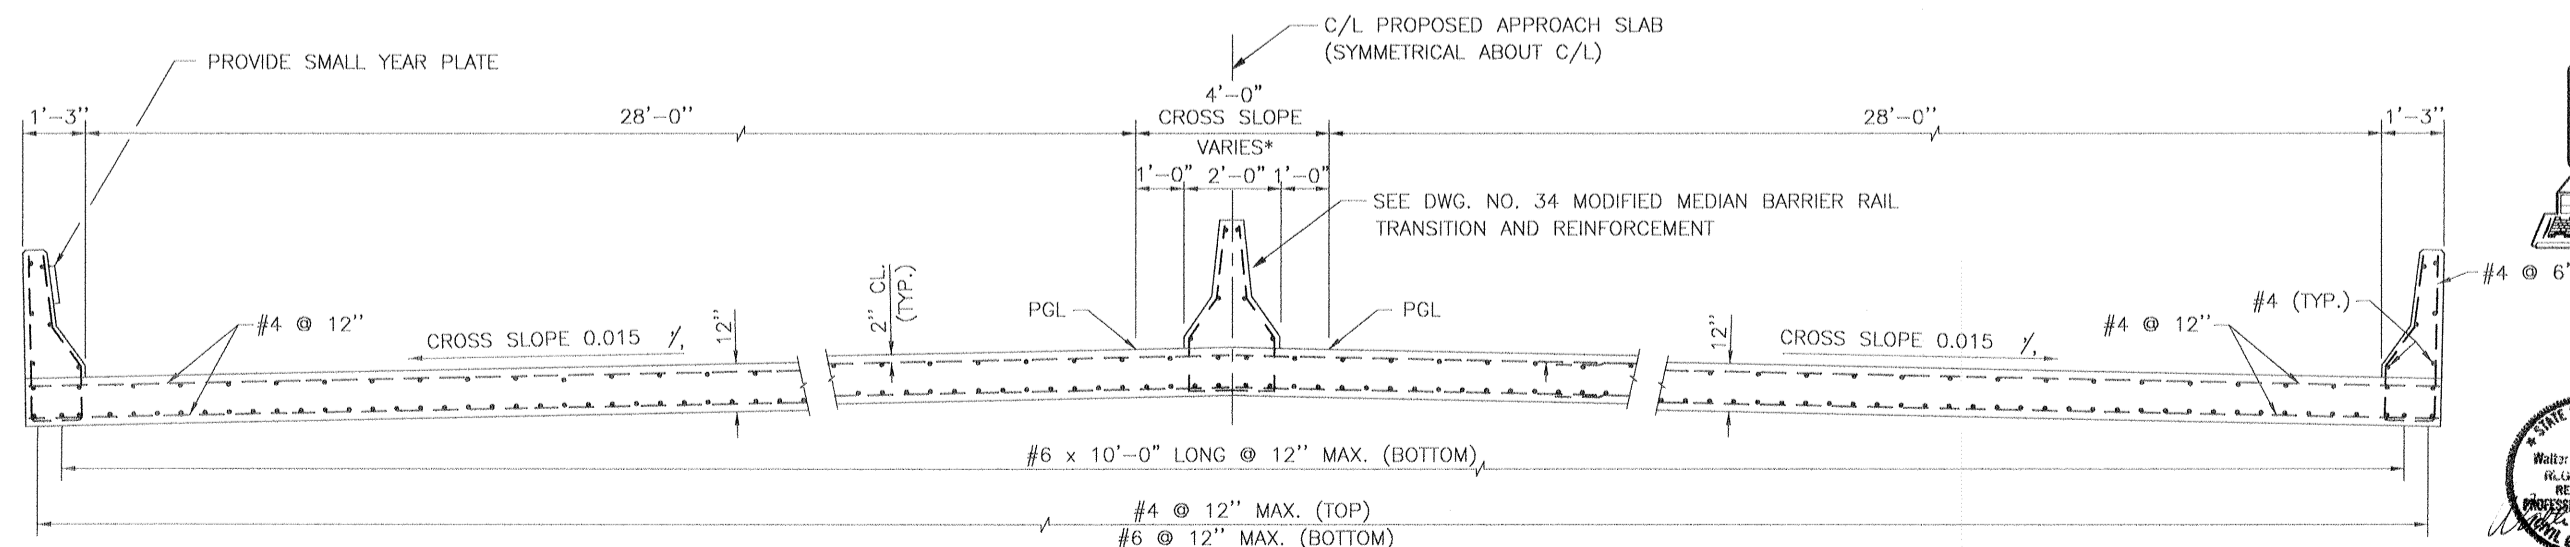

SECTION (A)

SCALE: 1/2" = 1'-0"

* SEE DWG. NO. 38 FOR CROWN DETAIL

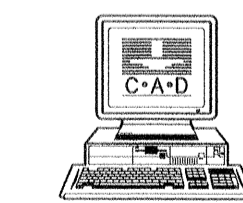

DACW29-00-B-0094


AS BUILT PLANS

DATE RECEIVED 3/15/02
DATE TRACINGS CORRECTED 4/18/02


SYMBOL	DESCRIPTION	DATE	APPROVED
REVISIONS			
U.S. ARMY ENGINEER DISTRICT, NEW ORLEANS CORPS OF ENGINEERS NEW ORLEANS, LOUISIANA			
BOARD OF LEVEE COMMISSIONERS ORLEANS LEVEE BOARD NEW ORLEANS, LOUISIANA		HARTMAN ENGINEERING, INC. CONSULTING ENGINEERS KENNER, LOUISIANA	
LAKE PONTCHARTRAIN, LA. AND VICINITY HIGH LEVEL PLAN ORLEANS AVENUE OUTFALL CANAL PHASE 1B ORLEANS PARISH LOUISIANA			
ROBERT E. LEE BOULEVARD BRIDGE EAST APPROACH SLAB			
DESIGNED BY: W.D.L.	DATE: MAR. 8, 2000	PLOT SCALE: 24	PLOT DATE: MARCH 8, 2000
DRAWN BY: L.A.C.	CHECKED BY: P.J.H.	CADD FILE: SHT33.DGN	FILE NO. H-4-44776
SUBMITTED BY: HARTMAN ENGINEERING DESIGN ENGINEER	SOLICITATION NO. DACW29-00-B-0094	DWG. 33 OF 59	

The D:\SHT33.DWG. last edited: AUG 26, 02 @ 2:47 P.M. Scale: 1/24 R.L.C.


Safety is a Part of Your Contract

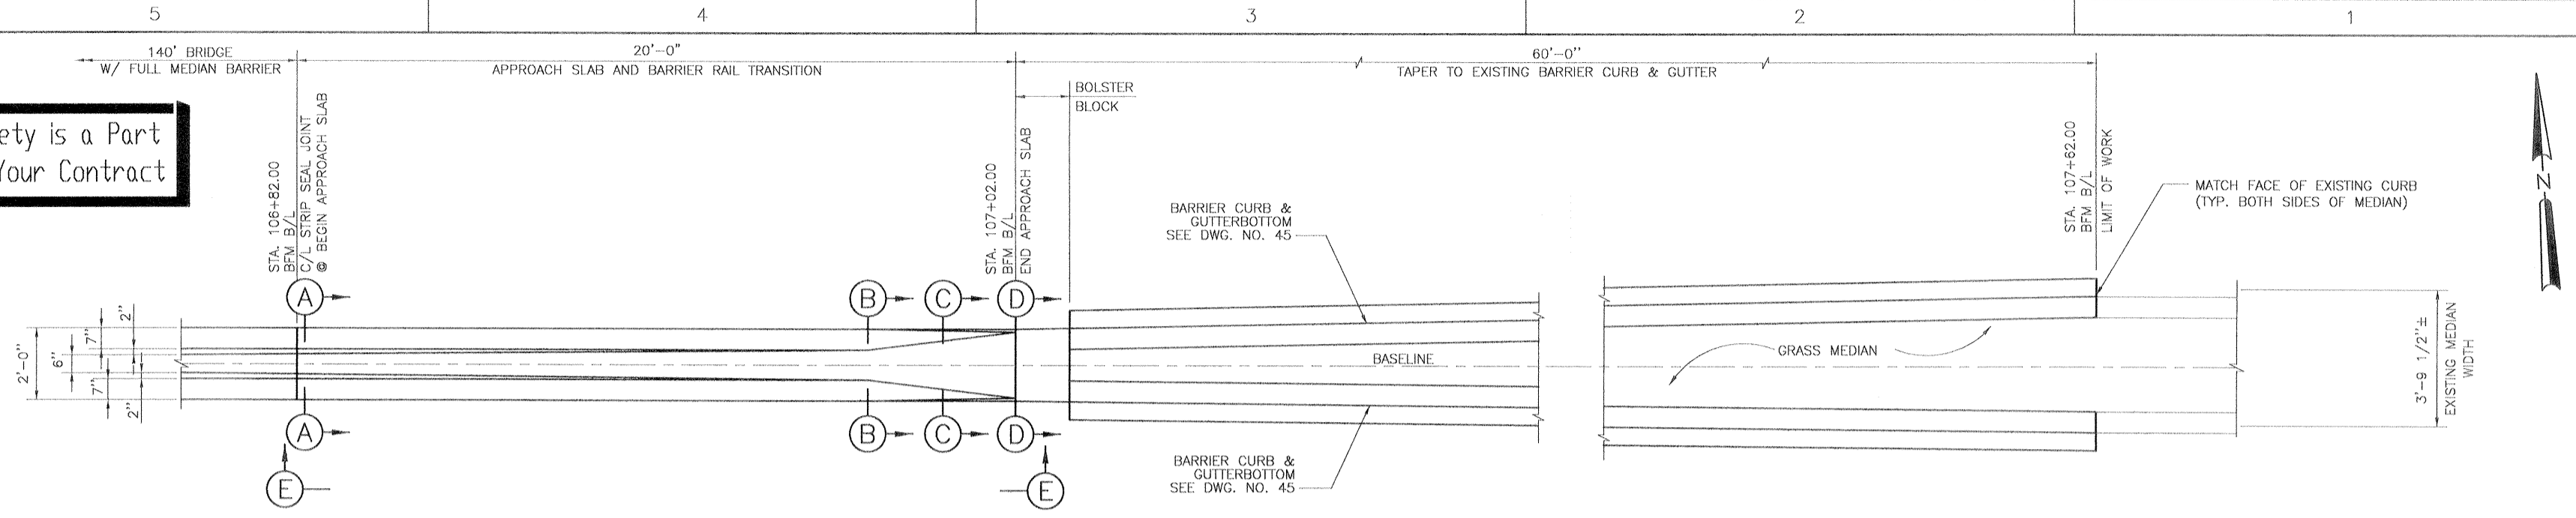


PLAN OF MEDIAN BARRIER TRANSITION/CURB EAST BANK
SCALE: 1/2" = 1' - 0"

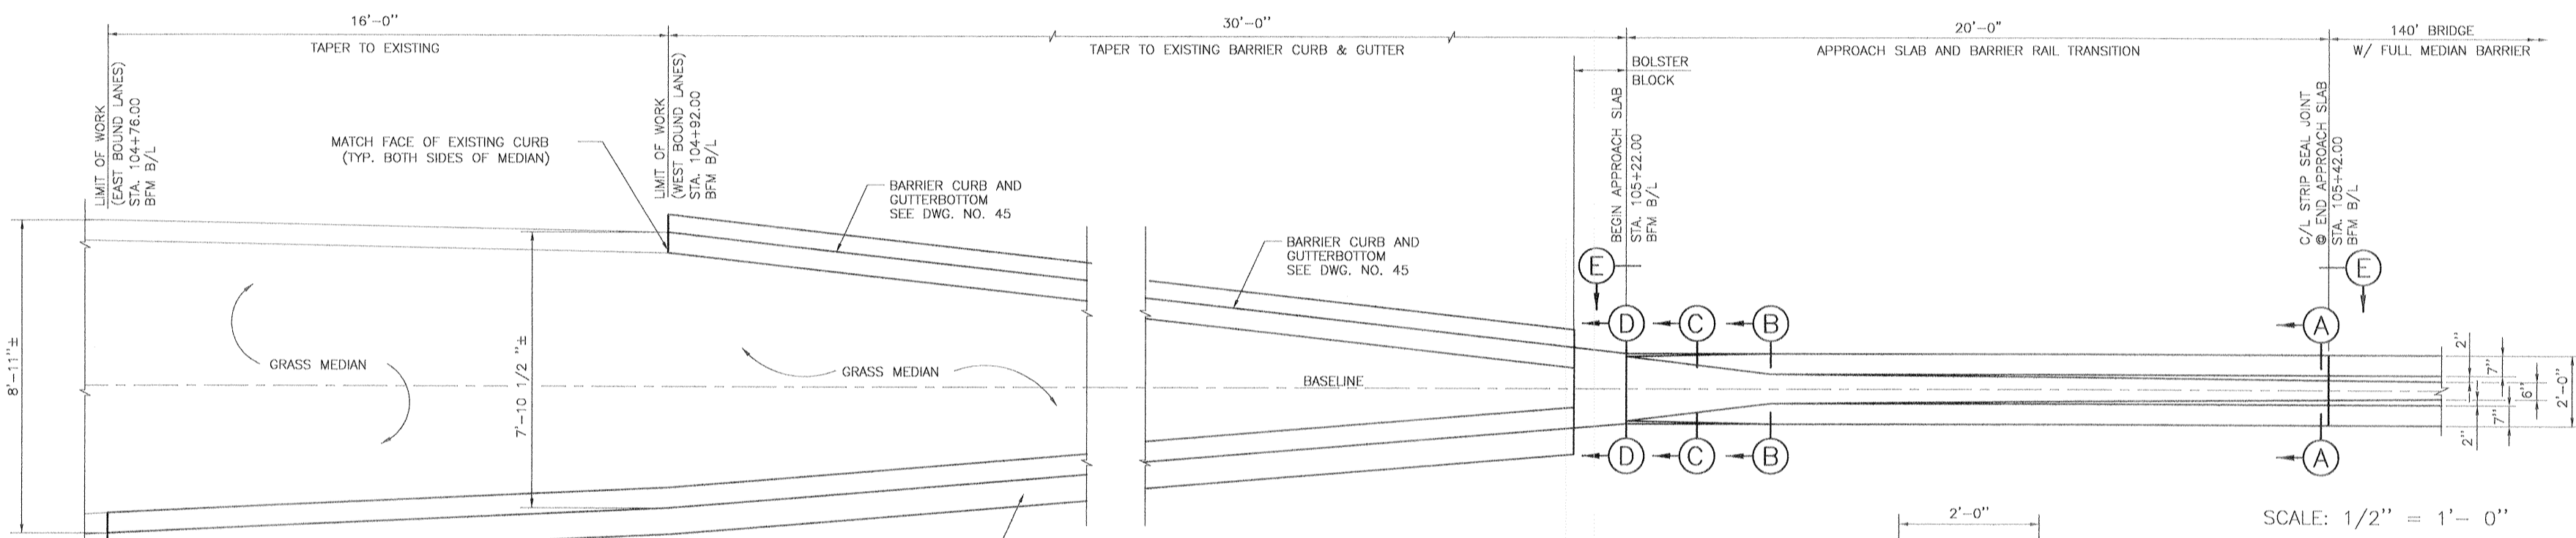


PLAN OF MEDIAN BARRIER TRANSITION/CURB WEST BANK
SCALE: 1/2" = 1' - 0"

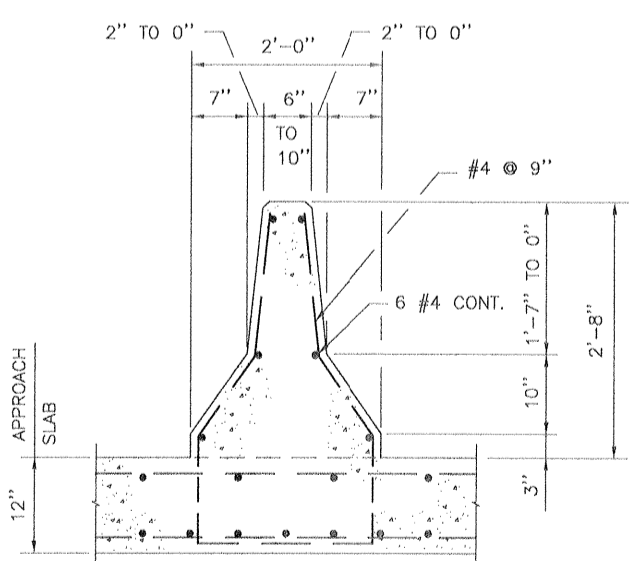

SECTION (A)
SCALE: 1" = 1' - 0"

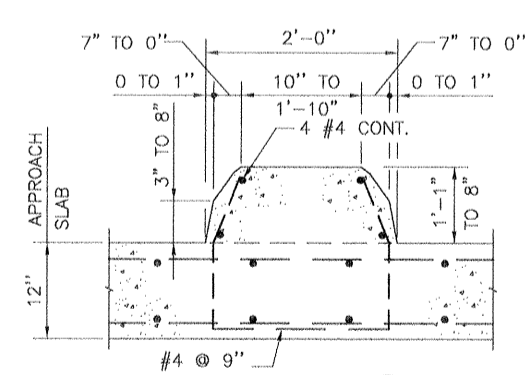


SECTION (C)
SCALE: 1" = 1' - 0"

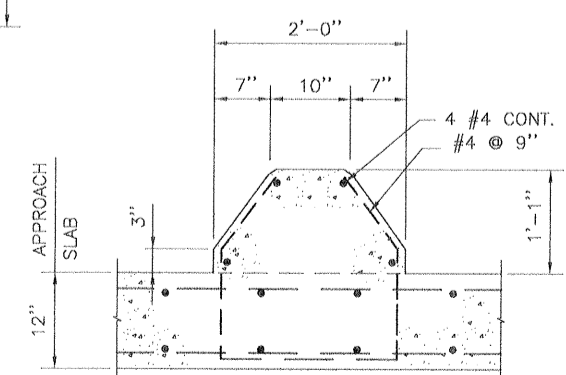


SECTION (B)
SCALE: 1" = 1' - 0"


- REFERENCE DRAWINGS
1. FOR GENERAL NOTES, SEE DWG. NO. 3.
 2. FOR PLAN/PROFILE, SEE DWG. NO. 5.
 3. FOR TYPICAL ROADWAY SECTIONS, SEE DWG. NO. 44.
 4. FOR TYPICAL ROADWAY AND SIDEWALK DETAILS, SEE DWG. NO. 45.

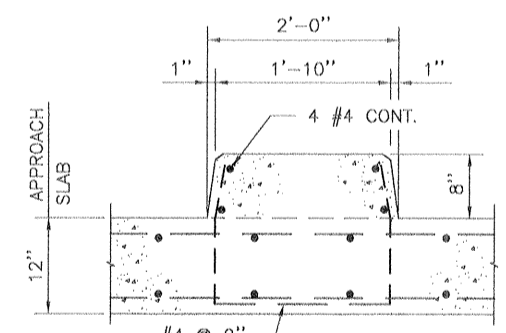

SECTION (D)
SCALE: 1" = 1' - 0"
NOTE: BOLSTER BLOCK NOT SHOWN FOR CLARITY.

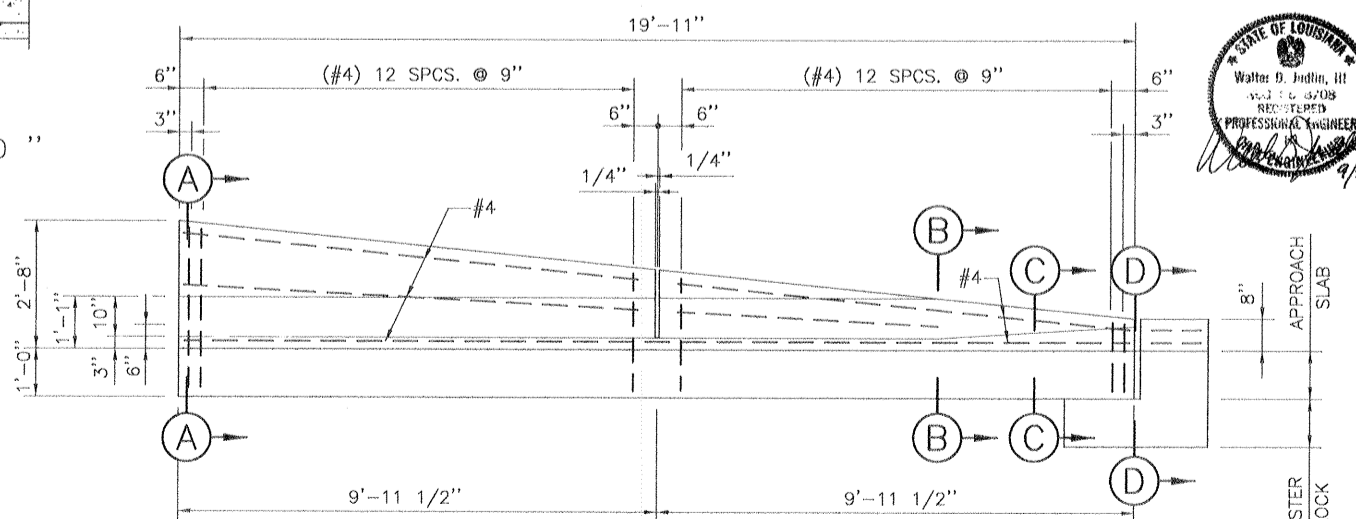

ELEVATION (E)
SCALE: 1/2" = 1' - 0"

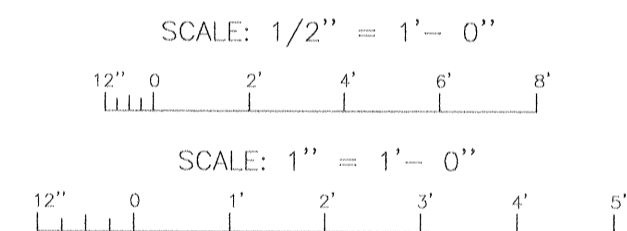


DAW29-00-B-0094
AS BUILT PLANS
DATE RECEIVED 3/15/02
DATE TRACINGS CORRECTED 4/18/02

SYMBOL	DESCRIPTION	DATE	APPROVED
REVISIONS			
U.S. ARMY ENGINEER DISTRICT, NEW ORLEANS CORPS OF ENGINEERS NEW ORLEANS, LOUISIANA			
BOARD OF LEVEE COMMISSIONERS ORLEANS LEVEE BOARD NEW ORLEANS, LOUISIANA		HARTMAN ENGINEERING, INC. CONSULTING ENGINEERS KENNER, LOUISIANA	
LAKE PONCHARTRAIN, LA. AND VICINITY HIGH LEVEL PLAN ORLEANS AVENUE OUTFALL CANAL PHASE 1B ORLEANS PARISH LOUISIANA			
ROBERT E. LEE BOULEVARD BRIDGE APPROACH SLAB DETAILS			
DESIGNED BY: W.D.L.	DATE: MAR. 8, 2000	PLOT SCALE: 24	PLOT DATE: MARCH 8, 2000
DRAWN BY: C.R.N.	CARD FILE: SHT34.DGN	FILE NO. H-4-44776	
CHECKED BY: P.J.H.	SUBMITTED BY: HARTMAN ENGINEERING DESIGN ENGINEER	DWG. 34 OF 59	

FILE: D:\SHT34.DGN; LAST MODIFIED: AUG. 25, 00 @ 3:52 PM; SCALE: 1/2" = 1' - 0"




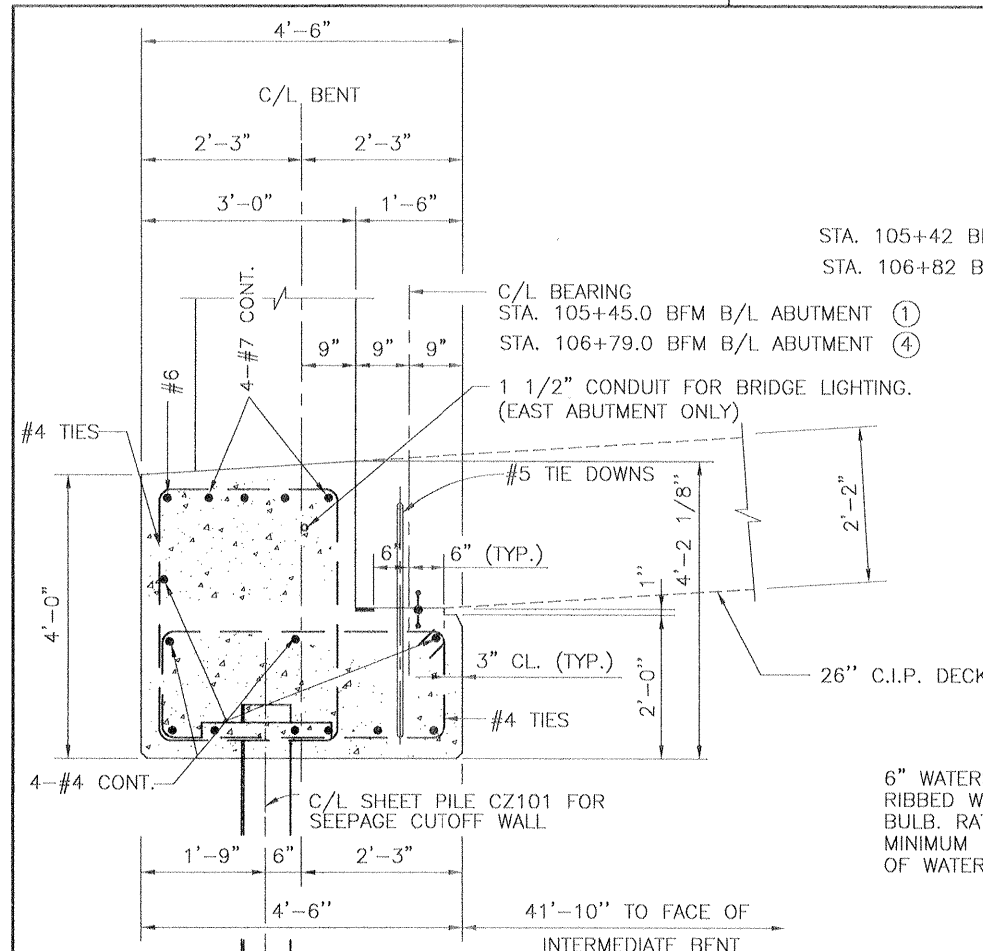

SECTION A
35/36


SCALE: 3/4" = 1'-0"

**Safety is a Part
of Your Contract**

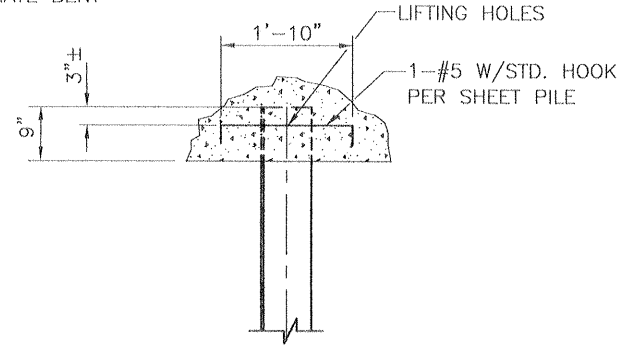


SHEET PILE ANCHOR DETAIL

SCALE: 3/4" = 1'-0"

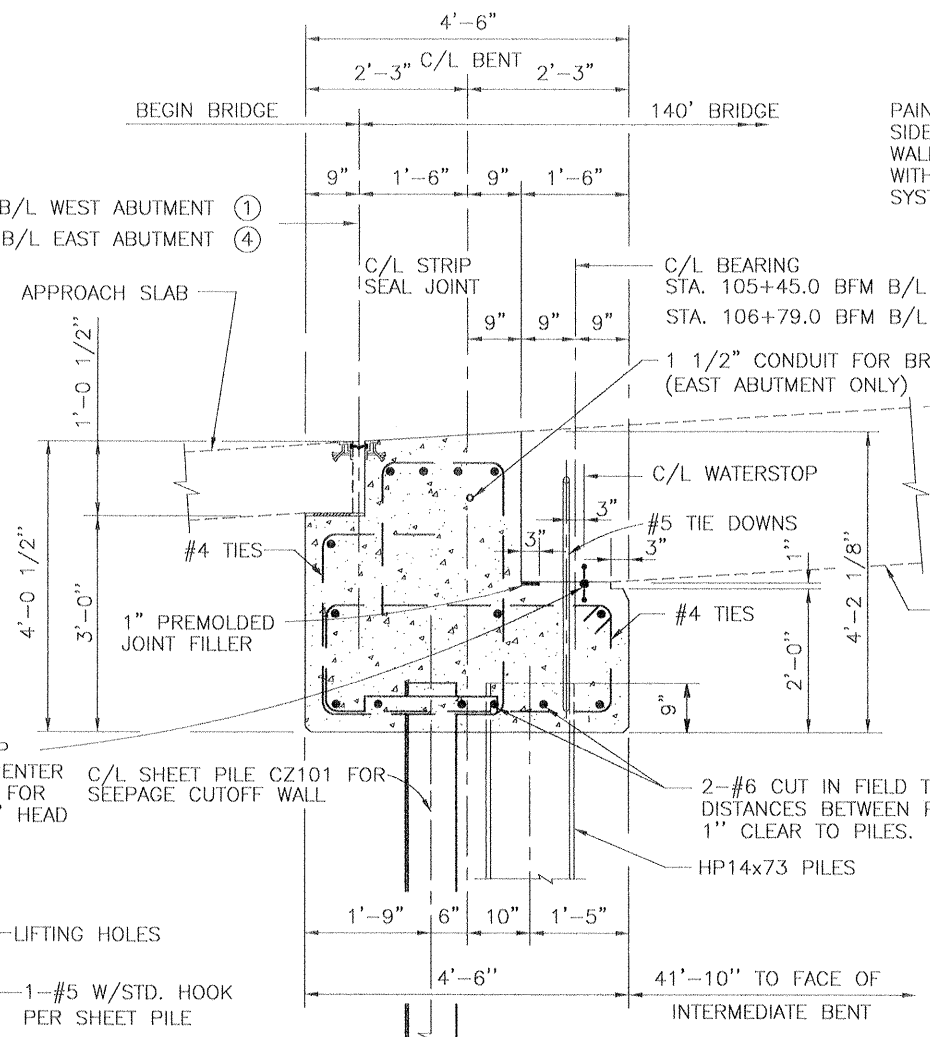

SECTION B
35/36


SCALE: 3/4" = 1'-0"

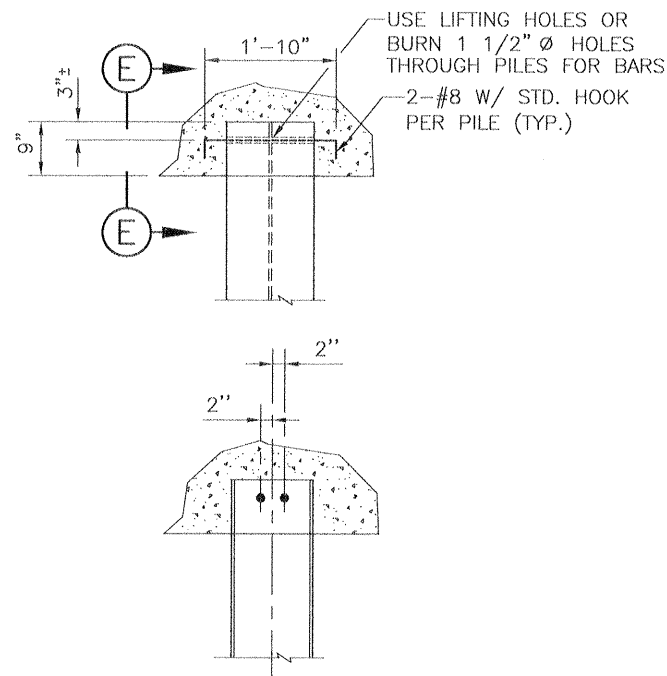

SECTION E

HP14X73 PILE ANCHOR DETAIL


SCALE: 3/4" = 1'-0"

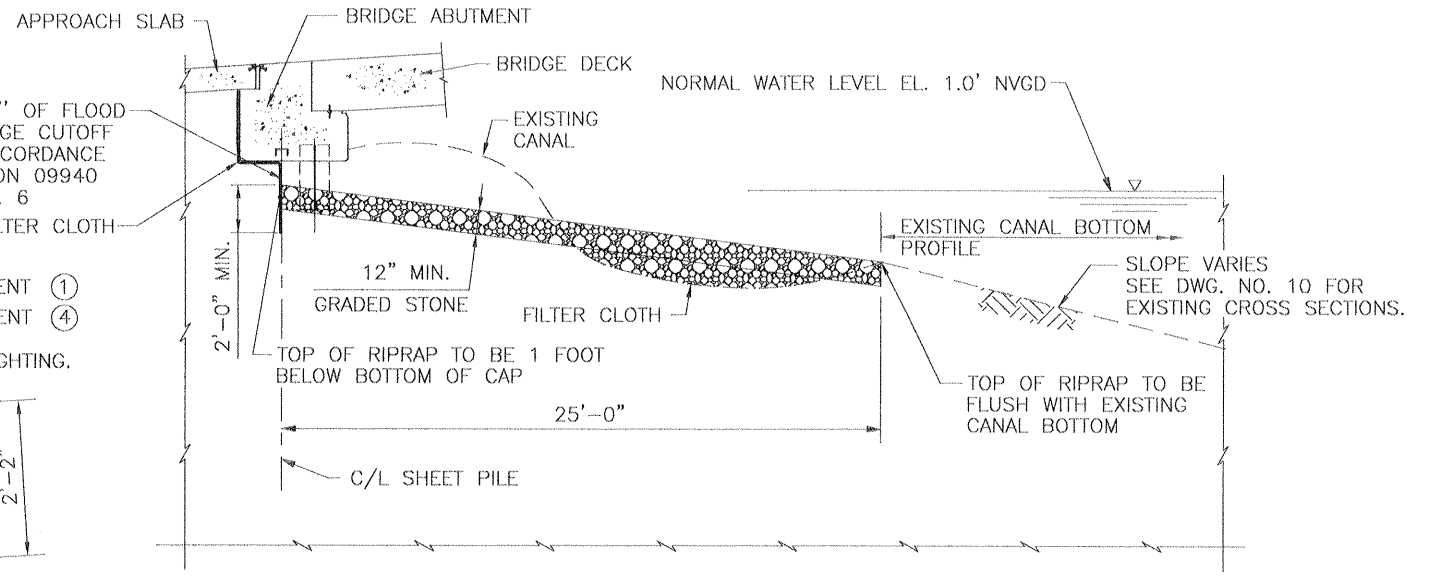

TYPICAL RIPRAP

SCALE: 1/4" = 1'-0"


PROTECTED SIDE

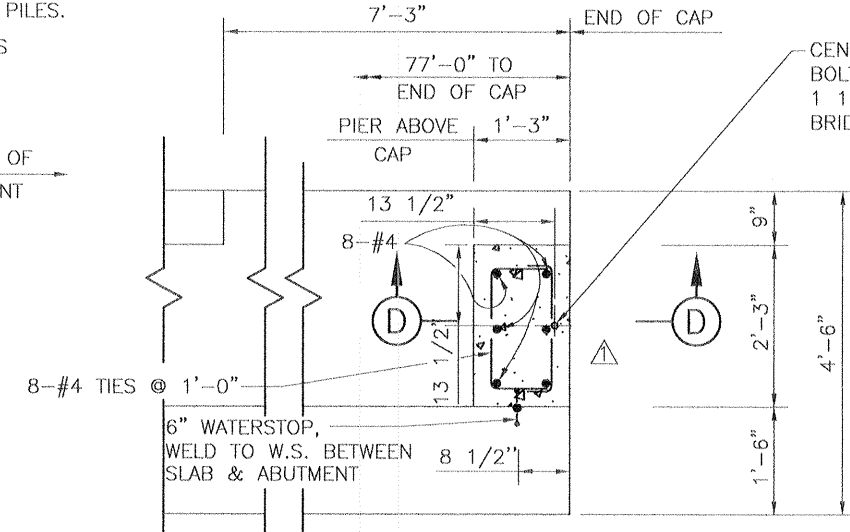

FLOOD SIDE


TYP. ABUTMENT PIER SECTION

SCALE: 3/4" = 1'-0"

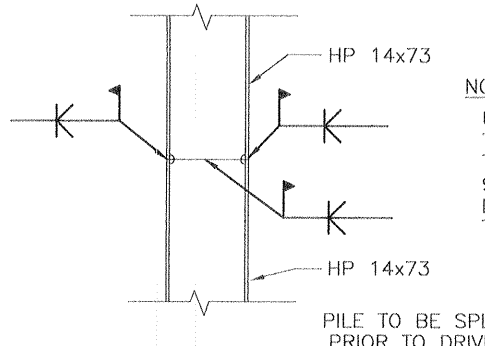


HP14X73 PILE SPlice DETAIL

SCALE: 3/4" = 1'-0"

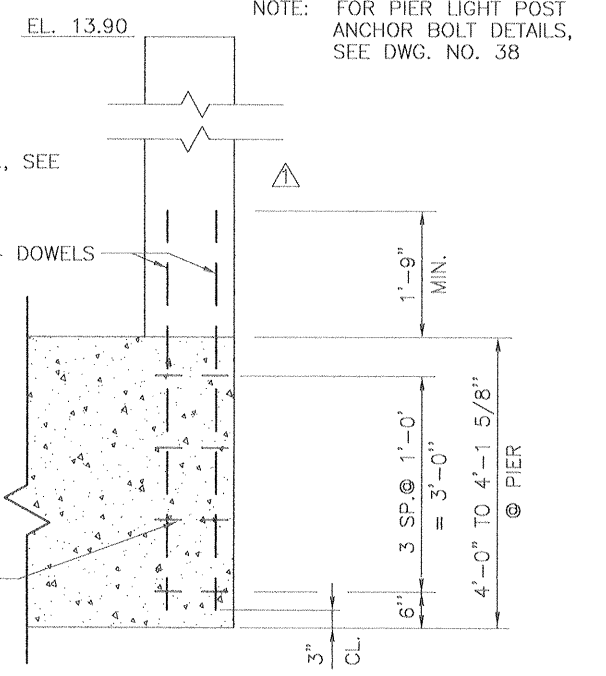

SECTION D



SCALE: 3/4" = 1'-0"

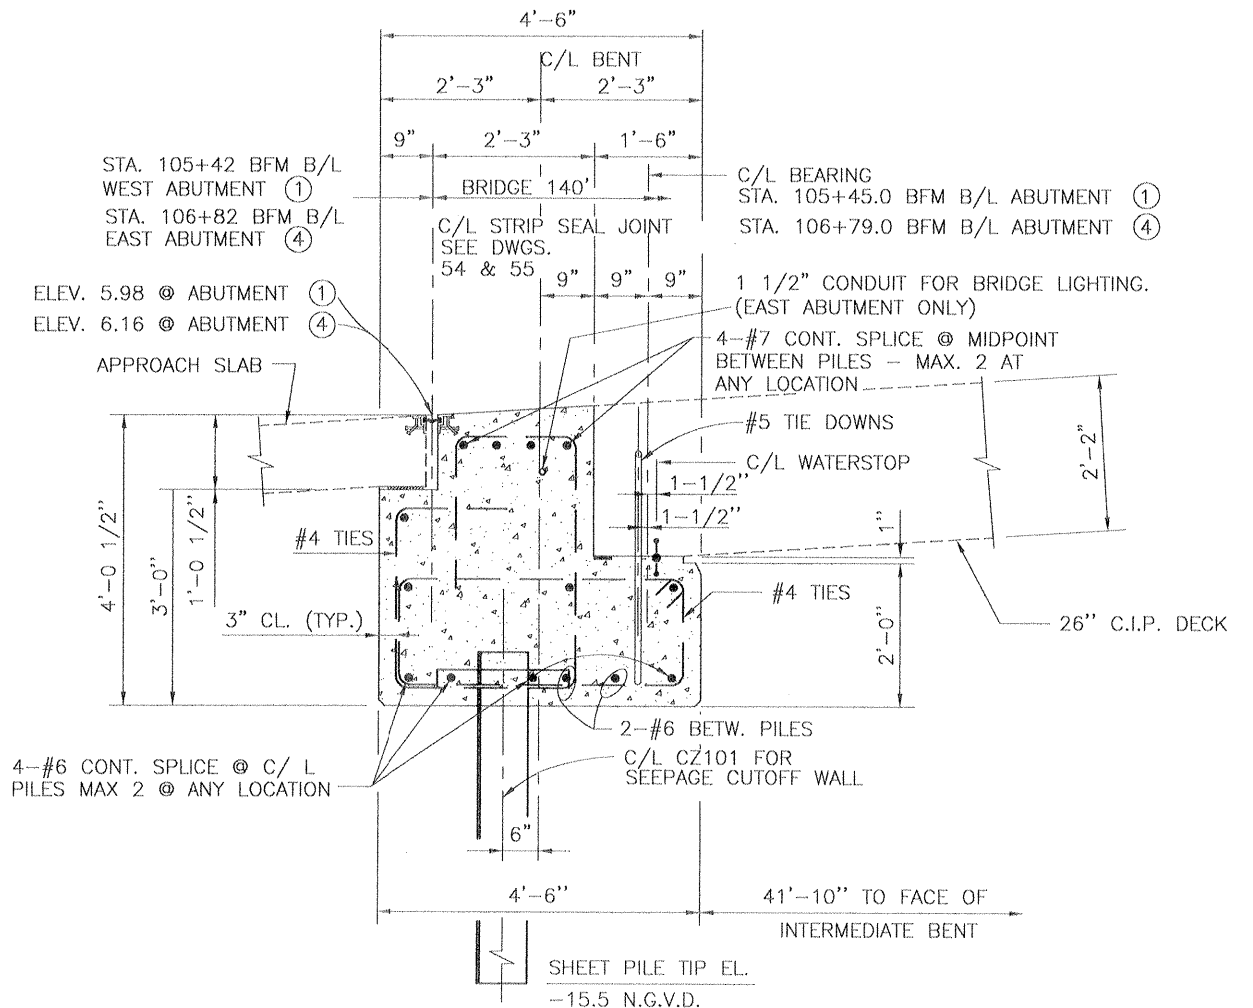

SECTION C
35/36


SCALE: 3/4" = 1'-0"

NOTE:
FOR SPACING OF SETS OF STIRRUPS,
SEE ELEVATION, DWG. 35.

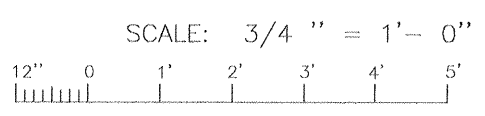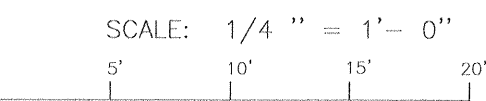

REFERENCE DRAWINGS:
FOR GENERAL NOTES, SEE DWG. NO. 3.
FOR BRIDGE PLAN AND ELEVATION,
SEE DWG. NO. 30.
FOR LIMITS OF RIPRAP, SEE DWG. NOS. 14
AND 35.


SYMBOL	DESCRIPTION	DATE	APPROVED
△	CHANGED ABUTMENT PIER SECTIONS	09/19/02	W.D.J.
REVISIONS			
U.S. ARMY ENGINEER DISTRICT, NEW ORLEANS CORPS OF ENGINEERS NEW ORLEANS, LOUISIANA			
BOARD OF LEEVEE COMMISSIONERS ORLEANS LEEVEE BOARD NEW ORLEANS, LOUISIANA		HARTMAN ENGINEERING, INC. CONSULTING ENGINEERS KENNER, LOUISIANA	
LAKE PONTCHARTRAIN, LA. AND VICINITY HIGH LEVEL PLAN ORLEANS AVENUE OUTFALL CANAL PHASE 1B ORLEANS PARISH LOUISIANA			
ROBERT E. LEE BOULEVARD BRIDGE ABUTMENT DETAILS			
DESIGNED BY: N.P.	DATE: MAR. 8, 2000	PLOT SCALE: 16	PLOT DATE: MARCH 8, 2000
DRAWN BY: L.A.C.	CHECKED BY: P.J.H.	CARD FILE: SH136.DGN	FILE NO. H-4-44776
SUBMITTED BY: HARTMAN ENGINEERING DESIGN ENGINEER	SOLICITATION NO. DACW29-00-B-0094	DWG. 36	OF 59

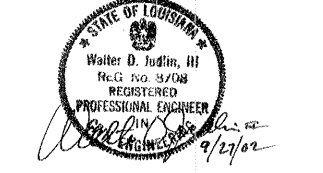

AS BUILT PLANS
DATE RECEIVED: 3/15/02
DATE TRACINGS CORRECTED: 4/18/02




Safety is a Part of Your Contract

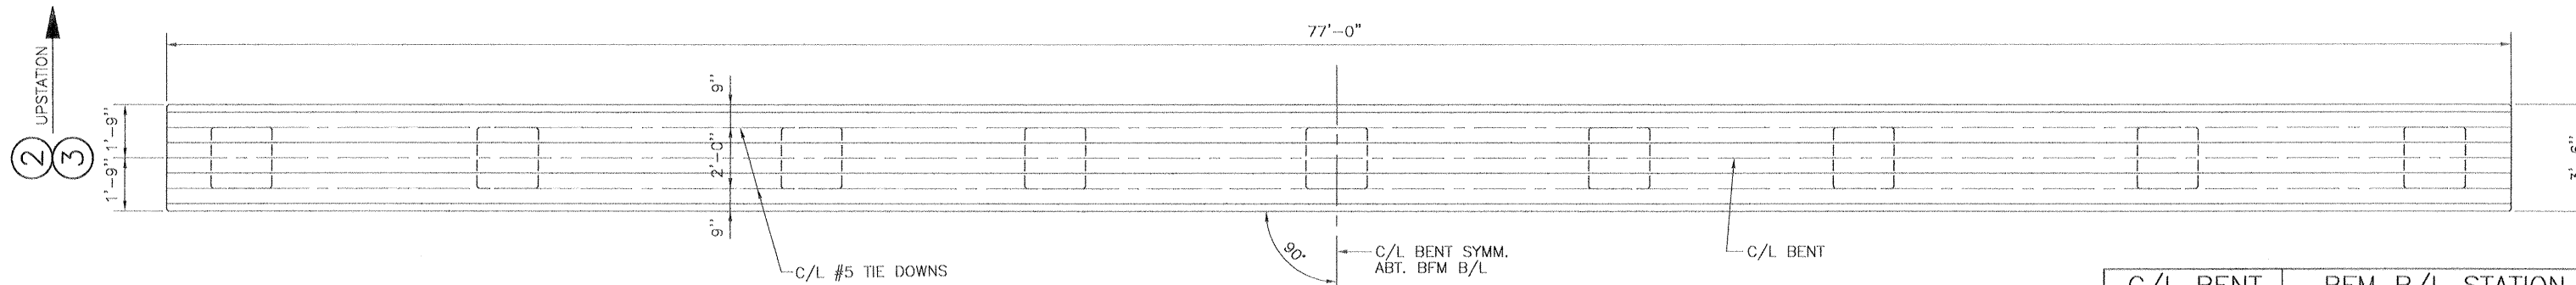

PLAN


SCALE: 3/8" = 1'-0"

C/L BENT	BFM B/L STATION	EL. A	EL. B
②	105+89.33	1.66	2.24
③	106+34.67	1.72	2.30

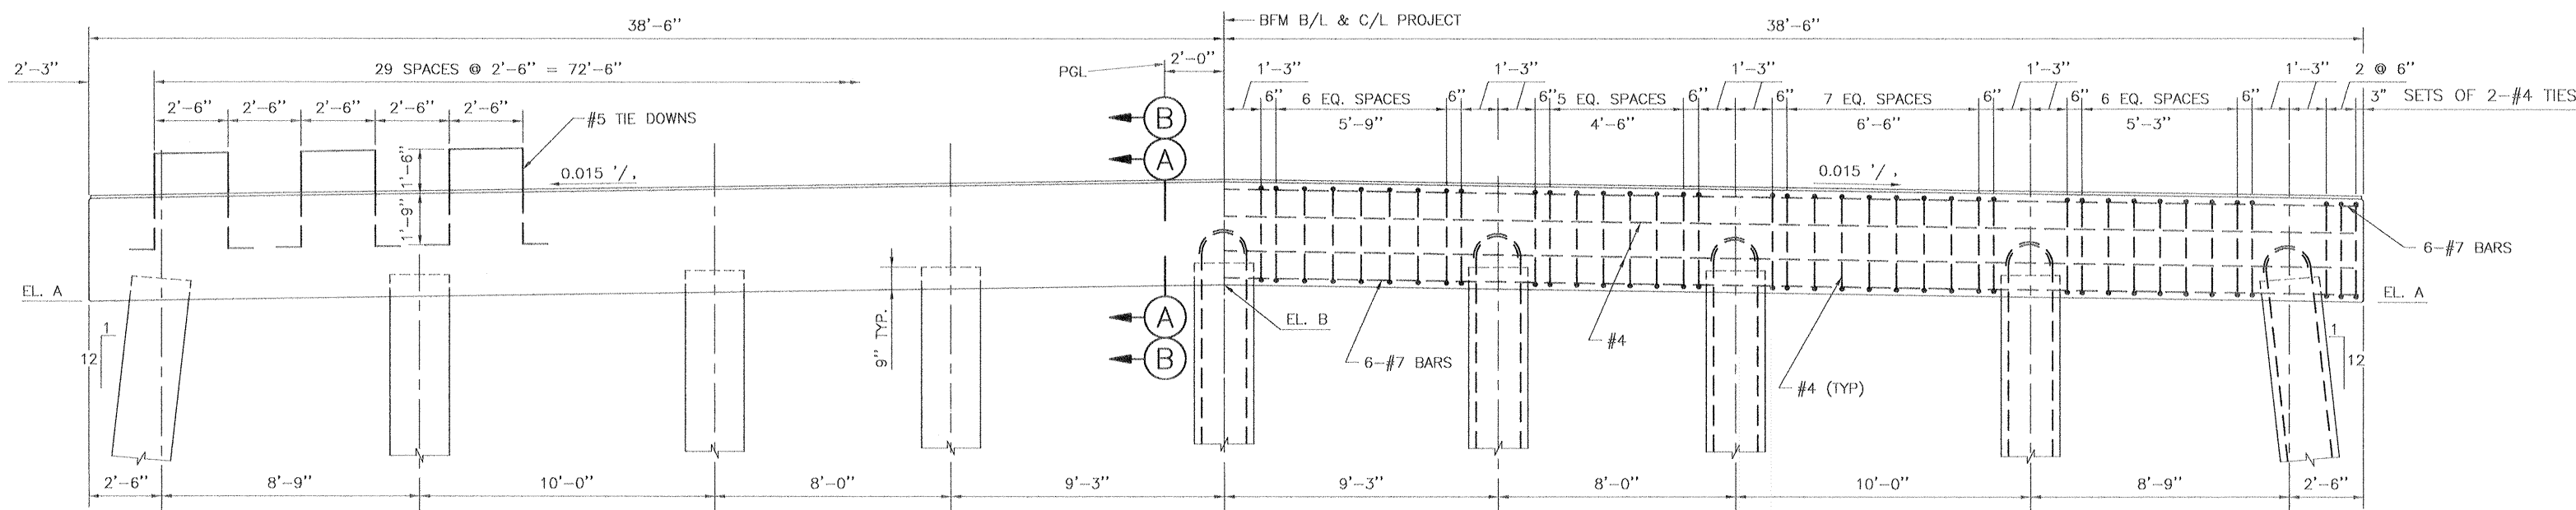


SECTION

SCALE: 3/8" = 1'-0"

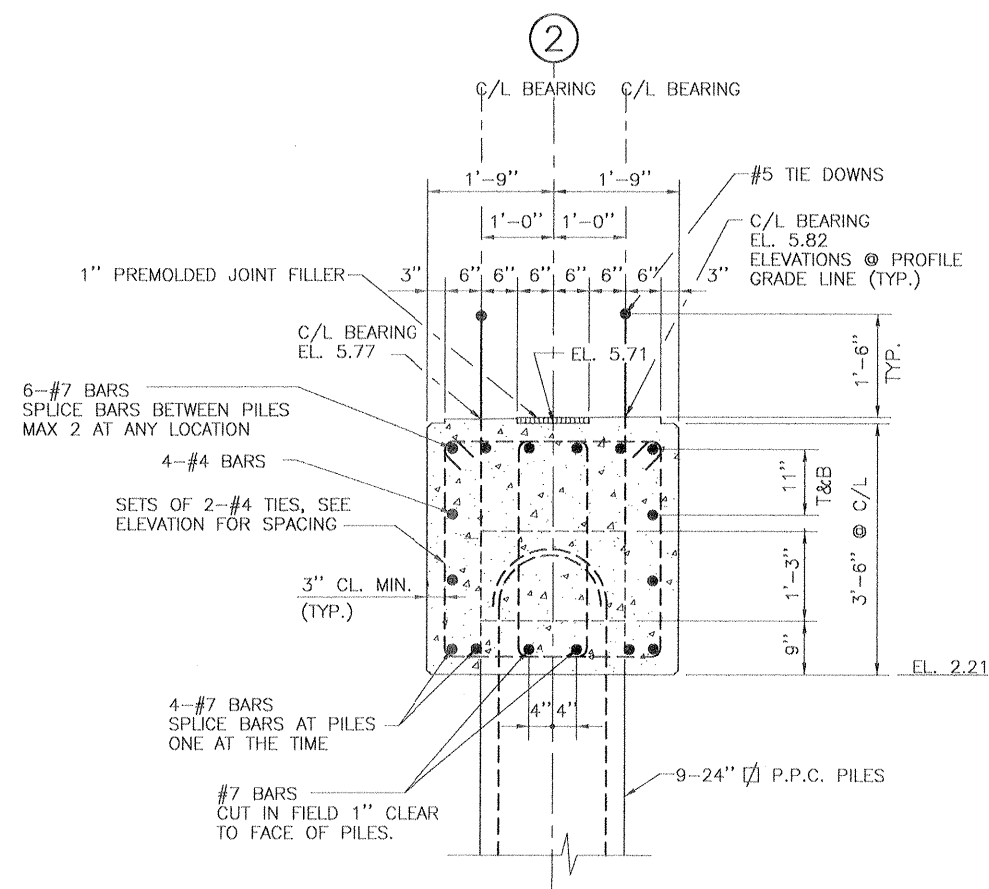

SECTION (A) BENT (2)



SCALE: 3/4" = 1'-0"

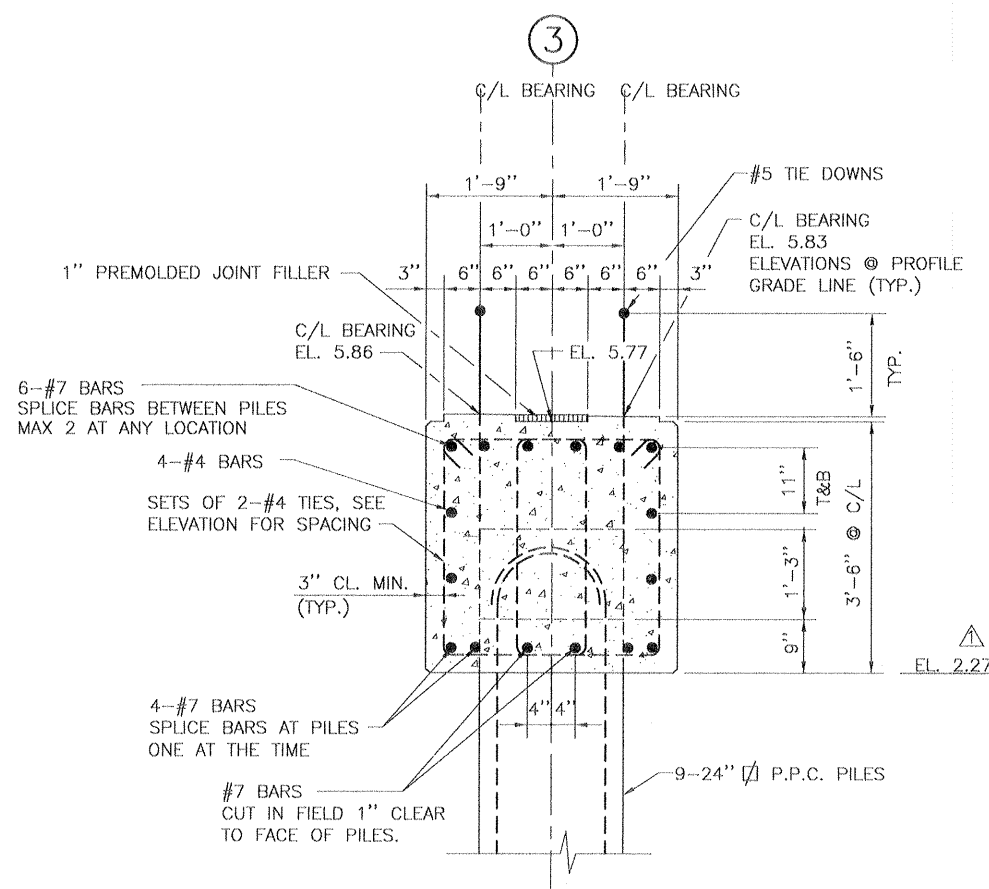

SECTION (B) BENT (3)

SCALE: 3/4" = 1'-0"


REFERENCE DRAWINGS:
 FOR GENERAL NOTES, SEE DWG. NO. 3.
 FOR BRIDGE PLAN AND ELEVATION, SEE DWG. NO. 30.
 FOR PILE LENGTHS, SEE DWG. NO. 31.

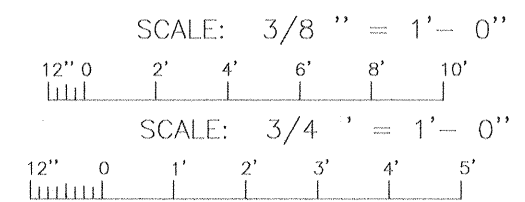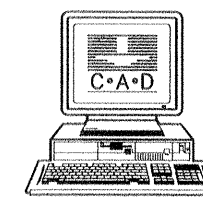

DACW29-00-B-0094

AS BUILT PLANS


DATE RECEIVED 3/15/02
 DATE TRACINGS CORRECTED 4/18/02

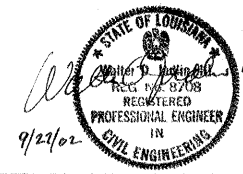


SYMBOL	DESCRIPTION	DATE	APPROVED
△	CHANGED EL. @ SECTION B, BENT 3	09/19/02	W.D.J.

U.S. ARMY ENGINEER DISTRICT, NEW ORLEANS CORPS OF ENGINEERS NEW ORLEANS, LOUISIANA	
BOARD OF LEVEE COMMISSIONERS ORLEANS LEVEE BOARD NEW ORLEANS, LOUISIANA	HARTMAN ENGINEERING, INC. CONSULTING ENGINEERS KENNER, LOUISIANA


LAKE PONTCHARTRAIN, LA. AND VICINITY HIGH LEVEL PLAN ORLEANS AVENUE OUTFALL CANAL PHASE 1B ORLEANS PARISH LOUISIANA			
ROBERT E. LEE BOULEVARD BRIDGE BENTS (2) & (3)			
DESIGNED BY: N.P. DRAWN BY: L.A.C. CHECKED BY: P.J.H.	DATE: MAR. 8, 2000 CADD FILE: SHT37.DGN SOLICITATION NO.	PLOT SCALE: 3/4" FILE NO. H-4-44776	PLOT DATE: MARCH 8, 2000 DWG. 37 OF 59

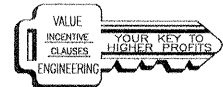


Safety is a Part of Your Contract

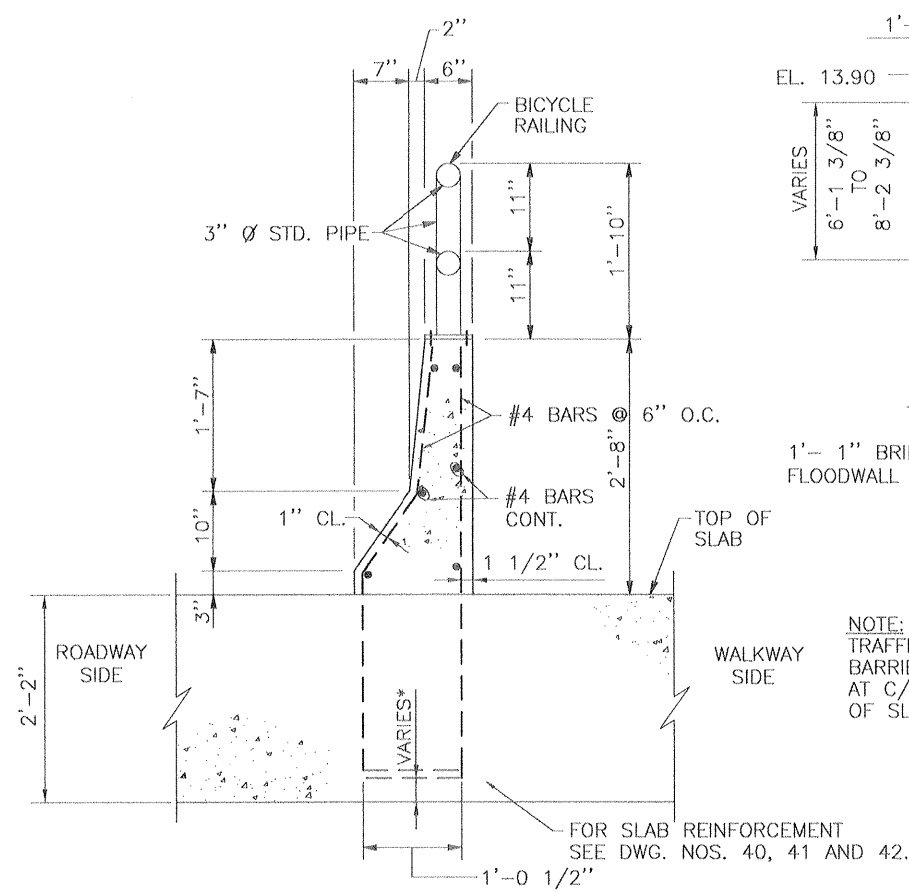


TRAFFIC BARRIER DETAIL
SCALE: 1" = 1'-0"

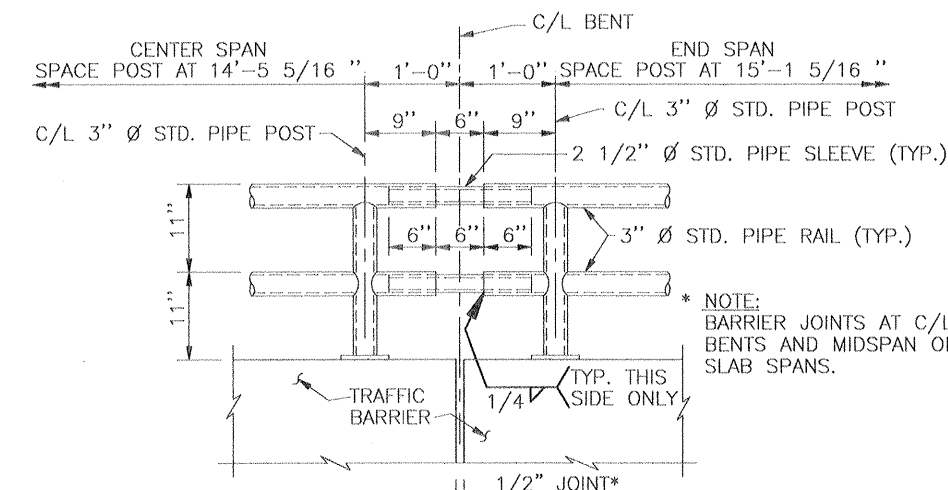


BICYCLE RAILING JOINT
SCALE: 1" = 1'-0"

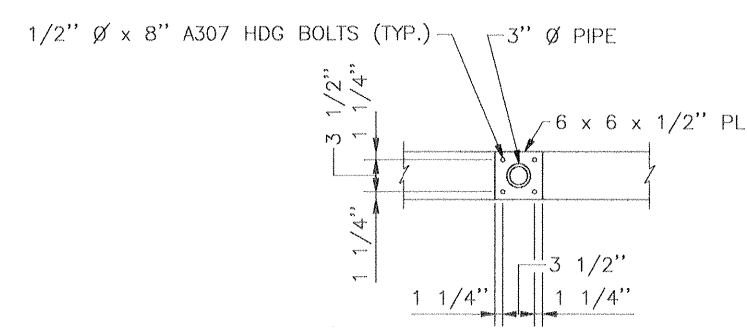

SECTION (A)
SCALE: 1" = 1'-0"

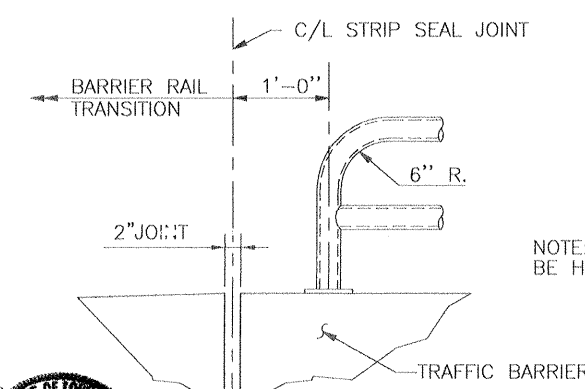

END OF RAILING
SCALE: 1" = 1'-0"

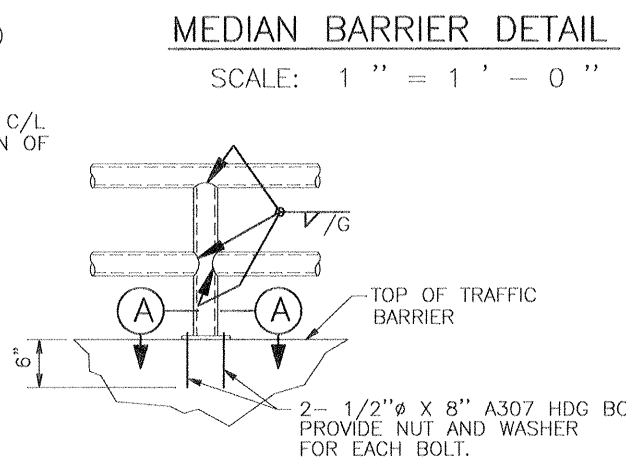


MEDIAN BARRIER DETAIL
SCALE: 1" = 1'-0"

NOTE: TRAFFIC BARRIER AND MEDIAN BARRIER TO HAVE 1/2" JNTS. AT C/L BENTS AND MIDSPAN OF SLAB SPANS.


*NOTE: BRIDGE FLOODWALL AND BARRIER REINFORCING STEEL TO BE PLACED ON TOP OF PRIMARY SLAB REINFORCEMENT SEE DWG. NOS. 40, 41 AND 42 FOR VARYING DIMENSION DETAILS.

NOTE: LIGHT POST ANCHOR BOLTS NOT SHOWN FOR CLARITY. SEE ANCHOR BOLT DETAILS THIS SHEET.

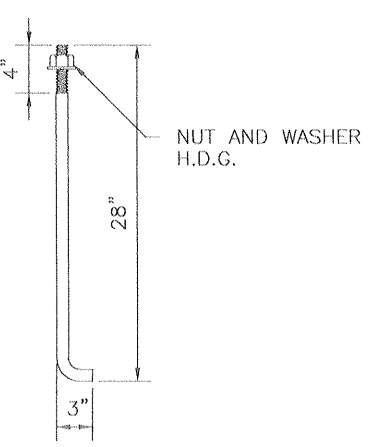


1" DIA H.D.G. ANCHOR BOLT DETAIL
(24 REQUIRED)
SCALE: 1 1/2" = 1'-0"

NOTE: ANCHOR BOLT LAYOUT AND PROJECTION PER LIGHT POST MANUFACTURER

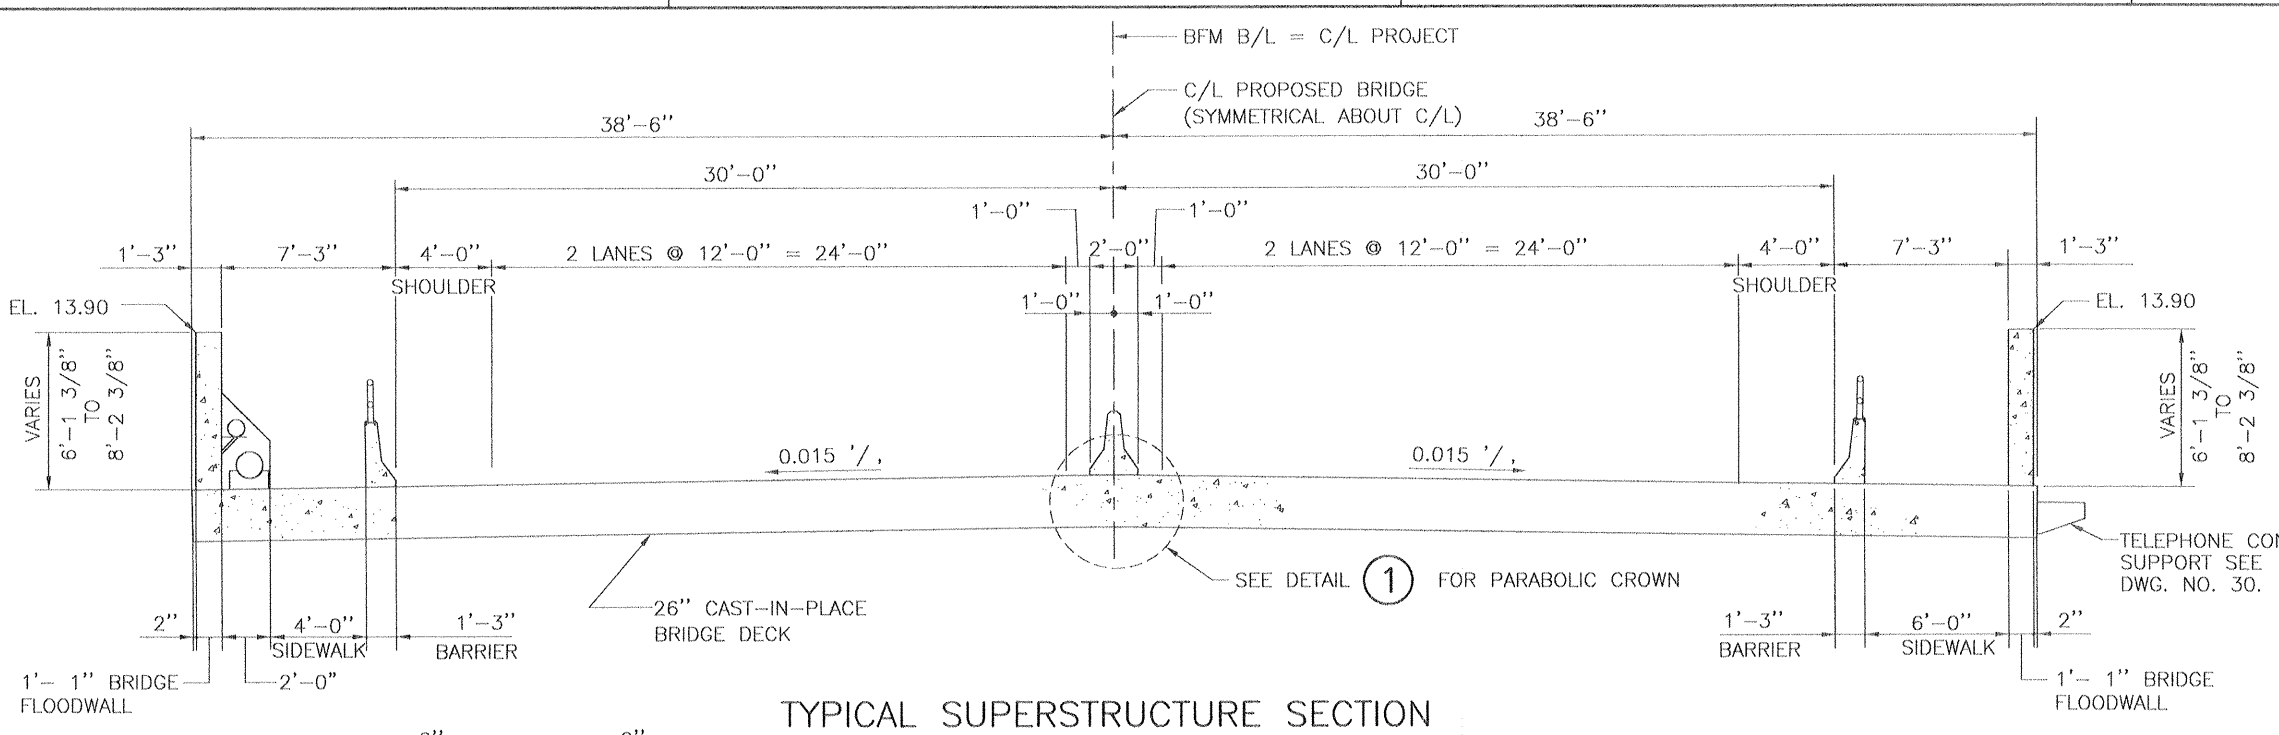


TYPICAL SUPERSTRUCTURE SECTION
SCALE: 1/4" = 1'-0"

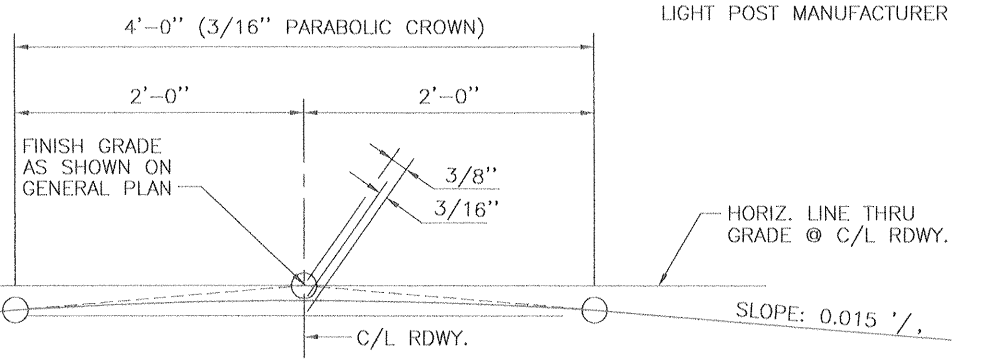


DETAIL (1)
TWO WAY TANGENT CROWN PARABOLIC CROWN DETAIL

NOTE: LIGHT POST ANCHOR BOLTS NOT SHOWN FOR CLARITY. SEE ANCHOR BOLT DETAILS THIS SHEET.

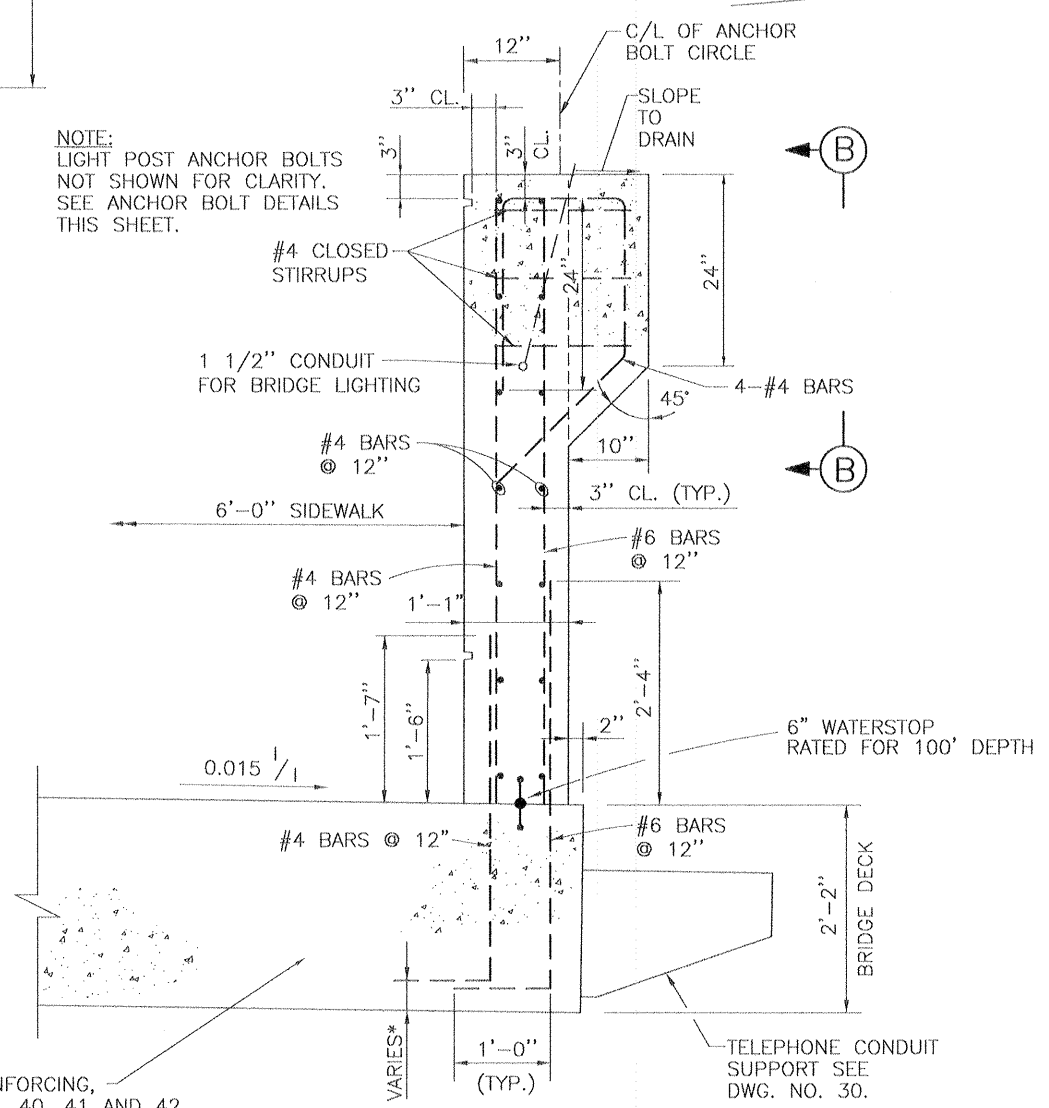


TYPICAL BRIDGE FLOODWALL DETAIL INCLUDING LIGHT POST CORBEL
SCALE: 1" = 1'-0"

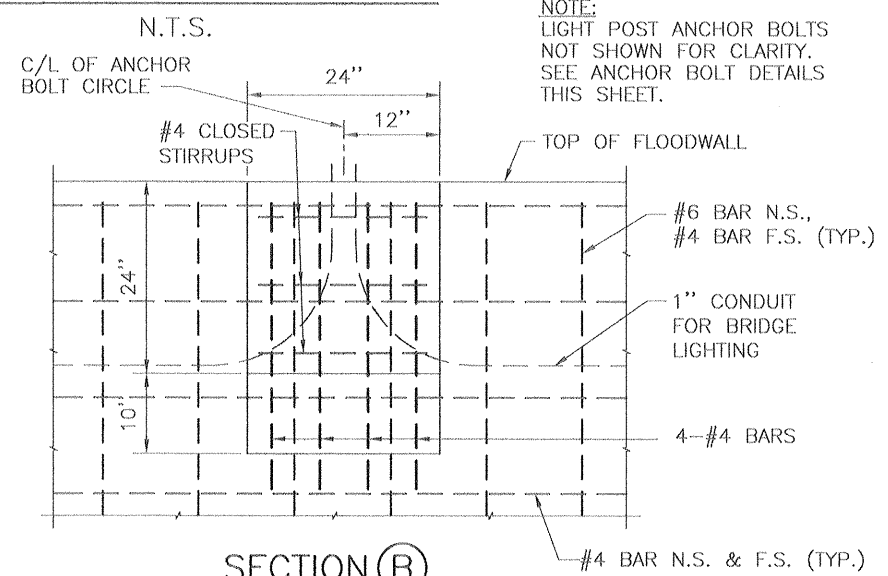

SECTION (B)
SCALE: 1" = 1'-0"


- REFERENCE DRAWINGS
- FOR GENERAL NOTES, SEE DWG. NO. 3.
 - FOR BRIDGE PLAN AND ELEVATION, SEE DWG. NO. 30.
 - FOR BRIDGE SLAB DETAILS, SEE DWG. NOS. 40, 41 AND 42.

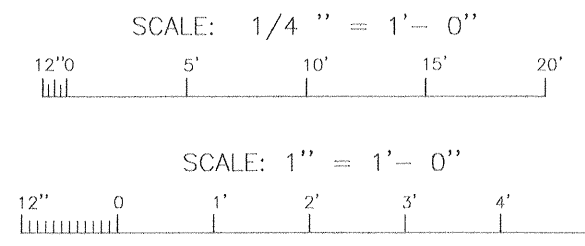

File: D:\PROJECTS\DWG\Last method: AUG. 26, 02 @ 4:35 P.M. Scale: 1/48 P.L.C.


DACW29-00-B-0094

AS BUILT PLANS
DATE RECEIVED: 3/15/02
DATE TRACINGS CORRECTED: 4/18/02

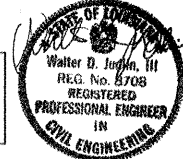

SYMBOL	DESCRIPTION	DATE	APPROVED
REVISIONS			
U.S. ARMY ENGINEER DISTRICT, NEW ORLEANS CORPS OF ENGINEERS NEW ORLEANS, LOUISIANA			
BOARD OF LEVEE COMMISSIONERS ORLEANS LEVEE BOARD NEW ORLEANS, LOUISIANA		HARTMAN ENGINEERING, INC. CONSULTING ENGINEERS KENNER, LOUISIANA	
LAKE PONTCHARTRAIN, LA. AND VICINITY HIGH LEVEL PLAN ORLEANS AVENUE OUTFALL CANAL PHASE 1B ORLEANS PARISH LOUISIANA			
ROBERT E. LEE BOULEVARD BRIDGE TYPICAL SUPERSTRUCTURE SECTION			
DESIGNED BY: W.D.L.	DATE: MAR. 8, 2000	PLOT SCALE: 48	PLOT DATE: MARCH 8, 2000
DRAWN BY: L.A.C.	CHECKED BY: P.J.H.	CADD FILE: SHT38.DGN	FILE NO. H-4-44776
SUBMITTED BY: HARTMAN ENGINEERING DESIGN ENGINEER	SOLICITATION NO. DACW29-00-B-0094	DWG. 38 OF 59	

Safety is a Part of Your Contract

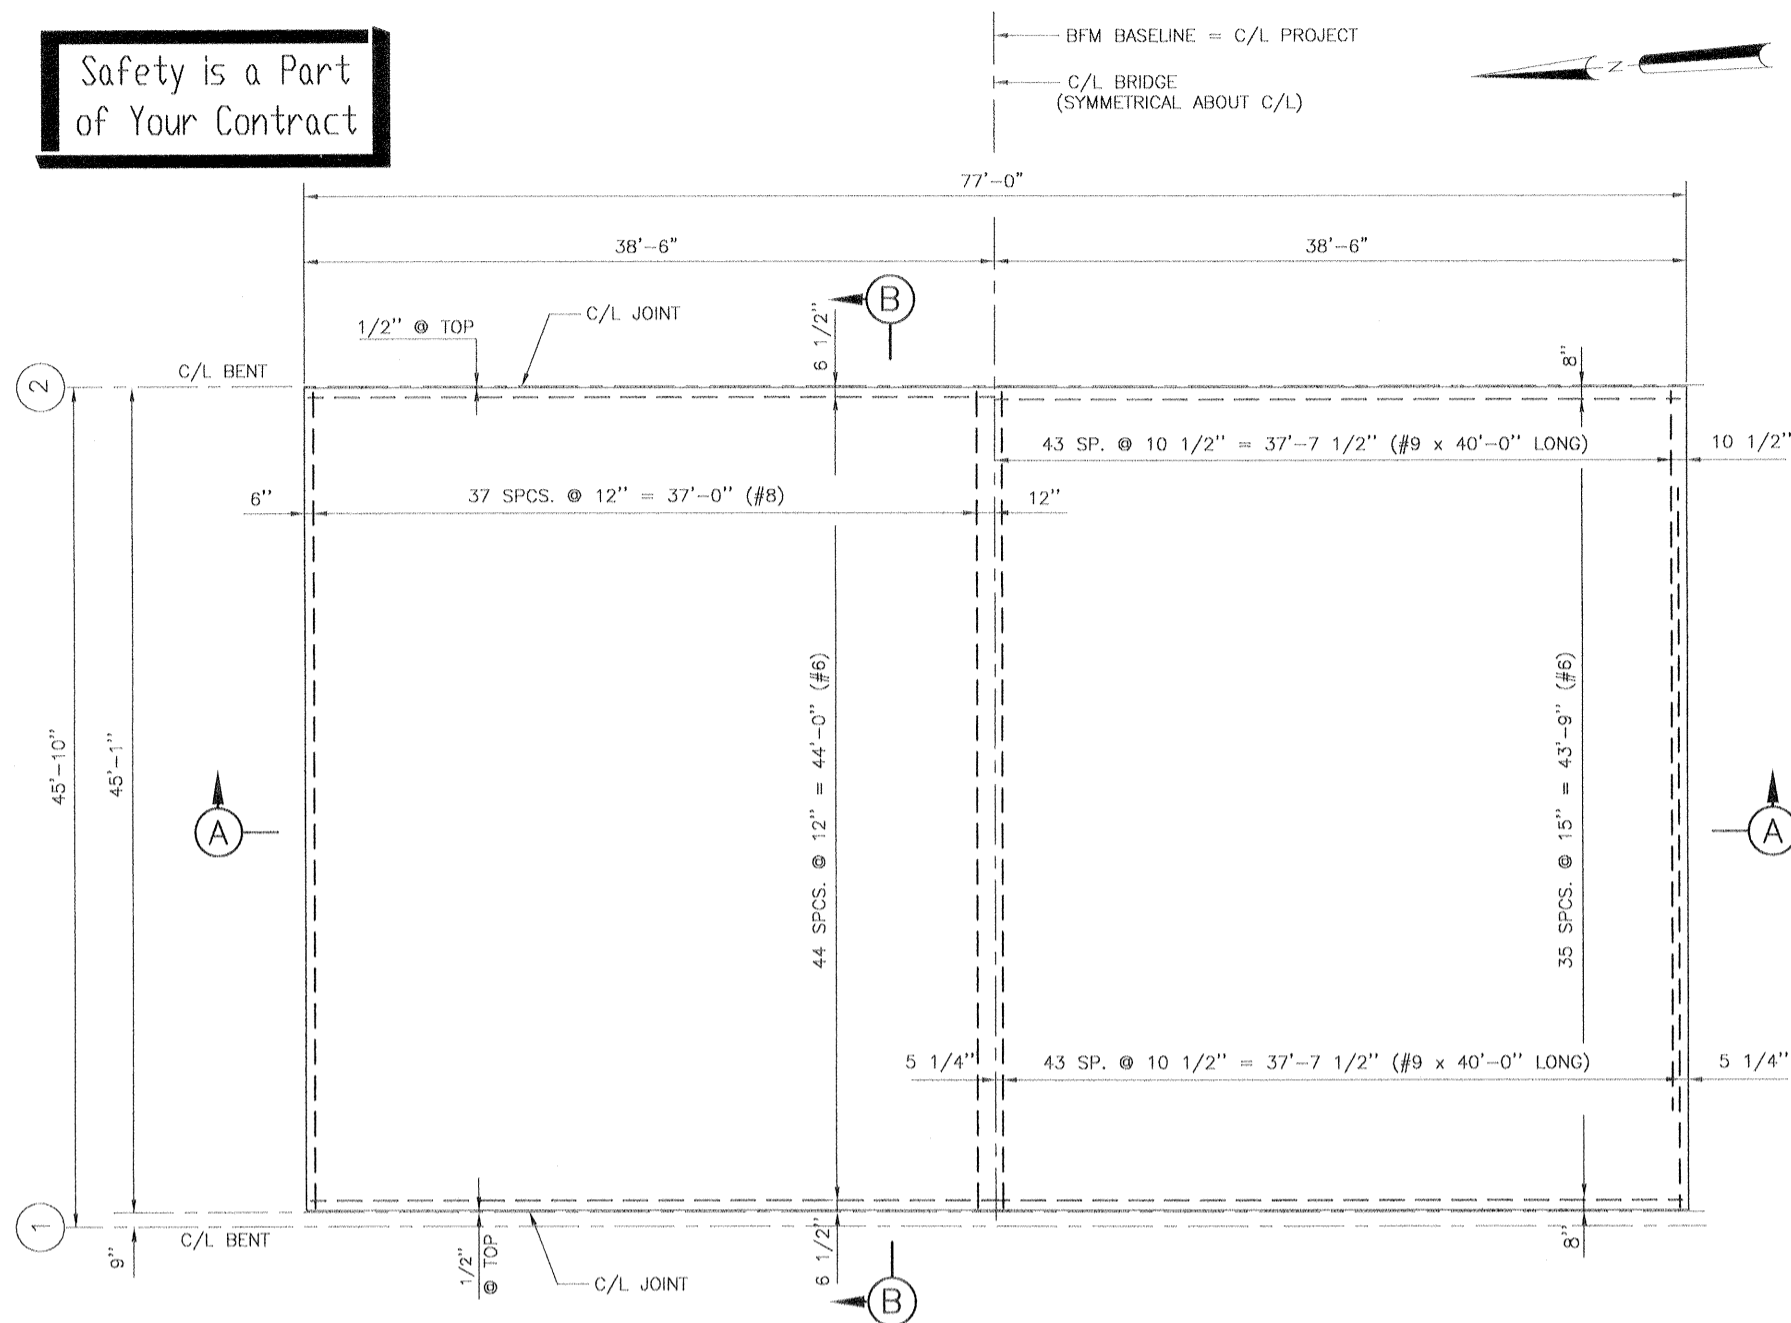


HALF PLAN
SHOWING SPACING OF
TOP REINF. STEEL

HALF PLAN
SHOWING SPACING OF
BOT. REINF. STEEL

PLAN

SCALE: 3/16" = 1'-0"

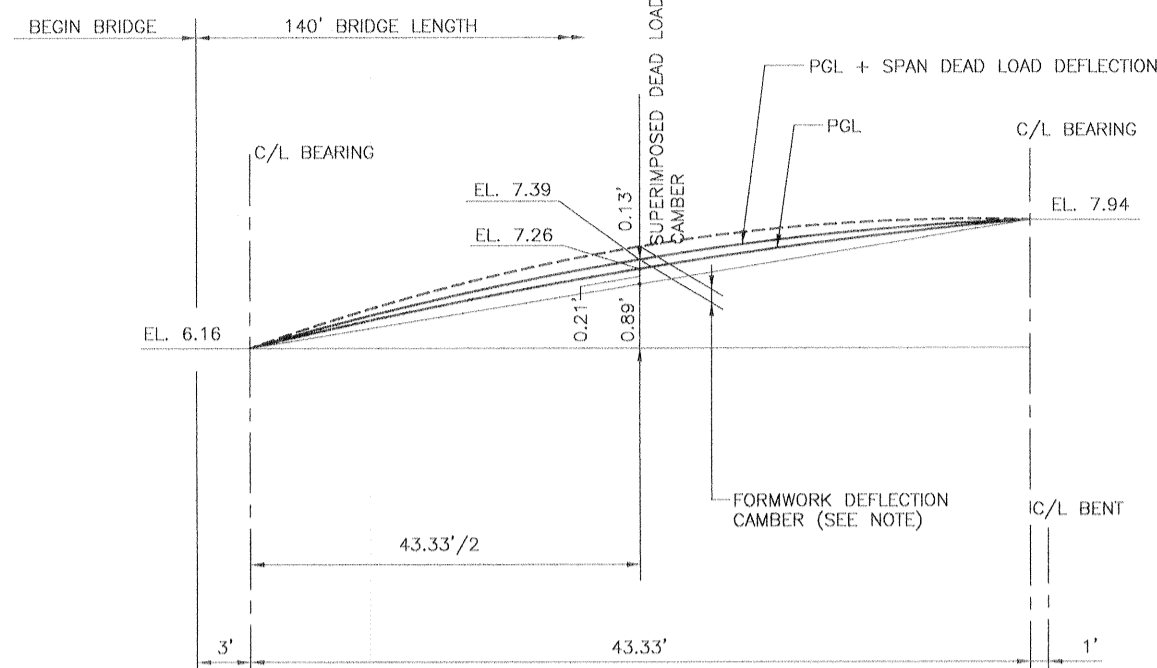


BRIDGE DECK CAMBER (SPAN 1)

SCALE: 3/16" = 1'-0" HORIZ.
3/4" = 1'-0" VERT.

DETAIL (3)


SCALE: 3" = 1'-0"

NOTE:
THE PGL + SPAN DEAD LOAD DEFLECTION CHAMBER SHOWN DOES NOT INCLUDE THE DEFLECTION DUE TO THE WEIGHT OF THE FORMWORK. THE CONTRACTOR SHALL PROVIDE ADDITIONAL CAMBER TO ACCOUNT FOR SUCH DEFLECTIONS. CALCULATIONS ARE TO BE SUBMITTED TO CONTRACTING OFFICER.

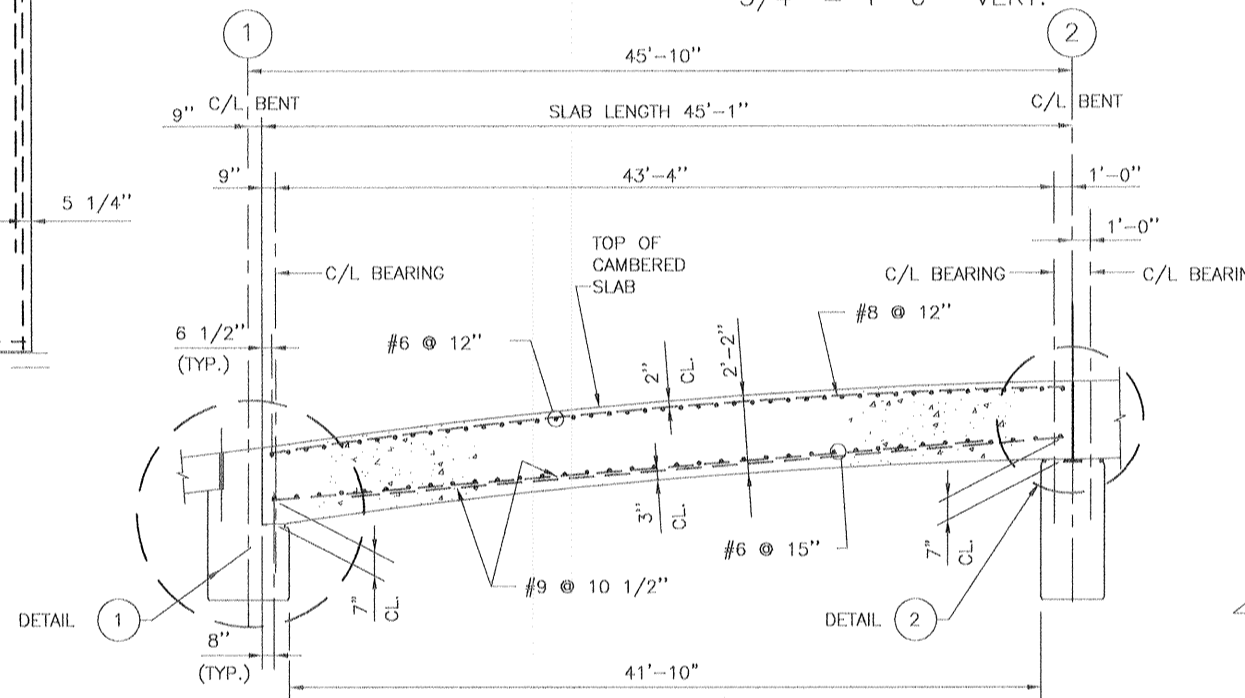


SECTION (B)

HOR. SCALE: 3/16" = 1'-0"
VERT. SCALE: 3/8" = 1'-0"

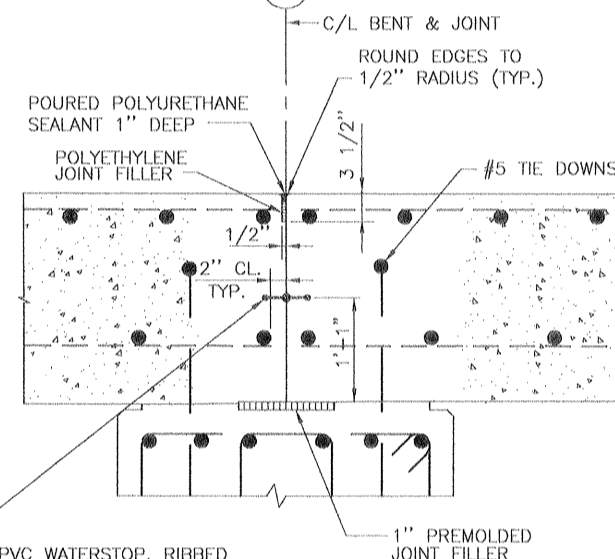


DETAIL (2)

SCALE: 1" = 1'-0"

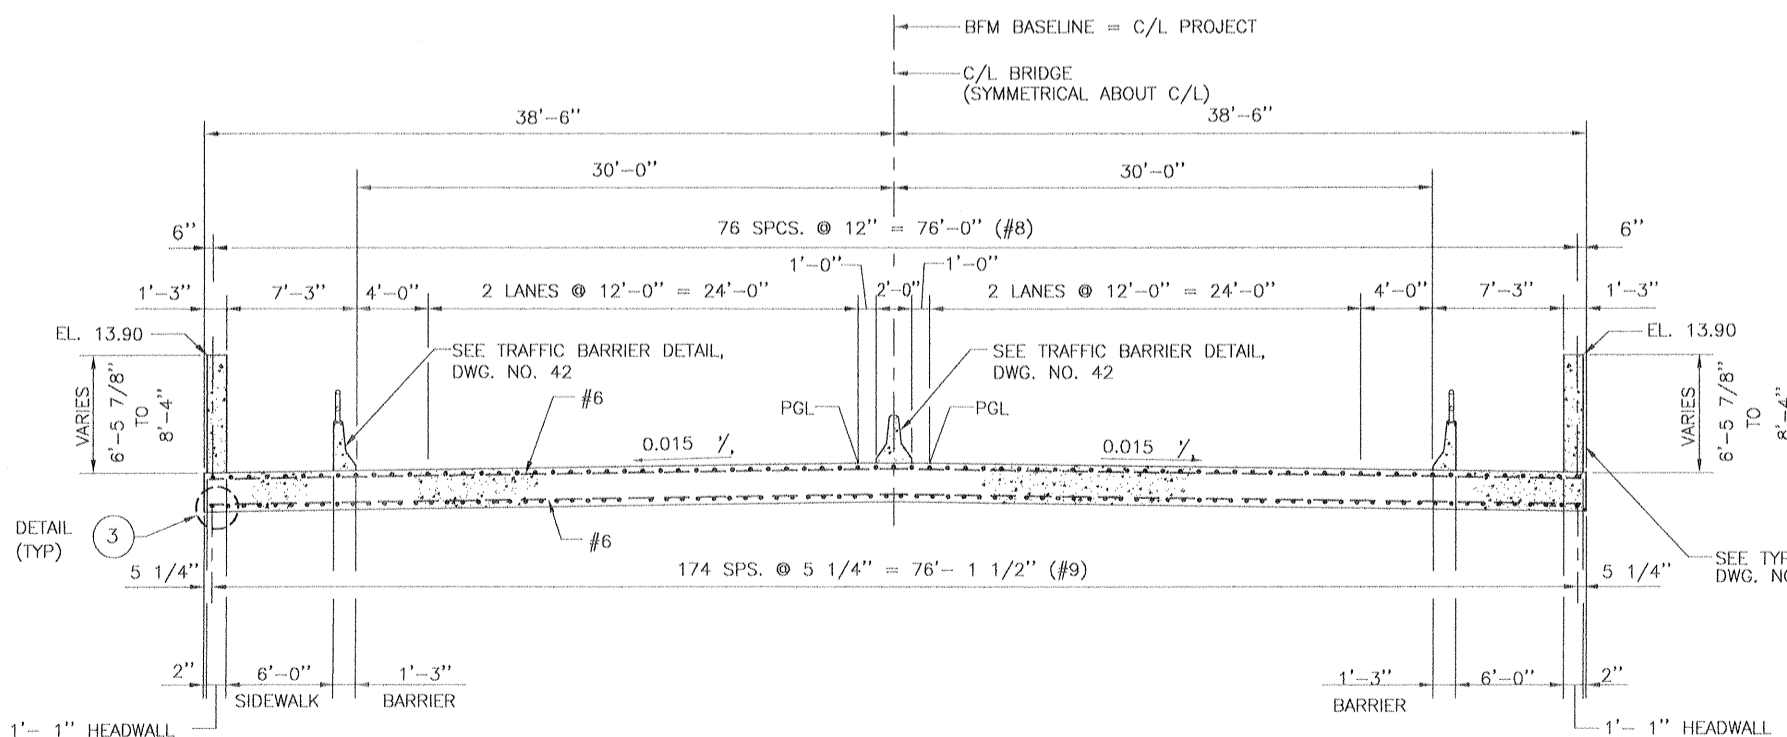

SECTION (A)


SCALE: 3/16" = 1'-0"

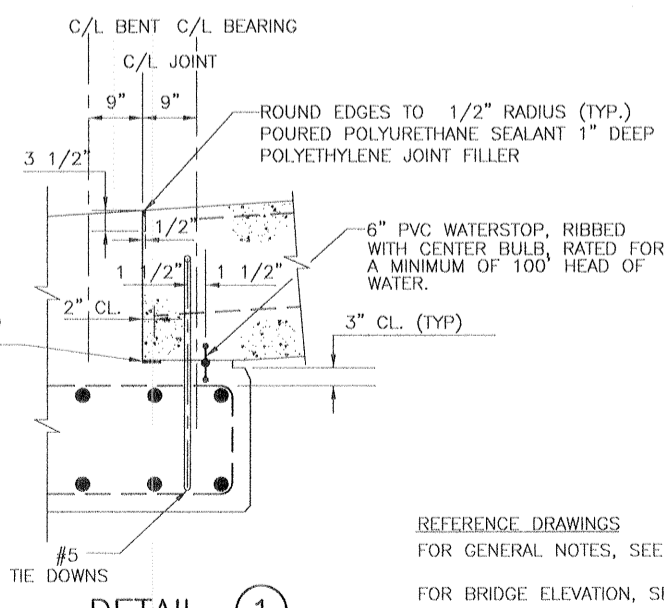

DETAIL (1)

SCALE: 3/4" = 1'-0"


REFERENCE DRAWINGS
FOR GENERAL NOTES, SEE DWG. NO. 3.
FOR BRIDGE ELEVATION, SEE DWG. NO. 30.
FOR BENTS, SEE DWG. NO. 37.
FOR BRIDGE FLOODWALL SECTION, SEE DWG. NO. 38.
FOR BAR SUPPORT DETAILS, SEE DWG. NO. 56.

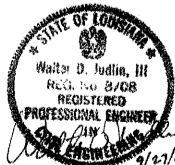

DACW29-00-B-0094

AS BUILT PLANS


DATE RECEIVED 3/15/02
DATE TRACINGS CORRECTED 4/18/02

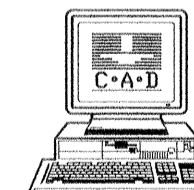

SYMBOL	DESCRIPTION	DATE	APPROVED
REVISIONS			
U.S. ARMY ENGINEER DISTRICT, NEW ORLEANS CORPS OF ENGINEERS NEW ORLEANS, LOUISIANA			
BOARD OF LEVEE COMMISSIONERS NEW ORLEANS, LOUISIANA		HARTMAN ENGINEERING, INC. CONSULTING ENGINEERS KENNER, LOUISIANA	
LAKE PONTCHARTRAIN, LA. AND VICINITY HIGH LEVEL PLAN ORLEANS AVENUE OUTFALL CANAL PHASE 1B ORLEANS PARISH LOUISIANA			
ROBERT E. LEE BOULEVARD BRIDGE SLAB SPAN 1			
DESIGNED BY: N.P.	DATE: MAR. 8, 2000	PLOT SCALE: 64	PLOT DATE: MARCH 8, 2000
DRAWN BY: L.A.C.	CADD FILE: SHT40.DGN	FILE NO.:	H-4-44776
CHECKED BY: P.J.H.	SOLICITATION NO.:	DWG. NO.:	40 OF 59
SUBMITTED BY: HARTMAN ENGINEERING DESIGN ENGINEER	SOLICITATION NO.:	DWG. NO.:	

File: D:\SP40.DWG Last edited: AUG. 28, 02 @ 4:46 p.m. Scale: 1/8" = 1'-0"


Safety is a Part of Your Contract

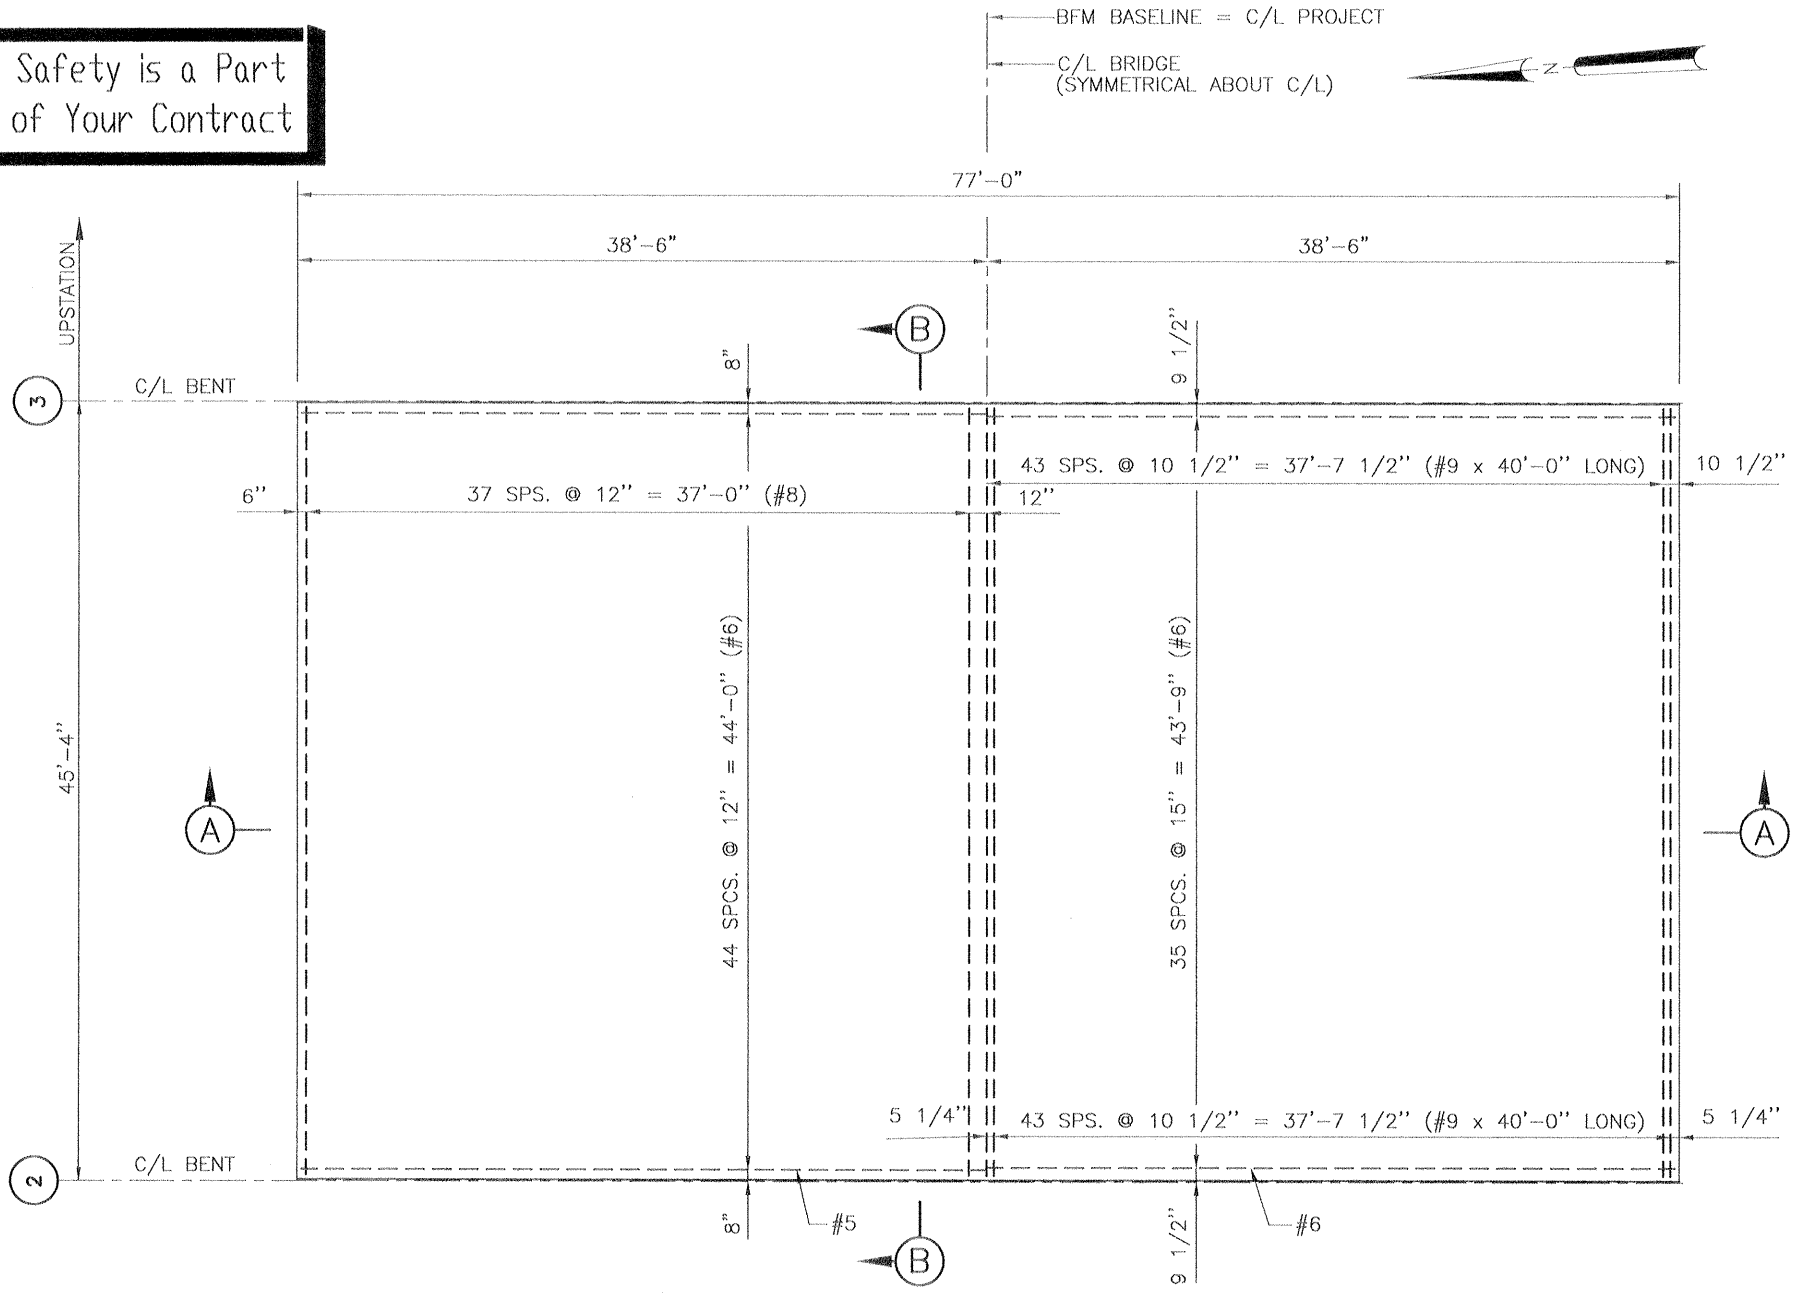

HALF PLAN SHOWING SPACING OF TOP REINF. STEEL
 HALF PLAN SHOWING SPACING OF BOT. REINF. STEEL


PLAN

SCALE: 3/16" = 1'-0"

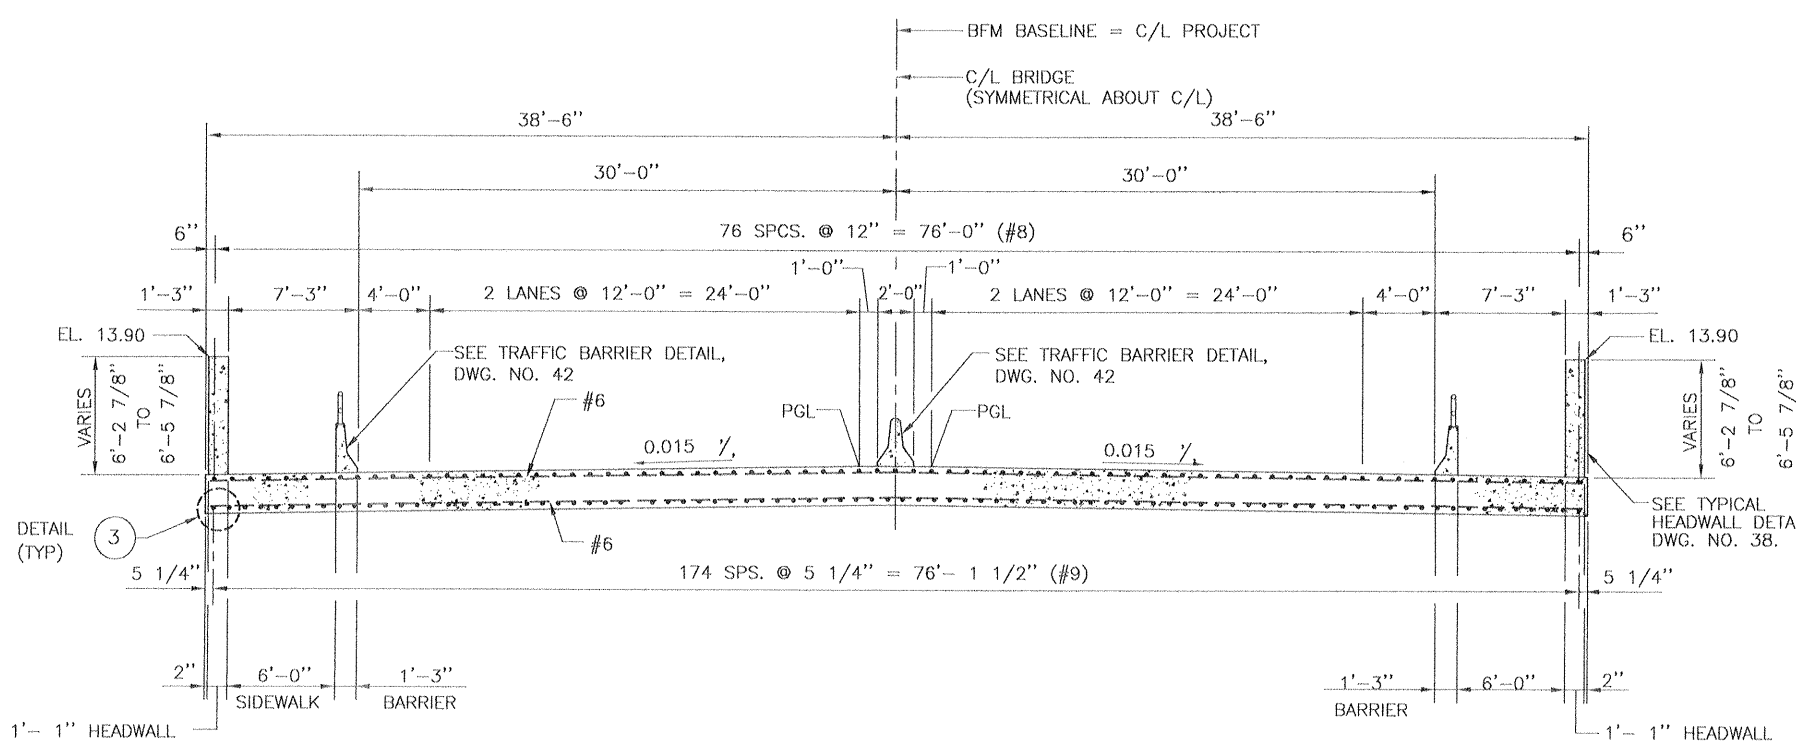


SECTION A

SCALE: 3/16" = 1'-0"

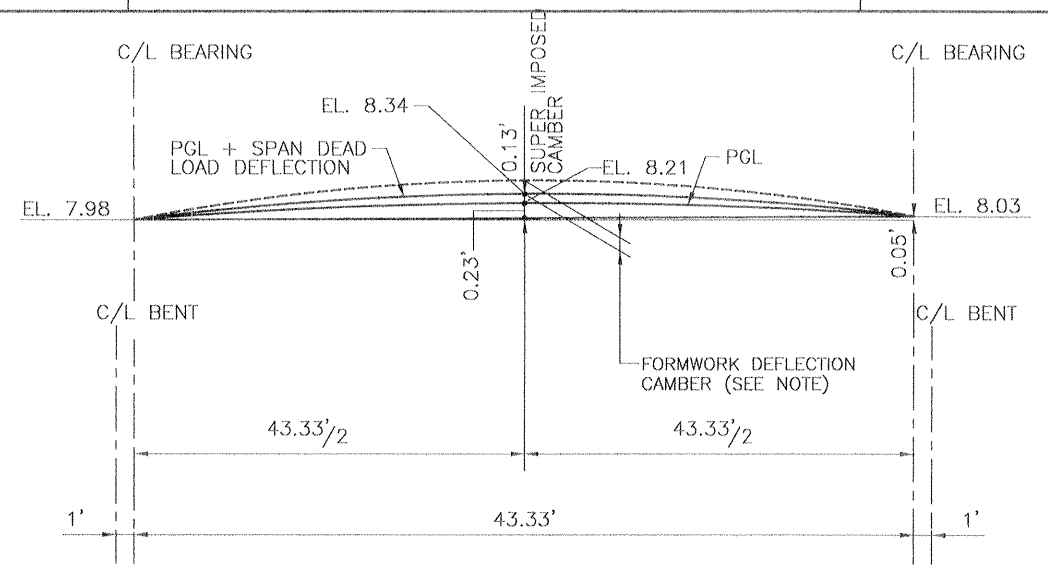


BRIDGE DECK CAMBER (SPAN 2)

SCALE: 3/16" = 1'-0" HORZ.
 3/4" = 1'-0" VERT.

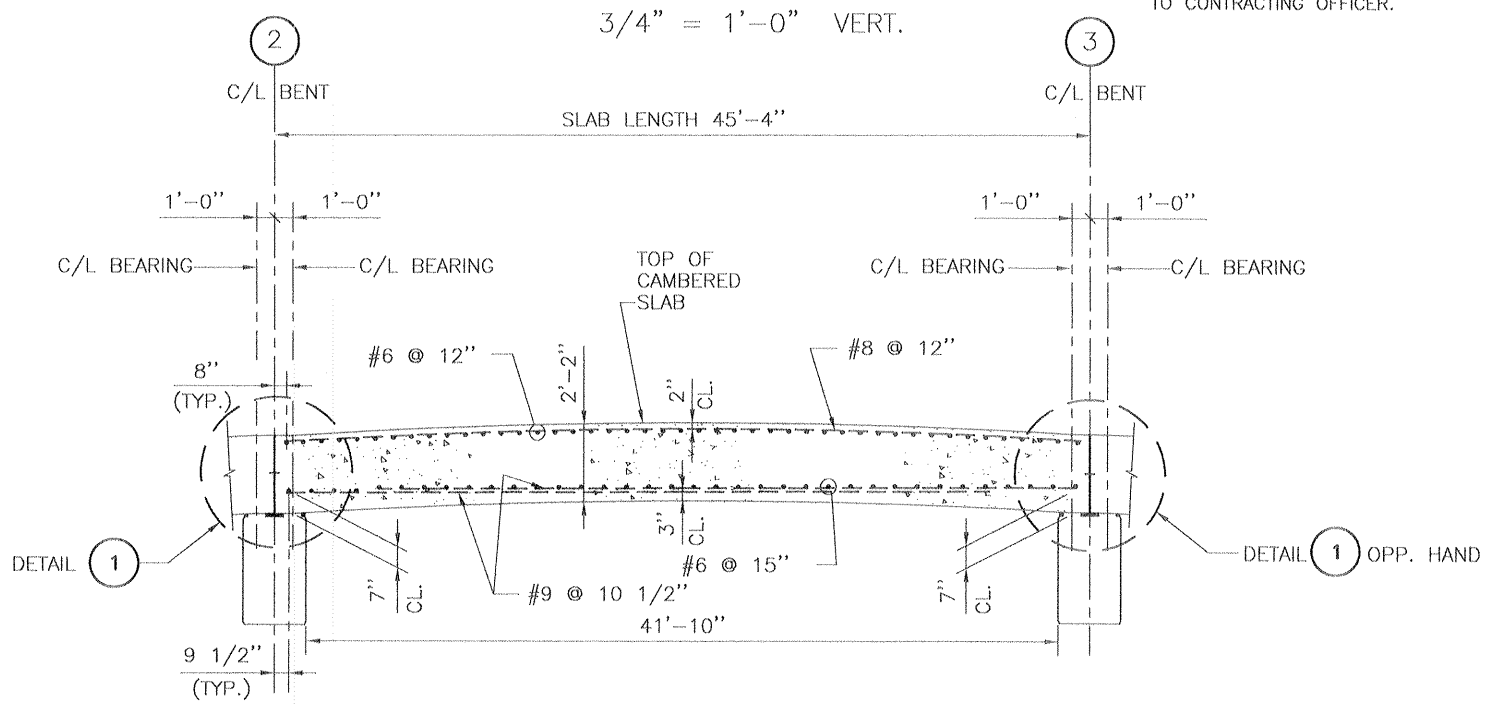

SECTION B


HOR. SCALE: 3/16" = 1'-0"
 VERT. SCALE: 3/8" = 1'-0"

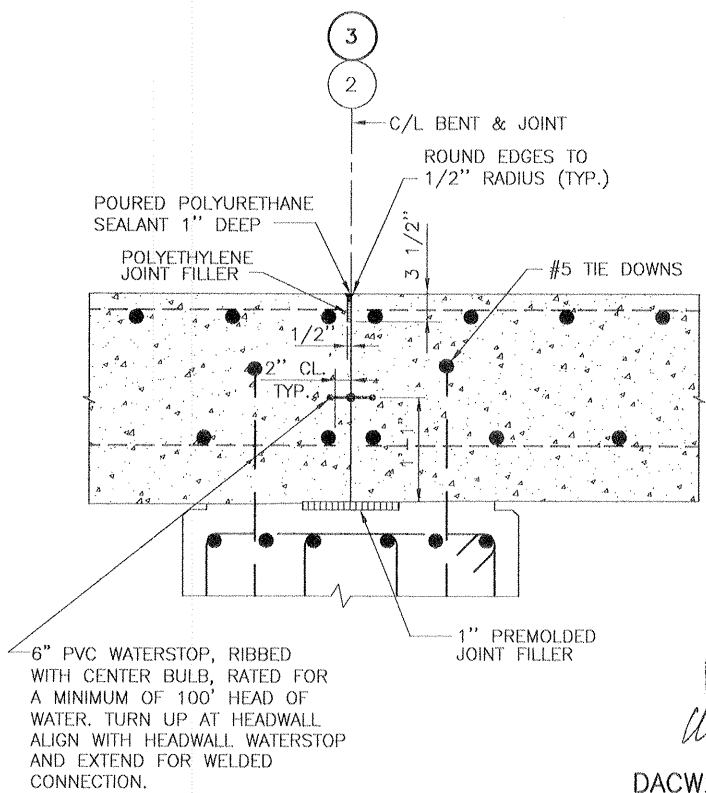

DETAIL 1

SCALE: 1" = 1'-0"

© BENT LINE 3 OPP. HAND

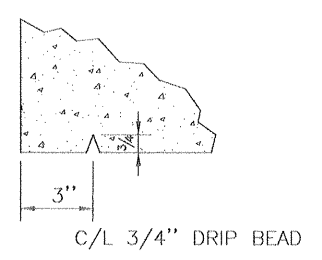


DETAIL 3
 SCALE: 3" = 1'-0"

NOTE:
 THE PGL + SPAN DEAD LOAD DEFLECTION CAMBER SHOWN DOES NOT INCLUDE THE DEFLECTION DUE TO THE WEIGHT OF THE FORMWORK. THE CONTRACTOR SHALL PROVIDE ADDITIONAL CAMBER TO ACCOUNT FOR SUCH DEFLECTIONS. CALCULATIONS ARE TO BE SUBMITTED TO CONTRACTING OFFICER.


REFERENCE DRAWINGS
 FOR GENERAL NOTES, SEE DWG. NO. 3.
 FOR BRIDGE ELEVATION, SEE DWG. NO. 30.
 FOR BENTS, SEE DWG. NO. 37.
 FOR BRIDGE FLOODWALL SECTION, SEE DWG. NO. 38.
 FOR BAR SUPPORT DETAILS, SEE DWG. NO. 56.

SYMBOL	DESCRIPTION	DATE	APPROVED
REVISIONS			
U.S. ARMY ENGINEER DISTRICT, NEW ORLEANS CORPS OF ENGINEERS NEW ORLEANS, LOUISIANA			
BOARD OF LEVEE COMMISSIONERS ORLEANS LEVEE BOARD NEW ORLEANS, LOUISIANA		HARTMAN ENGINEERING, INC. CONSULTING ENGINEERS KENNER, LOUISIANA	
LAKE PONTCHARTRAIN, LA. AND VICINITY HIGH LEVEL PLAN ORLEANS AVENUE OUTFALL CANAL PHASE 1B ORLEANS PARISH LOUISIANA			
ROBERT E. LEE BOULEVARD BRIDGE SLAB SPAN 2			
DESIGNED BY: N.P.	DATE: MAR. 8, 2000	PLOT SCALE: 64	PLOT DATE: MARCH 8, 2000
DRAWN BY: L.A.C.	CADD FILE: SH141.DGN		FILE NO. H-4-44776
CHECKED BY: P.J.H.	SUBMITTED BY: HARTMAN ENGINEERING	SOLICITATION NO. DACW29-00-B-0094	DWG. 41 OF 59


AS BUILT PLANS
 DATE RECEIVED: 3/15/02
 DATE TRACINGS CORRECTED: 4/18/02

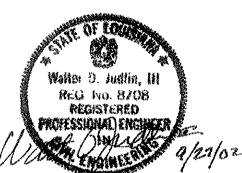

File: DA3914.DWG Last revised: AUG. 26, 02 @ 4:47 p.m. Scale: 1/8" = 1'-0"

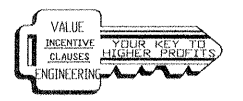

Safety is a Part of Your Contract

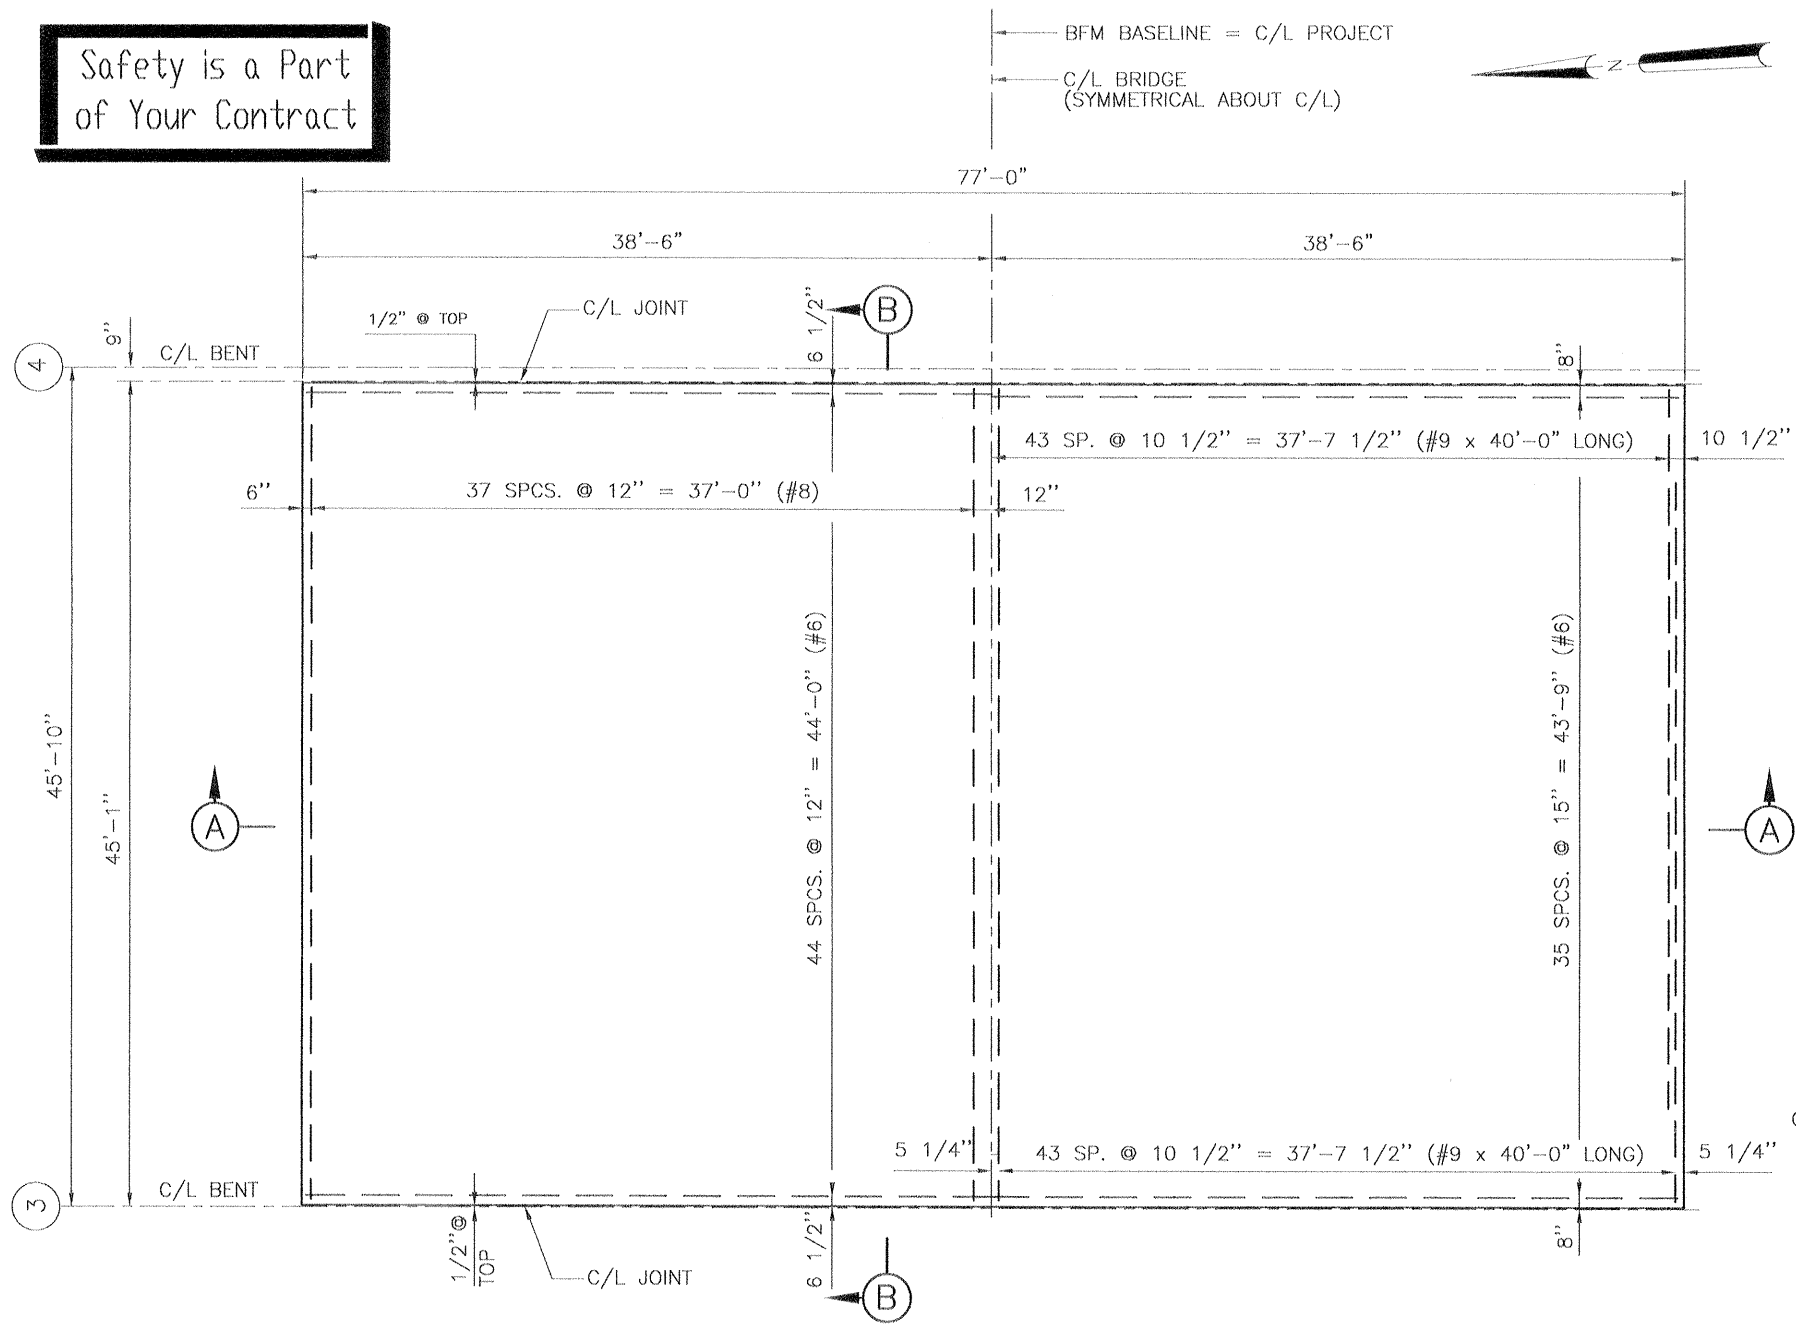


HALF PLAN SHOWING SPACING OF TOP REINF. STEEL

HALF PLAN SHOWING SPACING OF BOT. REINF. STEEL


PLAN

SCALE: 3/16" = 1'-0"

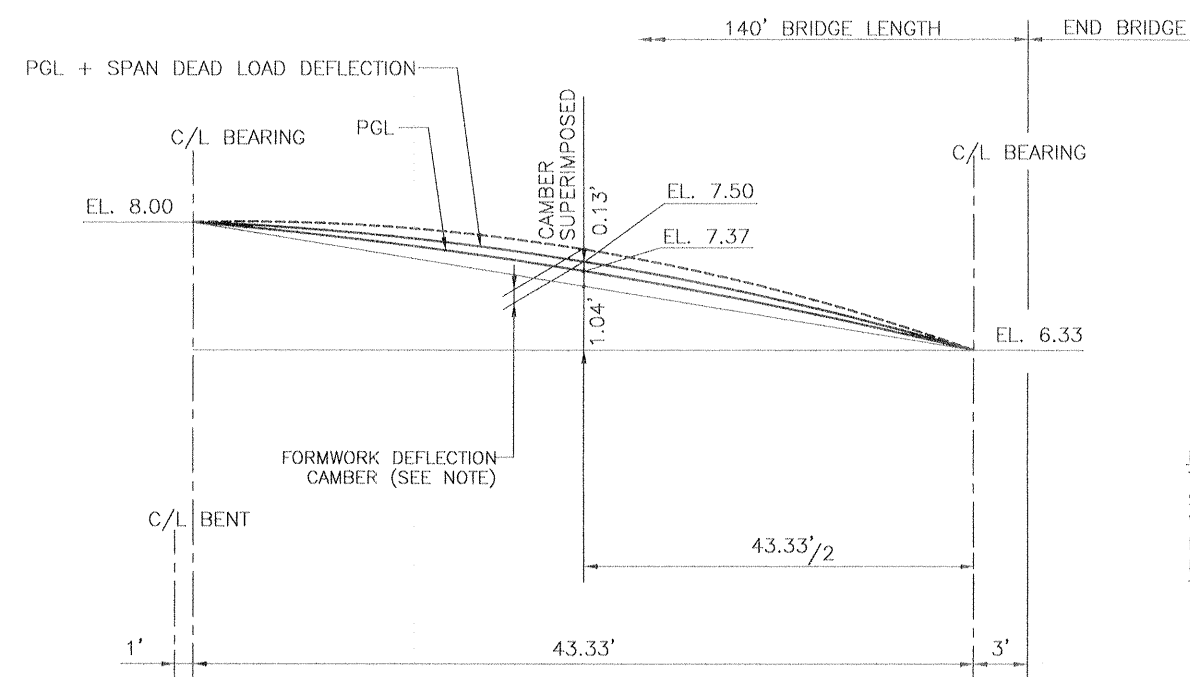


BRIDGE DECK CAMBER (SPAN 3)

SCALE: 3/16" = 1'-0" HORIZ.
3/4" = 1'-0" VERT.

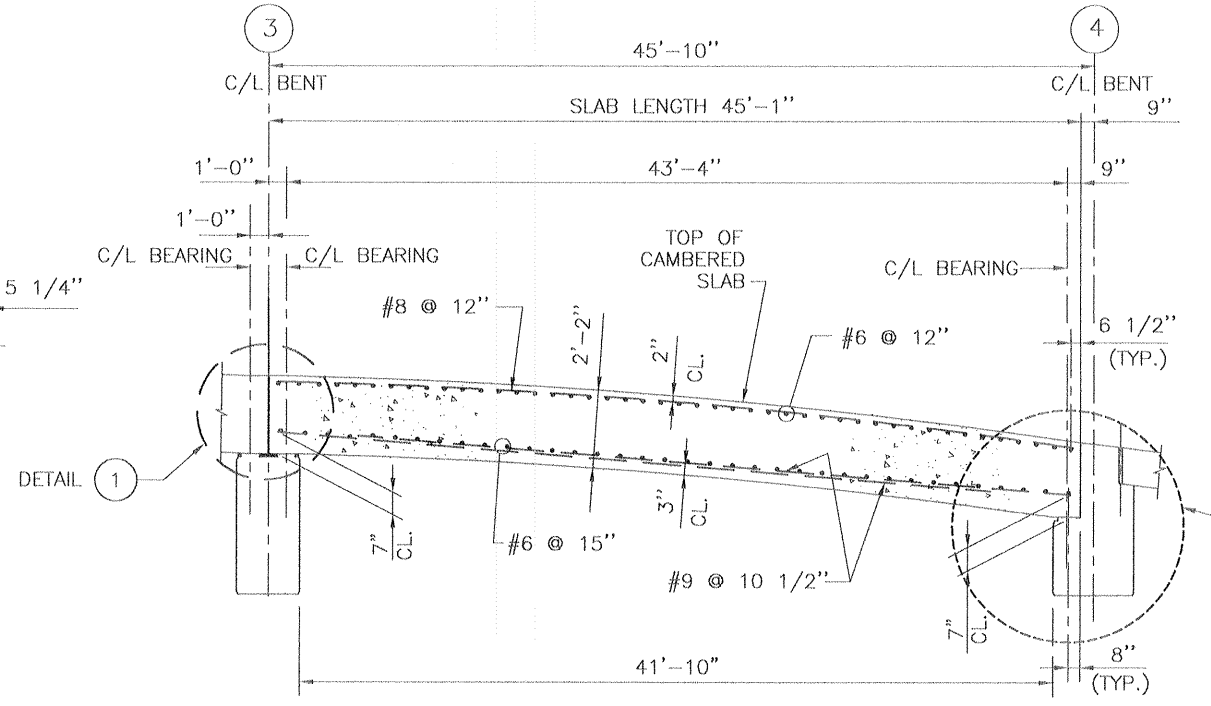

SECTION (B)


HOR. SCALE: 3/16" = 1'-0"
VERT. SCALE: 3/8" = 1'-0"

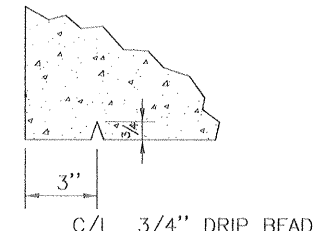

DETAIL (3)

SCALE: 3" = 1'-0"


NOTE: THE PGL + SPAN DEAD LOAD DEFLECTION CAMBER SHOWN DOES NOT INCLUDE THE DEFLECTION DUE TO THE WEIGHT OF THE FORMWORK. THE CONTRACTOR SHALL PROVIDE ADDITIONAL CAMBER TO ACCOUNT FOR SUCH DEFLECTIONS. CALCULATIONS ARE TO BE SUBMITTED TO CONTRACTING OFFICER.

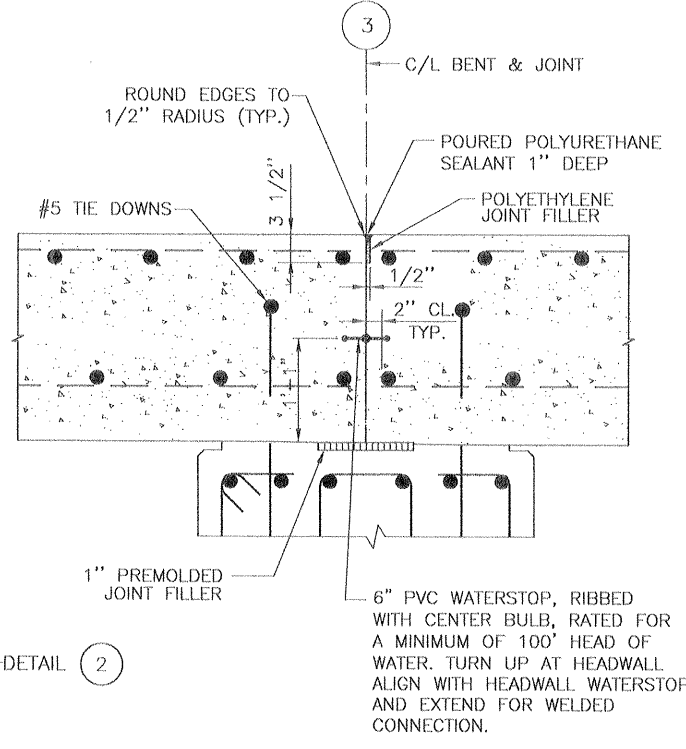

DETAIL (1)


SCALE: 1" = 1'-0"

- REFERENCE DRAWINGS
FOR GENERAL NOTES, SEE DWG. NO. 3.
FOR BRIDGE ELEVATION, SEE DWG. NO. 30.
FOR BENTS, SEE DWG. NO. 37.
FOR BRIDGE FLOODWALL SECTION, SEE DWG. NO. 38.
FOR BAR SUPPORT DETAILS, SEE DWG. NO. 56.

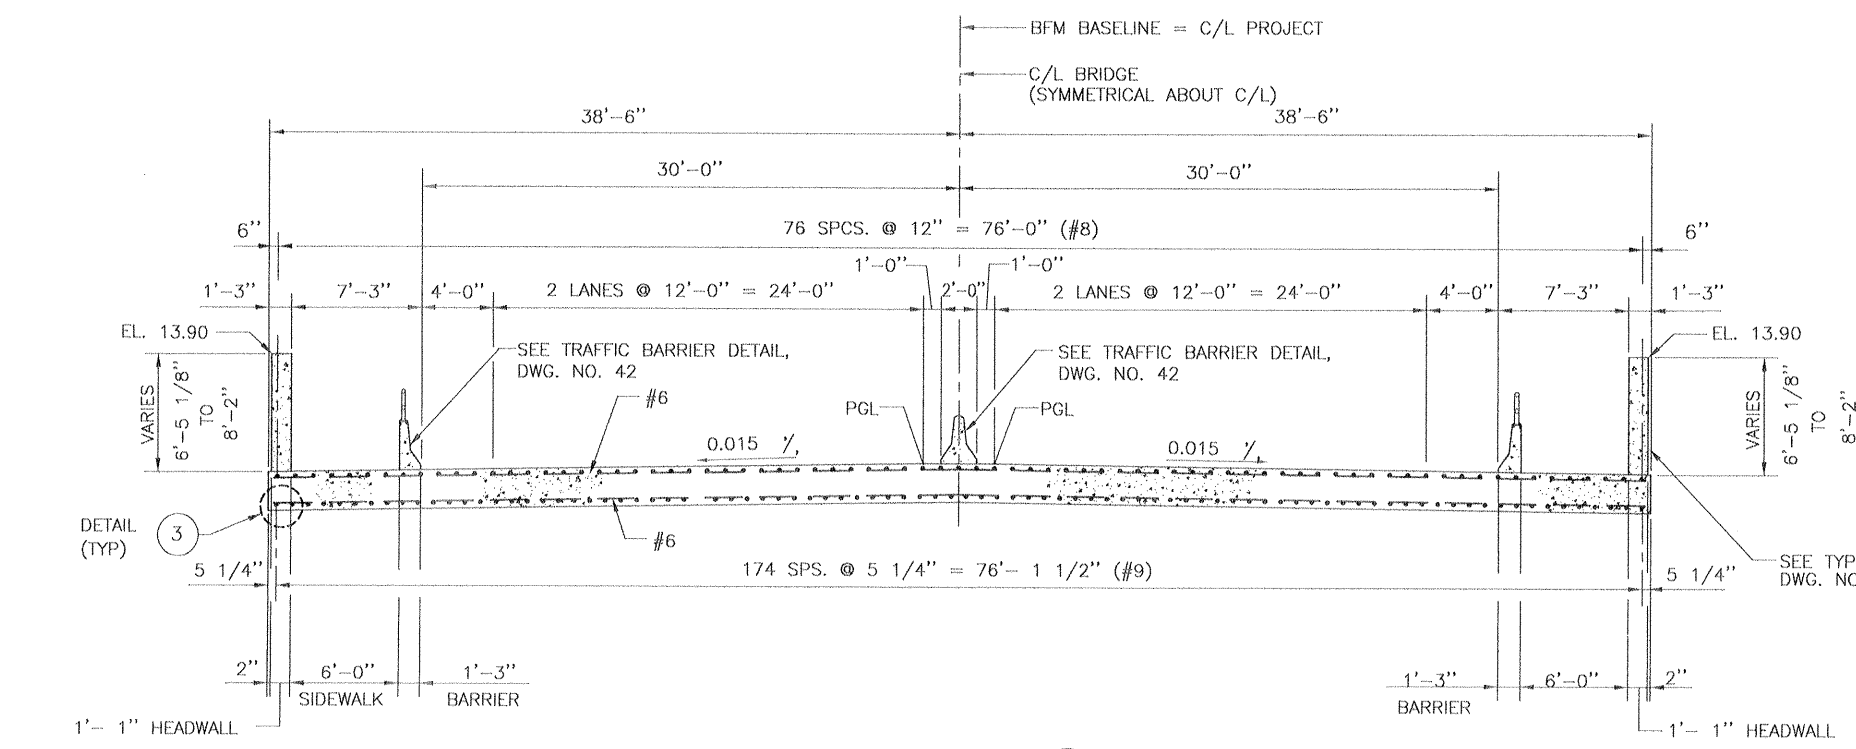


SECTION (A)

SCALE: 3/16" = 1'-0"

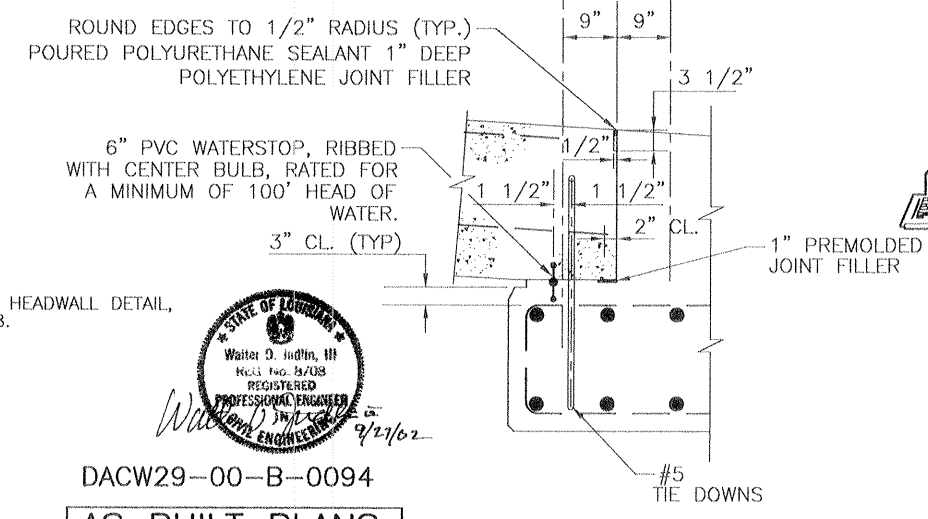

DETAIL (2)

SCALE: 3/4" = 1'-0"

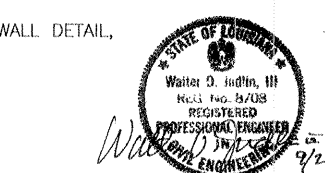

DACW29-00-B-0094


AS BUILT PLANS

DATE RECEIVED 3/15/02
DATE TRACINGS CORRECTED 4/18/02

SYMBOL	DESCRIPTION	DATE	APPROVED
REVISIONS			
S. ARMY ENGINEER DISTRICT, NEW ORLEANS CORPS OF ENGINEERS NEW ORLEANS, LOUISIANA			
BOARD OF LEVEE COMMISSIONERS ORLEANS LEVEE BOARD NEW ORLEANS, LOUISIANA		HARTMAN ENGINEERING, INC. CONSULTING ENGINEERS KENNER, LOUISIANA	
LAKE PONTCHARTRAIN, LA. AND VICINITY HIGH LEVEL PLAN ORLEANS AVENUE OUTFALL CANAL PHASE 1B ORLEANS PARISH LOUISIANA			
ROBERT E. LEE BOULEVARD BRIDGE SLAB SPAN 3			
DESIGNED BY: N.P.	DATE: MAR. 8, 2000	PLOT SCALE: 64	PLOT DATE: MARCH 8, 2000
DRAWN BY: L.A.C.	CHECKED BY: P.J.H.	CADD FILE: SHT42.DGN	FILE NO. H-4-44776
SUBMITTED BY: HARTMAN ENGINEERING	SOLICITATION NO. DACW29-00-B-0094	DWG. 42 OF 59	


FILE: D:\SHT42.DWG Last edited: AUG. 26, 02 @ 4:49 p.m. Scale: 1/8" = 1'-0"



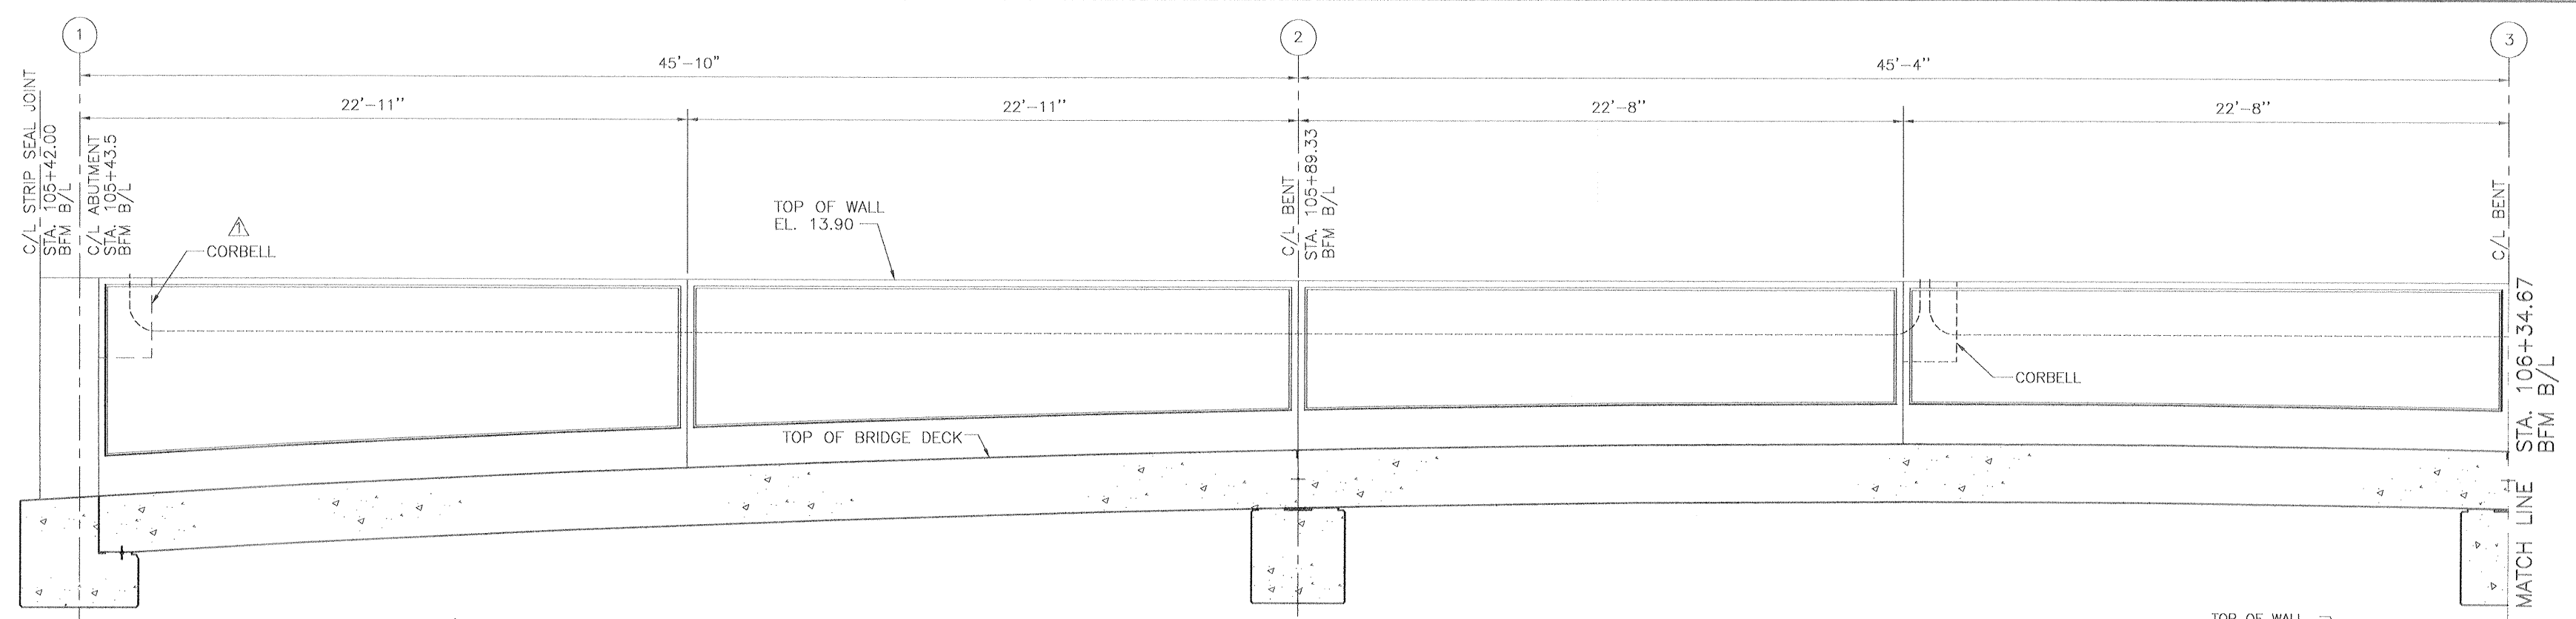


**Safety is a Part
of Your Contract**


**PROTECTED SIDE ELEVATION
SHOWING FLOODWALL FINISH**
SCALE: 3/8" = 1' - 0"

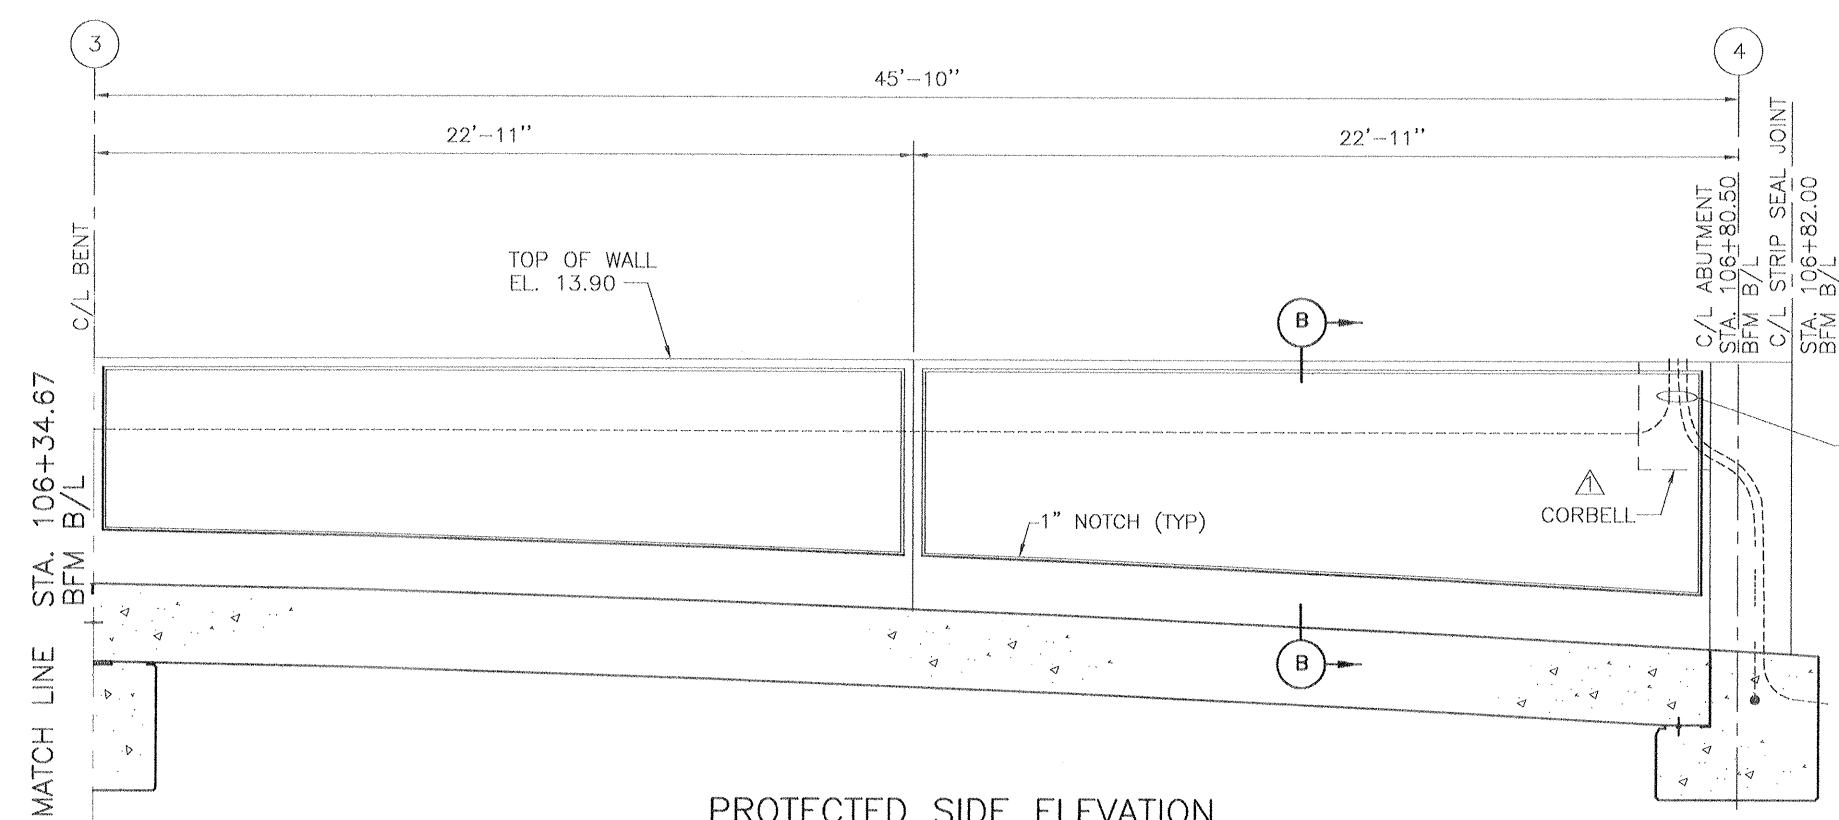

**PROTECTED SIDE ELEVATION
SHOWING FLOODWALL FINISH**
SCALE: 3/8" = 1' - 0"

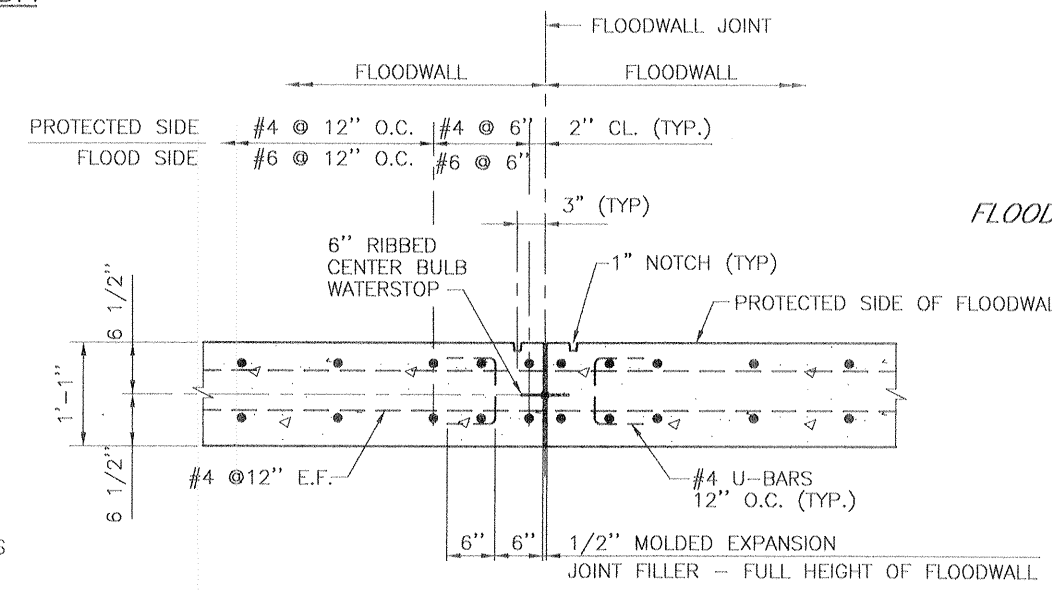


SECTION (A)
SCALE: 1" = 1' - 0"

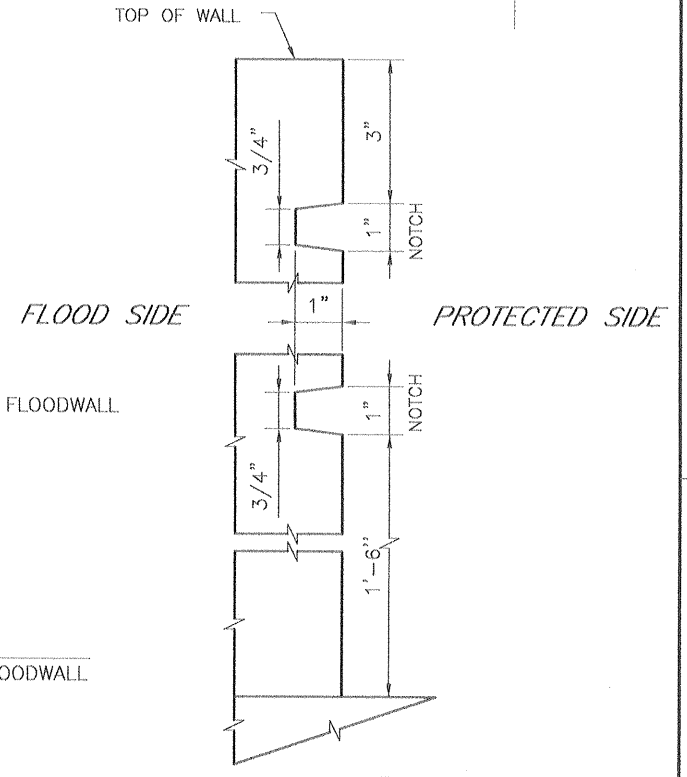


SECTION (B)
SCALE: 1/2" = 1' - 0"

REFERENCE DRAWINGS


- FOR GENERAL NOTES, SEE DWG. NO. 3
- FOR PLAN/PROFILE, SEE DWG. NO. 5
- FOR BRIDGE LIGHTING CONDUITS, SEE DWG. NO. 11
- FOR ABUTMENT DETAILS, SEE DWG. NO. 35 AND NO. 36
- FOR TYPICAL BRIDGE FLOODWALL AND CORBELL DETAIL SEE DWG. NO. 38
- FOR SLAB SPAN DETAILS, SEE DWG. NO. 40, 41 AND 42

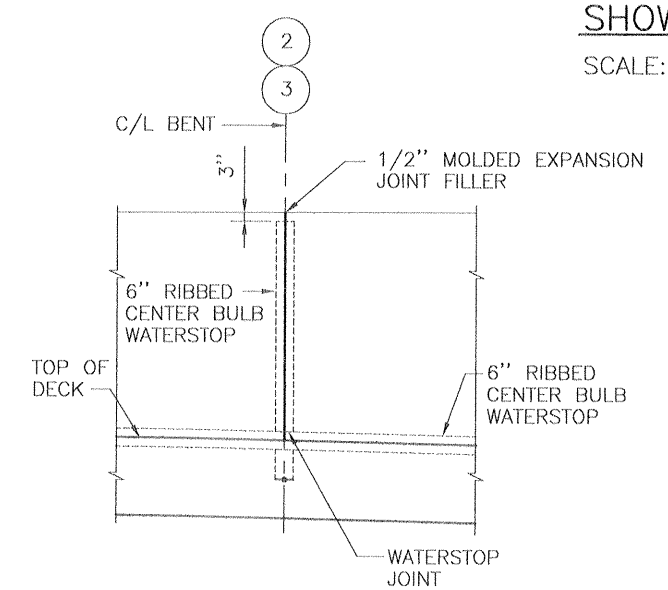


**FLOOD SIDE ELEVATION
FLOODWALL JOINT AT BENTS**
SCALE: 3/8" = 1' - 0"

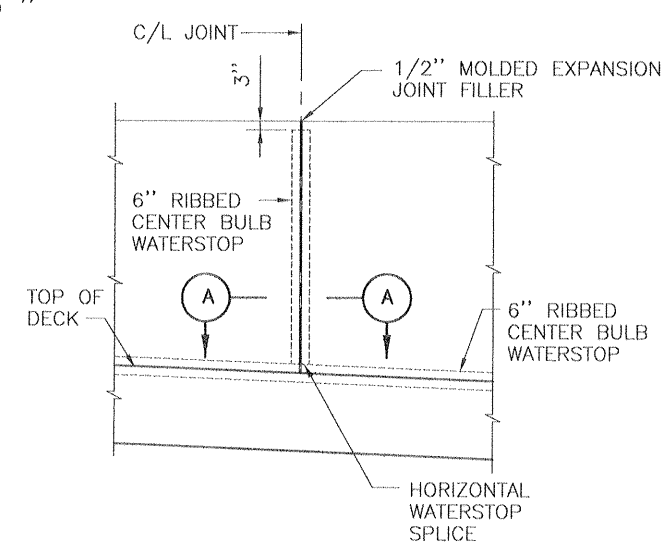

**FLOOD SIDE ELEVATION
FLOODWALL JOINT AT MIDSPAN**
SCALE: 3/8" = 1' - 0"

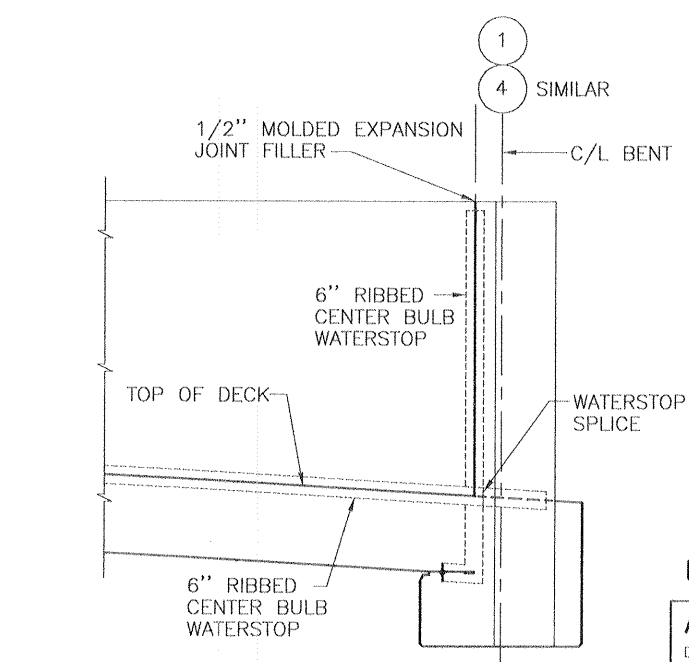

**FLOOD SIDE ELEVATION
DECK/FLOODWALL SEAL AT ABUTMENTS**
SCALE: 3/8" = 1' - 0"

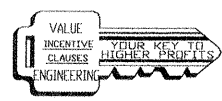

C.A.D.

STATE OF LOUISIANA
Robert E. Lee
REGISTERED PROFESSIONAL ENGINEER
No. 12345

DACW29-00-B-0094

AS BUILT PLANS
DATE RECEIVED 3/15/02
DATE TRACINGS CORRECTED 4/18/02

SYMBOL	DESCRIPTION	DATE	APPROVED
△	CHANGED TO SHOW CORBELL	09/19/02	W.D.J.

REVISIONS

U.S. ARMY ENGINEER DISTRICT, NEW ORLEANS
CORPS OF ENGINEERS
NEW ORLEANS, LOUISIANA

BOARD OF LEVEE COMMISSIONERS
ORLEANS LEVEE BOARD
NEW ORLEANS, LOUISIANA


HARTMAN ENGINEERING, INC.
CONSULTING ENGINEERS
KENNER, LOUISIANA

LAKE PONTCHARTRAIN, LA. AND VICINITY
HIGH LEVEL PLAN
ORLEANS AVENUE OUTFALL CANAL
PHASE 1B
ORLEANS PARISH
LOUISIANA

**ROBERT E. LEE BOULEVARD BRIDGE
BRIDGE FLOODWALL DETAILS**

DESIGNED BY: W.D.L.	DATE: MAR. 8, 2000	PLOT SCALE: 32	PLOT DATE: MARCH 8, 2000
DRAWN BY: C.R.N.	CADD FILE: SHT4.3.DGN		FILE NO. H-4-44776
CHECKED BY: P.J.H.	SOLICITATION NO. DACW29-00-B-0094		DWG. 43 OF 59


Safety is a Part of Your Contract

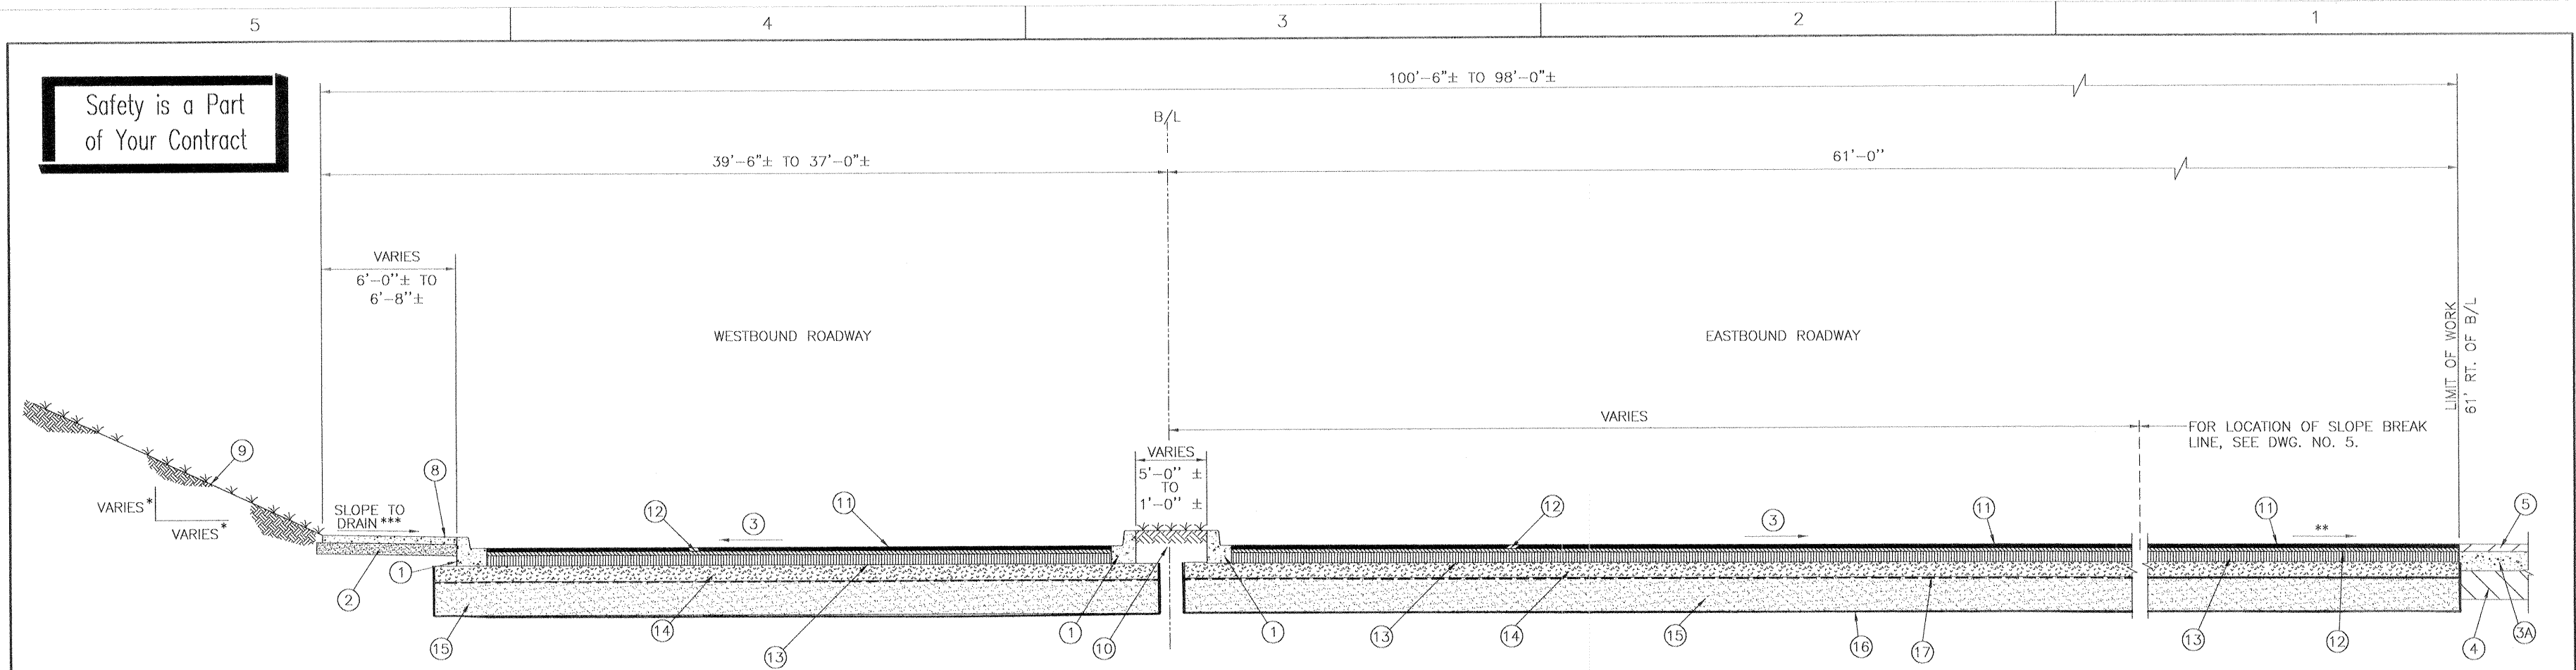

ROBERT E. LEE BOULEVARD
STA. 104+99± TO 105+20±
TYPICAL ROADWAY SECTION
SCALE: 1" = 3'- 0"


- ① REQ'D INTEGRAL BARRIER CURB AND GUTTER
- ② REQ'D 6" COMPACTED SAND
- ③ SLOPE VARIES
- ③A EXISTING CONCRETE ROADWAY (THICKNESS VARIES)
- ④ EXISTING PAVEMENT BASE (THICKNESS VARIES)
- ⑤ EXISTING PAVEMENT SURFACE COURSE (THICKNESS VARIES)
- ⑦ REQ'D GRADING TO TOP OF CURB
- ⑧ REQ'D 4" SIDEWALK (SLOPE TO DRAIN)
- ⑨ REQ'D GRADING TO MEET LEVEE SLOPES
- ⑩ GRASSED MEDIAN
- ⑪ REQ'D 2" TYPE 8F WEARING COURSE
- ⑫ REQ'D 2" TYPE 8 BINDER COURSE
- ⑬ REQ'D 5 1/2" TYPE 5A BASE COURSE
- ⑭ REQ'D 8 1/2" CRUSHED STONE BASE
- ⑮ REQ'D 18" SAND SUBBASE
- ⑯ REQ'D GEOTEXTILE FABRIC
- ⑰ REQ'D GEOTEXTILE FABRIC AND GEOGRID FABRIC

REFERENCE DRAWINGS
FOR GENERAL NOTES, SEE DWG. NO. 3
FOR PLAN/PROFILE, SEE DWG. NO. 5
FOR DEMOLITION PLAN, SEE DWG. NO. 9
FOR ROADWAY ELEVATIONS, SEE DWG. NO. 39.
FOR TYPICAL ROADWAY AND SIDEWALK DETAILS SEE DWG. NO. 45.
FOR ROADWAY CROSS-SECTIONS, SEE DWG. NO. 47, 48 AND 49.

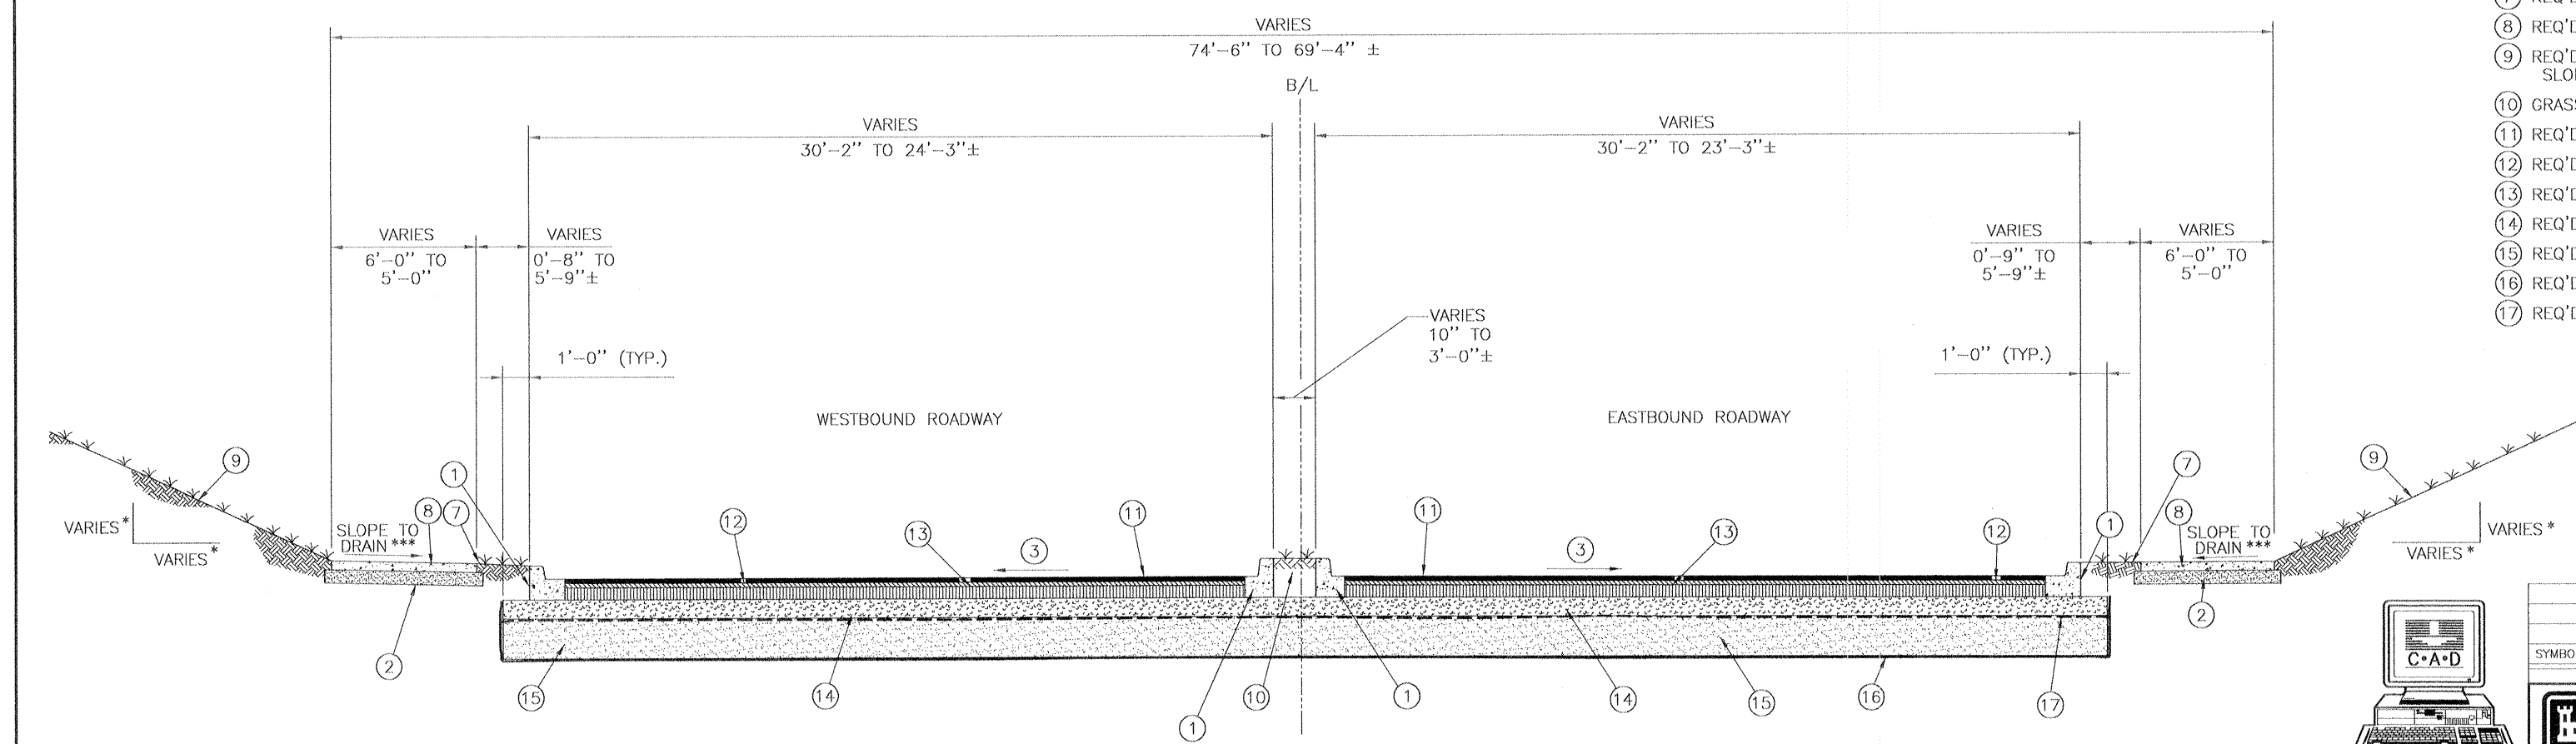

ROBERT E. LEE BOULEVARD
STA. 107+02 TO STA. 107+62
TYPICAL ROADWAY SECTION
SCALE: 1" = 3'- 0"

- * SLOPE SHALL MATCH EXISTING TO LEVEE CROWN (SEE ROADWAY CROSS-SECTIONS)
- ** SLOPE TO MEET EXISTING GRADE @ LIMIT OF WORK
- *** 1/4" PER FT. MINIMUM

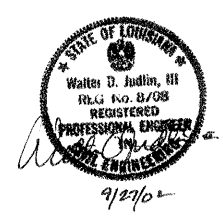


DACW29-00-B-0094
AS BUILT PLANS
DATE RECEIVED 3/15/02
DATE TRACINGS CORRECTED 4/18/02




SYMBOL	DESCRIPTION	DATE	APPROVED
REVISIONS			
U.S. ARMY ENGINEER DISTRICT, NEW ORLEANS CORPS OF ENGINEERS NEW ORLEANS, LOUISIANA			
BOARD OF LEVEE COMMISSIONERS ORLEANS LEVEE BOARD NEW ORLEANS, LOUISIANA		HARTMAN ENGINEERING, INC. CONSULTING ENGINEERS KENNER, LOUISIANA	
LAKE PONTCHARTRAIN, LA. AND VICINITY HIGH LEVEL PLAN ORLEANS AVENUE OUTFALL CANAL PHASE 1B ORLEANS PARISH LOUISIANA			
ROBERT E. LEE BOULEVARD BRIDGE TYPICAL ROADWAY SECTIONS			
DESIGNED BY: M.K.R.	DATE: MAR. 8, 2000	PLOT SCALE: 36	PLOT DATE: MARCH 8, 2000
DRAWN BY: C.R.N.	CARD FILE: SHT44.DGN	FILE NO. H-4-44776	
CHECKED BY: W.D.L.	SUBMITTED BY: HARTMAN ENGINEERING DESIGN ENGINEER		
SOLICITATION NO. DACW29-00-B-0094		DWG. 44 OF 59	


File: D:\SHT44.DGN Date: 08/26/02 8:51:10 AM Sheet: 13 of 13

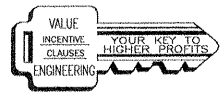


Safety is a Part of Your Contract

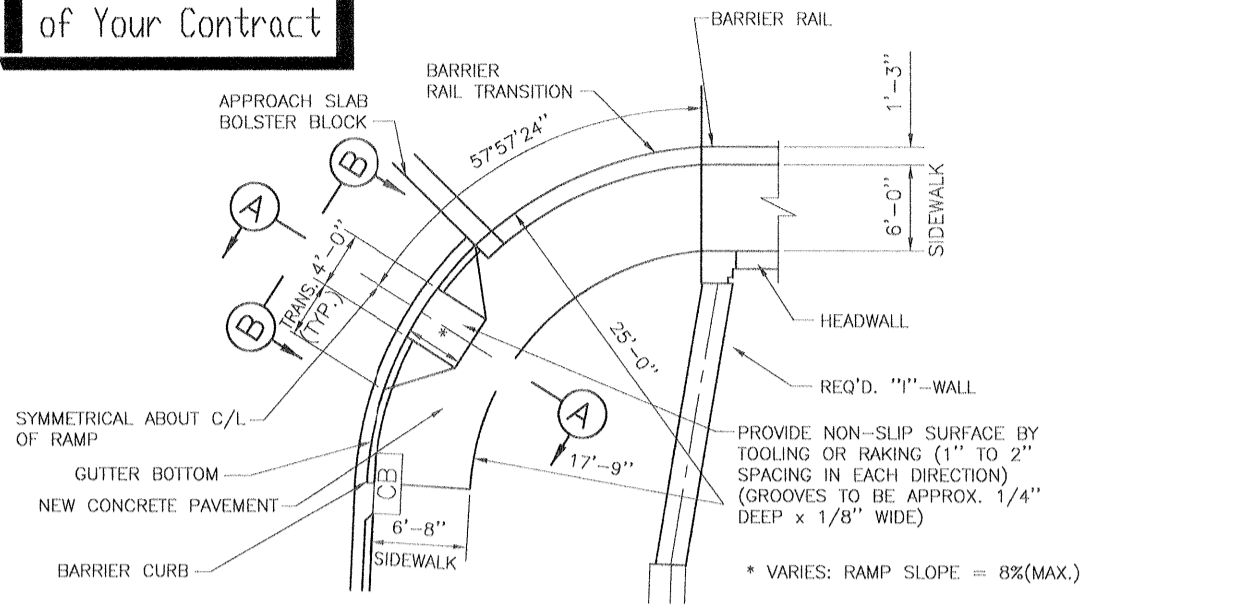

**EAST CONCRETE HANDICAPPED RAMP
TYPE "A"**
N.T.S.

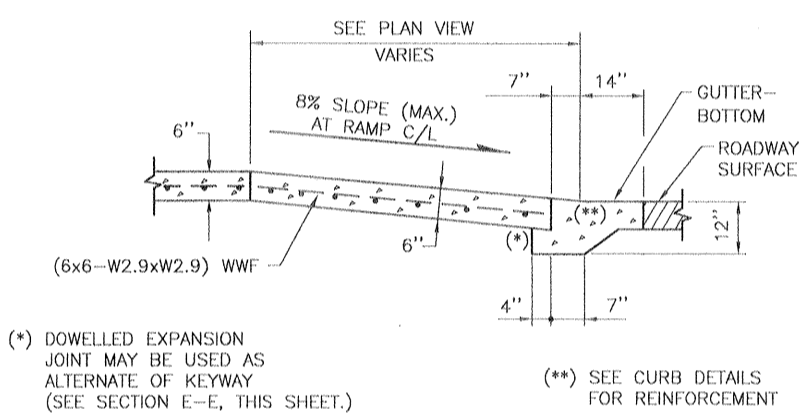


SECTION (A)
(TYPE "A" RAMP)
N.T.S.

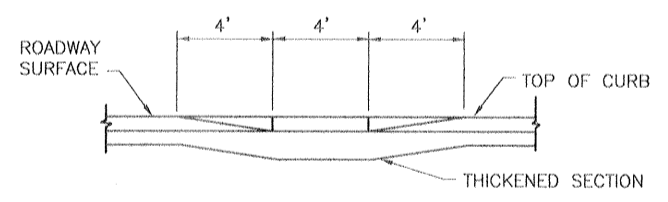


SECTION (B)
N.T.S.

HANDICAP RAMP NOTES:


- A. LOCATION**
1. STREET INTERSECTIONS AS SHOWN ON DRAWINGS.
- B. CONSTRUCTION**
1. THE SLOPE OF THE RAMP SHALL NOT EXCEED 8%.
 2. THE SLOPE OF THE SIDEWALK AND SIDEWALK TRANSITION SHALL NOT EXCEED 8%.
 3. THE WIDTH OF THE RAMP SHALL NOT BE LESS THAN 4' BUT MAY EXCEED THIS WHERE NECESSARY.

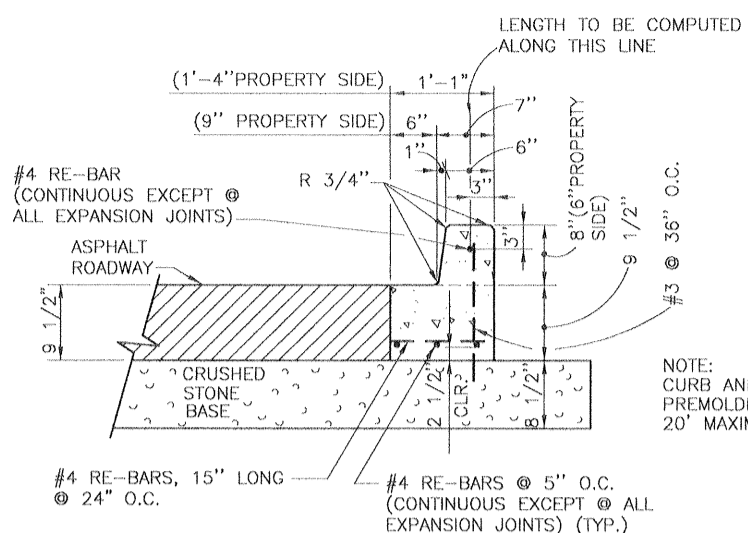


BARRIER CURB & GUTTERBOTTOM
SCALE: 1" = 1'-0"

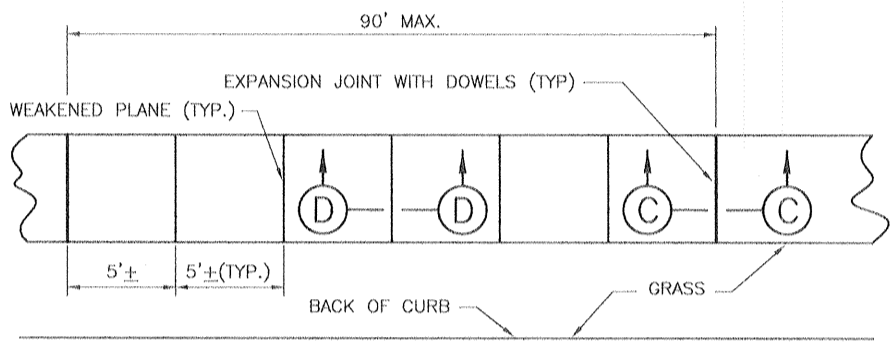


PLAN

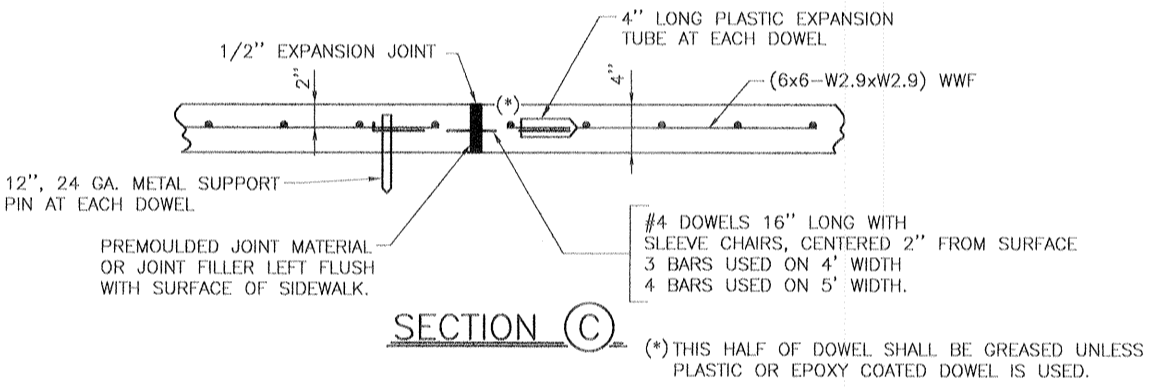

SECTION (C)

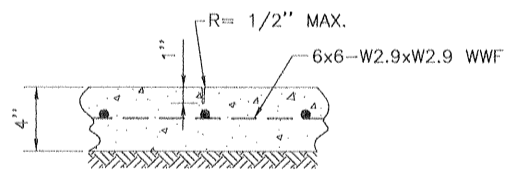


HAND-TOOLED CONTROL JOINT

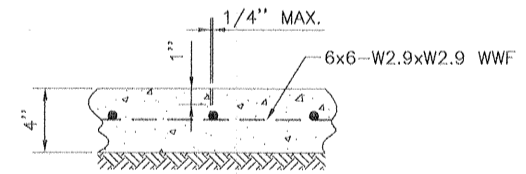


SAWED CONTROL JOINT

PORTLAND CEMENT CONCRETE SIDEWALK PAVEMENT
N.T.S.

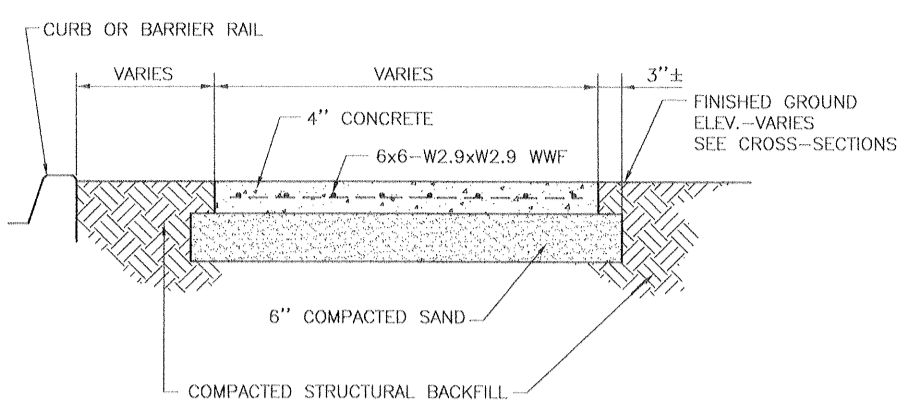


TYPICAL SIDEWALK SECTION
N.T.S.

- NOTES:**
1. REQUIRED WALKS TO BE CONSTRUCTED TO GRADES AS SHOWN ON "ROADWAY ELEVATIONS" SHEET.


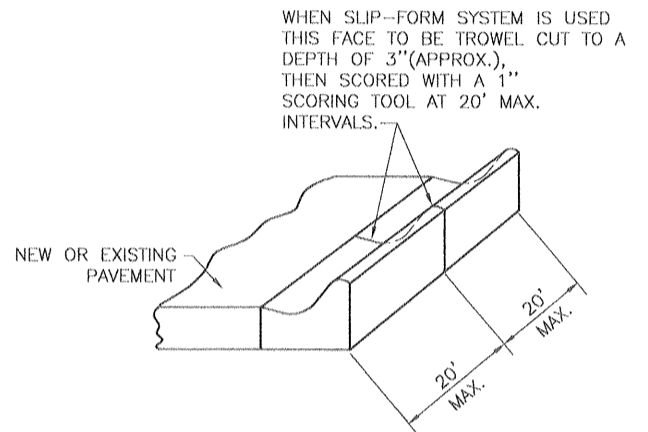


DETAIL SHOWING JOINTS IN CONCRETE CURB AND GUTTER
N.T.S.

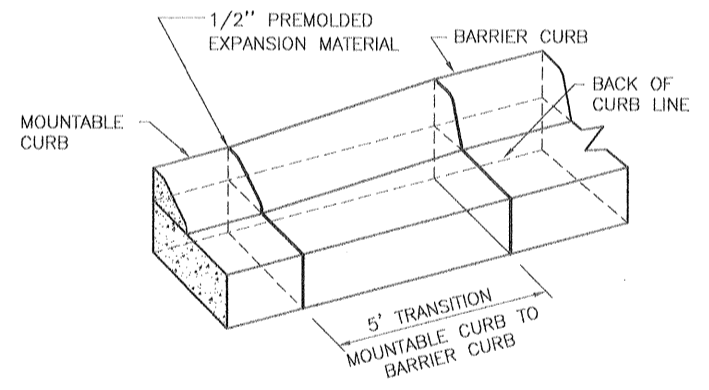

MOUNTABLE-BARRIER CURB TRANSITION
N.T.S.

File: D:\S\145.DWG User: lart Date: 02/26/02 11:11:22 AM Scale: 1:1 Plot: 11/11/02

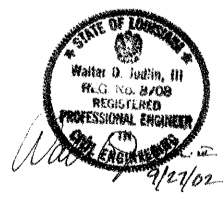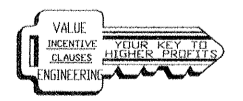


DATE RECEIVED 3/15/02
DATE TRACINGS CORRECTED 4/18/02

AS BUILT PLANS

DACW29-00-B-0094

SYMBOL	DESCRIPTION	DATE	APPROVED
REVISIONS			
U.S. ARMY ENGINEER DISTRICT, NEW ORLEANS CORPS OF ENGINEERS NEW ORLEANS, LOUISIANA			
BOARD OF LEVEE COMMISSIONERS ORLEANS LEVEE BOARD NEW ORLEANS, LOUISIANA		HARTMAN ENGINEERING, INC. CONSULTING ENGINEERS KENNER, LOUISIANA	
LAKE PONTCHARTRAIN, LA. AND VICINITY HIGH LEVEL PLAN ORLEANS AVENUE OUTFALL CANAL PHASE 1B ORLEANS PARISH LOUISIANA			
ROBERT E. LEE BOULEVARD BRIDGE TYP. ROADWAY AND SIDEWALK DETAILS			
DESIGNED BY: M.K.R.	DATE: MAR. 8, 2000	PLOT SCALE: 1	PLOT DATE: MARCH 8, 2000
DRAWN BY: L.A.C.	CADD FILE: SHT45.DGN	FILE NO. H-4-44776	
CHECKED BY: W.D.L.	SUBMITTED BY: HARTMAN ENGINEERING DESIGN ENGINEER	DACW29-00-B-0094	DWG. 45 OF 59

Safety is a Part of Your Contract

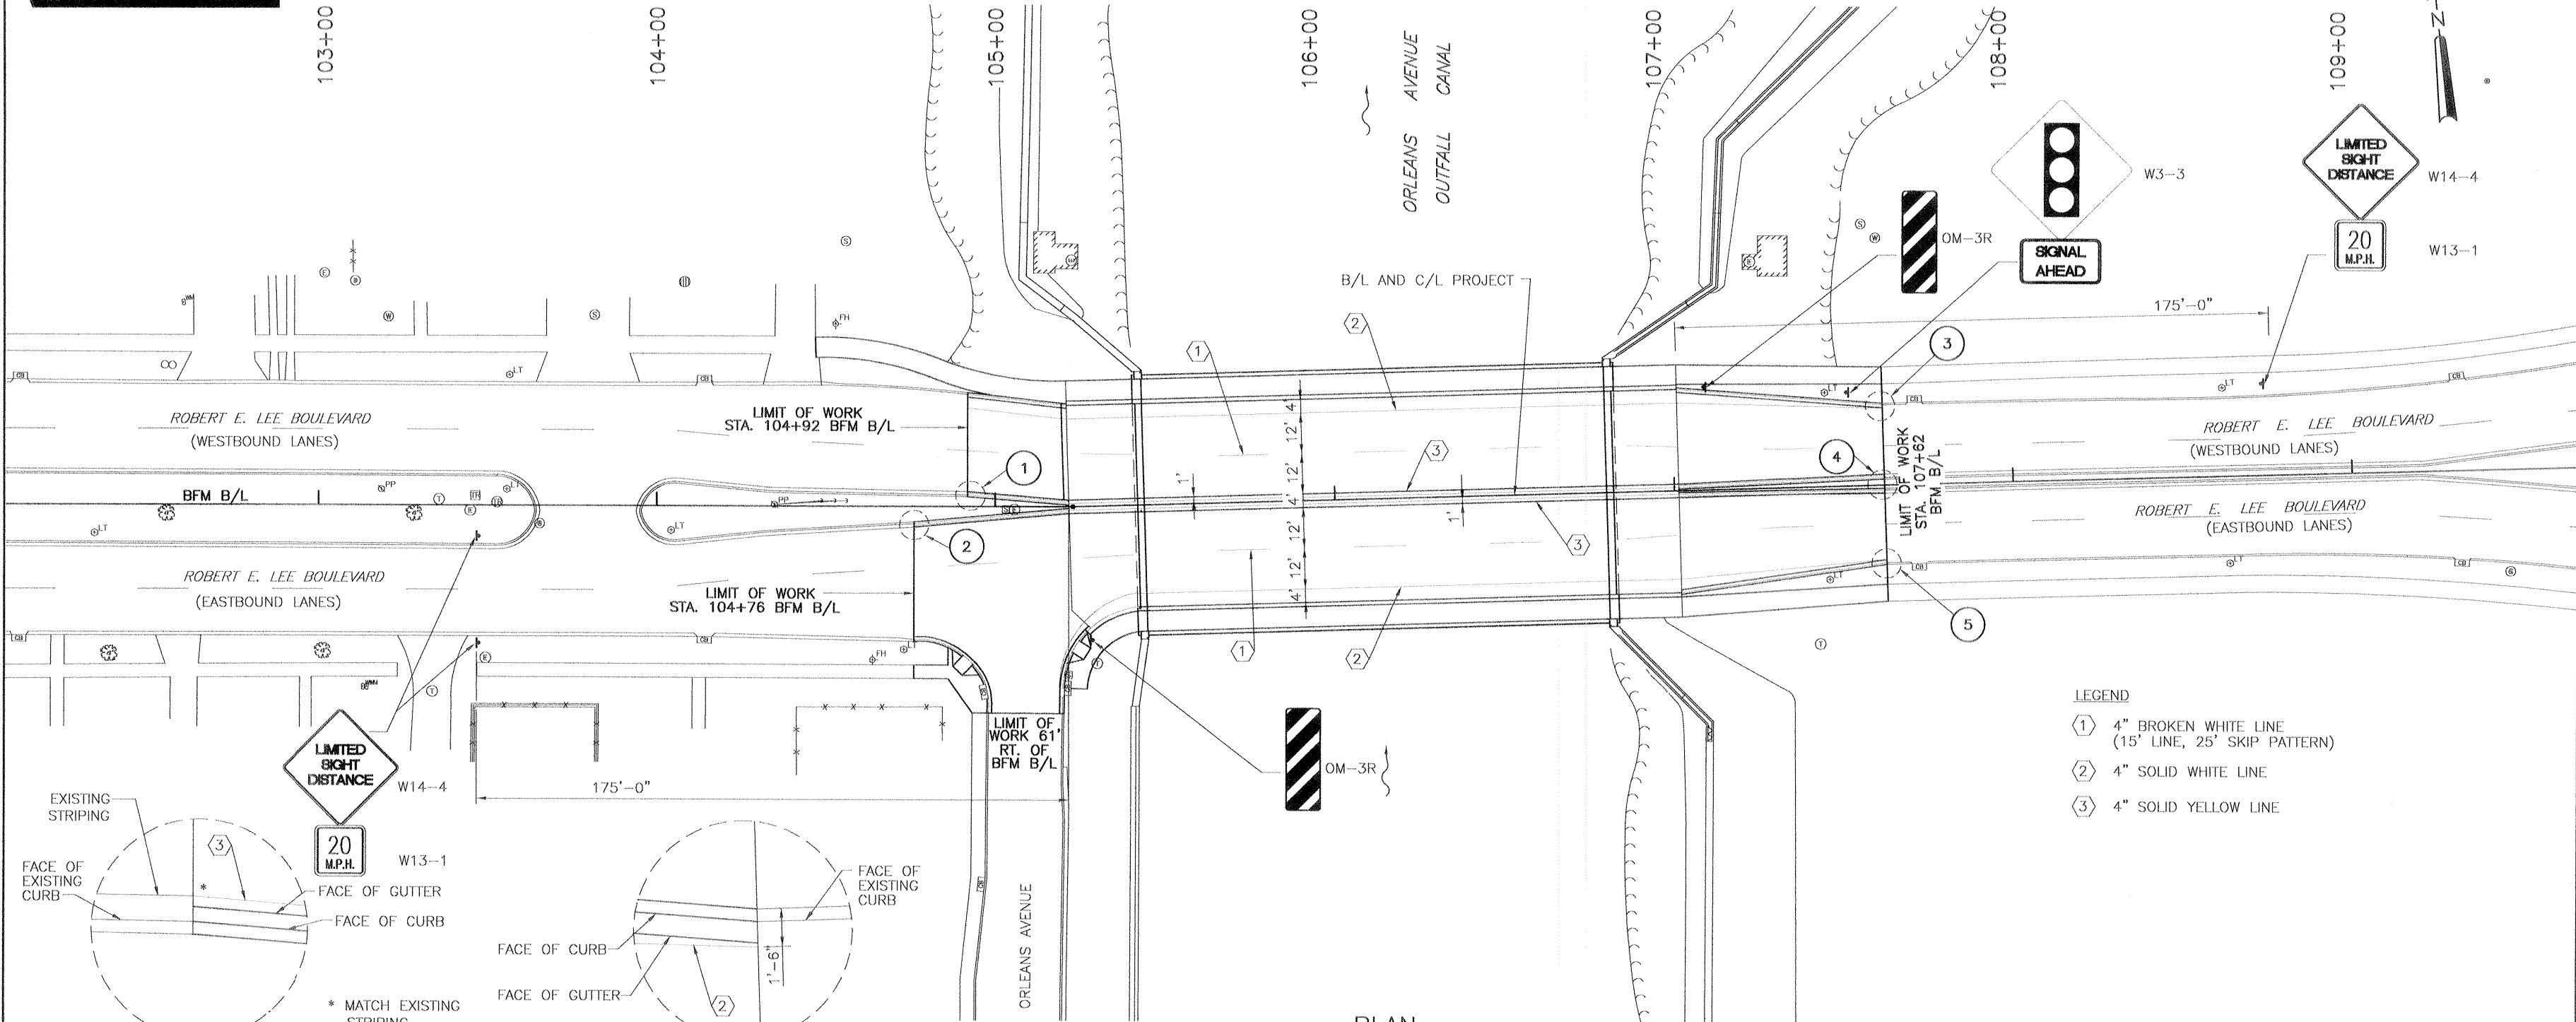


- LEGEND**
- ① 4" BROKEN WHITE LINE (15' LINE, 25' SKIP PATTERN)
 - ② 4" SOLID WHITE LINE
 - ③ 4" SOLID YELLOW LINE

PLAN




- NOTES:**
1. ALL PAVEMENT MARKINGS SHALL BE INSTALLED AS PER THE MANUAL ON UNIFORM TRAFFIC CONTROL DEVICES.
 2. ALL PAVEMENT MARKINGS SHALL BE PREFORMED PLASTIC OR HOT APPLIED THERMO PLASTIC.


DETAIL ①
SCALE: 3/8" = 1'-0"

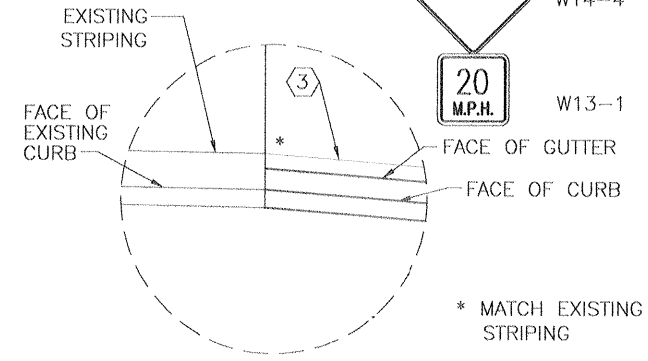


DETAIL ③
SCALE: 3/8" = 1'-0"

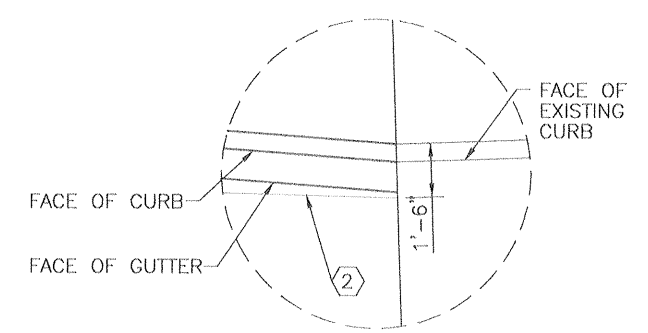


DETAIL ②
SCALE: 3/8" = 1'-0"

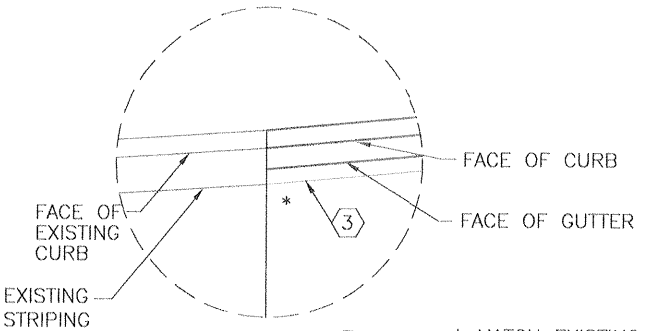

DETAIL ④
SCALE: 3/8" = 1'-0"

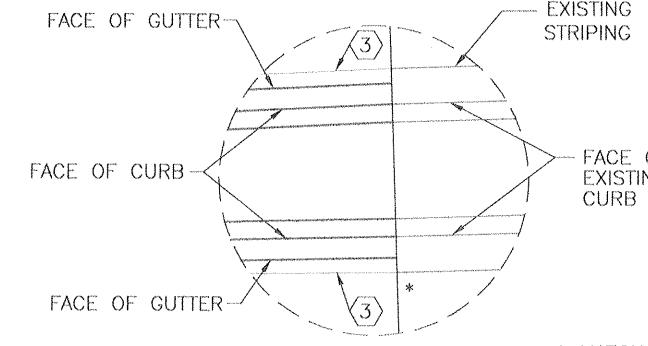


DETAIL ⑤
SCALE: 3/8" = 1'-0"

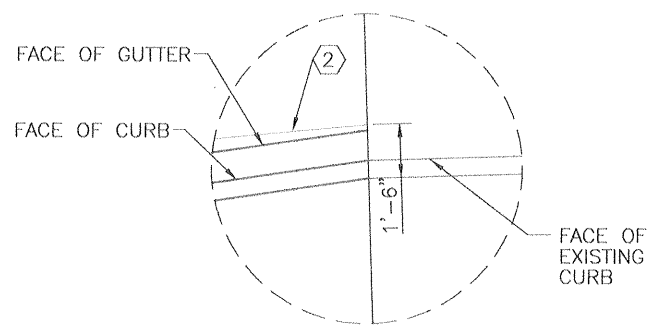

REFERENCE DRAWINGS
FOR GENERAL NOTES, SEE DWG. 3.
FOR PLAN/PROFILE, SEE DWG. 5.




AS BUILT PLANS
DATE RECEIVED 3/15/02
DATE TRACINGS CORRECTED 4/18/02






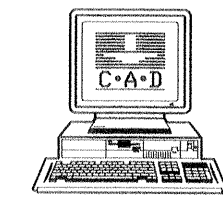


SYMBOL	DESCRIPTION	DATE	APPROVED
REVISIONS			
U.S. ARMY ENGINEER DISTRICT, NEW ORLEANS HIGH LEVEL PLAN CORPS OF ENGINEERS NEW ORLEANS, LOUISIANA			
BOARD OF LEVEE COMMISSIONERS ORLEANS LEVEE BOARD NEW ORLEANS, LOUISIANA		HARTMAN ENGINEERING, INC. CONSULTING ENGINEERS KENNER, LOUISIANA	
LAKE PONTCHARTRAIN, LA. AND VICINITY HIGH LEVEL PLAN ORLEANS AVENUE OUTFALL CANAL PHASE 1B ORLEANS PARISH LOUISIANA			
ROBERT E. LEE BOULEVARD BRIDGE PERMANENT PAVEMENT MARKINGS			
DESIGNED BY: M.K.R.	DATE: MAR. 8, 2000	PLOT SCALE: 20	PLOT DATE: MARCH 8, 2000
DRAWN BY: L.A.C.	CADD FILE: SHT46.DGN	FILE NO.	H-4-44776
CHECKED BY: W.D.L.	SUBMITTED BY:	SOLICITATION NO.	DWG. 46 OF 59
HARTMAN ENGINEERING DESIGN ENGINEER		DACW29-00-B-0094	

FILE: D:\SHT46.DWG (cont. sheet) AUG. 26, 02 @ 8:17 p.m. Scale: 1:20 R.L.C.

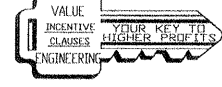

Safety is a Part of Your Contract

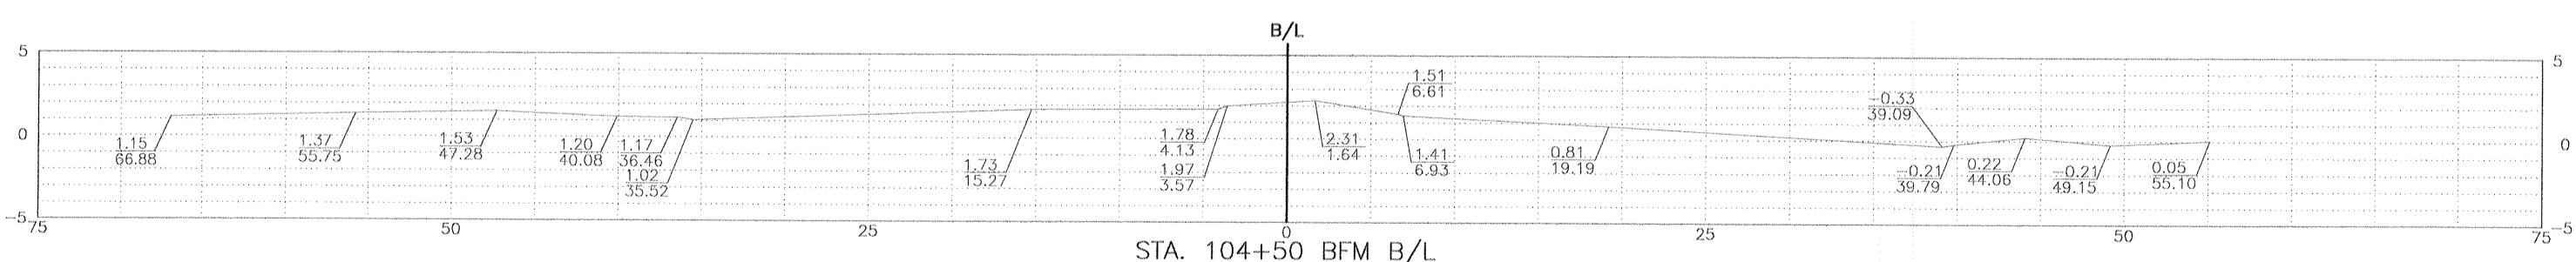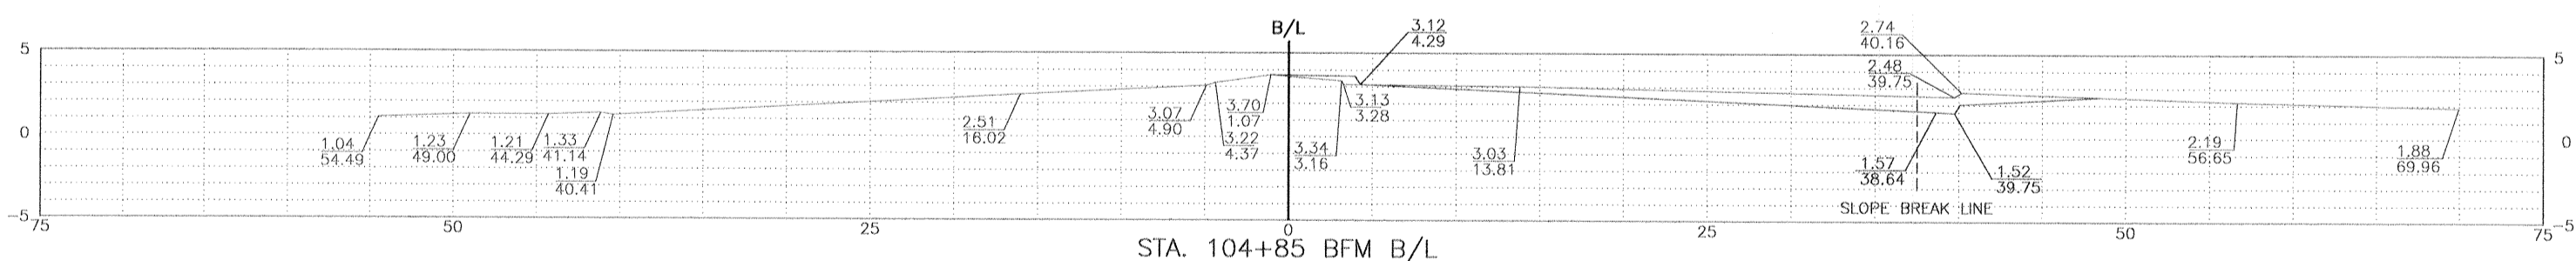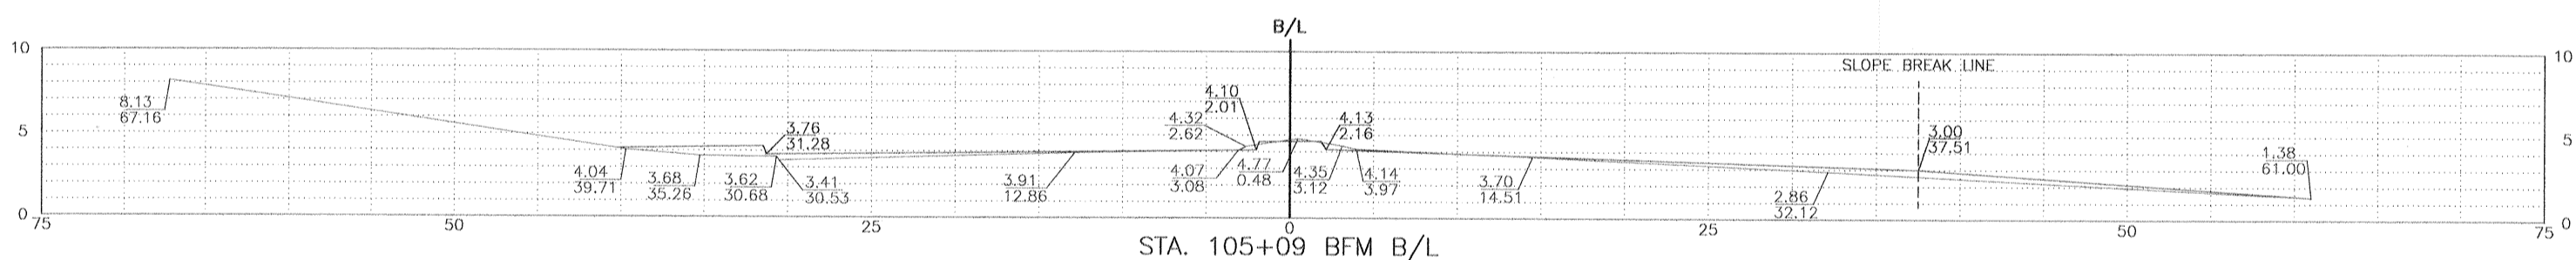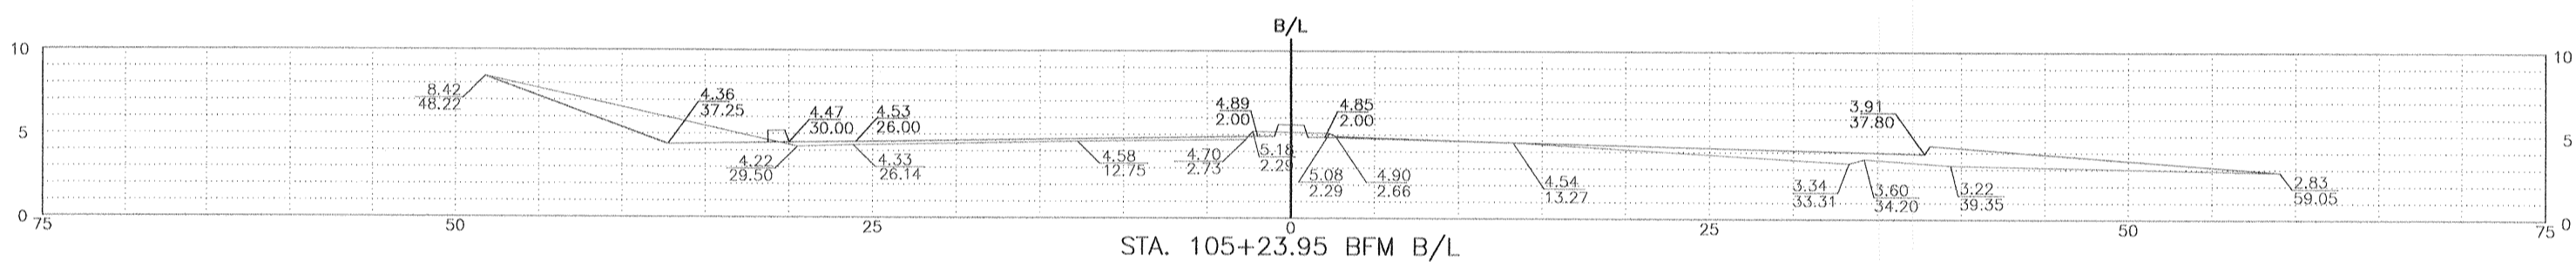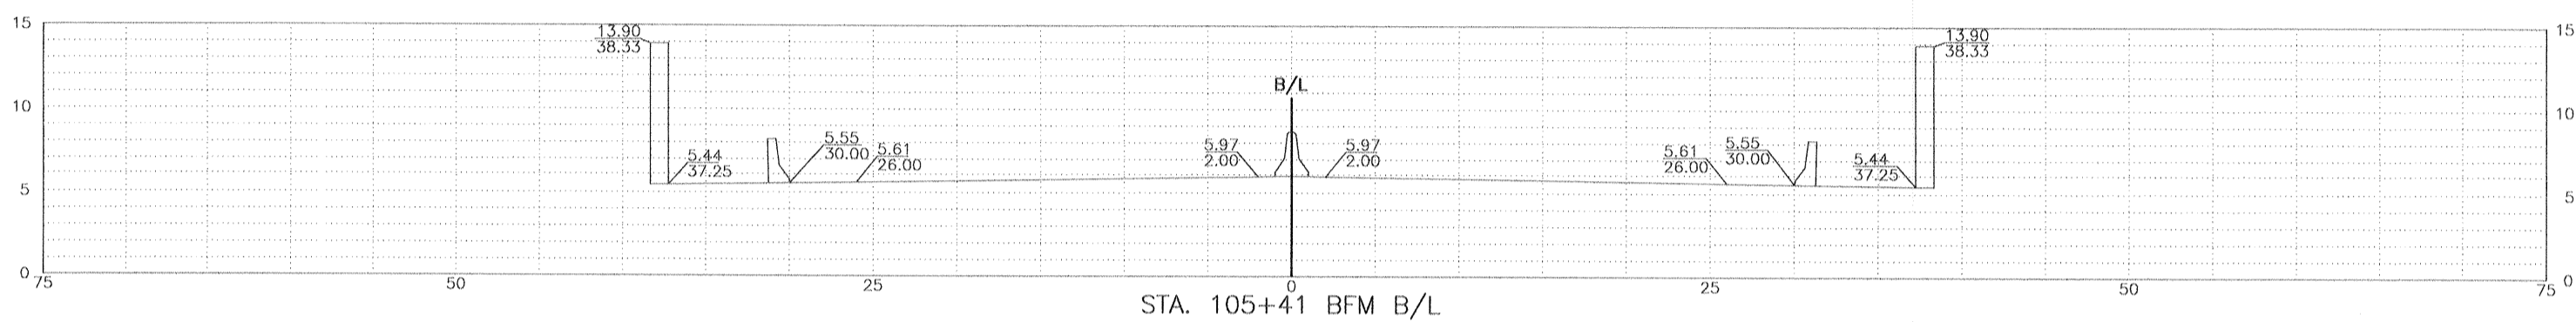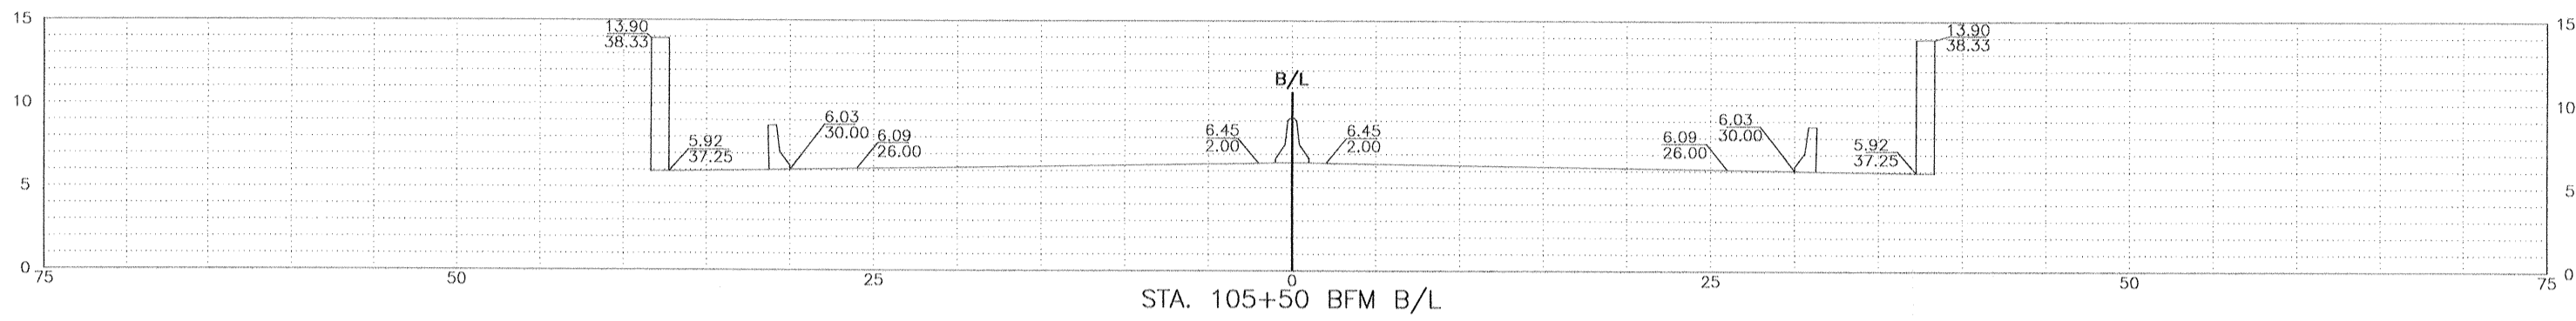

REFERENCE DRAWINGS
 FOR GENERAL NOTES, SEE DWG. NO. 3
 FOR PLAN/PROFILE, SEE DWG. NO. 5
 FOR ROADWAY ELEVATIONS, SEE DWG. NO. 39
 FOR TYPICAL ROADWAY SECTIONS, SEE DWG. NO. 44

SCALE: 1" = 5' (H)
 1" = 5' (V)

SYMBOL	DESCRIPTION	DATE	APPROVED

REVISIONS

--	--	--	--

U.S. ARMY ENGINEER DISTRICT, NEW ORLEANS
 CORPS OF ENGINEERS
 NEW ORLEANS, LOUISIANA



BOARD OF LEVEE COMMISSIONERS
 ORLEANS LEVEE BOARD
 NEW ORLEANS, LOUISIANA

HARTMAN ENGINEERING, INC.
 CONSULTING ENGINEERS
 KENNER, LOUISIANA

LAKE PONTCHARTRAIN, LA. AND VICINITY
 HIGH LEVEL PLAN
 ORLEANS AVENUE OUTFALL CANAL
 PHASE 1B
 ORLEANS PARISH
 LOUISIANA

ROBERT E. LEE BOULEVARD BRIDGE
 ROADWAY CROSS SECTIONS

DESIGNED BY: M.K.R.	DATE: MAR. 8, 2000	PLOT SCALE: 5	PLOT DATE: MARCH 8, 2000
DRAWN BY: L.A.C.	CHECKED BY: W.D.L.	CADD FILE: SHT47.DGN	FILE NO. H-4-44776
SUBMITTED BY: HARTMAN ENGINEERING	SOLICITATION NO. DACW29-00-B-0094	DWG. 47 OF 59	

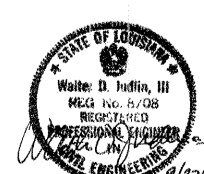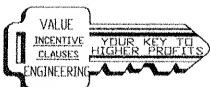


DACW29-00-B-0094
AS BUILT PLANS
 DATE RECEIVED 3/15/02
 DATE TRACINGS CORRECTED 4/18/02




FILE: D:\SHT47.DWG LAST MODIFIED: AUG. 26, 02 @ 5:19 P.M. SCALE: 1:5 B.L.C.


Safety is a Part
of Your Contract

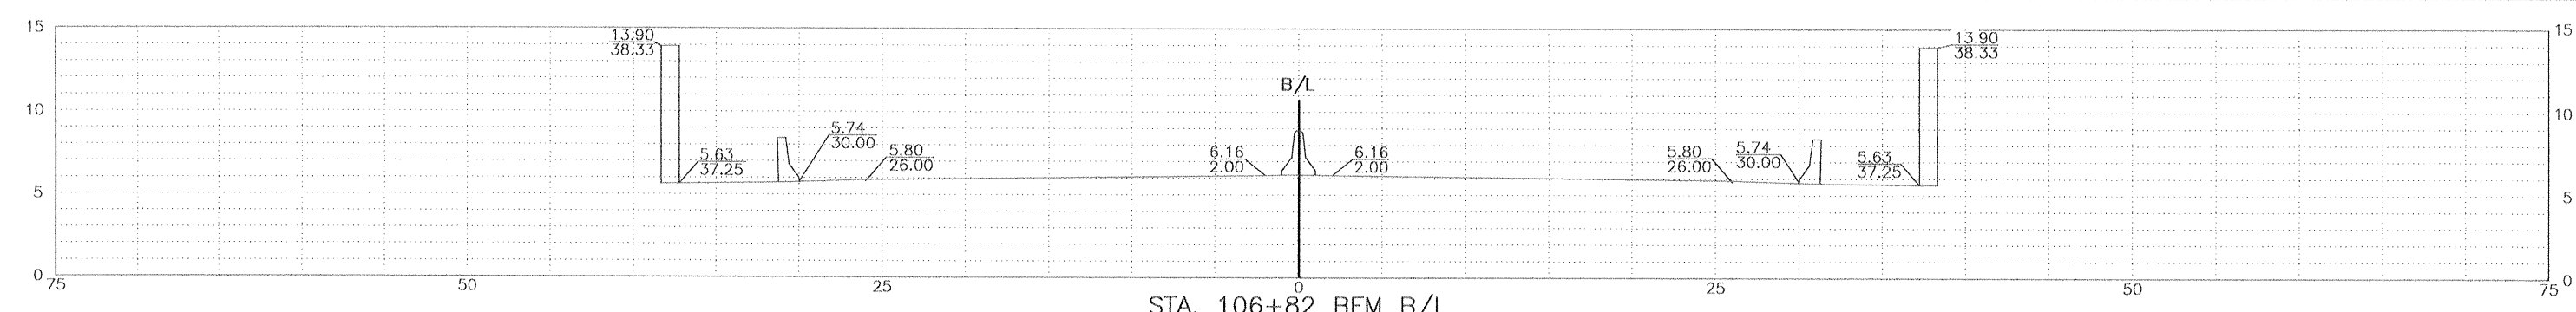


STA. 106+82 BFM B/L

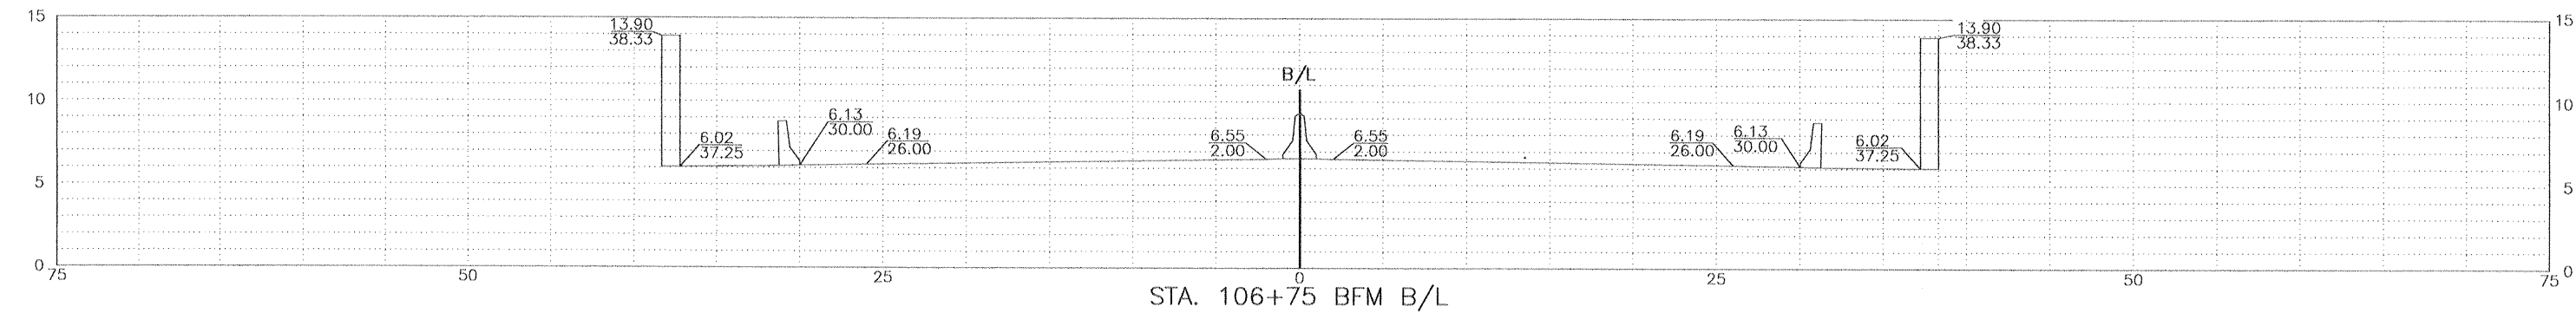


STA. 106+75 BFM B/L

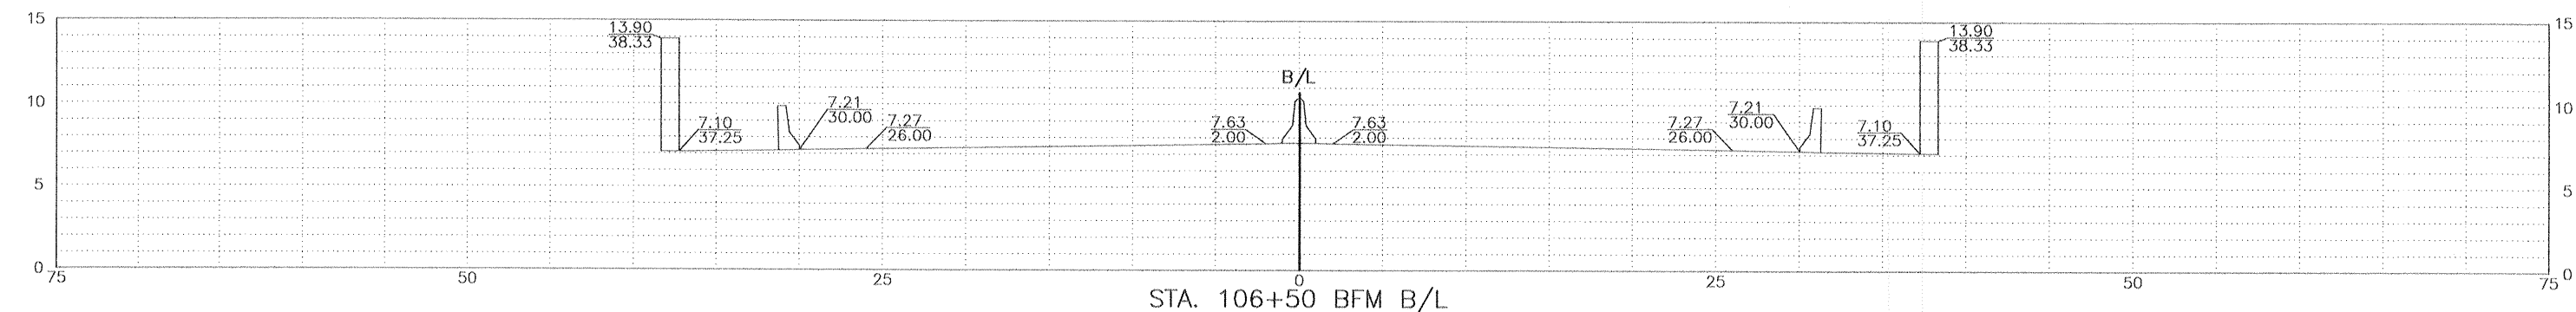


STA. 106+50 BFM B/L

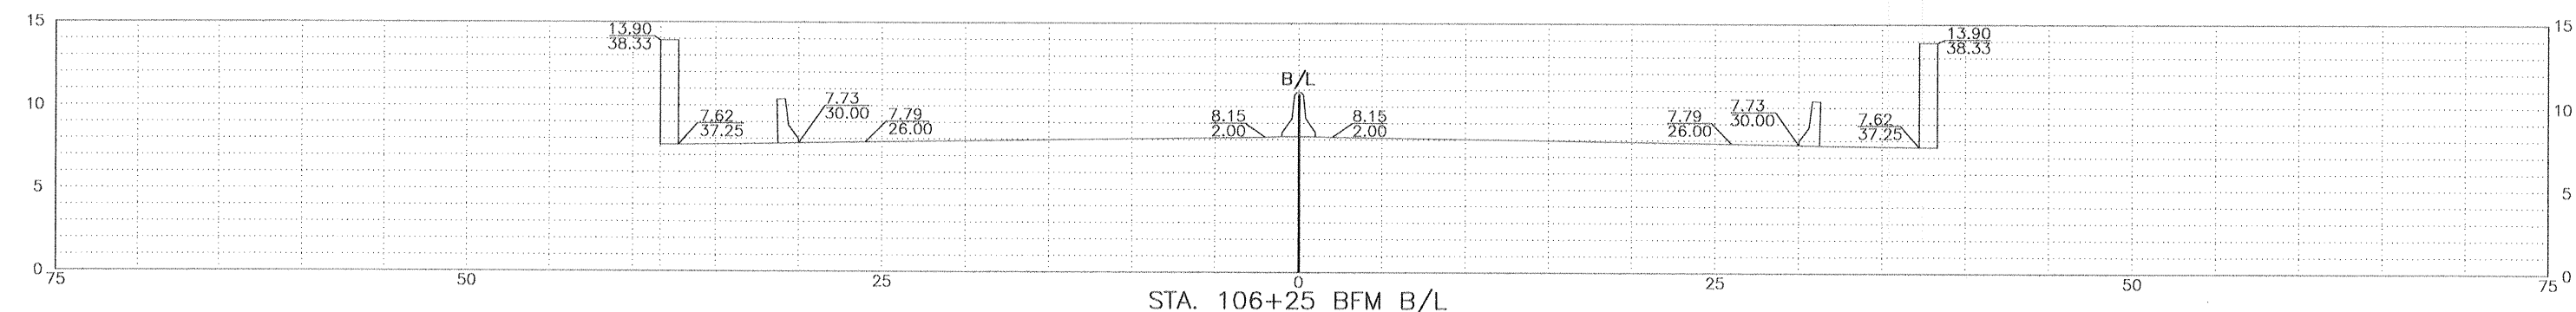

STA. 106+25 BFM B/L

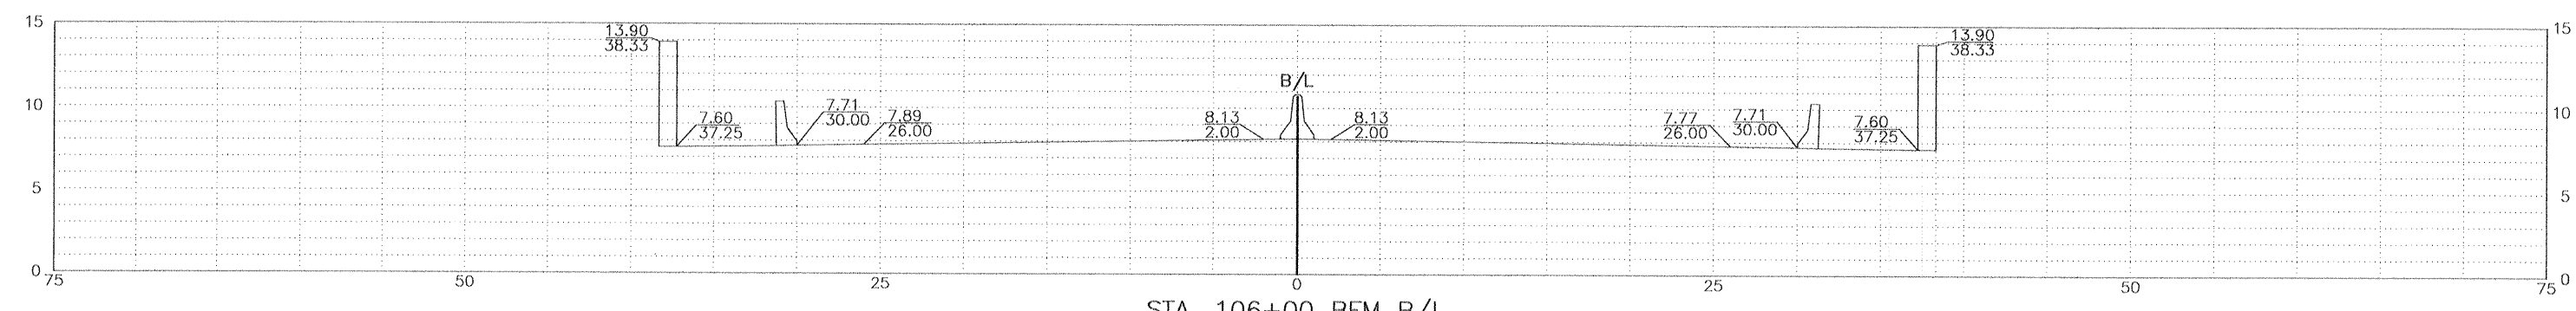

STA. 106+00 BFM B/L

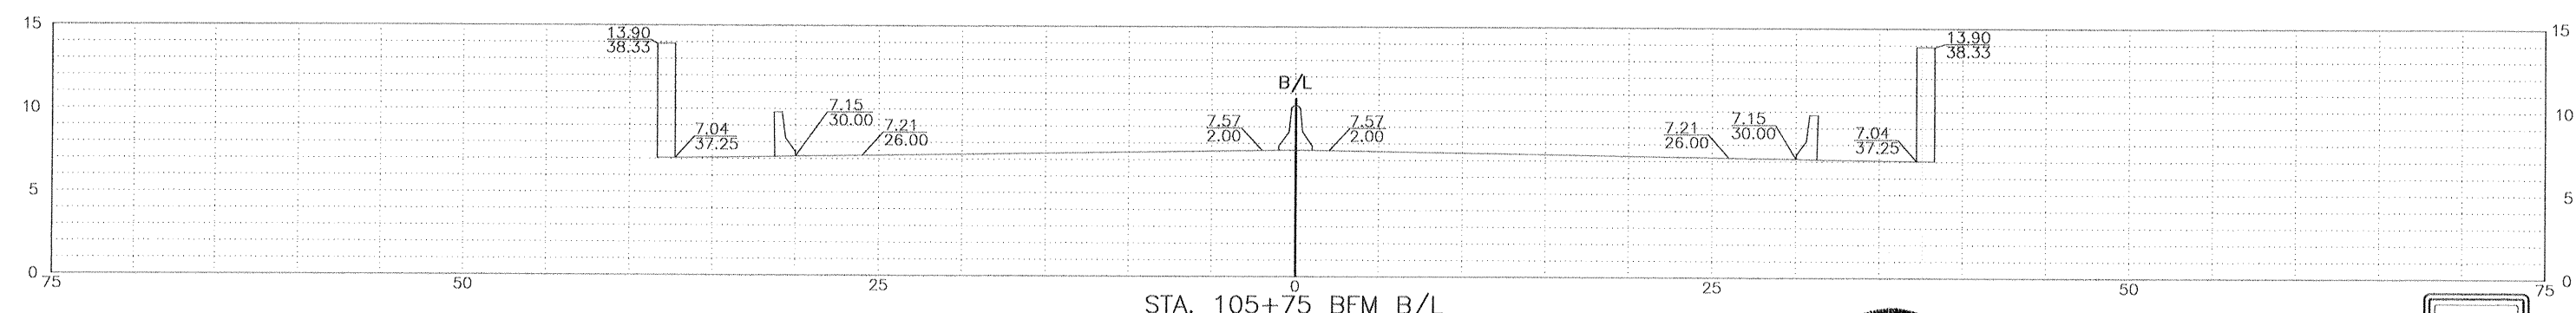

STA. 105+75 BFM B/L

REFERENCE DRAWINGS
FOR GENERAL NOTES, SEE DWG. NO. 3.
FOR PLAN/PROFILE, SEE DWG. NO. 5.
FOR ROADWAY ELEVATIONS, SEE DWG. NO. 39.
FOR TYPICAL ROADWAY SECTIONS, SEE DWG. NO. 44.

SCALE: 1" = 5' (H)
1" = 5' (V)

SYMBOL	DESCRIPTION	DATE	APPROVED
REVISIONS			

U.S. ARMY ENGINEER DISTRICT, NEW ORLEANS
CORPS OF ENGINEERS
NEW ORLEANS, LOUISIANA

BOARD OF LEVEE COMMISSIONERS
ORLEANS LEVEE BOARD
NEW ORLEANS, LOUISIANA

HARTMAN ENGINEERING, INC.
CONSULTING ENGINEERS
KENNER, LOUISIANA




LAKE PONTCHARTRAIN, LA. AND VICINITY
HIGH LEVEL PLAN
ORLEANS AVENUE OUTFALL CANAL
PHASE 1B
ORLEANS PARISH
LOUISIANA

ROBERT E. LEE BOULEVARD BRIDGE
ROADWAY CROSS SECTIONS

DESIGNED BY: M.K.R.	DATE: MAR. 8, 2000	PLOT SCALE: 5	PLOT DATE: MARCH 8, 2000
DRAWN BY: L.A.C.	CHECKED BY: W.D.L.	CADD FILE: SHT48.DGN	FILE NO. H-4-44776
SUBMITTED BY: HARTMAN ENGINEERING	DESIGN ENGINEER	SOLICITATION NO. DACW29-00-B-0094	DWG. 48 OF 59





DACW29-00-B-0094

AS BUILT PLANS
DATE RECEIVED 3/15/02
DATE TRACINGS CORRECTED 4/16/02

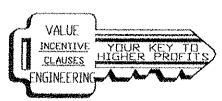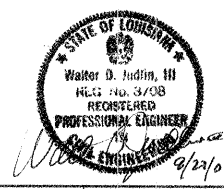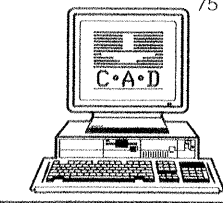


File: D:\SHT48.DWG Date: 02/28/02 1:15 P.M. Scale: 1:5 B.L.C.

Safety is a Part of Your Contract

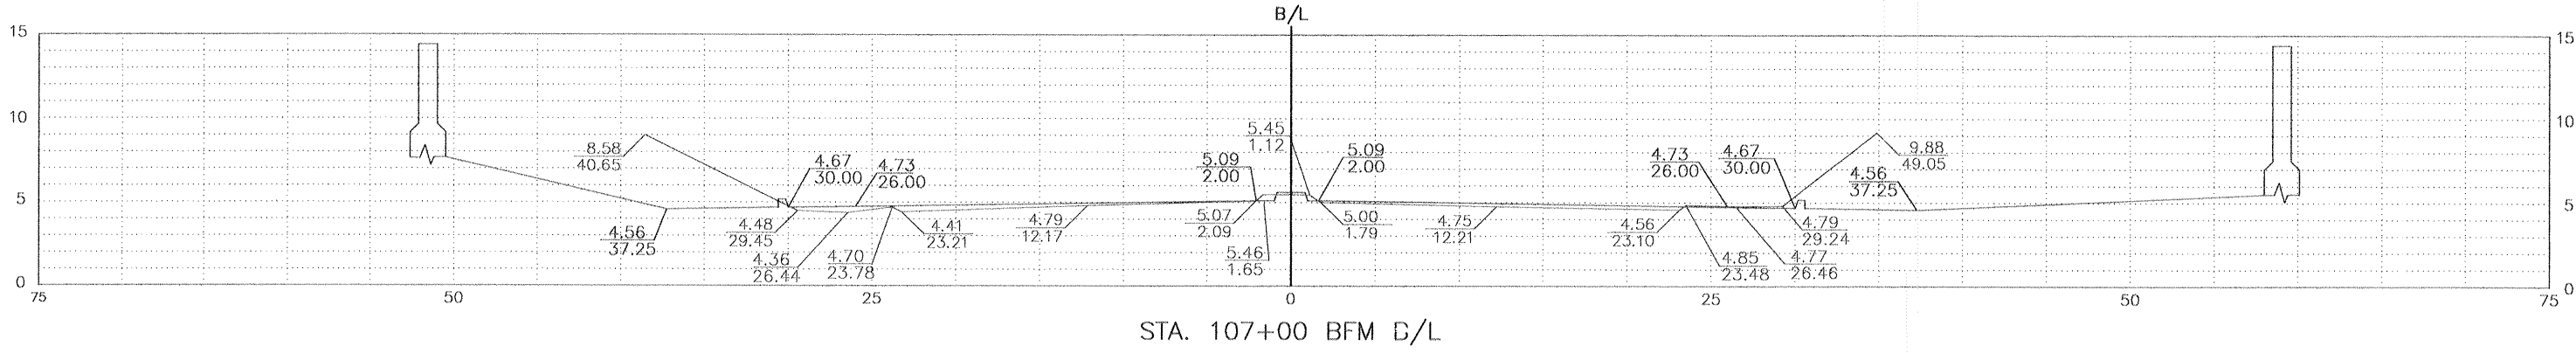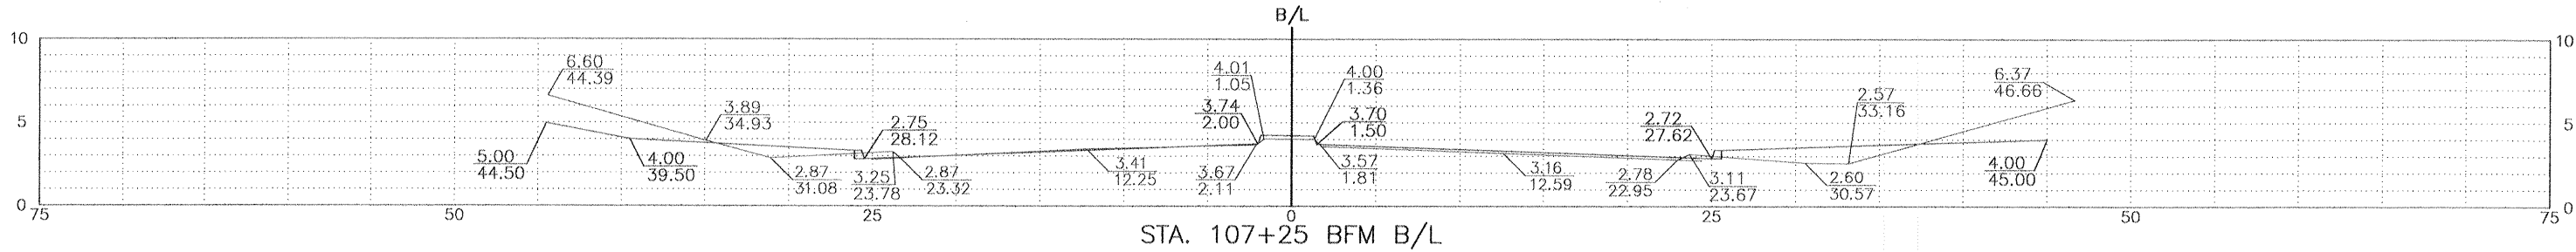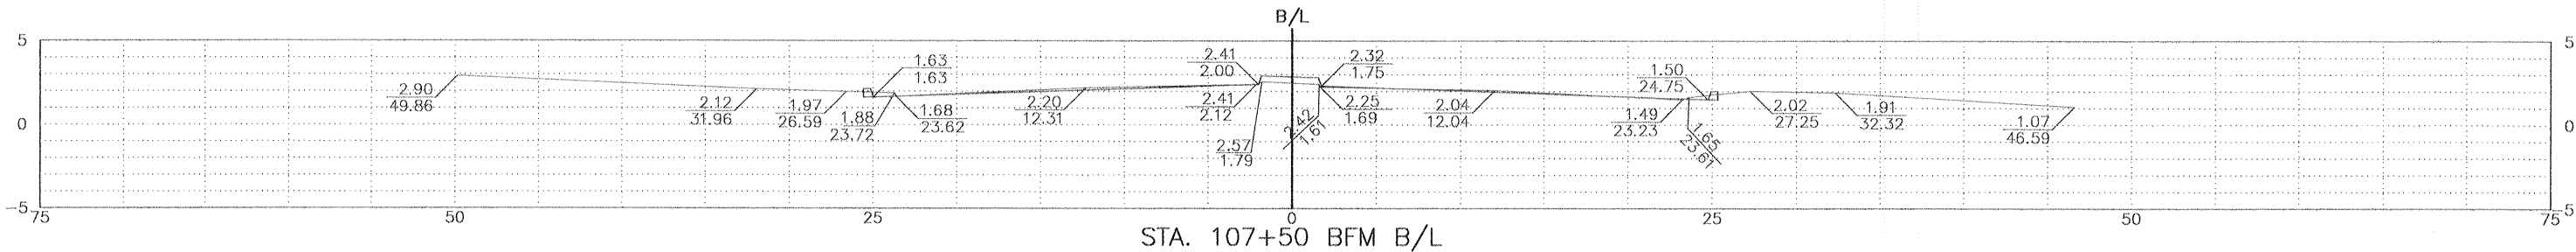
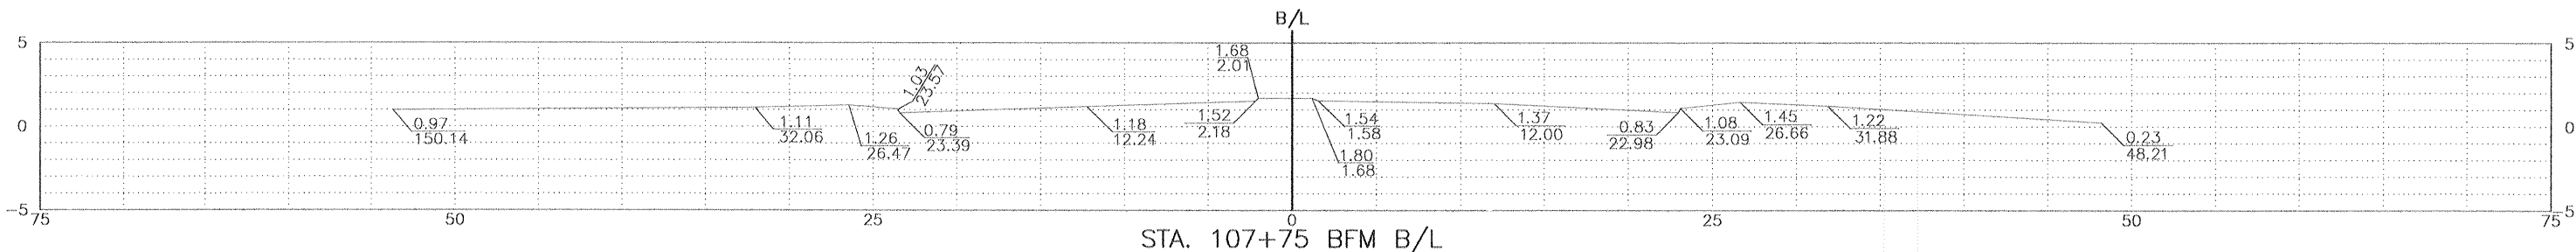


REFERENCE DRAWINGS
 FOR GENERAL NOTES, SEE DWG. NO. 3.
 FOR PLAN/PROFILE, SEE DWG. NO. 5.
 FOR ROADWAY ELEVATIONS, SEE DWG. NO. 39.
 FOR TYPICAL ROADWAY SECTIONS, SEE DWG. NO. 44.


SCALE: 1" = 5' (H)
 1" = 5' (V)

SYMBOL	DESCRIPTION	DATE	APPROVED
REVISIONS			
 U.S. ARMY ENGINEER DISTRICT, NEW ORLEANS CORPS OF ENGINEERS NEW ORLEANS, LOUISIANA			
BOARD OF LEVEE COMMISSIONERS ORLEANS LEVEE BOARD NEW ORLEANS, LOUISIANA		HARTMAN ENGINEERING, INC. CONSULTING ENGINEERS KENNER, LOUISIANA	
LAKE PONTCHARTRAIN, I.A. AND VICINITY HIGH LEVEL PLAN ORLEANS AVENUE OUTFALL CANAL PHASE 1B ORLEANS PARISH LOUISIANA ROBERT E. LEE BOULEVARD BRIDGE ROADWAY CROSS SECTIONS			
DESIGNED BY: M.K.R.	DATE: MAR. 8, 2000	PLOT SCALE: 5	PLOT DATE: MARCH 8, 2000
DRAWN BY: L.A.C.	CADD FILE: SHT149.DGN	CHECKED BY: W.D.L.	FILE NO. H-4-44776
SUBMITTED BY: HARTMAN ENGINEERING DESIGN ENGINEER		SOLICITATION NO. DACW29-00-B-0094 DWG. 49 OF 59	

File: D:\SHT149.DWG Last edited: AUG. 28, 2002 @ 4:58 p.m. Scale: 1"=5'

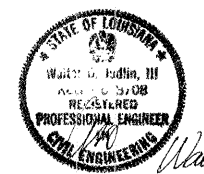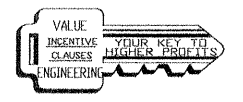

DACW29-00-B-0094
AS BUILT PLANS
 DATE RECEIVED 3/15/02
 DATE TRACINGS CORRECTED 4/18/02

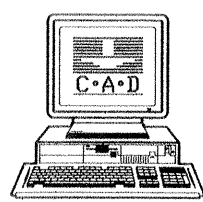

Safety is a Part of Your Contract

SUMMARY OF BORINGS

BORING NO. 35
USACE E B/L STA. 87+34, 4.5' RT.
GROUND ELEVATION +9.16 NGVD*

BORING NO. 36
USACE W B/L STA. 87+26, 25' LT.
GROUND ELEVATION -5.20 NGVD

DEPTH FEET	SAMPLE NO.	SAMPLE DEPTH - FEET		DEPTH STRATUM FEET		VISUAL CLASSIFICATION	STANDARD PENETRATION TEST	
		FROM	TO	FROM	TO			
0	1	0.0	0.5	0.0	3.0	STIFF TAN & GRAY CLAY W/GRASS ROOTS		
	2	1.7	2.5			STIFF TAN & GRAY CLAY W/CLAYEY SILT POCKETS		
	3	4.7	5.5	3.0		STIFF GRAY CLAY W/CLAYEY SILT POCKETS & SILTY SAND LAYERS		
	4	7.7	8.5			STIFF GRAY CLAY W/CLAYEY SILT POCKETS		
10	5	10.7	11.5		12.0	STIFF GRAY CLAY W/CLAYEY SILT POCKETS		
	6	13.7	14.5	12.0	15.0	SOFT DARK GRAY CLAY W/HUMUS POCKETS & ORGANIC MATTER		
	7	18.2	19.0	15.0	19.0	SOFT DARK GRAY SILTY CLAY W/CLAYEY SILT POCKETS		
20	8	23.2	24.0	19.0	24.0	SOFT BROWN & GRAY ORGANIC CLAY W/HUMUS LAYERS & FEW ROOTS		
	9	28.2	29.0	24.0	29.0	VERY LOOSE GRAY CLAYEY SILT		
30	10	33.2	34.0	29.0		SOFT TO MEDIUM STIFF GRAY CLAY W/FEW CLAYEY SILTY LENSES & SHELLS		
	11	38.2	39.0		41.0	SOFT TO MEDIUM STIFF GRAY CLAY W/FEW SILTY SAND POCKETS		
40	12	43.2	44.0	41.0	44.0	VERY LOOSE TO LOOSE GRAY CLAYEY SAND W/CLAY POCKETS & SHELL FRAGMENTS		
	13	45.0	46.5	44.0		MEDIUM DENSE GRAY FINE SAND W/SHELL FRAGMENTS	5	18
50	14	48.5	50.0		50.0	MEDIUM DENSE GRAY FINE SAND W/SHELL FRAGMENTS	5	13

DEPTH FEET	SAMPLE NO.	SAMPLE DEPTH - FEET		DEPTH STRATUM FEET		VISUAL CLASSIFICATION	STANDARD PENETRATION TEST	
		FROM	TO	FROM	TO			
0				0.0	3.0	ASPHALT, CONCRETE, FILL(SAND & SHELLS) & MISCELLANEOUS FILL		
	1	5.0	6.0	3.0	7.0	EXTREMELY SOFT BLACK & BROWN HUMUS W/WOOD & ROOTS		
		8.0	9.0	7.0	9.0	WOOD W/HUMUS & CLAY		
10	2	11.0	12.0	9.0	13.0	LOOSE GRAY CLAYEY SILT W/ORGANIC MATTER		
	3	14.0	15.0	13.0		VERY SOFT TO SOFT GRAY CLAY W/SILT LENSES		
20	4	19.0	20.0			VERY SOFT TO SOFT GRAY CLAY W/SILT LENSES		
	5	24.0	25.0		25.5	VERY SOFT TO SOFT GRAY CLAY W/SILT LENSES		
	6	28.0	29.0	25.5	29.0	LOOSE GRAY CLAYEY SAND W/SHELL FRAGMENTS		
30	7	29.0	30.5	29.0		MEDIUM DENSE GRAY SAND W/SHELL FRAGMENTS	3	23
	8	31.5	33.0		34.0	MEDIUM DENSE GRAY SAND W/SHELL FRAGMENTS	4	18
	9	34.0	35.5	34.0		LOOSE GRAY SAND W/SHELL FRAGMENTS	3	7
40	10	38.5	40.0		42.0	LOOSE GRAY SAND W/SHELL FRAGMENTS	1	5
	11	43.5	45.0	42.0		MEDIUM STIFF GRAY CLAY W/SAND POCKETS & SHELL FRAGMENTS	2	4
50	12	49.0	50.0		50.0	MEDIUM STIFF GRAY CLAY W/SAND POCKETS & SHELL FRAGMENTS		

* BORING 35 WAS TAKEN IN A LEVEE THAT WAS DEGRADED. THE TOP THREE TO FIVE FEET OF SOIL WAS REMOVED. THE APPROXIMATE GROUND SURFACE ELEVATIONS AT THE LOCATIONS OF THESE BORINGS ARE NOW THREE TO FIVE FEET LOWER.

NOTES

- NUMBER IN FIRST STANDARD PENETRATION TEST COLUMN INDICATES NUMBER OF BLOWS OF 140-LB. HAMMER DROPPED 30 IN. REQUIRED TO SEAT 2-IN. O.D. SPLITSPOON SAMPLER 6 IN. NUMBER IN SECOND COLUMN INDICATES NUMBER OF BLOWS OF 140-LB HAMMER DROPPED 30 IN. REQUIRED TO DRIVE 2 IN. O.D. SPLITSPOON SAMPLER 1 FT. AFTER SEATING 6 IN.
- BORING 35 WAS TAKEN AUGUST 31, 1985. BORING 36 WAS TAKEN SEPTEMBER 18, 1985.
- BORINGS TAKEN BY EUSTIS ENGINEERING.

SUMMARY OF LABORATORY TEST RESULTS

BORING 35


SAMPLE NO.	DEPTH IN FEET	CLASSIFICATION	WATER CONTENT PERCENT	DENSITY PCF		UNCONFINED COMPRESSIVE STRENGTH PSF
				DRY	WET	
2	1.7	STIFF TAN & GRAY CLAY W/CLAYEY SILT LAYERS & POCKETS	26.2	91.9	115.9	2290*
4	7.7	STIFF GRAY CLAY W/CLAYEY SILT LAYERS & LENSES	22.6	95.7	117.3	2440*
5	10.7	STIFF GRAY CLAY W/CLAYEY SILT LAYERS & LENSES	30.1	89.1	115.9	2560*
7	18.2	SOFT DARK GRAY SILTY CLAY W/ORGANIC MATTER	70.0	52.8	89.8	640
9	28.2	VERY LOOSE GRAY CLAYEY SILT W/SILTY CLAY LAYERS	47.0	71.8	105.5	385
11	38.2	MEDIUM STIFF GRAY CLAY	70.9	57.3	98.0	1105

BORING 36

SAMPLE NO.	DEPTH IN FEET	CLASSIFICATION	WATER CONTENT PERCENT	DENSITY PCF		UNCONFINED COMPRESSIVE STRENGTH PSF
				DRY	WET	
1	5.0	EXTREMELY SOFT BLACK & BROWN HUMUS W/ORGANIC CLAY & ROOTS	212.0	23.5	73.2	215
3	14.0	VERY SOFT GRAY CLAY W/SILT POCKETS & SHELL FRAGMENTS	64.3	60.7	99.7	435
5	24.0	SOFT GRAY CLAY	75.7	54.3	95.4	700
6	28.0	LOOSE GRAY CLAYEY SAND W/SHELL FRAGMENTS	28.2	93.2	119.5	345*
12	49.0	MEDIUM STIFF GRAY CLAY W/SHELL FRAGMENTS & SAND POCKETS	58.8	63.3	100.5	1010

*UNCONSOLIDATED UNDRAINED TRIAXIAL COMPRESSION TEST— ONE SPECIMEN; CONFINED AT THE APPROXIMATE OVERBURDEN PRESSURE

LEGEND

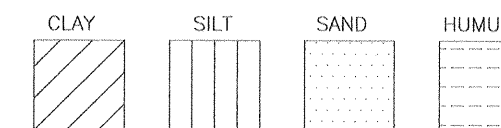

PREDOMINANT TYPE SHOWN IN HEAVY. MODIFYING TYPE SHOWN LIGHT.





DACW29-00-B-0094

AS BUILT PLANS
DATE RECEIVED 3/15/02
DATE TRACINGS CORRECTED 4/18/02

REFERENCE DRAWINGS


- FOR GENERAL NOTES, SEE DWG. NO. 3.
- FOR USACE B/L INFORMATION, SEE DWG. NO. 5.

SCALE: 1" = 5'

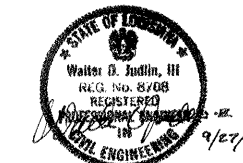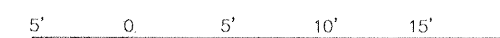

SYMBOL	DESCRIPTION	DATE	APPROVED
REVISIONS			
U.S. ARMY ENGINEER DISTRICT, NEW ORLEANS CORPS OF ENGINEERS NEW ORLEANS, LOUISIANA			
BOARD OF LEVEE COMMISSIONERS ORLEANS LEVEE BOARD NEW ORLEANS, LOUISIANA		HARTMAN ENGINEERING, INC. CONSULTING ENGINEERS KENNER, LOUISIANA	
LAKE PONTCHARTRAIN, LA. AND VICINITY HIGH LEVEL PLAN ORLEANS AVENUE OUTFALL CANAL PHASE 1B ORLEANS PARISH LOUISIANA			
ROBERT E. LEE BOULEVARD BRIDGE BORING LOGS			
DESIGNED BY: EUSTIS	DATE: MAR. 8, 2000	PLOT SCALE: 60	PLOT DATE: MARCH 8, 2000
DRAWN BY: L.A.C.	CHECKED BY: W.D.L.	GADD FILE: SHT50.DGN	FILE NO. H-4-44776
SUBMITTED BY: HARTMAN ENGINEERING	SOLICITATION NO. DACW29-00-B-0094	DWG. NO. 50	OF 59

File: D:\PROJECTS\Boring Log\Boring Log.dwg, Date: 03/14/02, Scale: 1/8" = 1'-0"

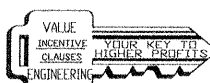

Safety is a Part of Your Contract

SUMMARY OF BORINGS

BORING NO. 37
USACE E B/L STA. 93+97, 1.5' LT.
GROUND ELEVATION +9.04 NGVD*

BORING NO. 38
USACE W B/L STA. 93+67
GROUND ELEVATION +8.89 NGVD*

DEPTH FEET	STRATUM	VISUAL CLASSIFICATION	STANDARD PENETRATION TEST	
			8	15
0.0		MEDIUM COMPACT TO COMPACT BROWN CLAYEY SILT W/CLAY POCKETS (FILL)		
1.5		MEDIUM COMPACT TO COMPACT BROWN CLAYEY SILT	8	25
4.0	6.0	MEDIUM COMPACT TO COMPACT BROWN CLAYEY SILT W/SHELLS, BRICK, GLASS, ETC.	10	14
8.3		MEDIUM STIFF TO STIFF BROWN SILTY CLAY W/BRICKS & SILT POCKETS (FILL)		
11.3	12.0	MEDIUM STIFF TO STIFF BROWN SILTY CLAY W/SAND & SILT POCKETS		
14.3	15.0	LOOSE DARK GRAY CLAYEY SILT W/ROOTS & ORGANIC MATTER		
17.0	18.0	LOOSE DARK GRAY CLAYEY SILT W/CLAY LAYERS, ROOTS & WOOD		
18.0	19.5	WOOD		
23.5	24.5	SOFT BROWN SILTY CLAY W/ROOTS & SILTY CLAY LAYERS & ORGANIC MATTER		
28.5	29.5	SOFT GRAY SILTY CLAY W/ROOTS & ORGANIC MATTER		
33.5	34.5	SOFT GRAY CLAY W/SILT LENSES		
38.5	39.5	SOFT GRAY CLAY		
42.5	43.5	LOOSE GRAY CLAYEY SAND W/CLAY POCKETS & SHELLS		
44.0	45.5	MEDIUM DENSE GRAY FINE SAND	4	12
46.5	48.0	MEDIUM DENSE GRAY FINE SAND	5	18
48.5	50.0	MEDIUM DENSE GRAY FINE SAND W/CLAY LAYERS	9	22

DEPTH FEET	STRATUM	VISUAL CLASSIFICATION	STANDARD PENETRATION TEST	
			8	15
0.0		STIFF GRAY & TAN SILTY CLAY W/SILT POCKETS		
5.0	5.5	STIFF BROWN CLAY W/ORGANIC MATTER		
8.0	8.5	SOFT GRAY CLAY W/ORGANIC MATTER		
11.0	11.5	SOFT GRAY CLAY W/ORGANIC MATTER		
14.0	14.5	SOFT GRAY CLAY W/ORGANIC MATTER		
19.0	19.5	SOFT BROWN ORGANIC CLAY W/ORGANIC MATTER & WOOD		
24.0	24.5	SOFT BROWN ORGANIC CLAY W/ORGANIC MATTER & WOOD		
29.0	29.5	SOFT GRAY CLAY W/ORGANIC MATTER		
34.0	34.5	SOFT GRAY CLAY W/SILT LENSES		
39.0	39.5	SOFT GRAY CLAY W/SILT LENSES		
42.0	42.5	SOFT GRAY SANDY CLAY W/SHELL FRAGMENTS		
43.5	45.0	MEDIUM DENSE GRAY SAND W/SHELL FRAGMENTS	5	13
46.0	47.5	MEDIUM DENSE GRAY SAND W/SHELL FRAGMENTS	4	11
48.5	50.0	MEDIUM DENSE GRAY SAND W/SHELL FRAGMENTS	5	15
53.5	55.0	LOOSE GRAY SAND W/SHELL FRAGMENTS	3	8
58.5	60.0	SOFT GRAY SANDY CLAY W/SHELL FRAGMENTS	2	5
64.0	64.5	MEDIUM STIFF GRAY CLAY W/SAND POCKETS & SHELL FRAGMENTS		
68.5	69.5	MEDIUM STIFF GRAY CLAY W/ROOTS & ORGANIC CLAY LAYERS		
73.5	74.5	MEDIUM STIFF LIGHT GRAY SILTY CLAY		
78.5	79.5	STIFF GREENISH-GRAY CLAY		
83.5	84.5	STIFF GREENISH GRAY SANDY CLAY W/CLAYEY SAND POCKETS		
89.5	90.0	MEDIUM DENSE GRAY & TAN CLAYEY SAND W/CLAY LAYERS		
94.0	94.5	MEDIUM DENSE GRAY & TAN CLAYEY SAND W/CLAY LAYERS		
98.5	99.5	MEDIUM STIFF GRAY CLAY W/SAND LENSES & LAYERS		

* BORING 37 AND 38 WERE TAKEN IN A LEVEE THAT WAS DEGRADED. THE TOP THREE TO FIVE FEET OF SOIL WAS REMOVED. THE APPROXIMATE GROUND SURFACE ELEVATIONS AT THE LOCATIONS OF THESE BORINGS ARE NOW THREE TO FIVE FEET LOWER.

NOTES

- NUMBER IN FIRST STANDARD PENETRATION TEST COLUMN INDICATES NUMBER OF BLOWS OF 140-LB. HAMMER DROPPED 30 IN. REQUIRED TO SEAT 2-IN. O.D. SPLITSPOON SAMPLER 6 IN. NUMBER IN SECOND COLUMN INDICATES NUMBER OF BLOWS OF 140-LB. HAMMER DROPPED 30 IN. REQUIRED TO DRIVE 2 IN. O.D. SPLITSPOON SAMPLER 1 FT. AFTER SEATING 6 IN.
- BORING 37 WAS TAKEN AUGUST 1, 1985
BORING 38 WAS TAKEN SEPTEMBER 5-6, 1985
- BORINGS TAKEN BY EUSTIS ENGINEERING

SUMMARY OF LABORATORY TEST RESULTS


BORING 37

SAMPLE NO.	DEPTH IN FEET	CLASSIFICATION	WATER CONTENT PERCENT	DENSITY PCF		UNCONFINED COMPRESSIVE STRENGTH PSF
				DRY	WET	
2	1.5	COMPACT BROWN CLAYEY SILT W/SILTY CLAY & ROOTS (FILL)	9.1			
4	8.3	MEDIUM STIFF BROWN SILTY CLAY W/SANDY SILT (FILL)	26.5			
6	14.3	LOOSE DARK GRAY CLAYEY SILT W/ORGANIC MATTER	38.4	78.4	108.5	630
8	23.5	SOFT BROWN SILTY CLAY W/MUCH ORGANIC MATTER	98.2	41.9	82.9	795
10	33.5	SOFT GRAY CLAY W/SILT & SAND POCKETS & DECAYED SHELL FRAGMENTS	56.1	66.2	103.3	575

BORING 38

SAMPLE NO.	DEPTH IN FEET	CLASSIFICATION	WATER CONTENT PERCENT	DENSITY PCF		UNCONFINED COMPRESSIVE STRENGTH PSF
				DRY	WET	
2	5.0	STIFF BROWN CLAY W/CLAYEY SAND POCKETS	34.6	78.8	106.0	2165
4	11.0	SOFT GRAY CLAY W/ORGANIC MATTER LENSES & SILTY SAND POCKETS	55.6	65.4	101.8	660
6	19.0	SOFT BROWN ORGANIC CLAY W/HUMUS & ROOTS	198.1	23.8	70.9	745
8	29.0	SOFT GRAY CLAY W/CLAYEY SILT POCKETS & DECAYED SHELLS	59.4	63.9	101.9	570
10	39.0	SOFT GRAY CLAY W/CLAYEY SILT LENSES	70.8	57.2	97.7	890
17	64.0	MEDIUM STIFF GRAY CLAY W/DECAYED SHELLS	54.0	67.3	103.7	1175
19	73.5	MEDIUM STIFF LIGHT GRAY SILTY CLAY W/TRACE OF SAND	23.3	99.0	122.1	1835
20	78.5	STIFF GREENISH-GRAY CLAY	39.9	79.7	111.5	2825
21	83.5	STIFF LIGHT GRAY SANDY CLAY	24.9	97.2	121.4	2515

LEGEND

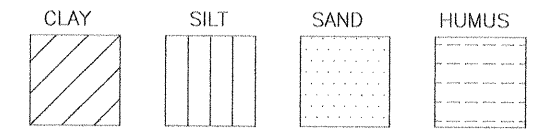

PREDOMINANT TYPE SHOWN IN HEAVY.
MODIFYING TYPE SHOWN LIGHT.

REFERENCE DRAWINGS

- FOR GENERAL NOTES, SEE DWG. NO. 3.
- FOR USACE B/L INFORMATION, SEE DWG. NO. 5.


SCALE: 1" = 5'



DACW29-00-B-0094

AS BUILT PLANS

DATE RECEIVED 3/15/02
DATE TRACINGS CORRECTED 4/18/02

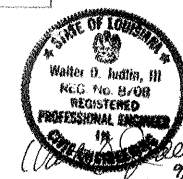

SYMBOL	DESCRIPTION	DATE	APPROVED

REVISIONS
U.S. ARMY ENGINEER DISTRICT, NEW ORLEANS
CORPS OF ENGINEERS
NEW ORLEANS, LOUISIANA

BOARD OF LEVEE COMMISSIONERS
ORLEANS LEVEE BOARD
NEW ORLEANS, LOUISIANA

HARTMAN ENGINEERING, INC.
CONSULTING ENGINEERS
KENNER, LOUISIANA

LAKE PONTCHARTRAIN, LA. AND VICINITY
HIGH LEVEL PLAN
ORLEANS AVENUE OUTFALL CANAL
PHASE 1B
ORLEANS PARISH
LOUISIANA

ROBERT E. LEE BOULEVARD BRIDGE
BORING LOGS





DESIGNED BY: EUSTIS	DATE: MAR. 8, 2000	PLOT SCALE: 60	PLOT DATE: MARCH 8, 2000
DRAWN BY: L.A.C.	CADD FILE: SH151.DGN		FILE NO. H-4-44776
CHECKED BY: W.D.L.	SUBMITTED BY: HARTMAN ENGINEERING	SOLICITATION NO. DACW29-00-B-0094	DWG. 51 OF 59

FILE: D:\SITING\2900\2900.dwg Plot: 4/18/02 10:58:17 am Sheet: 15 of 15






Safety is a Part
of Your Contract

SUMMARY OF PAVEMENT CORES

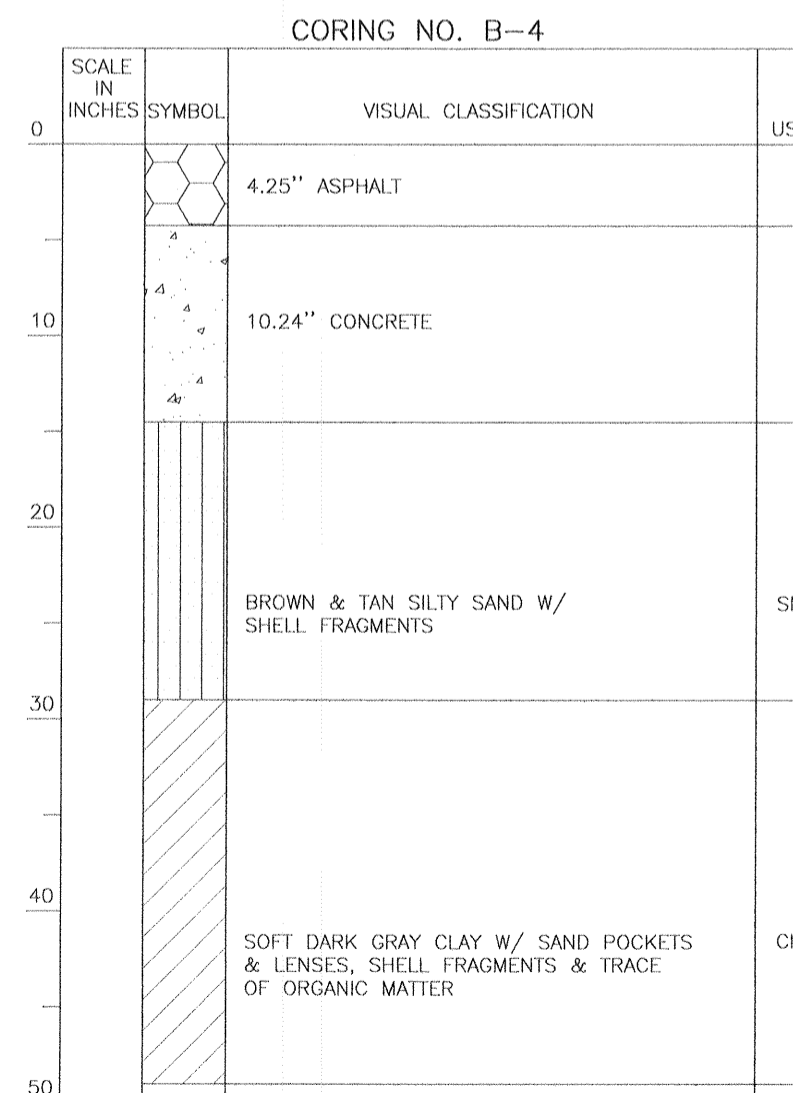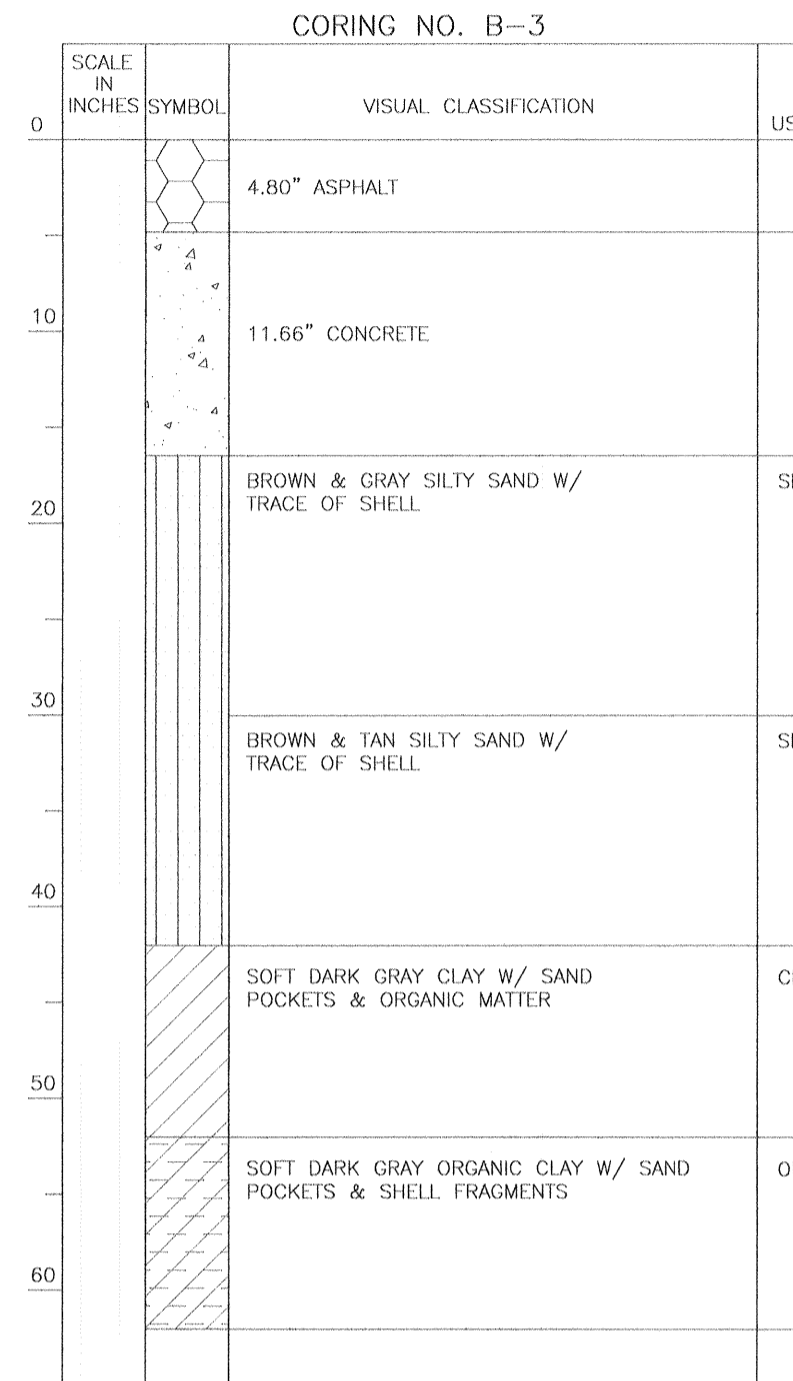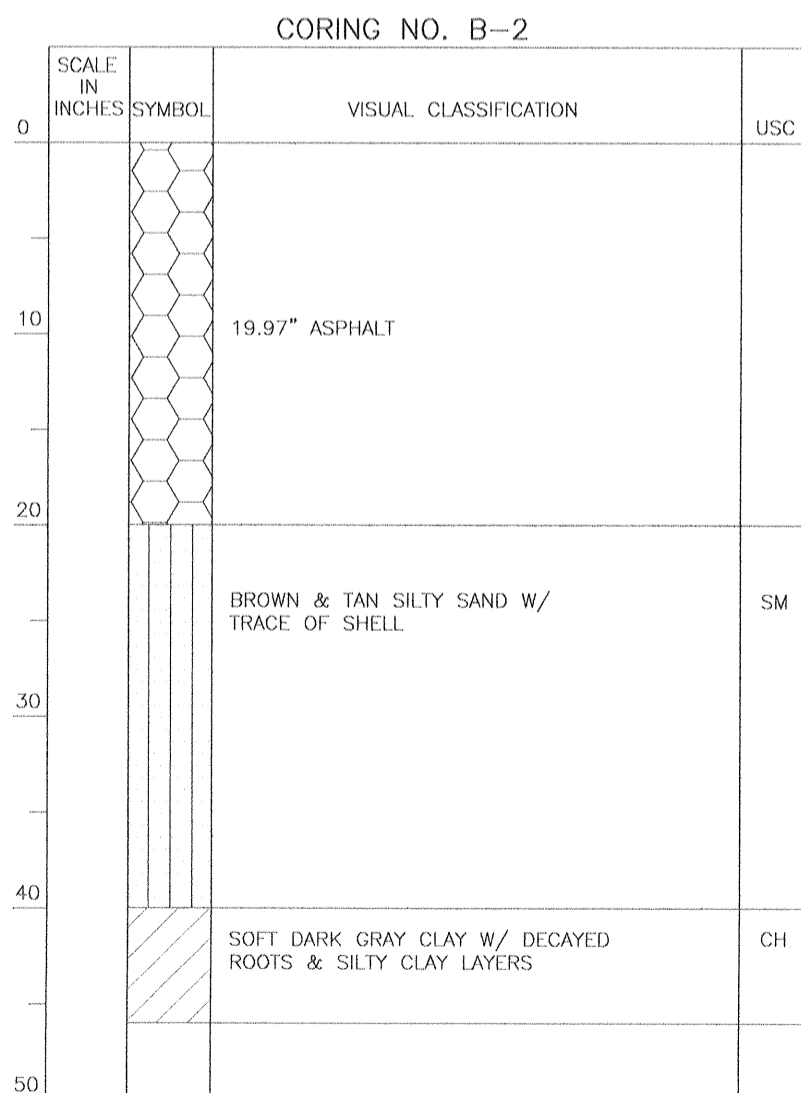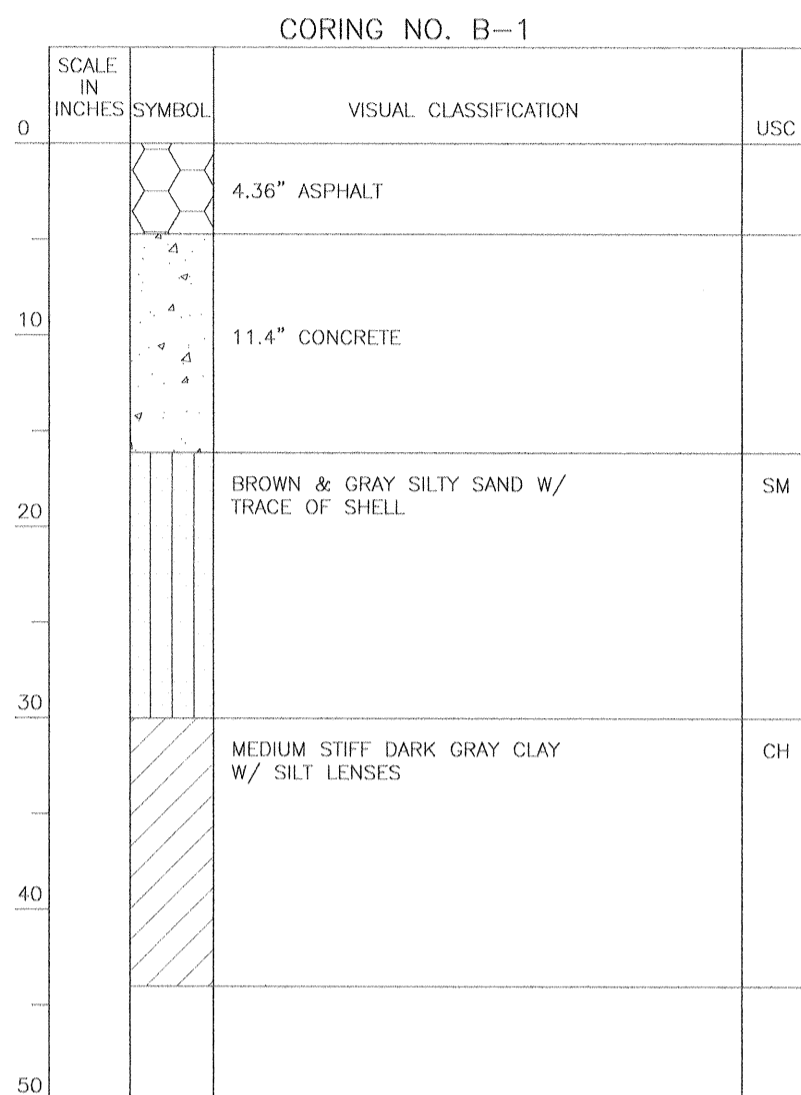


- NOTES
1. CORES TAKEN AUGUST 6 AND AUGUST 7, 1996.
 2. SEE DRAWING NO. 9, DEMOLITION PLAN FOR CORE LOCATIONS.
 3. CORES TAKEN BY EUSTIS ENGINEERING.

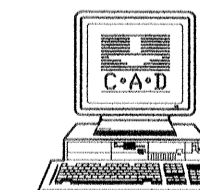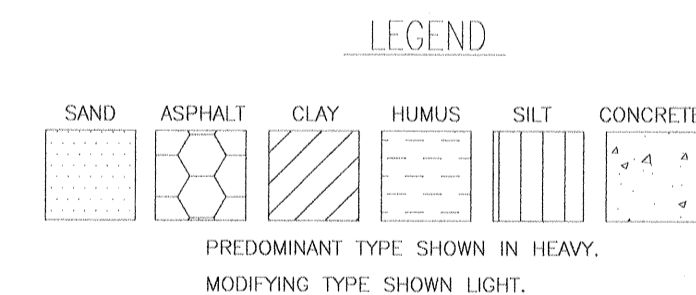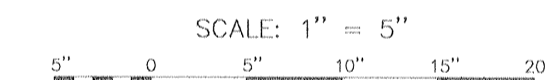


SYMBOL	DESCRIPTION	DATE	APPROVED
REVISIONS			
U.S. ARMY ENGINEER DISTRICT, NEW ORLEANS CORPS OF ENGINEERS NEW ORLEANS, LOUISIANA			
BOARD OF LEVEE COMMISSIONERS ORLEANS LEVEE BOARD NEW ORLEANS, LOUISIANA		HARTMAN ENGINEERING, INC. CONSULTING ENGINEERS KENNER, LOUISIANA	
LAKE PONTCHARTRAIN, LA. AND VICINITY HIGH LEVEL PLAN ORLEANS AVENUE OUTFALL CANAL PHASE 1B ORLEANS PARISH LOUISIANA			
ROBERT E. LEE BOULEVARD BRIDGE CORING LOGS			
DESIGNED BY: EUSTIS	DATE: MAR. 8, 2000	PLOT SCALE: 60	PLOT DATE: MARCH 8, 2000
DRAWN BY: L.A.C.	CHECKED BY: W.D.L.	GADD FILE: SHT52.DGN	FILE NO. H-4-44776
SUBMITTED BY: HARTMAN ENGINEERING	SOLICITATION NO. DACW29-00-B-0094	DWG. 52	OF 59

DATE RECEIVED 3/15/02
AS BUILT PLANS
 DATE TRACINGS CORRECTED 4/18/02

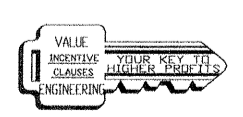


STATE PROJECT	PARISH	SHEET NO.
---------------	--------	-----------

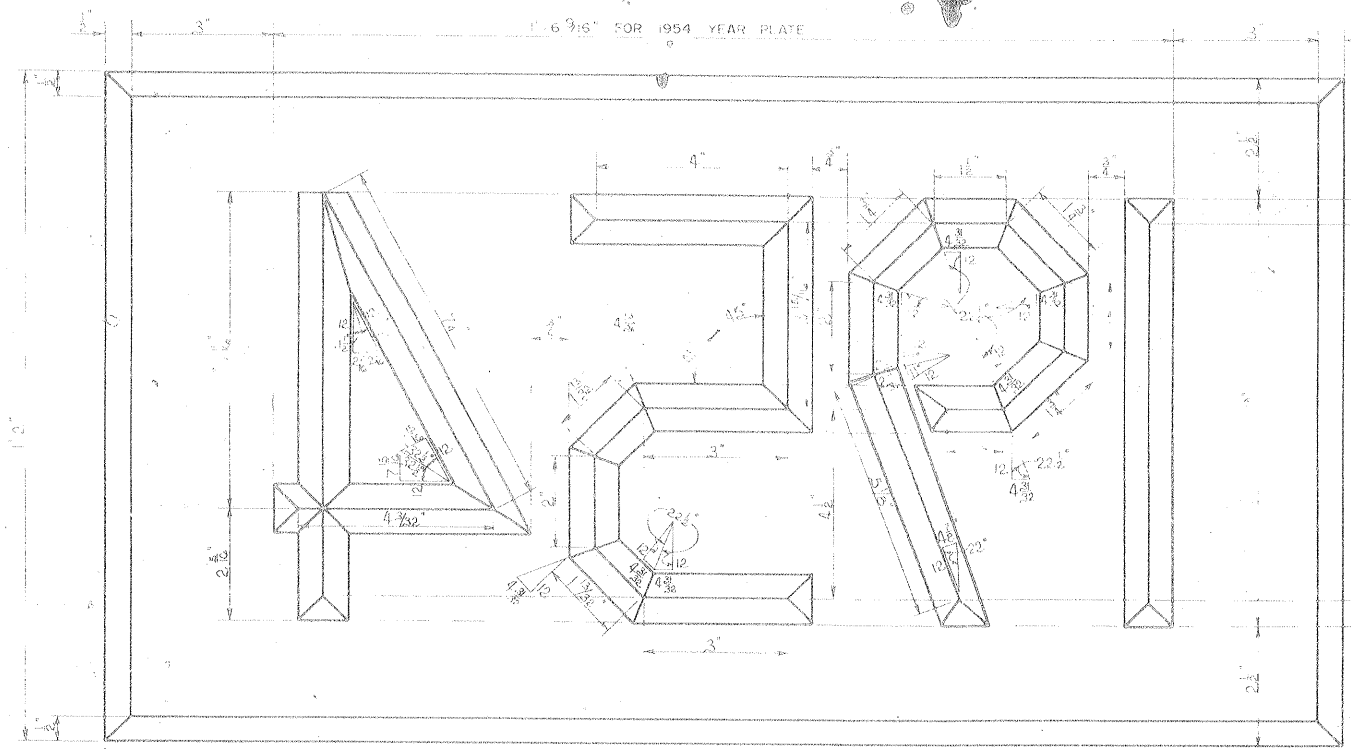


YEAR PLATE

DIMENSIONS SHOWN ARE FOR LARGE PLATE, USE ONE-HALF (1/2) ABOVE DIMENSIONS FOR SMALL PLATES.
YEAR PLATE TO CORRESPOND TO YEAR IN WHICH STRUCTURE IS COMPLETED.

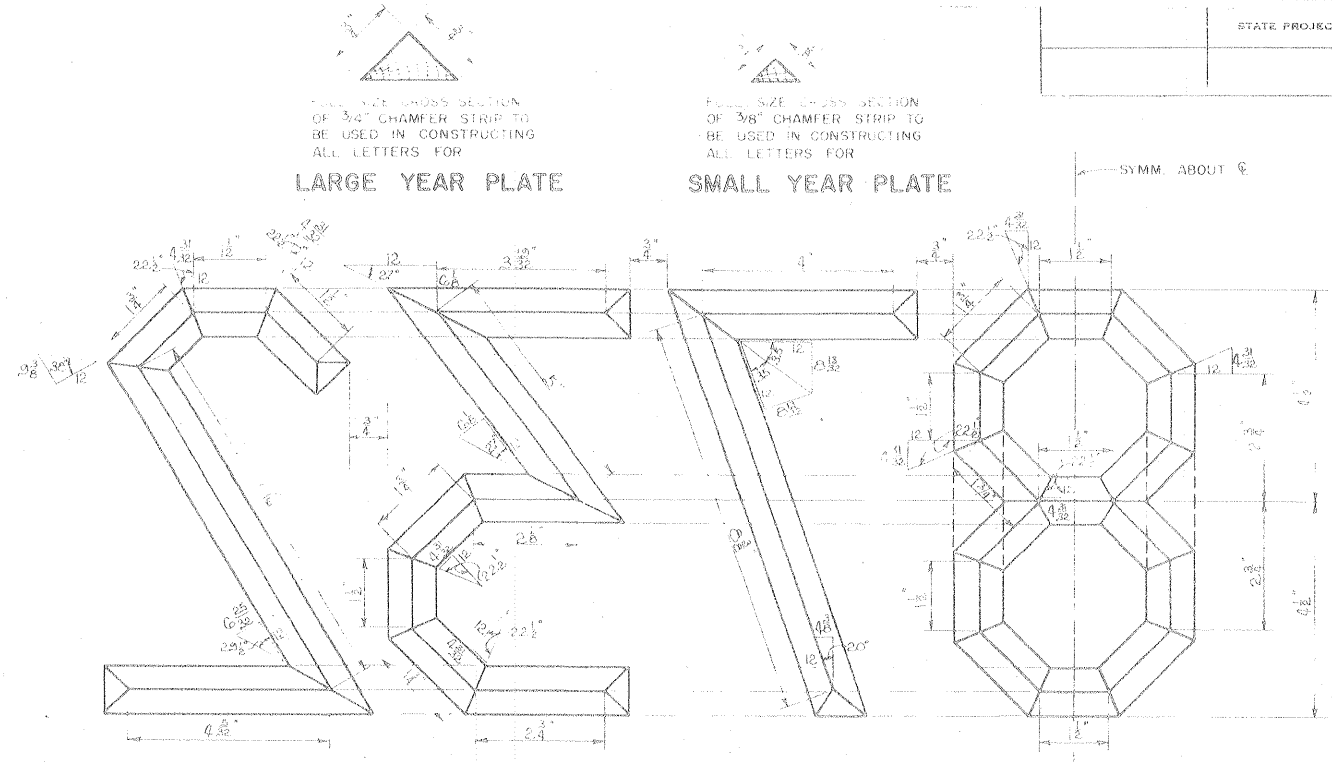

NOTE:
FIGURE "6" TO BE "9" INVERTED.
FIGURE "0" TO BE MADE AS DASHED LINES INDICATE ON DETAIL OF FIGURE "8".
FIGURE DETAILS ARE HALF SCALE FOR LARGE YEAR PLATE.
FIGURE DETAILS ARE FULL SCALE FOR SMALL YEAR PLATE.
DIMENSIONS SHOWN ARE FOR LARGE YEAR PLATE.
USE 1/2 DIMENSIONS SHOWN FOR SMALL YEAR PLATE.

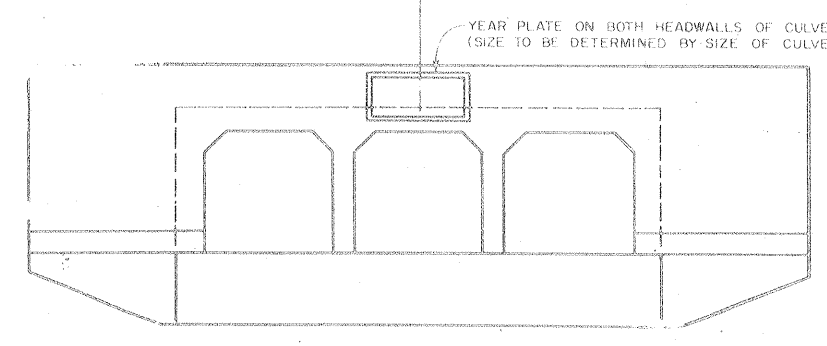

CULVERT ELEVATION



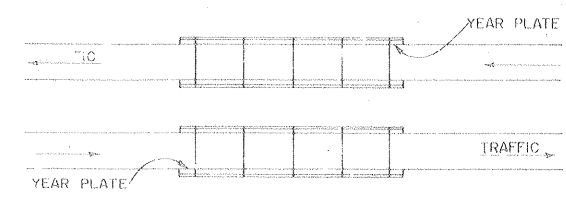


PLATE LOCATIONS FOR TWIN BRIDGE SITES


NOTE:
YEAR PLATE REQUIRED AT BOTH ENDS OF TWO-WAY TRAFFIC BRIDGE ON ONCOMING SIDE.

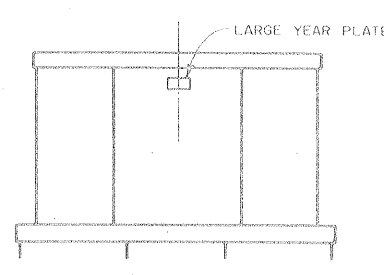


PIER ELEVATION

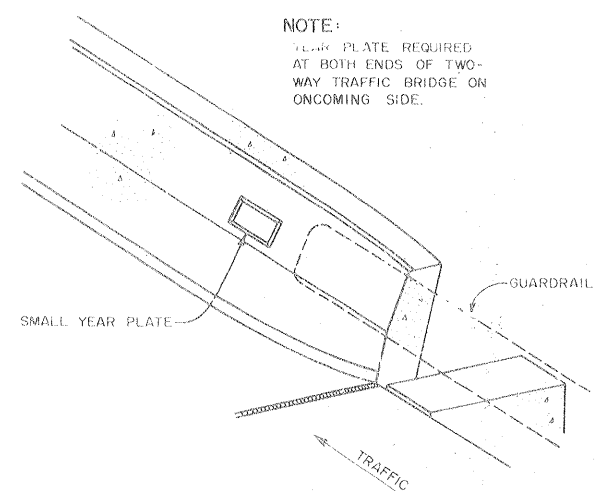


END WALL BARRIER TYPE BRIDGE RAILING

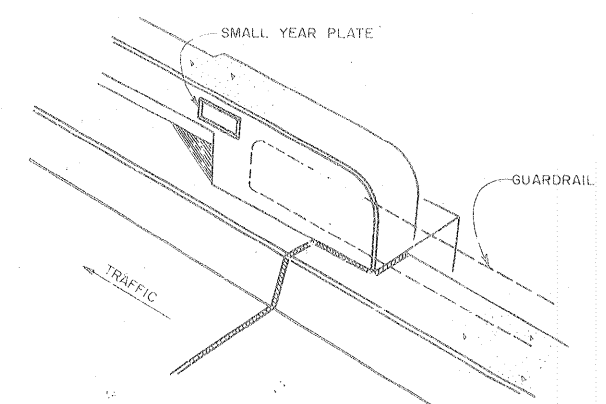


END WALL BRUSH CURB TYPE BRIDGE RAILING

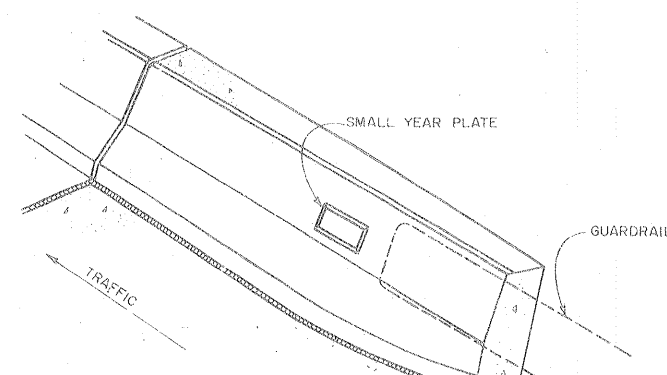


END WALL ABUTMENT TYPE END BENT - BARRIER RAILING

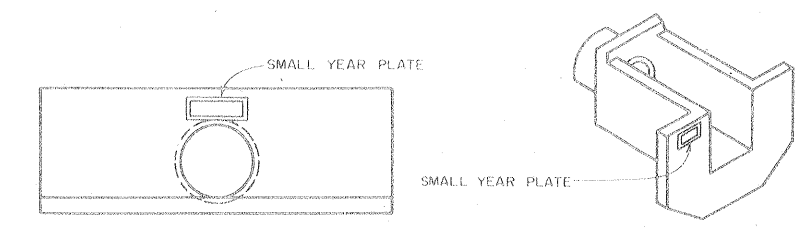


PIPE CULVERT HEADWALL
YEAR PLATE REQUIRED ON BOTH HEADWALLS OF CULVERT

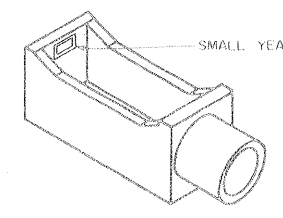

PIPE HEADWALL OPEN BOX TYPE END WALL WITHOUT WEIR

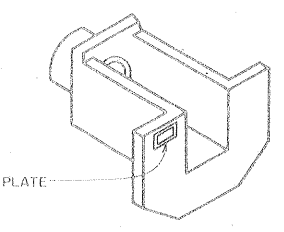

PIPE HEADWALL OPEN END

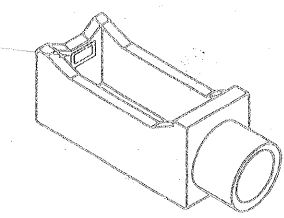

PIPE HEADWALL OPEN BOX TYPE END WALL WITH WEIR

SKETCHES SHOWING LOCATION OF YEAR PLATE ON VARIOUS CONCRETE STRUCTURES

DATE	DESCRIPTION	BY	DESIGNED	CHECKED	TRACED
2-21-74	UPDATED	D.S.H.			
5-25-66	RETRACED	T.W.M.			
2-25-55	REDETAILED & RETRACED	W.D.C.			
1-36	DELINEATOR OMITTED				
3-44	DELINEATOR ADDED	C.E.A.			
10-40	NEW SPECS. & REORG.	S.C.M.			
10-20	RETRACED	M.J.H.			

STANDARD PLAN YEAR PLATES FOR CONCRETE STRUCTURES (TO BE USED WITH STD. PLAN C.M. 95 WHEN ALPHABET IS REQ'D.)		
STATE OF LOUISIANA DEPARTMENT OF TRANSPORTATION & DEVELOPMENT OFFICE OF HIGHWAYS	DATE: JULY 1953	
DESIGNED BY: [Signature]	DETAILED R.V.W.	TRACED BY: [Signature]
CHECKED BY: [Signature]	CHECKED I.R.P.	CHECKED BY: [Signature]
BRIDGE & STRUCTURAL DESIGN SECTION		
APPROVED: [Signature]	CHIEF ENGINEER	DATE: 12/11/89

C.M.97

U.S. ARMY ENGINEER DISTRICT, NEW ORLEANS
CORPS OF ENGINEERS
NEW ORLEANS, LOUISIANA


BOARD OF LEVEE COMMISSIONERS
ORLEANS LEVEE BOARD
NEW ORLEANS, LOUISIANA

HARTMAN ENGINEERING, INC.
CONSULTING ENGINEERS
KENNER, LOUISIANA

LAKE PONCHARTRAIN, LA. AND VICINITY
HIGH LEVEL PLAN
ORLEANS AVENUE OUTFALL CANAL
PHASE 1B
ORLEANS PARISH
LOUISIANA

ROBERT E. LEE BOULEVARD BRIDGE
YEAR PLATES

DESIGNED BY:	DATE:	PLOT SCALE:	PLOT DATE:
DRAWN BY:	MAR. 8, 2000	1	MARCH 8, 2000
CHECKED BY:	CADD FILE: SHT53.DGN		FILE NO. H-4-44776
SUBMITTED BY:	SOLICITATION NO. DACW29-00-B-0094		DWG. 53 OF 59

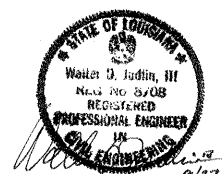


DACW29-00-B-0094

AS BUILT PLANS
DATE RECEIVED 3/15/02
DATE TRACINGS CORRECTED 4/18/02




Safety is a Part
of Your Contract


File: D:\SHT53-00.DWG Last edited: AUG. 27, 02 @ 08:20 a.m. Scale: 1:1 R.L.C.

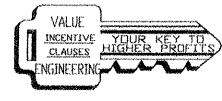


WATSON-BOWMAN /ACME
ROLLED STEEL SHAPE *

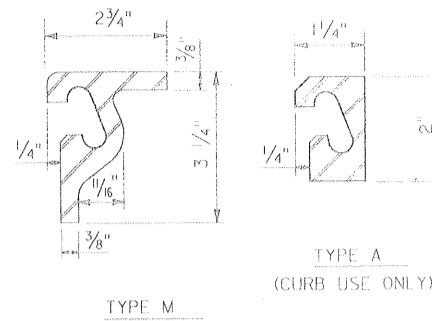


ONFLEX
STEEL EXTRUSIONS

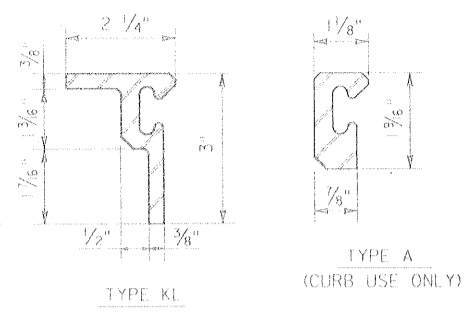


D.S.BROWN
ROLLED STEEL SHAPE *

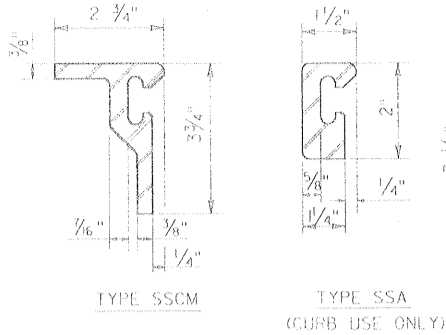


ESCO
STEEL EXTRUSIONS

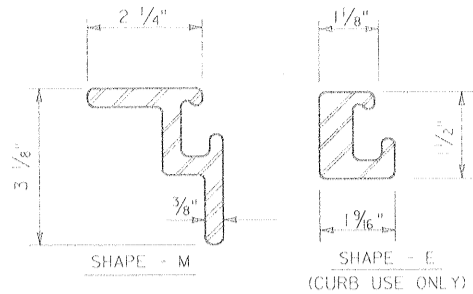

E-POXY INC.
STEEL EXTRUSIONS

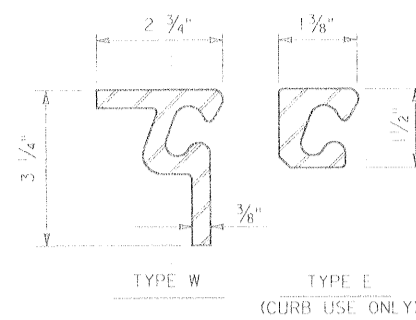


NEOPRENE EXTRUSIONS

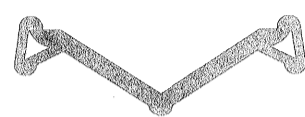

TYPE SE 400

NEOPRENE EXTRUSIONS

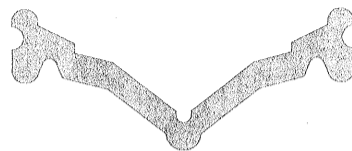


TYPE 40 SS

NEOPRENE EXTRUSIONS




L2 SEAL

NEOPRENE EXTRUSIONS

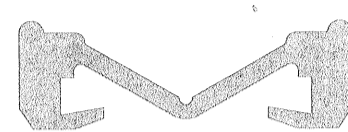

TYPE ES 400

NEOPRENE EXTRUSIONS

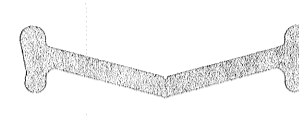


TYPE S 400

* REFERRED TO AS EXTRUSIONS IN THE NOTES.

LENCO

STEEL EXTRUSIONS

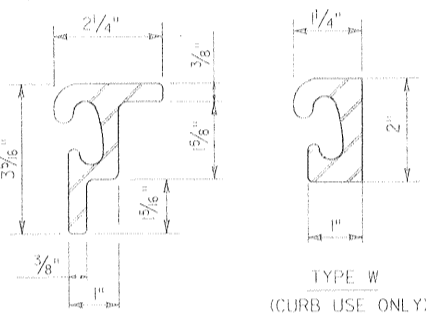


TYPE X


NEOPRENE EXTRUSIONS



TYPE L400

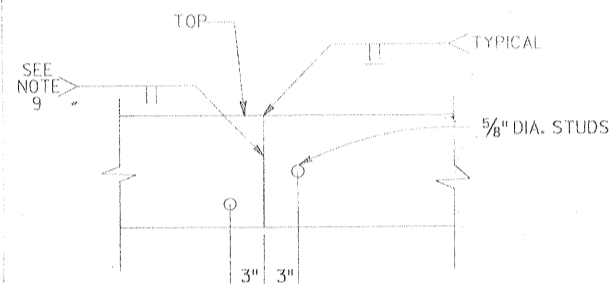

TYPICAL SPLICE

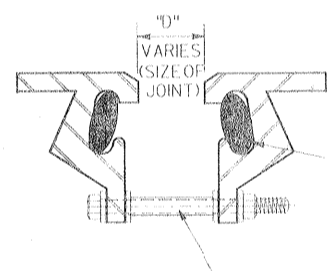

SECTION

1/2" Ø x 4" BOLT,
w/ 1/2" I.D. HEX NUT
1/2" I.D. FLAT WASHERS,
3/8" I.D. x 1 3/4" BLACK PIPE
SPACE 5'-0" O.C. (MAX.)

INSTALLATION :


CONDITION 1: DECKS ON EACH SIDE OF JOINT POURED AT DIFFERENT TIME INTERVALS

- A-PLACE JOINT IN PLACE AS A UNIT (SPACER STILL IN PLACE).
- B-ADJUST TO PROPER VERTICAL POSITION.
- C-POUR DECK THAT IS TO BE POURED FIRST.
- D-PRIOR TO POURING THE ADJACENT DECK, REMOVE SPACER.
- E-JUST PRIOR TO POURING THE ADJACENT DECK, SET JOINT TO PROPER OPENING RELATIVE TO THE CURRENT TEMPERATURE.

CONDITION 2: DECK ON EACH SIDE OF JOINT POURED SIMULTANEOUSLY.

- A-PLACE JOINT IN PLACE AS A UNIT (SPACER STILL IN PLACE).
- B-ADJUST TO PROPER VERTICAL POSITION.
- C-PRIOR TO POURING DECKS, REMOVE SPACER.
- D-JUST PRIOR TO POURING DECKS, SET JOINT TO PROPER OPENING RELATIVE TO THE CURRENT TEMPERATURE.

NOTE: FIELD BENDING OF STUDS IS TOTALLY PROHIBITED.

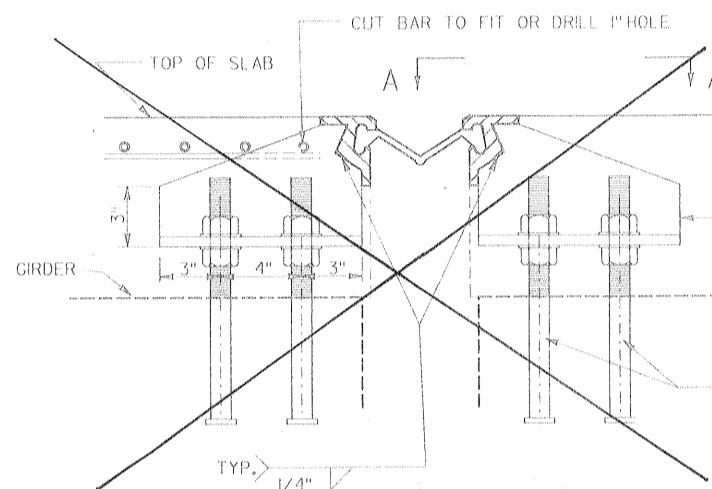

SECTION


(TYPICAL CONNECTION AT GIRDER)

3/8" Ø STUD 8" LONG
1'-0" O.C. (TYP) (6" ALT. CENTERS)

1/2" x 2 1/2" SLOTTED HOLE
(FIELD CUT)

3/8" HOLES ARE TO BE PLACED
SO AS NOT TO INTERFERE WITH
ANCHORAGE SYSTEMS.

VIEW A-A

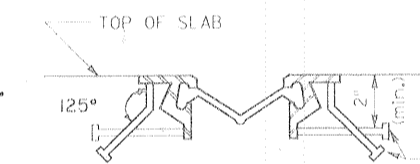

SECTION

125°

3/8" Ø STUDS
Ø ABOUT 1'-0"
(6" ALT. CENTERS)

SUPPORT DETAIL

(TO BE USED WITH A CONCRETE GIRDER OR
STEEL GIRDER WITH A WELDED STUD)

DATE	DESCRIPTION	BY
5/22/95	ADDED ITEM #05 (BB BENDING ANGLE ON STUDS)	TWA
9/15/94	ADDED NOTE TO TYP. CONN. GIRDER & STUD (CLR.)	NPK
5/5/94	PAYMENT ITEM CHANGED ON NOTE # 14	NPK
3/1/94	SPACER & CONN. STUD AT WELDED SPLICES	NPK
1/20/93	ANCHOR BOLTS LOCATION AT END DAM	NPK
5/20/93	SLOTTED HOLES SHALL BE FIELD CUT	NPK

REVISIONS

- NOTES:
- THE FOLLOWING MATERIALS ARE TO BE PAID FOR IN THE BID PRICE PER LINEAR FOOT OF STRIP SEAL, INCLUDED IN STRIP SEAL JOINTS.
 - A. NEOPRENE EXTRUSION
 - B. STEEL EXTRUSIONS
 - C. 5/8" DIAMETER STUDS
 - D. ALL STEEL PLATES REQUIRED FOR BARRIER SECTION
 - E. CAP SCREWS AND NUTS, TEMPORARY STEEL SPACER BLOCKS AND POLYURETHANE FILLER ROD
 - F. CONNECTION PLATE
 - G. HEAVY DUTY ANCHOR STRAPE & REBAR
 - STRUCTURAL STEEL SHALL CONFORM TO ASTM A-36 OR A-588
 - THE MANUFACTURER'S RECOMMENDED CONSTRUCTION METHODS SHALL BE FOLLOWED.
 - A FACTORY REPRESENTATIVE IS TO BE PRESENT DURING THE INSTALLATION OF THE JOINT.
 - SHOP DETAILS OF JOINTS SHALL BE SUBMITTED FOR APPROVAL PRIOR TO FABRICATION.
 - STEEL EXTRUSIONS SHALL BE SHIPPED IN Pairs.
 - POLYURETHANE FILLER ROD WILL BE PLACED IN THE STEEL EXTRUSION'S CAVITY PRIOR TO SHIPMENT, THIS ROD WILL BE REMOVED ONLY WHEN THE NEOPRENE EXTRUSION IS TO BE INSTALLED IN PLACE.
 - ALL WELDS SHALL CONFORM TO AWS D15.00 BRIDGE STRUCTURAL WELDING CODE AND D 14.92 REINFORCING STEEL WELDING CODE.
 - WELDED SPLICES OF STEEL EXTRUSIONS SHALL BE SHOP SPLICES AND EACH PORTION OF THE EXTRUSION SHALL BE NOT LESS THAN 15 FEET IN LENGTH EXCEPT THAT ONE SECTION, NOT LESS THAN 4 FEET IN LENGTH WILL BE ALLOWED IN THE SHOULDER AREA IF REQUIRED TO MATCH THE ROADWAY CROSS SECTION. ALL SPLICES SHALL BE MADE SO AS TO OCCUR OUTSIDE THE WHEEL PATHS. (SEE DETAIL ON SHEET 2 OF 2).
 - IF A SECTION LESS THAN 15 FEET IS USED, THE CONNECTION STUDS WILL BE SPACED AT 9 INCH ALTERNATE CENTERS. ALL SPLICE LOCATIONS WILL BE SHOWN ON THE SHOP DRAWINGS. DRAWINGS WILL NOT BE APPROVED UNLESS THE LOCATIONS ARE DESIGNATED ON THE DRAWINGS. THE LOCATIONS MAY BE DESIGNATED WITH A 1/2" - 6 INCH TOLERANCE. WELDED SPLICES ARE ALSO REQUIRED WHERE TWO DIFFERENT STEEL SHAPES ARE JOINED AT THE CURB AREA AND WHERE THE CURB UNITS ARE TURNED UP.
 - WELDED SPLICES WILL BE BUTT SPLICES AND CARE SHALL BE TAKEN NOT TO ALLOW WELD METAL TO INVAD THE GLAND CAVITY. WELD MATERIAL IN THE CAVITY WILL BE CAUSE FOR REJECTION. CONNECTION STUDS WILL BE LOCATED 3 INCHES EITHER SIDE OF WELDED SPLICES.
 - NEOPRENE EXTRUSIONS SHALL BE MANUFACTURED AS A CONTINUOUS PIECE WITH ONLY ONE (1) SHOP SPLICE PER JOINT ALLOWED WHEN LENGTH EXCEEDS 50 FEET. THE NEOPRENE STRIP SEAL SHALL BE AN EXTRUDED NEOPRENE MATERIAL CONFORMING TO ASTM DESIGNATION D2628 MODIFIED TO OMIT RECOVERY TEST AND TO REVISE THE REQUIRED DUROMETER - TYPE A HARNESSTO 55 - 5/410 AS DETERMINED BY ASTM D2240.
 - SEAL SHALL BE BONDED TO STEEL WITH A PRE-MIXED LUBRICATING ADHESIVE SOLUTION WHICH SHALL BE USED TO FACILITATE THE SEAL INSTALLATION. THIS LUBRICANT ADHESIVE SHALL BE SELECTED FROM THE LA DOT QUALIFIED PRODUCTS LIST, AS MAINTAINED BY THE DEPARTMENT'S MATERIALS SECTION. THE LUBRICANT SHOULD FLOW FREELY AND EVENLY COAT THE SEAL AND JOINT FACE. THE LUBRICANT SHOULD COMPLETELY COAT THE SEAL AND STEEL EXTRUSION CAVITY WHICH REMAINS IN CONTACT.
 - ALL METAL SURFACES NOT EMBEDDED IN CONCRETE SHALL BE SHOP PAINTED WITH TWO COATS OF ~~PRIMER~~ PRIMER (NO TOP COAT). CARE SHALL BE TAKEN THAT A PAINT BUILD-UP DOES NOT OCCUR IN THE BOTTOM OF THE STEEL EXTRUSION CAVITY.
 - JOINTS UP TO FIFTY FOUR (54) FEET IN LENGTH SHALL BE DELIVERED TO THE JOB SITE IN ONE PIECE. JOINTS OVER FIFTY FOUR (54) FEET IN LENGTH MAY HAVE PROVISIONS FOR A FIELD SPLICE IN THE STEEL EXTRUSIONS PROVIDING THE SPLICE IS PERFORMED IN SHOP LIKE CONDITIONS IN THE PRESENCE OF A STATE INSPECTOR AND MEET THE REQUIREMENTS OF NOTE 8 ABOVE.
 - ALL OTHER WELDED SPLICES OF STEEL EXTRUSIONS SHALL BE SHOP SPLICES.
 - ALL LABOR, MATERIALS, EQUIPMENT, MANUFACTURER SUPERVISION AND INCIDENTALS PERTAINING TO THE INSTALLATION OF THE JOINT SHALL BE PAID FOR UNDER ITEM #05 (H).
 - PAY LENGTH FOR JOINT IS MEASURED GUTTER TO GUTTER ALONG CENTERLINE OF JOINT.
 - ALL STUDS SHALL BE BENT PRIOR TO WELDING TO THE JOINT

STRIP SEAL JOINT DETAILS (4")

DESIGNED BY: DESIGNED KNAPP	CHECKED BY: CHECKED D. MILLER	DATE: MAR. 8, 2000	FILE: stripsead.dgn
STATE OF LOUISIANA		DEPARTMENT OF TRANSPORTATION AND DEVELOPMENT	
DESIGNED BY: DESIGNED KNAPP		CHECKED BY: CHECKED D. MILLER	

U.S. ARMY ENGINEER DISTRICT, NEW ORLEANS
CORPS OF ENGINEERS
NEW ORLEANS, LOUISIANA

BOARD OF LEVEE COMMISSIONERS
ORLEANS LEVEE BOARD
NEW ORLEANS, LOUISIANA

HARTMAN ENGINEERING, INC.
CONSULTING ENGINEERS
KENNER, LOUISIANA


LAKE PONTCHARTRAIN, LA. AND VICINITY
HIGH LEVEL PLAN
ORLEANS AVENUE OUTFALL CANAL
PHASE 1B
ORLEANS PARISH
LOUISIANA

ROBERT E. LEE BOULEVARD BRIDGE
STRIP SEAL JOINT DETAILS


DESIGNED BY: HARTMAN ENGINEERING	DATE: MAR. 8, 2000	PLOT SCALE: 1	PLOT DATE: MARCH 8, 2000
CHECKED BY: HARTMAN ENGINEERING	CADD FILE: SHTS54.DGN	FILE NO: H-4-44776	OWG: 54 OF 59
SUBMITTED BY: HARTMAN ENGINEERING	SOLICITATION NO: DACW29-00-B-0094		







Safety is a Part
of Your Contract

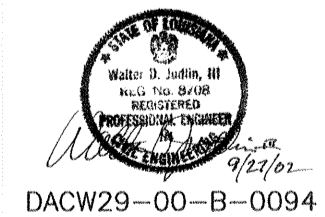

AS BUILT PLANS
DATE RECEIVED 3/15/02
DATE TRACINGS CORRECTED 4/18/02

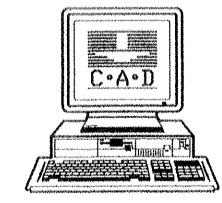

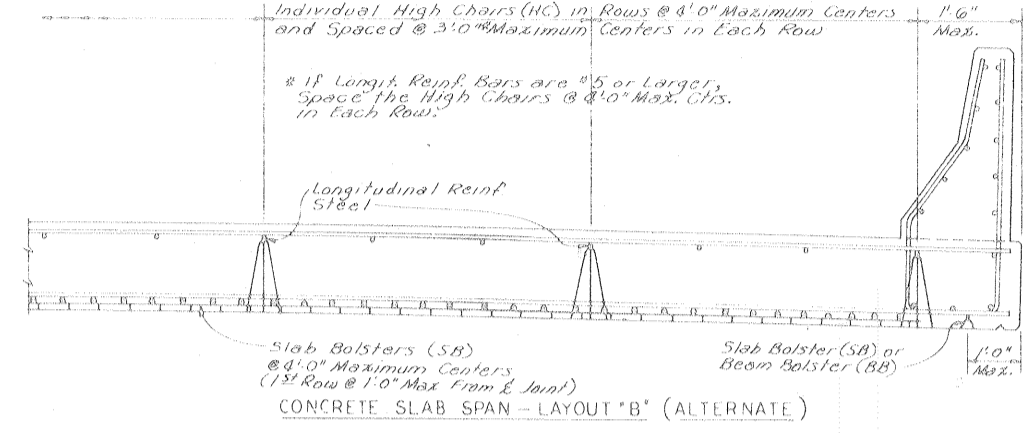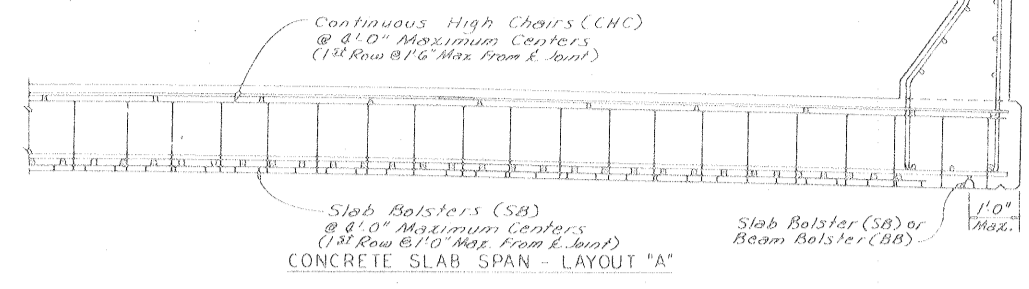
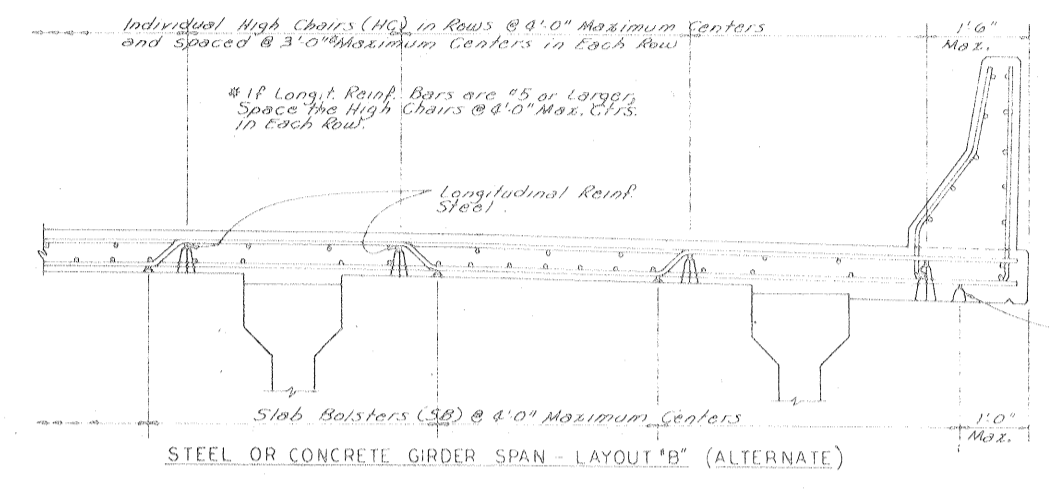
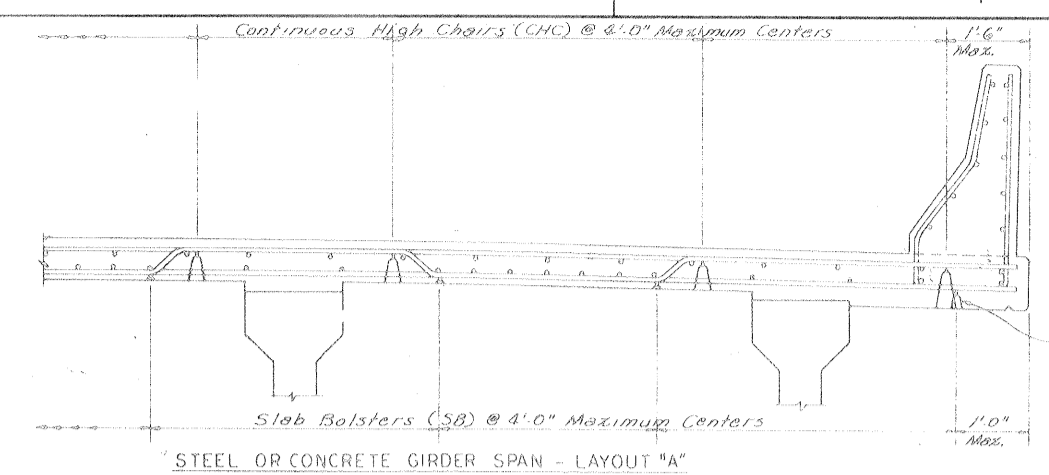


TYPE OF SUPPORT	BAR SUPPORT ILLUSTRATION	MINIMUM WIRE SIZES ^Δ			REMARKS
		HEIGHT	TOP	LEGS	
Slab Bolster (SB)		All	N ^o 8 Cor- rugated	N ^o 6	Vert. Curvature Spaced 1'-0" Ctrs.
Beam Bolsters (BB)		Up to 2'	N ^o 7	N ^o 7	
Individual High Chair (HC)		2' to 5'	N ^o 8	N ^o 6	
Continuous High Chair (CHC)		5' to 9'	N ^o 8	N ^o 6	
		Over 9'	N ^o 8	N ^o 6	

^Δ Legs at 90 degrees or less with vertical. When height exceeds 12', reinforce legs with welded cross wires or encircling wires.

^Δ Legs at 90 degrees or less with vertical. All legs 8 3/4" on center maximum, with leg within 4" of end of chair, and spread between legs not less than 50% of nominal height.

^Δ American Steel & Wire Gauges.

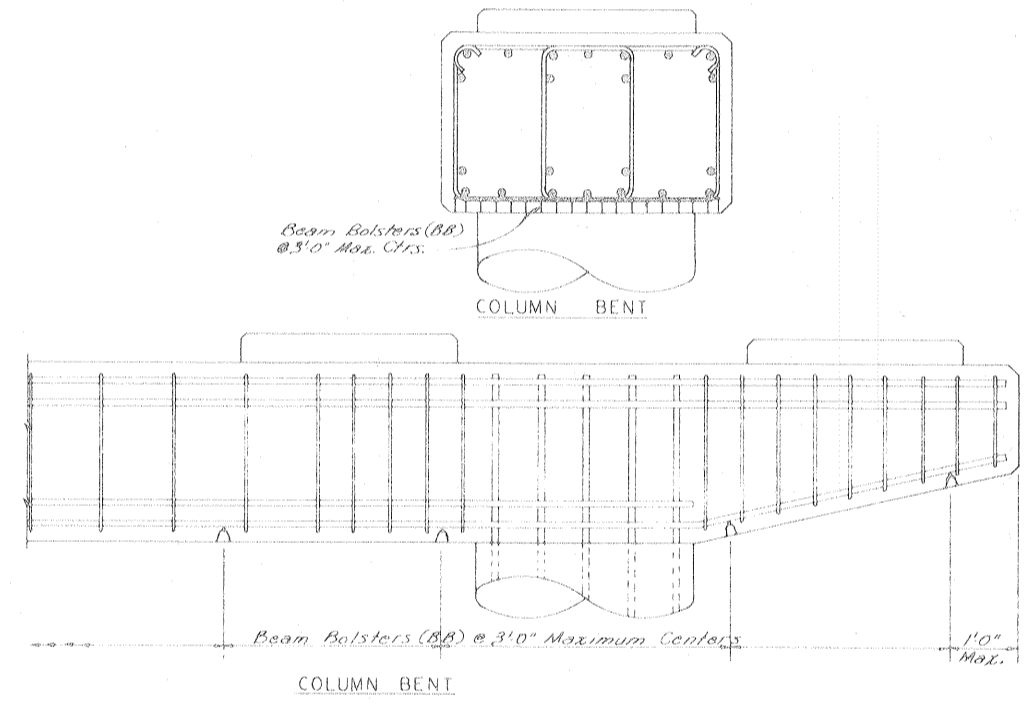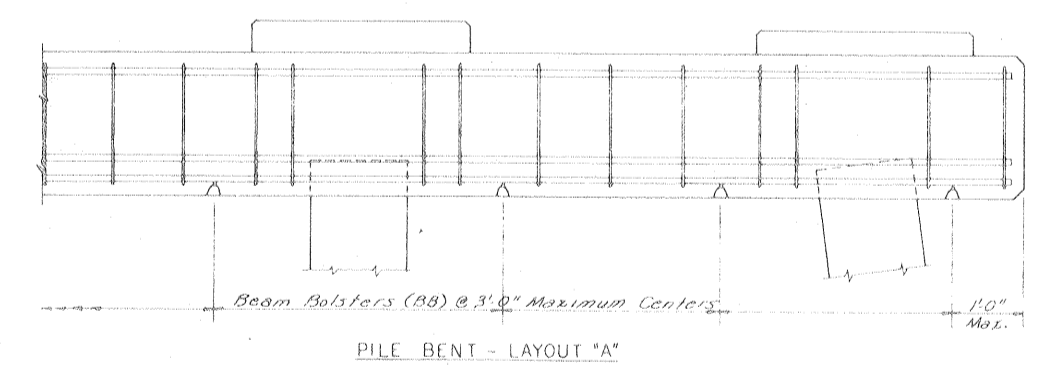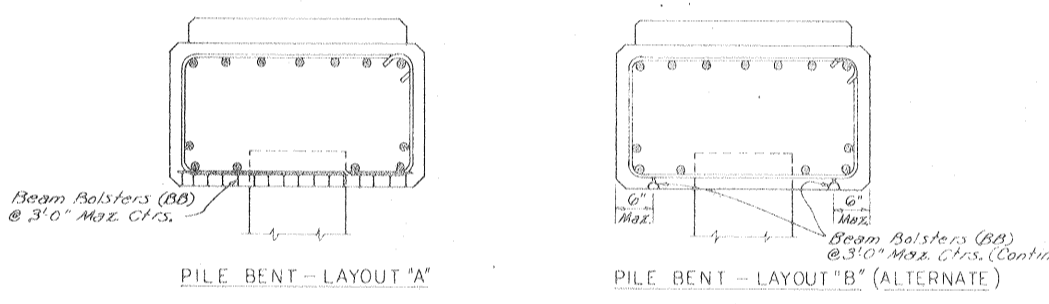

GENERAL NOTES:

Steel Wire Bar Supports shall be in accordance with the latest Approved Louisiana Std. Specs. for Roads and Bridges, 1982, as Amended by Special Provisions and/or Supplemental Specifications. Reinforcing Steel Bars shall be tied in accordance with the latest Approved Louisiana Std. Specs. for Roads and Bridges, 1982, as amended by Special Provisions and/or Supplemental Specifications. A No. 5 Bar with Individual High Chairs @ 8'-0" Max. Ctrs. or A No. 8 Bar with Individual High Chairs @ 3'-0" Max. Ctrs. may be substituted, on a one for one basis, for the Continuous High Chairs. Height of bar supports to be that required to support the Reinforcing Bars in Positions Shown on Plans. Bar supports are not intended, and shall not be used, to support Runways for Concrete Bumpers or Similar Loads.

When bar supports are placed in continuous lines, they shall be so placed that the ends of the supporting wires shall be lapped to lock the last legs on adjoining pieces, but no bar shall be placed more than 2' beyond the last leg at the end of a run of any continuous supports.

Where bar supports are used on earth or aggregate subgrades, suitable plates shall be provided to prevent displacement of the support feet. All bar supports bearing on the forms shall have radius bearing legs in the form of a hook (upturned legs) or spherical foot at the lower end of the legs.

STEEL WIRE BAR SUPPORTS

STANDARD PLAN
BAR SUPPORTS
FOR
REINFORCING STEEL

DATE: March 27, 1982


STATE OF LOUISIANA
DEPARTMENT OF TRANSPORTATION & DEVELOPMENT
OFFICE OF HIGHWAYS

DESIGNED BY: [Signature] TRACED
CHECKED BY: [Signature] CHECKED
BRIDGE & STRUCTURAL DESIGN SECTION


APPROVED: [Signature] DATE: [Signature]
CHIEF ENGINEER

DATE	DESCRIPTION	BY
6-8-83	Std. Specs. Date & Min. Wire Sizes	[Signature]
3-10-87	Corr. Inters.	[Signature]
1-21-94	Note regarding upturned legs	[Signature]

S.W.B.S. 100

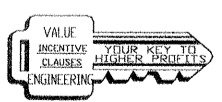

Safety is a Part
of Your Contract

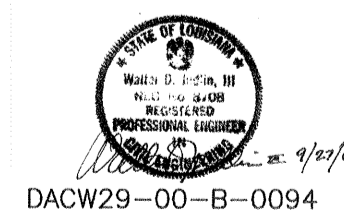


DACW29-00-B-0094

AS BUILT PLANS

DATE RECEIVED 3/15/02

DATE TRACINGS CORRECTED 4/18/02

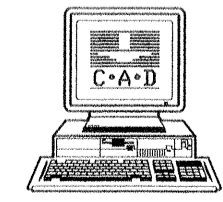

U.S. ARMY ENGINEER DISTRICT, NEW ORLEANS
CORPS OF ENGINEERS
NEW ORLEANS, LOUISIANA

BOARD OF LEEVEE COMMISSIONERS
ORLEANS LEEVEE BOARD
NEW ORLEANS, LOUISIANA

HARTMAN ENGINEERING, INC.
CONSULTING ENGINEERS
KENNER, LOUISIANA

LAKE PONTCHARTRAIN, LA. AND VICINITY
HIGH LEVEL PLAN
ORLEANS AVENUE OUTFALL CANAL
PHASE 1B
ORLEANS PARISH
LOUISIANA

ROBERT E. LEE BOULEVARD BRIDGE
BAR SUPPORTS FOR REINFORCING STEEL


DESIGNED BY:	DATE:	PLOT SCALE:	PLOT DATE:
DRAWN BY:	MAR. 8, 2000	1	MARCH 8, 2000
CHECKED BY:	CADD FILE: SH156.DGN		FILE NO. H-4-44776
SUBMITTED BY:	SOLICITATION NO. DACW29-00-B-0094		DWG. 56 OF 59

STATE PROJECT	PARISH	SHEET NO.

ADVANCE ROAD (STREET) CONSTRUCTION SIGN (W20-1)

The Road (Street) Construction sign is to be located in advance of the initial activity or detour a driver may encounter, and is intended for use as a general warning of obstructions or restrictions. It carries the legend ROAD (STREET) CONSTRUCTION () FT., or ROAD (STREET) CONSTRUCTION () MILE. It may be used in repetition with appropriate legends, or in conjunction with other construction signs.


The legend ROAD (STREET) CONSTRUCTION AHEAD is intended mainly for use on approaches of Roads (Streets) that intersect the route under construction in between the 500 FT. advance warning signs and the End Construction sign. It is also employed as the first advance sign in urban settings with short 250' spacing.



W20-1
48" x 48"

ADVANCE DETOUR SIGN (W20-2)


The Detour sign is intended for use in advance of a point at which traffic is diverted over a temporary roadway or route. It carries the legend DETOUR () FT., or DETOUR () MILE. It may be used in repetition with appropriate legends or in conjunction with other construction signs.



W20-2
48" x 48"

ADVANCE ROAD (STREET) CLOSED SIGN (W20-3)

The Road (Street) Closed sign is intended for use in advance of a point at which a roadway is closed to all traffic or to all but local traffic. It carries the legend ROAD (STREET) CLOSED () FT., or ROAD (STREET) CLOSED () MILE. It may be used in repetition with appropriate legends or in conjunction with other construction signs.




W20-3
48" x 48"

ADVANCE ONE LANE ROAD SIGN (W20-4)

The One Lane Road sign is used only in advance of a point where traffic in both directions must use a single lane. It carries the legend ONE LANE ROAD () FT., or ONE LANE ROAD () MILE. It may be used in repetition with appropriate legends or in conjunction with other construction signs.


If the affected one-lane roadway is not visible from one end to the other, or if traffic is such that simultaneous arrivals at both ends occur frequently, flagging procedures or signal control shall be used to control alternate traffic flows. In general, two-way traffic will always be restored at night. Only in special low volume and/or short length situations will a one lane road be left at night unattended.



W20-4
48" x 48"

ADVANCE LANE CLOSED SIGN (W20-5)

The Lane Closed sign is intended for use in advance of a point where one lane of a multiple-lane roadway is closed. It carries the legend RIGHT (LEFT) LANE CLOSED () FT., or RIGHT (LEFT) LANE CLOSED () MILE. It may be used in repetition with appropriate legends or in conjunction with other construction signs.





W20-5
48" x 48"

ADVANCE FLAGGER SIGN (W20-7)

The Flagger sign is used in advance of any point at which a flagger has been stationed to control traffic through a construction or maintenance project. When needed, an appropriate distance message may be displayed on a supplemental plate below the symbol sign. It may be used in repetition with appropriate revisions in the supplemental distance plate or in conjunction with other construction signs.

The word message sign W20-7 with appropriate distances may be used as an alternate to the W20-7a flagger symbol sign.

The sign shall be promptly removed, covered, or turned to face away from the roadway when the flagger is not at the station.

W20-7
36" x 36"
Supplemental Plate
24" x 18"


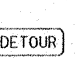

W20-7a
36" x 36"
Supplemental Plate
24" x 18"

DETOUR SIGNS

The Detour Arrow sign (M4-10) is used only at the point where a detour roadway or route has been established due to the closure of a street or highway to through traffic. It should usually be mounted just below the Road Closed sign or the Local Traffic Only sign, normally on top of a Type III barricade.

The Detour Marker (M4-8) mounted on a route marker assembly is to be used to mark a temporary detour route that branches from a regular numbered route; bypasses a section of a route that is closed by construction, or other reasons; and rejoins the regular route beyond that section. The route marker assembly shall include an arrow indicating the direction of the detour.

The Detour sign (M4-9) is to be used for unnumbered routes, or in emergency situations; for periods of short duration, or where it is not necessary to show route markers to guide traffic along to its desired route. A Street Name sign may be placed above or incorporated in the Detour sign to indicate the name of the roadway for which the detour was established.

M4-9 R
M4-9 L
30" x 24"

M4-8
12" x 24"


M4-10 R
M4-10 L
48" x 18"

Background - Black
Arrow - Orange
Legend - 6" Series D

ROAD CLOSED SIGN (R11-2)

The Road (Street) Closed Sign shall be used where the road is closed to all traffic except contractors' equipment and officially authorized vehicles. It should be erected at or near the center of the roadway above a Type III barricade. The words BRIDGE, OUT may be substituted for ROAD CLOSED where applicable. It shall have a standard minimum size of 48 in. by 30 in.

The Road Closed sign shall not be used where traffic is maintained or where the actual closure is some distance beyond the sign and local traffic is permitted access to nearer points.



R11-2
48" x 30"



Background - White
Legend & Border - Black
Legend - 8" Series D

ROAD MACHINERY AHEAD SIGN (W21-3)

The Road Machinery sign shall be used in areas where heavy road equipment such as a grader is operating in or closely adjacent to the roadway.

FRESH OIL SIGN (W21-2)

The Fresh Oil or Fresh Tar sign shall be used to warn motorists that resurfacing operation have rendered the surface of the pavement temporarily hazardous and that objectionable splashing on vehicles may occur.





W21-3
36" x 36"
Legend 5" Series D

W21-2
30" x 30"
Legend 6" Series D

ROAD WORK AHEAD SIGN (W21-4)

The Road Work sign is intended for use in advance of maintenance or minor reconstruction operations in the roadway.





W21-4
36" x 36"
Legend 5" Series D

SHOULDER WORK AHEAD SIGN (W21-5)

The Shoulder Work sign is intended for use in advance of maintenance or minor reconstruction operations involving the shoulder, where the travelway remains unobstructed.

SURVEY CREW SIGN (W21-6)

The Survey Crew sign is intended for use in advance of a point where a surveying party is working in or closely adjacent to the roadway.

W21-5
30" x 30"
Legend 5" Series C



W21-6
30" x 30"
Legend 5" Series D

LENGTH OF CONSTRUCTION SIGN (G20-1)

The Length of Construction sign shall be erected at the beginning of any major road construction or maintenance job of more than 2 miles in length. Where traffic is maintained through the job it carries the legend ROAD CONSTRUCTION NEXT () MILES. Ordinarily it should be mounted on top of a Type III barricade. The project length shall be approximated only to the nearest tenth of a mile.

END CONSTRUCTION SIGN (G20-2)

The End Construction Sign shall be erected approximately 500 feet beyond the end of a major construction or maintenance job to indicate the limits of any restrictions or special precautions that have been imposed.

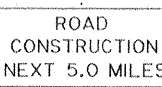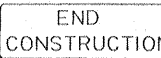
G20-1
60" x 36"

G20-2
60" x 24"

Legend - 6" Series C

LOCAL TRAFFIC ONLY SIGN (R11-3)

The Local Traffic Only sign shall be used where through traffic must detour to avoid a closing of the highway of a construction or maintenance job some distance beyond but where the highway is open for traffic up to the point of closure. It carries the legend ROAD CLOSED () MILES AHEAD - LOCAL TRAFFIC ONLY. It should be erected at both sides of the roadway above a Type III barricade. Normally it will be accompanied by a detour arrow sign indicating the proper route for through traffic. The words BRIDGE, OUT may be substituted for ROAD CLOSED where applicable. Where the sign faces through traffic it shall be preceded by an advance road closed sign with the secondary legend ahead and if applicable an advance detour sign. The distance from the sign to the road closure shall be approximated to the nearest tenth of a mile.

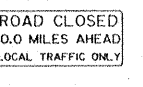

R11-3
60" x 30"

Background - White
Legend & Border - Black
Legend - Line 1 - 6" Series C
Line 2 - 5" Series C
Line 3 - 4" Series C

SPEED LIMIT SIGN



Preexisting speed limits shall at no time be increased during construction and shall remain in effect, except when reduced or hereby indicated.

A reduced speed limit of 45 MPH shall be used where shown on plans and may be used at locations within the project limits where construction activities have altered the roadway below original conditions, or where work is in progress and/or equipment is in the immediate vicinity of the travelway. The speed limit can be reduced to 20 MPH if workers are in close proximity to traffic. Preexisting signs exceeding the construction speed limit shall be removed or covered.

Reduced speed limits should begin approximately 750 ft. (275 ft. in urban areas) in advance of the point of actual need, and be removed or covered when not required. Reduced speed limits shall also be posted at or just beyond any important access point.

The reduced speed zone shall be terminated by erecting a speed limit sign showing the original speed limit. Work zones separated by less than 1/2 mile shall be considered as a single zone and be continuously posted.

The "Speed Zone Ahead" sign shall be erected in advance of each reduced speed zone signs within a construction area.

R2-5c
24" x 30" Standard
48" x 60" on Interstate and Freeways


R2-1
24" x 30" Standard
48" x 60" on Interstate and Freeways

Background - White
Legend & Border - Black
Legend - Line 1, 2 & 3
6" Series C

Background - White
Legend & Border - Black
Legend - Line 1 & 2
4" Series E
Line 3 - 10" Series E

TWO WAY TRAFFIC SIGN (W6-3)


The Two Way Traffic Sign is intended for use where a roadway designed or normally used for one way traffic is temporarily being used for traffic in both directions or where under any circumstance it may be necessary to remind drivers that they are traveling on a two way roadway. The sign should be posted at intervals of about one-half mile but not exceeding one mile. Speed care must be taken to place it at or just beyond any important access points.

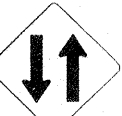

W6-3
48" x 48"

SIDE ROAD CONSTRUCTION AHEAD SIGN

The Side Road Construction Ahead sign is intended for use in advance of an intersection where the road construction project on the side roadway approach terminates at the crossing. No construction activity shall be on the through roadway.



36" x 36"
Legend 5" Series C



DO NOT PASS SIGN (R4-1)

The Do Not Pass sign may be used on a two or three-lane road, at the beginning of, and at intervals of 1500' within a work zone through which restricted sight distance or other conditions makes overtaking and passing hazardous. Where standard pavement markings are present, the sign need not be used. However, the sign may be used in addition to the pavement markings to emphasize the restriction on passing.

Because a driver about to pass often has only a restricted view to the right, consideration should be given to placing a sign on the left-hand side of the roadway. The No Passing Zone sign (W14-3) placed on the left-hand side of two-way roadways, should be considered as a supplement to the enforceable no-passing zone control, which is the regulatory marking and/or the regulatory Do Not Pass sign.

PASS WITH CARE SIGN (R4-2)

The Pass With Care sign should be used at the end of a no-passing zone where a Do Not Pass sign has been erected of the beginning of the zone. It shall be of the same size and erected in the same manner as the Do Not Pass sign.

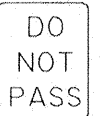R4-1
24" x 30"



R4-2
24" x 30"

Background - White
Legend & Border - Black
Legend - 6" Series D

Background - White
Legend & Border - Black
Legend - 6" Series D

ONE WAY SIGNS

The One Way Sign shall be used to indicate streets or roadways upon which vehicular traffic is allowed to travel in one direction only. The vertical design has advantage where lateral space is limited. Both designs may use either right or left arrows.

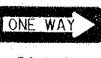R6-1 L
R6-1 R
36" x 12"


R6-2 L
R6-2 R
18" x 24"

Background - Black
Legend - Black
Arrow - White
Legend - 4" Series D

Background - White
Legend & Border - Black
Legend - 5" Series D

ADVISORY SPEED PLATES (W13-1)

In conjunction with any warning sign an advisory speed plate may be used to indicate a maximum recommended speed through a hazardous area. Except in emergencies an advisory speed plate shall not be erected until the recommended speed has been determined by the traffic engineer. Advisory speeds greater than the posted speed limit shall not be used.





W13-1
18" x 18"

Line 1 - 8" Series E
Line 2 - 3" Series E

SOFT SHOULDER SIGN

The soft shoulders and/or the low shoulders signs shall be used when in the opinion of the project engineer the shoulder of the highway under construction becomes hazardous to traffic.


WB-4
30" x 30"

WB-9
30" x 30"


Legend 5" Series C

NOTE:
All signs on this sheet shall have orange backgrounds with black legends and borders, except where otherwise specified.

STANDARD PLAN NO.	HS-01	1 OF 3
STANDARD PLAN HIGHWAY SIGN AND BARRICADE DETAILS FOR CONSTRUCTION PROJECTS		
STATE OF LOUISIANA DEPARTMENT OF TRANSPORTATION AND DEVELOPMENT		
DESIGNED	A. Cozart	TRACED
CHECKED	D. Beatty	CHECKED
APPROVED	[Signature]	DATE 9-18-99

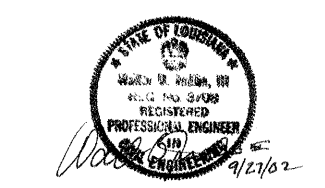

DAW29-00-B-0094
AS BUILT PLANS
DATE RECEIVED 3/15/02
DATE TRACINGS CORRECTED 4/18/02

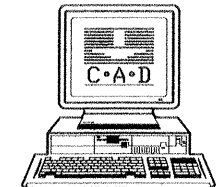

U.S. ARMY ENGINEER DISTRICT, NEW ORLEANS
CORPS OF ENGINEERS
NEW ORLEANS, LOUISIANA

BOARD OF LEVEE COMMISSIONERS
ORLEANS LEVEE BOARD
NEW ORLEANS, LOUISIANA

HARTMAN ENGINEERING, INC.
CONSULTING ENGINEERS
KENNER, LOUISIANA






LAKE PONTCHARTRAIN, LA. AND VICINITY
HIGH LEVEL PLAN
ORLEANS AVENUE OUTFALL CANAL
PHASE 1B
ORLEANS PARISH
LOUISIANA

ROBERT E. LEE BOULEVARD BRIDGE
HWY. SIGN AND BARRICADE DETAILS FOR CONSTRUCTION

DESIGNED BY:	DATE:	PLOT SCALE:	PLOT DATE:
DRAWN BY:	MAR. 8, 2000	1	MARCH 8, 2000
CHECKED BY:	CADD FILE:	SH157.DGN	FILE NO.
SUBMITTED BY:	SOLICITATION NO.	DAW29-00-B-0094	H-4-44776
HARTMAN ENGINEERING DESIGN ENGINEER	DATE:	DATE:	DWG. 57 OF 59

Safety is a Part
of Your Contract



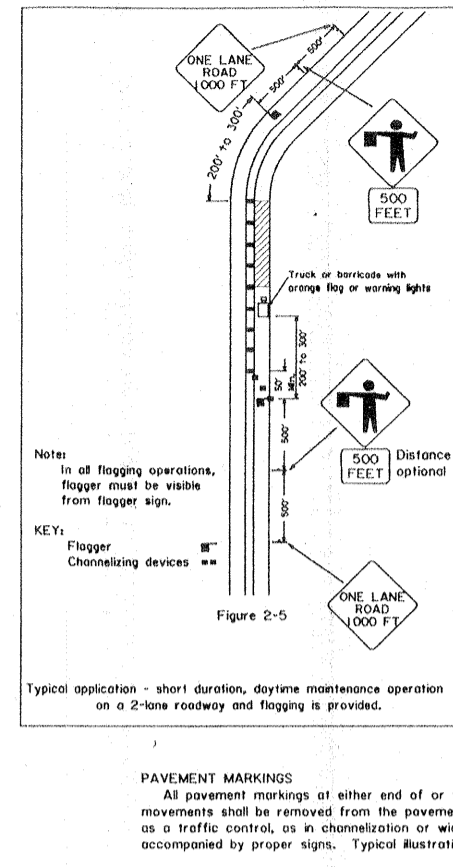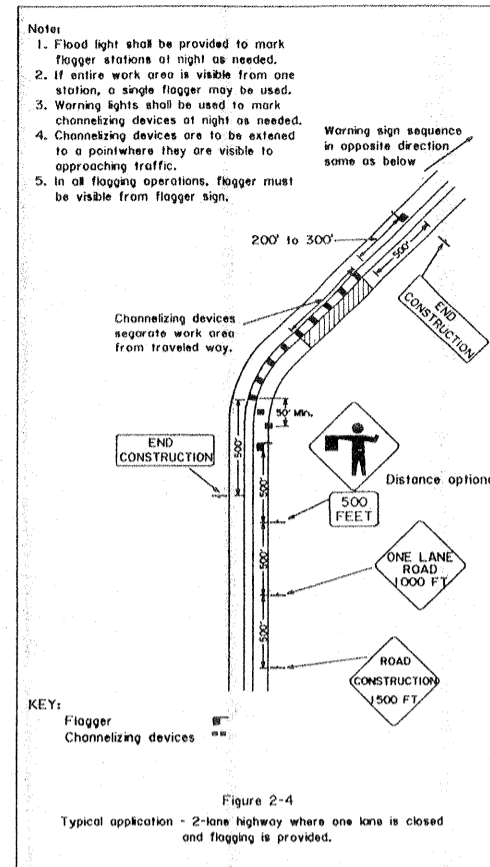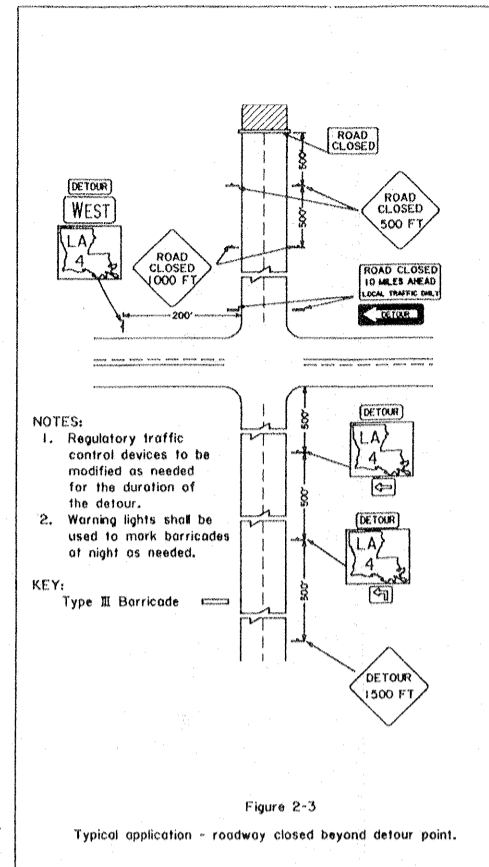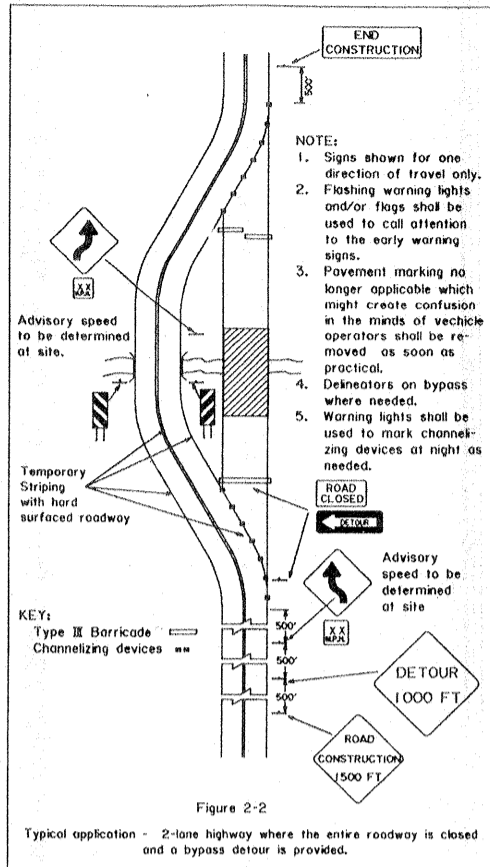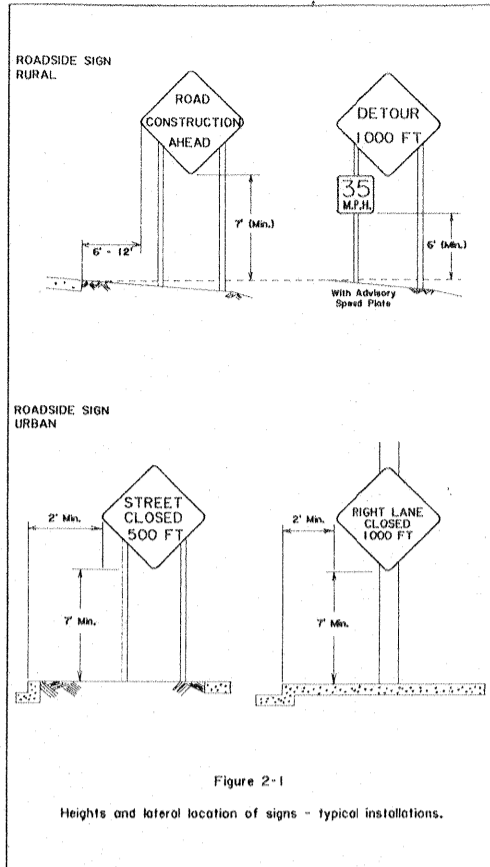

STATE PROJECT	PARISH	SHEET NO.
---------------	--------	-----------

NOTES:

GENERAL

- All signs and pavement markings herein shall be in accordance with the current edition of the "Louisiana Manual on Uniform Traffic Control Devices."
- No traffic controls shall be erected until construction work is about to begin and with the authorization of the Project Engineer.
- Responsibility is hereby placed upon the contractor for the erection and maintenance of all markings, signs and barricades called for in these plans or required by the Project Engineer for the protection of the traveling public or construction personnel. The contractor shall also be responsible for the maintenance or refurbishing, if necessary, of all permanent signs and pavement markings that should be left in place as essential to the safe movement and guidance of traffic within the limits of the project.
- All retroreflective devices such as signs, drums, barricades, vertical panels, delineators of any type, etc., shall be cleaned or washed periodically, to maintain their effectiveness, as required by conditions of the Project Engineer.
- Where a construction project involves a number of road segments remote from each other, only those segments where actual work is in progress shall be signed. Upon completion of any segment, construction signing shall be removed and replaced with permanent signing.
- When different projects are next to each other, or separated by less than one mile, they shall be considered as one project for construction signing purposes, and all advance signing of the project shall be eliminated, except for any signing that the Project Engineer might require due to site conditions.
- Signs shown in all illustrations are typical and may vary with each specific condition. Other signs from sheet one (1) more appropriate for the specific condition may be substituted in any of the above illustrations upon approval by the Project Engineer. However, the required number of such signs shall in general be constant.
- Taper Length (L) Formula
 $L = S \times W$ for speed limit ≥ 45 MPH
 $L = \frac{W^2}{60}$ for speed limit < 40 MPH
 where:
 L = minimum length of taper
 S = numerical value of posted speed limit prior to work or 85th percentile speed
 W = width of offset
- Spacing of channelizing devices such as cones, panels, drums, and Type I or II barricades shall not exceed a distance in feet equal to the speed limit when used for taper channelization and a distance in feet of twice the speed limit when used for tangent channelization.

PAVEMENT MARKINGS

All pavement markings at either end of or within the limits of the project that are in conflict with the project signing or the required traffic movements shall be removed from the pavement by abrasion. If, in the opinion of the project engineer, special pavement markings are needed as a traffic control, as in channelization or width transitions, they shall be reflective, removable, temporary lane marking tape and should be accompanied by proper signs. Typical illustrations are shown in the "Louisiana Manual of Uniform Traffic Control Devices."

SIGN MATERIALS

The backing material used in the fabrication and erection of construction signs shall be in accordance with Subsection 1015.04(b) of the Standard Specifications as revised by project specifications. Signs shall normally be mounted on two posts, except speed limit signs, chevrons and other similar signs, which shall be mounted on one post. A minimum of two bolts per post shall be used. Reflectization of signs and barricades shall be by means of materials that conform to the requirements of Subsection 1015.05(e) of the Standard Specifications as revised by project specifications. If support posts should be spliced, the splice should be no higher than 15" above the ground. All materials and their application shall meet Department Specifications.

REMOVAL OF SIGNS

At no time shall signs warning against a particular hazard or operation be left in place when the operation is not in progress, or where the hazard has been removed. On part-time operations, signs such as "Truck Crossing," "Men Working," etc., shall be removed or set aside out of view of traffic when the operation is not in progress. When construction operations change, signing must change accordingly; all conflicting signs from previous operations must be removed or covered as new signs are erected.







COVERING OF SIGNS

Signs shall be covered with a strong, lightweight, completely opaque material, shaped or formed so as to cover all of the legend on the face of the sign. The covering shall be securely fastened so as to prevent its accidental removal by wind or other causes. The covering material shall be non-reflective and of a neutral shade, or black. Burlap cloth, cardboard, or paper are not acceptable materials. Signs that might obscure other construction signs shall be removed not covered.


LIGHTING

Lighting shall supplement all barricades that close one or more lanes or that extend across a highway. At least two high intensity lights will be used but, where the travelway ends immediately after a barricade, a minimum of four lights shall be used. Lighting shall be by approved electrical installations. Where battery operated equipment is used, it shall conform to specifications for high or low intensity, flashing or steady burning lights as set forth in subsection 1018.12 of the Standard Specifications.

- High intensity flashing lights shall be used to mark the first advance warning sign.
- Low intensity flashing lights shall be used to mark all other hazards of the travelway.
- Steady burning lights shall be used on all traffic control devices used for channelization.

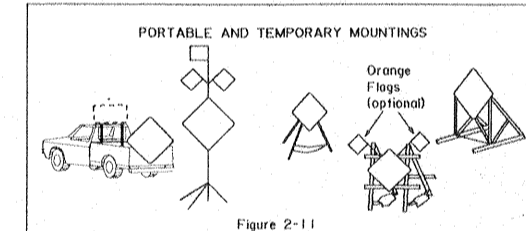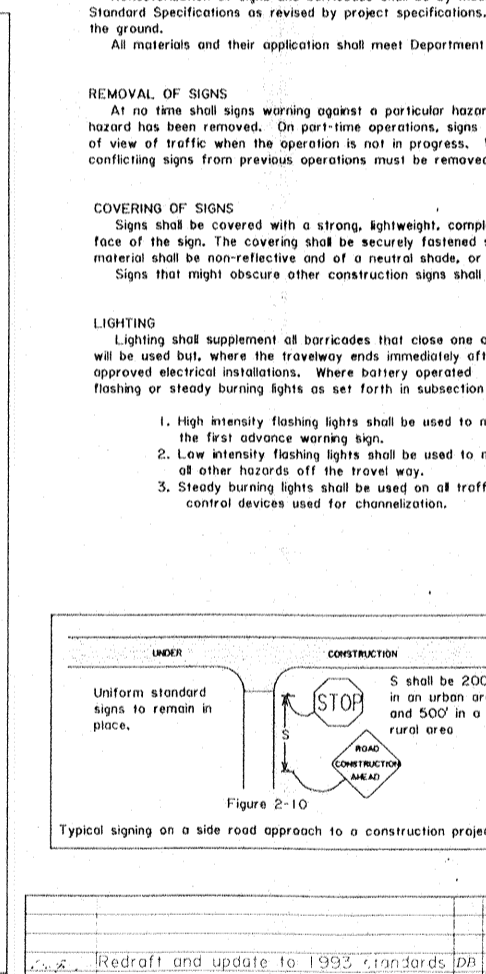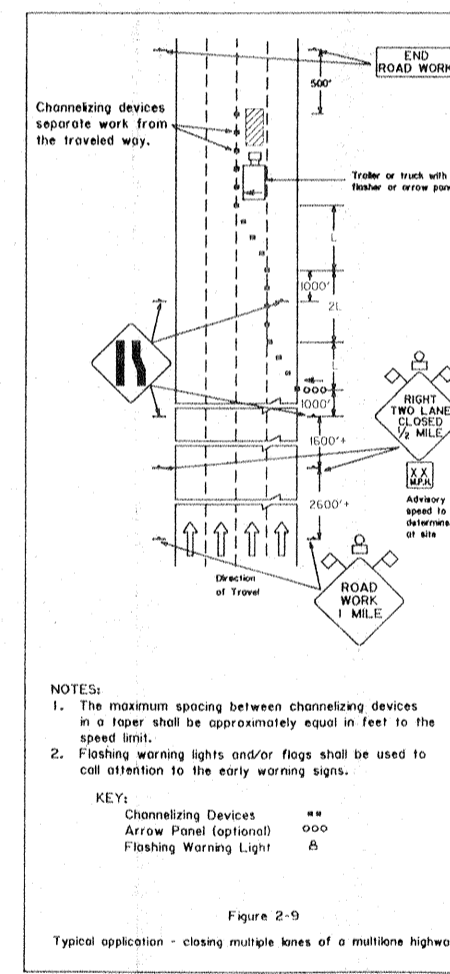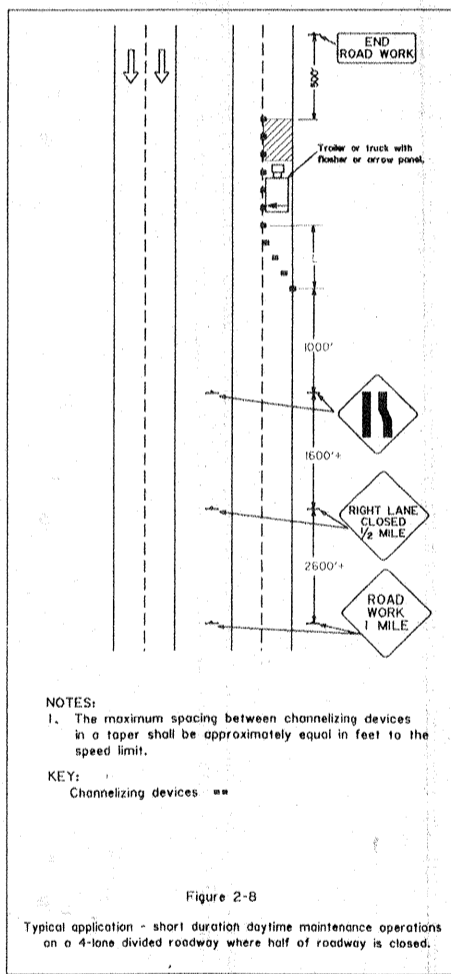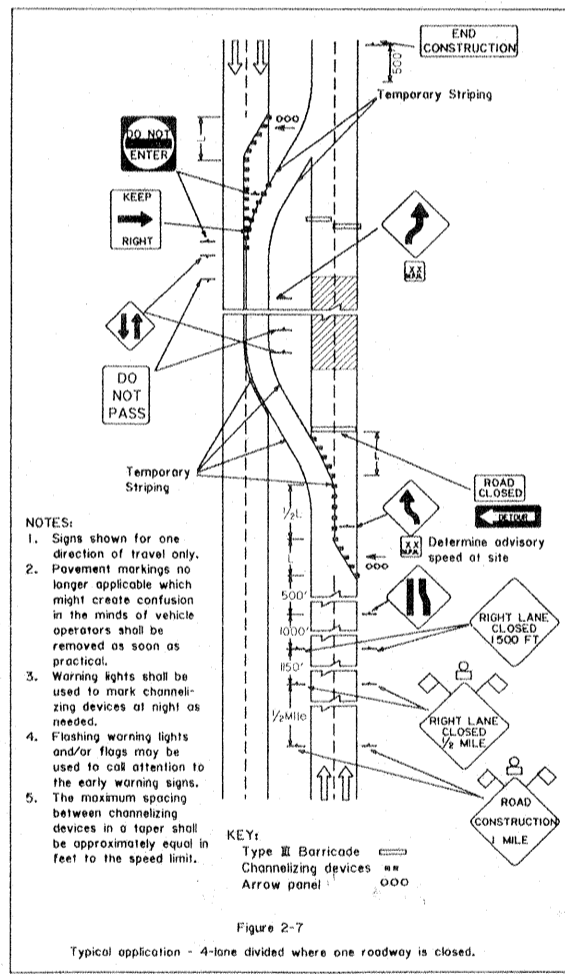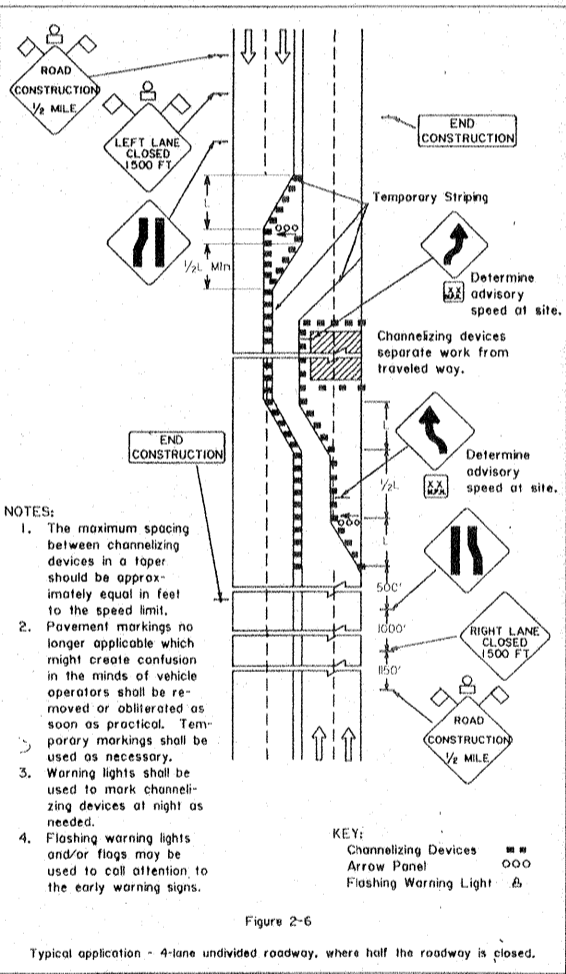


STANDARD PLAN NO.	HS-01	2 OF 3
STANDARD PLAN HIGHWAY SIGN AND BARRICADE DETAILS FOR CONSTRUCTION PROJECTS		
DATE: _____		
STATE OF LOUISIANA DEPARTMENT OF TRANSPORTATION AND DEVELOPMENT		
DESIGNED A Coates	DETAILED D Easley	TRACED W.J.M.Jr.
CHECKED D Easley	CHECKED A Coates	CHECKED _____
APPROVED _____		DATE 9/18/99
CHIEF ENGINEER		

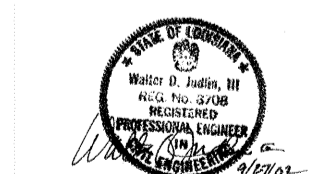

DACW29-00-B-0094

AS BUILT PLANS
DATE RECEIVED 3/15/02
DATE TRACINGS CORRECTED 4/18/02

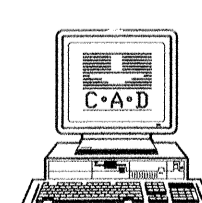

U.S. ARMY ENGINEER DISTRICT, NEW ORLEANS
CORPS OF ENGINEERS
NEW ORLEANS, LOUISIANA

BOARD OF LEVEE COMMISSIONERS
ORLEANS LEVEE BOARD
NEW ORLEANS, LOUISIANA


HARTMAN ENGINEERING, INC.
CONSULTING ENGINEERS
KENNER, LOUISIANA

LAKE PONTCHARTRAIN, LA. AND VICINITY
HIGH LEVEL PLAN
ORLEANS AVENUE OUTFALL CANAL
PHASE 1B
ORLEANS PARISH
LOUISIANA

ROBERT E. LEE BOULEVARD BRIDGE
HWY. SIGN AND BARRICADE DETAILS FOR CONSTRUCTION

DESIGNED BY:	DATE:	PLOT SCALE:	PLOT DATE:
DRAWN BY:	MAR. 8, 2000	1	MARCH 8, 2000
CHECKED BY:	CADD FILE: SH15B.DGN		FILE NO.
			H-4-44776
SUBMITTED BY:	SOLICITATION NO.		DWG. 58 OF 59
HARTMAN ENGINEERING DESIGN ENGINEER	DACW29-00-B-0094		

Safety is a Part
of Your Contract

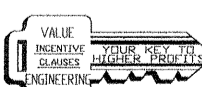

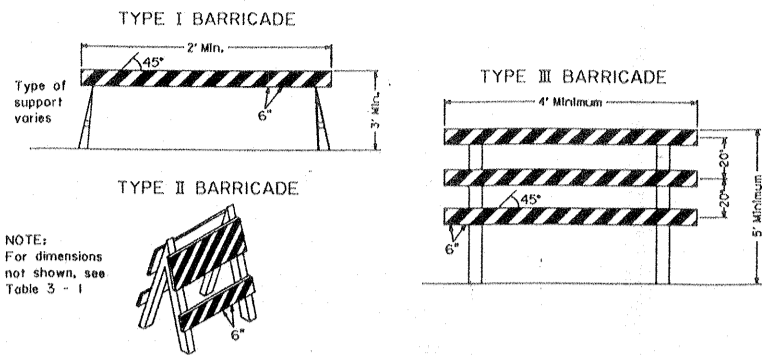


Figure 3 - 1
Standard Barricades

Barricade Design

A barricade is a portable or fixed device having from one to three rails with appropriate markings used to control traffic by closing, restricting or detouring all or a portion of the right-of-way.

Barricades shall be one of three types: Type I, Type II, or Type III; as shown in Figure 3 - 1 and Table 3 - 1.

Stripes on barricade rails shall be alternate orange and white reflective stripes (sloping downward at an angle of 45° in the direction traffic is to pass). The stripes shall be 6 inches wide except where rail lengths are less than 36 inches, then 4 inch wide stripes may be used. The minimum rail length is 24 inches. The entire area of orange and white shall be reflectorized using encapsulated lens reflective sheeting which will display the same approximate size, shape and color day and night, conforming to Subsection 1015.05(e) of the Standard Specifications. The predominant color for other barricade components shall be white, except that unpainted galvanized metal or aluminum components may be used. Barricades used on expressways, freeways, and other high-speed roadways shall have a minimum of 270 square inches of reflective area facing traffic.

When a barricade extends entirely across a roadway, the stripes should slope downward in the direction toward which traffic must turn in detouring. Where both right and left turns are provided, the chevron striping may slope downward in both directions from the center of the barricade.

Barricade rails should be supported in a manner that will allow them to be seen by the motorist and provide a stable support not easily blown over by the wind or traffic. For Type I barricades, the support may include other unstriped horizontal panels necessary to provide stability. The name of the agency, contractor, or support shall not be shown on the face parts of any barricade. Identification markings may be shown only on the back side of barricade rails.

Barricades are located adjacent to traffic and therefore subject to impact by errant vehicles. Because of their vulnerable position and the possible hazard they could create, they should be constructed of lightweight materials and have no rigid stay bracing for A-frame designs.

Barricade Application

Type I or Type II barricades are intended for use in situations where traffic is maintained through the area being constructed and/or reconstructed. They may be used singly or in groups to mark a specific hazard or they may be used in a series for channelizing traffic. Type I barricades would normally be used on conventional roads or urban streets and arterials. Type II barricades have more reflective area, and are intended for use on expressways and freeways or other high speed roadways.

On high speed expressways or in other situations where barricades may be susceptible to overturning in the wind, sandbags should be used for ballasting. Sandbags may be placed on lower parts of the frame or stays to provide the required ballast but shall not be placed on top of any striped rail. Barricades shall not be ballasted by solid objects such as rocks or chunks of concrete.

When maintenance activities are being performed, the roadway condition seldom requires a complete closing of the facility. Where such a condition does occur, it is almost always an emergency situation, as would result from a broken water main or a washed-out culvert. This type of repair work is generally initiated on an emergency basis and the street or road closure should be accomplished with Type I barricades.

On construction projects, where a road section is closed to traffic, Type III barricades shall be erected at the points of closure. They may extend completely across a roadway and its shoulders or from curb to curb. Where provisions must be made for access of equipment and authorized vehicles, the Type III barricades shall be provided with gates or movable sections that can be closed when work is not in progress, or with indirect openings that will discourage public entry. Where access is provided through the Type III barricades, responsibility shall be assigned to a person to assure proper closure at the end of each working day.

When a road or street is legally closed, but access must still be allowed for local traffic, the Type III barricade cannot be extended completely across a roadway. A sign with the appropriate legend concerning permissible use by local traffic shall be mounted above the barricade.

Wing barricades are a special application of Type II barricade, erected on the roadway shoulder (on one or both sides of the pavement) to give the illusion of a narrowed or restricted roadway.

Type III barricades may be used as a mounting for regulatory signs, guide signs or lighting devices. The Road Closed signs, Detour Arrow signs, and the Large Arrow warning signs, for example, can effectively be mounted above the barricade that closes the roadway.

Construction and maintenance zones often encroach on sidewalks or crosswalks necessitating provisions for alternate routing. Where it is not possible to close a path and divert the pedestrians to other walkways, barricades may be used to define the path. Warning lights shall be used on sidewalk barricades in accordance with the following paragraph; however, where high levels of illumination exist for sidewalk areas, extra lighting may not be needed.

For nighttime use of any type of barricade, add flashing warning lights when barricades are used singly, and steady burn lights when barricades are used in a series for channelization.

Table 3 - 1
Barricade Characteristics

Type*	I	II	III
Minimum Width of Rail	8 in.	8 in.	8 in.
Maximum Width of Rail	12 in.	12 in.	12 in.
Minimum Length of Rail	2 ft.	2 ft.	4 ft.
Width of Stripes**	6 in.	6 in.	6 in.
Minimum Height	3 ft.	3 ft.	5 ft.
Number of Reflectorized Rails facing one direction of traffic	1	2	3

* For wooden barricades nominal lumber dimensions will be satisfactory
** For rails less than 3 feet long, 4 inch wide stripes shall be used

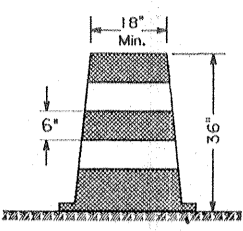


Figure 3 - 4
DRUM

Drum Design

Drums used for traffic warning or channelization shall be made of plastic and shall be as per the qualified product list. Drums shall be approximately 36 inches in height and a minimum of 18 inches in diameter. The markings on drums shall be horizontal, circumferential, alternating orange and white reflectorized stripes 6 inches wide, using a material that has a smooth, sealed outer surface which will display the same approximate size, shape and color day and night, conforming to Subsection 1015.05(e) of the Standard Specifications. There shall be at least two orange and two white stripes on each drum with the top stripe being orange. If there are nonreflectorized spaces between the horizontal orange and white stripes, they shall be no more than two inches wide. Drums shall have closed tops which will not allow collection of construction or other debris.

Drum Application

Drums are most commonly used to channelize or delineate traffic flow but may also be used singly or in groups to mark specific hazards. Drums are highly visible and have good target value, giving the appearance of being formidable obstacles and, therefore, command the respect of drivers. They are portable enough to be shifted from place to place within a construction project in order to accommodate changing conditions, but are generally used in situations where they will remain in place for a prolonged period of time. When drums are placed in the roadway, appropriate advance warning signs shall be used.

Drums should not be weighted with sand, water, or any other material to the extent that would make them hazardous to motorists, pedestrians, or workers; a typical ballast would be a 25 pound bag of sand placed on the base of the drum. When they are used in regions susceptible to freezing, they should have drain holes in the bottom so water will not accumulate and freeze, causing a hazard if struck by a motorist. Ballast shall not be placed on top of the drum. Drums shall not be ballasted with solid objects such as rocks or pieces of concrete.

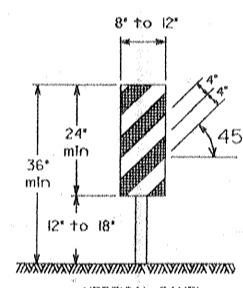


Figure 3 - 5
VERTICAL PANEL

Vertical Panel Design

Vertical panels shall be 8 to 12 inches in width and at least 24 inches in height. They shall have orange and white stripes reflectorized with the same material as drums. Panel stripe widths shall be 6 inches except where panel heights are less than 36 inches, then 4 inch stripes may be used. If used for two-way traffic, back-to-back panels shall be used.

Stripes for vertical panels shall slope downward at an angle of 45° in the direction traffic is to pass. Vertical panels used on expressways, freeways, and other high speed roadways shall have a minimum reflective area of 270 square inches facing traffic.

Vertical Panel Application

Vertical panels may be used to channelize traffic, divide opposing lanes of traffic, divide traffic lanes when two or more lanes are kept open in the same direction and in place of barricades where space is limited.

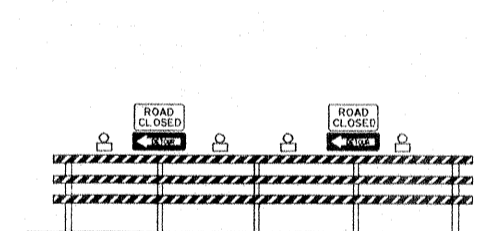


Figure 3 - 2
Barricade closing a road

Application of Barricades - Where a road is closed to traffic, Type III barricades shall be erected at the points of closure, and shall extend across the roadway to a minimum of 2 ft. from each edge. To further discourage public motorists gaining access through the construction site by removing the barricades, the Type III barricades shall be anchored to the existing roadway if necessary.

Figure 3 - 2 shows a typical closure of a two-lane roadway. Four high intensity flashing warning lights shall be placed on the barricade as shown above. If only one lane of the travel-way is closed by a barricade, two lights shall be used.

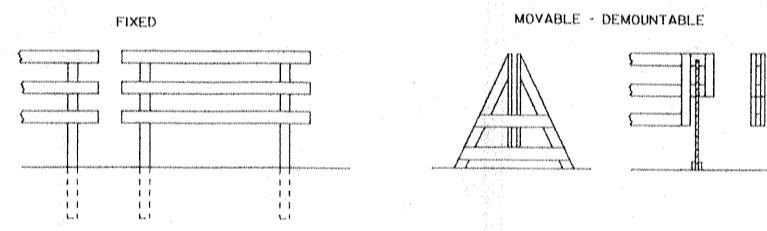


Figure 3 - 3
Type III barricade construction - Typical examples

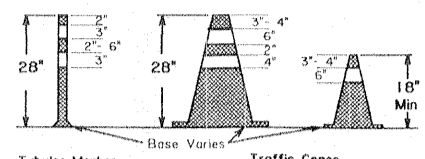


Figure 3 - 6

Tubular Marker Design

Tubular markers shall be predominantly orange, not less than 18 inches high and not less than 2 inches wide when viewed from any direction, and shall be made of a material that can be struck without damaging impacting vehicles. Tubular markers shall be a minimum of 28 inches high when they are used on freeways and other high-speed roadways and on all facilities during hours of darkness, or whenever more conspicuous guidance is needed.

For nighttime use, tubular markers shall be reflectorized. Reflectorization of tubular markers shall be provided by two, 3 inch wide white bands placed a maximum of 2 inches from the top of the marker, with a maximum of 6 inches between the bands. Reflectorized material shall conform to Subsection 1015.05(e) of the Standard Specifications.

Tubular Marker Application

Tubular markers have less visible area than other devices and shall generally be used in situations where space restrictions do not allow the use of more visible devices. They may be used to divide opposing traffic lanes, divide traffic lanes when one or more lanes are kept open in the same direction, and to delineate edge of pavement dropoff where space limitations do not allow the use of larger devices.

Steps should be taken to ensure that tubular markers will not be blown over or displaced by wind or moving traffic. Effective steps include affixing them to the pavement with anchor bolts or adhesive, using weighted bases or weighted rings that can be dropped over the marker. Ballast, however, should not create a hazard if the markers are inadvertently struck. If a non-cylindrical device is used, and it could be displaced with a width less than the minimum facing traffic, it shall be attached to the pavement.

Cone Design

Cones shall be predominantly orange, not less than 18 inches high, and shall be made of a material that can be struck without damaging impacting vehicles. Cones shall be a minimum of 28 inches high when they are used on freeways and other high-speed roadways and on all facilities during hours of darkness, or whenever more conspicuous guidance is needed.

For daytime use only, an 18 inch high cone may be reflectorized by placing a 6 inch wide white band 3 to 4 inches down from the top of the cone. For nighttime use, cones shall be reflectorized or equipped with lighting devices for maximum visibility. Reflectorization of 28 inch cones shall be provided by a white band 6 inches wide placed 3 to 4 inches from the top of the cone, and an additional 4 inch wide white band 2 inches below the 6 inch band. Reflectorized material shall have a smooth, sealed outer surface which will display the same approximate color day and night, and shall meet the requirements of Subsection 1015.05(e) of the Standard Specifications.

Cone Application

Traffic cones are used to channelize traffic, divide opposing traffic lanes, divide traffic lanes when two or more lanes are kept open in the same direction, and shall basically be used for emergency situations, or short term operations that require rapid deployment and removal of channelizing devices.

Steps should be taken to ensure that cones will not be blown over or displaced by wind or moving traffic. Cones can be doubled up to increase their weight; some cones are constructed with bases that can be filled with ballast, or can be weighted by dropping rings over the cone. Ballast, however, should not present a hazard if the cones are inadvertently struck.

STATE PROJECT	PARISH	SHEET NO.
---------------	--------	-----------

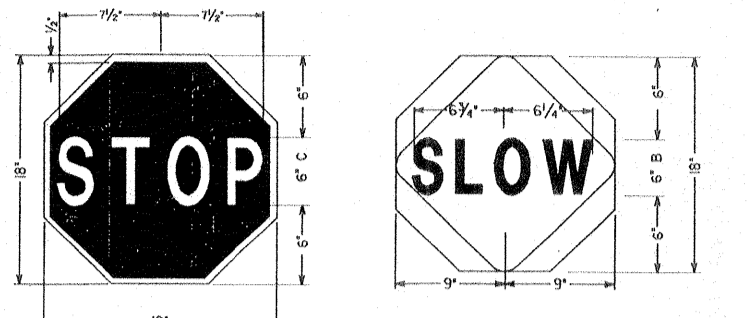


Figure 3 - 7
Details of hand sign

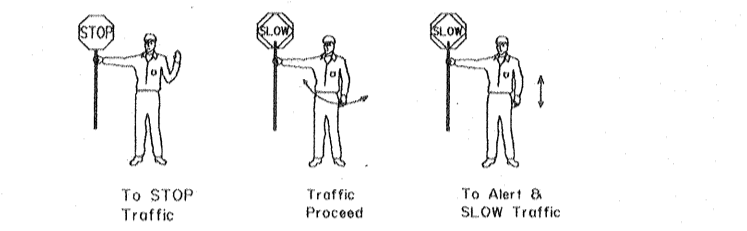


Figure 3 - 9
Use of Hand Sign

A flagger equipped with a sign paddle shall be stationed where construction operations require two-way traffic to use a single lane, where moving equipment enters or crosses the travelway, and well in advance of blasting or any other hazardous operation requiring the absolute control of traffic. Flagger stations shall be located in a highly visible location in advance of the work zone. The distance before the work zone should allow motorists to safely decelerate and is thus related to the approach speeds and physical conditions of the site. 200 to 300 feet is desirable in most situations. In urban areas, where speeds are low and streets are closely spaced, the advance distance should be decreased. The hand sign (Fig 3-7) gives drivers more positive guidance than flags, and shall be the primary hand signaling device. The sign paddle shall be provided with a rigid handle and a secure mounting as shown.

The following standard procedure shall be followed by flaggers:

- (A) Stand adjacent to the travelway, never in the travelway.
- (B) Stand alone. Never permit a group of workers to congregate around or obscure the flagger.
- (C) Be courteous in explaining the reason for the delay and in issuing instructions to motorists.
- (D) Reasonable efforts should be made to allow drivers the right-of-way and to prevent excessive delays.
- (E) Flaggers shall wear an orange vest, an orange cap shall be optional.
- (F) For night operations all signs and clothing shall be reflectorized, flagging stations should be illuminated, and flaggers should be equipped with a bright red light.
- (G) Use the following motions to direct traffic (Figure 3-9):
 1. To STOP traffic. Face traffic with STOP sign paddle in a stationary position, with arm extended horizontally from the body. Raise the free arm with the palm facing traffic.
 2. Traffic Proceed. Face traffic with SLOW sign paddle in a stationary position, with arm extended horizontally from the body. Use the free arm to motion traffic ahead.
 3. To Alert or SLOW Traffic. Face traffic with SLOW sign paddle in a stationary position, with arm extended horizontally from the body. Move the free arm up and down.

DATE	DESCRIPTION	BY	APPROVED
	Reprint and update to 1993 standards DW		

STANDARD PLAN NO.	HS-01	SHEET	3 OF 3
STANDARD PLAN HIGHWAY SIGN AND BARRICADE DETAILS FOR CONSTRUCTION PROJECTS			
DATED:			
STATE OF LOUISIANA DEPARTMENT OF TRANSPORTATION AND DEVELOPMENT			
DESIGNED	A. Carver	DETAILED	D. Esely
CHECKED	D. Esely	CHECKED	A. Carver
APPROVED	[Signature]	DATE	9/18/88

U.S. ARMY ENGINEER DISTRICT, NEW ORLEANS
CORPS OF ENGINEERS
NEW ORLEANS, LOUISIANA


BOARD OF LEVEE COMMISSIONERS
ORLEANS LEVEE BOARD
NEW ORLEANS, LOUISIANA

HARTMAN ENGINEERING, INC.
CONSULTING ENGINEERS
KENNER, LOUISIANA

LAKE PONTCHARTRAIN, LA. AND VICINITY
HIGH LEVEL PLAN
ORLEANS AVENUE OUTFALL CANAL
PHASE 1B
ORLEANS PARISH
LOUISIANA


ROBERT E. LEE BOULEVARD BRIDGE
HWY. SIGN AND BARRICADE DETAILS FOR CONSTRUCTION

DESIGNED BY:	DATE:	PLOT SCALE:	PLOT DATE:
DRAWN BY:	MAR. 8, 2000	1	MARCH 8, 2000
CHECKED BY:	CADD FILE:	SHT59.DGN	FILE NO.
SUBMITTED BY:	SOLICITATION NO.	DACW29-00-B-0094	H-4-44776
HARTMAN ENGINEERING DESIGN ENGINEER			DWG. 59 OF 59

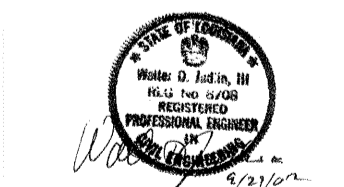



DACW29-00-B-0094

AS BUILT PLANS
DATE RECEIVED 3/15/02
DATE TRACINGS CORRECTED 4/18/02

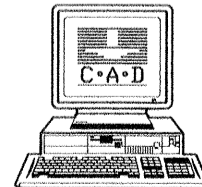

Safety is a Part
of Your Contract

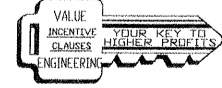

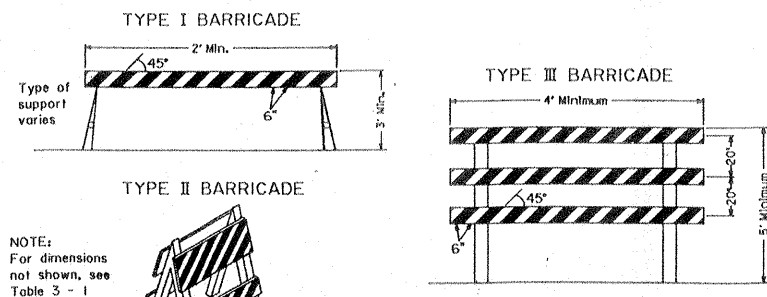

NOTE:
For dimensions not shown, see Table 3-1

Figure 3-1
Standard Barricades

Table 3-1
Barricade Characteristics

Type*	I	II	III
Minimum Width of Rail	8 in.	8 in.	8 in.
Maximum Width of Rail	12 in.	12 in.	12 in.
Minimum Length of Rail	2 ft.	2 ft.	4 ft.
Width of Stripes**	6 in.	6 in.	6 in.
Minimum Height	3 ft.	3 ft.	5 ft.
Number of Reflectorized Rails facing one direction of traffic	1	2	3

* For wooden barricades nominal lumber dimensions will be satisfactory
** For rails less than 3 feet long, 4 inch wide stripes shall be used

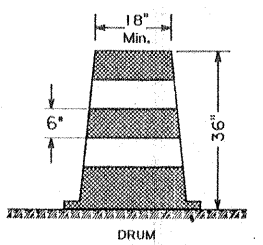


Figure 3-4
DRUM

Drum Design

Drums used for traffic warning or channelization shall be made of plastic and shall be as per the qualified product list. Drums shall be approximately 36 inches in height and a minimum of 18 inches in diameter. The markings on drums shall be horizontal, circumferential, alternating orange and white reflectorized stripes 6 inches wide, using a material that has a smooth, sealed outer surface which will display the same approximate size, shape and color day and night, conforming to Subsection 1015.05(e) of the Standard Specifications. There shall be at least two orange and two white stripes on each drum with the top stripe being orange. If there are nonreflectorized spaces between the horizontal orange and white stripes, they shall be no more than two inches wide. Drums shall have closed tops which will not allow collection of construction or other debris.

Drum Application

Drums are most commonly used to channelize or delineate traffic flow but may also be used singly or in groups to mark specific hazards. Drums are highly visible and have good target value, giving the appearance of being formidable obstacles and, therefore, command the respect of drivers. They are portable enough to be shifted from place to place within a construction project in order to accommodate changing conditions, but are generally used in situations where they will remain in place for a prolonged period of time. When drums are placed in the roadway, appropriate advance warning signs shall be used.

Drums should not be weighted with sand, water, or any other material to the extent that would make them hazardous to motorists, pedestrians, or workers; a typical ballast would be a 25 pound bag of sand placed on the base of the drum. When they are used in regions susceptible to freezing, they should have drain holes in the bottom so water will not accumulate and freeze, causing a hazard if struck by a motorist. Ballast shall not be placed on top of the drum. Drums shall not be ballasted with solid objects such as rocks or pieces of concrete.

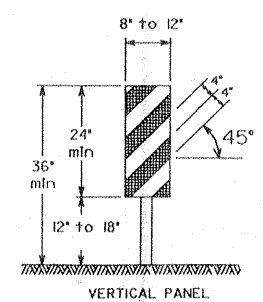


Figure 3-5
VERTICAL PANEL

Vertical Panel Design

Vertical panels shall be 8 to 12 inches in width and at least 24 inches in height. They shall have orange and white stripes reflectorized with the same material as drums. Panel stripe widths shall be 6 inches except where panel heights are less than 36 inches, then 4 inch stripes may be used. If used for two-way traffic, back-to-back panels shall be used.

Strips for vertical panels shall slope downward at an angle of 45° in the direction traffic is to pass. Vertical panels used on expressways, freeways, and other high speed roadways shall have a minimum reflective area of 270 square inches facing traffic.

Vertical Panel Application

Vertical panels may be used to channelize traffic, divide opposing lanes of traffic, divide traffic lanes when two or more lanes are kept open in the same direction and in place of barricades where space is limited.

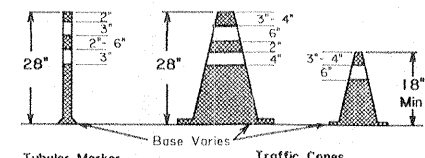


Figure 3-6
Tubular Marker Design

Tubular Marker Design

Tubular markers shall be predominantly orange, not less than 18 inches high and not less than 2 inches wide when viewed from any direction, and shall be made of a material that can be struck without damaging impacting vehicles. Tubular markers shall be a minimum of 28 inches high when they are used on freeways and other high-speed roadways and on all facilities during hours of darkness, or whenever more conspicuous guidance is needed.

For nighttime use, tubular markers shall be reflectorized. Reflectorization of tubular markers shall be provided by two, 3 inch wide white bands placed a maximum of 2 inches from the top of the marker, with a maximum of 6 inches between the bands. Reflectorized material shall conform to Subsection 1015.05(e) for Drums of the Standard Specifications.

Tubular Marker Application

Tubular markers have less visible area than other devices and shall generally be used in situations where space restrictions do not allow the use of more visible devices. They may be used to divide opposing traffic lanes, divide traffic lanes when one or more lanes are kept open in the same direction, and to delineate edge of pavement dropoff where space limitations do not allow the use of larger devices.

Steps should be taken to ensure that tubular markers will not be blown over or displaced by wind or moving traffic. Effective steps include affixing them to the pavement with anchor bolts or adhesive, using weighted bases or weighted rings that can be dropped over the marker. Ballast, however, should not present a hazard if the markers are inadvertently struck. If a non-cylindrical device is used, and it could be deployed with a width less than the minimum facing traffic, it shall be attached to the pavement.

Cone Design


Cones shall be predominantly orange, not less than 18 inches high, and shall be made of a material that can be struck without damaging impacting vehicles. Cones shall be a minimum of 28 inches high when they are used on freeways and other high-speed roadways and on all facilities during hours of darkness, or whenever more conspicuous guidance is needed.

For daytime use only, an 18 inch high cone may be reflectorized by placing a 6 inch wide white band 3 to 4 inches down from the top of the cone. For nighttime use, cones shall be reflectorized or equipped with lighting devices for maximum visibility. Reflectorization of 28 inch cones shall be provided by a white band 6 inches wide placed 3 to 4 inches from the top of the cone, and an additional 4 inch wide white band 2 inches below the 6 inch band. Reflectorized material shall have a smooth, sealed outer surface which will display the same approximate color day and night, and shall meet the requirements of Subsection 1015.05(e) of the Standard Specifications.

Cone Application

Traffic cones are used to channelize traffic, divide opposing traffic lanes, divide traffic lanes when two or more lanes are kept open in the same direction, and shall basically be used for emergency situations, or short term operations that require rapid deployment and removal of channelizing devices.

Steps should be taken to ensure that cones will not be blown over or displaced by wind or moving traffic. Cones can be doubled up to increase their weight. Some cones are constructed with bases that can be filled with ballast, or can be weighted by dropping rings over the cone. Ballast, however, should not present a hazard if the cones are inadvertently struck.

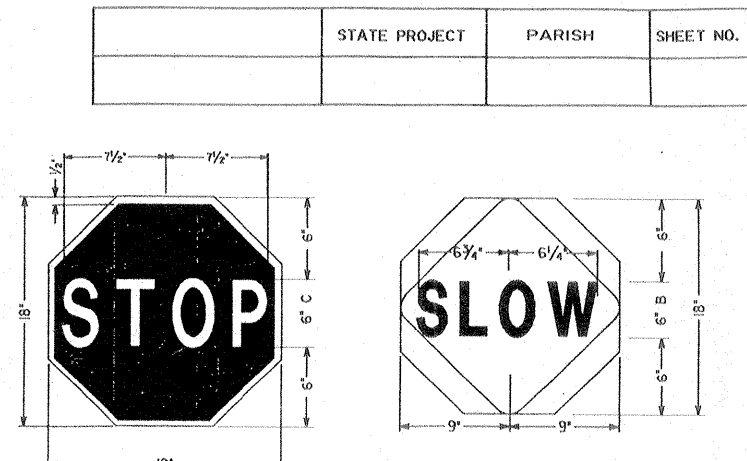

Background - Red
Barricade - White
Legend - 6" Series C
To be made of 0.08 aluminum, or 0.04 tempered aluminum

Background - Orange (reflectorized)
Area outside diamond - Black or Light Blue
Legend - 6" Series B
To be made of 0.08 aluminum, or 0.04 tempered aluminum

Figure 3-7
Details of hand sign

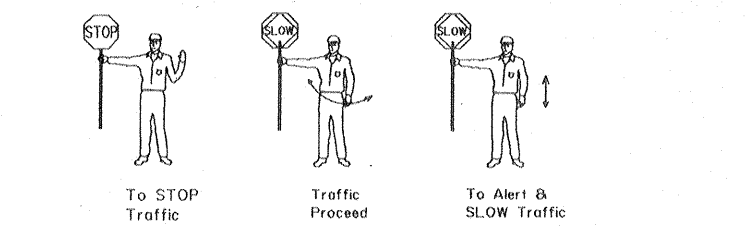


Figure 3-9
Use of Hand Sign

Use of hand signaling devices by flagger

A flagger equipped with a sign paddle shall be stationed where construction operations require two-way traffic to use a single lane, where moving equipment enters or crosses the freeway, and well in advance of blasting or any other hazardous operation requiring the absolute control of traffic. Flagging stations shall be located in a highly visible location in advance of the work zone. The distance before the work zone should allow motorists to safely decelerate and is thus related to the approach speeds and physical conditions of the site. 200 to 300 feet is desirable in most situations. In urban areas, where speeds are low and streets are closely spaced, the advance distance should be decreased. The hand sign (Fig 3-7) gives drivers more positive guidance than flags, and shall be the primary hand signaling device. The sign paddle shall be provided with a rigid handle and a secure mounting as shown.

The following standard procedure shall be followed by flaggers:

- Stand adjacent to the freeway, never in the travelway;
- Stand alone. Never permit a group of workers to congregate around or obscure the flagger;
- Be courteous in explaining the reason for the delay and in issuing instructions to motorists;
- Responsible efforts should be made to allow drivers the right-of-way and to prevent excessive delays;
- Flaggers shall wear an orange vest, an orange cap shall be optional;
- For night operations all signs and clothing shall be reflectorized, flagging stations should be illuminated, and flaggers should be equipped with a bright red light;
- Use the following motions to direct traffic (Figure 3-9):
 - To STOP traffic. Face traffic with STOP sign paddle in a stationary position, with arm extended horizontally from the body. Raise the free arm with the palm facing traffic;
 - Traffic Proceed. Face traffic with SLOW sign paddle in a stationary position, with arm extended horizontally from the body. Use the free arm to motion traffic ahead;
 - To Alert or SLOW Traffic. Face traffic with SLOW sign paddle in a stationary position, with arm extended horizontally from the body. Move the free arm up and down;

Barricade Design

A barricade is a portable or fixed device having from one to three rails with appropriate markings used to control traffic by closing, restricting or delineating all or a portion of the right-of-way.

Barricades shall be one of three types: Type I, Type II, or Type III, as shown in Figure 3-1 and Table 3-1.

Stripes on barricade rails shall be alternate orange and white reflectorized stripes (sloping downward at an angle of 45° in the direction traffic is to pass). The stripes shall be 6 inches wide except where rail lengths are less than 36 inches, then 4 inch wide stripes may be used. The minimum rail length is 24 inches. The entire area of orange and white shall be reflectorized using encapsulated lens reflective sheeting which will display the same approximate size, shape and color day and night, conforming to Subsection 1015.05(e) of the Standard Specifications. The predominant color for other barricade components shall be white, except for uncoated galvanized metal or aluminum components may be used. Barricades used on expressways, freeways, and other high-speed roadways shall have a minimum of 270 square inches of reflective area facing traffic.

Where a barricade extends entirely across a roadway, the stripes should slope downward in the direction toward which traffic must turn in detouring. Where both right and left turns are provided for, the chevron striping may slope downward in both directions from the center of the barricade.

Barricade rails should be supported in a manner that will allow them to be seen by the motorist and provide a stable support not easily blown over by the wind or traffic. For Type I barricades, the support may include other unstrapped horizontal panels necessary to provide stability. The name of the agency, contractor, or support shall not be shown on the face parts of any barricade. Identification markings may be shown only on the back side of barricade rails.

Barricades are located adjacent to traffic and therefore subject to impact by errant vehicles. Because of their vulnerable position and the possible hazard they could create, they should be constructed of lightweight materials and have no rigid stay bracing for A-frame designs.

Barricade Application

Type I or Type II barricades are intended for use in situations where traffic is maintained through the area being constructed and/or reconstructed. They may be used singly or in groups to mark a specific hazard or they may be used in a series for channelizing traffic. Type I barricades would normally be used on conventional roads or urban streets and arterials. Type II barricades have more reflective area, and are intended for use on expressways and freeways or other high speed roadways.

On high speed expressways or in other situations where barricades may be susceptible to overturning in the wind, sandbags should be used for ballasting. Sandbags may be placed on lower parts of the frame or stays to provide the required ballast but shall not be placed on top of any straddled rail. Barricades shall not be ballasted by solid objects such as rocks or chunks of concrete.

Where maintenance activities are being performed, the roadway condition seldom requires a complete closing of the facility. Where such a condition does occur, it is almost always an emergency situation, as would result from a broken water main or a washed-out culvert. This type of repair work is generally initiated on an emergency basis and the street or road closure can be accomplished with Type I barricades.

On construction projects, where a road section is closed to traffic, Type III barricades shall be erected at the points of closure. They may extend completely across a roadway and its shoulders or from curb to curb. Where provisions must be made for access of equipment and authorized vehicles, the Type III barricades shall be provided with gates or movable sections that can be closed when work is not in progress, or with indirect openings that will discourage public entry. Where access is provided through the Type III barricades, responsibility shall be assigned to a person to assure proper closure at the end of each working day.

When a road or street is legally closed, but access must still be allowed for local traffic, the Type III barricade cannot be extended completely across a roadway. A sign with the appropriate legend concerning permissible use by local traffic shall be mounted above the barricade.

Wing barricades are a special application of Type III barricade, erected on the roadway shoulder (on one or both sides of the pavement) to give the illusion of a narrowed or restricted roadway.

Type III barricades may be used as a mounting for regulatory signs, guide signs or lighting devices. The Road Closed signs, Detour Arrow signs, and the Large Arrow warning signs, for example, can effectively be mounted above the barricade that closes the roadway.

Construction and maintenance zones often encroach on sidewalks or crosswalks necessitating provisions for alternate routing. Where it is not possible to close a path and divert the pedestrians to other walkways, barricades may be used to define the path. Warning lights shall be used on sidewalk barricades in accordance with the following paragraph; however, where high levels of illumination exist for sidewalk areas, extra lighting may not be needed.

For nighttime use of any type of barricade, add flashing warning lights when barricades are used singly, and steady burn lights when barricades are used in a series for channelization.

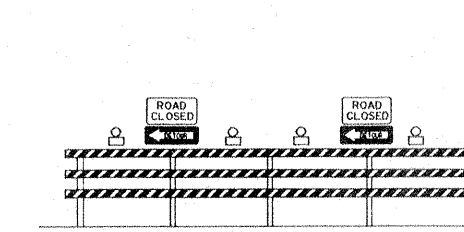


Figure 3-2
Barricade closing a road

Application of Barricades - Where a road is closed to traffic, Type III barricades shall be erected at the points of closure, and shall extend across the roadway to a minimum of 5 ft. from each edge. To further discourage public motorists going across through the construction site by removing the barricades, the Type III barricades shall be anchored to the existing roadway if necessary.

Figure 3-2 shows a typical closure of a two lane roadway. Four high intensity flashing warning lights shall be placed on the barricade as shown above. If only one lane of the travelway is closed by a barricade, two lights shall be used.


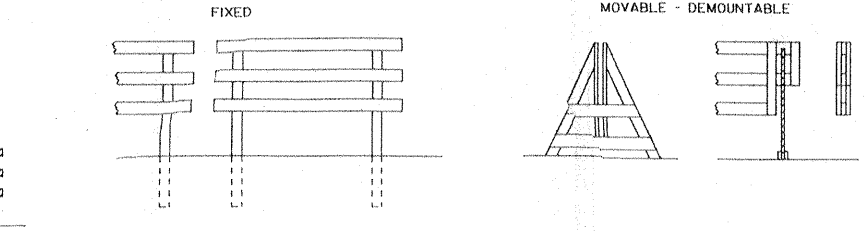


Figure 3-3
Type III barricade construction - Typical examples



Safety is a Part of Your Contract

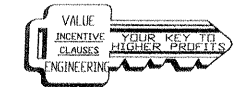

DACW29-00-B-0094

AS BUILT PLANS
DATE RECEIVED 3/15/02
DATE TRACINGS CORRECTED 4/18/02



U.S. ARMY ENGINEER DISTRICT, NEW ORLEANS
CORPS OF ENGINEERS
NEW ORLEANS, LOUISIANA

BOARD OF LEVEE COMMISSIONERS
ORLEANS LEVEE BOARD
NEW ORLEANS, LOUISIANA

HARTMAN ENGINEERING, INC.
CONSULTING ENGINEERS
KENNER, LOUISIANA

LAKE PONTCHARTRAIN, LA. AND VICINITY
HIGH LEVEL PLAN
ORLEANS AVENUE OUTFALL CANAL
PHASE 1B
ORLEANS PARISH
LOUISIANA

ROBERT E. LEE BOULEVARD BRIDGE
HWY. SIGN AND BARRICADE DETAILS FOR CONSTRUCTION

DESIGNED BY:	DATE:	PLOT SCALE:	PLOT DATE:
DRAWN BY:	MAR. 8, 2000	1	MARCH 8, 2000
CHECKED BY:	CADD FILE:	SHT59.DGN	FILE NO.
SUBMITTED BY:	SOLICITATION NO.	DACW29-00-B-0094	H-4-44776
HARTMAN ENGINEERING DESIGN ENGINEER			DWG. 59 OF 59