

CELMN-CD-NO

25 Aug 94

MEMORANDUM THRU

Area Engineer, NOAO
C/Const Div ATTN: Contr Adm Br

FOR C/Engr Div

SUBJECT: Narrative Completion Report for Contract No. DACW29-93-C-0077, Lake Pontchartrain, La. & Vicinity, Hurricane Protection Levee, New Orleans Lakefront Levee West of I.H.N.C., Orleans Avenue Canal Flood Protection Improvement, Phase II-D (West Side: Sta. 2+39.00 to 29+07.50 B/L), Orleans Parish, LA

1. The subject contract dated 18 June 93, was awarded to T. L. James and Co., Inc., P. O. Box 20115, New Orleans, La 70141-0115. The Notice to Proceed was issued on 22 July 93, with construction to start no later than 1 August 1993. The original completion date was set for 22 July 94, with the estimated amount of the contract being \$1,540,966.50.

2. Required work under this contract included construction of sheet piling and concrete I-type floodwall plus cofferdam, demolition of the existing wall concrete cap and sheet piling, clearing and grubbing, driving steel sheet piling, degrading and placing backfill, fertilizing and seeding, and all other incidental work.

3. The preconstruction Conference was held at the New Orleans Area Office on 22 July 93. Detailed minutes of this meeting are located in the contract file. The Notice to Proceed was signed by the contractor on 22 July 93, and the contractor began setting up field office on 26 July 93. The contractor set up the safety fence on 17 August 93, and started clearing and grubbing on 20 August 93.

4. This contract provided for 7 major construction phases: (1) cofferdam, (2) sheet pile driving, (3) I-wall construction, (4) removal of old I-wall, (5) structural excavation and backfill, (6) fertilizing, seeding and mulching, and (7) cleaning and painting of retaining wall.

5. The contractor began driving PZ-27 sheetpiles for the cofferdam on 27 Sep 93. The contractor used a 50T American 797 crane with a 90' boom, 235 Cat crawler backhoe and vibratory hammer to drive the sheet piles. Piles were pinned with a H-8 clothes pin hammer. This phase continued until 30 May 94.

AUG 26 1994

CELMN-CD-NO-Q

SUBJECT: Contract No. DACW29-93-C-0077, Lake Pontchartrain, Louisiana and Vicinity, High Level Plan, New Orleans Lakefront Levee, West of IHNC, Orleans Avenue Canal Flood Protection Improvement, Phase II-D, New Orleans, LA

6. The driving of steel sheet piles for the floodwall began on 20 October 93. Syro SPZ-22 cold rolled substitute sheets were driven to grade using a ICE 216 vibratory hammer. The crane was a 50T American crane with 90' boom. As monolith sections were completed, #6 rebars were welded across the top of the sheets. Cathodic cables were welded to the monoliths at the joints. Under the I-610 bridge, the sheet piles were driven in three segments. The contractor drove SPZ-22 type sheets for tie-ins to existing wall. All sheets were driven to grade and within allowable tolerance. The sheet pile driving operation was completed with the tie-in sheets under the I-610 bridge on 19 May 94.

7. The contractor began construction on the reinforced concrete floodwall on 29 Nov 93. The contractor used a subcontractor, American Rebar and Cable Co., for tying the rebar. The contractor placed the concrete using a 797 American crane, concrete bucket and chute. Each monolith was placed continuously. The lower half of the monolith was placed with the concrete bucket and chute. Then the top form section (protected side) was set and the top section placed using a hopper and 5' long rubber trunk. The last monolith was placed on 25 May 94.

8. The contractor used a EB-40 backhoe, American 797 crane with clam bucket, and D4 dozer for structural excavation and backfill. Structural excavation and backfill was performed concurrent to other work. The contractor began final dressing of the levee on 14 June 94. Concrete slope pavement was placed under the I-610 bridge between 13 July 94 to 19 July 94.

9. The next operation was to remove the old existing concrete cap and sheet pile down to elevation 4.00. The contractor started on 1 June 94, using a EB-40 backhoe to cut existing steel sheet pilings and remove the existing concrete floodwall. An American 797 crane was used to load blocks onto flatbeds for removal. The areas with corrugated sheet piles were easily cut and removed. The sheet pile in the other areas were cut using two torches. The last section was removed on 27 June 94.

10. The next phase of work was to clean and paint the retaining wall. The contractor started cleaning the wall on 6 July 94, using two pressure washers. Tammscoat was then applied using an airless sprayer. A final clear coat was applied by brush. The operation was finished on 18 July 94.

CELMN-CD-NO-Q

SUBJECT: Contract No. DACW29-93-C-0077, Lake Pontchartrain, Louisiana and Vicinity, High Level Plan, New Orleans Lakefront Levee, West of IHNC, Orleans Avenue Canal Flood Protection Improvement, Phase II-D, New Orleans, LA

11. Fertilizing, seeding and mulching of completed levee as well as disturbed area was the final phase of work. This operation was begun and completed on 30 July 94. Two farm tractors were used along with a harrow, culti-packer, mechanical spreader, and mulch slurry tank. After harrowing, fertilizer was broadcast over the entire levee section. Hauled bermuda grass seed (60 lbs/acre) was then broadcast and culti-packed. Finally, fiber mulch was sprayed over the seeded areas.

12. There were eight modifications on this contract and a summary of significant ones follows:

a. P00002 (CIN-01), dated 13 Jan 94. The modification was necessary because of differing site conditions. The modification required the probing for unknown obstructions below the limits of structural excavation. The modification increased the contract by \$4,000 and added seven calendar days to the contract time.

b. P00003 (CIN-02), dated 2 Feb 94. This modification called for an additional 30 feet of I-wall and coated sheet piling. The contract was increased by \$18,200 and added 9 calendar days to the contract time.

c. P00005 (CIN-03), dated 14 Feb 94. This modification changed the contract under "Type of Finish/Structure or Portion of structure". The contract price was increased by \$10,396 with no time extension.

d. P00008 (CIN-04), dated 18 June 94. This modification was for removal and disposal of tree stumps and other subsurface debris found in the sheetpile line of construction. The contract price was increased by \$15,865.00 with no time extension.

13. The contract time was increased by 36 days.

14. Following is a list of major suppliers and subcontractors on the subject contract:

- a. Reinforcement - Lulich Steel Corp., Slidell La.
- b. Sheet Piles - Syro Steel, Girard, Ohio
- c. Concrete - Carlo Ditta Inc., Harvey La.
- d. American Rebar and Cable Co., Inc., installed the reinforcement

CELMN-CD-NO-Q

SUBJECT: Contract No. DACW29-93-C-0077, Lake Pontchartrain, Louisiana and Vicinity, High Level Plan, New Orleans Lakefront Levee, West of IHNC, Orleans Avenue Canal Flood Protection Improvement, Phase II-D, New Orleans, LA

e. Economy Grassing provided erosion control as well as fertilizer, seed and mulching to complete levee section and any disturbed areas.

15. Professional Services Industries, Inc., of Jefferson, La. monitored ground vibrations.

16. The contractor submitted and enforced an adequate Accident Prevention Program. The contractor was very cooperative in the performance of the work and performed daily safety inspections in addition to holding weekly safety meetings. There was no lost time accidents throughout the duration of the project.

17. The contractor was efficient and professional in the performance of the work and any extra work required to complete this project. The equipment used was kept in good working condition. Quality control was maintained throughout the life of the contract.

18. Following is a comparison of contract quantities versus actual quantities:

Item No.	Description	Qty & Unit	Unit Price	Est. Amt	Final Qty	Earnings to Date
1	Mob & Demob	LS	LS	\$100,000	\$100,000	\$100,000
2	Clearing & Grubbing	LS	LS	\$15,433	\$15,433	\$15,433.00
3	Structural Exc. & Backfill (P00003)	LS	LS	\$40,800	\$40,800	\$40,800.00
4	Piling, Steel Sheet, PSA-23	480SF	\$10	\$4,800	510.85SF	\$5,108.50
5	Piling, Steel Sheet, PZ-27	73,371SF	\$9.50	\$697,024.50	72,401.51SF	\$687,814.34
6	Piling, Steel Sheet, PZ-27 In segments	3,780SF	\$13.00	\$49,140	4,007.90	\$52,102.70

CELMN-CD-NO-Q

SUBJECT: Contract No. DACW29-93-C-0077, Lake Pontchartrain, Louisiana and Vicinity, High Level Plan, New Orleans Lakefront Levee, West of IHNC, Orleans Avenue Canal Flood Protection Improvement, Phase II-D, New Orleans, LA

(P00008)	LS	LS	\$15,865	\$15,865	\$15,865.00
----------	----	----	----------	----------	-------------

19. A copy of the As-Built Drawings are attached.

20. The contract was completed in accordance with the contract plans and specifications with final acceptance on 3 Aug 94.

Bernard Brogna
BERNARD BROGNA
Quality Assurance Representative
New Orleans Area Office

CF:

Proj Engr (Gonzalez)
Proj Insp (Brogna)
Ofc Engr w/as-built
CELMN-CD-Q w/as-built
CELMN-PA
CELMN-CT
CELMN-ED-C
CELMN-CD-B
CELMN-CD-CC
CELMN-PP

Safety is a Part
of Your Contract


ORLEANS AVENUE CANAL NOAO FLOOD PROTECTION IMPROVEMENT PROJECT

ORLEANS PARISH, LOUISIANA

PHASE II-D

"AS"
Built


LOCATION OF WORK

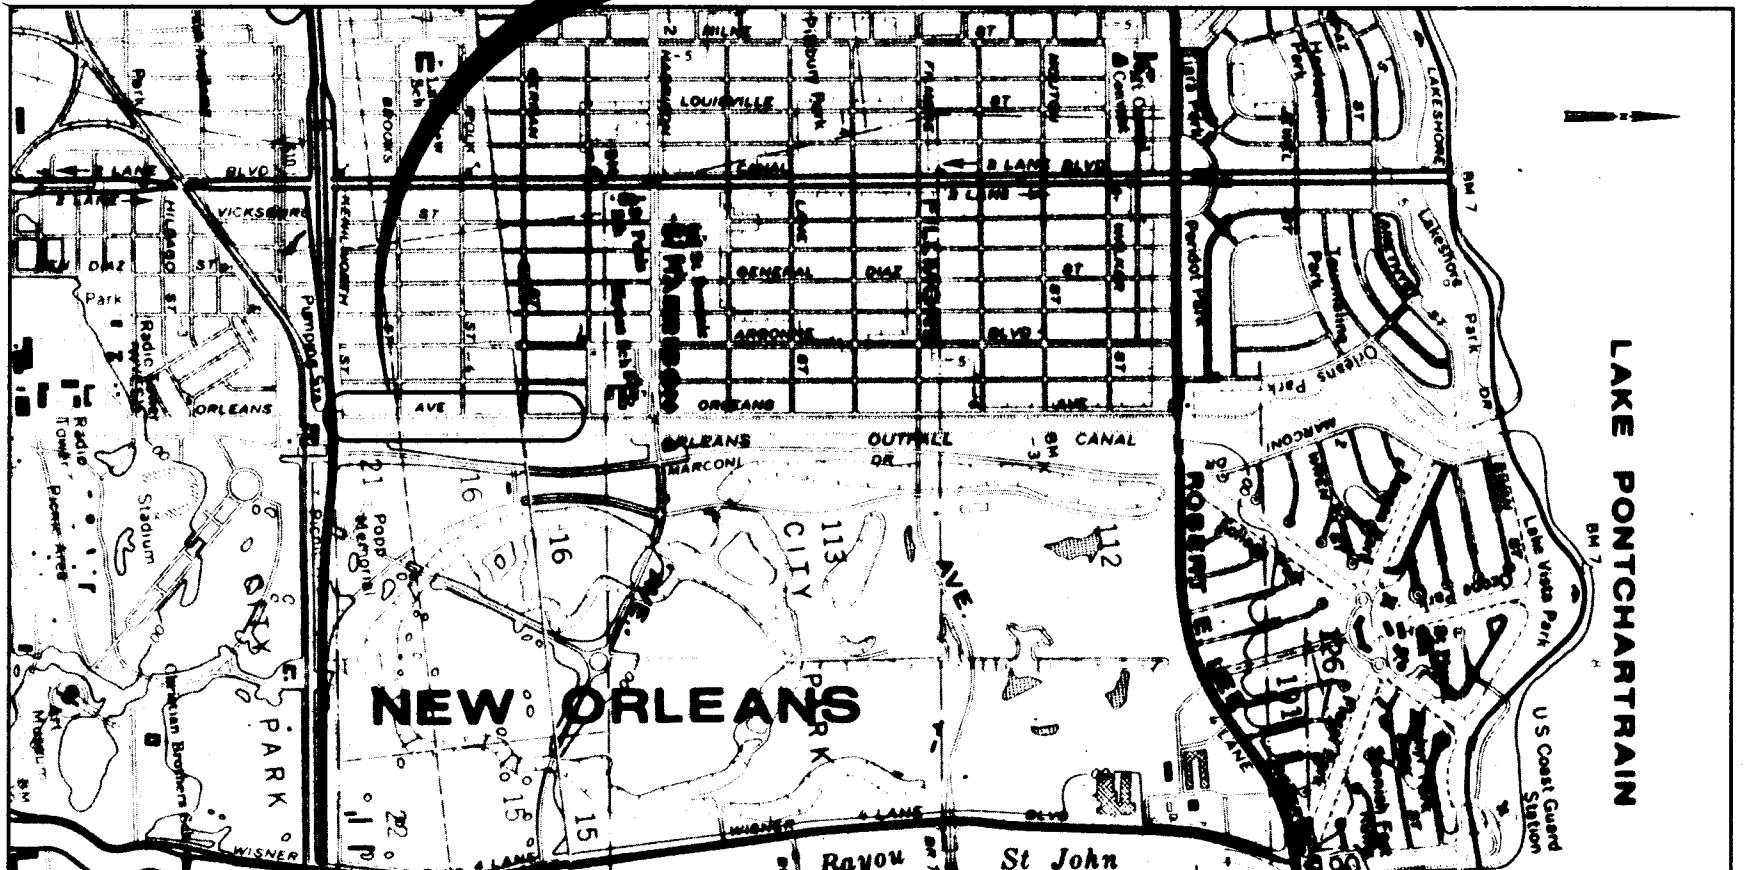

LOCATION MAP

SCALE IN FEET
1000' 0 1000' 2000' 3000' 4000'

"AS" BUILT

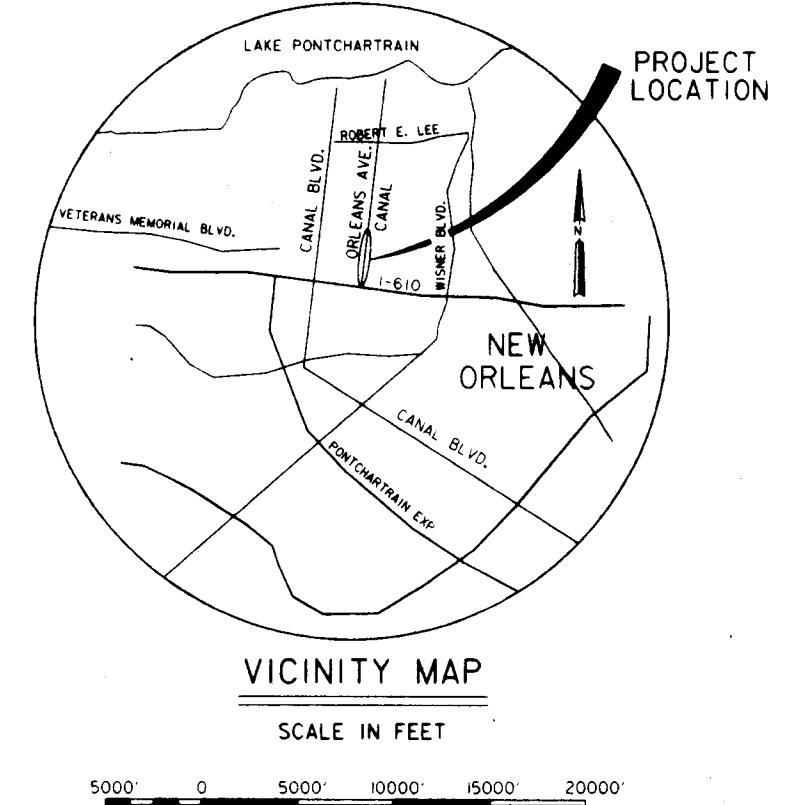

NOTE:
DRAWINGS IN THIS FOLIO
HAVE BEEN REDUCED ONE
HALF THE ORIGINAL SCALE

DRAWING INDEX			
DRAWING NUMBER	DRAWING TITLE	DRAWING NUMBER	DRAWING TITLE
1	LOCATION AND VICINITY MAP	15	RIGHTS OF WAY AND STAGING AREA
2	GENERAL NOTES AND LEGEND	16	SOIL BORING LOGS
3	PROJECT MAP	16a	SOIL BORING LEGEND
4	GEOMETRIC LAYOUT	17	BORROW AREA LOCATION
5-8	PLAN/PROFILE SHEETS	18-24	CROSS SECTIONS
9	TYPICAL SECTIONS		
10	STEEL SHEET PILING AND MONOLITH LAYOUT		
11-12	TYPICAL "I"-WALL DETAILS		
12a	TYPICAL "I"-WALL DETAILS		
13-13a	"I"-WALL ARCHITECTURAL TREATMENT		
14	CONNECTIONS TO EXIST. WALL AND MISCELLANEOUS DETAILS		




U.S. ARMY ENGINEER DISTRICT, NEW ORLEANS		CORPS OF ENGINEERS NEW ORLEANS, LOUISIANA
BOARD OF LEVEE COMMISSIONERS NEW ORLEANS LEVEE DISTRICT NEW ORLEANS, LOUISIANA		
DESIGN ENGINEERING, INC. 3330 W. ESPALOMADE AVE. S. METairie, LOUISIANA 70002		
LAKE PONTCHARTRAIN, LA. AND VICINITY HIGH LEVEL PLAN		
NEW ORLEANS LAKEFRONT LEVEE WEST OF I.H.N.C.		
ORLEANS AVE. CANAL FLOOD PROTECTION IMPROVEMENT PHASE II-D (WEST SIDE) B/L STA.2+39.00 TO STA.29+07.50 ORLEANS PARISH, LOUISIANA		
LOCATION AND VICINITY MAP		
REVISIONS	DATE	APPROVED
C.A.D.		
REMOVED BY U.S. ARMY ENGINEER DISTRICT DRAWN BY: P. J. ALLEN CHECKED BY: T. J. SMITH MAILED BY: F. E. BURGESS SUBMITTED BY: DESIGN ENGINEERING, INC.	DATE: MARCH 1993 PLOT SCALE: 1:2000	SOLICITATION NO: DACW29-93-B-0042 FILE NO: H-4-40205


Safety is a Part
of Your Contract

GENERAL SYMBOLS

EXISTING

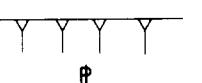○ 8' Ø OAK	TREE AND TRUNK DIAMETER
● B-54	SOIL BORING AND NUMBER
● B-54	5' Ø SOIL BORING AND NUMBER
(AM)	BENCH MARK
	BANK OR SLOPE LINES
P	PROPERTY LINE
— — — — —	ROW, PROPERTY LINE
— — — — —	FENCE
G	GAS (NATURAL)
S	SANITARY SEWER
SFM	SEWER FORCE MAIN
D	STORM DRAIN
W	WATER MAIN
T	BURIED TELEPHONE CABLE
> <	DRAINAGE CULVERT (UNDER 36°)
L — — — — —	DRAINAGE CULVERT (36° AND OVER)
⑤	SANITARY SEWER MANHOLE
⑩	STORM DRAIN MANHOLE
● B-75	SHALLOW SOIL BORING AND NO.
— — E — — —	ELECTRIC CONDUIT BURIED
— — E — — —	ELECTRIC CABLE OVERHEAD

PROPOSED

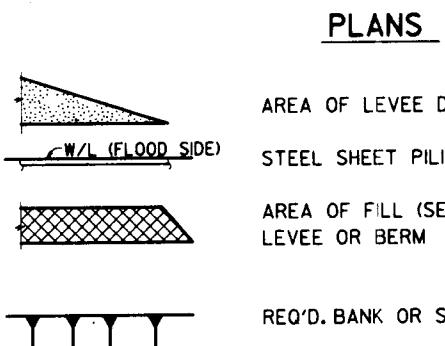

PLANS

PROFILES & SECTIONS

EL. +1.0	TOP OF SHEET PILING OR I-WALL
EL. -27.0	CONCRETE I-WALL W/BOTTOM OF CONCRETE ELEVATION
	STEEL SHEET PILING W/BOTTOM OF PILING ELEVATION
	AREA OF FILL
	REQ'D. GRADE OF LEVEE OR BERM
	AREA OF LEVEE DEGRADING

Notes:

- 1) Values in the table shall apply for bars spaced laterally, not less than 3db and when bars have concrete cover which complies with ACI 7.7.i.
- 2) When bar spacing laterally is greater than 5db and when bars have 2.5db or more inches of concrete cover, the values in the table may be reduced by a factor of 0.8.
- 3) Embedment and splice lengths shall be a minimum of 12 inches.
- 4) Number 14 and 18 bars shall not be lap spliced. These bars shall be spliced with mechanical butt splices only.
- 5) Top bars are horizontal bars and bars inclined less than 45 degrees with respect to a horizontal plane which are placed such that more than 12 inches of concrete is cast in the member below the bar.

Reinforcement Embedment and Splice Table				
Bar Size	Minimum Embedment Length, inches		Minimum Lap Length	
	Top Bars	Other	Top Bars	Other
3	13	12	16	12
4	17	12	22	16
5	21	15	27	20
6	27	19	35	25
7	37	26	48	34
8	48	35	63	45
9	61	44	80	57
10	78	56	101	72
11	96	68	124	89
14	130	93	•	•
18	169	120	•	•



ABBREVIATIONS

AZ	AZIMUTH
BM	BENCH MARK
BP	BRACE POLE
CB	CATCH BASIN
CMP	CORRUGATED METAL PIPE
CN	CONCRETE NAIL
CONC	CONCRETE
CP	CONCRETE PIPE
CSP	CORRUGATED STEEL PIPE
CY	CUBIC YARD
DI	DROP INLET
DIA	DIAMETER
D/W	DRIVEWAY
EL	ELEVATION
EXIST	EXISTING
FND	FOUND
FT	FOOT
HORIZ	HORIZONTAL
HWY	HIGHWAY
ID	INTERNAL DIAMETER
INV	INVERT
IR	IRON ROD
LF	LINEAR FEET
LG	LONG
LT	LEFT
MAX	MAXIMUM
MH	MANHOLE
MIN	MINIMUM
MSL	MEAN SEA LEVEL
OD	OUTSIDE DIAMETER
OLB	ORLEANS LEVEE BOARD
PI	POINT OF INTERSECTION
POT	POINT ON TRAVERSE
PROJ	PROJECT
PVC	POLYVINYL CHLORIDE PIPE
RCP	REINFORCED CONCRETE PIPE
RD	ROAD
RET	RETAINING
REINF	REINFORCING
REQ'D	REQUIRED
ROW OR R/W	RIGHT-OF-WAY
RR	RAILROAD
RRS	RAILROAD SPIKE
RT	RIGHT
SECT	SECTION
SMH	SEWER MANHOLE
ST	STREET
STA	BASELINE STATION
TC	TOP OF CURB
TEL	TELEPHONE
TYP	TYPICAL
UG	UNDERGROUND
USCGS	UNITED STATES COAST & GEODETIC SURVEY
VERT	VERTICAL
WT	WEIGHT
WS	WATER SURFACE
C/L	CENTER LINE
OR W.B.	WEST BASELINE
W/L	WALL LINE
GIP	GALVANIZED IRON PIPE
NIC	NOT IN CONTRACT
NGVD	NATIONAL GEODETIC VERTICAL DATUM

GENERAL NOTES

1. All azimuths are true south azimuths turned in a clockwise direction from 0 degrees (due south).
2. All elevations are expressed in feet and refer to National Geodetic Vertical Datum (N.G.V.D.).
3. All R/W and construction easement lines are parallel with or perpendicular to the baseline, unless otherwise indicated.
4. For soilboring logs, see DWG 16.
5. For existing utilities location and approximate location of relocated utilities see "Plan and Profile" drawings.


STEEL NOTES (STRUCTURAL STEEL)

1. All structural steel shall be ASTM A36, unless otherwise noted.
2. To prevent corrosion by moisture between steel surfaces in contact, all such contacts shall be sealed watertight by running a continuous $\frac{1}{8}$ " fillet weld along all edges of the contact, unless otherwise noted.
3. All welding shall be electric welding. Workmanship and technique where applicable shall conform to the American Welding Society specifications AWS D1-83 Structural Welding Code.
4. Welding symbols shown are those adopted by the American Welding Society and indicate only size and type of welds required. Detailed information shall be shown on the shop drawings and submitted by the contractor for approval.
5. Items marked C.R.S. shall be corrosion resistant steel (Stainless Steel). See specifications.

CONCRETE NOTES (CAST-IN-PLACE CONCRETE)

1. $f'_c = 3000$ PSI, $f_y = 60,000$ PSI.
 $f'_c = 2000$ PSI, $f_y = 65,000$ PSI (slope pavement only)
2. All unformed surfaces shall be given a float finish, unless otherwise specified.
3. All exterior formed surfaces not covered by backfill shall be class "A" finish and surfaces covered by backfill shall be class "D" finish, unless otherwise noted.
4. Construction joints shall be provided where shown.
5. Unless otherwise noted, provide $\frac{3}{4}$ " chamfer at all exposed joints, edges, external corners, vertical expansion joints and horizontal construction joints.
6. All primary reinforcement shall have a minimum cover of 3" unless otherwise noted. The cover for secondary reinforcement may be reduced from the above by the diameter of the bar.
7. All bends of reinforcement and all bar spacers and supports shall be in accordance with the American Concrete Institute "Manual of Standard Practice for Detailing Reinforced Concrete Structures" in effect at the time of fabrication.
8. Reinforcing bar designation numbers conform to the current numbering system of the Concrete Reinforcing Steel Institute.
9. All reinforcing shall be lapped or embedded according to the tables on this drawing, unless otherwise noted.

REVISIONS			
SYMBOL	DESCRIPTION	DATE	APPROVED
	U.S. ARMY ENGINEER DISTRICT, NEW ORLEANS CORPS OF ENGINEERS NEW ORLEANS, LOUISIANA		
BOARD OF LEVEE COMMISSIONERS NEW ORLEANS LEVEE DISTRICT	DESIGN ENGINEERING, INC. 3330 W. ESPLANADE AVE. S. METAIRIE, LOUISIANA 70022		
LAKE PONTCHARTRAIN, LA. AND VICINITY HIGH LEVEL PLAN			
NEW ORLEANS LAKEFRONT LEVEE WEST OF I.H.N.C. ORLEANS AVE. CANAL FLOOD PROTECTION IMPROVEMENT PHASE II-D (WEST SIDE: B/L STA. 2+39.00 TO STA. 29+7.50) ORLEANS PARISH, LOUISIANA			
GENERAL NOTES AND LEGEND			
DESIGNED BY: M.B.SHUKLA DRAWN BY: P.M.KILLEEN CHECKED BY: T.M.SMITH SUBMITTED BY: DESIGN ENGINEERING, INC.	PLOT SCALE: FEB., 1993 CADD FILE: II-D02 SOLICITATION NO.: H-4-40205 DESIGN ENGINEER: DACW29-93-B-0042	PLOT DATE: MARCH 1993 FILE NO.: DWG. 2 OF 24	

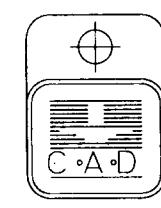

Safety is a Part
of Your Contract



PROJECT MAP

PLAN

SCALE: 1" = 500'


SCALE: 1" = 500'

500' 0 500' 1000' 1500' 2000'



REVISIONS	DATE APPROVED
SYMBOL	DESCRIPTION
U.S. ARMY ENGINEER DISTRICT, NEW ORLEANS CORPS OF ENGINEERS NEW ORLEANS, LOUISIANA	
BOARD OF LEVEE COMMISSIONERS ORLEANS LEVEE DISTRICT NEW ORLEANS, LOUISIANA	
DESIGN ENGINEERING, INC. 3330 W. ESPLANADE AVE. S. METAIRIE, LOUISIANA 70002	
LAKE PONTCHARTRAIN, LA. AND VICINITY HIGH LEVEL PLAN	
NEW ORLEANS LAKEFRONT LEVEE WEST OF I.H.N.C.	
ORLEANS AVE. CANAL FLOOD PROTECTION IMPROVEMENT	
PHASE II-D (WEST SIDE: B/L STA.2+39.00 TO STA.29+07.50)	
ORLEANS PARISH, LOUISIANA	
PROJECT MAP	
DESIGNED BY: M.B.SHUKLA DRAWN BY: C.J.KR CHECKED BY: T.M.SMITH SUBMITTED BY: DESIGN ENGINEERING, INC. DESIGN ENGINEER	DATE: MARCH 1993 PLOT SCALE: 500 FILE NO.: H-4-40205 SOLICITATION NO.: DACW29-93-B-0042 Dwg. 3 of 24

Safety is a Part
of Your Contract

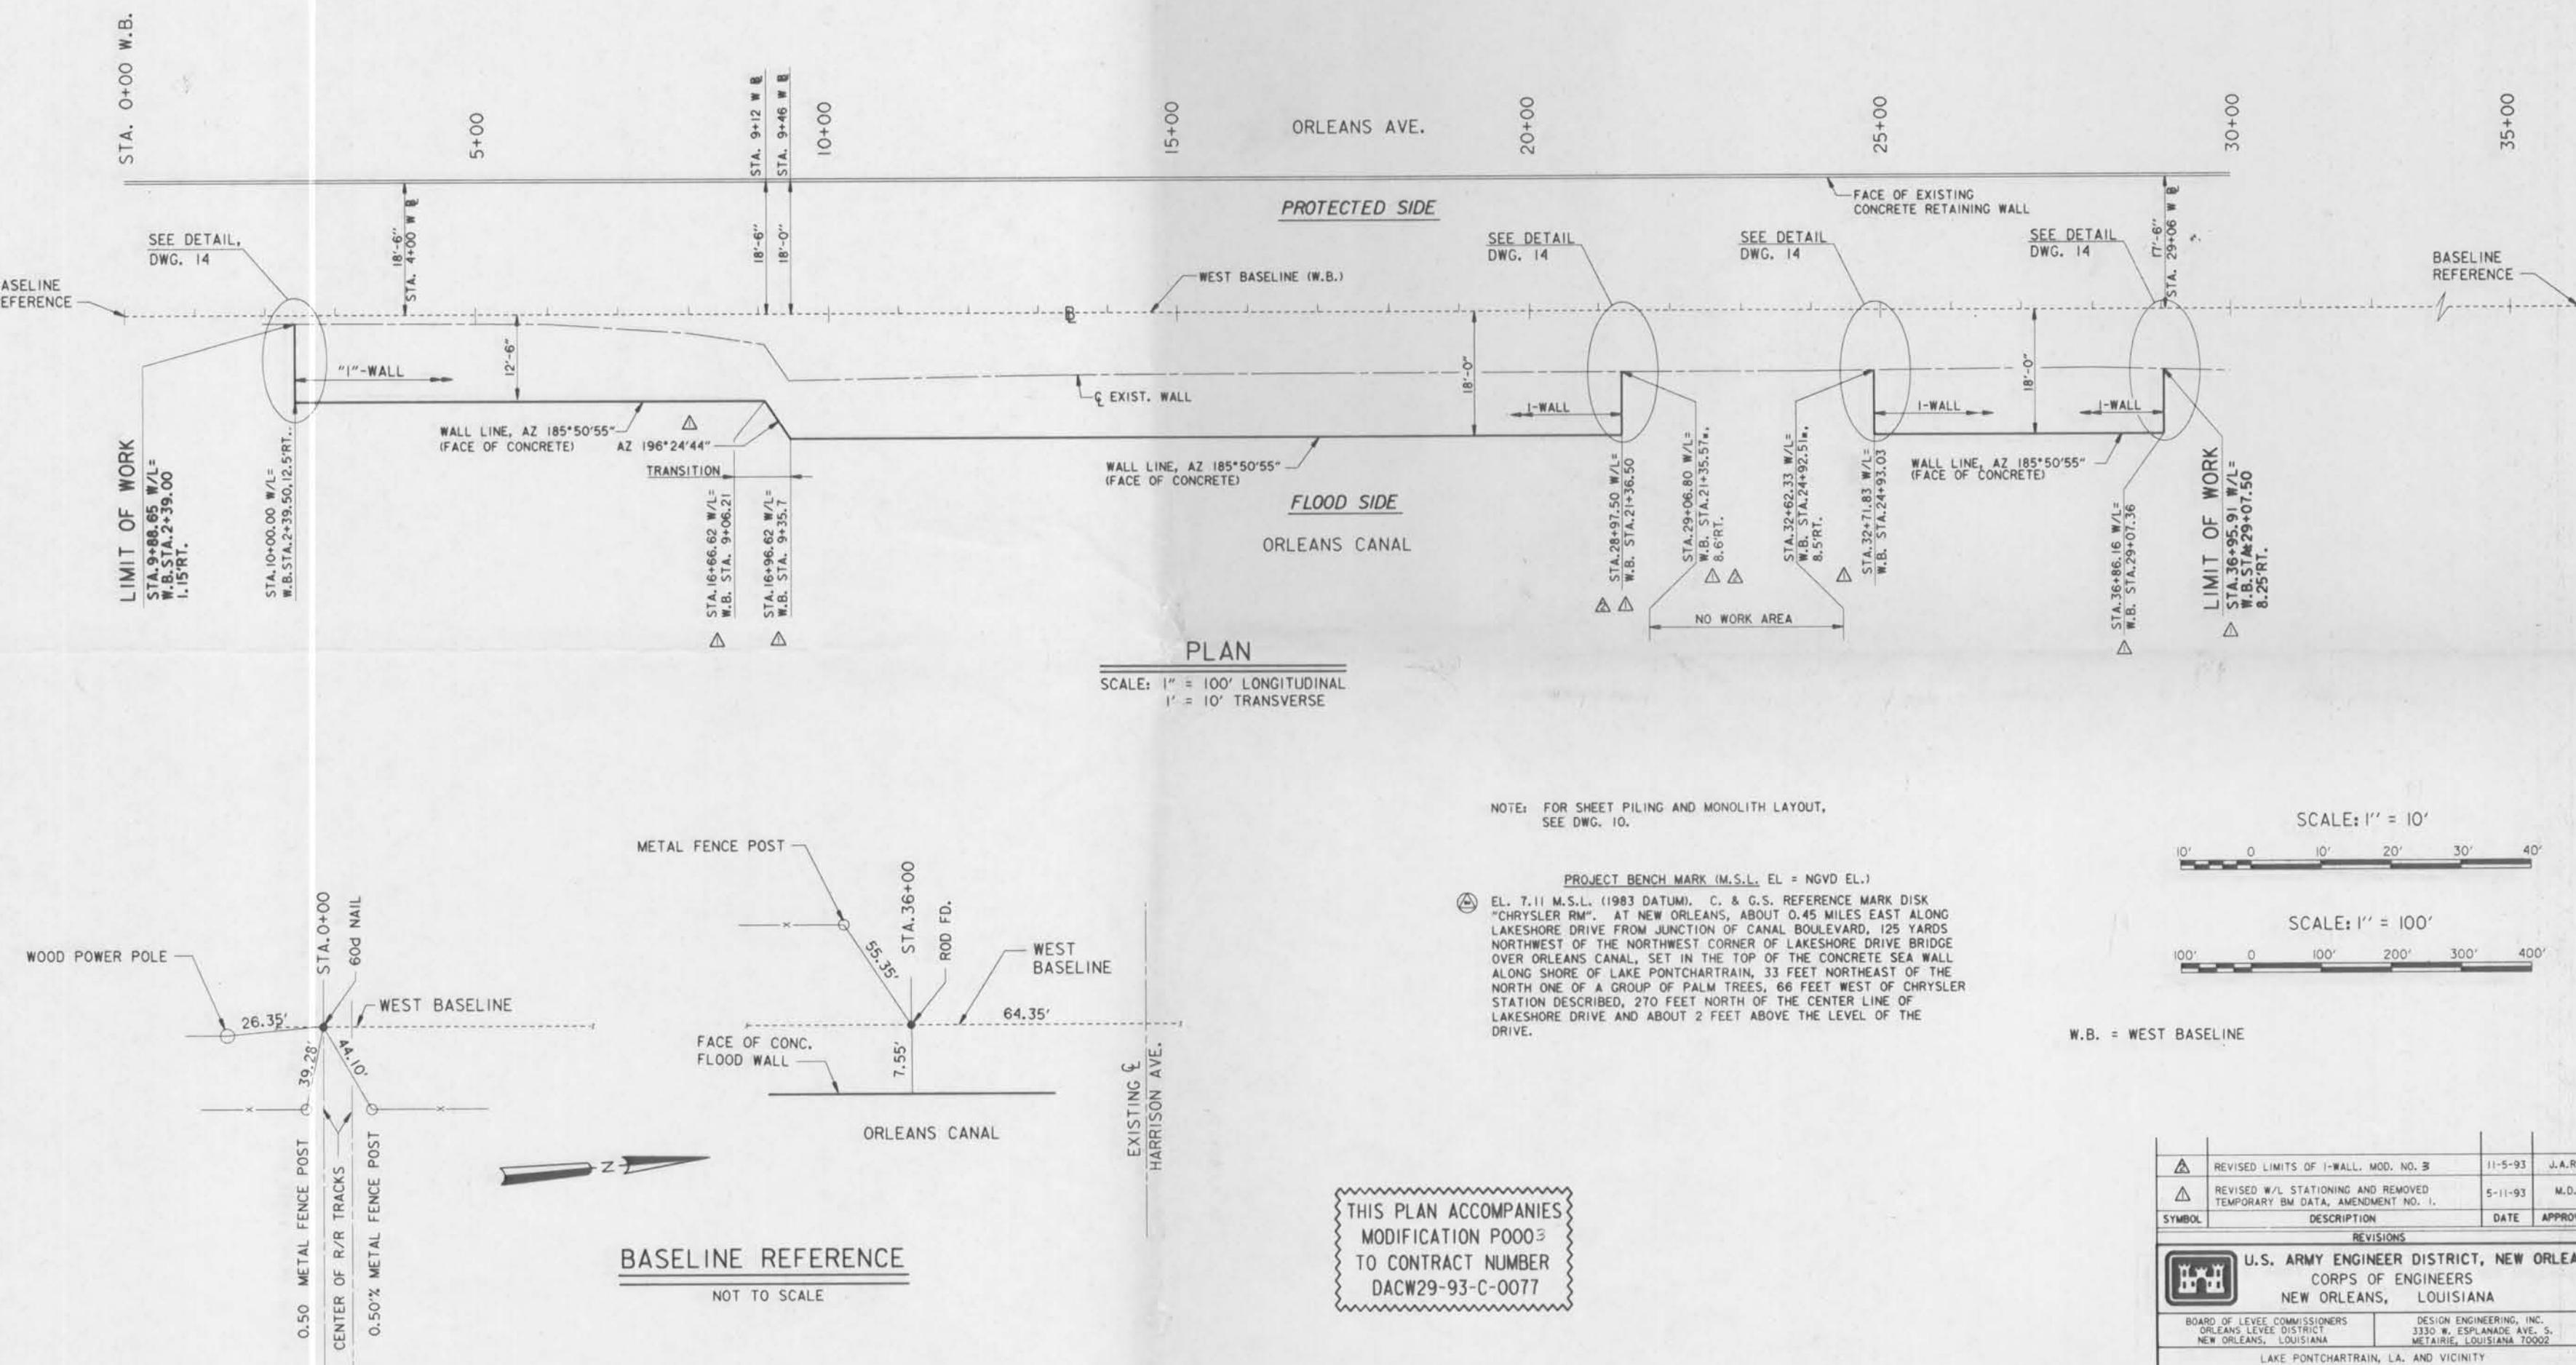


THIS PLAN ACCOMPANIES
MODIFICATION P0003
TO CONTRACT NUMBER
DACP29-93-C-0077



REVISIONS	
▲	REVISED LIMITS OF I-WALL, MOD. NO. 3
△	REVISED W/L STATIONING AND REMOVED TEMPORARY BM DATA, AMENDMENT NO. 1.
SYMBOL	DATE APPROVED
	5-11-93 M.D.
	REVISIONS
U.S. ARMY ENGINEER DISTRICT, NEW ORLEANS	CORPS OF ENGINEERS
NEW ORLEANS, LOUISIANA	DESIGN ENGINEERING, INC. 3330 W. ESPLANADE AVE., S. METAIRIE, LOUISIANA 70002
LAKE PONTCHARTRAIN, LA. AND VICINITY	HIGH LEVEL PLAN
NEW ORLEANS LAKEFRONT LEVEE	WEST OF I.H.N.C.
ORLEANS AVE. CANAL FLOOD PROTECTION IMPROVEMENT	PHASE II-D (WEST SIDE: B/L STA. 2+39.00 TO STA. 29+07.50)
ORLEANS PARISH, LOUISIANA	GEOMETRIC LAYOUT
DESIGNED BY: T. M. SMITH	DATE: FEB. 1993 PLOT SCALE: 100 PLOT DATE: FEB 1994
DRAWN BY: K. C. REID	FILE NO.
CHECKED BY: J. W. HOLTGREVE	H-4-40205
SUBMITTED BY: DESIGN ENGINEERING, INC.	SOLICITATION NO.
DESIGN ENGINEER	DACP29-93-B-0042
	DWG. 4 OF 24

Safety is a Part
of Your Contract

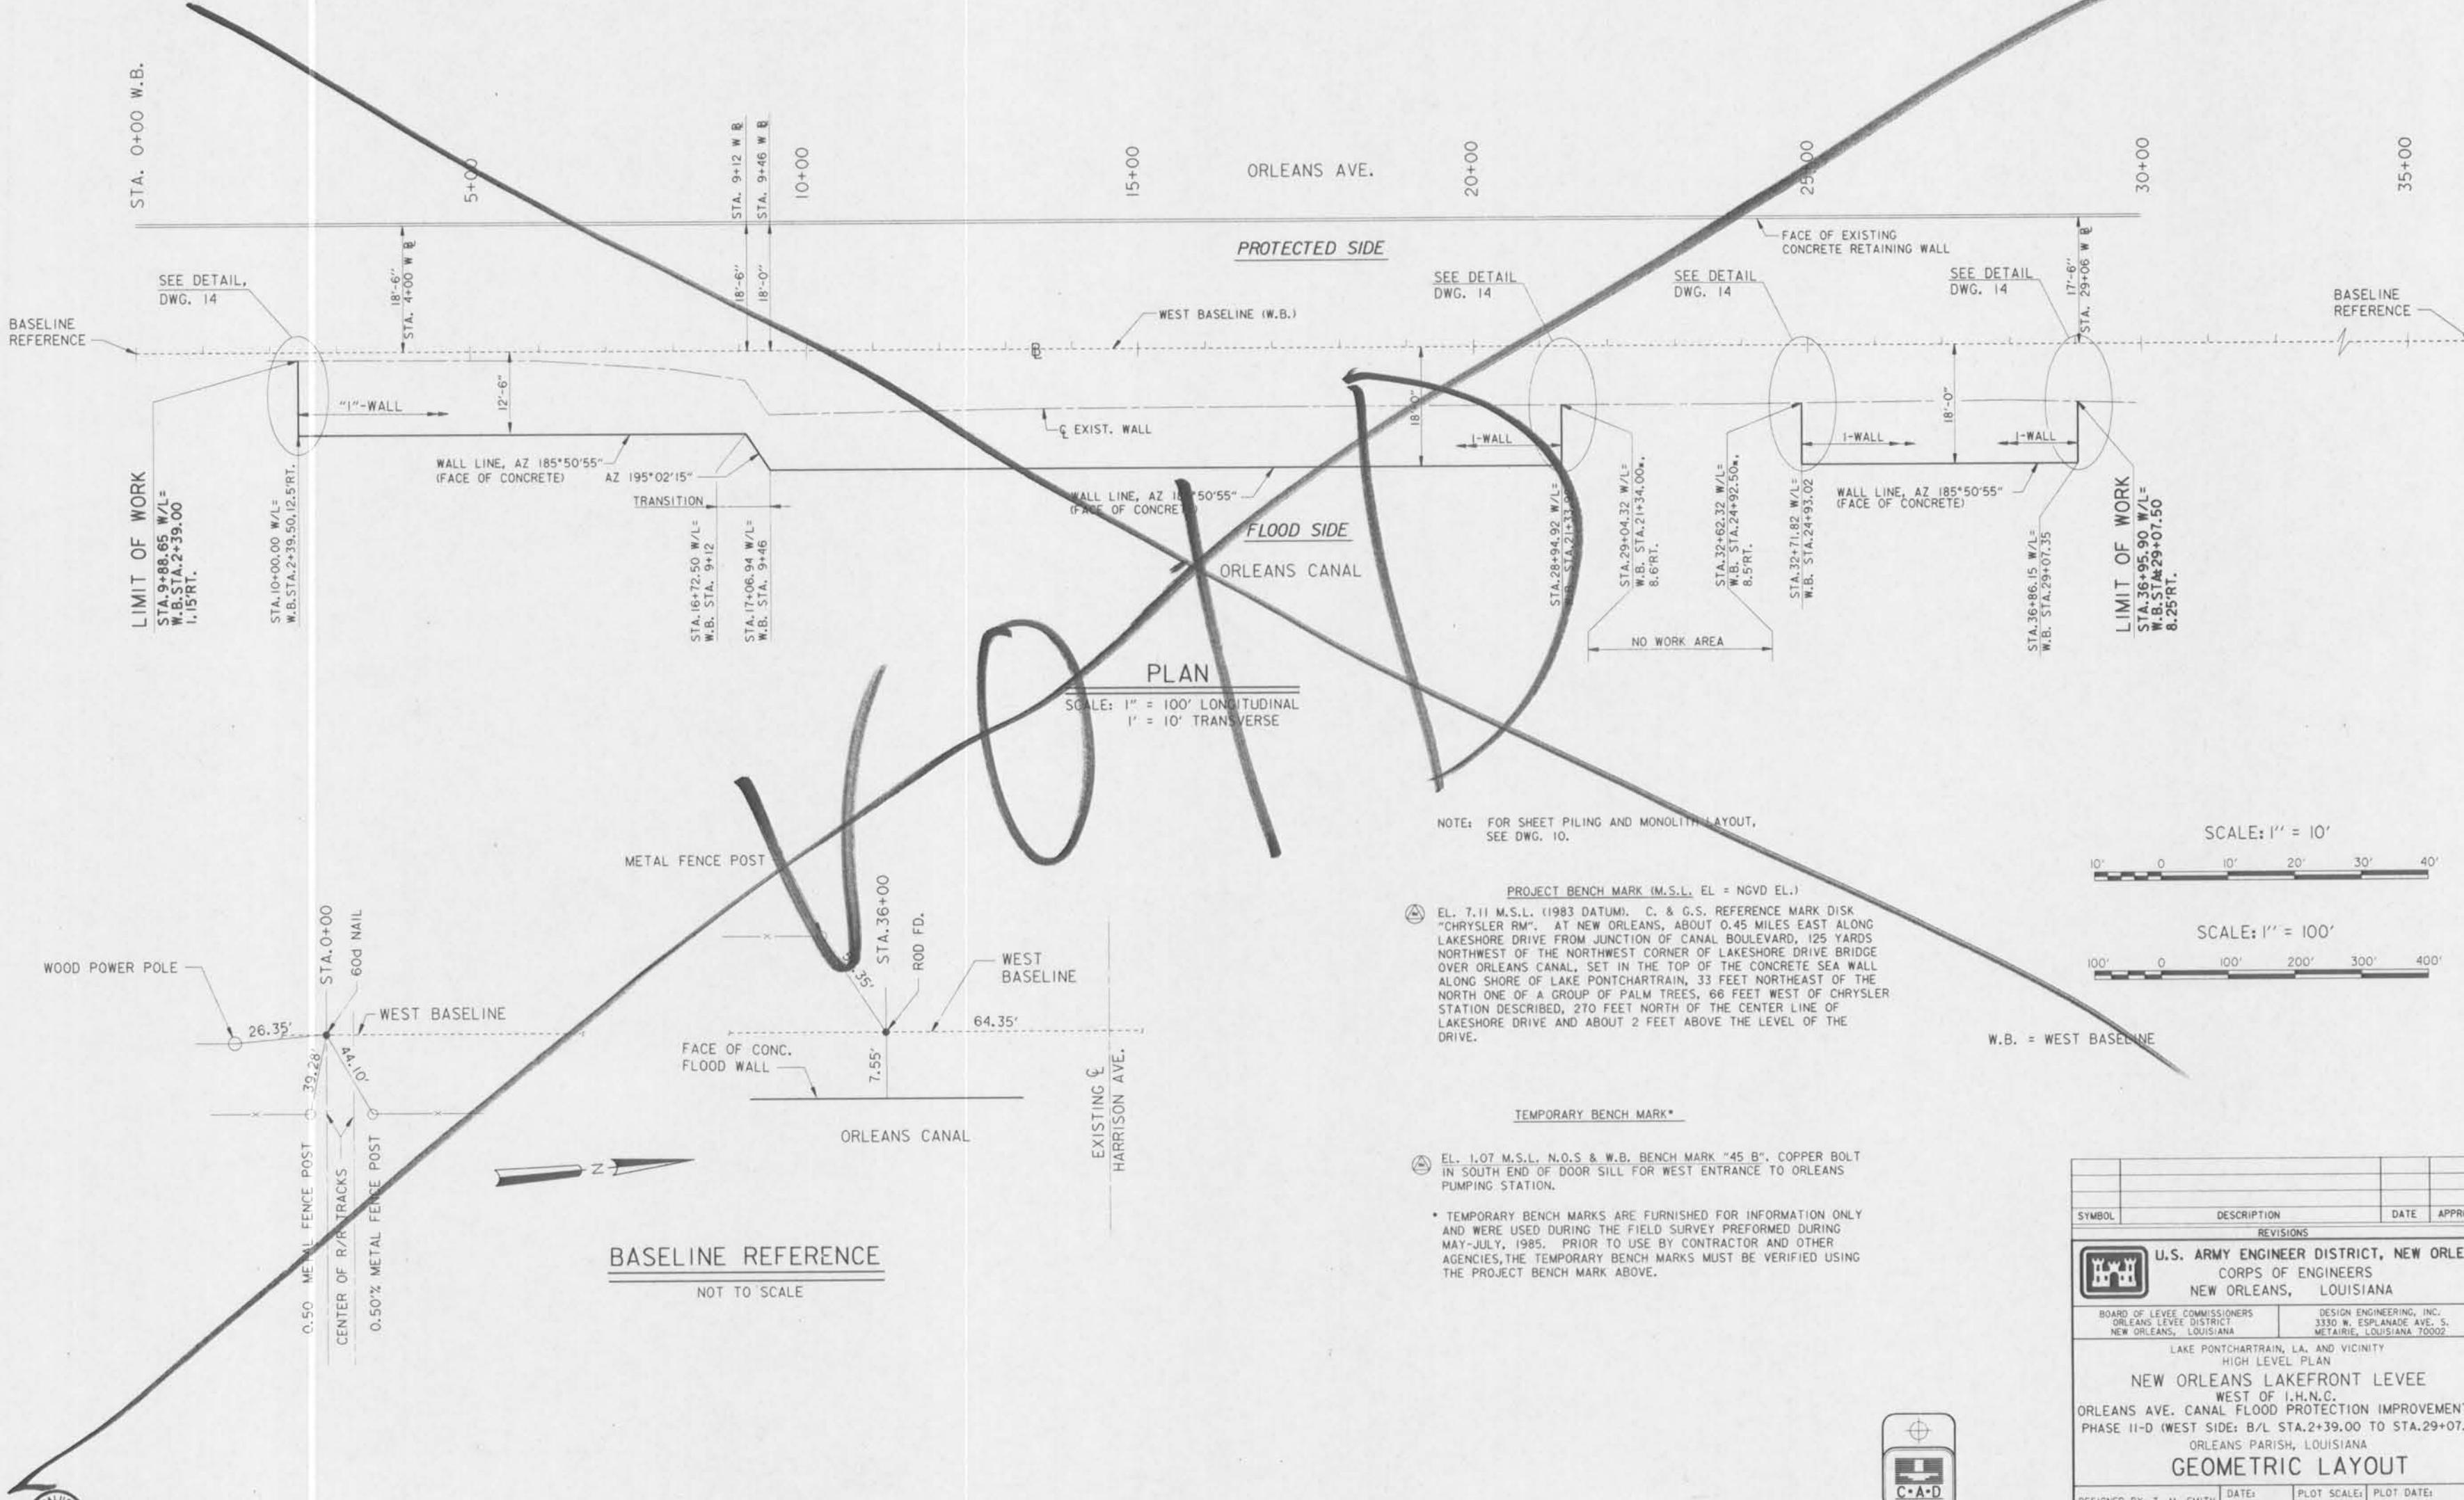

SYMBOL	DESCRIPTION	DATE	APPROVED
	REVISIONS		
	U.S. ARMY ENGINEER DISTRICT, NEW ORLEANS CORPS OF ENGINEERS NEW ORLEANS, LOUISIANA		
BOARD OF LEVEE COMMISSIONERS ORLEANS LEVEE DISTRICT NEW ORLEANS, LOUISIANA		DESIGN ENGINEERING, INC. 3330 W. ESPANADE AVE. S. METAIRIE, LOUISIANA 70002	
LAKE PONTCHARTRAIN, LA. AND VICINITY HIGH LEVEL PLAN			
NEW ORLEANS LAKEFRONT LEVEE WEST OF I.H.N.C. ORLEANS AVE. CANAL FLOOD PROTECTION IMPROVEMENT PHASE II-D (WEST SIDE: B/L STA.2+39.00 TO STA.29+07.50) ORLEANS PARISH, LOUISIANA			
GEOMETRIC LAYOUT			
DESIGNED BY: T. M. SMITH	DATE:	PLOT SCALE:	PLOT DATE:
DRAWN BY: K. C. REID	FEB., 1993	100	MARCH 1993
CHECKED BY: J.W. HOLTREIVE	CADD FILE:	II-D04	FILE NO.
SUBMITTED BY: DESIGN ENGINEERING, INC. DESIGN ENGINEER	SOLICITATION NO.	DACW29-93-B-0042	H-4-40205
		DWC. 4	OF 24

Safety is a Part
of Your Contract


5

4

3

2


1

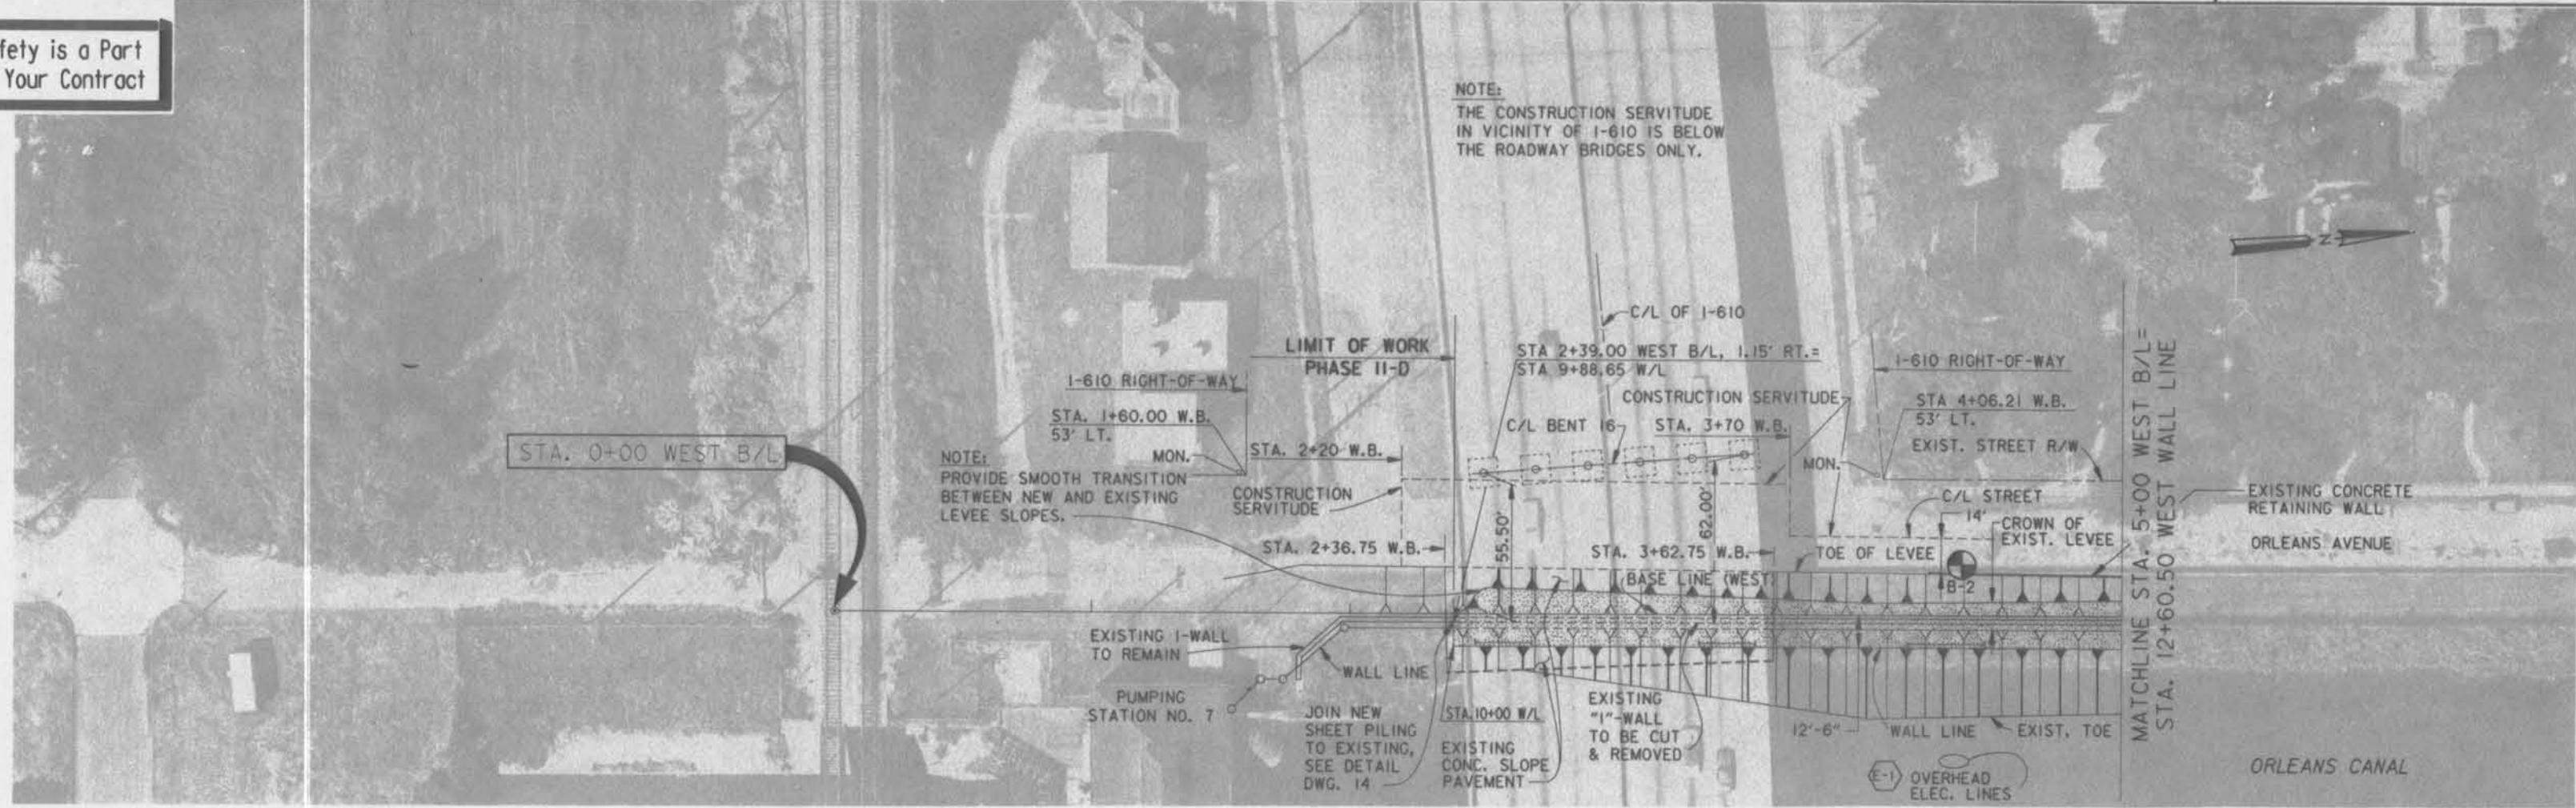

AERIAL FLOWN OCT. 1981

PLAN

SCALE: 1" = 30'

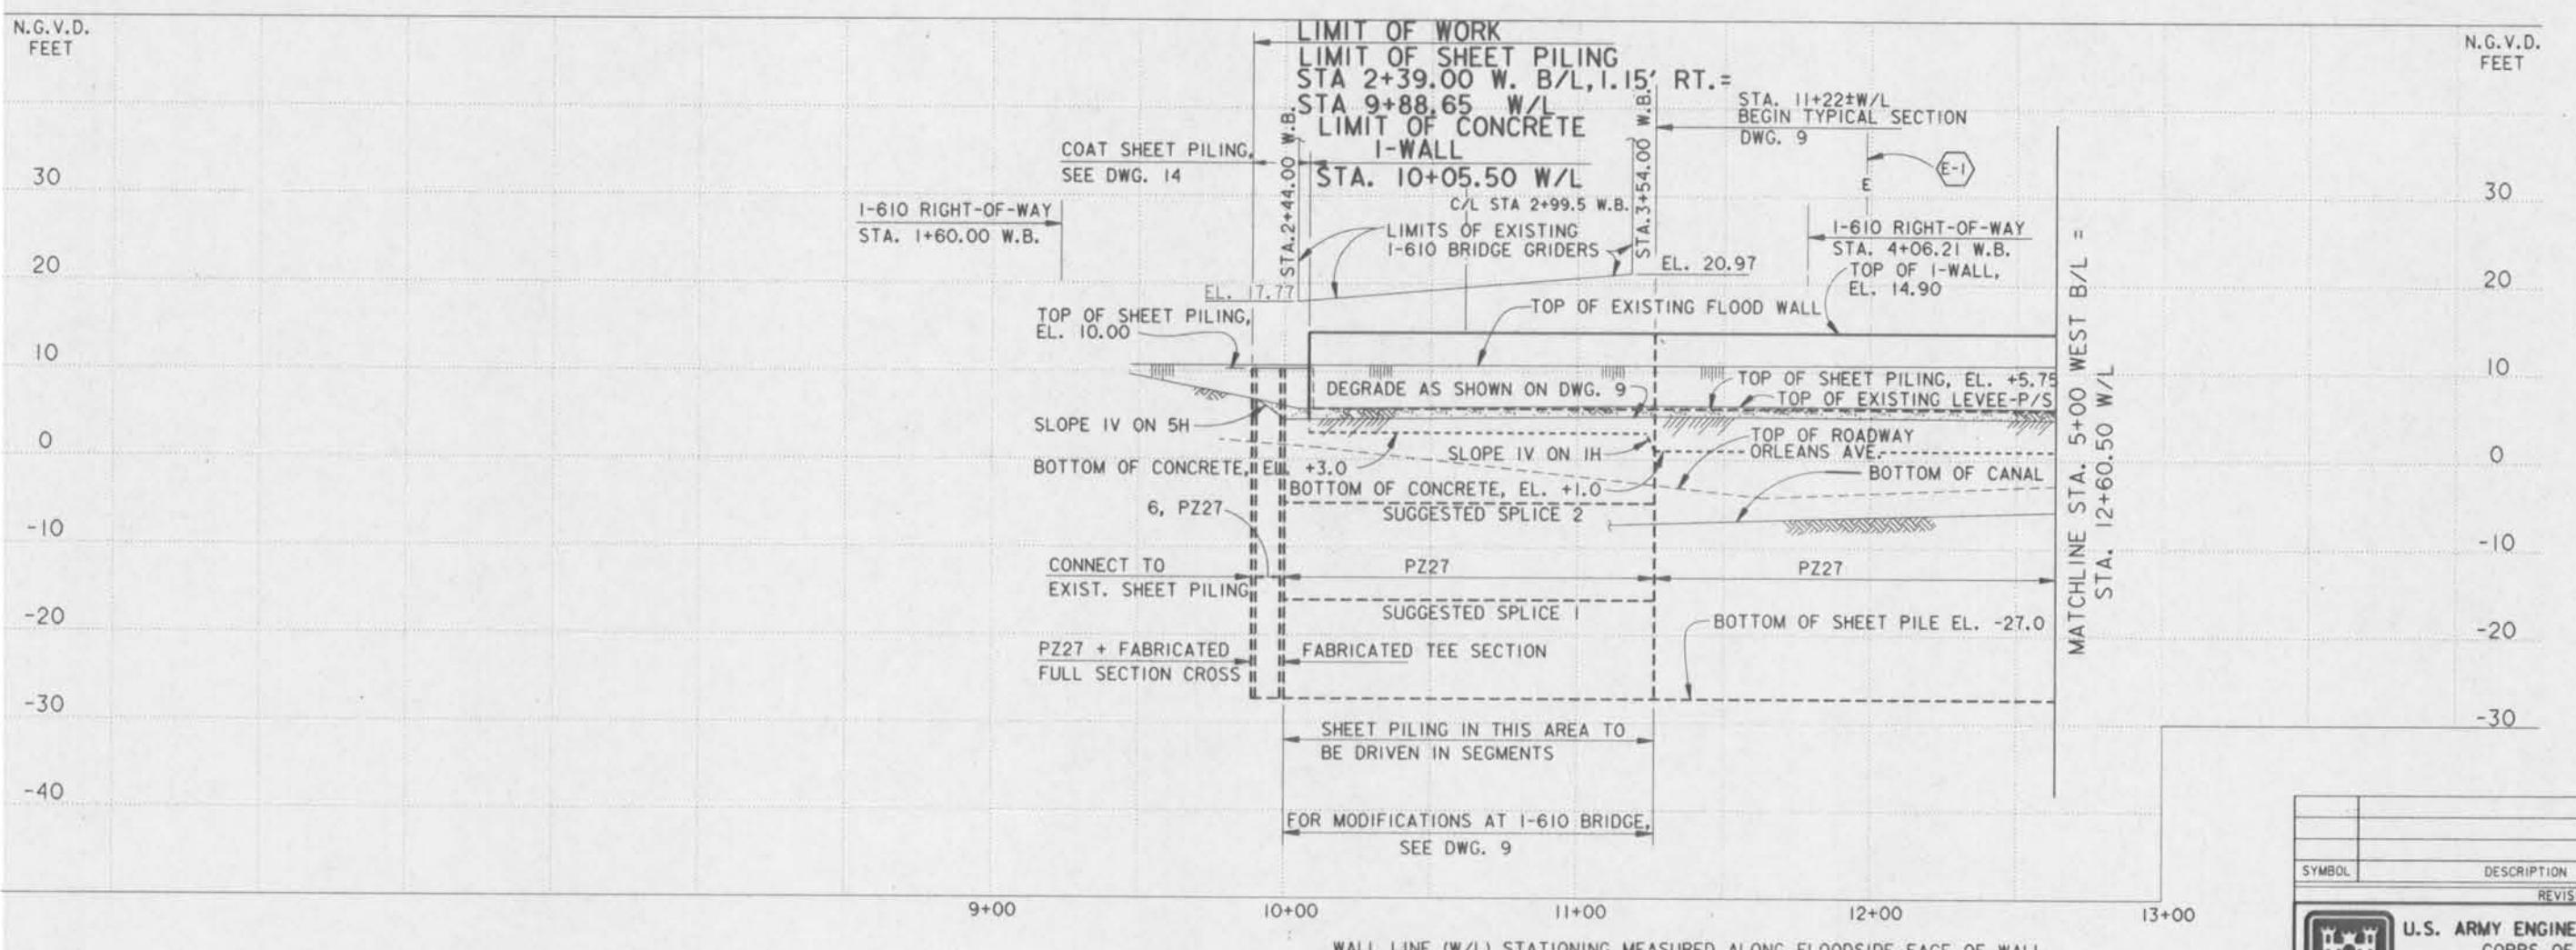

REVISIONS			
SYMBOL	DESCRIPTION	DATE	APPROVED
	U.S. ARMY ENGINEER DISTRICT, NEW ORLEANS CORPS OF ENGINEERS NEW ORLEANS, LOUISIANA		
BOARD OF LEVEE COMMISSIONERS NEW ORLEANS LEVEE DISTRICT NEW ORLEANS, LOUISIANA	DESIGN ENGINEERING, INC. 3330 W. ESPLANADE AVE., S. METAIRIE, LOUISIANA 70092		
LAKE PONTCHARTRAIN, LA. AND VICINITY HIGH LEVEL PLAN			
NEW ORLEANS LAKEFRONT LEVEE WEST OF I.H.N.C. ORLEANS AVE. CANAL FLOOD PROTECTION IMPROVEMENT PHASE II-D (WEST SIDE; B/L STA.2+39.00 TO STA.29+07.50) ORLEANS PARISH, LOUISIANA			
PLAN/PROFILE STAS. 2+40 W.B. TO 5+00 W.B.			
DESIGNED BY: M.B. SHUKLA DRAWN BY: K.C.R. & G.F.G. CHECKED BY: T.M. SMITH SUBMITTED BY: DESIGN ENGINEERING, INC. SOLICITATION NO. DACW29-93-B-0042	DATE: FEB., 1993 PLOT SCALE: 30 CADD FILE: II-005 FILE NO.: H-4-40205	PLOT DATE: MARCH 1993 FILE NO.: H-4-40205	DWG. 5 OF 24

EXISTING UTILITIES			
ITEM NO.	DESCRIPTION	W.B. STA.	OWNER
E-1	AERIAL POWER LINE	4+32	NEW ORLEANS PUBLIC SERVICE, INC.

NOTES:

1. WALL LINE STATIONING IS MEASURED ALONG FLOOD
SIDE FACE OF CONCRETE.
2. USE OF A VIBRATORY HAMMER TO DRIVE SHEET PILING
WITHIN LDOTD RIGHTS-OF-WAY IS REQUIRED. THE
PRESENCE OF AN LDOTD INSPECTOR IS REQUIRED FOR ALL
WORK PERFORMED WITHIN THE RIGHTS-OF-WAY.
3. FOR SHEET PILING LAYOUT, SEE DWG. 10.
4. FOR SHEET PILING CONNECTION DETAILS, SEE DWG. 14.

WEST SIDE PROFILE

SCALE: 1" = 30' HORIZ.
1" = 10' VERT.

SCALE: 1" = 10'

SCALE: 1" = 30'





5

4

3

2

1

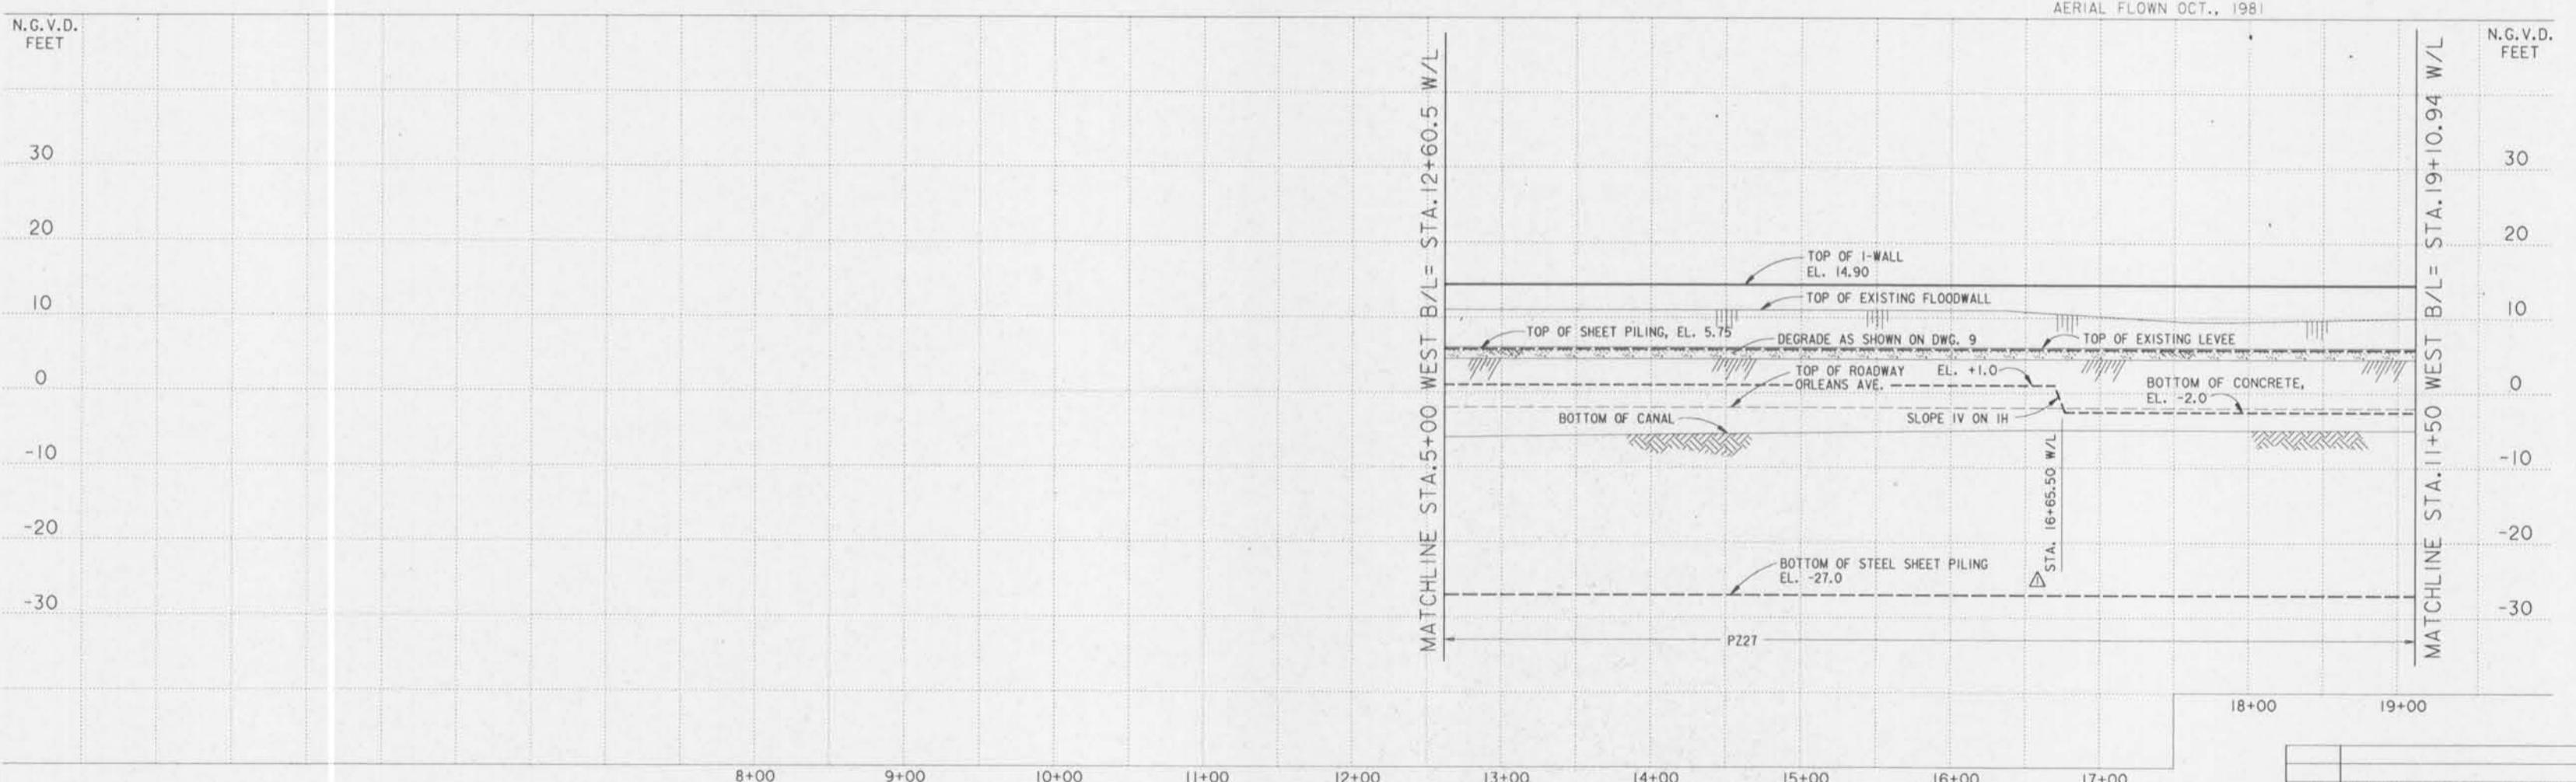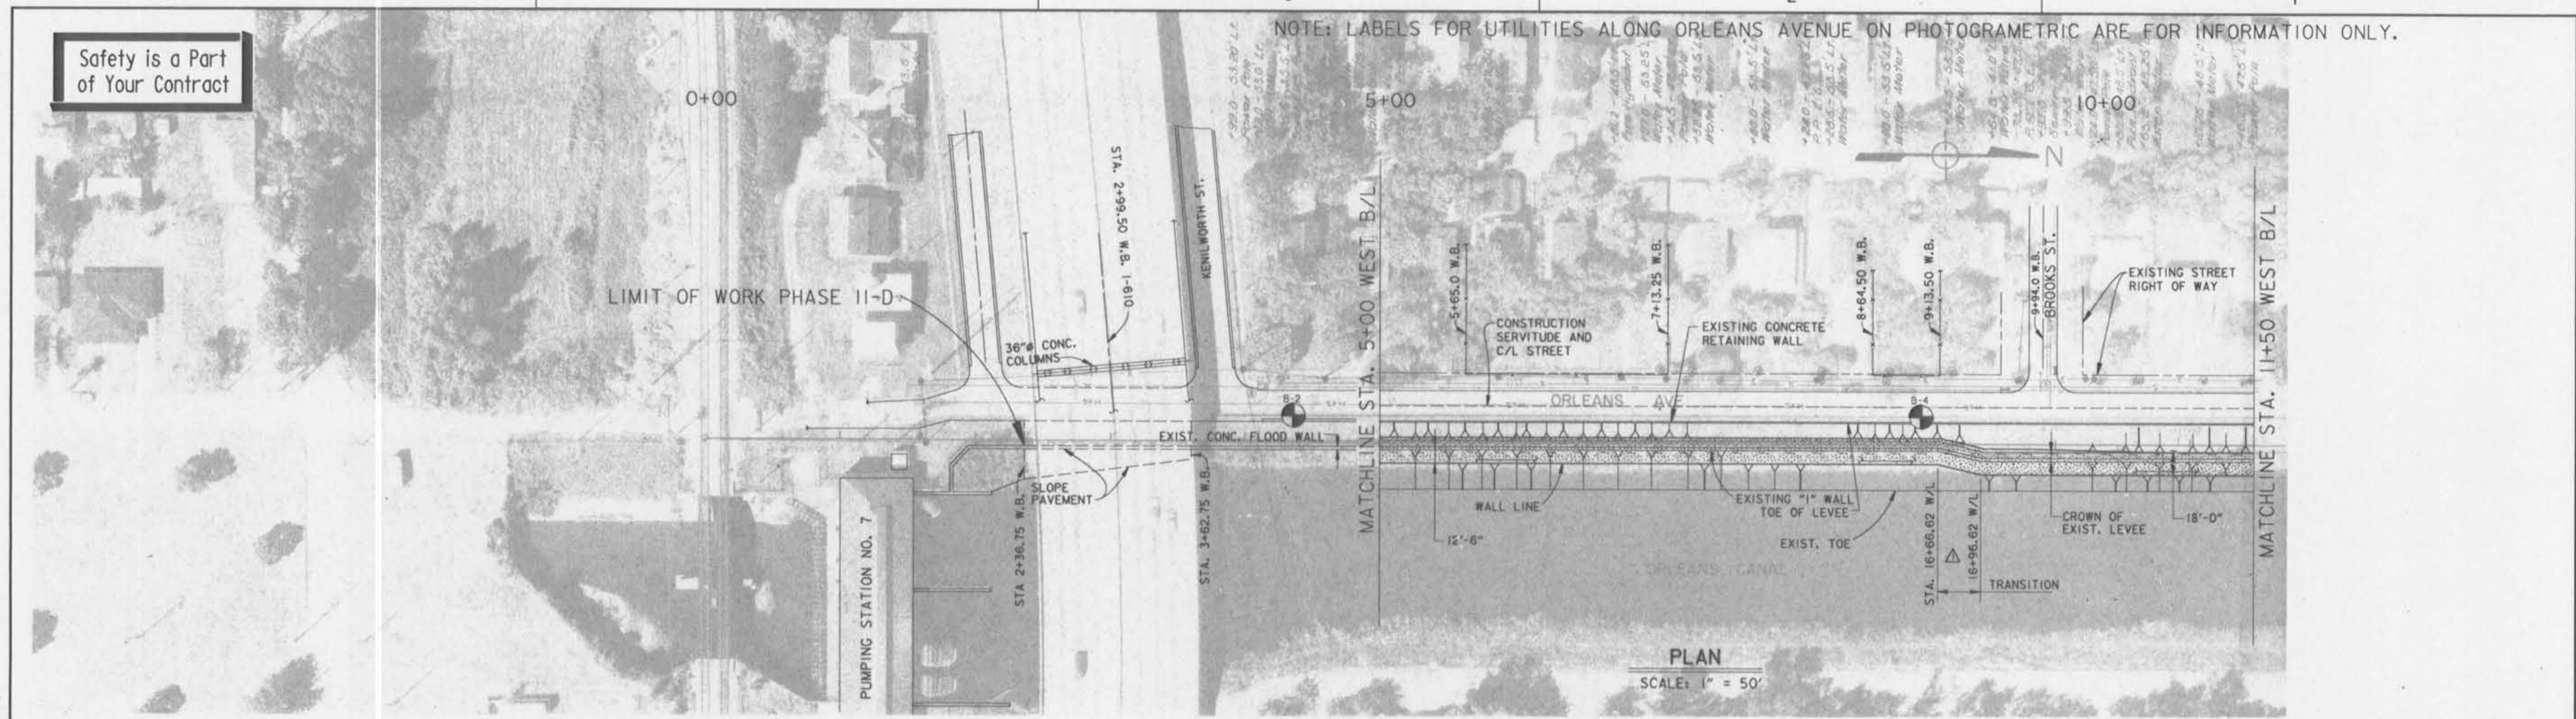


NOTES:

1. WALL LINE STATIONING IS MEASURED ALONG FLOOD SIDE FACE OF CONCRETE.
2. USE OF A VIBRATORY HAMMER TO DRIVE SHEET PILING WITHIN LDOTD RIGHTS-OF-WAY IS REQUIRED. THE PRESENCE OF AN LDOTD INSPECTOR IS REQUIRED FOR ALL WORK PERFORMED WITHIN THE RIGHTS-OF-WAY.
3. FOR SHEET PILING LAYOUT, SEE DWG. 10.
4. FOR SHEET PILING CONNECTION DETAILS, SEE DWG. 14.



WEST SIDE PROFILE

SCALE: 1" = 50' HORIZ.

1" = 10' VERT.

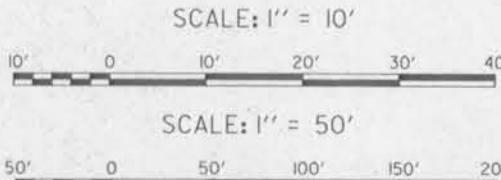

	REVISED W/L STATIONING, AMENDMENT NO. 1, 5-11-93 M.D.
SYMBOL	DESCRIPTION
	DATE APPROVED
REVISIONS	
U.S. ARMY ENGINEER DISTRICT, NEW ORLEANS CORPS OF ENGINEERS NEW ORLEANS, LOUISIANA	
BOARD OF LEVEE COMMISSIONERS NEW ORLEANS, LOUISIANA	
DESIGN ENGINEERING, INC. 3330 W. ESPLANADE AVE., S. METAIRIE, LOUISIANA 70002	
LAKE PONTCHARTRAIN, LA. AND VICINITY HIGH LEVEL PLAN	
NEW ORLEANS LAKEFRONT LEVEE WEST OF I.H.N.C.	
ORLEANS AVE. CANAL FLOOD PROTECTION IMPROVEMENT PHASE II-D (WEST SIDE: B/L STA. 2+39.00 TO STA. 29+07.50) ORLEANS PARISH, LOUISIANA	
PLAN/PROFILE STAS. 5+00 W.B. TO 11+50 W.B.	
DESIGNED BY: M.B. SHUKLA DRAWN BY: K.C.R. & G.F.G. CHECKED BY: T.M. SMITH SUBMITTED BY: DESIGN ENGINEERING, INC. SOLICITATION NO. DACW29-93-B-0042 DESIGN ENGINEER	DATE: FEB., 1993 PLOT SCALE: 50' PLOT DATE: MAY 1993 FILE NO. H-4-40205 CADD FILE #: II-006 DWG. 6 OF 24

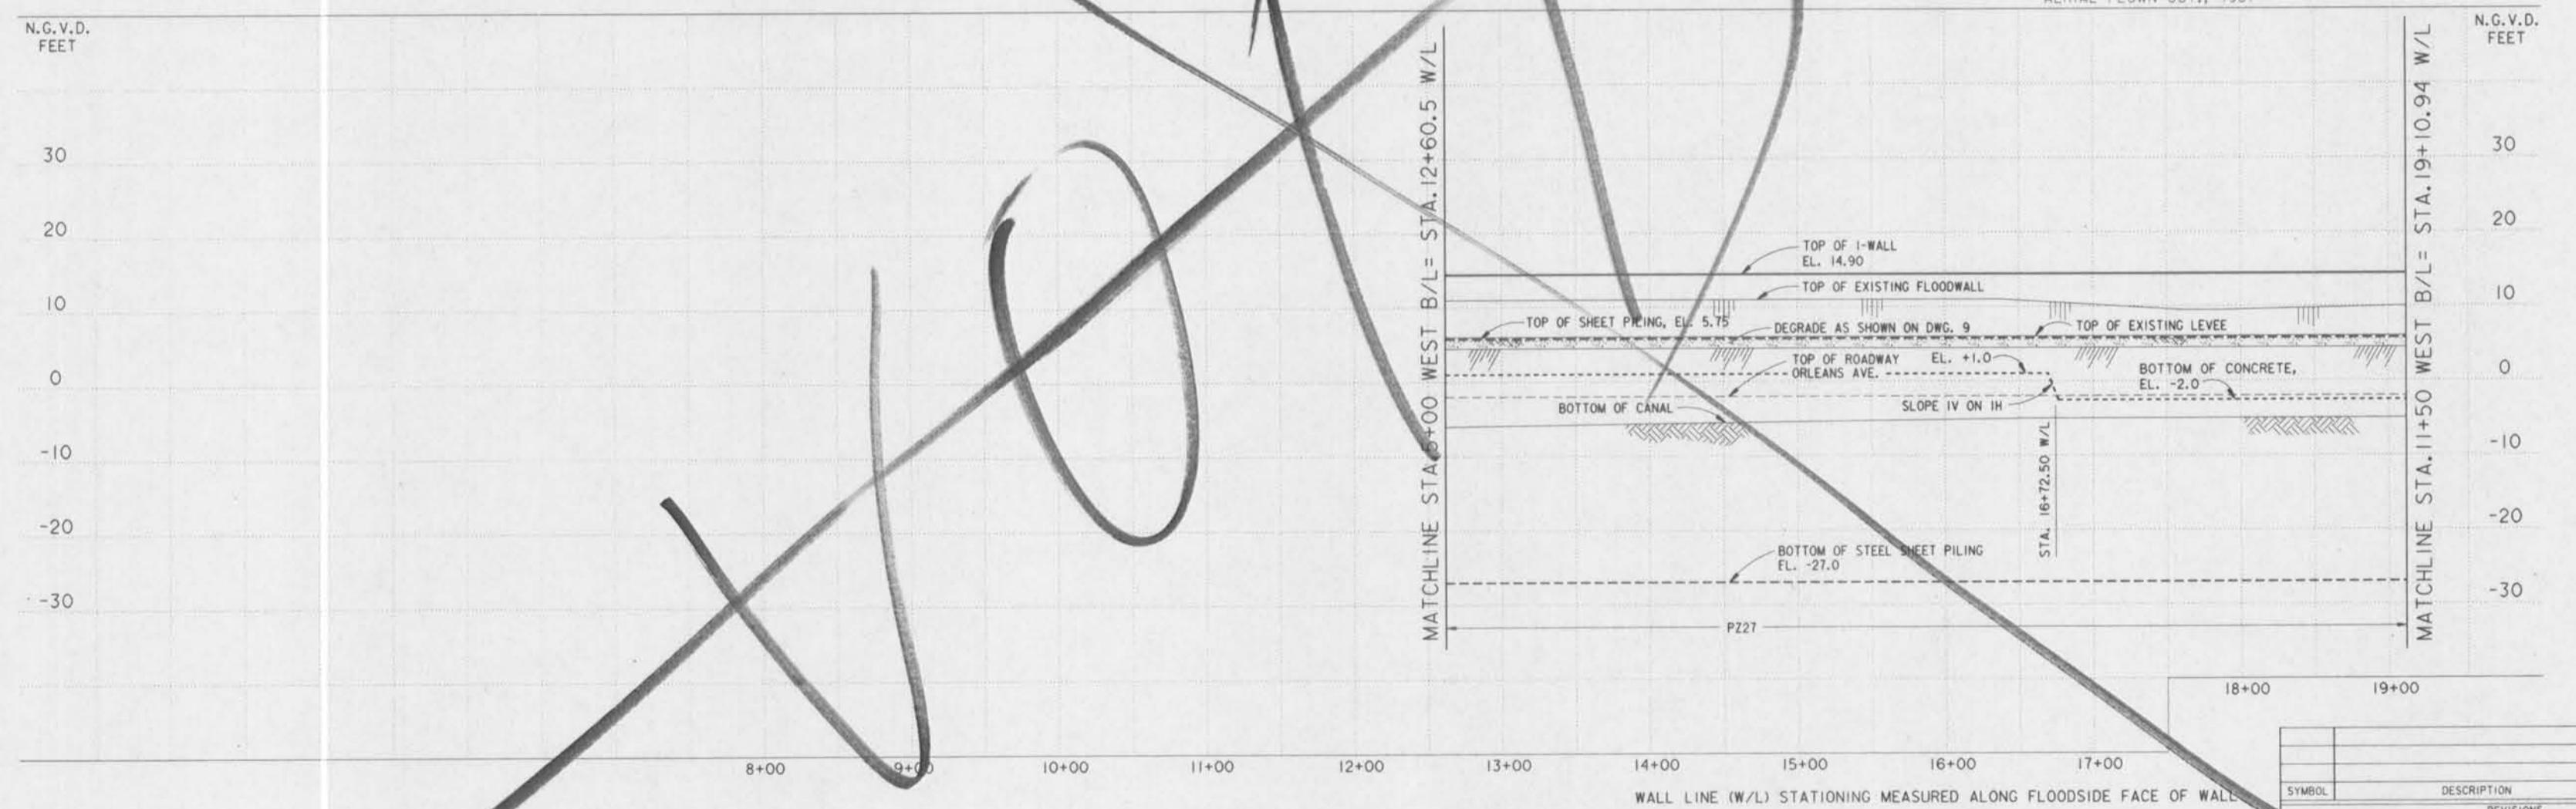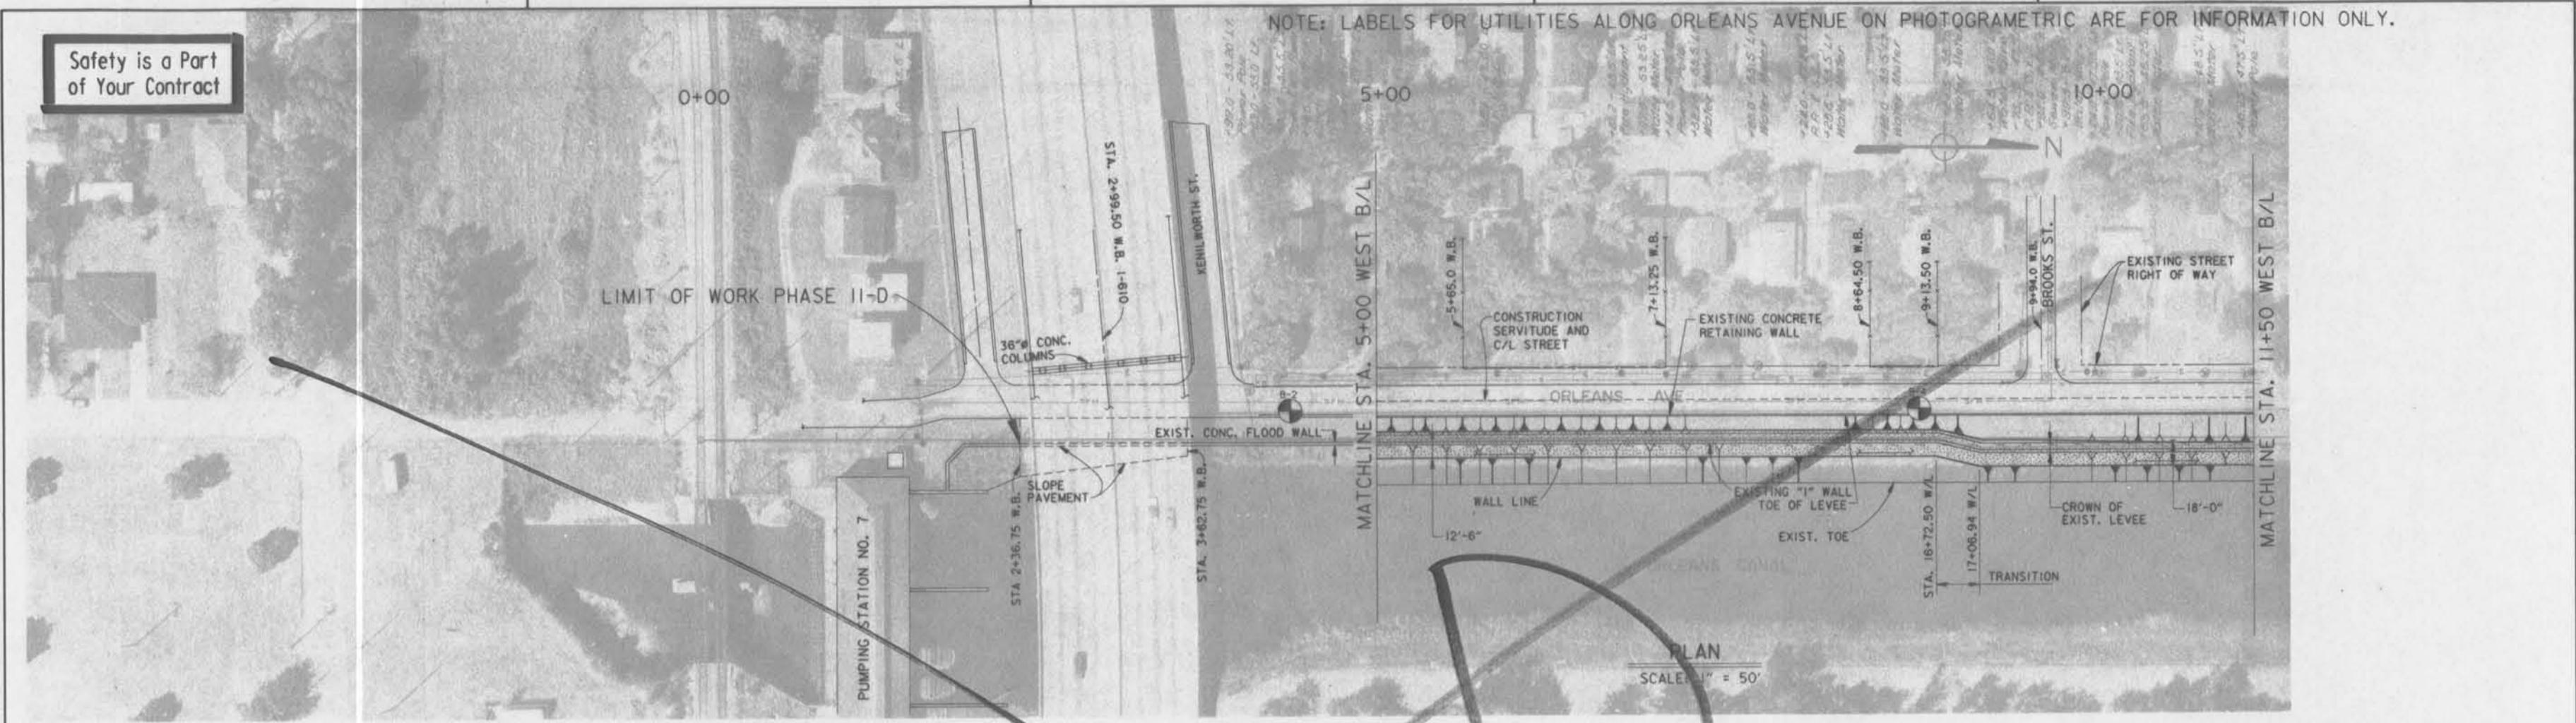

NOTES:

1. WALL LINE STATIONING IS MEASURED ALONG FLOOD SIDE FACE OF CONCRETE.
2. USE OF A VIBRATORY HAMMER TO DRIVE SHEET PILING WITHIN LDOTD RIGHTS-OF-WAY IS REQUIRED. THE PRESENCE OF AN LDOTD INSPECTOR IS REQUIRED FOR ALL WORK PERFORMED WITHIN THE RIGHTS-OF-WAY.
3. FOR SHEET PILING LAYOUT, SEE DWG. 10.
4. FOR SHEET PILING CONNECTION DETAILS, SEE DWG. 14.




WEST SIDE PROFILE

SCALE: 1" = 50' HORIZ.

1" = 10' VERT.

SCALE: 1" = 10'

SCALE: 1" = 50'

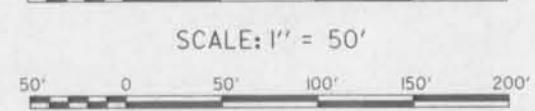

U.S. ARMY ENGINEER DISTRICT, NEW ORLEANS
CORPS OF ENGINEERS
NEW ORLEANS, LOUISIANA

BOARD OF LEVEE COMMISSIONERS
ORLEANS LEVEE DISTRICT
NEW ORLEANS, LOUISIANA 70002
LAKE PONTCHARTRAIN, LA. AND VICINITY
HIGH LEVEL PLAN


NEW ORLEANS LAKEFRONT LEVEE
WEST OF I.H.N.C.
ORLEANS AVE. CANAL FLOOD PROTECTION IMPROVEMENT
PHASE II-D (WEST SIDE: B/L STA.2+39.00 TO STA.29+07.50)
ORLEANS PARISH, LOUISIANA

PLAN/PROFILE STAS. 5+00 W.B. TO 11+50 W.B.

DESIGNED BY: M.B. SHUKLA	DATE: FEB., 1993	PLOT SCALE: 50
DRAWN BY: K.C.R. & G.F.C.		
CHECKED BY: T.M. SMITH		
SUBMITTED BY: DESIGN ENGINEERING, INC. DESIGN ENGINEER		
SOLICITATION NO.: DACW29-93-B-0042		
DWG. 6 OF 24		

Safety is a Part
of Your Contract

MATCHLINE STA. 11+50 WEST B/L

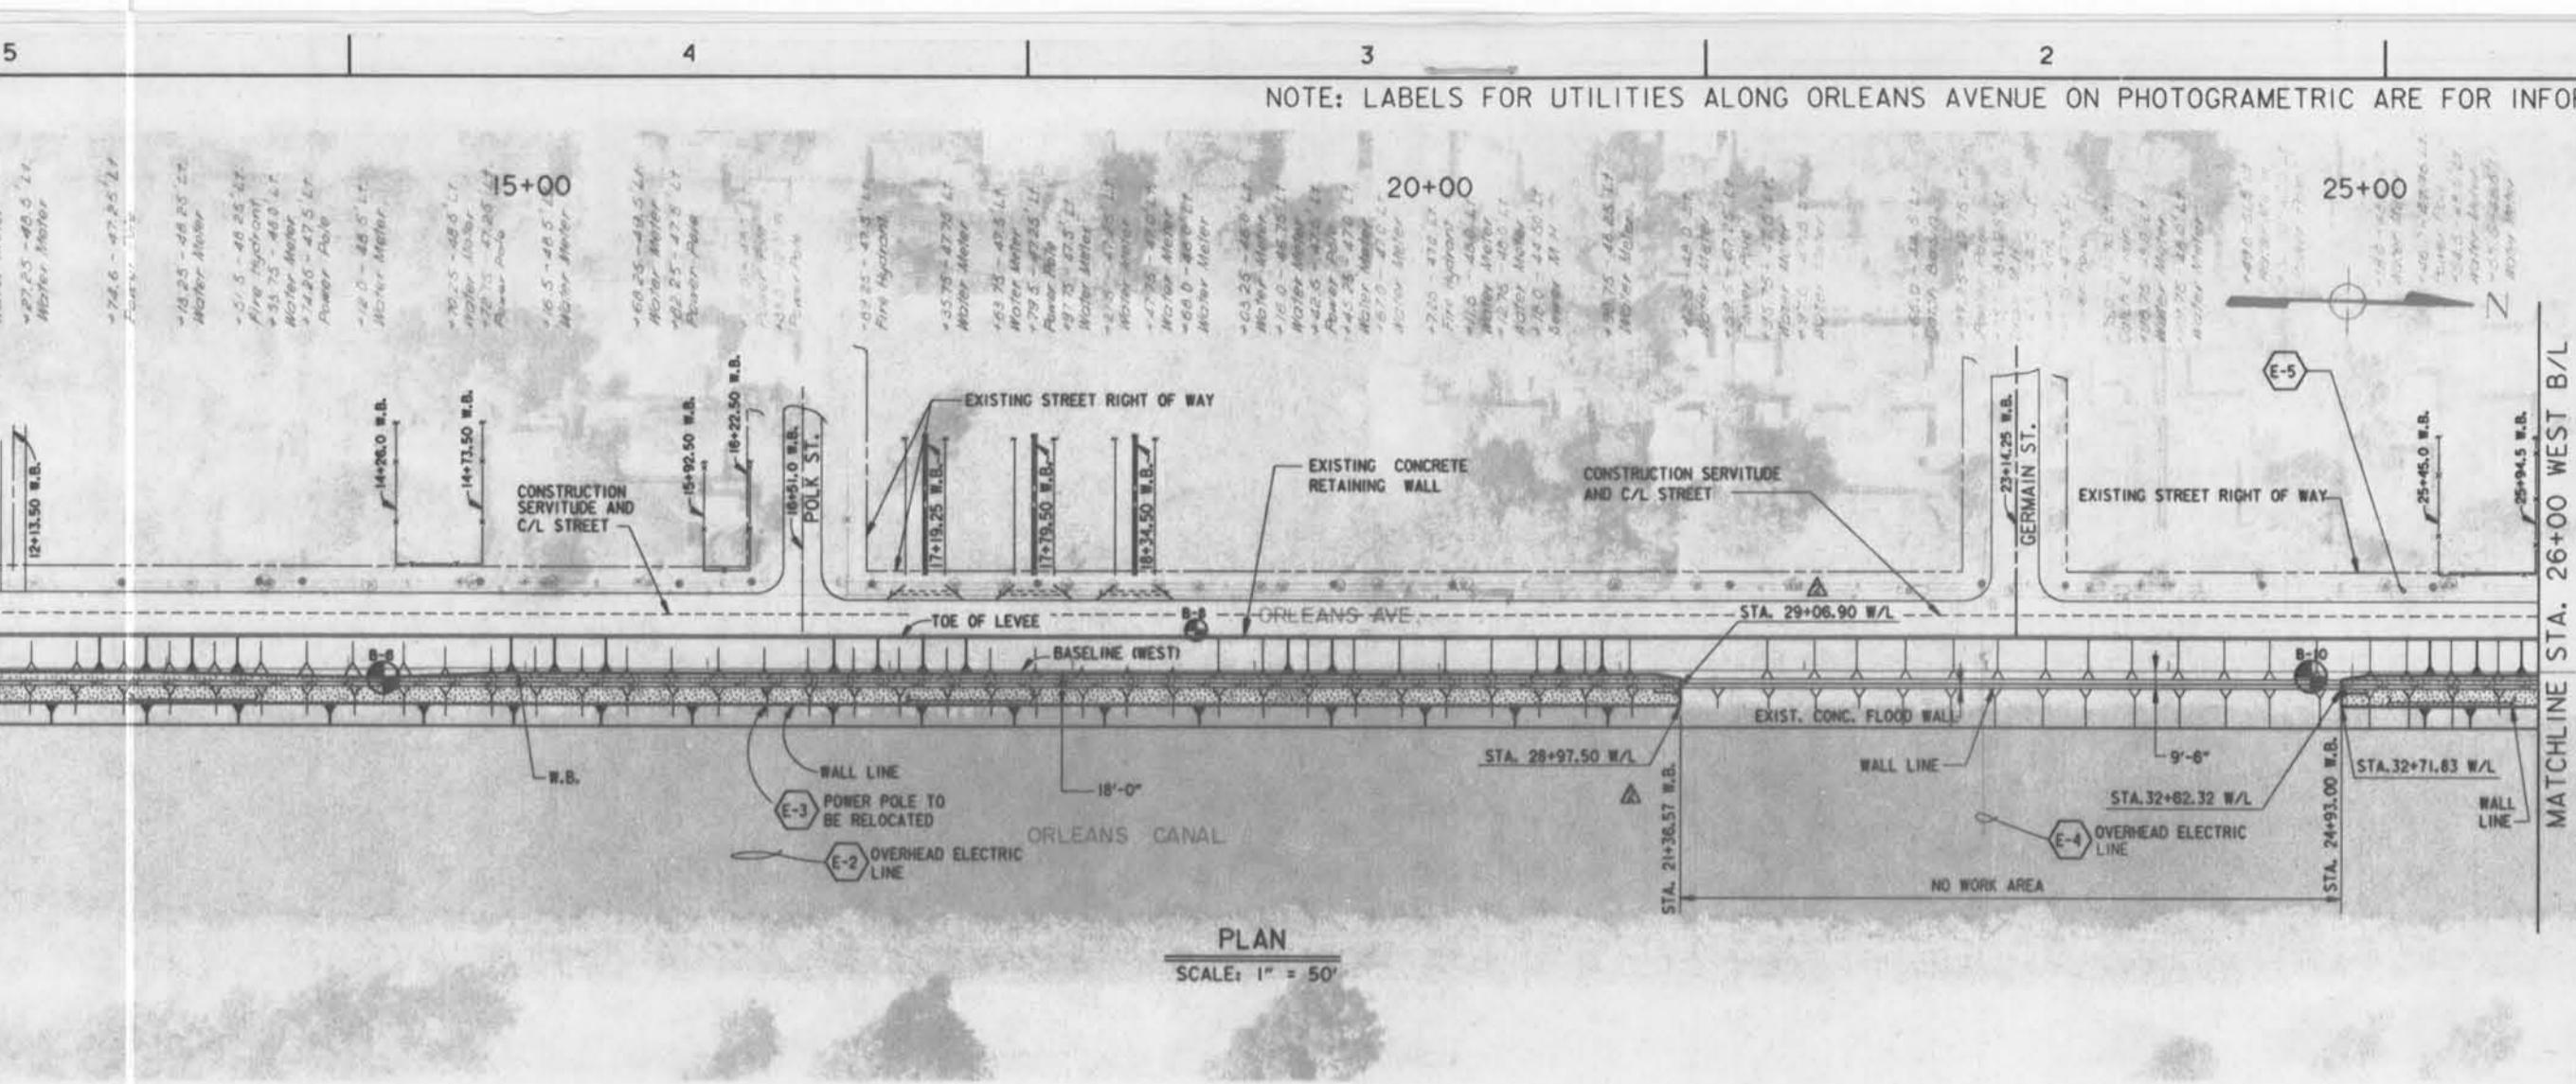


NOTE:
PROVIDE A SMOOTH TRANSITION
BETWEEN NEW AND EXISTING
LEVEE AT THE LIMITS OF THE
NO WORK AREA.

THIS PLAN ACCOMPANIES
MODIFICATION P000\$
TO CONTRACT NUMBER
DACP29-93-C-0077

N.G.V.D.
FEET

N.G.V.D.
FEET

MATCHLINE STA. 11+50 WEST B/L = STA. 19+10.94 W/L

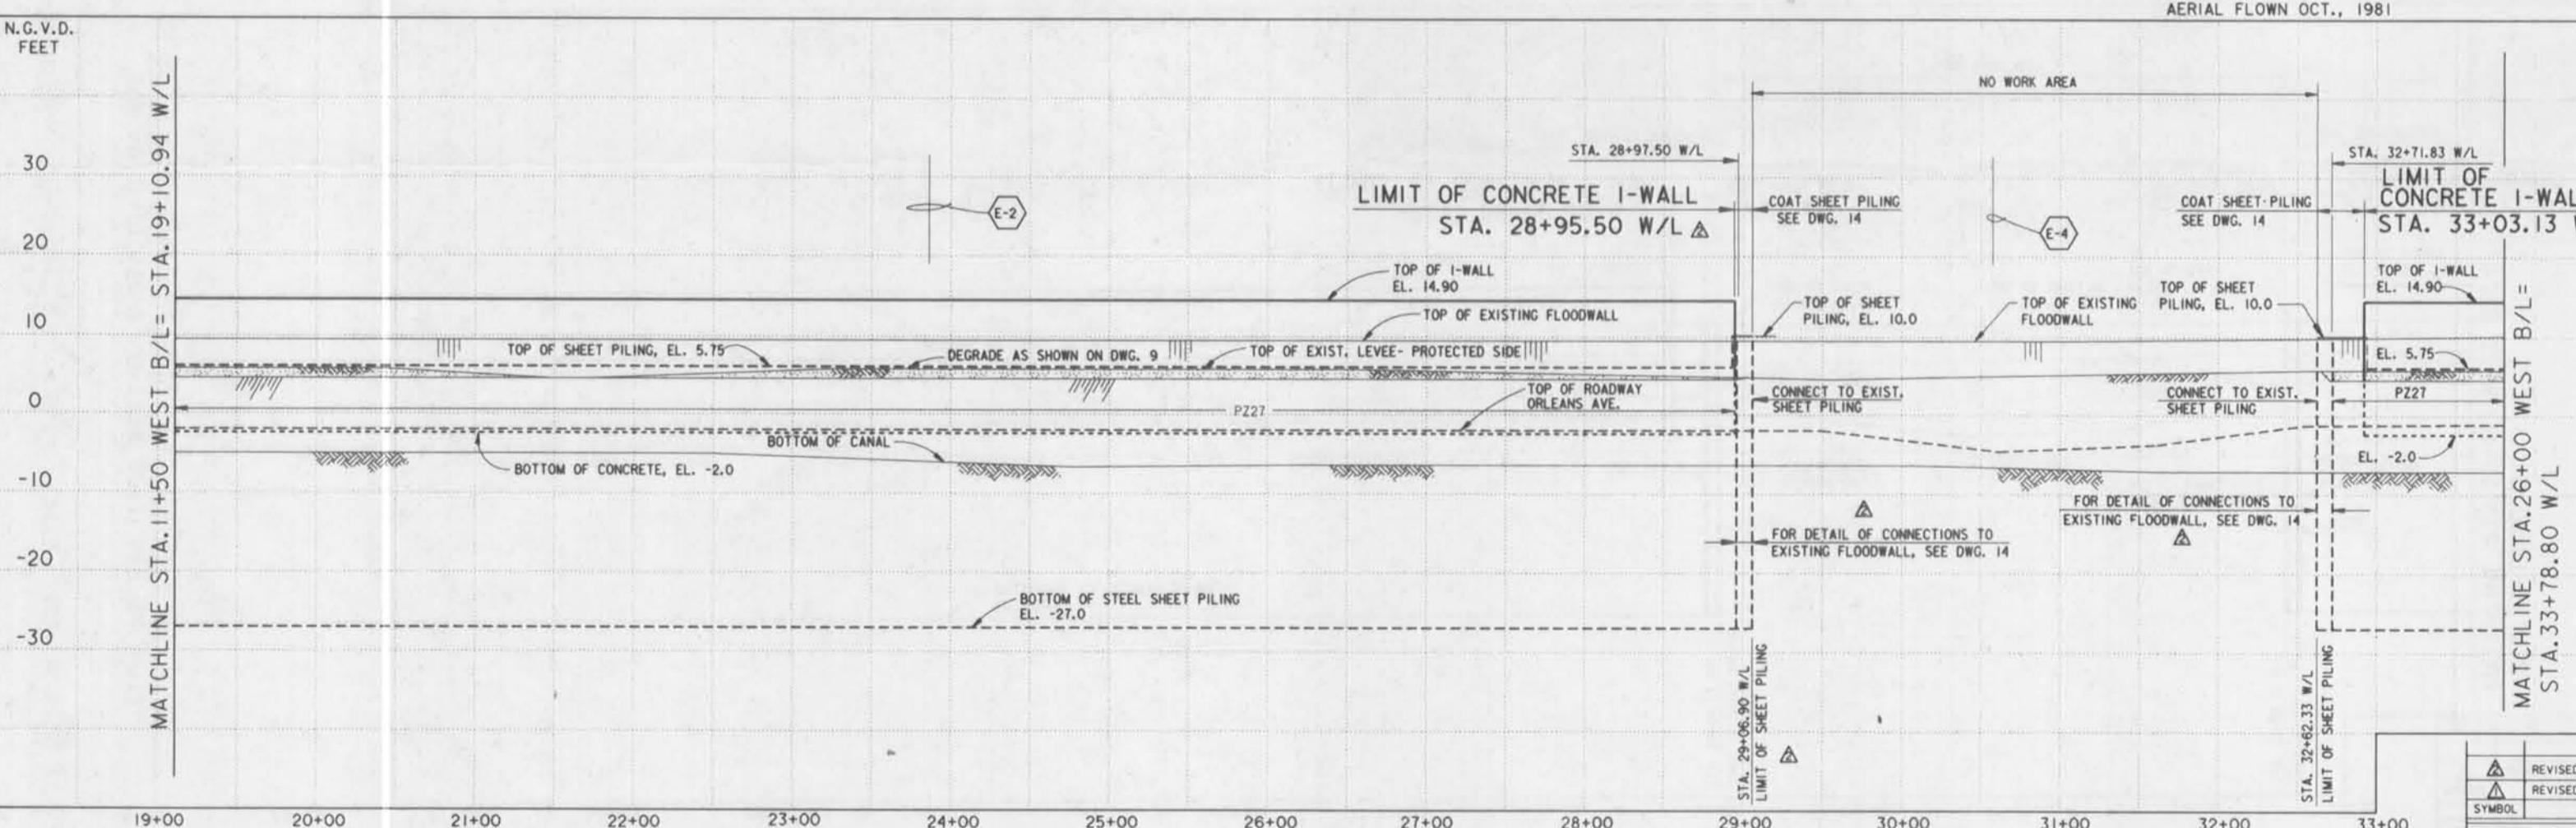

REVISIONS	REVISIED LIMITS OF I-WALL, MOD. NO. <u>3</u>	11-5-93	J.A.R.
SYMBOL	REVISED W/L STATIONING, AMENDMENT NO. <u>1</u>	5-11-93	M.D.
DESCRIPTION	DATE	APPROVED	
	REVISIED LIMITS OF I-WALL, MOD. NO. <u>3</u>	11-5-93	J.A.R.
	REVISED W/L STATIONING, AMENDMENT NO. <u>1</u>	5-11-93	M.D.

U.S. ARMY ENGINEER DISTRICT, NEW ORLEANS
CORPS OF ENGINEERS
NEW ORLEANS, LOUISIANA

BOARD OF LEVEE COMMISSIONERS
ORLEANS LEVEE DISTRICT
NEW ORLEANS, LOUISIANA

DESIGN ENGINEERING, INC.
3330 W. ESPLANADE AVE. S.
METAIRIE, LOUISIANA 70002

HIGH LEVEL PLAN
LAKE PONTCHARTRAIN, LA. AND VICINITY

NEW ORLEANS LAKEFRONT LEVEE
WEST OF I.H.N.C.
ORLEANS AVE. CANAL FLOOD PROTECTION IMPROVEMENT
PHASE II-D (WEST SIDE: B/L STA. 24+39.00 TO STA. 29+07.50)
ORLEANS PARISH, LOUISIANA

PLAN/PROFILE STAS. 11+50 W.B. TO 26+00 W.B.


DESIGNED BY: M.B. SHUKLA
DRAWN BY: K.C.R. & G.F.G.
CHECKED BY: T.M. SMITH
SUBMITTED BY: DESIGN ENGINEERING, INC.
SOLICITATION NO.: DACW29-93-B-0042

DATE: FEB 1994
PLOT SCALE: 1" = 50'
FILE NO.: H-4-40205
CADD FILE: II-D07
DWG. 7 OF 24

EXISTING UTILITIES				
ITEM NO.	DESCRIPTION	W.B. STA.	OWNER	DISPOSITION
E-2	AERIAL POWER LINE	16+30	NEW ORLEANS PUBLIC SERVICE, INC.	TO BE RELOCATED ON A DAILY BASIS BY OTHERS.
E-3	POWER POLE	16+30	NEW ORLEANS PUBLIC SERVICE, INC.	REMOVED PREVIOUS TO CONTRACT AWARD.
E-4	GUY WIRE FOR HIGH VOLTAGE TOWER	22+97	NEW ORLEANS PUBLIC SERVICE, INC.	NOT AFFECTED.
E-5	AERIAL POWER LINES 13,000 VOLTS TRANSMISSION	ALONG ORLEANS AVENUE	NEW ORLEANS PUBLIC SERVICE, INC.	TO BE DE-ENERGIZED AS REQUIRED BY OTHERS.

WEST SIDE PROFILE


SCALE: 1" = 50' HORIZ.
1" = 10' VERT.

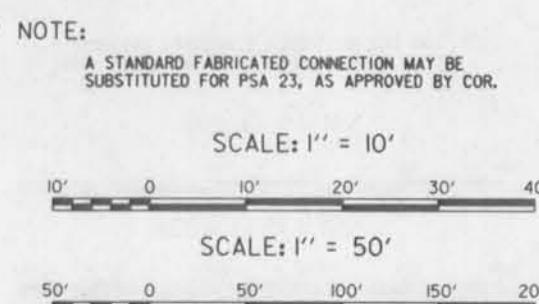

** NOTE:

A STANDARD FABRICATED CONNECTION MAY BE
SUBSTITUTED FOR PSA 23, AS APPROVED BY COR.

SCALE: 1" = 10'


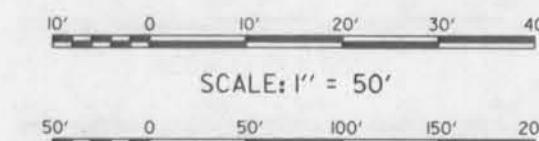


SCALE: 1" = 50'

- NOTES:
1. WALL LINE STATIONING IS MEASURED ALONG FLOOD SIDE FACE OF CONCRETE.
 2. FOR SHEET PILING LAYOUT, SEE DWG. 10.
 3. FOR SHEET PILING CONNECTION DETAILS, SEE DWG. 14.

Safety is a Part
of Your Contract

NOTE: LABELS FOR UTILITIES ALONG ORLEANS AVENUE ON PHOTOGRAFETRIC ARE FOR INFORMATION ONLY.

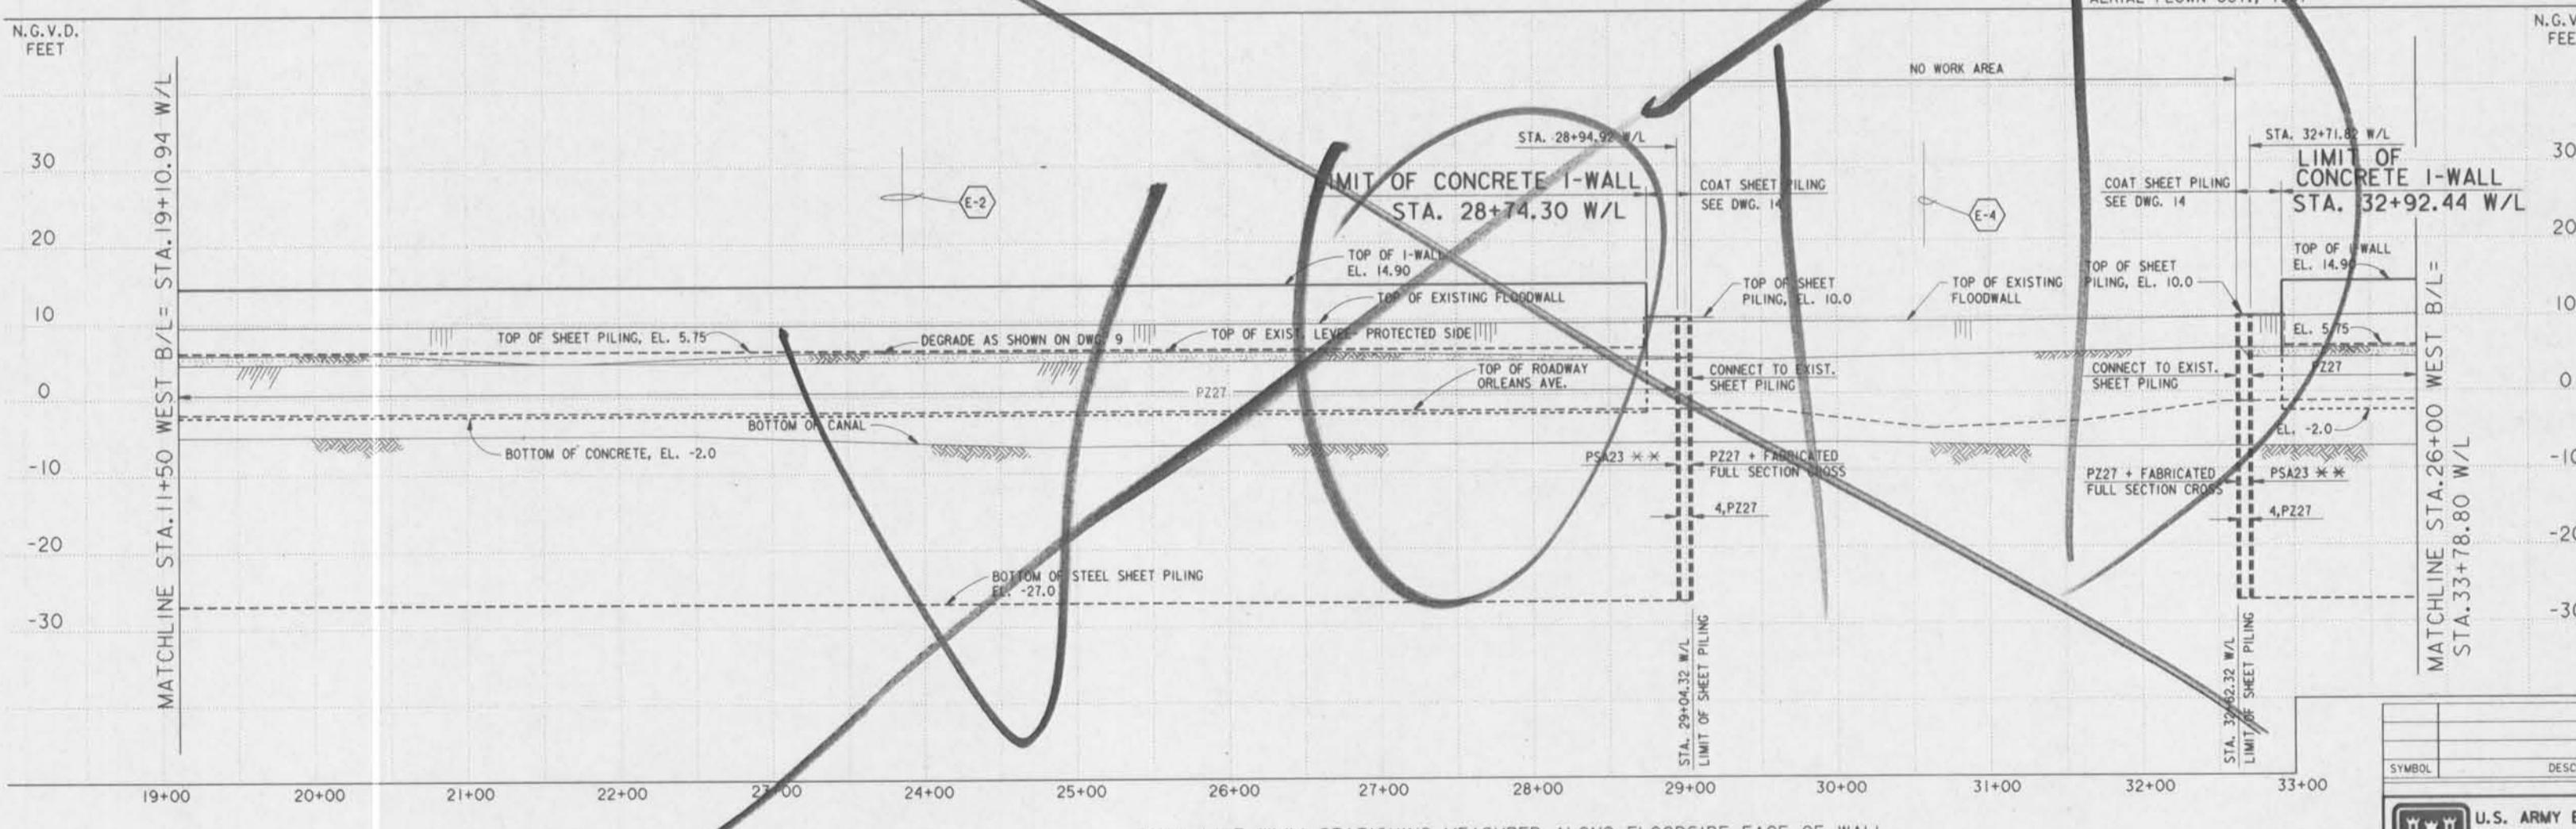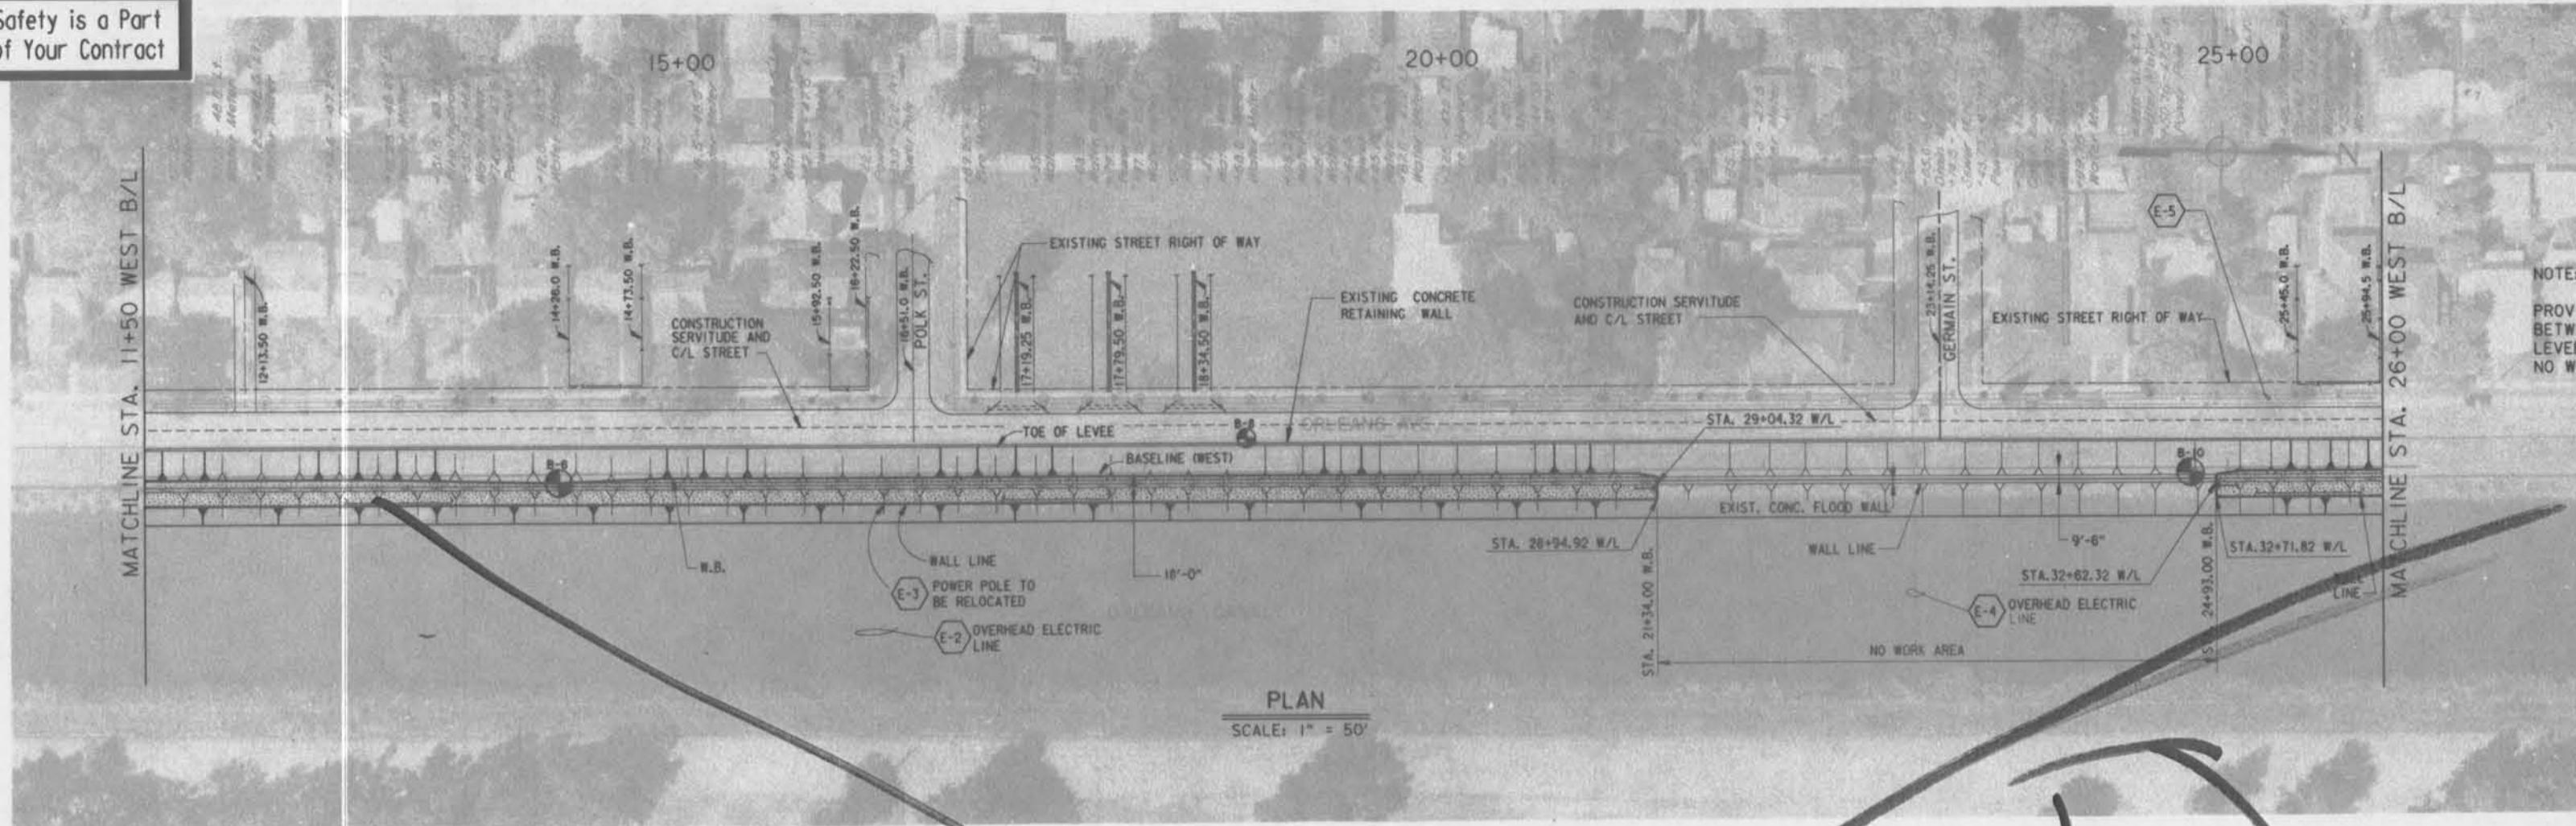

EXISTING UTILITIES				
ITEM NO.	DESCRIPTION	W.B. STA.	OWNER	DISPOSITION
E-2	AERIAL POWER LINE	16+30	NEW ORLEANS PUBLIC SERVICE, INC.	TO BE RELOCATED ON A DAILY BASIS BY OTHERS.
E-3	POWER POLE	16+30	NEW ORLEANS PUBLIC SERVICE, INC.	REMOVED PREVIOUS TO CONTRACT AWARD.
E-4	GUY WIRE FOR HIGH VOLTAGE TOWER	22+97	NEW ORLEANS PUBLIC SERVICE, INC.	NOT AFFECTED.
E-5	AERIAL POWER LINES 13,000 VOLTS TRANSMISSION	ALONG ORLEANS AVENUE	NEW ORLEANS PUBLIC SERVICE, INC.	TO BE DE-ENERGIZED AS REQUIRED BY OTHERS.

WEST SIDE PROFILE


SCALE: 1" = 50' HORIZ.
1" = 10' VERT.

** NOTE:

A STANDARD FABRICATED CONNECTION MAY BE SUBSTITUTED FOR PSA 23, AS APPROVED BY COR.

SCALE: 1" = 10'



SCALE: 1" = 50'

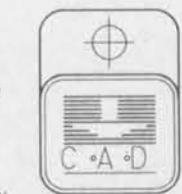

- NOTES:
 1. WALL LINE STATIONING IS MEASURED ALONG FLOOD SIDE FACE OF CONCRETE.
 2. FOR SHEET PILING LAYOUT, SEE DWG. 10.
 3. FOR SHEET PILING CONNECTION DETAILS, SEE DWG. 14.



SYMBOL	DESCRIPTION	DATE APPROVED
REVISIONS		
U.S. ARMY ENGINEER DISTRICT, NEW ORLEANS CORPS OF ENGINEERS NEW ORLEANS, LOUISIANA		
BOARD OF LEVEE COMMISSIONERS ORLEANS LEVEE DISTRICT NEW ORLEANS, LOUISIANA 7002		DESIGN ENGINEERING, INC. 3330 W. ESPANADE AVE., S. METAIRIE, LOUISIANA 70022
LAKE PONTCHARTRAIN, LA. AND VICINITY HIGH LEVEL PLAN		
NEW ORLEANS LAKEFRONT LEVEE WEST OF I.H.N.C. NEW ORLEANS CANAL FLOOD PROTECTION IMPROVEMENT PHASE II-D (WEST SIDE: B/L STA. 2+39.00 TO STA. 29+07.50) ORLEANS PARISH, LOUISIANA		
PLAN/PROFILE STAS. 11+50 W.B. TO 26+00 W.B.		
DESIGNED BY: M.B. SHUKLA	DRAWN BY: K.C.R. & G.F.G.	PLOT SCALE: 50'
CHECKED BY: T.M. SMITH	CADD FILE: II-D07	FILE NO. H-4-40205
SUBMITTED BY: DESIGN ENGINEERING, INC.	SOLICITATION NO. DACW29-93-B-0042	DWG. 7 OF 24

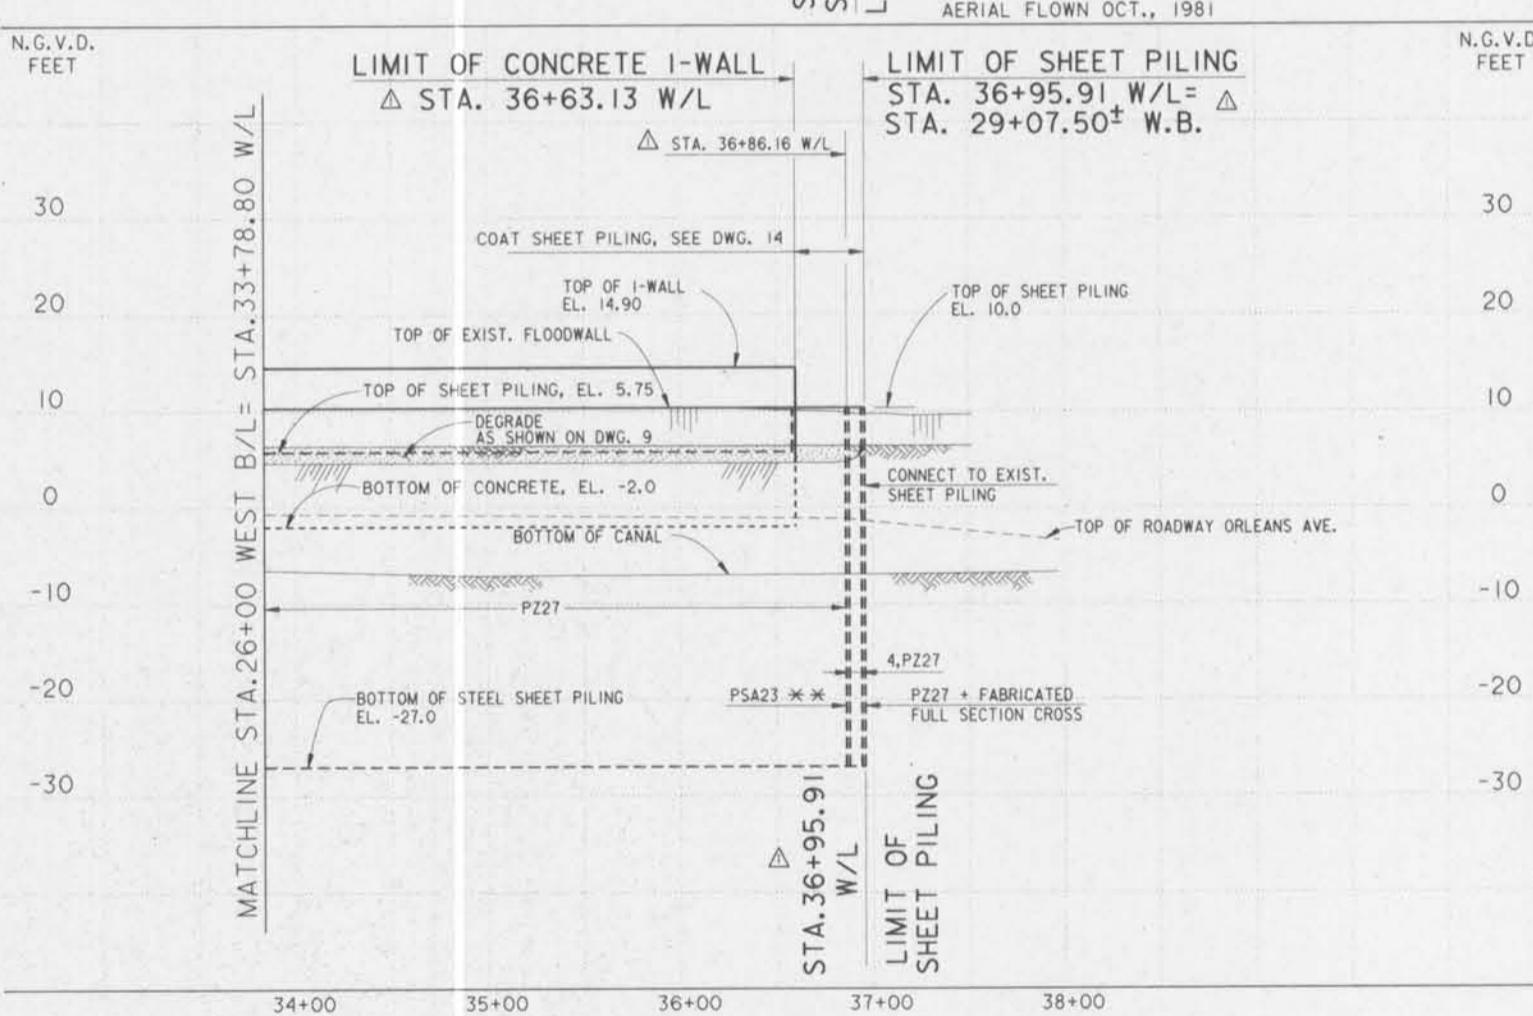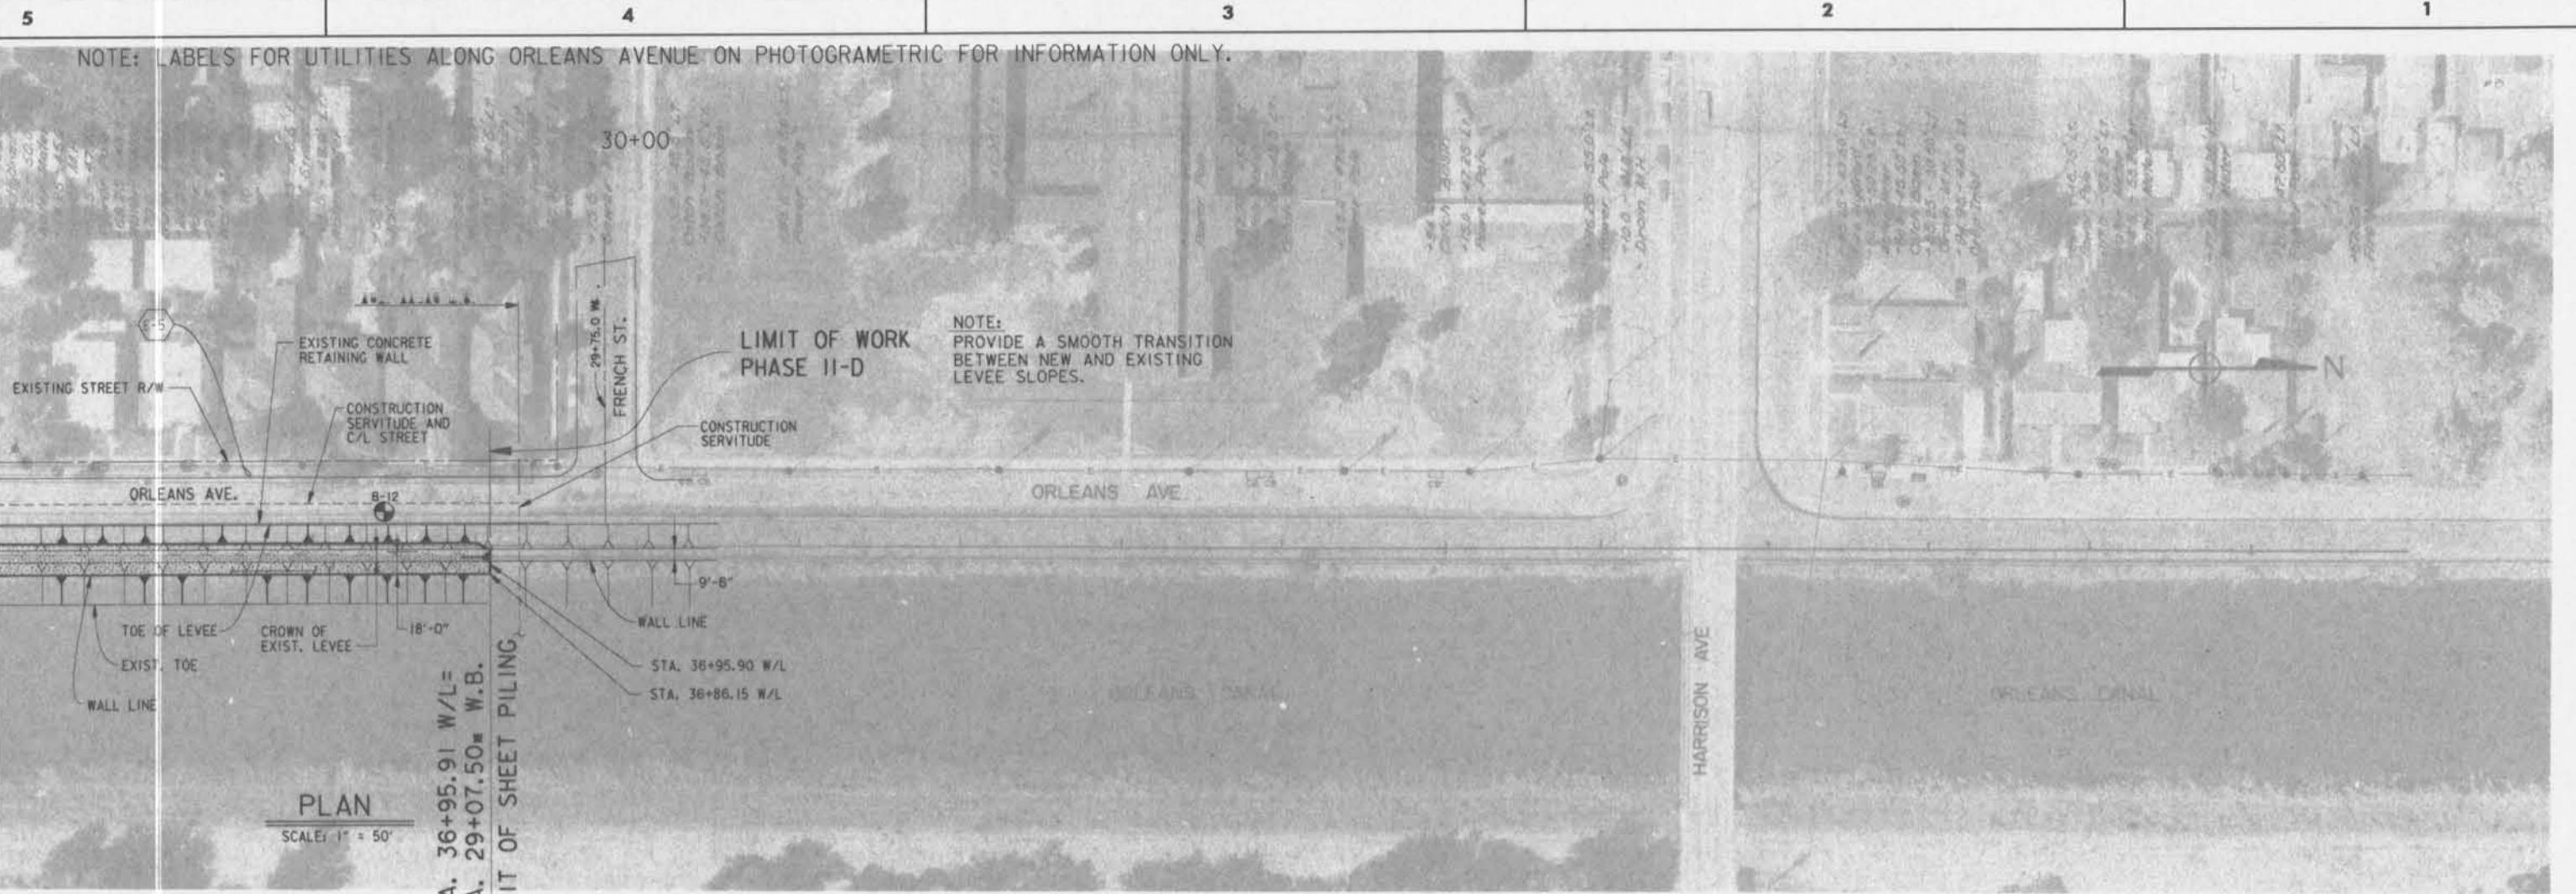

WALL LINE (W/L) STATIONING MEASURED ALONG FLOOD SIDE FACE OF WALL

WEST SIDE PROFILE

SCALE: 1" = 50' HORIZ.
1" = 10' VERT.

SCALE: 1" = 10'

SCALE: 1" = 50'

SCALE: 1" = 50'

** NOTE:
A STANDARD FABRICATED CONNECTION MAY BE SUBSTITUTED FOR PSA 23, AS APPROVED BY THE COR.

NOTES:

1. WALL LINE STATIONING IS MEASURED ALONG FLOOD SIDE FACE OF CONCRETE.
2. FOR SHEET PILING LAYOUT, SEE DWG. 10.
3. FOR SHEET PILING CONNECTION DETAILS, SEE DWG. 14.


EXISTING UTILITIES.				
ITEM NO.	DESCRIPTION	STA. W/L	OWNER	DISPOSITION
E-5	AERIAL POWER LINES 13,000 VOLTS TRANSMISSION	ALONG ORLEANS AVENUE	NEW ORLEANS PUBLIC SERVICE, INC.	TO BE DE-ENERGIZED AS REQUIRED BY OTHERS.




REVISED W/L STATIONING, AMENDMENT NO. 1.	5-11-93	M.D.
SYMBOL	DESCRIPTION	DATE APPROVED
REVISIONS		
U.S. ARMY ENGINEER DISTRICT, NEW ORLEANS CORPS OF ENGINEERS NEW ORLEANS, LOUISIANA		
BOARD OF LEVEE COMMISSIONERS ORLEANS LEVEE DISTRICT NEW ORLEANS, LOUISIANA	DESIGN ENGINEERING, INC. 3330 W. ESPLANADE AVE. S. METAIRIE, LOUISIANA 70002	
LAKE PONTCHARTRAIN, LA. AND VICINITY HIGH LEVEL PLAN		
NEW ORLEANS LAKEFRONT LEVEE WEST OF I.H.N.C. ORLEANS AVE. CANAL FLOOD PROTECTION IMPROVEMENT PHASE II-D (WEST SIDE B/L: STA.2+39.00 TO STA.29+07.50) ORLEANS PARISH, LOUISIANA		
PLAN/PROFILE STAS. 26+00 W.B. TO 29+06.30 W.B.		
DESIGNED BY: M.B. SHUKLA DRAWN BY: K.C.R. & G.F.G. CHECKED BY: T.M. SMITH SUBMITTED BY: DESIGN ENGINEERING, INC. DESIGN ENGINEER	PLOT DATE: MAY 1993 PLOT SCALE: 50 FILE NO. H-4-40205 SOLICITATION NO. DACW29-93-B-0042 DWG. 8 OF 24	

Safety is a Part
of Your Contract

NOTE: LABELS FOR UTILITIES ALONG ORLEANS AVENUE ON PHOTOGRAFETRIC FOR INFORMATION ONLY.

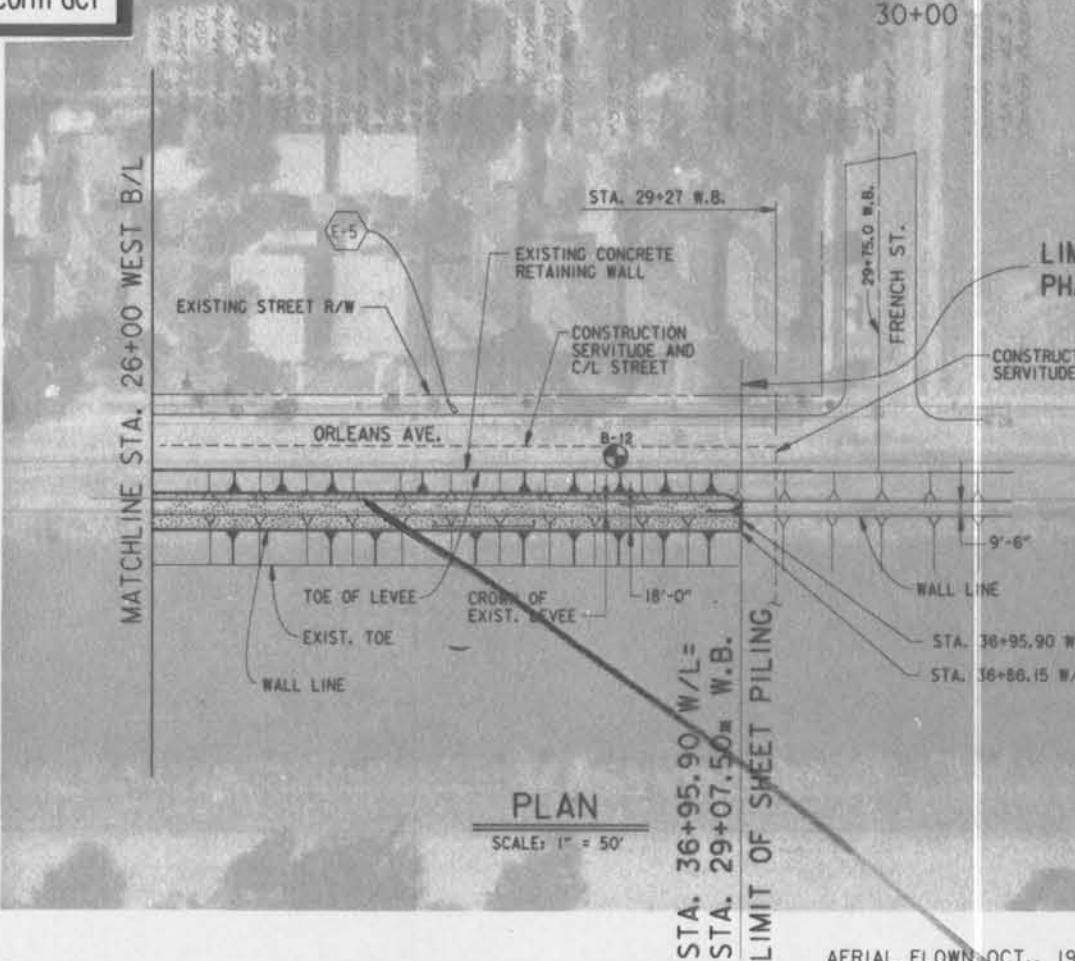

NOTE:
PROVIDE A SMOOTH TRANSITION
BETWEEN NEW AND EXISTING
LEVEE SLOPES.

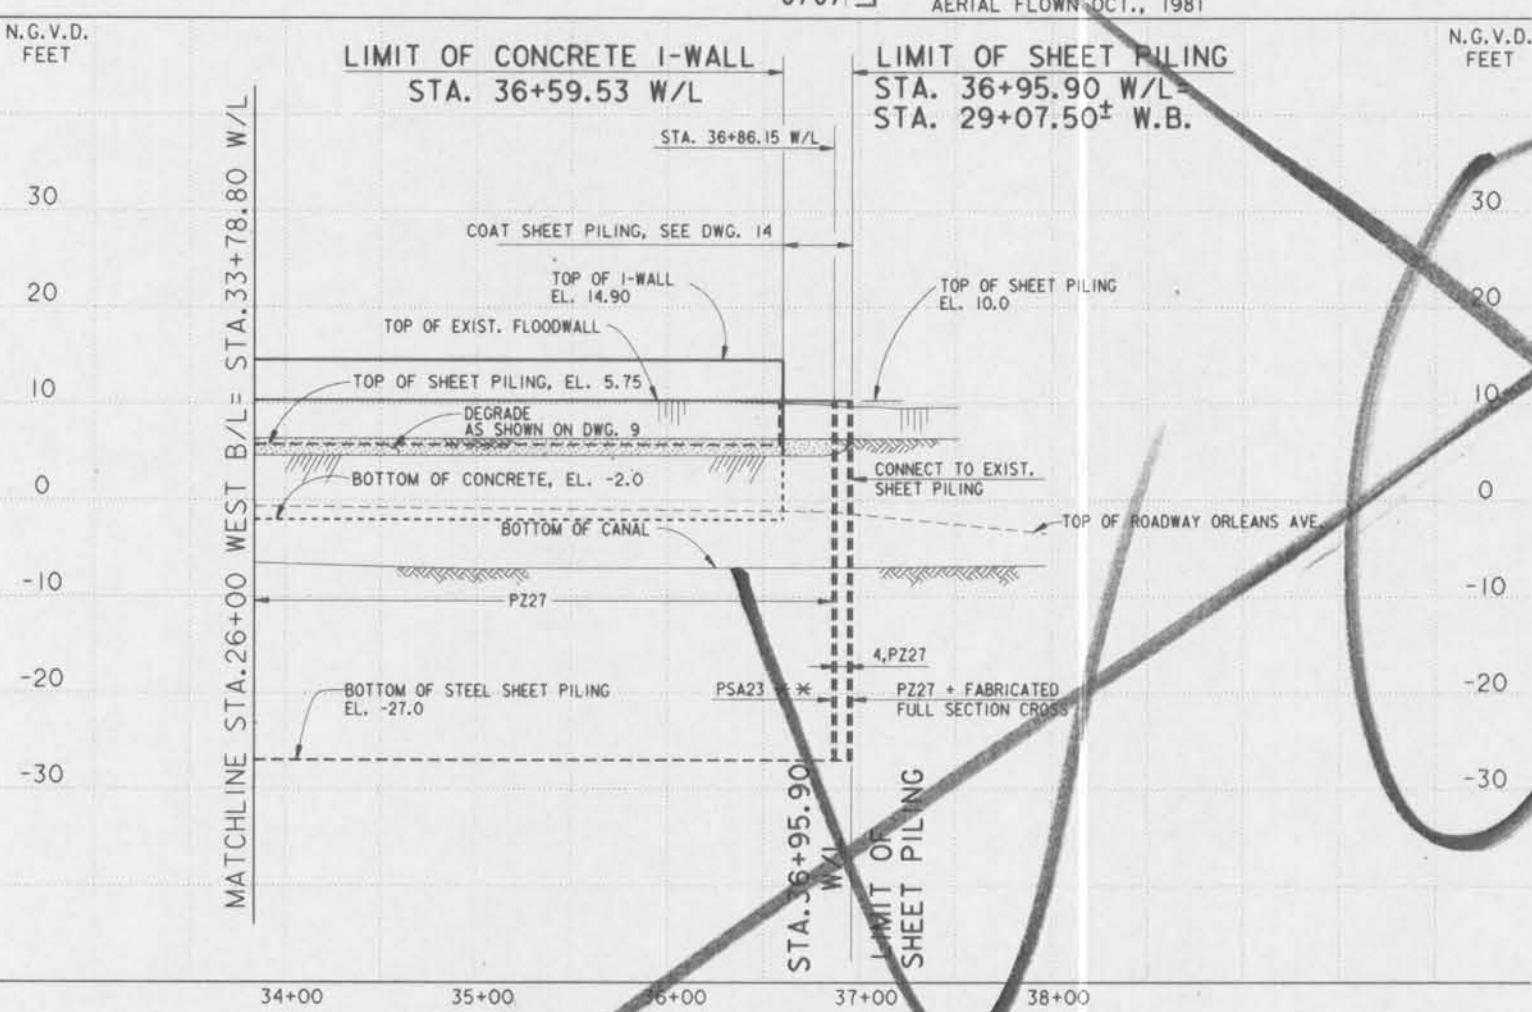

NOTES:

1. WALL LINE STATIONING IS MEASURED ALONG FLOOD SIDE FACE OF CONCRETE.
2. FOR SHEET PILING LAYOUT, SEE DWG. 10.
3. FOR SHEET PILING CONNECTION DETAILS, SEE DWG. 14.

** NOTE:

A STANDARD FABRICATED CONNECTION MAY BE SUBSTITUTED FOR PSA 23, AS APPROVED BY THE COR.

WEST SIDE PROFILE

SCALE: 1" = 50' HORIZ.
1" = 10' VERT.

SCALE: 1" = 10'

SCALE: 1" = 50'

50' 0 50' 100' 150' 200'



EXISTING UTILITIES				
ITEM NO.	DESCRIPTION	STA. W/L	OWNER	DISPOSITION
E-5	AERIAL POWER LINES 13,000 VOLTS TRANSMISSION	ALONG ORLEANS AVENUE	NEW ORLEANS PUBLIC SERVICE, INC.	TO BE DE-ENERGIZED AS REQUIRED BY OTHERS.



REVISIONS	SYMBOL	DESCRIPTION	DATE	APPROVED

U.S. ARMY ENGINEER DISTRICT, NEW ORLEANS
CORPS OF ENGINEERS
NEW ORLEANS, LOUISIANA

BOARD OF LEVEE COMMISSIONERS NEW ORLEANS, LOUISIANA	DESIGN ENGINEERING, INC. 3330 W. ESPLANADE AVE. S. METAIRIE, LOUISIANA 70002
LAKE PONTCHARTRAIN, LA. AND VICINITY HIGH LEVEL PLAN	

NEW ORLEANS LAKEFRONT LEVEE
WEST OF I.H.N.C.
ORLEANS AVE. CANAL FLOOD PROTECTION IMPROVEMENT
PHASE II-D (WEST SIDE B/L: STA.2+39.00 TO STA.29+07.50)
ORLEANS PARISH, LOUISIANA

PLAN/PROFILE STAS. 26+00 W.B. TO 29+06.30 W.B.

DESIGNED BY: M.B. SHUKLA	DATE: FEB., 1993	PLOT SCALE: 50
DRAWN BY: K.C.R. & G.F.G.	CHECKED BY: T.M. SMITH	PLOT DATE: MARCH 1993
SUBMITTED BY: DESIGN ENGINEERING, INC.	CADD FILE: II-DOB	FILE NO. H-4-40205
DESIGN ENGINEER	SOLICITATION NO. DACW29-93-B-0042	DWG. 8 OF 24

Safety is a Part
of Your Contract



5

4

3

2


1

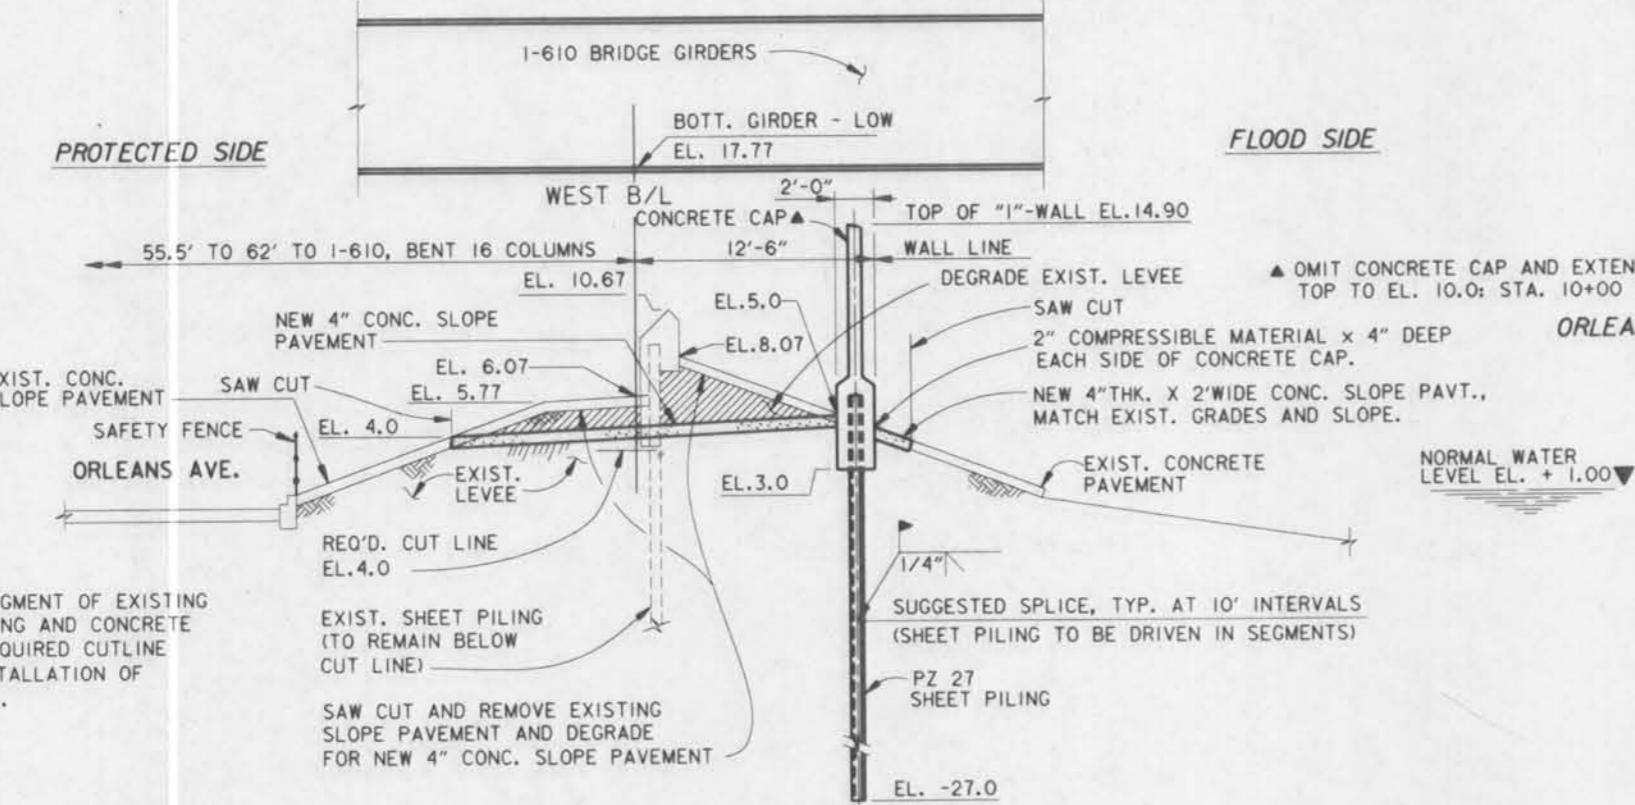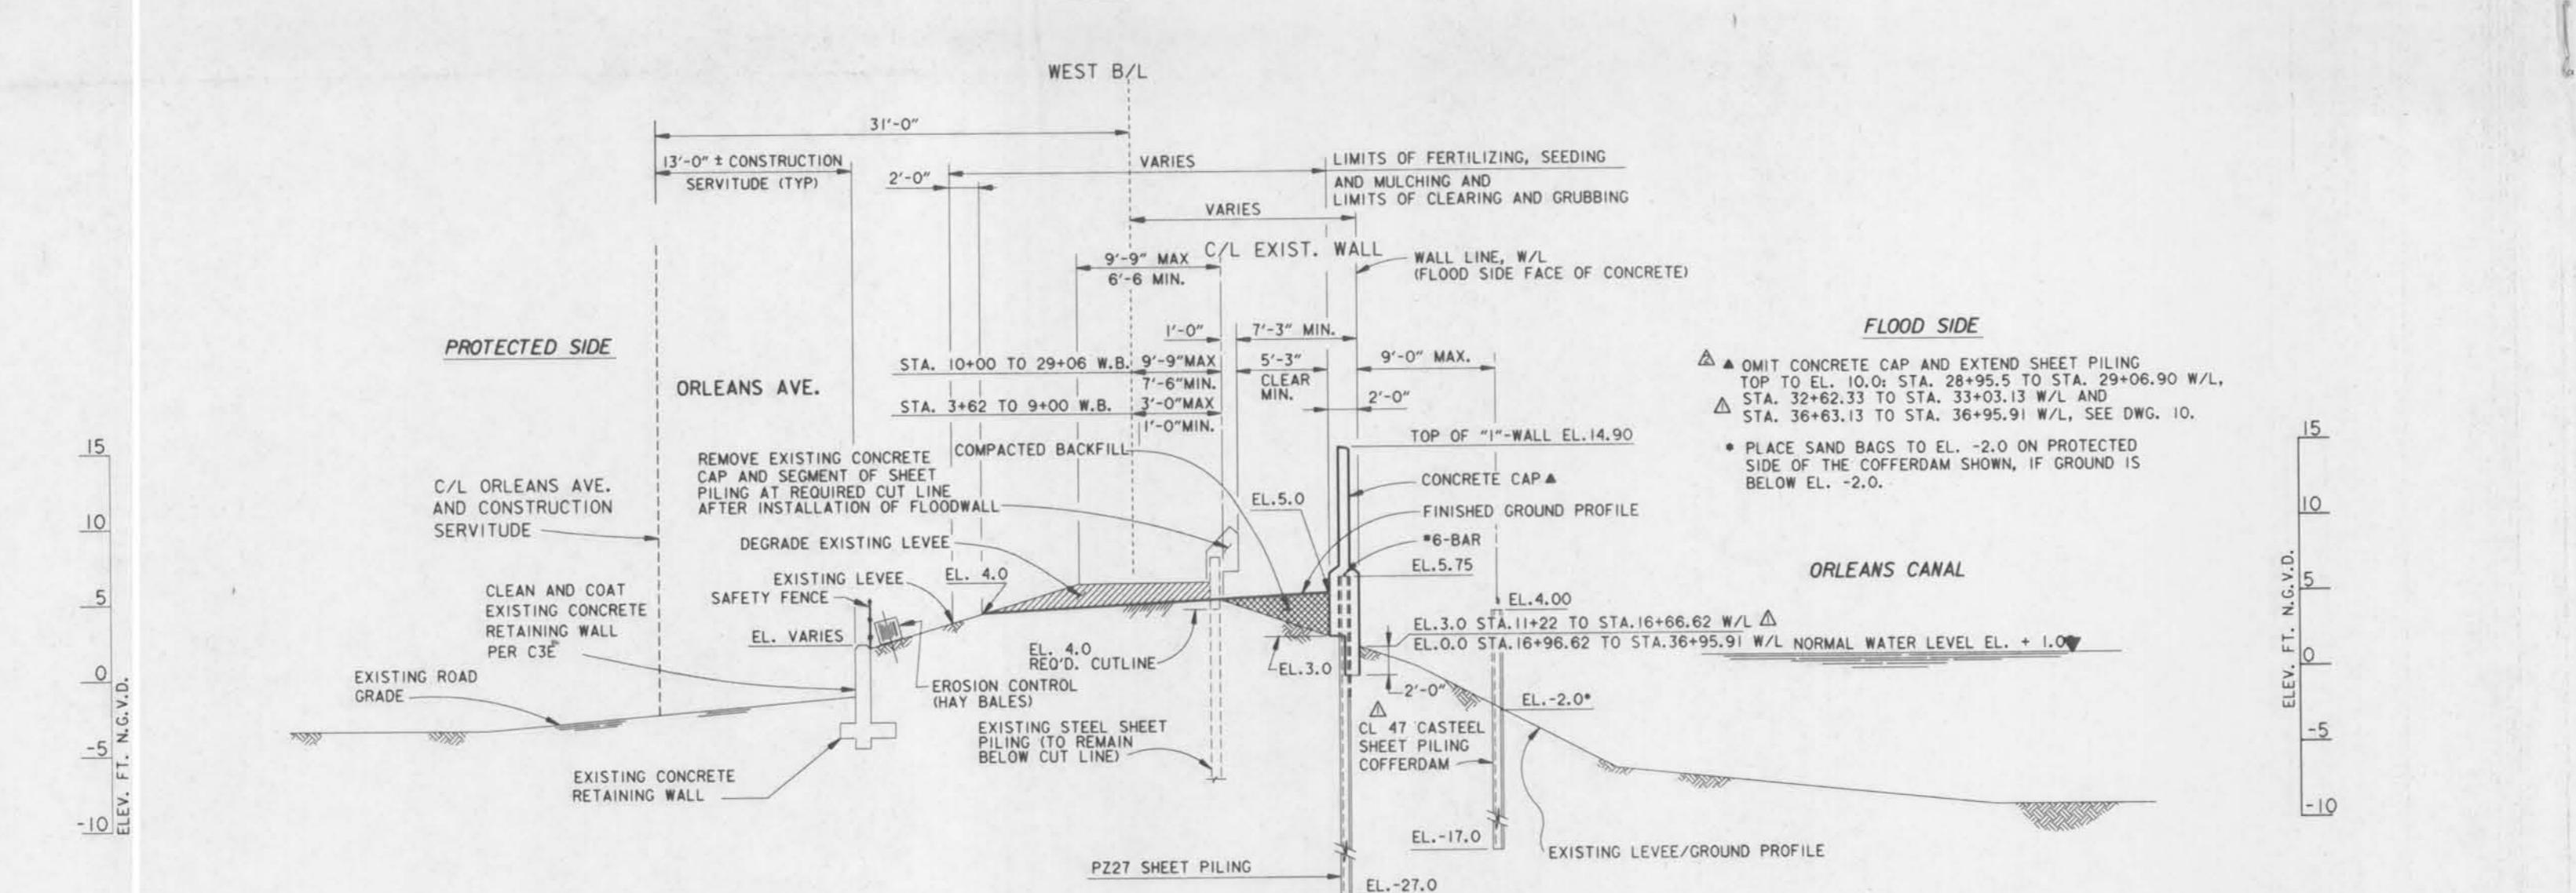

TYPICAL WALL SECTION AND SLOPE PAVEMENT

MODIFICATION AT I-610 BRIDGE

STA. 10+00 TO STA. 11+22 W/L
WEST SIDE OF CANAL
SCALE: 1'=5'-0"

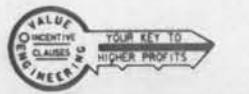

CONSTRUCTION SEQUENCE NOTES:

1. THE EXISTING FLOODWALL IS NOT TO BE REMOVED UNTIL COMPLETION OF THE NEW "I"-WALL.

COFFERDAM NOTES

1. "I"-WALL MONOLITH CONCRETE SHALL BE CAST "IN THE DRY". AREA ENCLOSED BY COFFERDAM SHALL BE DEWATERED PRIOR TO CASTING OF MONOLITH CONCRETE.
2. COFFERDAM SHEET PILING SHALL BE CLOSED TO THE NEW SHEET PILING TO FORM A WATERTIGHT CELL AROUND THE MONOLITHS TO BE CAST. SHOP DRAWINGS SHOWING ALL COFFERDAM SHEET PILING DETAILS, SHALL BE SUBMITTED TO THE COR FOR APPROVAL.
3. AN ALTERNATE LOCATION OF COFFERDAM SHEET PILING, CLOSE TO "I"-WALL TO SUIT CONCRETE FORM REQUIREMENTS MAY BE SELECTED BY CONTRACTOR.

NOTE:
FOR GENERAL NOTES, SEE DWG. 2.

- △ PROVIDE A SMOOTH TRANSITION IN FINISHED GRADE ELEVATIONS BETWEEN STATIONS 16+66.62 W/L AND 16+96.62 W/L.

WORK WITHIN LDOTD RIGHTS OF WAY
USE OF A VIBRATORY HAMMER TO DRIVE SHEET PILING WITHIN LDOTD RIGHTS-OF-WAY IS REQUIRED. THE PRESENCE OF AN LDOTD INSPECTOR IS REQUIRED FOR ALL WORK PERFORMED WITHIN THE RIGHTS-OF-WAY.

CONCRETE SLOPE PAVEMENT NOTES



1. NEW SLOPE PAVEMENT SHALL BE 2,000 P.S.I. CONCRETE. PAVEMENT SHALL BE REINFORCED WITH 6x6-4/4 WELDED WIRE FABRIC.
2. JOINTS IN NEW PAVEMENT SHALL BE SPACED AT 10' MAXIMUM AND TO MATCH EXISTING JOINT LOCATIONS.
3. NEW SLOPE PAVEMENT SHALL ABUT CONCRETE "I"-WALL.

SCALE: 1' = 5'
5' 0' 5' 10' 15' 20'



REVISIONS	REvised LIMITS OF I-WALL, MOD. NO. 3	11-5-93	J.A.R.
SYMBOL	GENERAL REVISIONS, AMENDMENT NO. 1,	5-11-93	M.O.
DESCRIPTION			APPROVED
REVISIONS			
U.S. ARMY ENGINEER DISTRICT, NEW ORLEANS			
CORPS OF ENGINEERS			
NEW ORLEANS, LOUISIANA			
BOARD OF LEVEE COMMISSIONERS	DESIGN ENGINEERING, INC.		
NEW ORLEANS, LOUISIANA	13301 ESP. ANADE AVE. S.		
LAKE PONTCHARTRAIN, LA. AND VICINITY	ST. MARY, LOUISIANA 70062		
HIGH LEVEL PLAN			
NEW ORLEANS LAKEFRONT LEVEE			
WEST OF I.H.N.C.			
ORLEANS AVE. CANAL FLOOD PROTECTION IMPROVEMENT			
PHASE II-D (WEST SIDE: B/L STA. 2+39.00 TO STA. 29+07.50)			
ORLEANS PARISH, LOUISIANA			
TYPICAL SECTIONS			
DESIGNED BY: M.B.SHUKLA	DATE: FEB., 1993	PLOT SCALE: 60'	PLOT DATE: FEB. 1994
DRAWN BY: K.C.REID			
CHECKED BY: T.M.SMITH			
CADD FILE: II-D09			
SUBMITTED BY: DESIGN ENGINEER, INC.			
DESIGN ENGINEER			
SOLICITATION NO. H-4-40205			
DWG. 9 OF 24			

Safety is a Part
of Your Contract

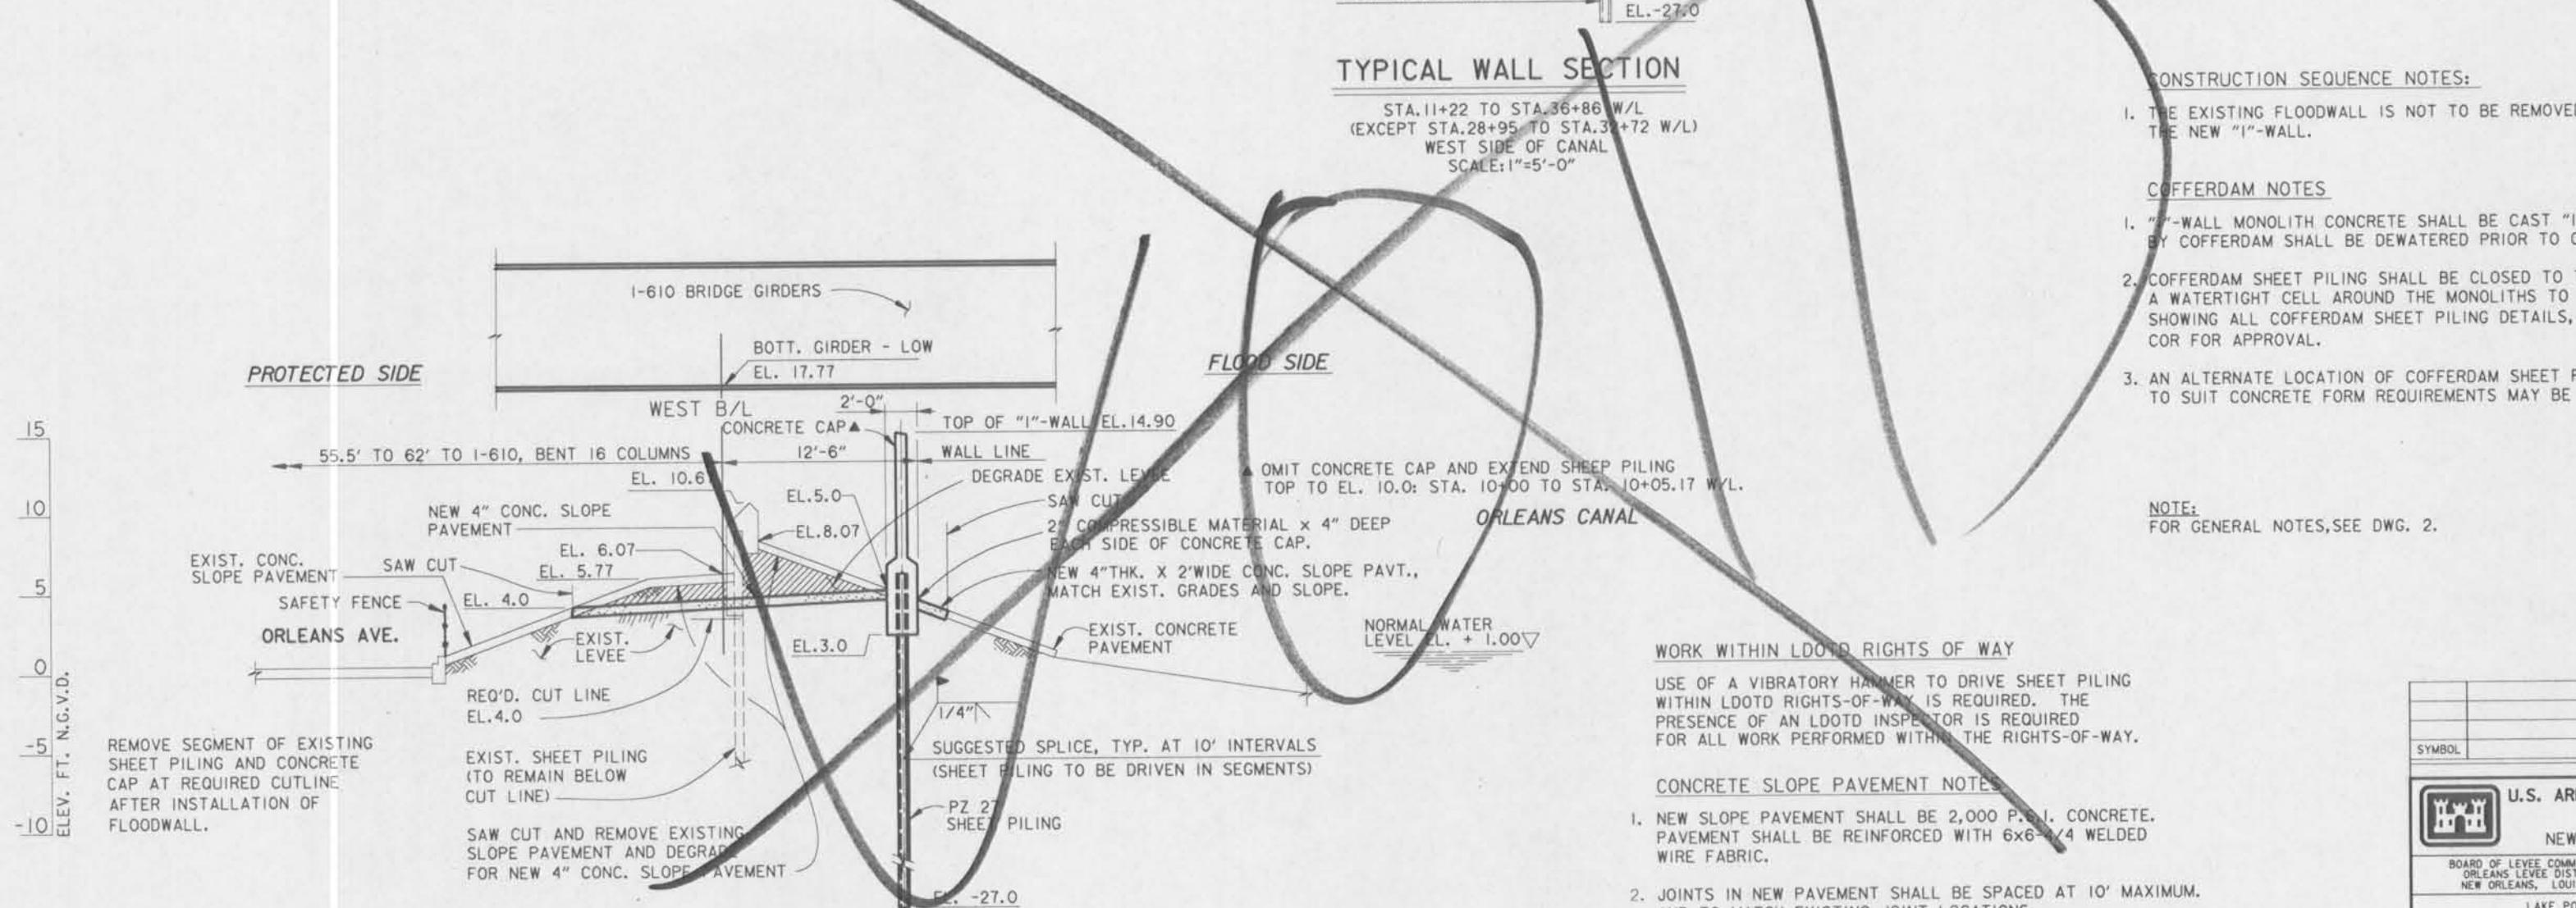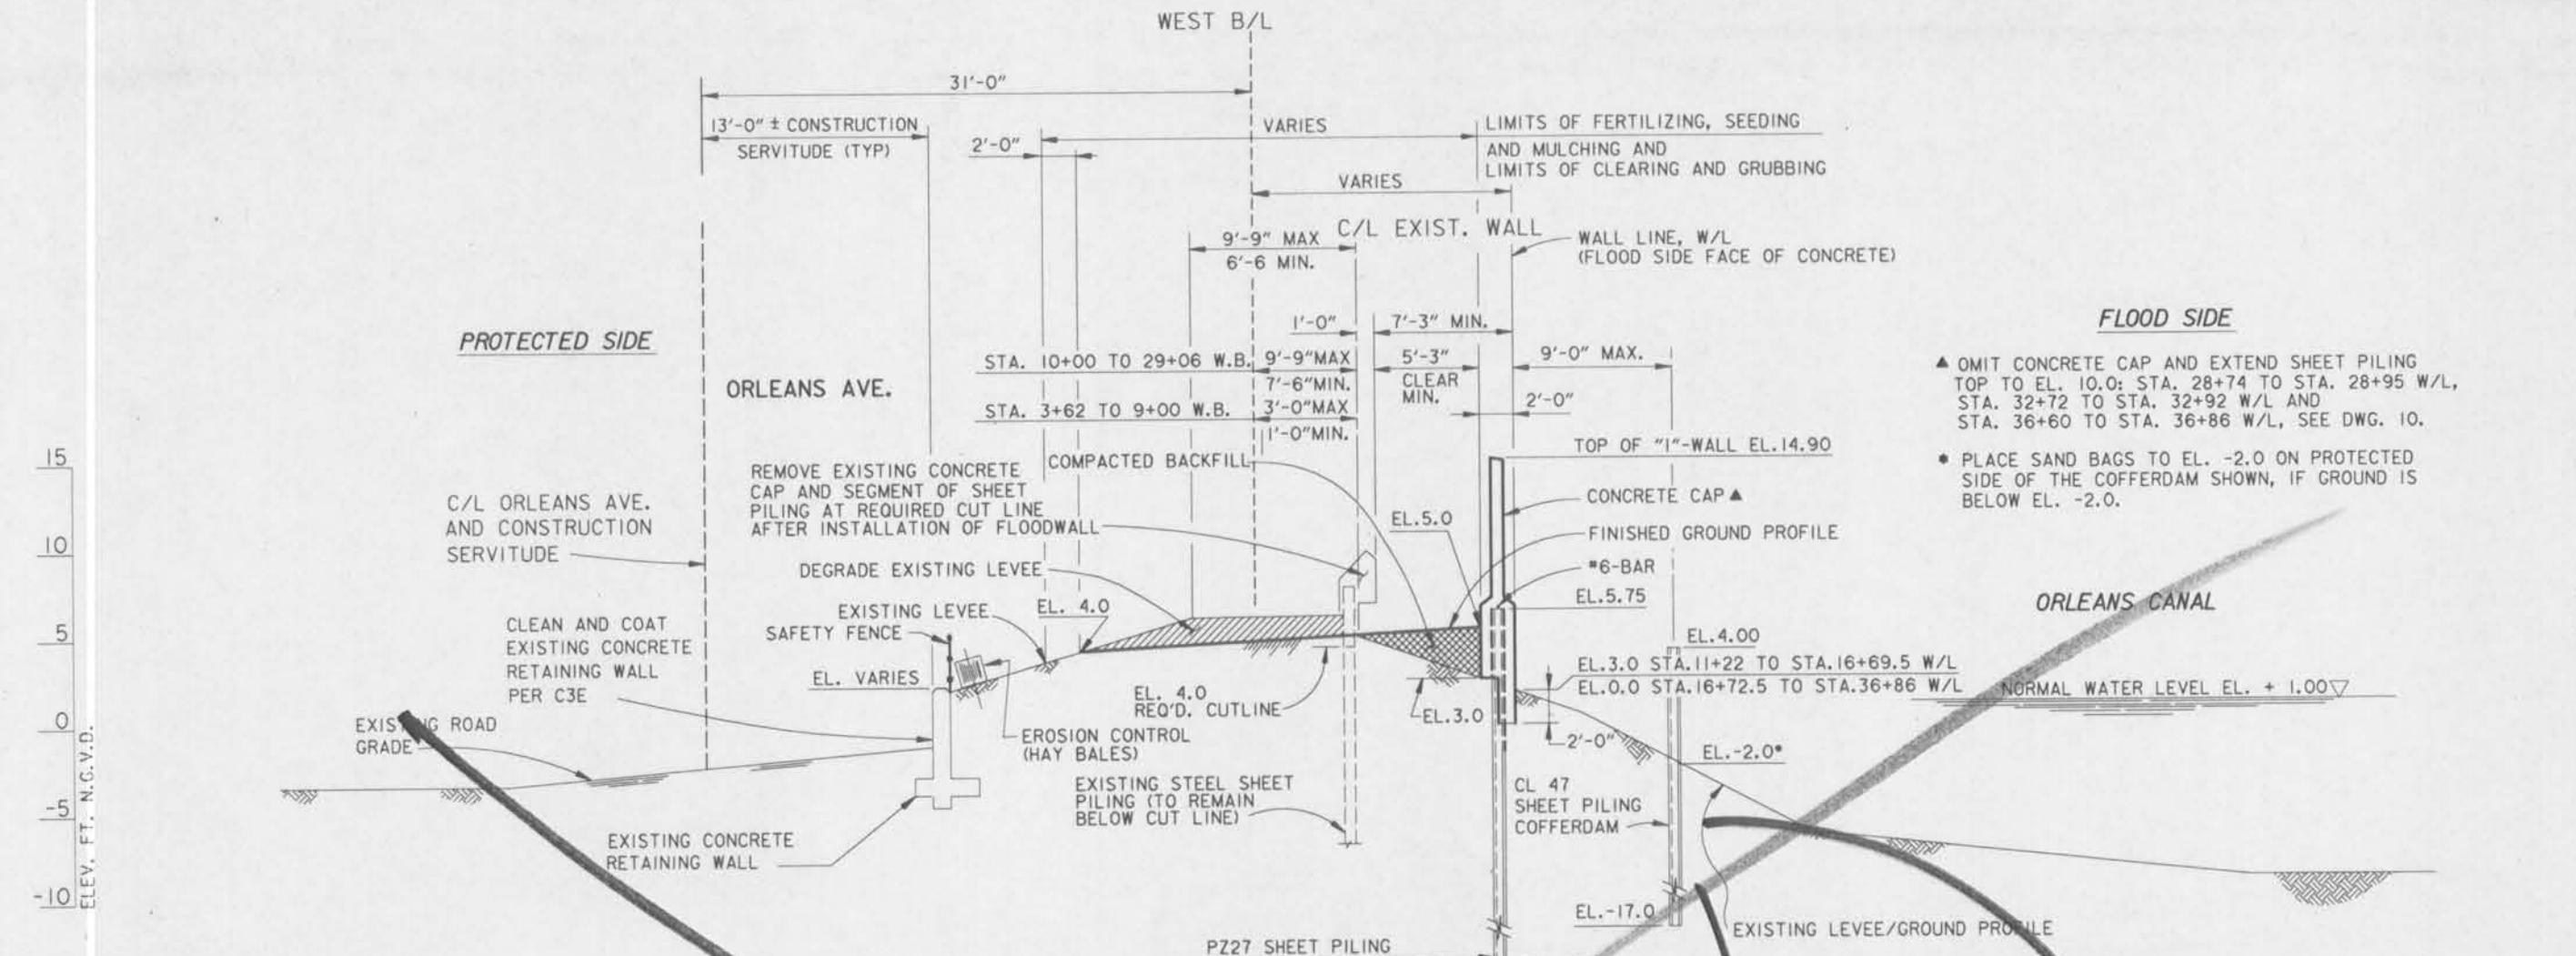

TYPICAL WALL SECTION AND SLOPE PAVEMENT

MODIFICATION AT I-610 BRIDGE


STA. 10+00 TO STA. 11+22 W/L
WEST SIDE OF CANAL
SCALE: 1"=5'-0"

SCALE: 1" = 5'
5' 0' 5' 10' 15' 20'




SYMBOL	DESCRIPTION	DATE APPROVED
REVISIONS		
	U.S. ARMY ENGINEER DISTRICT, NEW ORLEANS CORPS OF ENGINEERS NEW ORLEANS, LOUISIANA	
BOARD OF LEVEE COMMISSIONERS ORLEANS LEVEE DISTRICT NEW ORLEANS, LOUISIANA	DESIGN ENGINEERING, INC. 3330 W. ESPLANADE AVE., S. METAIRIE, LOUISIANA 70002	LAKE PONTCHARTRAIN, LA. AND VICINITY HIGH LEVEL PLAN
NEW ORLEANS LAKEFRONT LEVEE WEST OF I.H.N.C. ORLEANS AVE. CANAL FLOOD PROTECTION IMPROVEMENT PHASE II-D (WEST SIDE: B/L STA. 2+39.00 TO STA. 29+07.50) ORLEANS PARISH, LOUISIANA		
TYPICAL SECTIONS		
DESIGNED BY: M.B.SHUKLA DRAWN BY: K.C.REID CHECKED BY: T.M.SMITH SUBMITTED BY: DESIGN ENGINEER, INC. DESIGN ENGINEER	PLOT SCALE: 60 PLOT DATE: MARCH 1993 FILE NO.: H-4-40205 CADD FILE: II-D09 SOLICITATION NO.: DACW29-93-B-0042 DWG. 9 OF 24	

Safety is a Part
of Your Contract

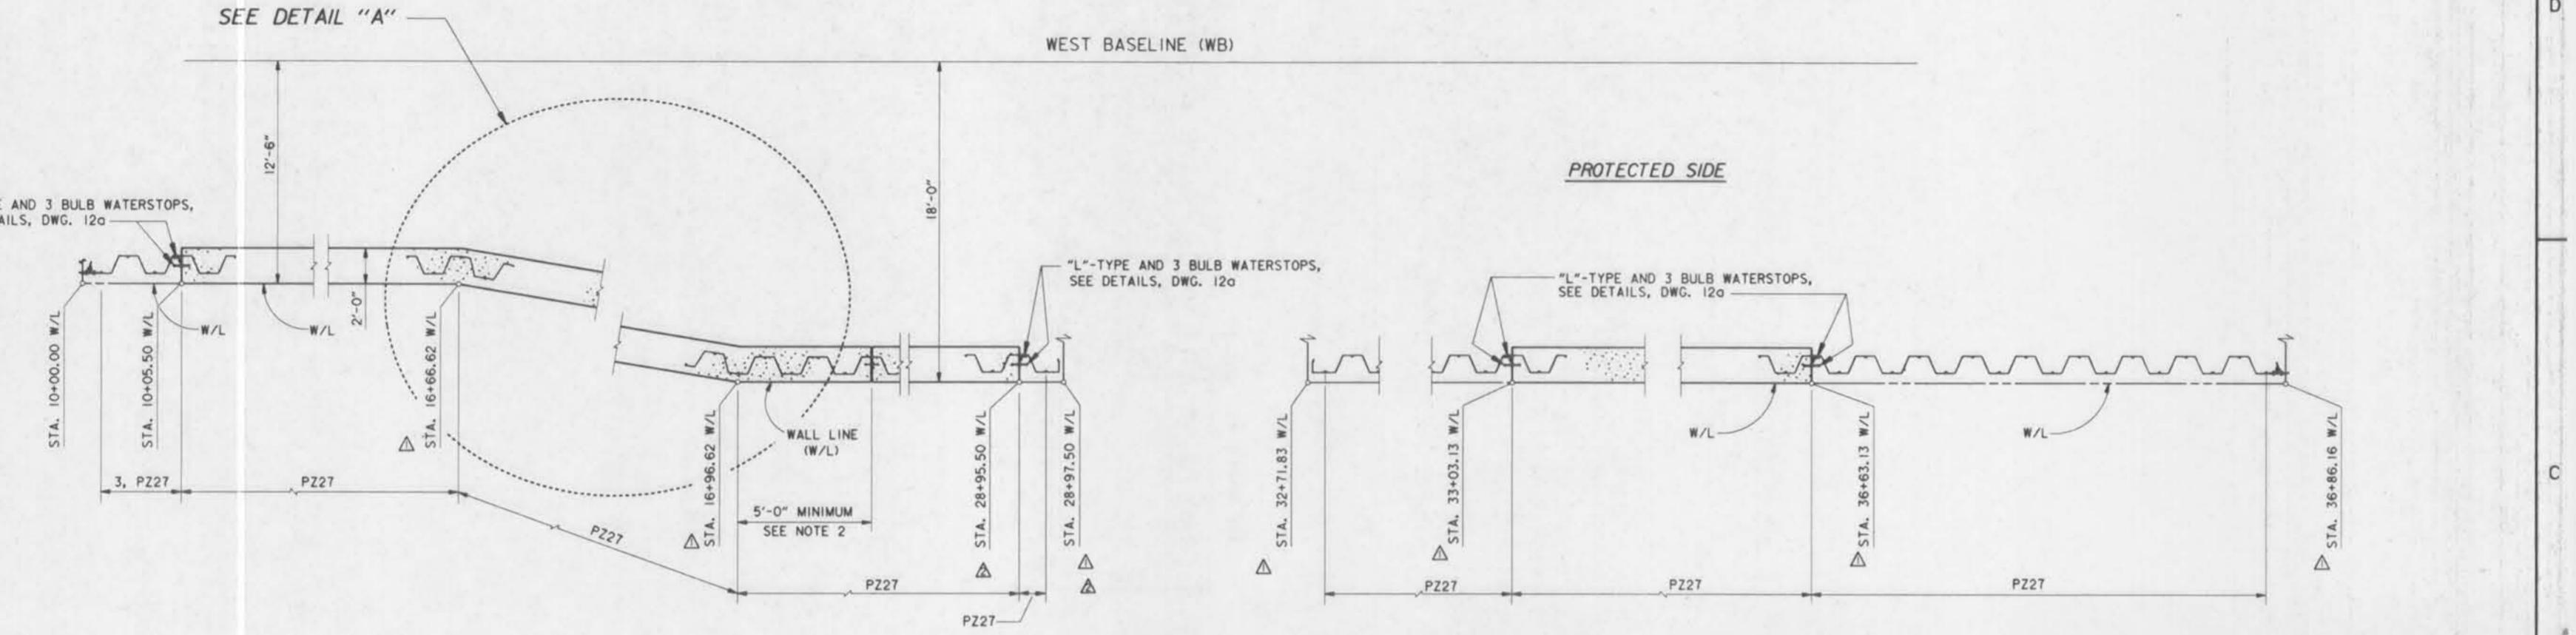


- NOTES:**
1. "I"-WALL MONOLITHS TO CONFORM TO LENGTHS SHOWN ON TYPICAL "I"-WALL DETAILS, DWG. 11.
 2. MONOLITH JOINTS TO BE OFFSET FROM WALL ANGLE POINTS A MINIMUM OF 5'-0".
 3. FOR SHEET PILING CONNECTION DETAILS, SEE DWG. 14.

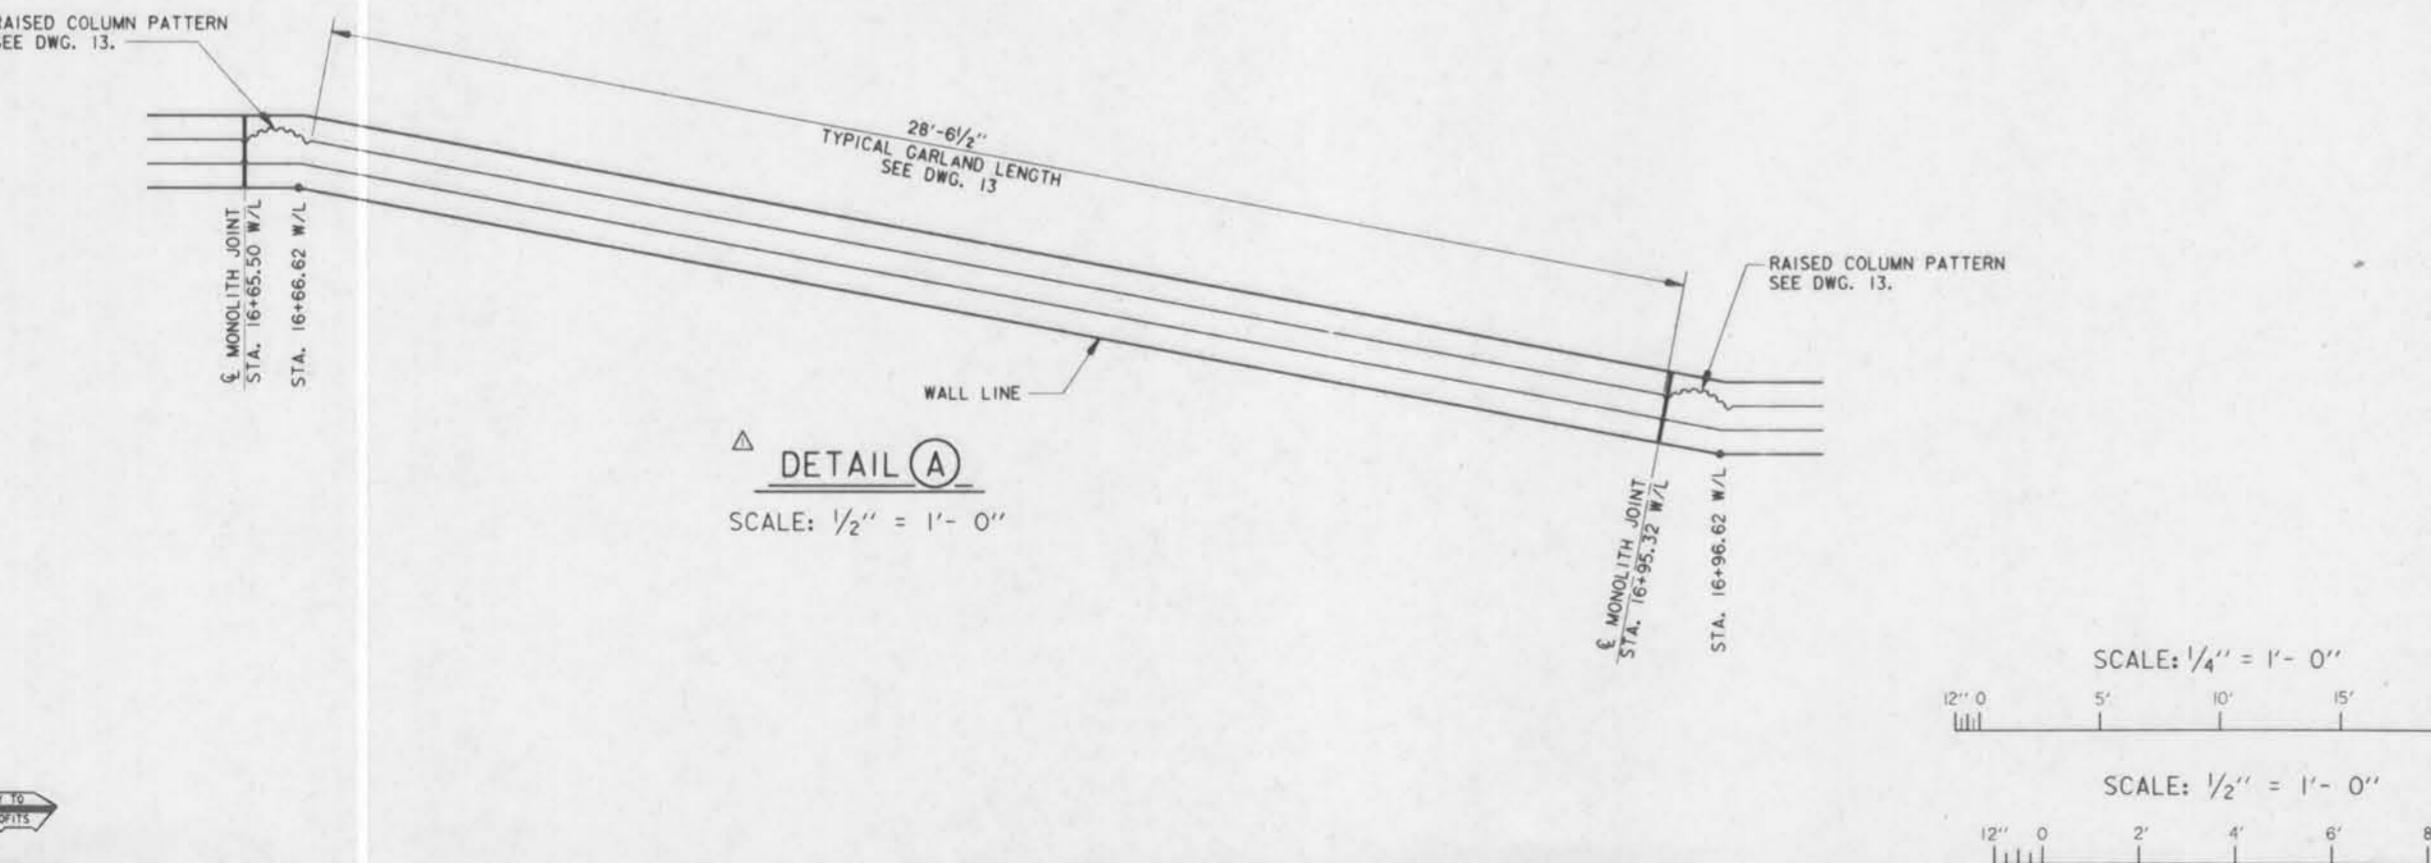

REVISIONS	REvised LIMITS OF I-WALL, MOD. NO. 5	11-5-93	J.A.R.
SYMBOL	REVISED W/L STATIONING, AMENDMENT NO. 1,	5-11-93	M.D.
	DESCRIPTION	DATE	APPROVED
U.S. ARMY ENGINEER DISTRICT, NEW ORLEANS CORPS OF ENGINEERS NEW ORLEANS, LOUISIANA			
BOARD OF LEVEE COMMISSIONERS NEW ORLEANS LEVEE BOARD 3313 ESPALADE AVE. S. METAIRIE, LOUISIANA 70002			
DESIGN ENGINEERING, INC. 3313 ESPALADE AVE. S. METAIRIE, LOUISIANA 70002			
LAKE PONTCHARTRAIN, LA. AND VICINITY HIGH LEVEL PLAN			
NEW ORLEANS LAKEFRONT LEVEE WEST OF I.H.N.C.			
ORLEANS AVE. CANAL FLOOD PROTECTION IMPROVEMENT PHASE II-D (WEST SIDE: B/L STA. 2+39.00 TO STA. 29+07.50) ORLEANS PARISH, LOUISIANA			
STEEL SHEET PILING AND MONOLITH LAYOUT			
DESIGNED BY: K.PANNELL	DATE:	PLOT SCALE:	PLOT DATE:
DRAWN BY: K.A.WOJALIA	FEB. 1993	48	FEB. 1994
CHECKED BY: T.M.SMITH			
SUBMITTED BY: DESIGN ENGINEERING, INC. DESIGN ENGINEER	CADD FILE:	H-4-40205	FILE NO.
	SOLICITATION NO.		
	DACW29-93-B-0042		DWG. 10 OF 24

Safety is a Part
of Your Contract

"L"-TYPE AND 3 BULB WATERSTOP,
SEE DETAILS, DWG. 12a

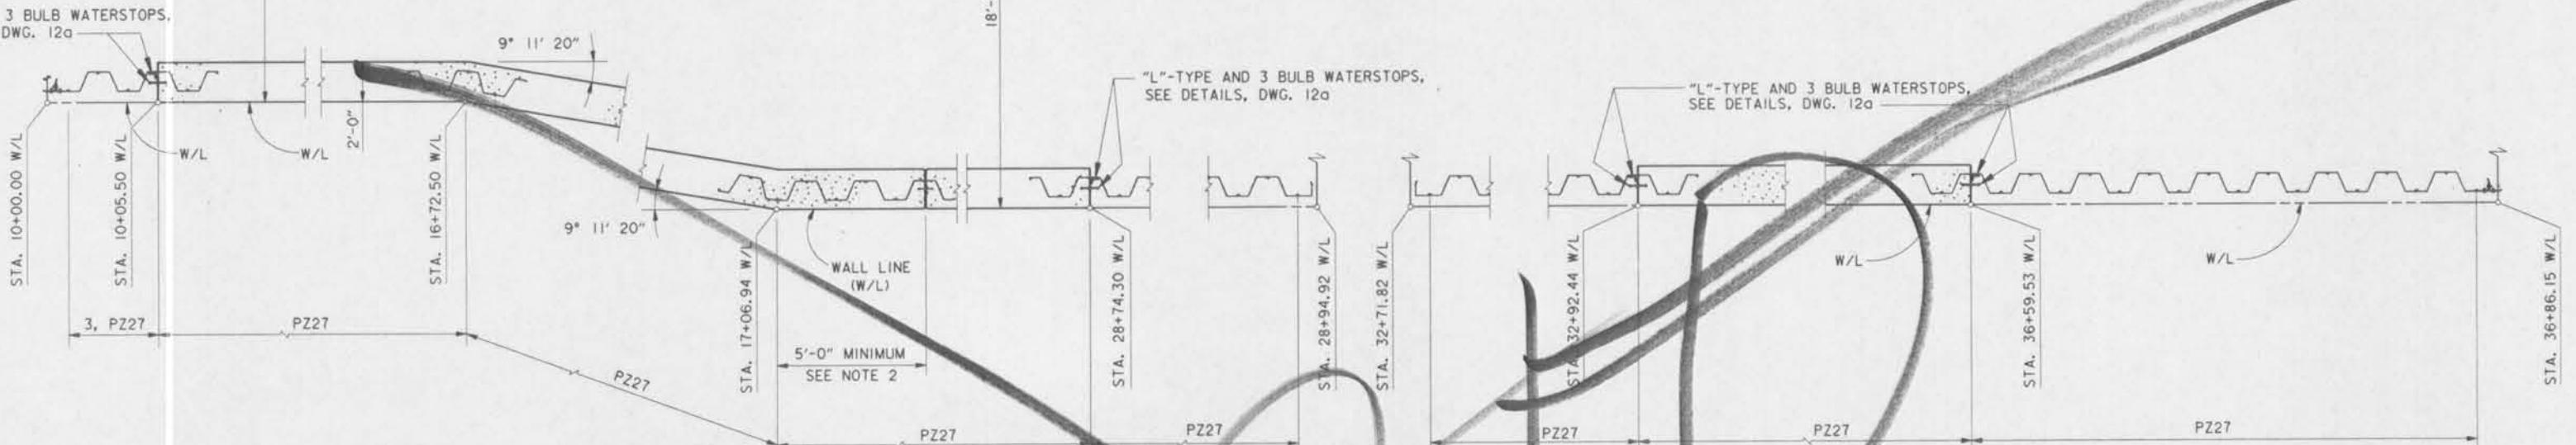

NOTES:

1. "I"-WALL MONOLITHS TO CONFORM TO LENGTHS SHOWN ON TYPICAL "I"-WALL DETAILS, DWG. 11.
2. MONOLITHS JOINTS TO BE OFFSET FROM WALL ANGLE POINTS A MINIMUM OF 5'-0".
3. FOR SHEET PILING CONNECTION DETAILS, SEE DWG. 14.

PLAN

SCALE: $\frac{1}{4}$ " = 1'-0"


SCALE: $\frac{1}{4}$ " = 1'- 0"
12' 0" 5' 10' 15' 20'



REVISIONS			
SYMBOL	DESCRIPTION	DATE	APPROVED
	U.S. ARMY ENGINEER DISTRICT, NEW ORLEANS CORPS OF ENGINEERS NEW ORLEANS, LOUISIANA		
BOARD OF LEVEE COMMISSIONERS ORLEANS LEVEE DISTRICT NEW ORLEANS, LOUISIANA	DESIGN ENGINEERING, INC. 3330 W. ESPLANADE AVE. S. METAIRIE, LOUISIANA 70002		
LAKE PONTCHARTRAIN, LA. AND VICINITY HIGH LEVEL PLAN	LAKE PONTCHARTRAIN, LA. AND VICINITY HIGH LEVEL PLAN		
NEW ORLEANS LAKEFRONT LEVEE WEST OF I.H.N.C.	NEW ORLEANS LAKEFRONT LEVEE WEST OF I.H.N.C.		
ORLEANS AVE. CANAL FLOOD PROTECTION IMPROVEMENT PHASE II-D (WEST SIDE) B/L STA.2+39.00 TO STA.29+07.50	ORLEANS AVE. CANAL FLOOD PROTECTION IMPROVEMENT PHASE II-D (WEST SIDE) B/L STA.2+39.00 TO STA.29+07.50		
ORLEANS PARISH, LOUISIANA	ORLEANS PARISH, LOUISIANA		
STEEL SHEET PILING AND MONOLITH LAYOUT	STEEL SHEET PILING AND MONOLITH LAYOUT		
DESIGNED BY: V.PANNELL DRAWN BY: K.A.WOJALIA CHECKED BY: T.M.SMITH SUBMITTED BY: DESIGN ENGINEERING, INC. DESIGN ENGINEER	DATE: FEB. 1993 PLOT SCALE: 48 PLOT DATE: MARCH 1993 FILE NO. H-4-40205 CADD FILE: II-D10 SOLICITATION NO. DACW29-93-B-0042 Dwg. 10 of 24		




Safety is a Part
of Your Contract

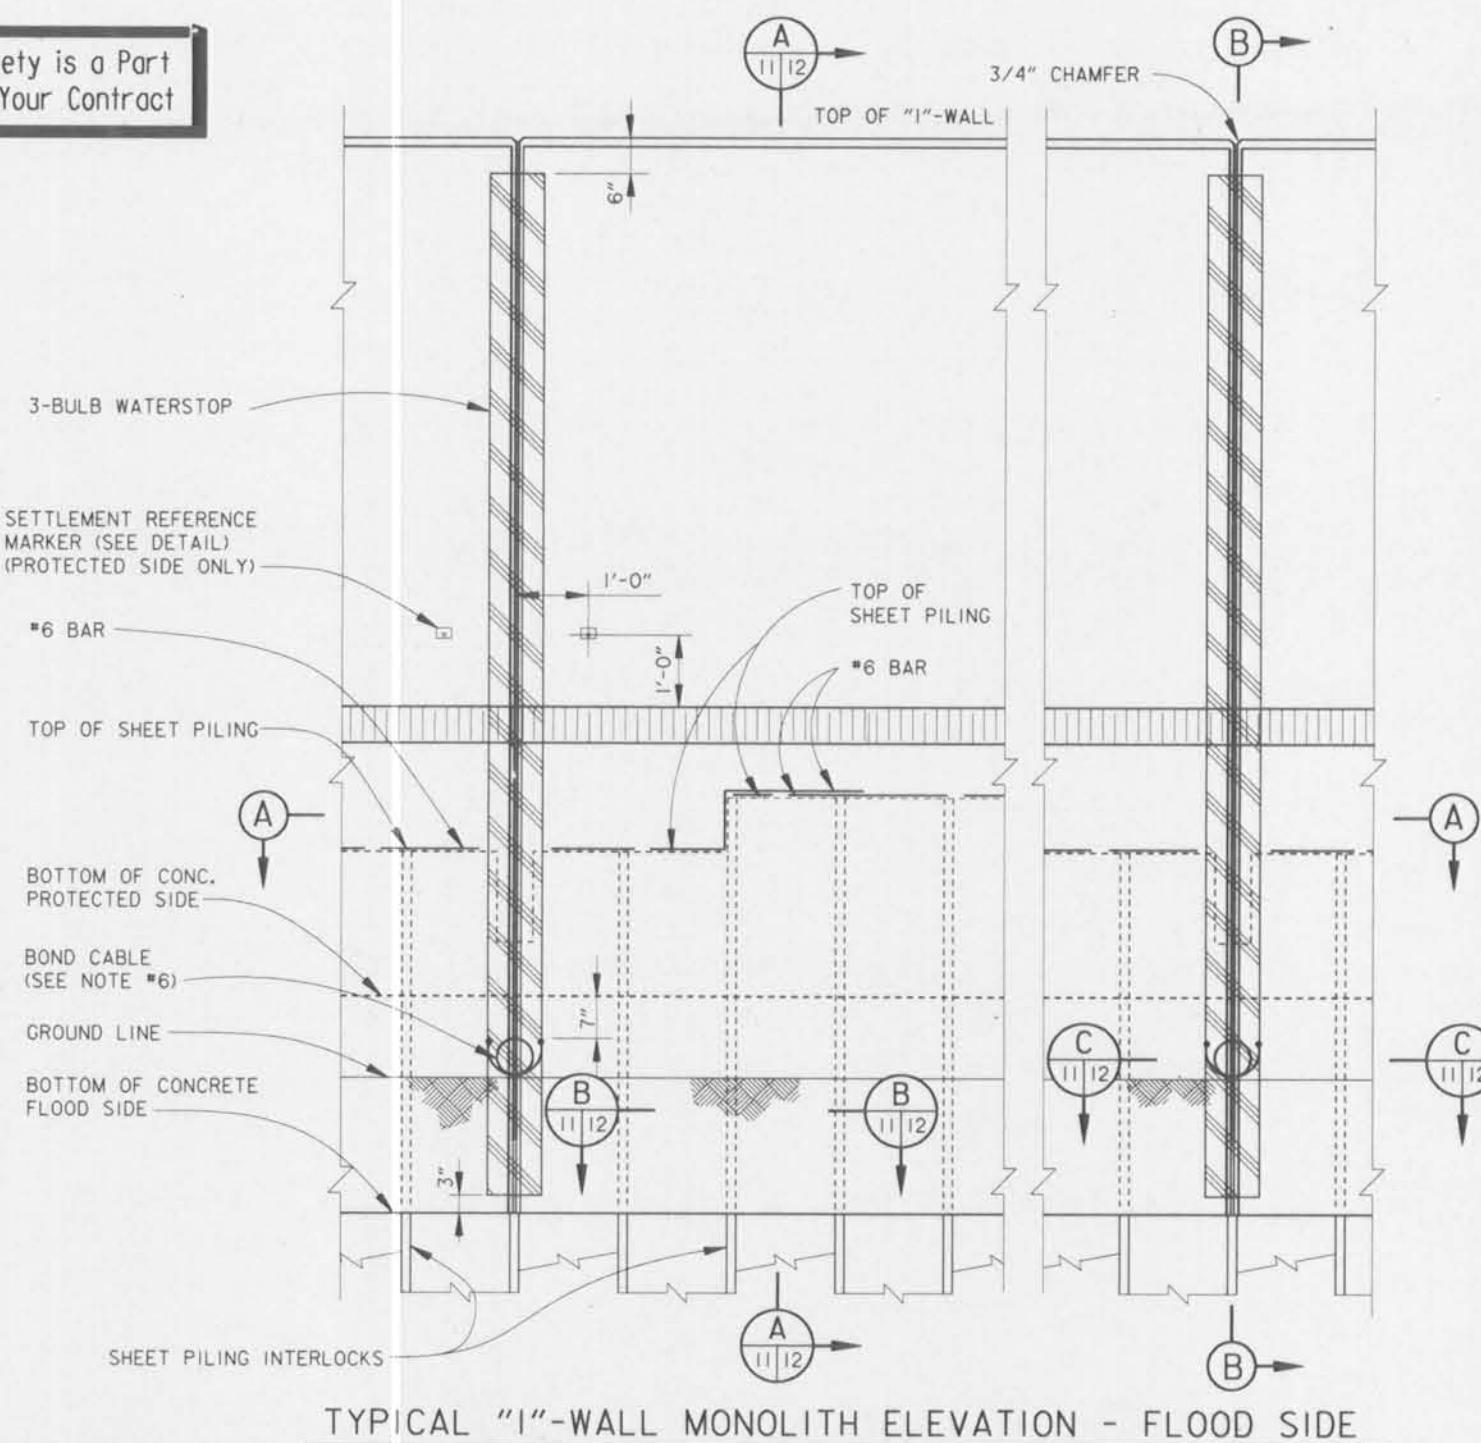

TYPICAL "I"-WALL MONOLITH ELEVATION - FLOOD SIDE

SCALE: 3/4" = 1'-0"

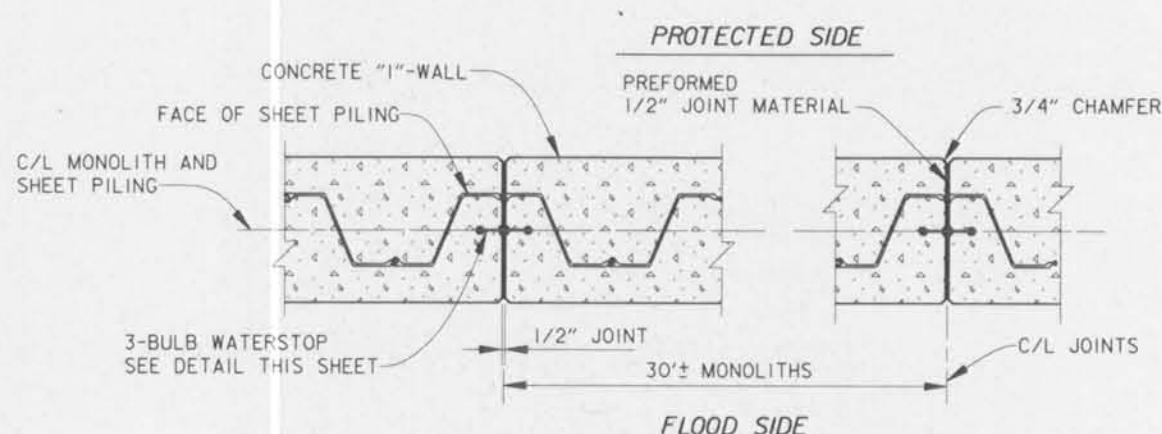


"I"-WALL MONOLITH PLAN/SECTION A

SCALE: 3/4" = 1'-0"


△ SETTLEMENT REFERENCE MARKER SCHEDULE							
S.R.M. NO.*	WEST W/L STA.	DIST. BELOW TOP OF WALL	FINAL ** ELEVATIONS	S.R.M. NO.	WEST W/L STA.	DIST. BELOW TOP OF WALL	FINAL ** ELEVATIONS
D 1	10+05	6.9'		D 6	25+65.5	6.9'	
D 2	13+05	6.9'		D 7	28+65.5	6.9'	
D 3	16+05	6.9'		D 8	33+03.13	6.9'	
D 4	19+65.5	6.9'		D 9	34+83.13	6.9'	
D 5	22+65.5	6.9'		D 10	36+63.13	6.9'	

** THE CONTRACTOR SHALL TAKE FINAL ELEVATIONS OF ALL SETTLEMENT MARKERS AND SHALL SUBMIT THIS DATA TO THE CONTRACTING OFFICER REPRESENTATIVE (COR)

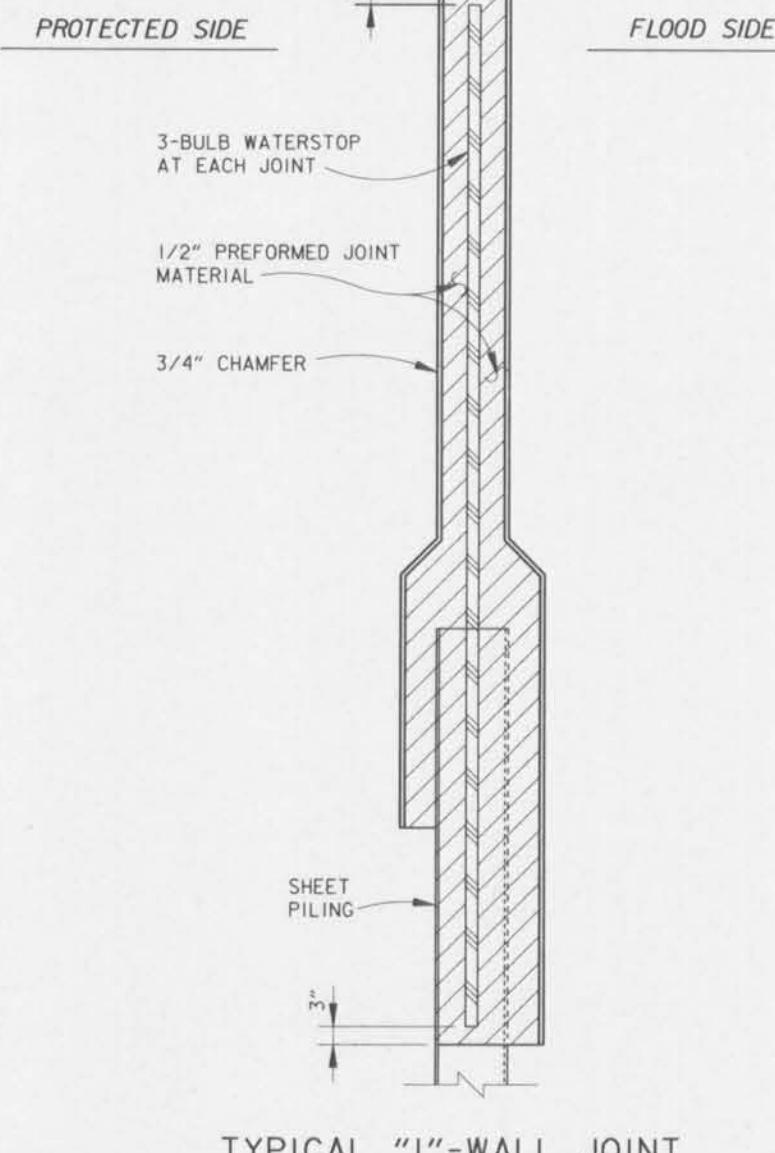

TYPICAL "I"-WALL JOINT SECTION B

SCALE: 3/4" = 1'-0"

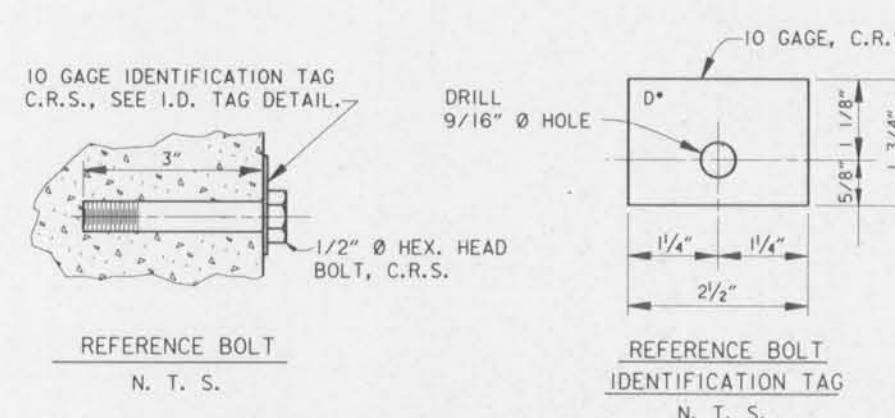


SETTLEMENT REFERENCE MARKER DETAILS

N. T. S.

*REFERENCE TAGS TO BE STAMPED
WITH S.R.M. NO. SHOWN IN SCHEDULE.


SCALE: 3/4" = 1'- 0"

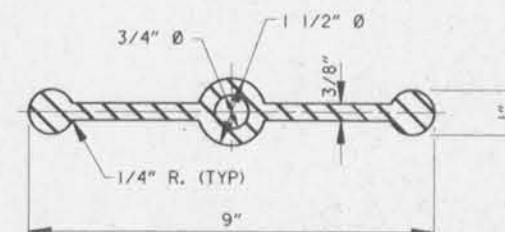

THREE-BULB WATERSTOP DETAIL

N. T. S.

SCALE: 1" = 1'- 0"

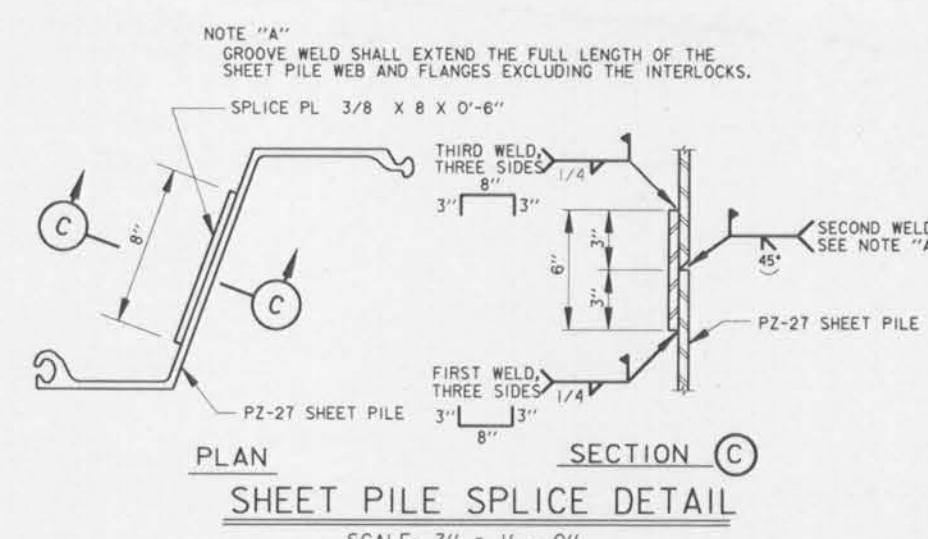

NOTE "A"
GROOVE WELD SHALL EXTEND THE FULL LENGTH OF THE
SHEET PILE WEB AND FLANGES EXCLUDING THE INTERLOCKS.

SPLICE PL 3/8 X 8 X 0'-6"

PZ-27 SHEET PILE

FIRST WELD, THREE SIDES 1/4"

SECOND WELD, SEE NOTE "A"

THIRD WELD, THREE SIDES 1/4"

6"

3"

3"

8"

PZ-27 SHEET PILE

SECOND WELD, SEE NOTE "A"

THIRD WELD, THREE SIDES 1/4"

6"

3"

3"

8"

SECOND WELD, SEE NOTE "A"

THIRD WELD, THREE SIDES 1/4"

6"

3"

3"

8"

SECOND WELD, SEE NOTE "A"

THIRD WELD, THREE SIDES 1/4"


6"

3"

3"


8"

Safety is a Part
of Your Contract

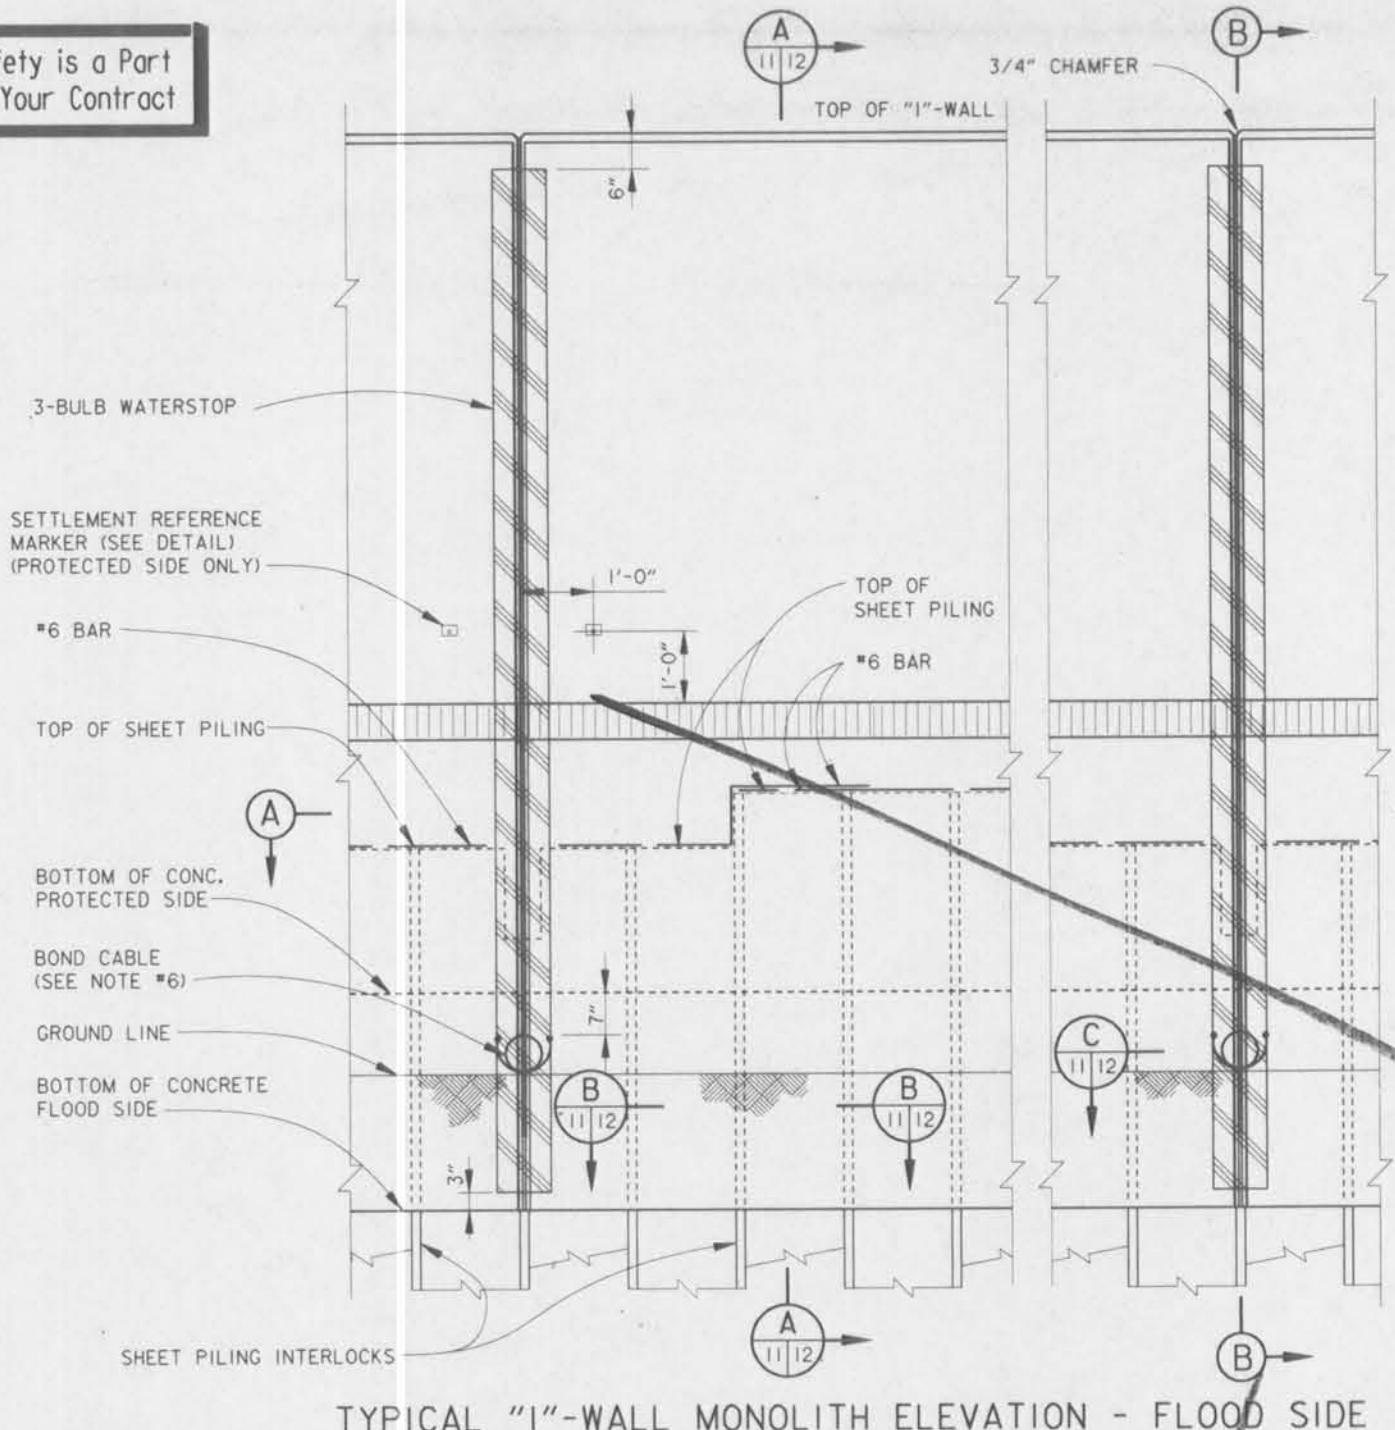

TYPICAL "I"-WALL MONOLITH ELEVATION - FLOOD SIDE

SCALE: 3/4" = 1'-0"

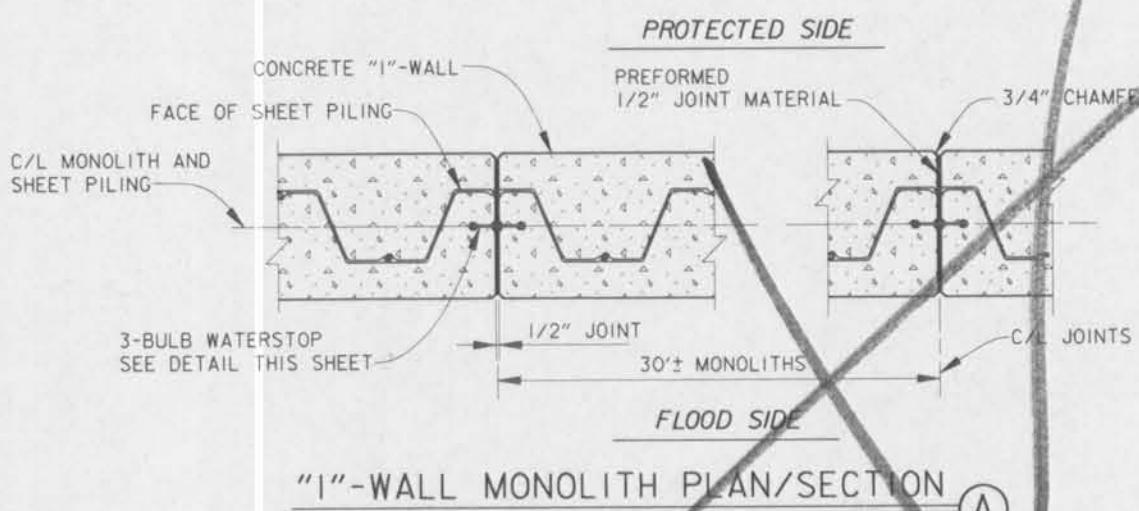


"I"-WALL MONOLITH PLAN/SECTION

SCALE: 3/4" = 1'-0"


SETTLEMENT REFERENCE MARKER SCHEDULE							
S.R.M. NO.*	WEST W/L STA.	DIST. BELOW TOP OF WALL	FINAL ** ELEVATIONS	S.R.M. NO.	WEST W/L STA.	DIST. BELOW TOP OF WALL	FINAL ** ELEVATIONS
D 1	10+06	6.9'		D 6	25+06	6.9'	
D 2	13+06	6.9'		D 7	28+74	6.9'	
D 3	16+06	6.9'		D 8	32+93	6.9'	
D 4	19+06	6.9'		D 9	34+76	6.9'	
D 5	22+06	6.9'		D 10	36+59	6.9'	

** THE CONTRACTOR SHALL TAKE FINAL ELEVATIONS OF ALL SETTLEMENT MARKERS AND SHALL SUBMIT THIS DATA TO THE CONTRACTING OFFICER REPRESENTATIVE (COR)

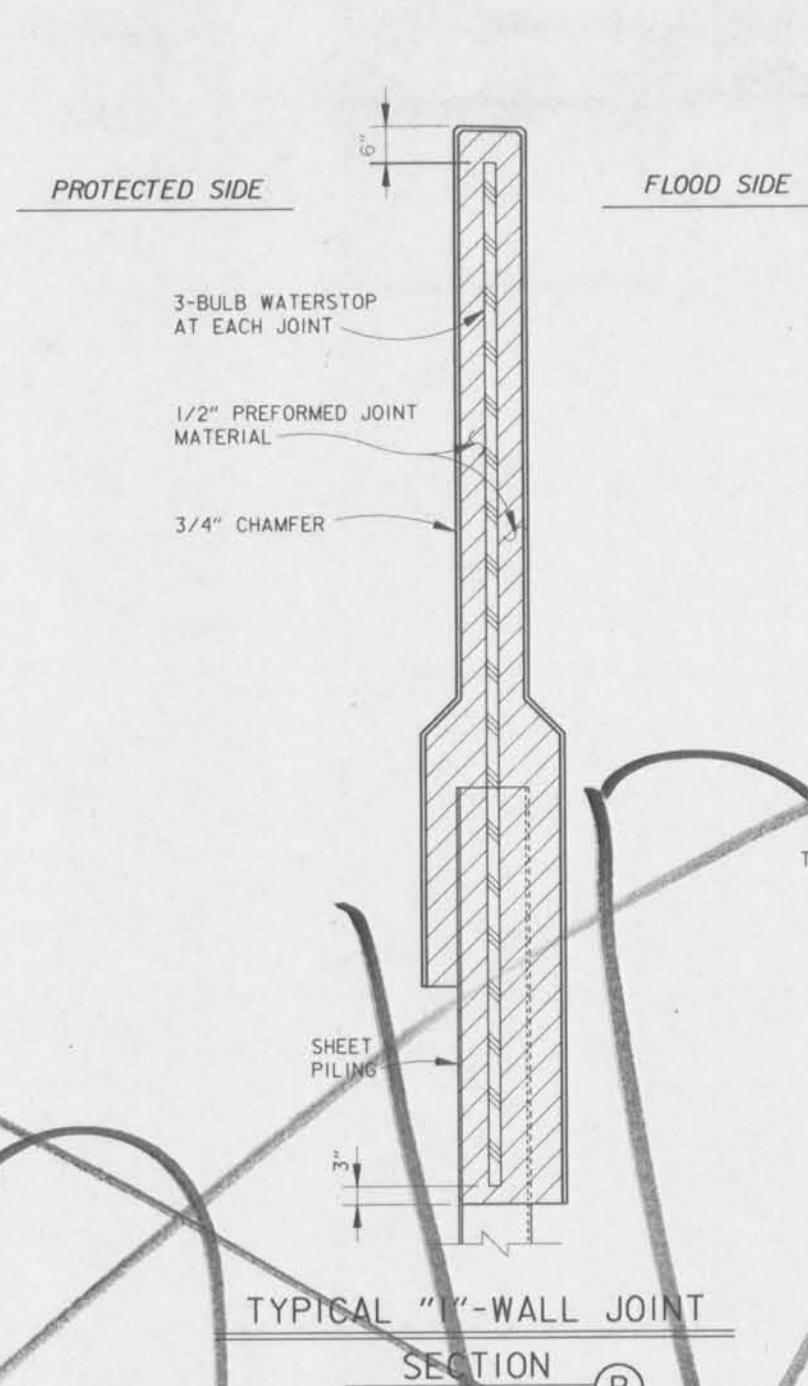

TYPICAL "I"-WALL JOINT
SECTION B

SCALE: 3/4" = 1'-0"

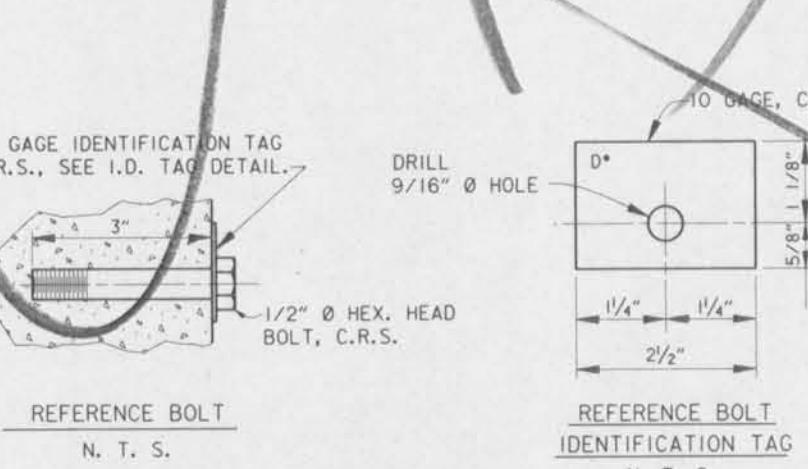

SETTLEMENT REFERENCE MARKER DETAILS

N. T. S.


N. T. S.

*REFERENCE TAGS TO BE STAMPED
WITH S.R.M. NO. SHOWN IN SCHEDULE.

N. T. S.

Safety is a Part
of Your Contract

PROTECTED SIDE

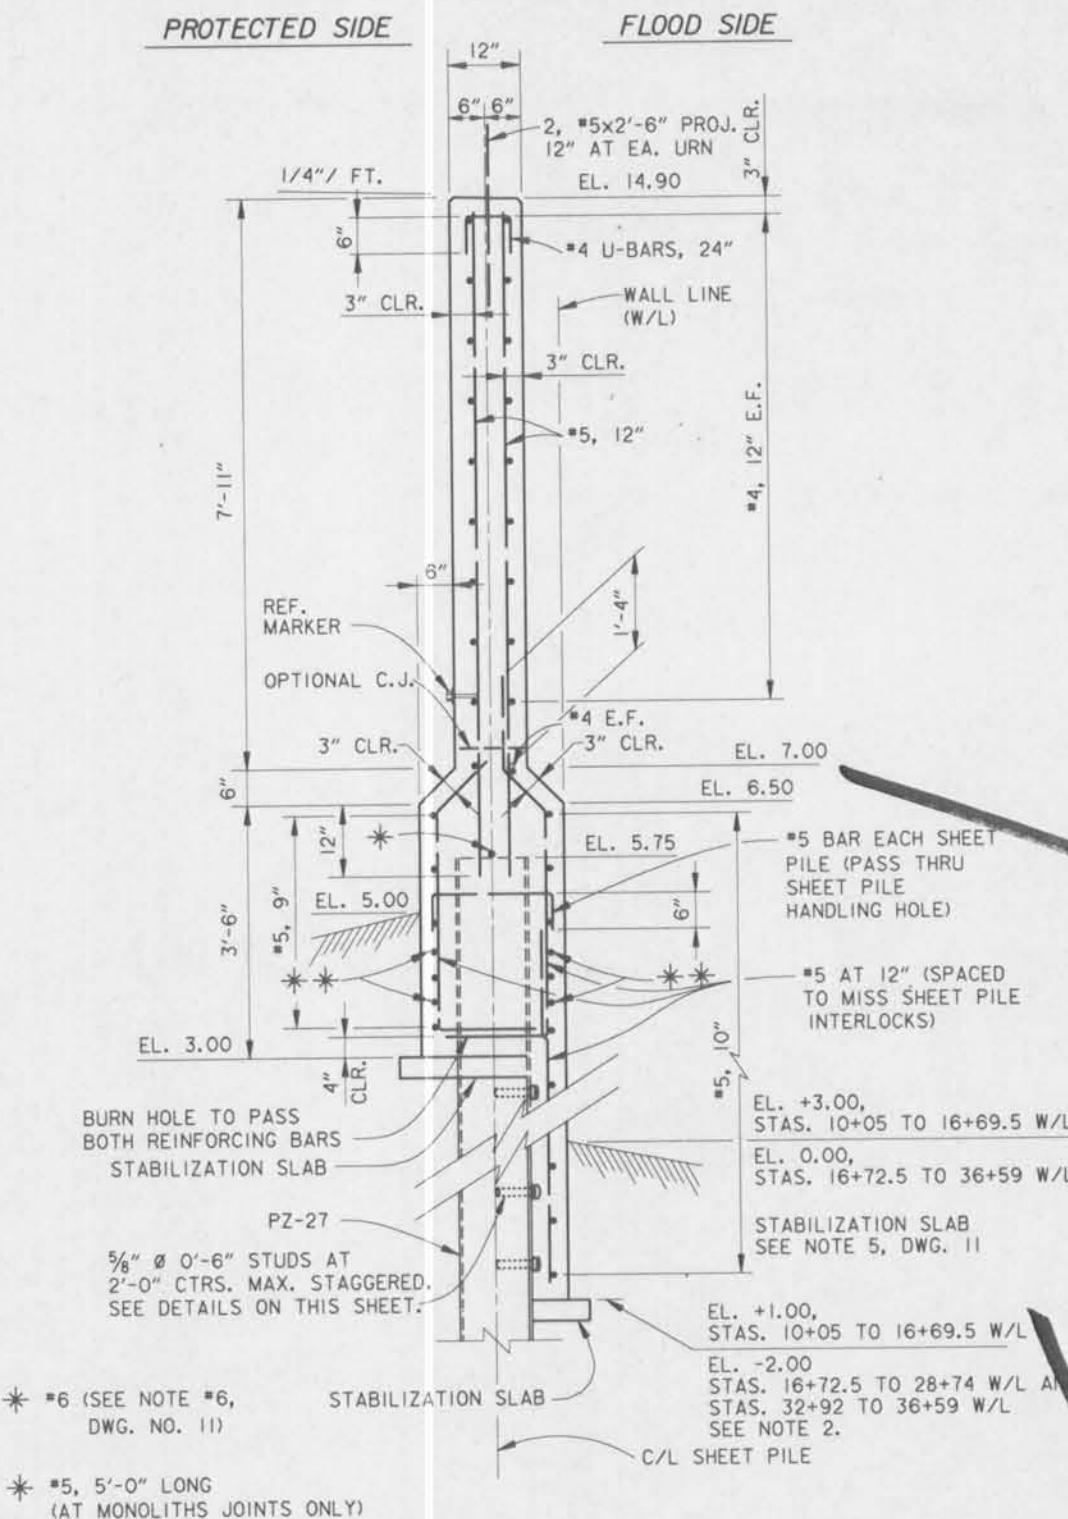


* * 5, 5'-0" LONG
(AT MONOLITH JOINTS ONLY)

TYPICAL "I"-WALL


SECTION A

SCALE: 3/4" = 1'-0"

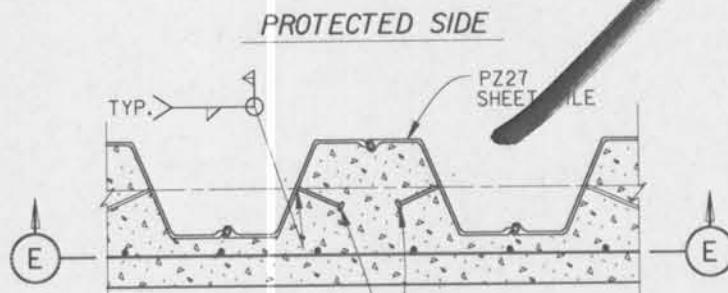


SECTION B

SCALE: 1" = 1'-0"

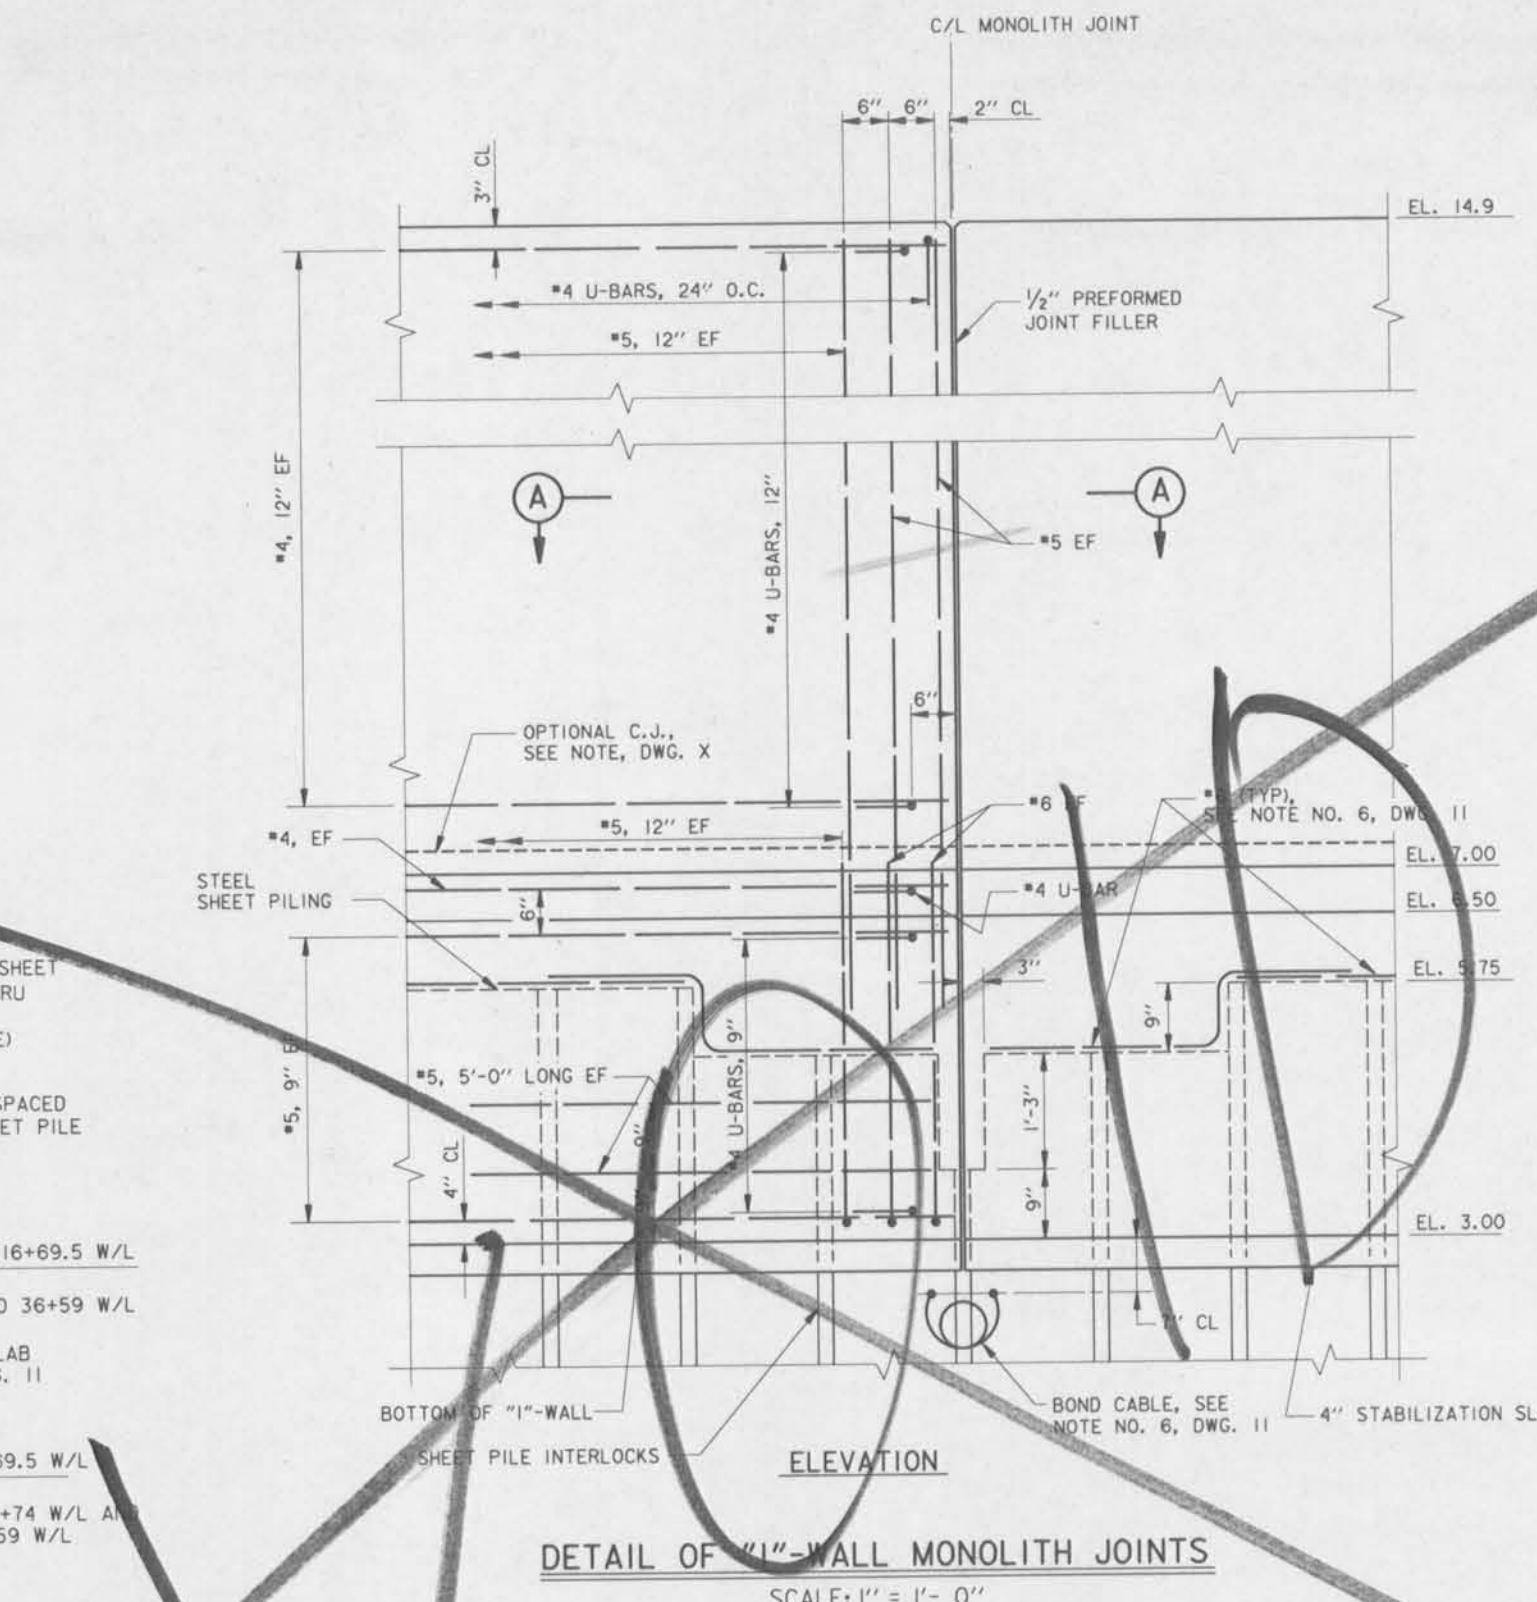

DETAIL OF "I"-WALL MONOLITH JOINTS


SCALE: 1" = 1'- 0"

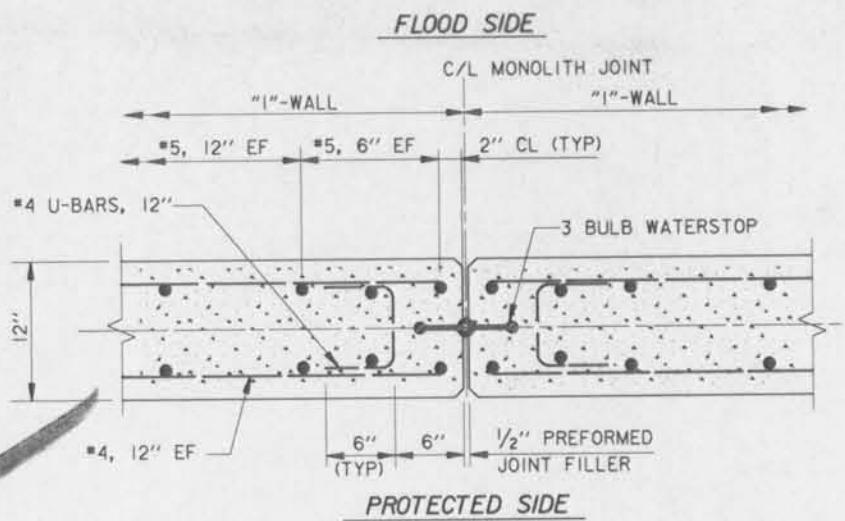

SECTION A

TYPICAL REINFORCEMENT AT MONOLITH JOINTS

SCALE: 1 1/2" = 1' - 0"

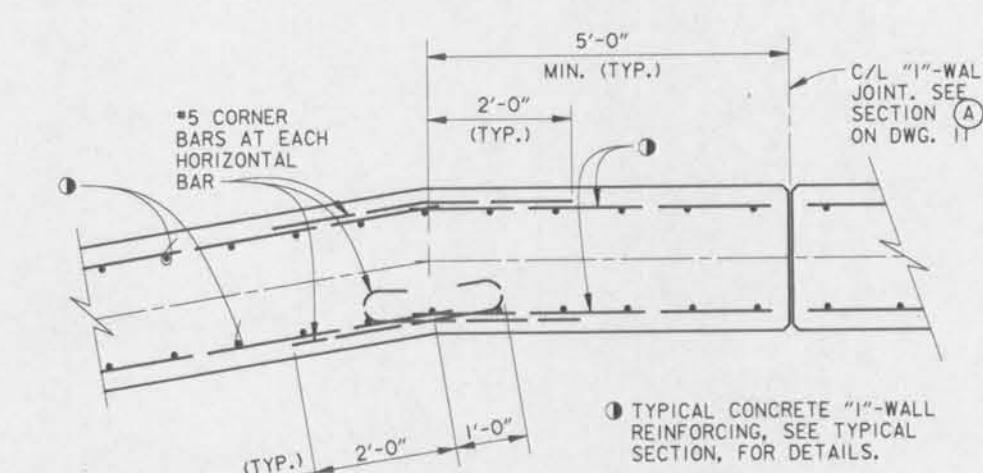


● TYPICAL CONCRETE "I"-WALL REINFORCING, SEE TYPICAL SECTION, FOR DETAILS.

"I"-WALL CORNER REINFORCING DETAIL

(STEEL SHEETING NOT SHOWN)

SCALE: 3/4" = 1'-0"

PROTECTED SIDE

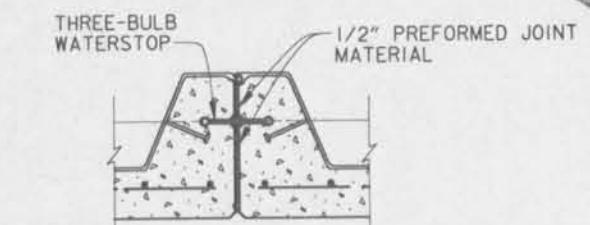

"I"-WALL JOINT C

SCALE: 1" = 1'- 0"

SCALE: 3/4" = 1'- 0"

SCALE: 1 1/2" = 1' - 0"

12' 0" 1' 2' 3' 4' 5'

SCALE: 1" = 1'- 0"

12' 0" 1' 2' 3' 4' 5'

SCALE: 1" = 1'- 0"


12' 0" 1' 2' 3' 4' 5'

NOTES:

1. FOR GENERAL NOTES, SEE DWG. 2.
2. PROVIDE A 1 V ON I H TRANSITION AT THE BOTTOM OF CONCRETE "I"-WALL (FLOOD SIDE ONLY) CENTERED AT STA. 16+71.0 W/L.

SYMBOL	DESCRIPTION	DATE APPROVED	REVISIONS
	U.S. ARMY ENGINEER DISTRICT, NEW ORLEANS CORPS OF ENGINEERS NEW ORLEANS, LOUISIANA		
BOARD OF LEVEE COMMISSIONERS NEW ORLEANS LEVEE DISTRICT NEW ORLEANS, LOUISIANA	DESIGN ENGINEERING, INC. 3330 W. ESPLANADE AVE. S. METAIRIE, LOUISIANA 70002		
LAKE PONTCHARTRAIN, LA. AND VICINITY NEW ORLEANS LAKEFRONT LEVEE WEST OF I.H.N.C. NEW ORLEANS AVE. CANAL FLOOD PROTECTION IMPROVEMENT PHASE II-D (WEST SIDE B/L STA.2+39.00 TO STA.29+07.50) NEW ORLEANS PARISH, LOUISIANA	HIGH LEVEL PLAN FILE NO. CADD FILE # II-D12		
	TYPICAL "I"-WALL DETAILS	PLOT DATE: MARCH 1993	PLOT SCALE: 16
DESIGNED BY: V. PANNELL DRAWN BY: CJK & GFG CHECKED BY: T. SMITH SUBMITTED BY: DESIGN ENGINEERING, INC. SOLICITATION NO.: H-4-40205 DESIGN ENGINEER: DAWC29-93-B-0042	CADD FILE # II-D12	FILE NO. H-4-40205	DWG. 12 OF 24

Safety is a Part of Your Contract

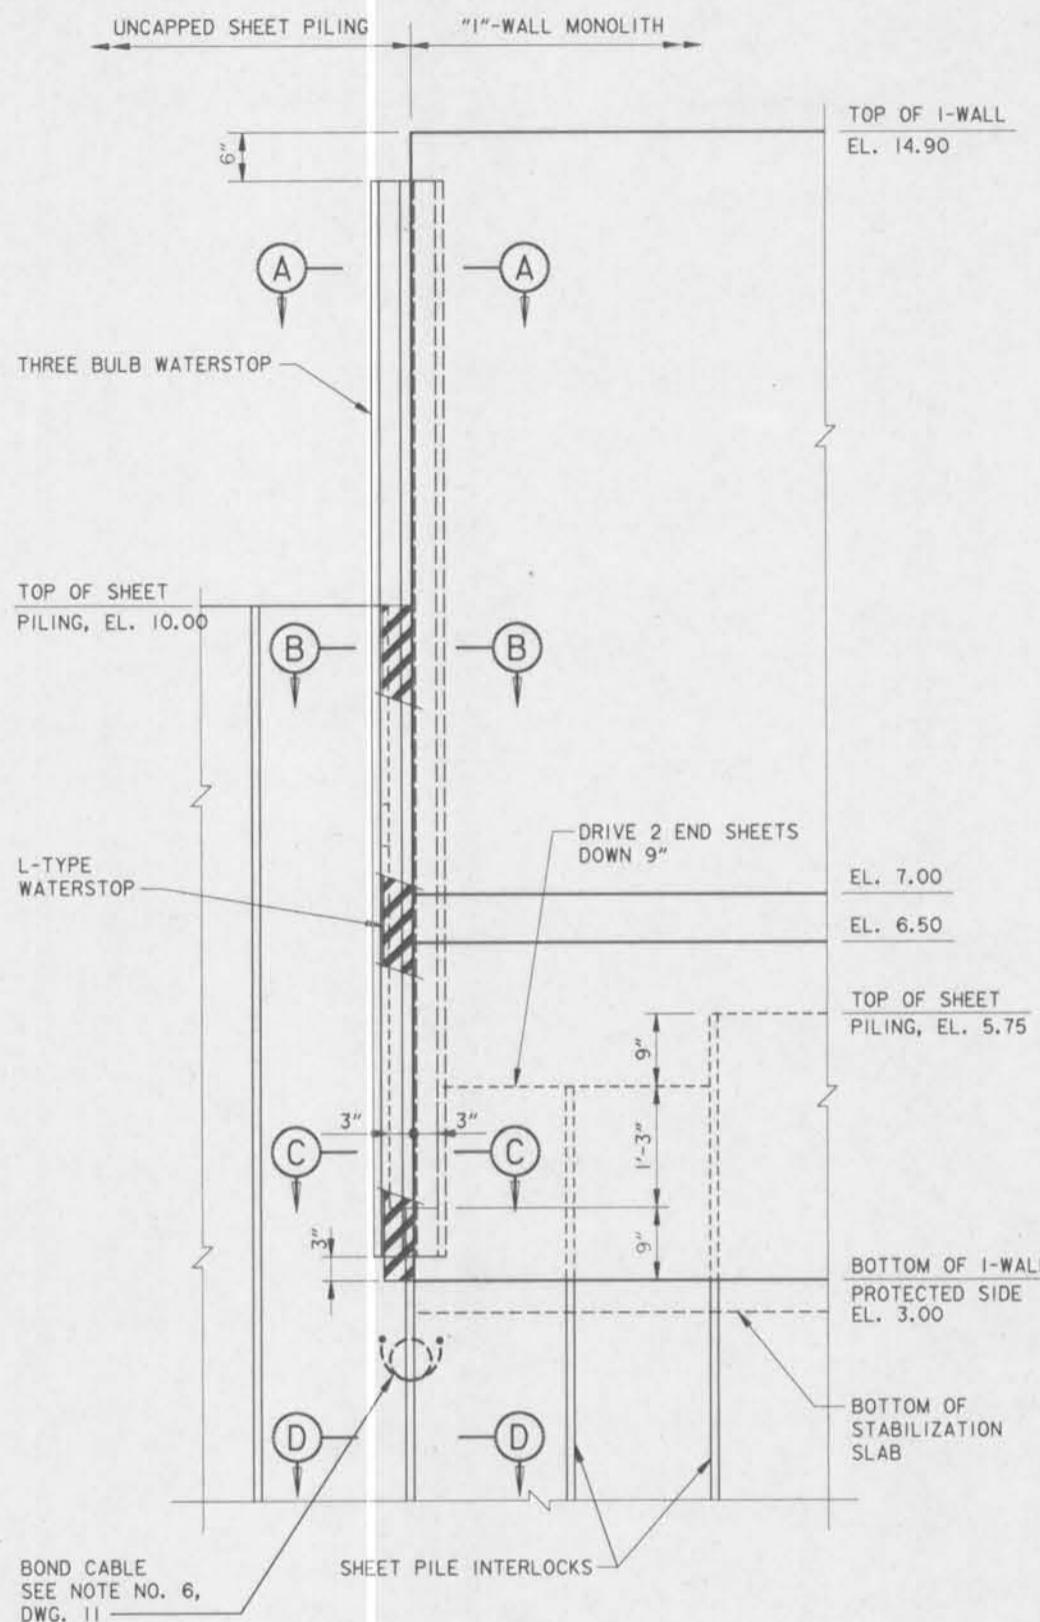

FLOOD SIDE ELEVATION

UNCAPPED SHEET PILING TO "I"-WALL

SCALE: 1" = 1'-0"


SCALE: 1'' = 1'-0"

A horizontal number line with tick marks every 0.5 units, labeled from $-2'$ to $4'$. The labels are positioned above the line: $-2'$, 0 , $1'$, $2'$, $3'$, and $4'$.

SCALE: 13'' = 1'

SCALE: 12' - 1' - 0'


SCALE: 3'' = 1'-0"

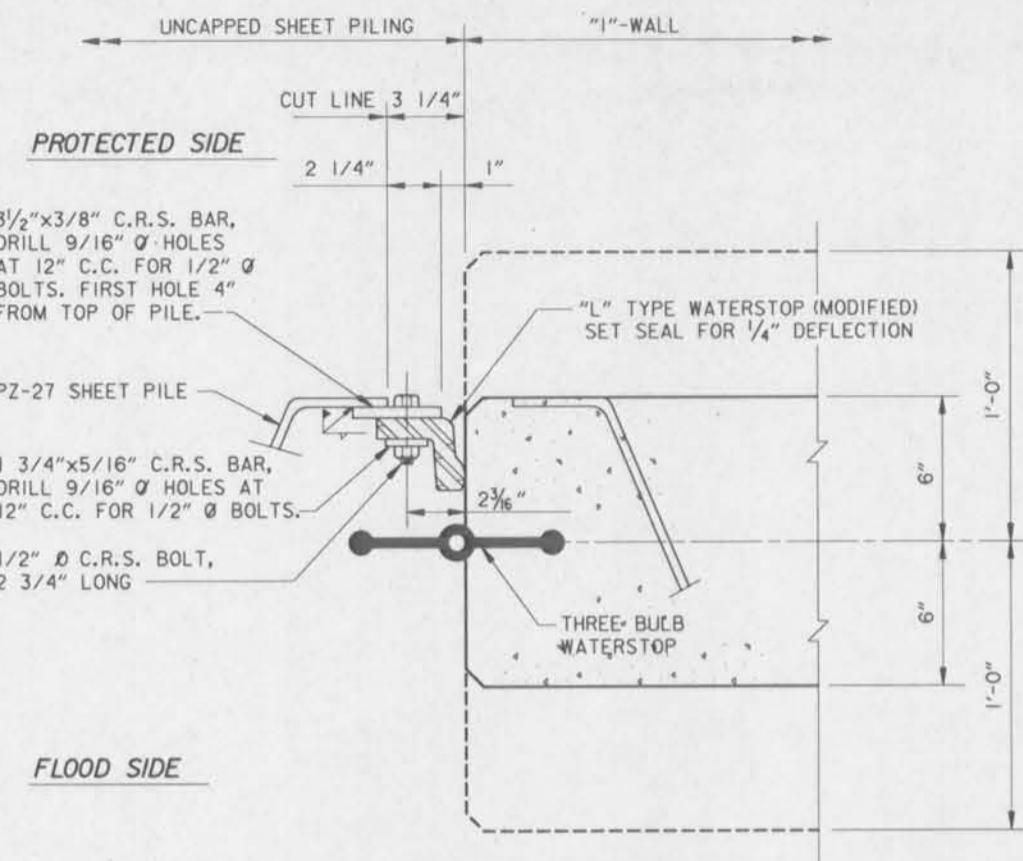

TRANSITION - I-WALL TO UNCAPPED SHEET PILING


DETAIL C

SCALE: 3" = 1'-0"

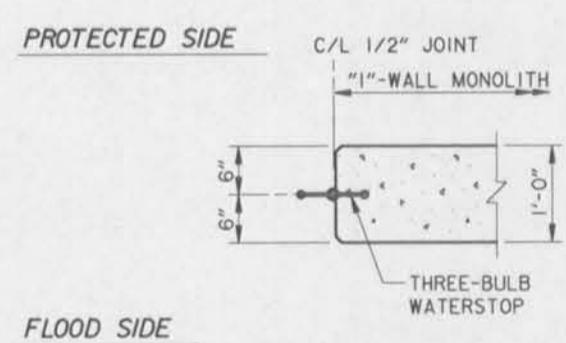


SECTION A

SCALE: 1" = 1'-0"

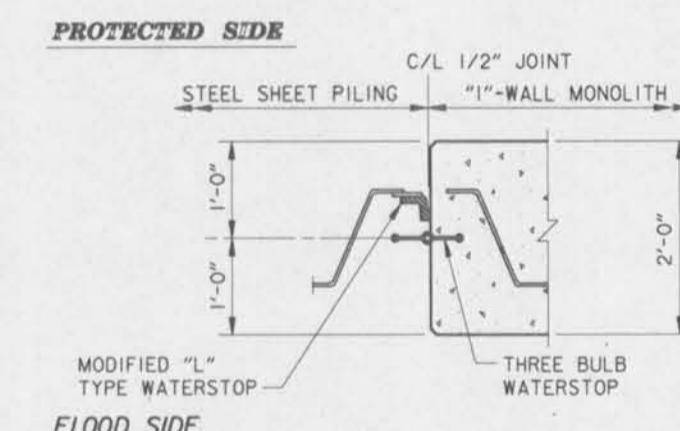

SECTION C


SCALE: 1" = 1'-0"

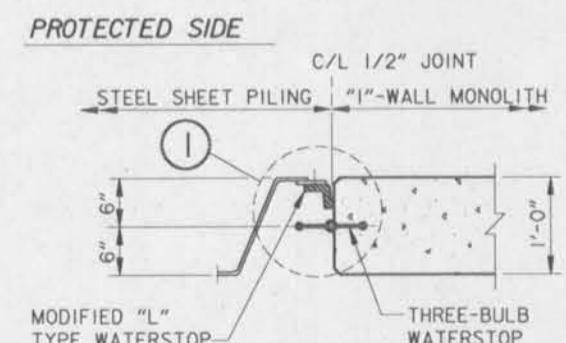

FLOOD SIDE

SECTION

SCALE: 1" = 1'-0"

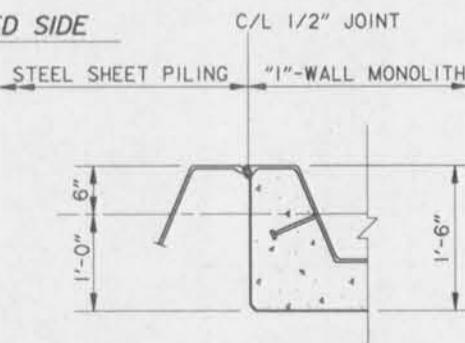

FLOOD SIDE


SECTION D

SCALE: 1" = 1'-0"




SYMBOL	DESCRIPTION	DATE	APPROVED
REVISIONS			
 <p>U. S. ARMY ENGINEER DISTRICT, NEW ORLEANS CORPS OF ENGINEERS NEW ORLEANS, LOUISIANA</p>			
BOARD OF LEVEE COMMISSIONERS ORLEANS LEVEE DISTRICT NEW ORLEANS, LOUISIANA		DESIGN ENGINEERING, INC. 3330 W. ESPLANADE AVE. S. METAIRIE, LOUISIANA 70002	
<p>LAKE PONTCHARTRAIN, LA. AND VICINITY HIGH LEVEL PLAN</p> <p>NEW ORLEANS LAKEFRONT LEVEE WEST OF I.H.N.C. ORLEANS AVE. CANAL FLOOD PROTECTION IMPROVEMENT PHASE II-D (WEST SIDE: B/L STA.2+39.00 TO STA.29+07.50) ORLEANS PARISH, LOUISIANA</p> <p>TYPICAL "I"-WALL DETAILS</p>			
DESIGNED BY: V. PANELL DRAWN BY: C. KOCH CHECKED BY: T. SMITH	DATE: FEB., 1993	PLOT SCALE: 12	PLOT DATE: MARCH 1993
SUBMITTED BY: <u>DESIGN ENGINEERING, INC.</u> DESIGN ENGINEER	CADD FILE: II-D12A	FILE NO. H-4-40205	DWG. 12a OF 24
SOLICITATION NO. DACP29-93-B-0042			


Safety is a Part of Your Contract

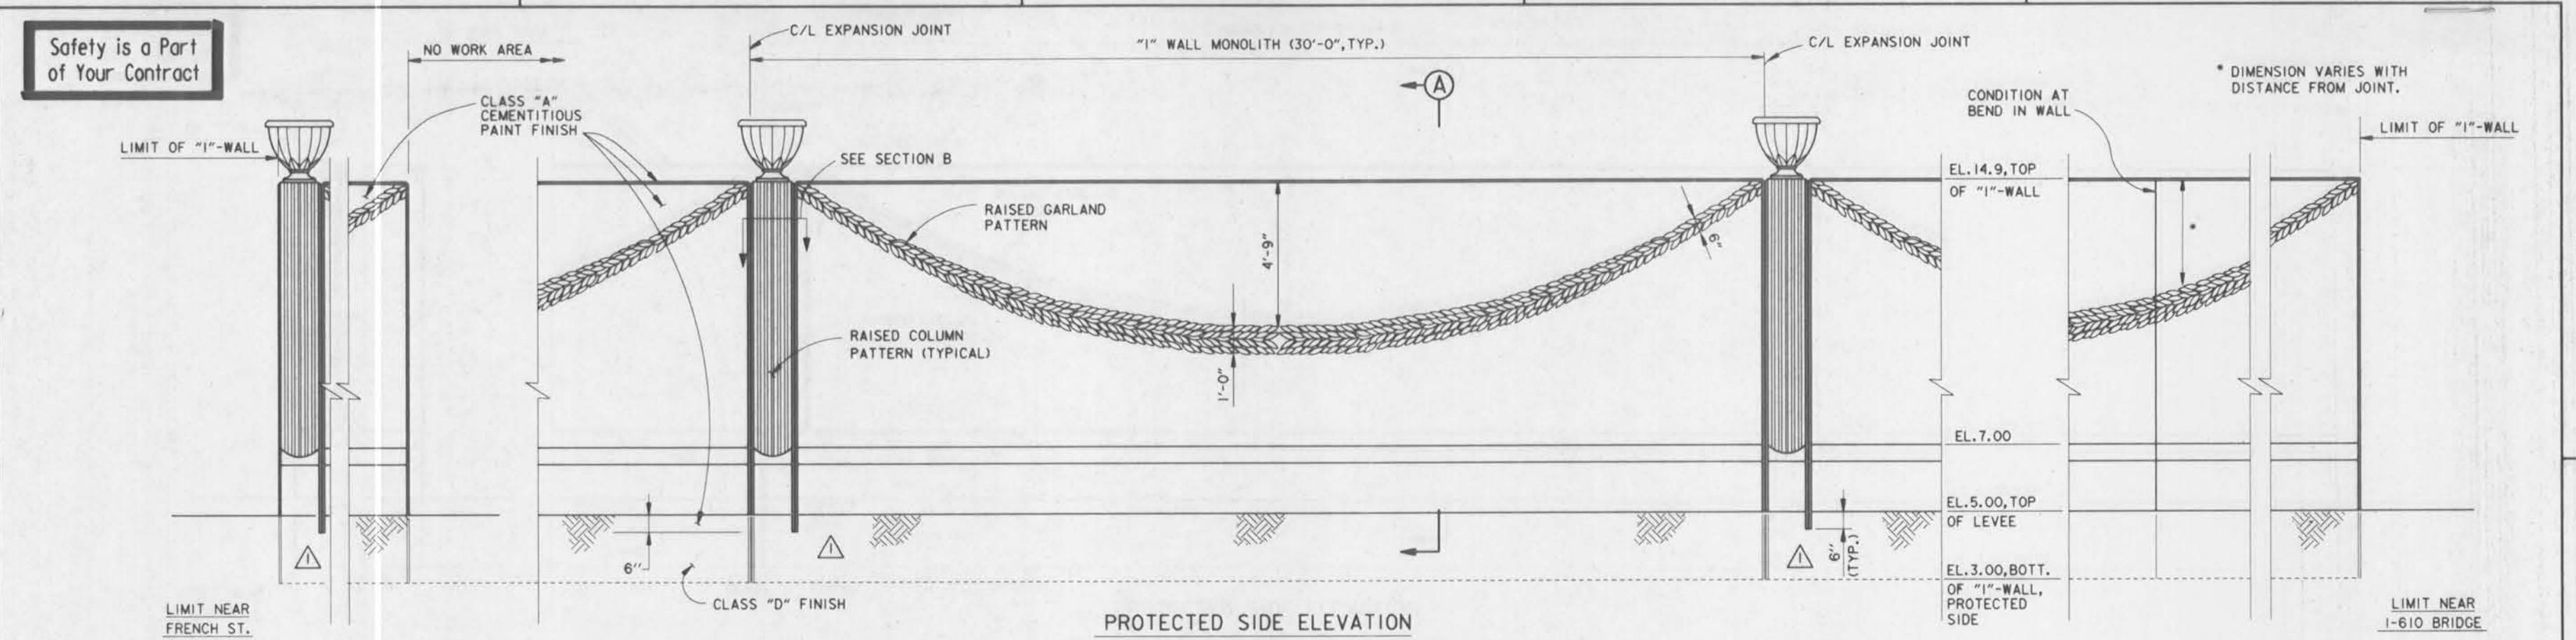


PROTECTED SIDE ELEVATION
TYPICAL "I"-WALL TREATMENT

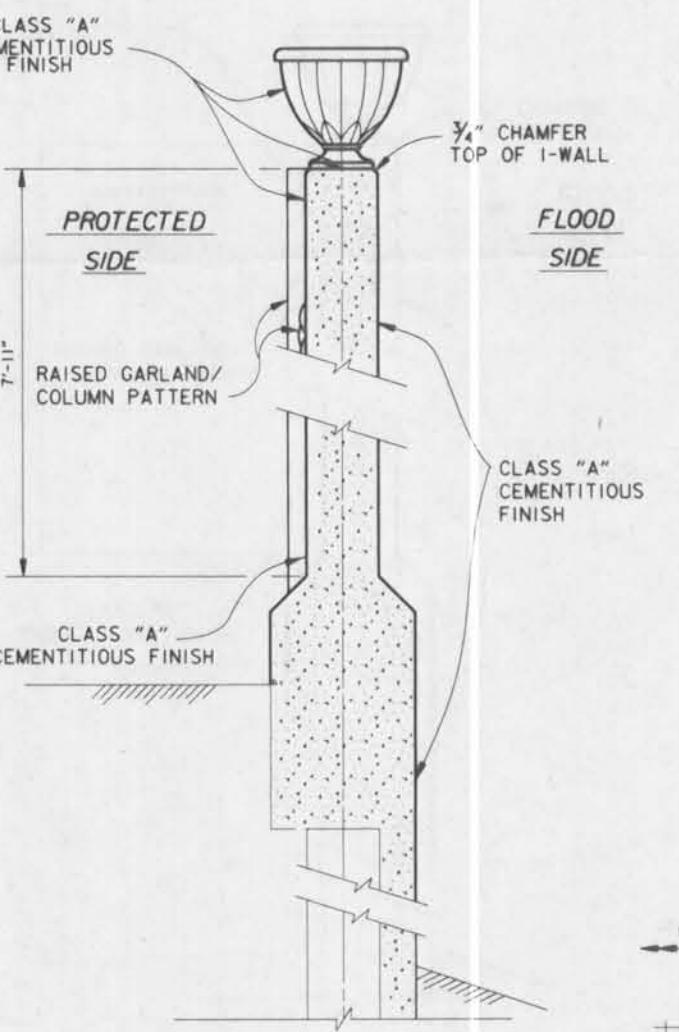


WALL

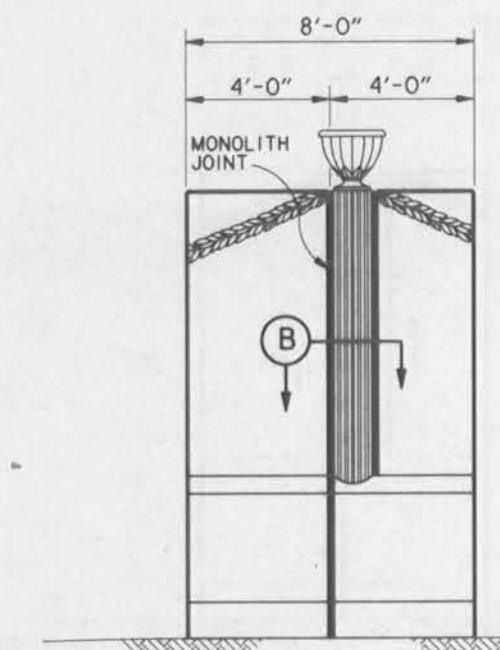


CLASS "A" CEMENTITIOUS FINISH TO BE APPLIED
TO SURFACES AS REQUIRED FOR "I"-WALL

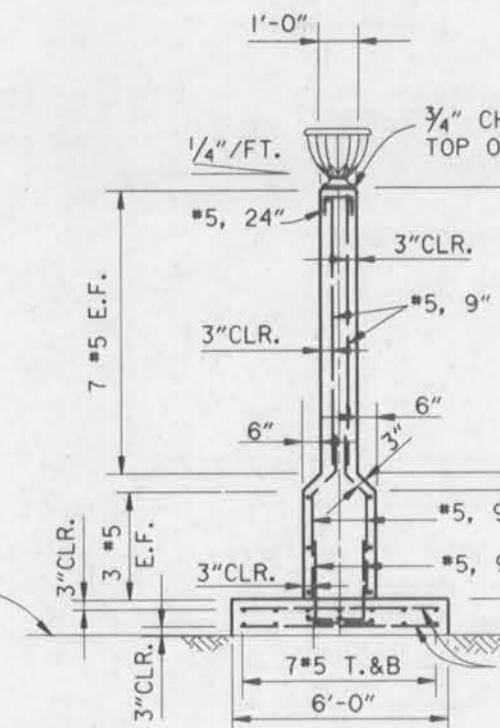


WALL SEC

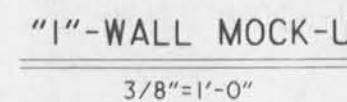

1

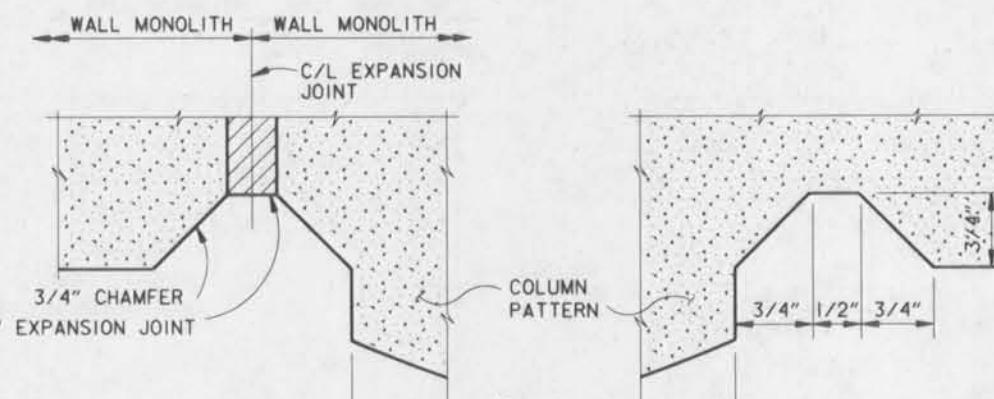

TYPICAL CHAMFER AT


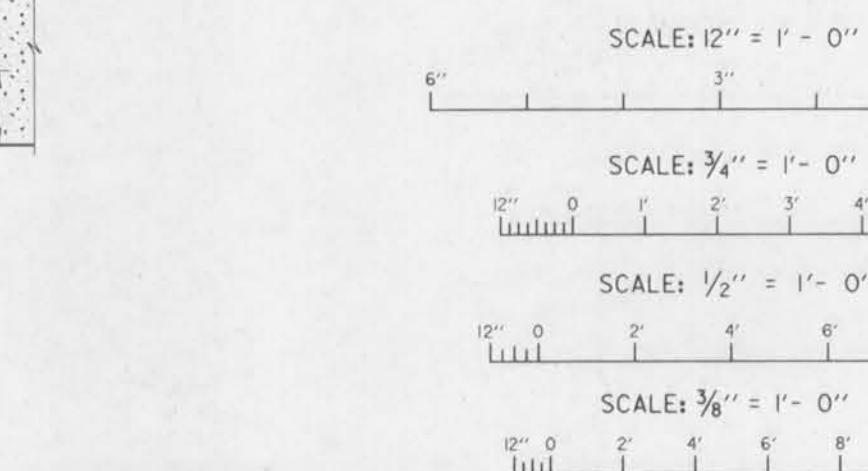


THIS PLAN ACC
MODIFICATION
TO CONTRACT
DACPW29-93-

- I. CONTRACTOR SHALL SUBMIT DRAWINGS SHOWING THE LOCATION OF ALL JOINTS IN ALL FORMS USED FOR CONSTRUCTION FOR PRIOR APPROVAL.
 2. ALL EXPOSED SURFACES SHALL BE FINISHED BY COATING WITH CEMENTITIOUS PAINT, SUCH AS "THOROSEAL" BY STANDARD DRY WALL PRODUCTS OR EQUAL, (FED. SPEC. AA-1555 '81) TO A DEPTH OF 1'-0" BELOW FINAL GRADE. A COLOR, BEIGE, IS TO BE ADDED TO THE COATING.
 3. OMIT CHAMFERS ON ALL HORIZONTAL CONSTRUCTI-JOINTS.


	MODIFIED DUMMY JOINT LENGTH, MOD. NO. 5	12-14-93	M.D.
SYMBOL	DESCRIPTION	DATE	APPROVED
REVISIONS			
 U.S. ARMY ENGINEER DISTRICT, NEW ORLEANS CORPS OF ENGINEERS NEW ORLEANS, LOUISIANA			
BOARD OF LEVEE COMMISSIONERS ORLEANS LEVEE DISTRICT NEW ORLEANS, LOUISIANA		DESIGN ENGINEERING, INC. 3330 W. ESPLANADE AVE. S. METAIRIE, LOUISIANA 70002	
LAKE PONTCHARTRAIN, LA. AND VICINITY HIGH LEVEL PLAN			
NEW ORLEANS LAKEFRONT LEVEE WEST OF I.H.N.C. ORLEANS AVE. CANAL FLOOD PROTECTION IMPROVEMENT PHASE II-D (WEST SIDE: B/L STA.2+39.00 TO STA.29+07.50) ORLEANS PARISH, LOUISIANA			
"I"-WALL ARCHITECTURAL TREATMENT			
DESIGNED BY: V. PANNELL	DATE: FEB. 1993	PLOT SCALE: 24	PLOT DATE: MARCH 1993
DRAWN BY: K.A. WOJTALA			FILE NO. H-4-40205
CHECKED BY: T.M. SMITH			
SUBMITTED BY: DESIGN ENGINEERING, INC. DESIGN ENGINEER	CADD FILE: II-D13	SOLICITATION NO. DACW29-93-B-0042	DWG. 13 OF 24

Safety is a Part
of Your Contract

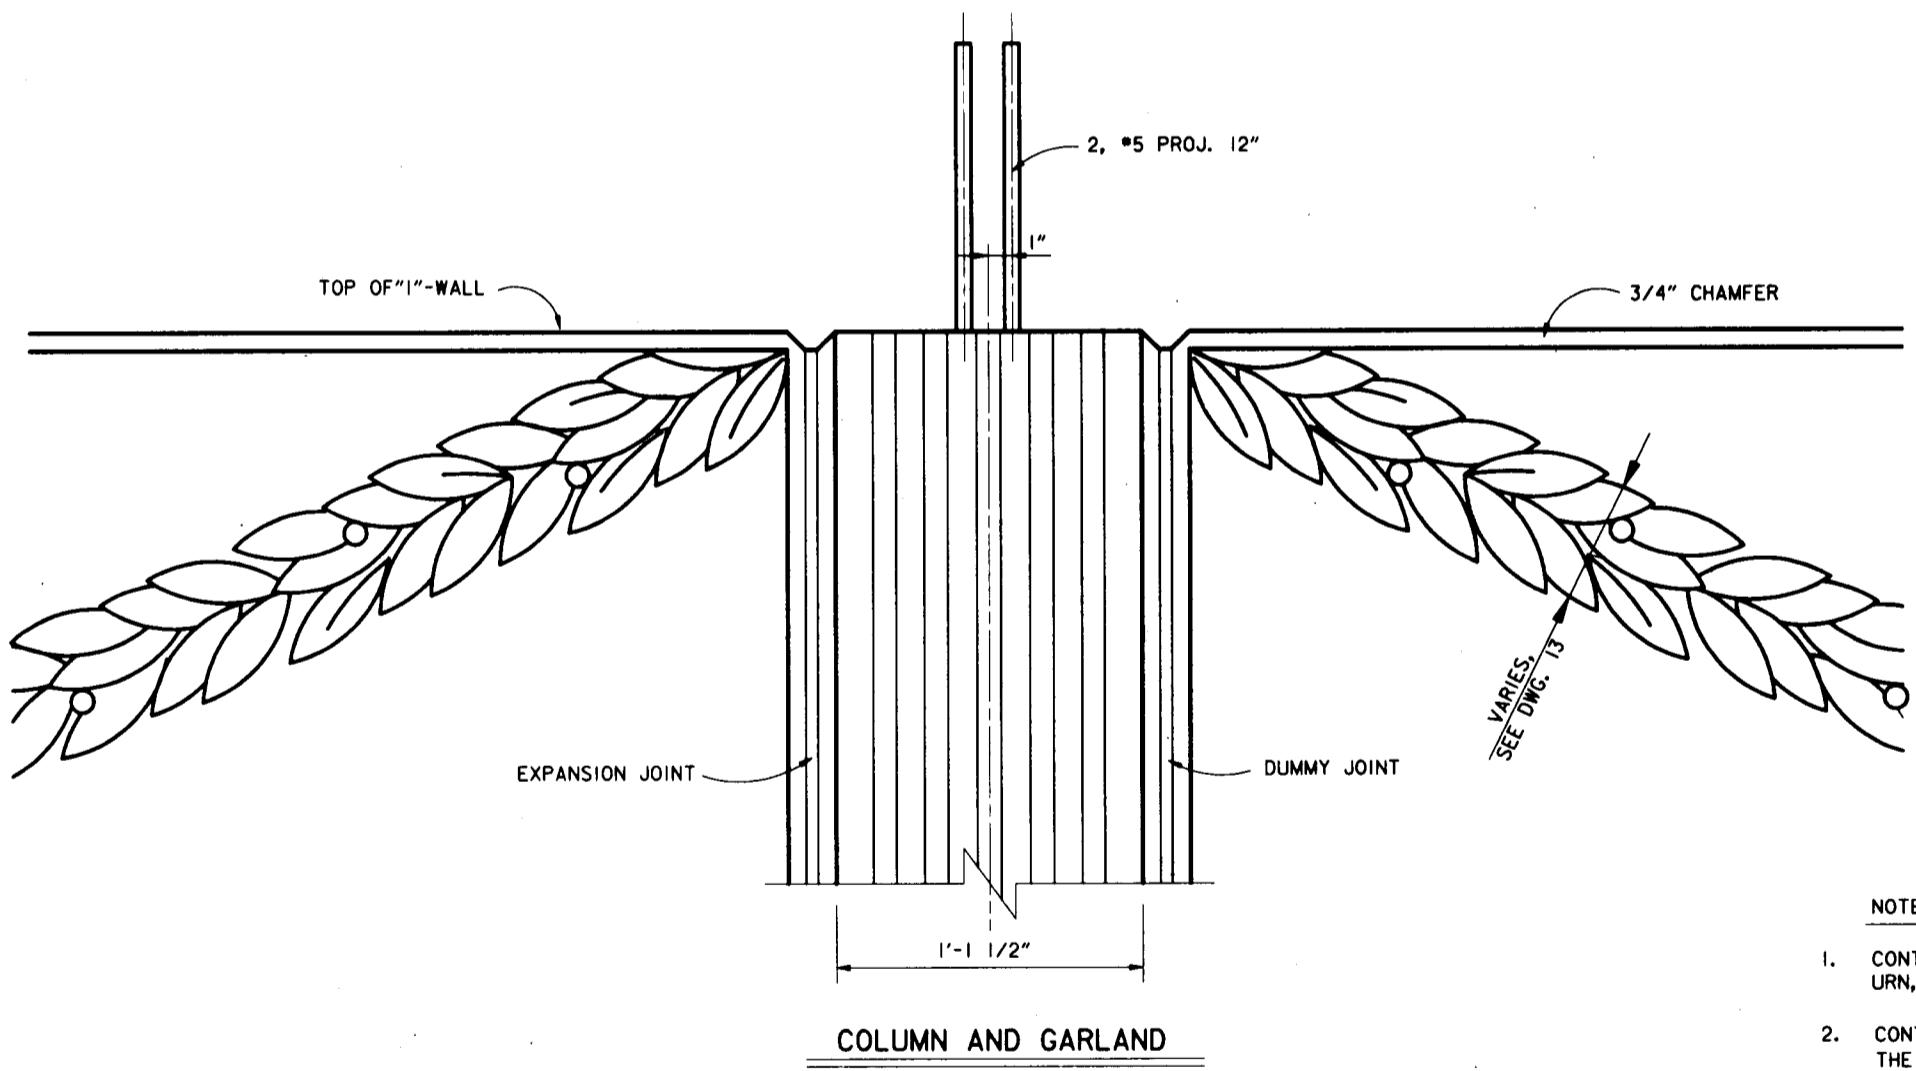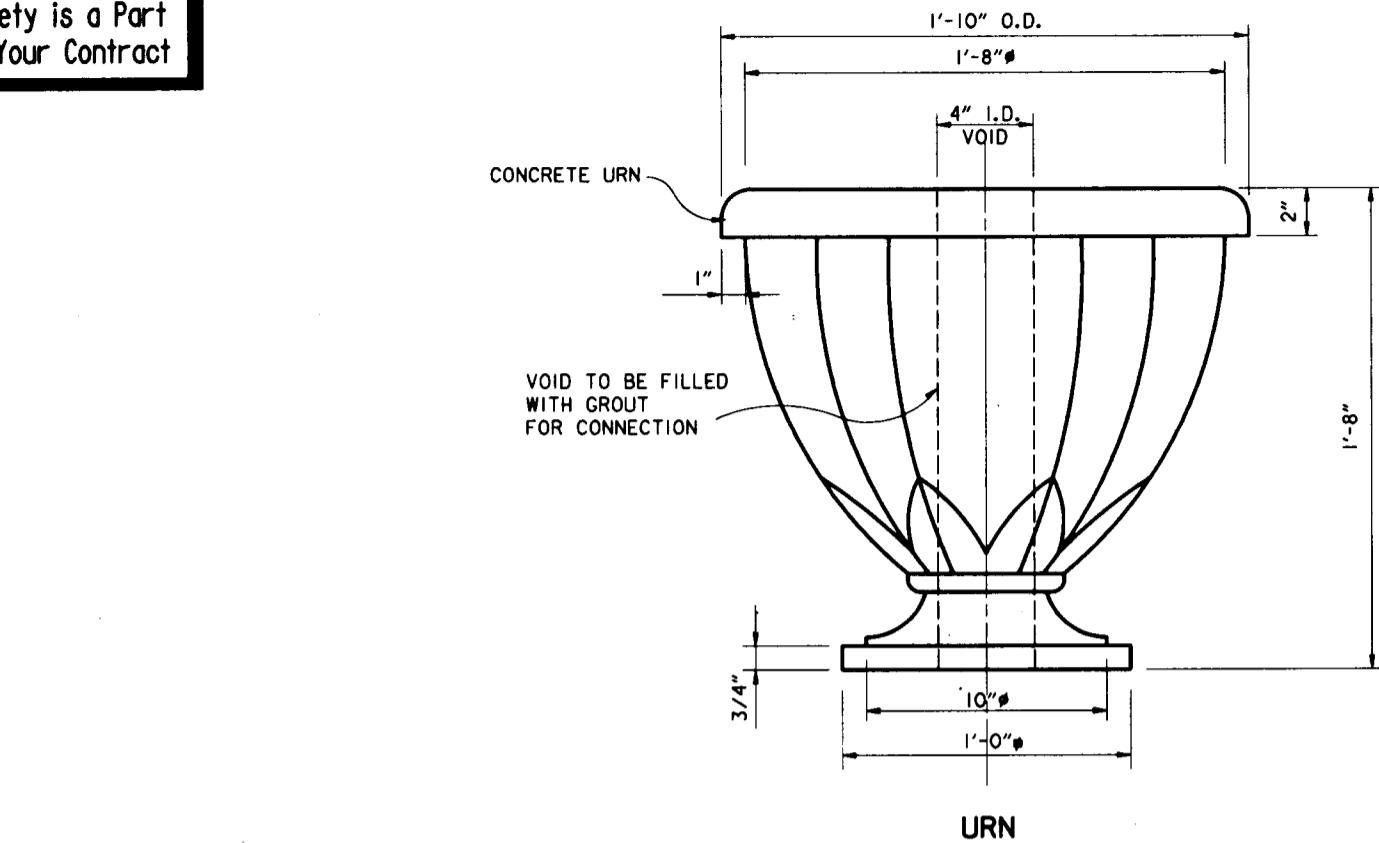

DETAIL VIEWS




SCALE: 3" = 1'-0"

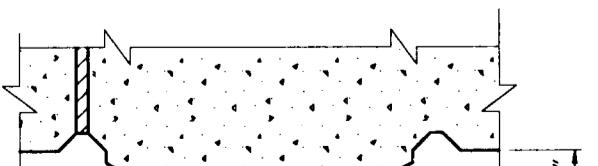


COLUMN PLAN

NOTES:

1. CONTRACTOR WILL BE FURNISHED WITH MOLDS OF THE URN, COLUMN AND GARLAND SHAPES BY THE GOVERNMENT.
2. CONTRACTOR SHALL MAKE REQUIRED FORMS AND FORM LINERS USING THE MOLDS SUPPLIED BY THE GOVERNMENT.
3. URNS TO BE PRECAST AND INSTALLED ONTO BARS WHICH PROJECT FROM THE TOP OF "T"-WALL. FILL VOID IN URN WITH GROUT TO CONNECT URN TO "T"-WALL.

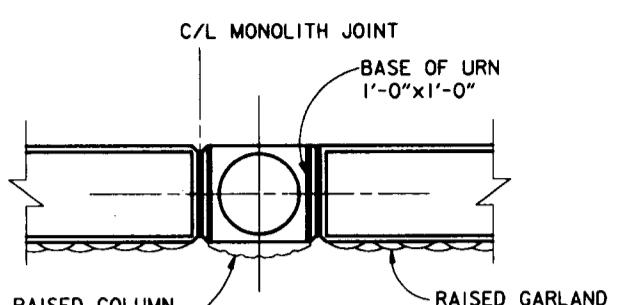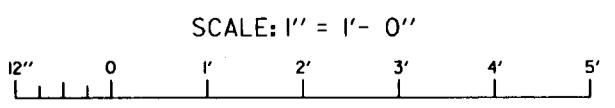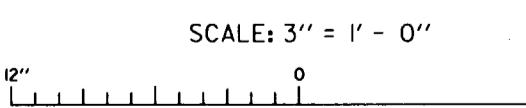

PLAN

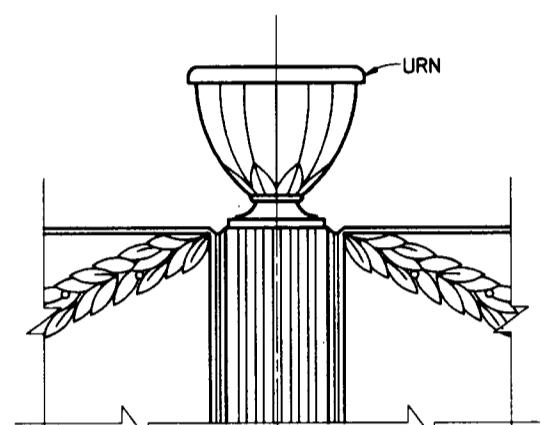

ELEVATION

ASSEMBLED VIEWS

SCALE: 1" = 1'-0"

REVISIONS	SYMBOL	DESCRIPTION	DATE	APPROVED
U.S. ARMY ENGINEER DISTRICT, NEW ORLEANS CORPS OF ENGINEERS NEW ORLEANS, LOUISIANA				

BOARD OF LEVEE COMMISSIONERS DESIGN ENGINEERING, INC.
NEW ORLEANS LEVEE DISTRICT 3320 W. ESPALMADE AVE. S.
NEW ORLEANS, LOUISIANA METAIRIE, LOUISIANA 7002

LAKE PONTCHARTRAIN, LA. AND VICINITY HIGH LEVEL PLAN

NEW ORLEANS LAKEFRONT LEVEE WEST OF I.H.N.C.

ORLEANS AVE. CANAL FLOOD PROTECTION IMPROVEMENT PHASE II-D (WEST SIDE: B/L STA.2+39.00 TO STA.2+07.50)


ORLEANS PARISH, LOUISIANA

"I"-WALL ARCHITECTURAL TREATMENT

DESIGNED BY: E. ALFREZ DATE: MARCH 1993 PLOT SCALE: 4 PLOT DATE: MARCH 1993
DRAWN BY: K.A. WOJTALA FILE NO. H-4-40205
CHECKED BY: T.M. SMITH CAD FILE: II-D13A
SUBMITTED BY: DESIGN ENGINEERING, INC. SOLICITATION NO.: DAWC29-93-B-0042
DESIGN ENGINEER Dwg. 13G of 24




Safety is a Part
of Your Contract

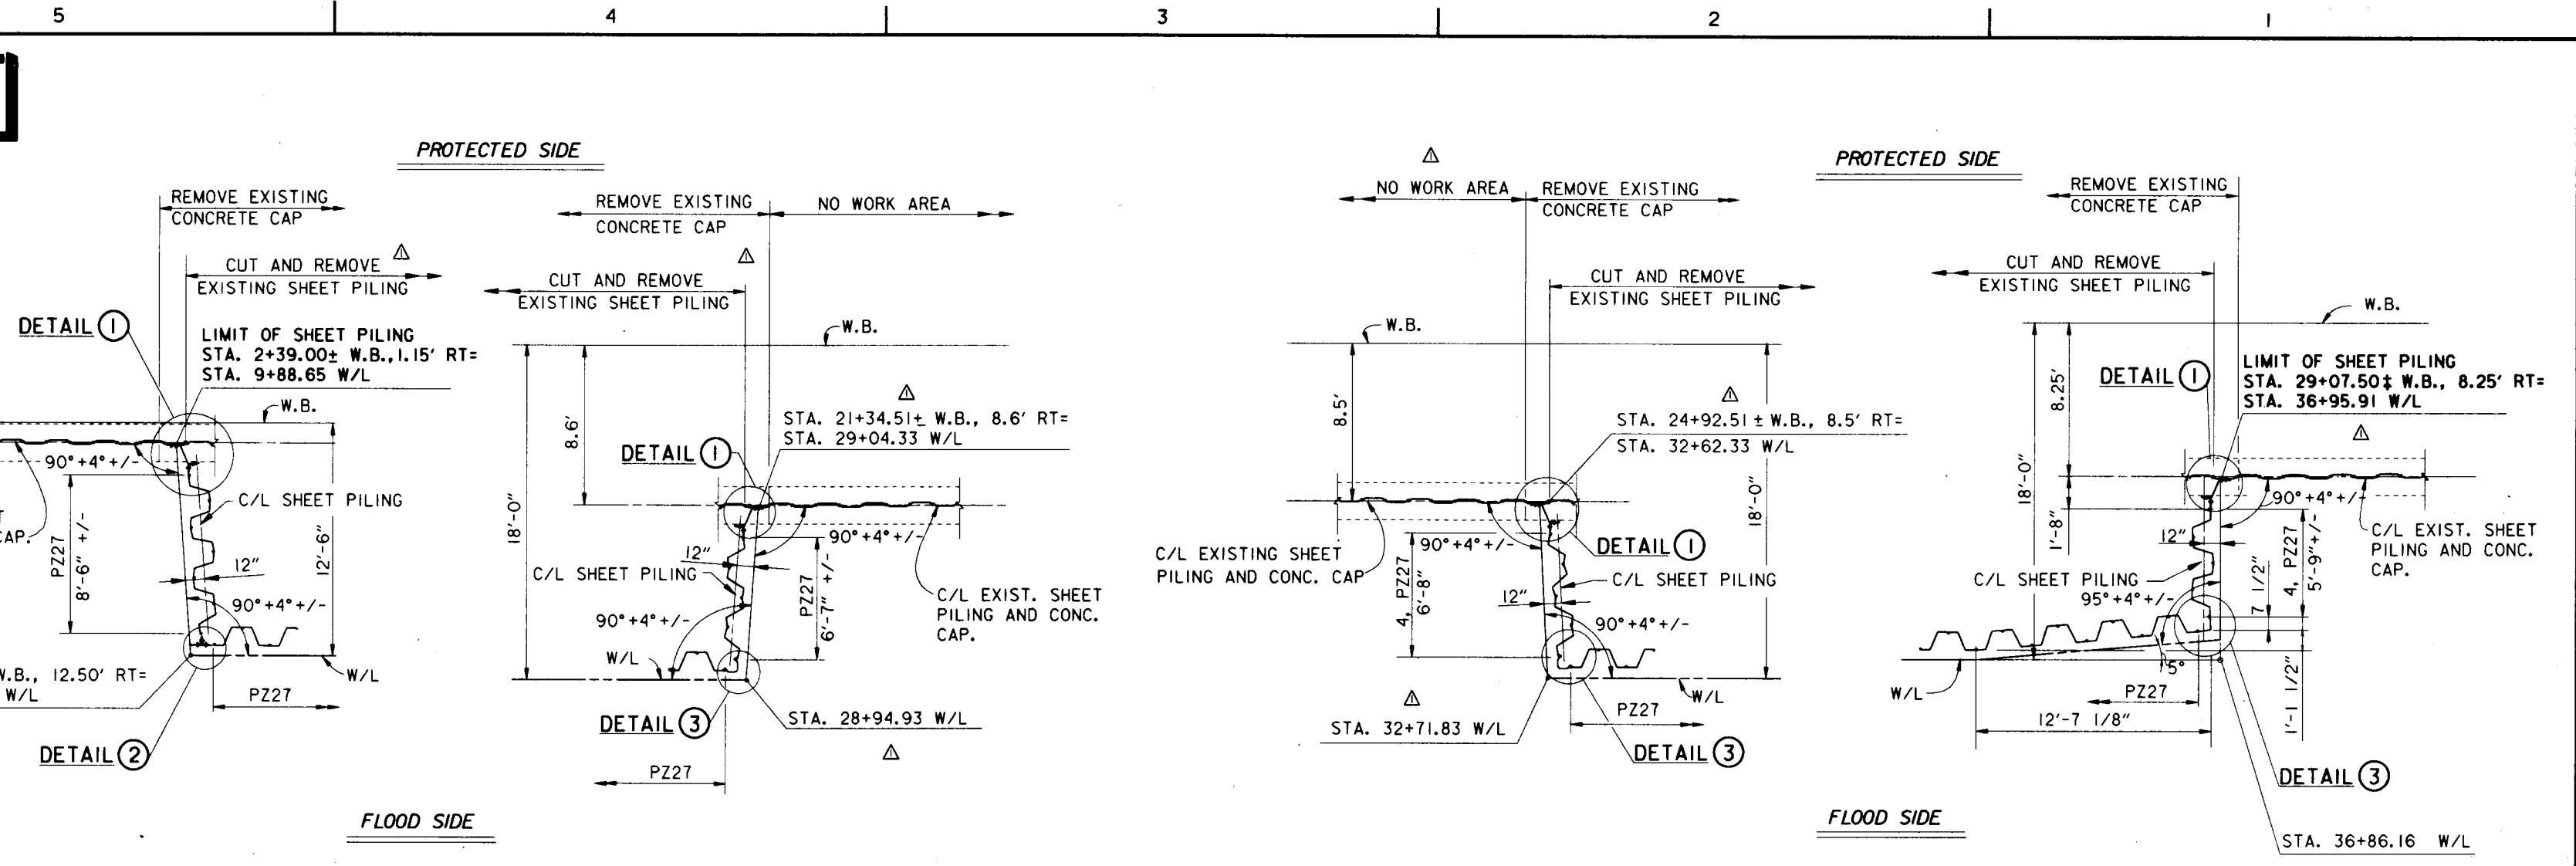

CONNECTIONS TO EXISTING FLOODWALL


SCALE: 1/4" = 1'-0"

NOTE:
FOR GENERAL NOTES, SEE DWG. 2.

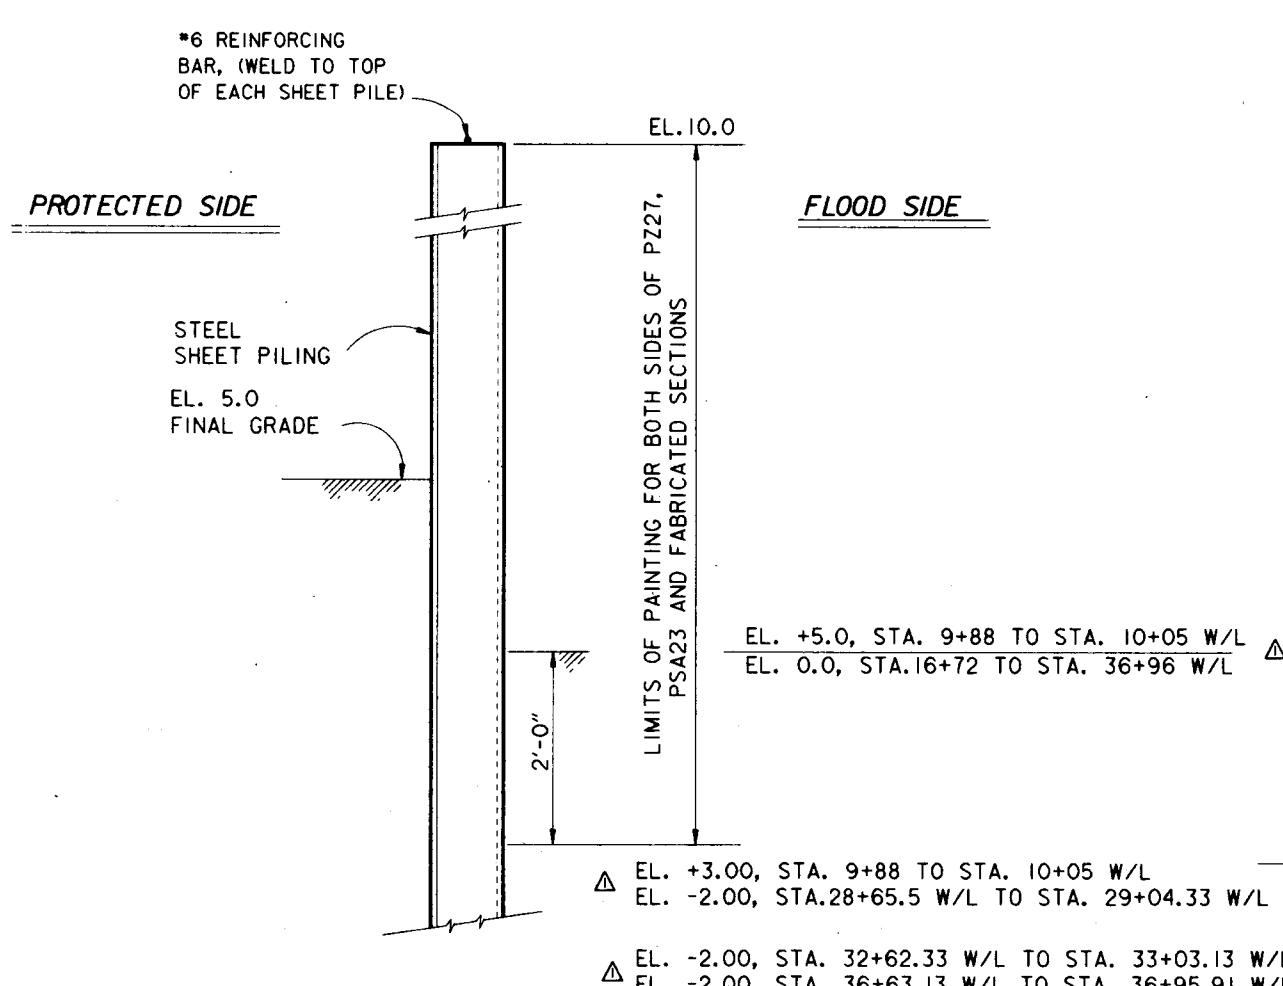

PAINTING AND CORROSION PROTECTION DETAIL I-TYPE WALL UNCAPPED

SCALE: 1"=1'-0"

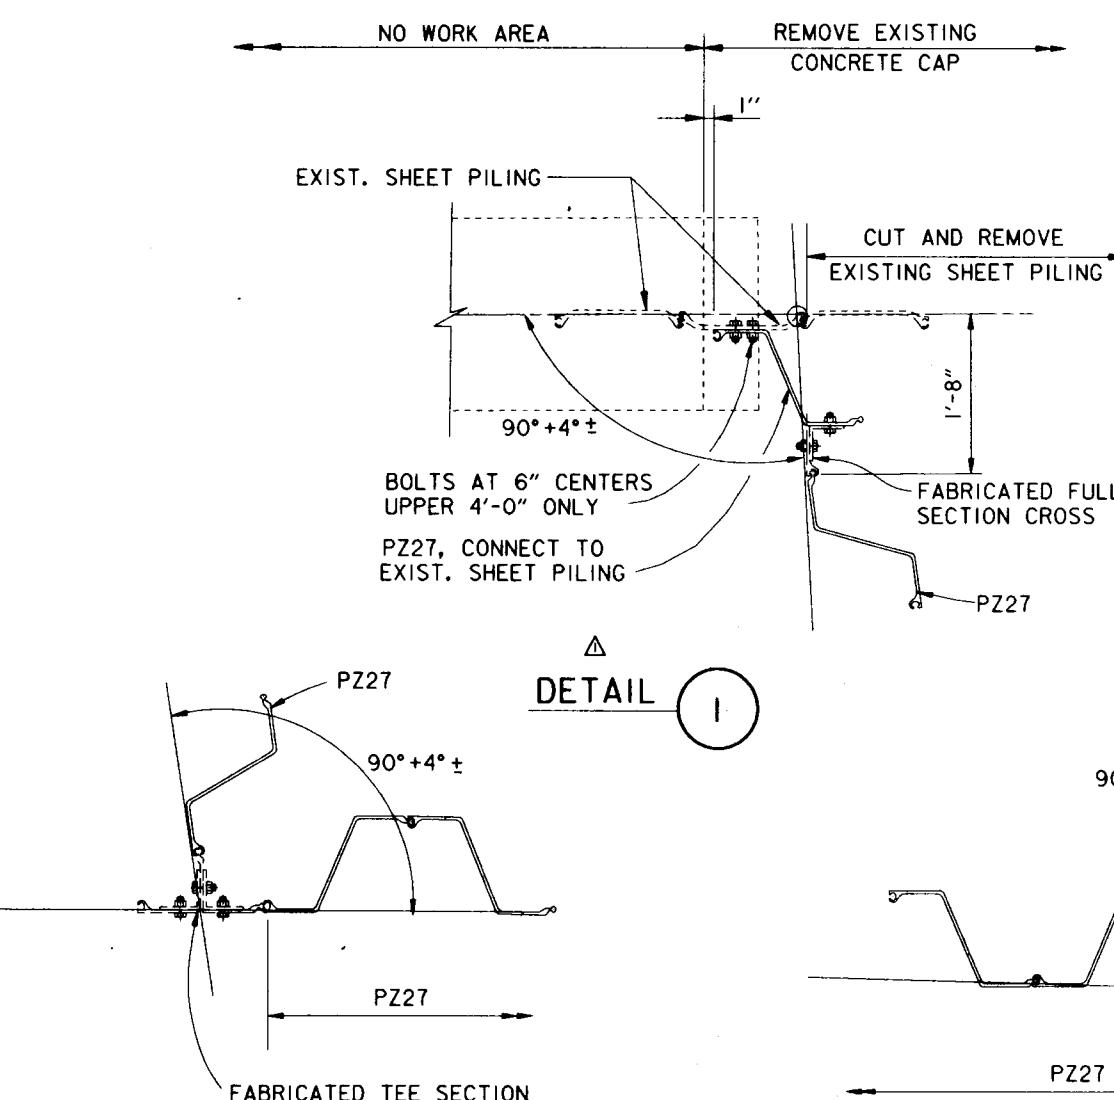

SCALE: 1" = 1'- 0"


SCALE: 1/4" = 1'- 0"

CONNECTION DETAILS

SCALE: 1"=1'-0"

GENERAL REVISIONS, AMENDMENT NO. I.		5-II-93	M.D.
SYMBOL	DESCRIPTION	DATE	APPROVED
REVISIONS			
U.S. ARMY ENGINEER DISTRICT, NEW ORLEANS CORPS OF ENGINEERS NEW ORLEANS, LOUISIANA			
BOARD OF LEVEE COMMISSIONERS NEW ORLEANS LEVEE DISTRICT NEW ORLEANS, LOUISIANA	DESIGN ENGINEERING, INC. 3330 W. ESPLANADE AVE. S. METairie, LOUISIANA 70002		
LAKE PONTCHARTRAIN, LA. AND VICINITY HIGH LEVEL PLAN			
NEW ORLEANS LAKEFRONT LEVEE WEST OF I.H.N.C.			
ORLEANS AVE. CANAL FLOOD PROTECTION IMPROVEMENT PHASE II-D (WEST SIDE): B/L STA. 2+39.00 TO STA. 29+07.50			
ORLEANS PARISH, LOUISIANA			
CONNECTIONS TO EXIST. WALL AND MISC. DETAILS			
DESIGNED BY: M.B.SHUKLA	DRAWN BY: K.C.REID	PLOT SCALE: 48	PLOT DATE: MAY 1993
DRAWN BY: K.C.REID	CHECKED BY: T.M.SMITH	FILE NO.	H-4-40205
SUBMITTED BY: DESIGN ENGINEERING, INC.	FILE NO.: II-D14	SOLICITATION NO.	DACW29-93-B-0042
DESIGN ENGINEER	DWG. 14 OF 24		


Safety is a Part
of Your Contract

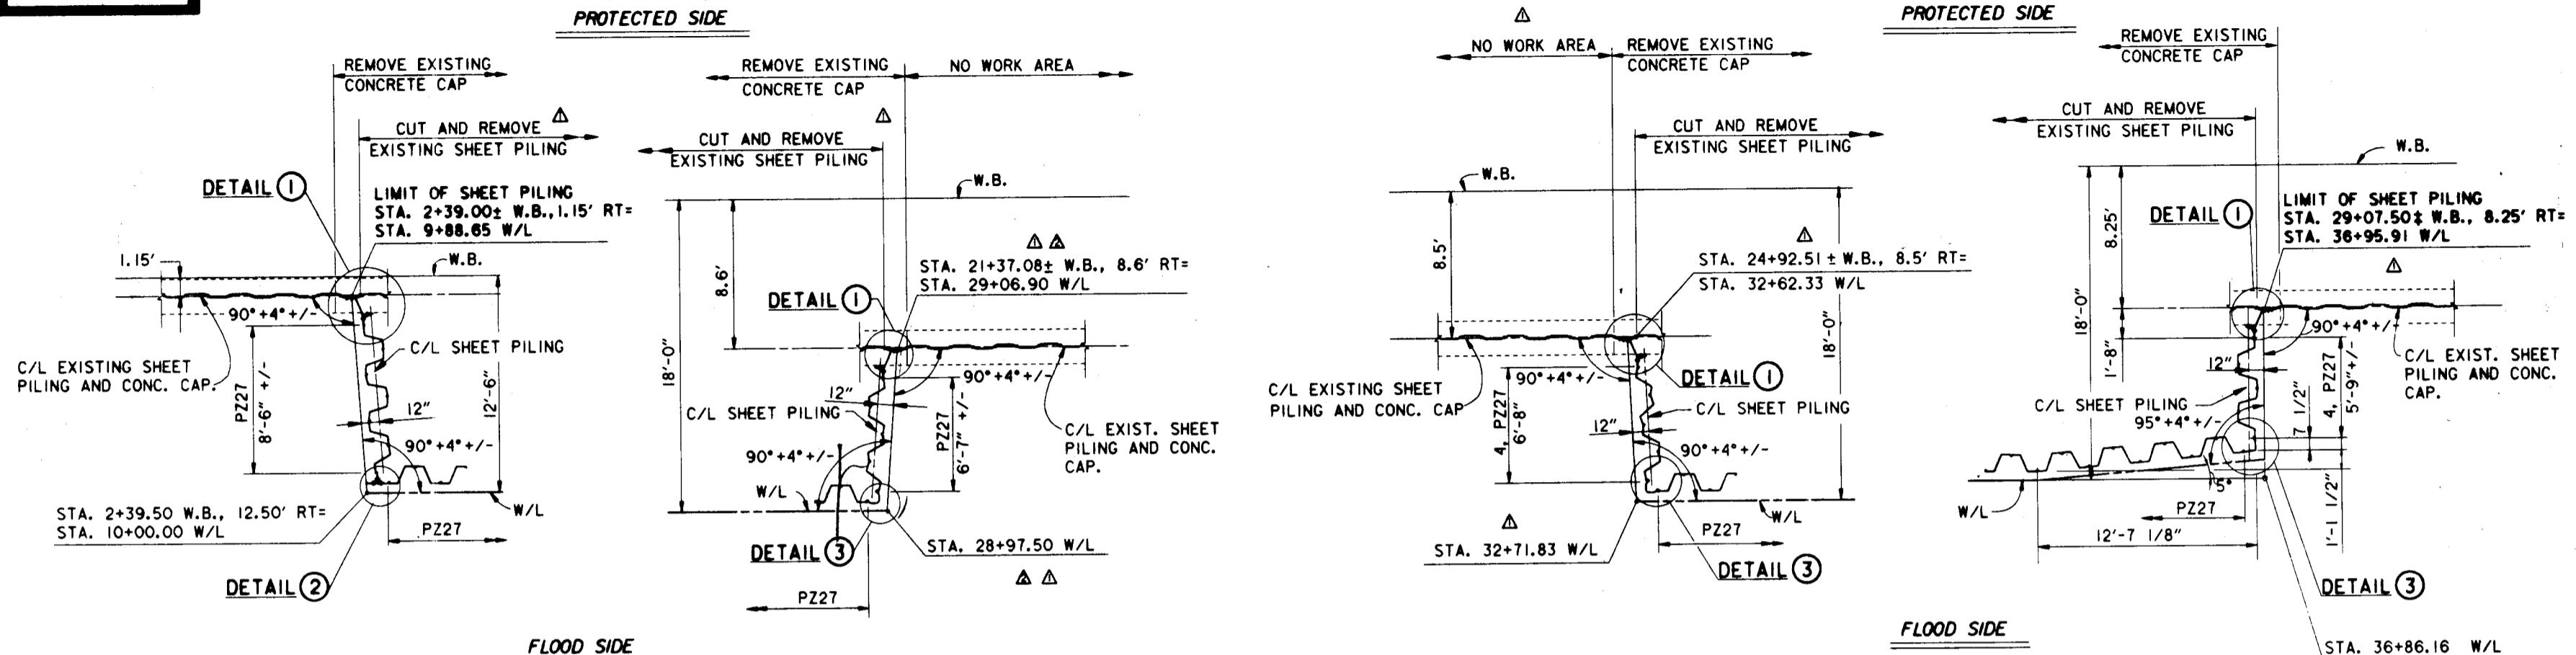

CONNECTIONS TO EXISTING FLOODWALL

SCALE: 1/4" = 1'-0"


NOTE:
FOR GENERAL NOTES, SEE DWG.2.

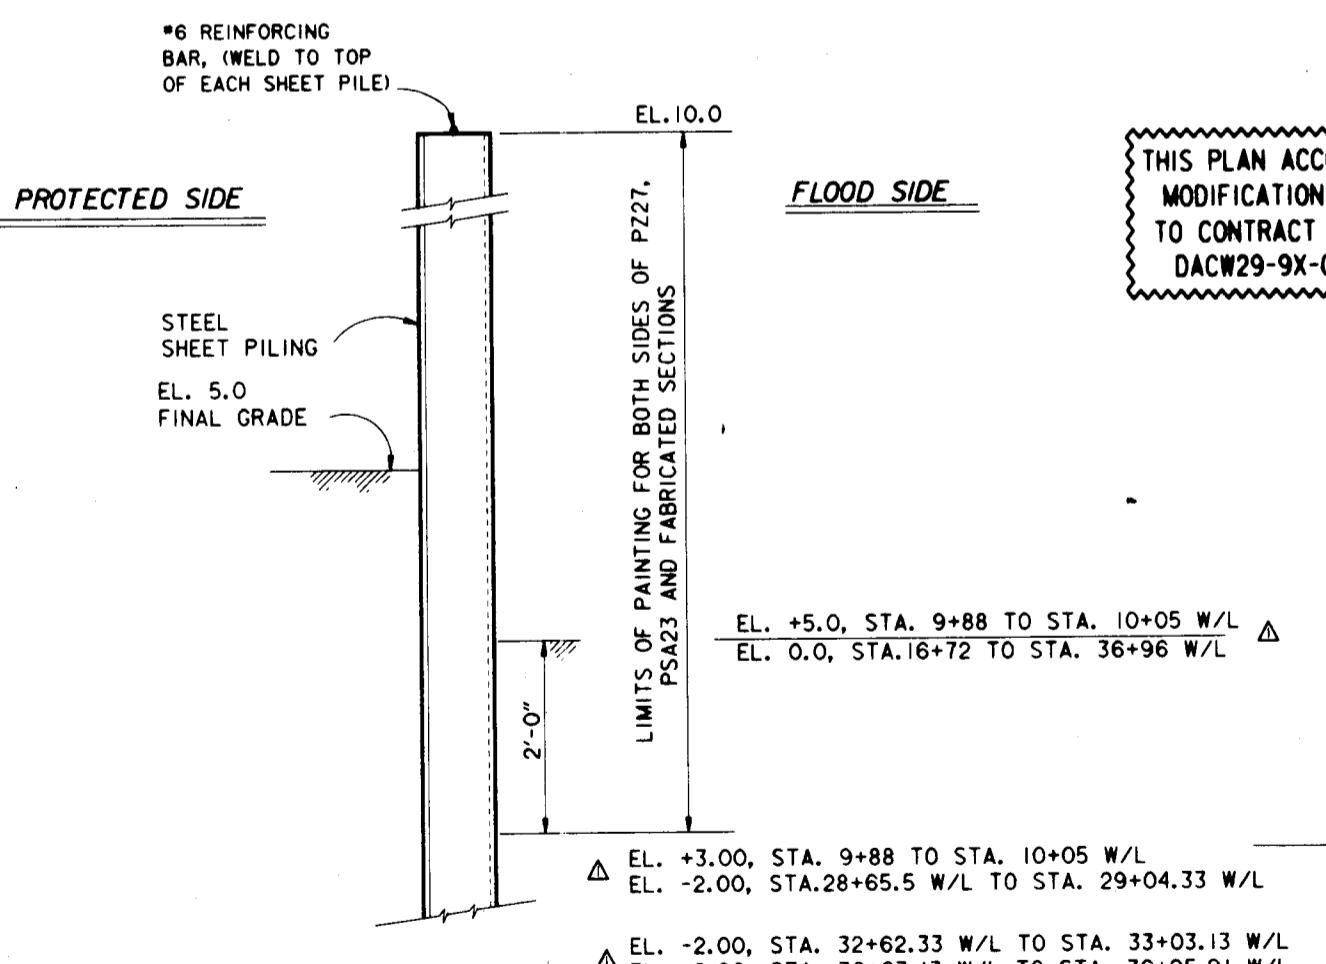


PAINTING AND CORROSION PROTECTION DETAIL

I-TYPE WALL UNCAPPED

SCALE: 1"=1'-0"

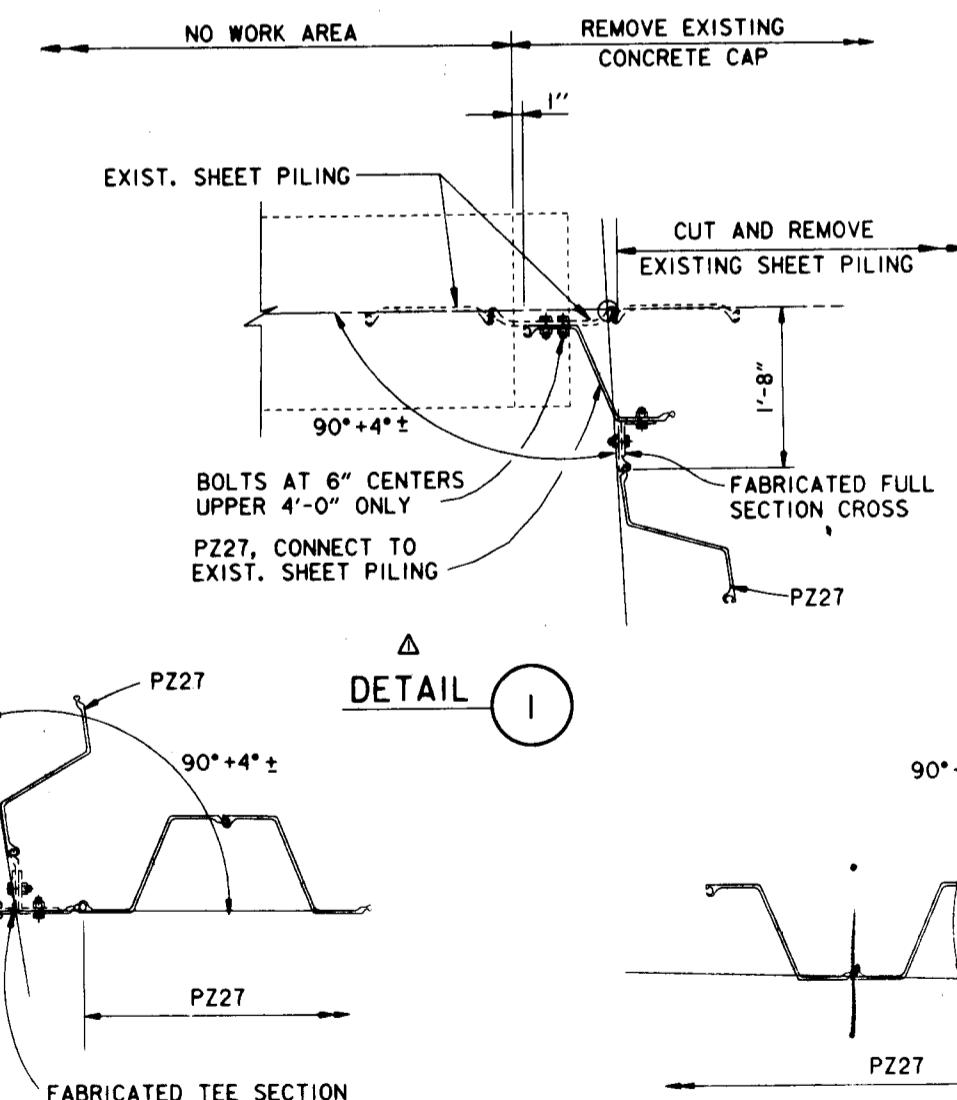

DETAIL 2

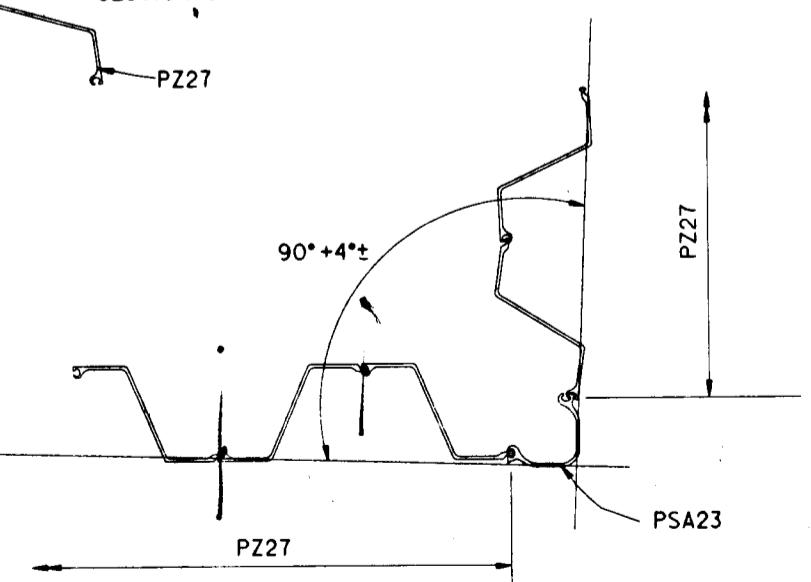


DETAIL 3

CONNECTION DETAILS


SCALE: 1"=1'-0"

REVISED LIMITS OF I-WALL, MOD. NO. 3		11-5-93	J.A.R.
GENERAL REVISIONS, AMENDMENT NO. 1.		5-11-93	M.D.
SYMBOL	DESCRIPTION	DATE APPROVED	
REVISIONS			
U.S. ARMY ENGINEER DISTRICT, NEW ORLEANS			
CORPS OF ENGINEERS			
NEW ORLEANS, LOUISIANA			
BOARD OF LEVEE COMMISSIONERS		DESIGN ENGINEERING, INC.	
NEW ORLEANS, LOUISIANA		3330 W. ESPLANADE AVE. S.	
		METAIRIE, LOUISIANA 70002	
LAKE PONTCHARTRAIN, LA. AND VICINITY			
HIGH LEVEL PLAN			
NEW ORLEANS LAKEFRONT LEVEE			
WEST OF I.H.N.C.			
ORLEANS AVE. CANAL FLOOD PROTECTION IMPROVEMENT			
PHASE II-D (WEST SIDE) B/I STA.2+39.00 TO STA.29+07.50			
ORLEANS PARISH, LOUISIANA			
CONNECTIONS TO EXIST. WALL AND MISC. DETAILS			
DESIGNED BY: M.B.SHUKLA	DATE: FEB., 1993	PLOT SCALE: 48	PLOT DATE: MAY 1993
DRAWN BY: K.C.REID	CHECKED BY: T.M.SMITH	FILE NO. H-4-40205	
SUBMITTED BY: DESIGN ENGINEERING, INC.	SOLICITATION NO. DAWC29-93-B-0042		
DESIGN ENGINEER	Dwg. 14 of 24		

Safety Is a Part
of Your Contract

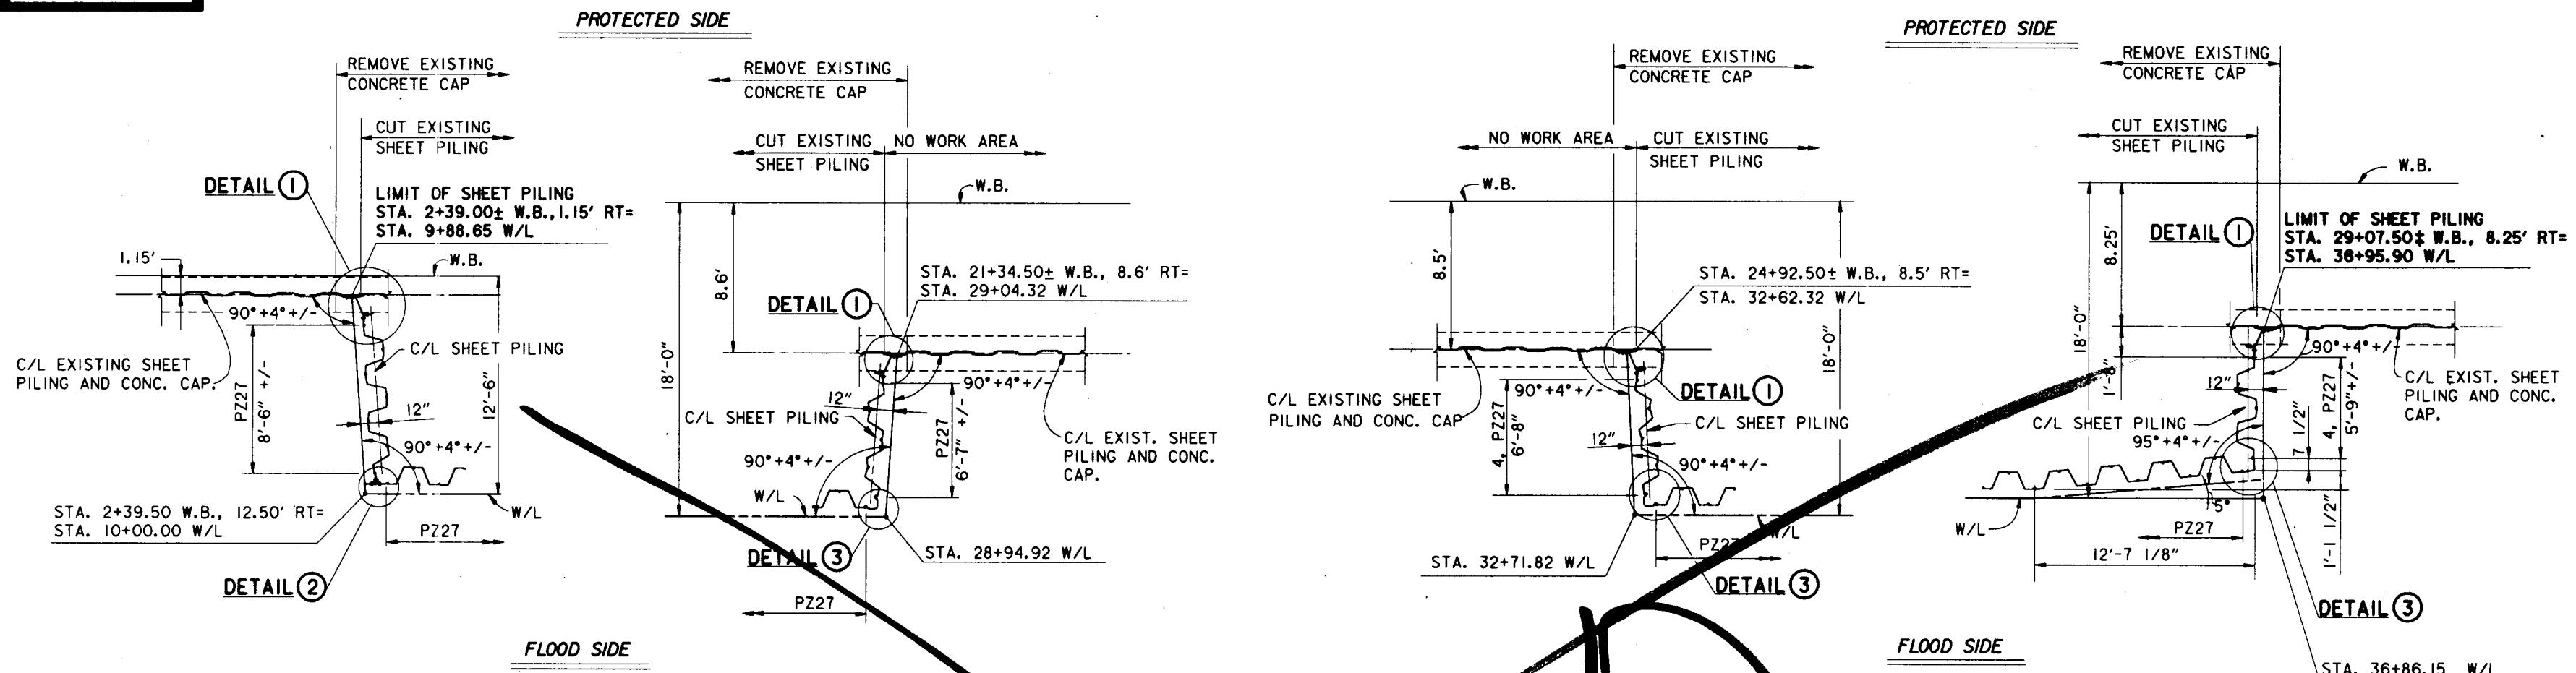


NOTE:
FOR GENERAL NOTES, SEE DWG. 2.

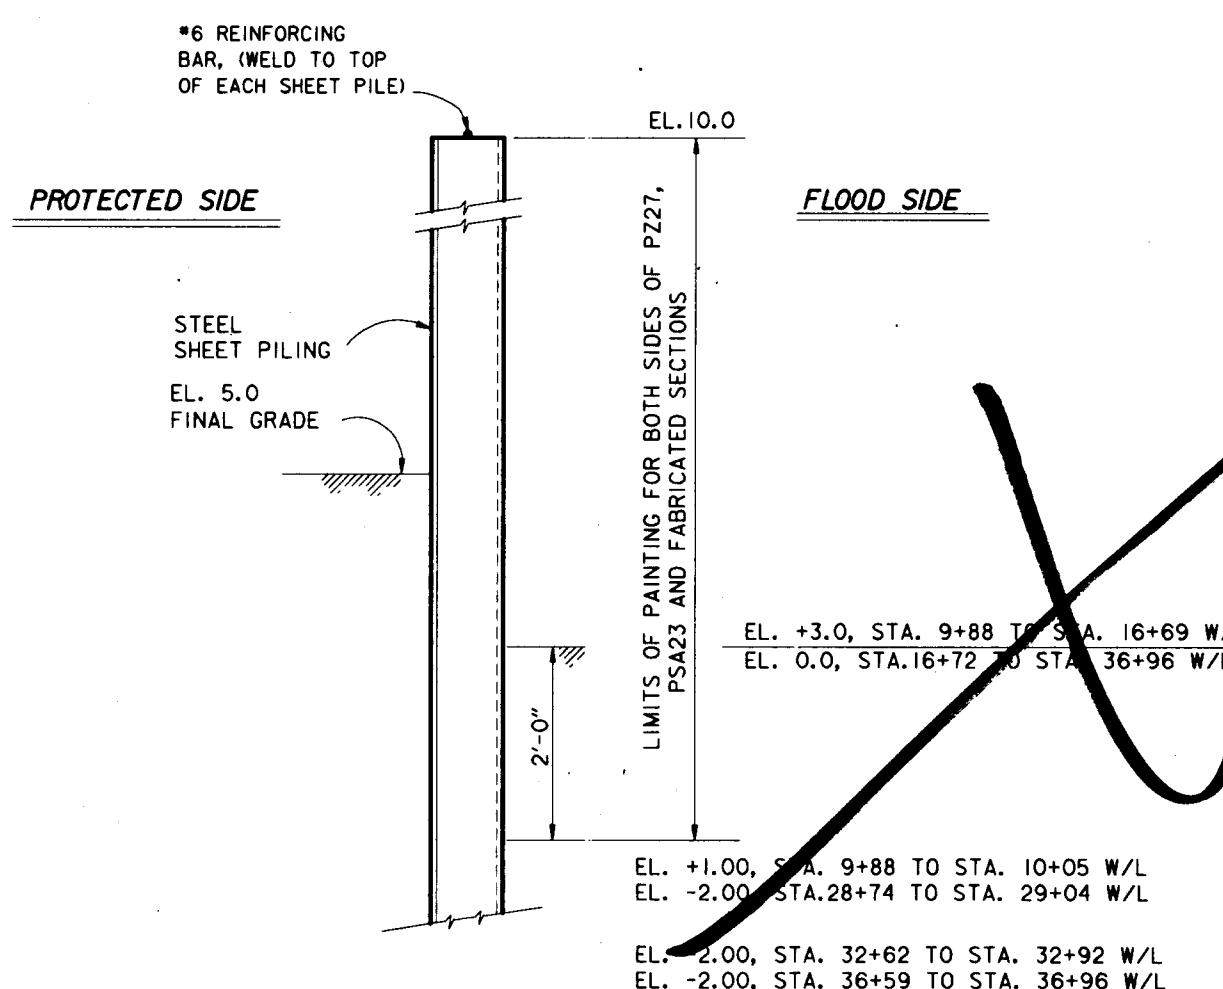

PAINTING AND
CORROSION PROTECTION DETAIL

I-TYPE WALL UNCAPPED

SCALE: 1"=1'-0"

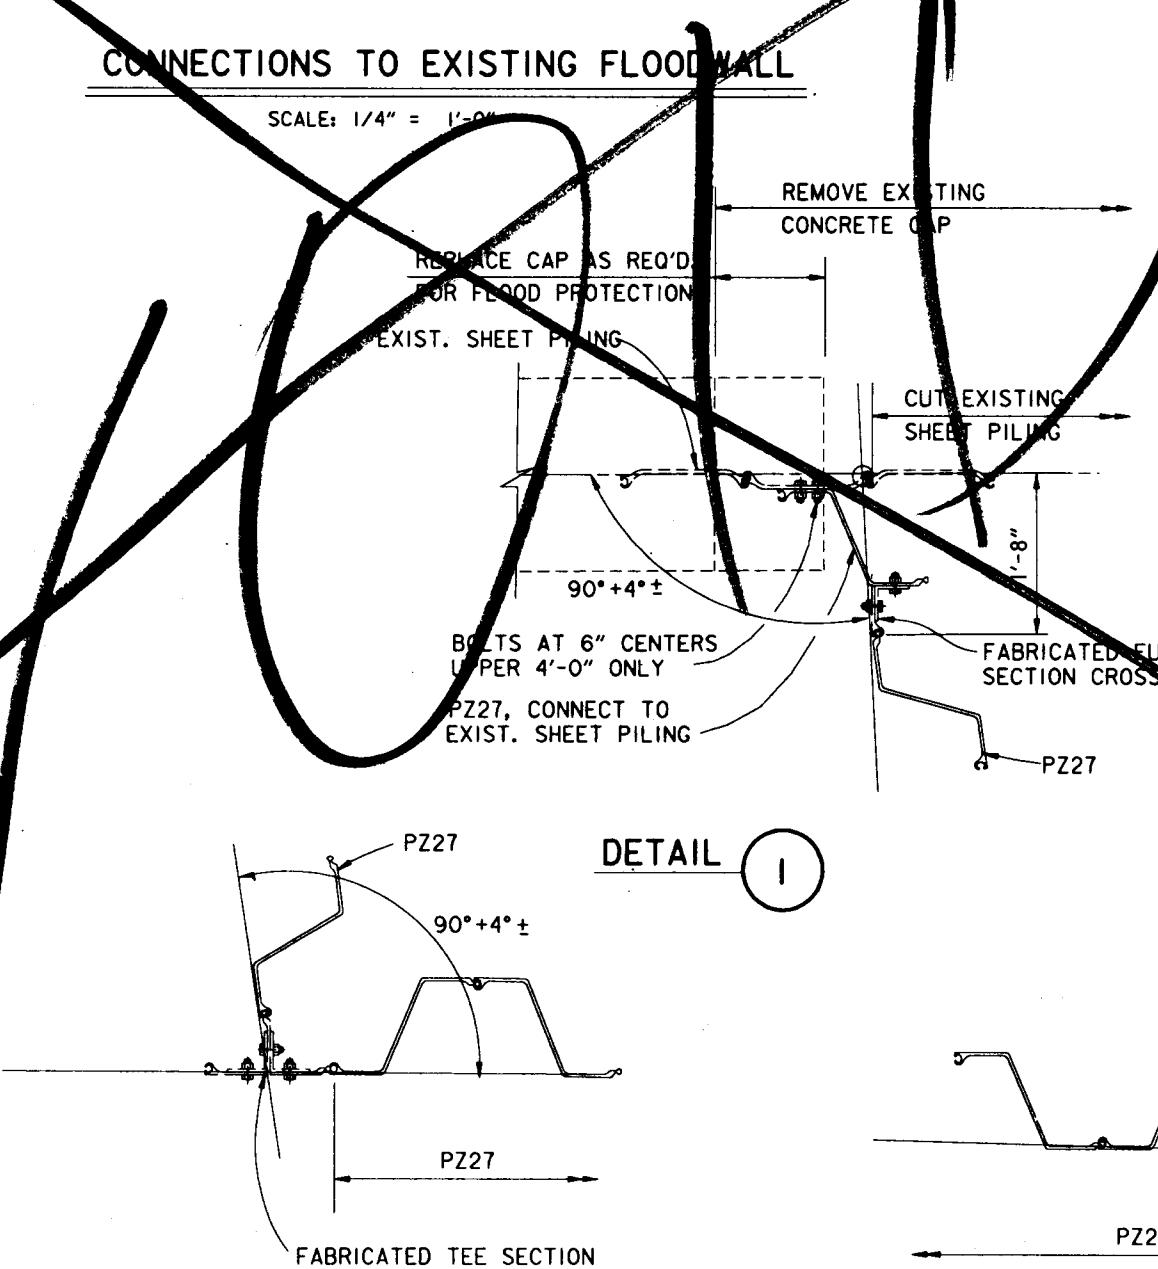


DETAIL 2

CONNECTION DETAILS


SCALE: 1"=1'-0"

DETAIL 3

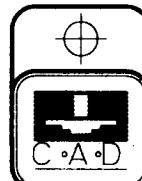

SYMBOL	DESCRIPTION	DATE	APPROVED
REVISIONS			
	U.S. ARMY ENGINEER DISTRICT, NEW ORLEANS CORPS OF ENGINEERS NEW ORLEANS, LOUISIANA		
BOARD OF LEVEE COMMISSIONERS NEW ORLEANS, LOUISIANA	DESIGN ENGINEERING, INC. 3330 W. ESPALANADE AVE. S. METairie, LOUISIANA 70002		
LAKE PONTCHARTRAIN LA. AND VICINITY HIGH LEVEL PLAN			
NEW ORLEANS LAKEFRONT LEVEE WEST OF I.H.N.C. ORLEANS AVE. CANAL FLOOD PROTECTION IMPROVEMENT PHASE II-D (WEST SIDE): B/L STA. 2+39.00 TO STA. 29+07.50 ORLEANS PARISH, LOUISIANA			
CONNECTIONS TO EXIST. WALL AND MISC. DETAILS			
DESIGNED BY: M.B.SHUKLA DRAWN BY: K.C.REID CHECKED BY: T.M.SMITH SUBMITTED BY: DESIGN ENGINEERING, INC. DESIGN ENGINEER	DATE: FEB., 1993 PLOT SCALE: 48 CADD FILE: II-D14 SOLICITATION NO.: DACW29-93-B-0042 DWG. 14 OF 24	PLOT DATE: MARCH 1993 FILE NO.: H-4-40205	


Safety is a Part
of Your Contract

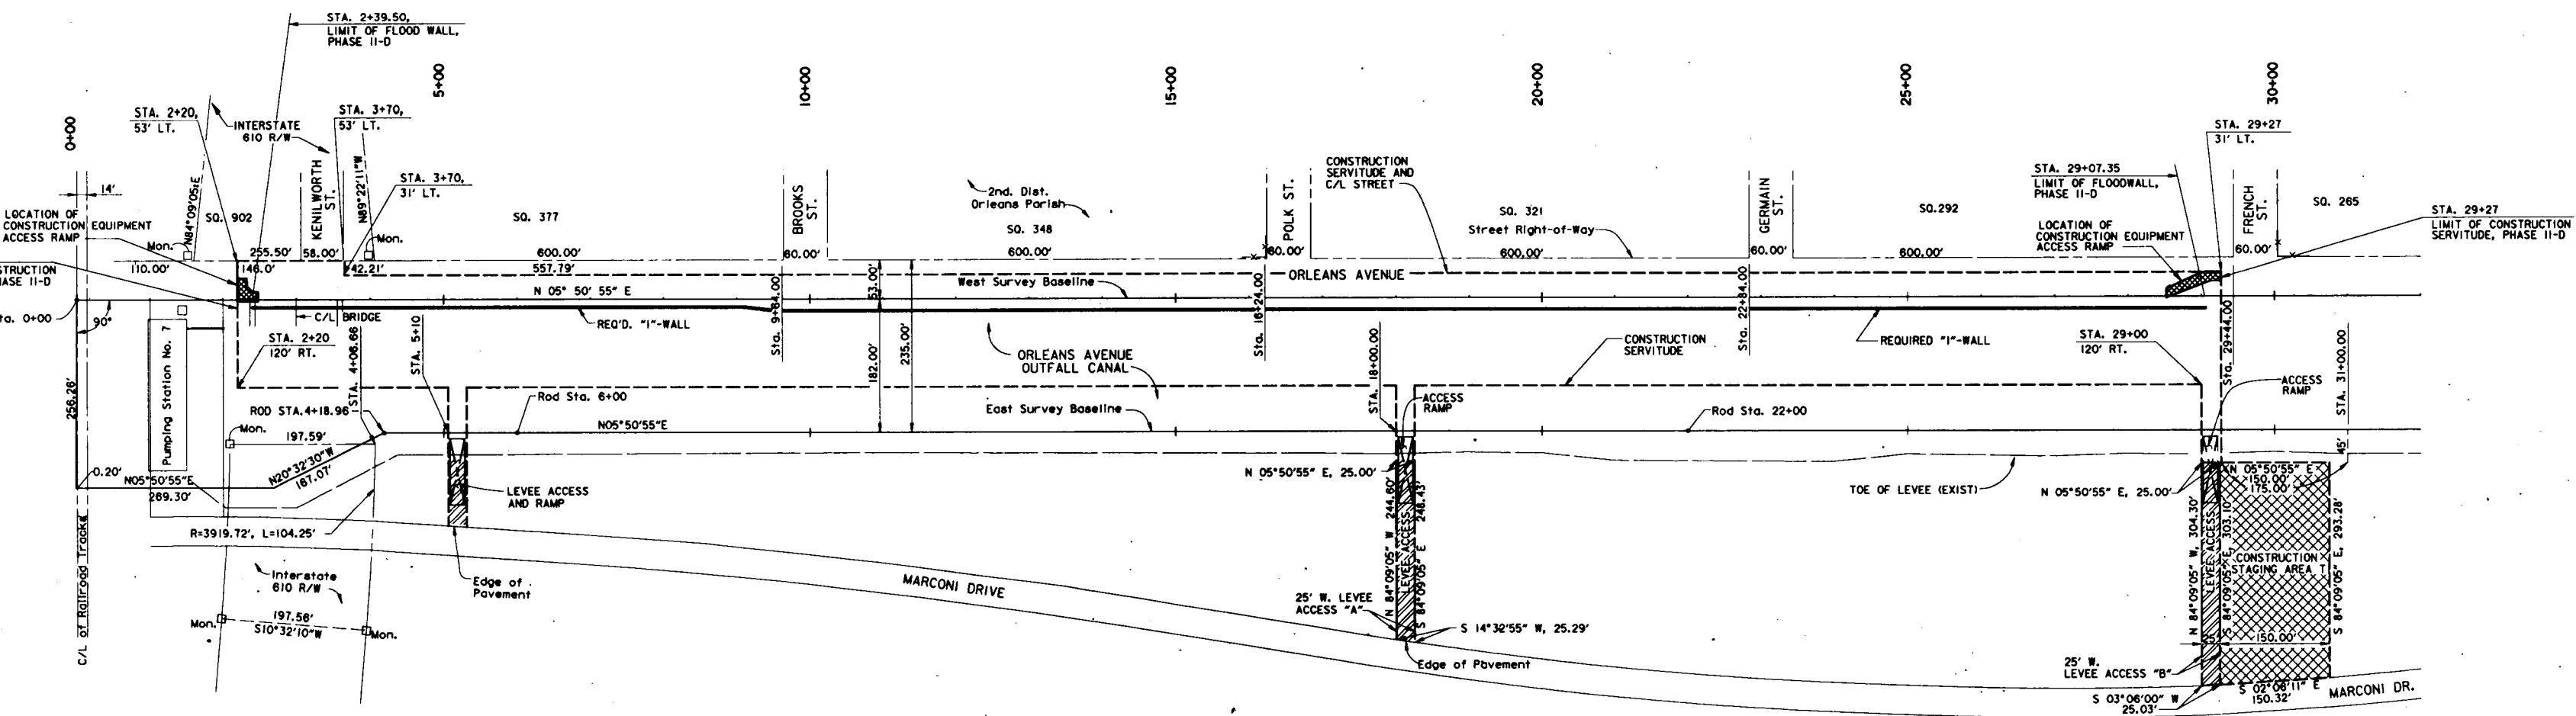

PLAN


SCALE: 1" = 100'

NOTE:
ALL "STA" CALL OUTS REFER TO WEST SURVEY BASELINE (W.B.) OR
EAST SURVEY BASELINE (E.B.). THEY ARE EQUAL.

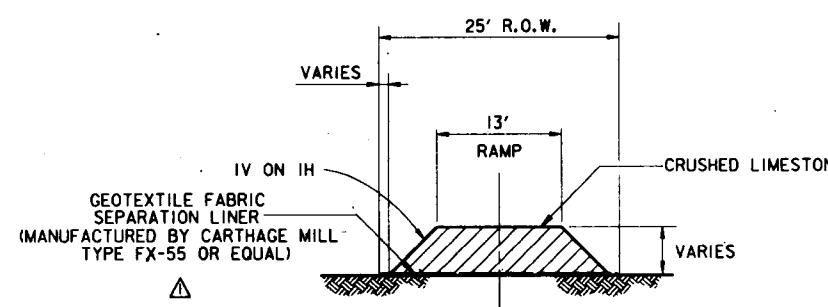

SECTION A

SCALE: 1"=10'

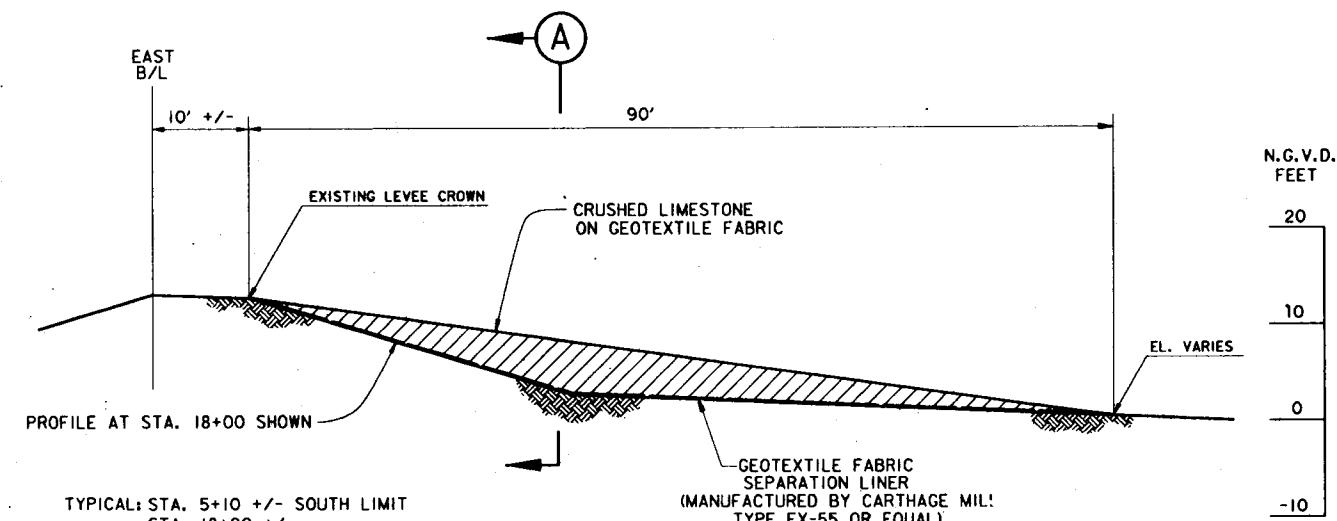

ACCESS RAMP DETAIL

SCALE: 1" = 10'

NOTES:

- EXISTING TREES IN THE WAY OF STAGING AREAS AND LEVEE ACCESS SHALL BE REMOVED BY CONTRACTOR. TREES ALONG MARCONI DRIVE IN THE WAY OF STAGING AREAS AND LEVEE ACCESS SHALL BE TRIMMED AS REQUIRED BY THE CONTRACTOR. THESE TREES MAY BE REMOVED ONLY IF APPROVED BY THE COR. SEE C2B-4.6.3.
- AREAS USED FOR CONSTRUCTION STAGING SHALL BE RESTORED TO EXISTING PROFILES AND FERTILIZED AND SEDED AFTER UTILIZATION IS COMPLETED.
- LEVEE AREAS USED FOR ACCESS RAMPS SHALL BE RESTORED TO ORIGINAL DESIGN SECTION AND FERTILIZED AND SEDED AFTER RAMP MATERIAL IS REMOVED.
- THE CONTRACTOR SHALL PROVIDE, ERECT, AND MAINTAIN A TEMPORARY SAFETY FENCE AROUND THE CONSTRUCTION STAGING AREAS AND LEVEE ACCESS WHICH ARE USED. SEE H-9 g.

SCALE: 1" = 100'

10' 0 100' 200' 300' 400'

SCALE: 1" = 10'

10' 0 10' 20' 30' 40'

△	CHANGED TYPE GEOTEXTILE FABRIC, AMENDMENT NO. 1.	5-11-93	M.D.
SYMBOL	DESCRIPTION	DATE	APPROVED

△	U.S. ARMY ENGINEER DISTRICT, NEW ORLEANS CORPS OF ENGINEERS NEW ORLEANS, LOUISIANA	DESIGN ENGINEERING, INC. 3320 W. ESPLANADE AVE. S. METairie, LOUISIANA 70002
LAKE PONTCHARTRAIN, LA. AND VICINITY HIGH LEVEL PLAN	BOARD OF LEVEE COMMISSIONERS NEW ORLEANS LEVEE DISTRICT NEW ORLEANS, LOUISIANA	DESIGN ENGINEERING, INC. 3320 W. ESPLANADE AVE. S. METairie, LOUISIANA 70002

LAKE PONTCHARTRAIN, LA. AND VICINITY
HIGH LEVEL PLAN

NEW ORLEANS LAKEFRONT LEVEE

WEST OF I.H.N.C.

ORLEANS AVE. CANAL FLOOD PROTECTION IMPROVEMENT

PHASE II-D (WEST SIDE: B/L STA. 2+39.00 TO STA. 29+07.50)

ORLEANS PARISH, LOUISIANA

RIGHTS-OF-WAY AND STAGING AREA

DESIGNED BY: T.M.SMITH DATE: FEB., 1993 PLOT SCALE: 100' PLOT DATE: MAY 1993


DRAWN BY: G.F.GETCHER CHECKED BY: T.M.SMITH FILE NO. rII-D15

SUBMITTED BY: DESIGN ENGINEERING, INC. SOLICITATION NO. H-4-40205

DESIGN ENGINEER: DAWC29-93-B-0042 DNG. 15 OF 24



Safety is a Part
of Your Contract

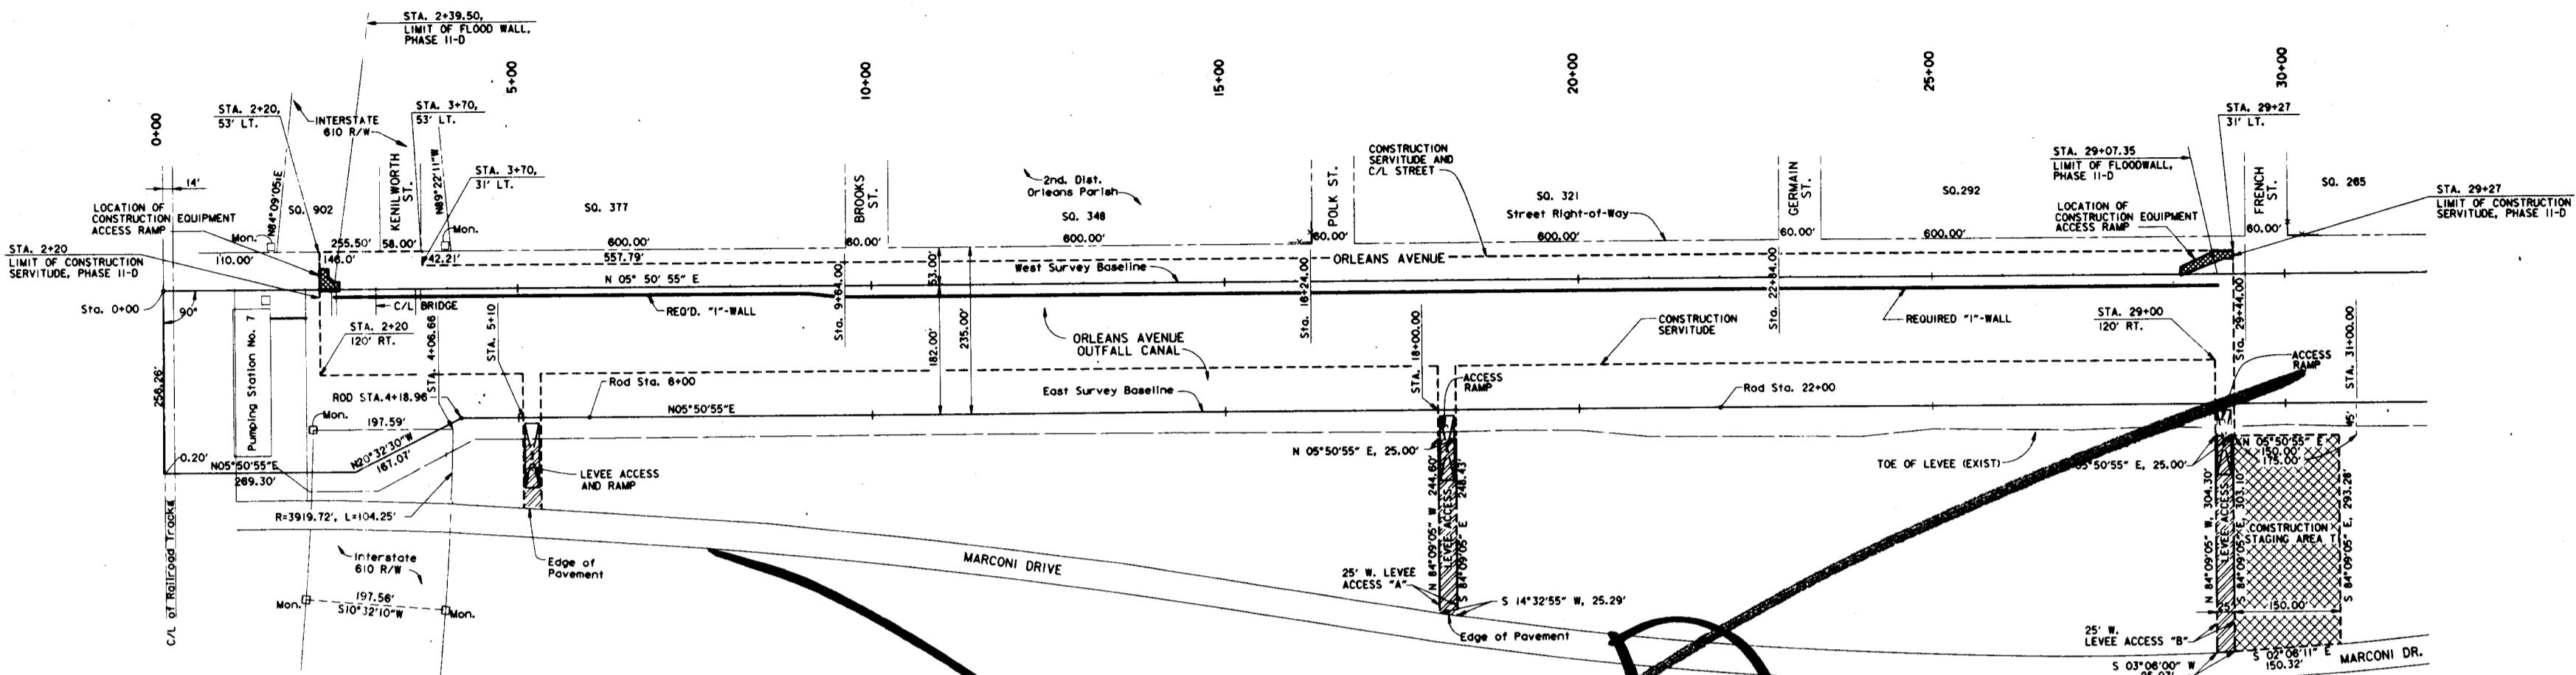


PLAN

SCALE: 1" = 100'


NOTE:
ALL "STA" CALL OUTS REFER TO WEST SURVEY BASELINE (W.B.) OR
EAST SURVEY BASELINE (E.B.). THEY ARE EQUAL.

LEGEND

- RIGHT-OF-WAY
- - - CONSTRUCTION SERVITUDE LIMITS
- BASELINE

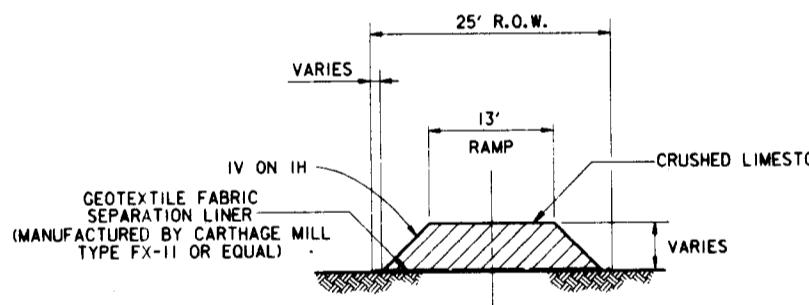

SECTION A
SCALE: 1"=10'

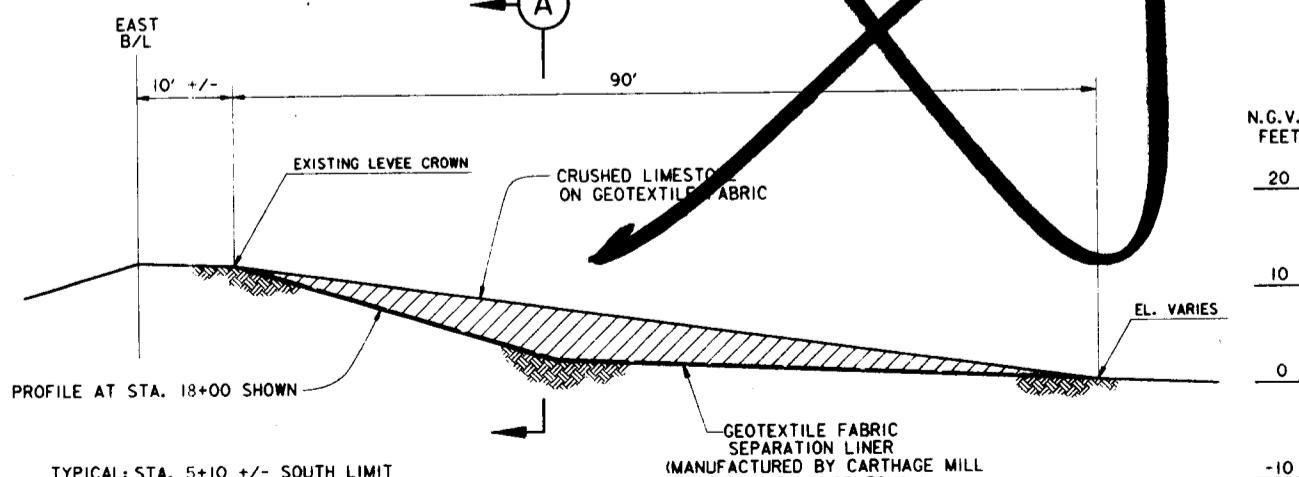


TYPICAL: STA. 5+10 +/- SOUTH LIMIT
STA. 18+00 +/-
STA. 29+00 +/-

ACCESS RAMP DETAIL



SCALE: 1" = 10'

- NOTES:
1. EXISTING TREES IN THE WAY OF STAGING AREAS AND LEVEE ACCESS SHALL BE REMOVED BY CONTRACTOR. TREES ALONG MARCONI DRIVE IN THE WAY OF STAGING AREAS AND LEVEE ACCESS SHALL BE TRIMMED AS REQUIRED BY THE CONTRACTOR. THESE TREES MAY BE REMOVED ONLY IF APPROVED BY THE CO. SEE C2B-4.6.3.
 2. AREAS USED FOR CONSTRUCTION STAGING SHALL BE RESTORED TO EXISTING PROFILES AND FERTILIZED AND SEDED AFTER UTILIZATION IS COMPLETED.
 3. LEVEE AREAS USED FOR ACCESS RAMPS SHALL BE RESTORED TO ORIGINAL DESIGN SECTION AND FERTILIZED AND SEDED AFTER RAMP MATERIAL IS REMOVED.
 4. THE CONTRACTOR SHALL PROVIDE, ERECT, AND MAINTAIN A TEMPORARY SAFETY FENCE AROUND THE CONSTRUCTION STAGING AREAS AND LEVEE ACCESS WHICH ARE USED. SEE H-9 g.

SCALE: 1" = 100'

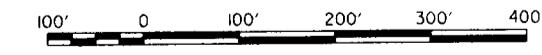

SCALE: 1" = 10'

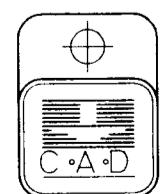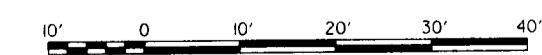

REVISIONS			
SYMBOL	DESCRIPTION	DATE	APPROVED
	U.S. ARMY ENGINEER DISTRICT, NEW ORLEANS CORPS OF ENGINEERS NEW ORLEANS, LOUISIANA		
BOARD OF LEVEE COMMISSIONERS NEW ORLEANS LEVEE DISTRICT NEW ORLEANS, LOUISIANA		DESIGN ENGINEERING, INC. 3330 W. ESPLANADE AVE. S. METAIRIE, LOUISIANA 70002	
LAKE PONTCHARTRAIN, LA. AND VICINITY HIGH LEVEL PLAN			
NEW ORLEANS LAKEFRONT LEVEE WEST OF I.H.N.C. NEW ORLEANS, LOUISIANA			
ORLEANS AVE. CANAL FLOOD PROTECTION IMPROVEMENT PHASE II-D (WEST SIDE) B/L STA.2+39.00 TO STA.29+07.50 ORLEANS PARISH, LOUISIANA			
RIGHTS-OF-WAY AND STAGING AREA			
DESIGNED BY: T.M.SMITH DRAWN BY: G.F.GETCHER CHECKED BY: T.M.SMITH SUBMITTED BY: DESIGN ENGINEERING, INC. DESIGN ENGINEER	DATE: FEB., 1993 CADD FILE: r11-d15 SOLICITATION NO. DACW29-93-B-0042	SCALE: 100' PLOT SCALE: 100' FILE NO. H-4-40205 Dwg. 15 of 24	PLOT DATE: MARCH 1993

**Safety is a Part
of Your Contract**

W.B. STA.4+36, 23'LT.

LOG OF BORING
EUSTIS ENGINEERING COMPANY
SOIL AND FOUNDATION CONSULTANTS
METAIRIE, LA.

Name of Project: Orleans Levee District, Orleans Avenue Outfall Canal
OLB Project No. 2048-0304, New Orleans, Louisiana
For: The Board of Levee Commissioners of the Levee District, New Orleans, La.
Design Engineering, Inc., Metairie, Louisiana

Boring No. 2 Soil Technician: George Hardee Date: 21 September 1985
Ground Elev. -1.70 Datum NGVD Gr. Water Depth

Sample No.	SAMPLE DEPTH		DEPTH SPLIT SPOON TEST		VISUAL CLASSIFICATION	* STANDARD PENETRATION TEST
	From	To	From	To		
	0.0	0.3	0.0	0.5	Asphalt w/gravel	
	0.3	1.0				
1	1.0	2.5	1.0	2.5	Dense tan fine sand	11 36
2	5.5	7.0	2.5	7.0	Wood	2 7
3	8.5	9.0	7.0	9.0	Medium stiff gray clay w/sand	
					pockets & roots	
4	9	10.5	9.0		Dense gray fine sand	2 30
5	11.5	13.0	13.5		Ditto	8 45
6	14.0	15.5	13.5	17.0	Very dense gray fine sand	12 50+9"
7	18.5	20.0	17.0	22.0	Dense gray fine sand	5 31
8	23.5	25.0	22.0		Very dense gray fine sand	11 50+8"
9	28.5	30.0			Ditto	14 50+9"
10	33.5	35.0	37.0		Ditto	14 50+8"
11	38.5	40.0	37.0	41.0		9 18
12	43.0	44.0	41.0	44.0	Medium stiff gray sandy clay w/ shells & large sand pockets	
13	44.0	45.5	44.0	48.5	Medium dense gray silty sand	1 25
14	48.5	50.0	48.5	50.0	Medium stiff gray clay w/sand	4 3
					pockets & shells	

W.B. STA.9+00, 23'LT.

LOG OF BORING
EUSTIS ENGINEERING COMPANY
SOIL AND FOUNDATION CONSULTANTS
METAIRIE, LA.

Name of Project: Orleans Levee District, Orleans Avenue Outfall Canal
OLB Project No. 2048-0304, New Orleans, Louisiana
For: The Board of Levee Commissioners of the Levee District, New Orleans, La.
Design Engineering, Inc., Metairie, Louisiana

Boring No. 4 Soil Technician: R. Elkins Date: 21 September 1985
Ground Elev. -1.54 Datum NGVD Gr. Water Depth See Text

Sample No.	SAMPLE DEPTH		DEPTH SPLIT SPOON TEST		VISUAL CLASSIFICATION	* STANDARD PENETRATION TEST
	From	To	From	To		
	0.0	0.5	0.0	0.5	Asphalt	
	0.5	1.0				
1	1.5	2.5	1.0	2.5	Medium compact tan & white sand & shells	10 30
2	5.5	7.0	2.5	7.0	Medium stiff gray & tan clay	2 7
3	8.5	9.0	7.0	9.0	w/micellaneous fill	
4	9	10.5	9.0		Soft gray clay w/organic matter & roots	2 30
5	11.5	13.0	13.5		Ditto	8 45
6	14.0	15.5	13.5	17.0	Very dense gray fine sand	12 50+9"
7	18.5	20.0	17.0	22.0	Dense gray fine sand	5 31
8	23.5	25.0	22.0		Very dense gray fine sand	11 50+8"
9	28.5	30.0			Ditto	14 50+8"
10	33.5	35.0	37.0		Ditto	14 50+8"
11	38.5	40.0	37.0	41.0		9 18
12	43.0	44.0	41.0	44.0	Medium dense gray sandy clay w/ shells & large sand pockets	
13	44.0	45.5	44.0	48.5	Medium dense gray silty sand	1 25
14	48.5	50.0	48.5	50.0	Very soft gray clay w/sand layers	2 4

W.B. STA.14+17, 4'LT.

LOG OF BORING
EUSTIS ENGINEERING COMPANY
SOIL AND FOUNDATION CONSULTANTS
METAIRIE, LA.

Name of Project: Orleans Levee District, Orleans Avenue Outfall Canal
OLB Project No. 2048-0304, New Orleans, Louisiana
For: The Board of Levee Commissioners of the Levee District, New Orleans, La.
Design Engineering, Inc., Metairie, Louisiana

Boring No. 6 Soil Technician: A. J. Mayoux Date: 21 September 1985
Ground Elev. -1.54 Datum NGVD Gr. Water Depth

Sample No.	SAMPLE DEPTH		DEPTH SPLIT SPOON TEST		VISUAL CLASSIFICATION	* STANDARD PENETRATION TEST
	From	To	From	To		
1	2.0	3.0	0.0	5.0	Medium stiff brown & gray clay w/ silty sand pockets	10 30
2	5.0	6.0	4.5	8.0	Very soft to soft brown clay w/ humus & sand pockets	1 2
3	8.0	9.0	8.0	10.0	Very soft dark gray clay w/organic matter & sand pockets	
4	11.0	12.0	10.0		Very soft brown & gray clay w/ organic matter	
5	15.0	16.0	18.0		Very soft brown & gray clay w/ humus & roots	
6	18.5	20.0	18.0		Medium dense gray sand	2 16
7	21.0	22.5			Ditto	5 18
8	23.5	25.0			Medium dense gray sand w/shell fragments	3 15
9	26.0	27.5			Ditto	3 15
10	28.5	30.0			Ditto	4 22
11	33.5	35.0			Ditto	6 18
12	38.5	40.0			Ditto	6 20
13	43.5	45.0	48.0		Ditto	8 22
14	48.5	50.0	48.0	50.0	Soft gray w/sand pockets & shell fragments	3 3

W.B. STA.18+67, 24.5'LT.

LOG OF BORING
EUSTIS ENGINEERING COMPANY
SOIL AND FOUNDATION CONSULTANTS
METAIRIE, LA.


Name of Project: Orleans Levee District, Orleans Avenue Outfall Canal
OLB Project No. 2048-0304, New Orleans, Louisiana
For: The Board of Levee Commissioners of the Levee District, New Orleans, La.
Design Engineering, Inc., Metairie, Louisiana

Boring No. 8 Soil Technician: R. Elkins Date: 19 September 1985
Ground Elev. -1.17 Datum NGVD Gr. Water Depth See Text

Sample No.	SAMPLE DEPTH		DEPTH SPLIT SPOON TEST		VISUAL CLASSIFICATION	* STANDARD PENETRATION TEST
	From	To	From	To		
1	2.0	3.0	0.0	5.0	Medium stiff brown & gray clay w/ sand shell fragments & gravel (III)	10 30
2	5.0	6.0	5.0	8.0	Soft brown & gray fissured clay w/ sand pockets	
3	8.0	9.0	8.0	10.0	Soft dark gray clay w/sand pockets & organic matter	10 30
4	11.0	12.0	11.0	14.0	Humus & miscellaneous fill	14 50+8"
5	12.0	15.0	12.0	18.5	Ditto	26 50+5
6	18.5	20.0	18.5	23.5	Dense gray sand	10 35
7	23.5	25.0	23.5		Very dense gray sand w/shell fragments	19 50+10"
8	28.5	30.0			Ditto	25 50+8"
9	33.5	35.0	36.5		Ditto	15 50+8"
10	38.5	40.0	38.5	43.5	Medium dense gray sand w/clay layers	5 16
11	43.5	45.0	43.5	48.5	Dense gray sand	12 41
12	48.5	50.0	48.5	50.0	Very soft gray clay w/sand layers	2 4

NOTE:
THE APPROXIMATE LOCATION OF THE SOIL BORINGS
ARE SHOWN ON DWGS. 5 THROUGH 8.

REMARKS _____

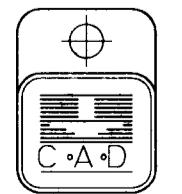


U.S. ARMY ENGINEER DISTRICT, NEW ORLEANS CORPS OF ENGINEERS NEW ORLEANS, LOUISIANA
BOARD OF LEVEE COMMISSIONERS NEW ORLEANS LEVEE DISTRICT NEW ORLEANS, LOUISIANA
DESIGN ENGINEERING, INC. 3330 W. ESPLANADE AVE. S. METAIRIE, LOUISIANA 70002
LAKE PONTCHARTRAIN, LA. AND VICINITY NEW ORLEANS LAKEFRONT LEVEE WEST OF I.H.N.C. NEW ORLEANS AVE. CANAL FLOOD PROTECTION IMPROVEMENT PHASE II-D (WEST SIDE) B/L STA.2+39.00 TO STA.29+07.50 ORLEANS PARISH, LOUISIANA
SOIL BORING LOGS
DESIGNED BY: EUSTIS DRAWN BY: K.C.REID CHECKED BY: T.M.SMITH SUBMITTED BY: CADD FILE: H-4-40205 Dwg. NO.: DACW29-93-B-0042 SOLICITATION NO.: H-4-4020

Safety is a Part
of Your Contract

UNIFIED SOIL CLASSIFICATION

MAJOR DIVISION	TYPE	LETTER SYMBOL	TYPICAL NAMES
COARSE - GRAINED SOILS More than half of material is larger than No. 200 sieve size.	GRAVELS More than half of coarse fraction is coarser than No. 4 sieve size.	GW GP GM GC SW SP SM SC	GRAVEL, Well Graded, gravel-sand mixtures, little or no fines GRAVEL, Poorly Graded, gravel-sand mixtures, little or no fines GRAVEL WITH FINES, (Applicable Amount of Fines) CLAYEY GRAVEL, gravel-sand-clay mixtures SAND, Well-Graded, gravelly sands SAND, Poorly-Graded, gravelly sands SANDS WITH FINES (Applicable Amount of Fines) CLAYEY SAND, sand-clay mixtures
FINE - GRAINED SOILS More than half the material is smaller than No. 200 sieve size.	SILTS AND CLAYS (Liquid Limit < 50) SILTS AND CLAYS (Liquid Limit > 50)	ML CL OL MH CH OH PT Wd SI NO SAMPLE	SILT & very fine sand, silty or clayey fine sand or clayey silt with slight plasticity LEAN CLAY, Sandy Clay, Silty Clay, of low to medium plasticity ORGANIC SILTS, and organic silty clays of low plasticity SILT, fine sandy or silty soil with high plasticity FAT CLAY, inorganic clay of high plasticity ORGANIC CLAYS of medium to high plasticity, organic silts PEAT, and other highly organic soil WOOD SHELLS
			WOOD SHELLS
			NO SAMPLE

NOTE: Soils possessing characteristics of two groups are designated by combinations of group symbols.


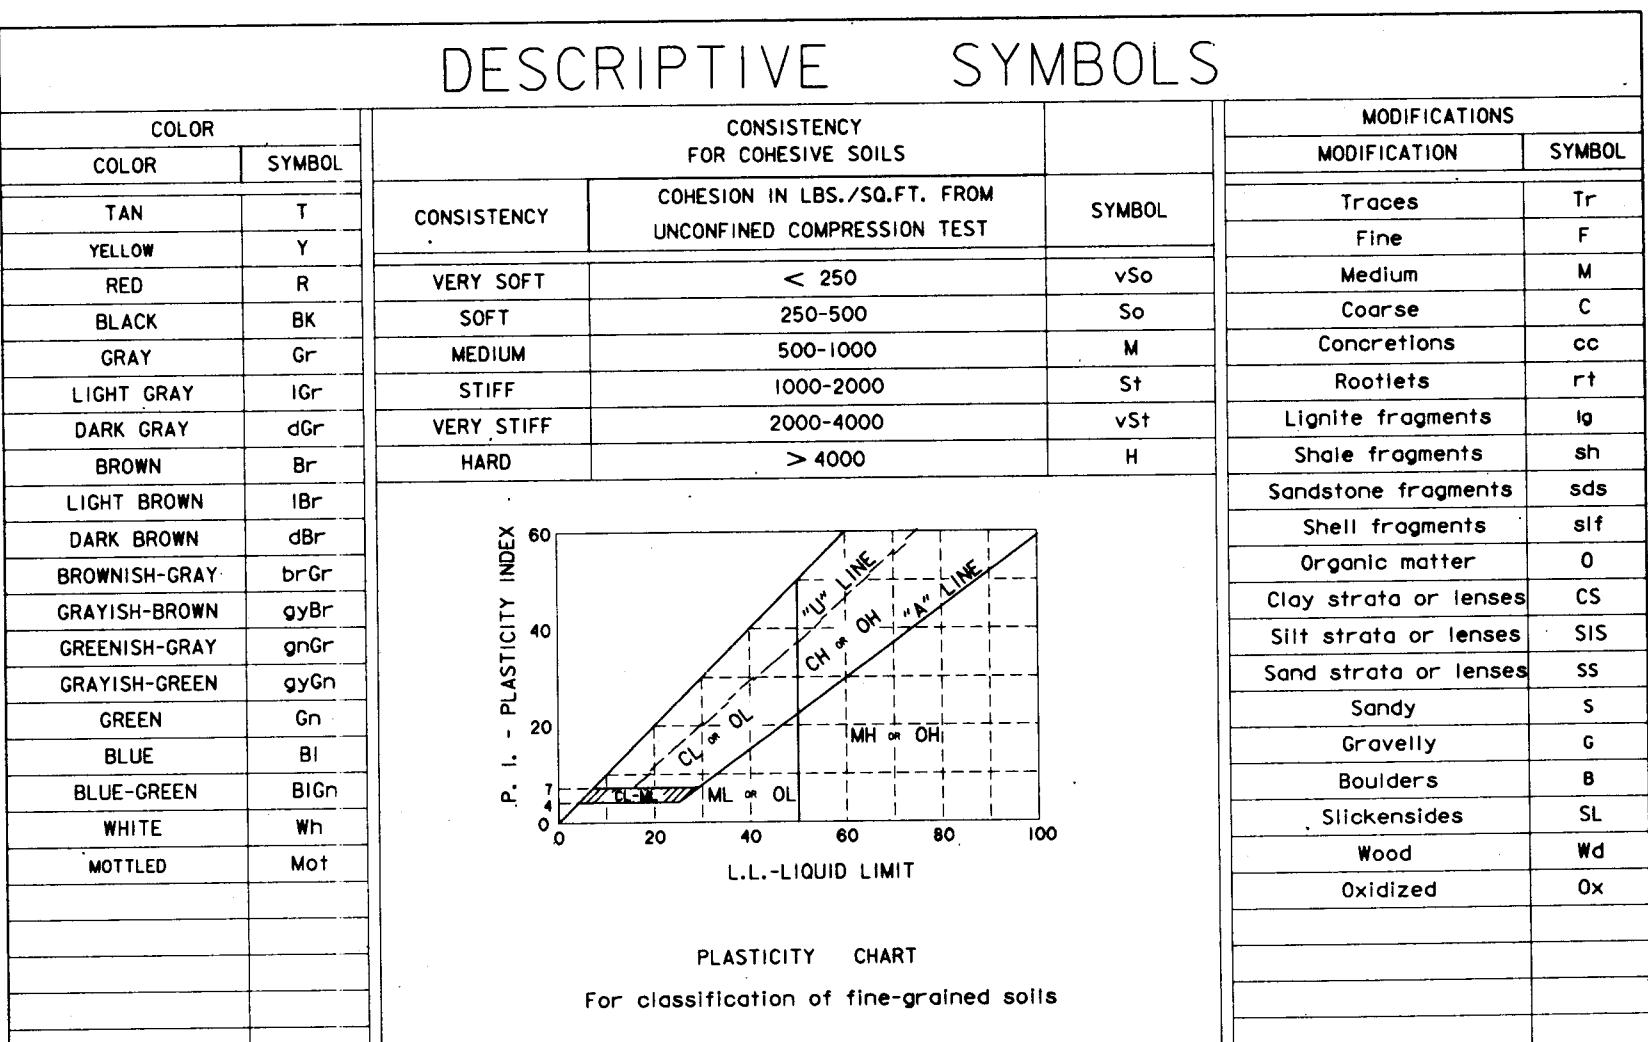


NOTES:	
FIGURES TO LEFT OF BORING UNDER COLUMN " W OR D ₁₀ "	
Are natural water contents in percent dry weight	
When underlined denotes D ₁₀ size in mm *	
FIGURES TO LEFT OF BORING UNDER COLUMNS " LL" AND " PL"	
Are liquid and plastic limits, respectively	
SYMBOLS TO LEFT OF BORING	
— Ground-water surface and date observed	
(C) Denotes location of consolidation test **	
(S) Denotes location of consolidated-drained direct shear test **	
(R) Denotes location of consolidated-undrained triaxial compression test **	
(Q) Denotes location of unconsolidated-undrained triaxial compression test **	
(T) Denotes location of sample subjected to consolidation test and each of the above three types of shear test **	
FW Denotes free water encountered in boring or sample	
FIGURES TO RIGHT OF BORING	
Are values of cohesion in lbs./sq.ft. from unconfined compression tests	
In parenthesis are driving resistances in blows per foot determined with a standard split spoon sampler (1 3/8" I.D., 2" O.D.) and a 140 lb. driving hammer with a 30" drop	
Where underlined with a solid line denotes laboratory permeability in centimeters per second of undisturbed sample	
Where underlined with a dashed line denotes laboratory permeability in centimeters per second of sample remoulded to the estimated natural void ratio.	
*The D ₁₀ size of a soil is the grain diameter in millimeters of which 10% of the soil is finer, and 90% coarser than D ₁₀ .	
**Results of these tests are available for inspection in the U.S. Army Engineer District Office, if these symbols appear beside the boring logs on the drawings.	

TYPICAL NOTES:

- While the borings are representative of subsurface conditions at their respective locations and for their respective vertical reaches, local variations characteristic of the subsurface materials of the region are anticipated and, if encountered, such variations will not be considered as differing materially within the purview of the contract clause entitled "Differing Site Conditions".
- Ground-water elevations shown on the boring logs represent ground-water surfaces encountered in such borings on the dates shown. Absence of water surface data on certain borings indicates that no ground-water data are available from the boring but does not necessarily mean that ground-water will not be encountered at the locations or within the vertical reaches of such borings.
- Consistency of cohesive soils shown on the boring logs is based on driller's log and visual examination and is approximate, except within those vertical reaches of the borings where shear strengths from unconfined compression tests are shown.
- Unless otherwise noted:
 - Undisturbed borings, indicated by the letter "U", are taken with a 5" I.D. Piston Type Sampler.
 - General type borings are taken with a 1 7/8" I.D. Tube Sampler and/or a 1 3/8" I.D. Split Spoon Sampler.

SYMBOL	DESCRIPTION	DATE	APPROVED
REVISIONS			
U.S. ARMY ENGINEER DISTRICT, NEW ORLEANS CORPS OF ENGINEERS NEW ORLEANS, LOUISIANA			
BOARD OF LEVEE COMMISSIONERS NEW ORLEANS LEVEE DISTRICT NEW ORLEANS, LOUISIANA		DESIGN ENGINEERING, INC. 3330 W. ESPLANADE AVE. S. METAIRIE, LOUISIANA 70022	
LAKE PONTCHARTRAIN, LA. AND VICINITY HIGH LEVEL PLAN			
NEW ORLEANS LAKEFRONT LEVEE WEST OF I.H.N.C. NEW ORLEANS AVE. CANAL FLOOD PROTECTION IMPROVEMENT PHASE II-D (WEST SIDE) B/L STA. 2+39.00 TO STA. 29+07.50 ORLEANS PARISH, LOUISIANA			
SOIL BORING LEGEND			
DESIGNED BY: J. RICHARDSON DRAWN BY: U.S.A.C.E. CHECKED BY: J. ROMERO SUBMITTED BY: DESIGN ENGINEERING, INC. DESIGN ENGINEER	PLOT SCALE: 1 FEB., 1993 CADD FILE: II-D16A FILE NO. H-4-40205	PLOT DATE: MARCH 1993 SUBMISSION NO. DACW29-93-B-0042	PLOT DATE: MARCH 1993 DWG. 16d OF 24

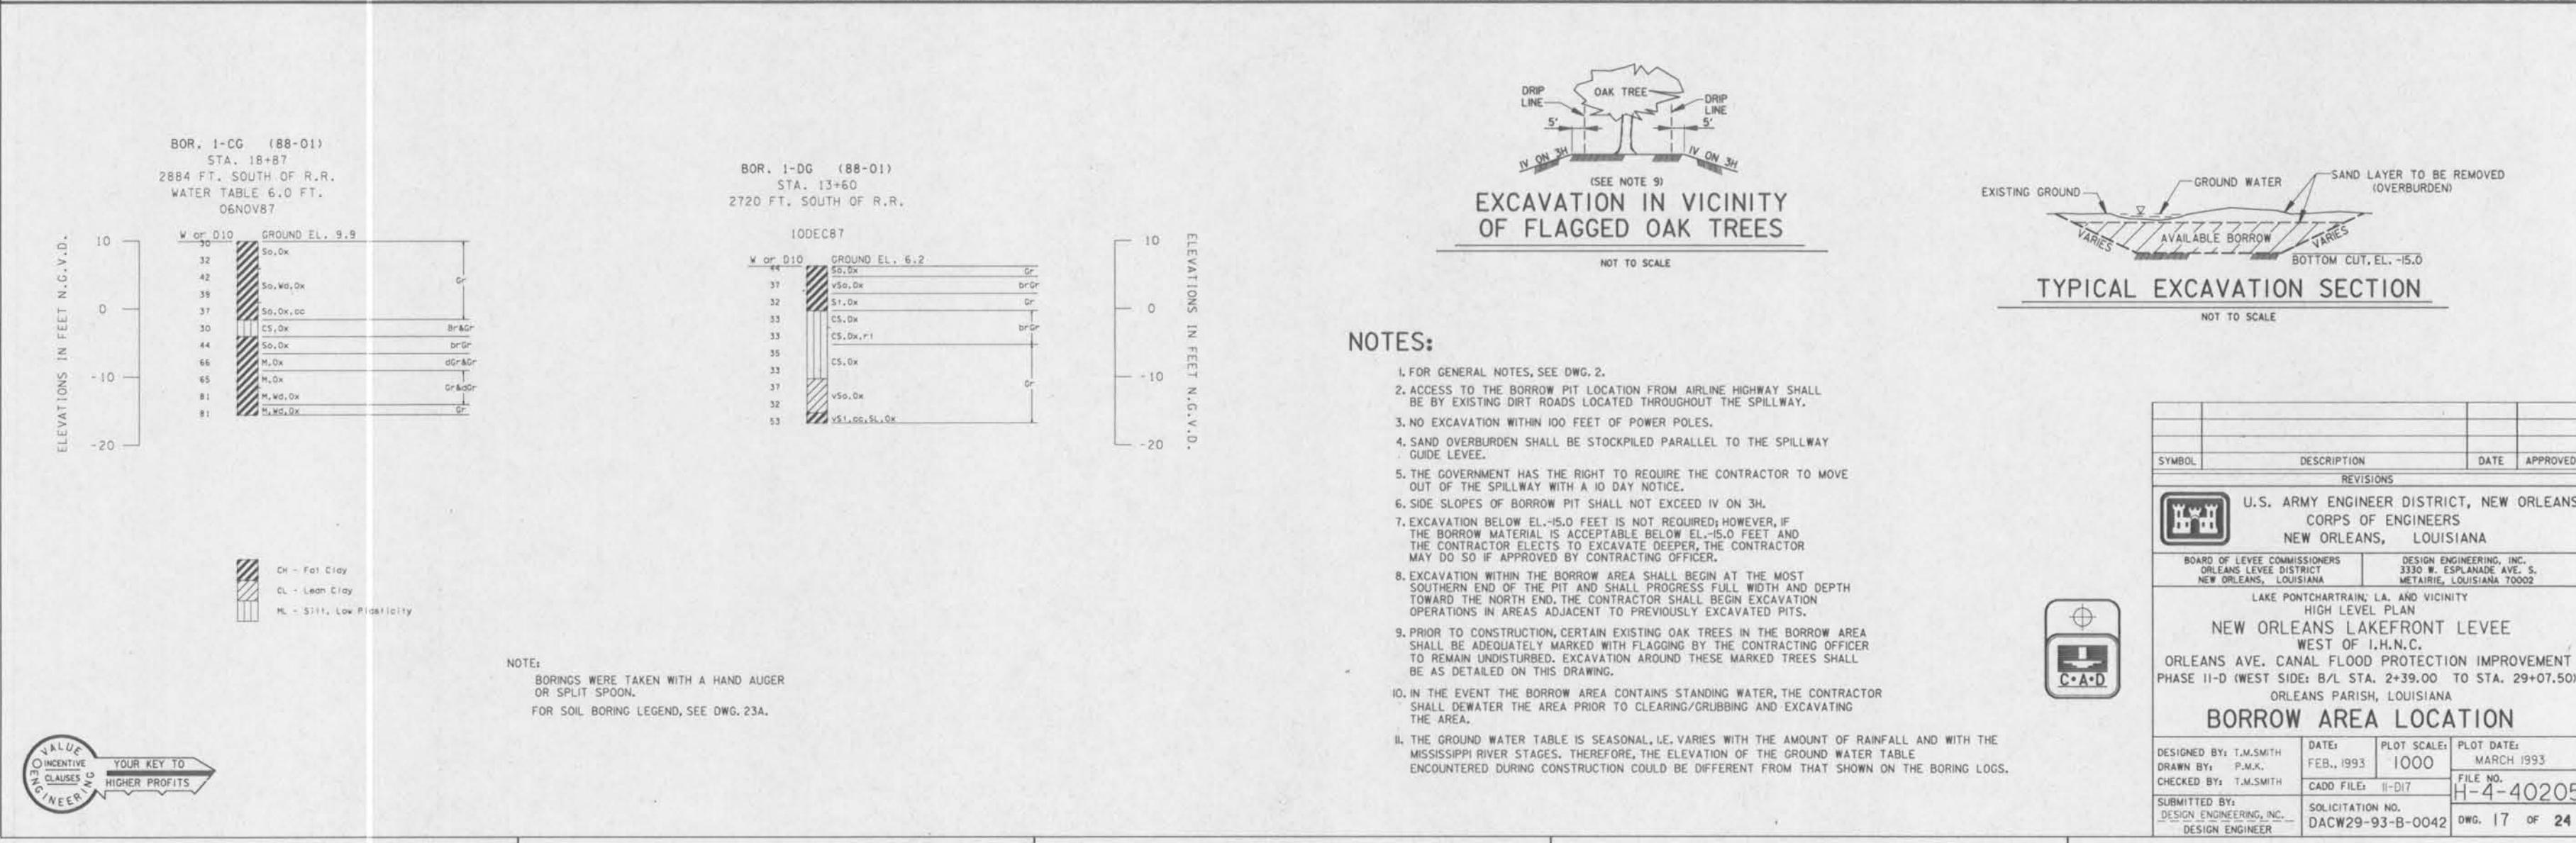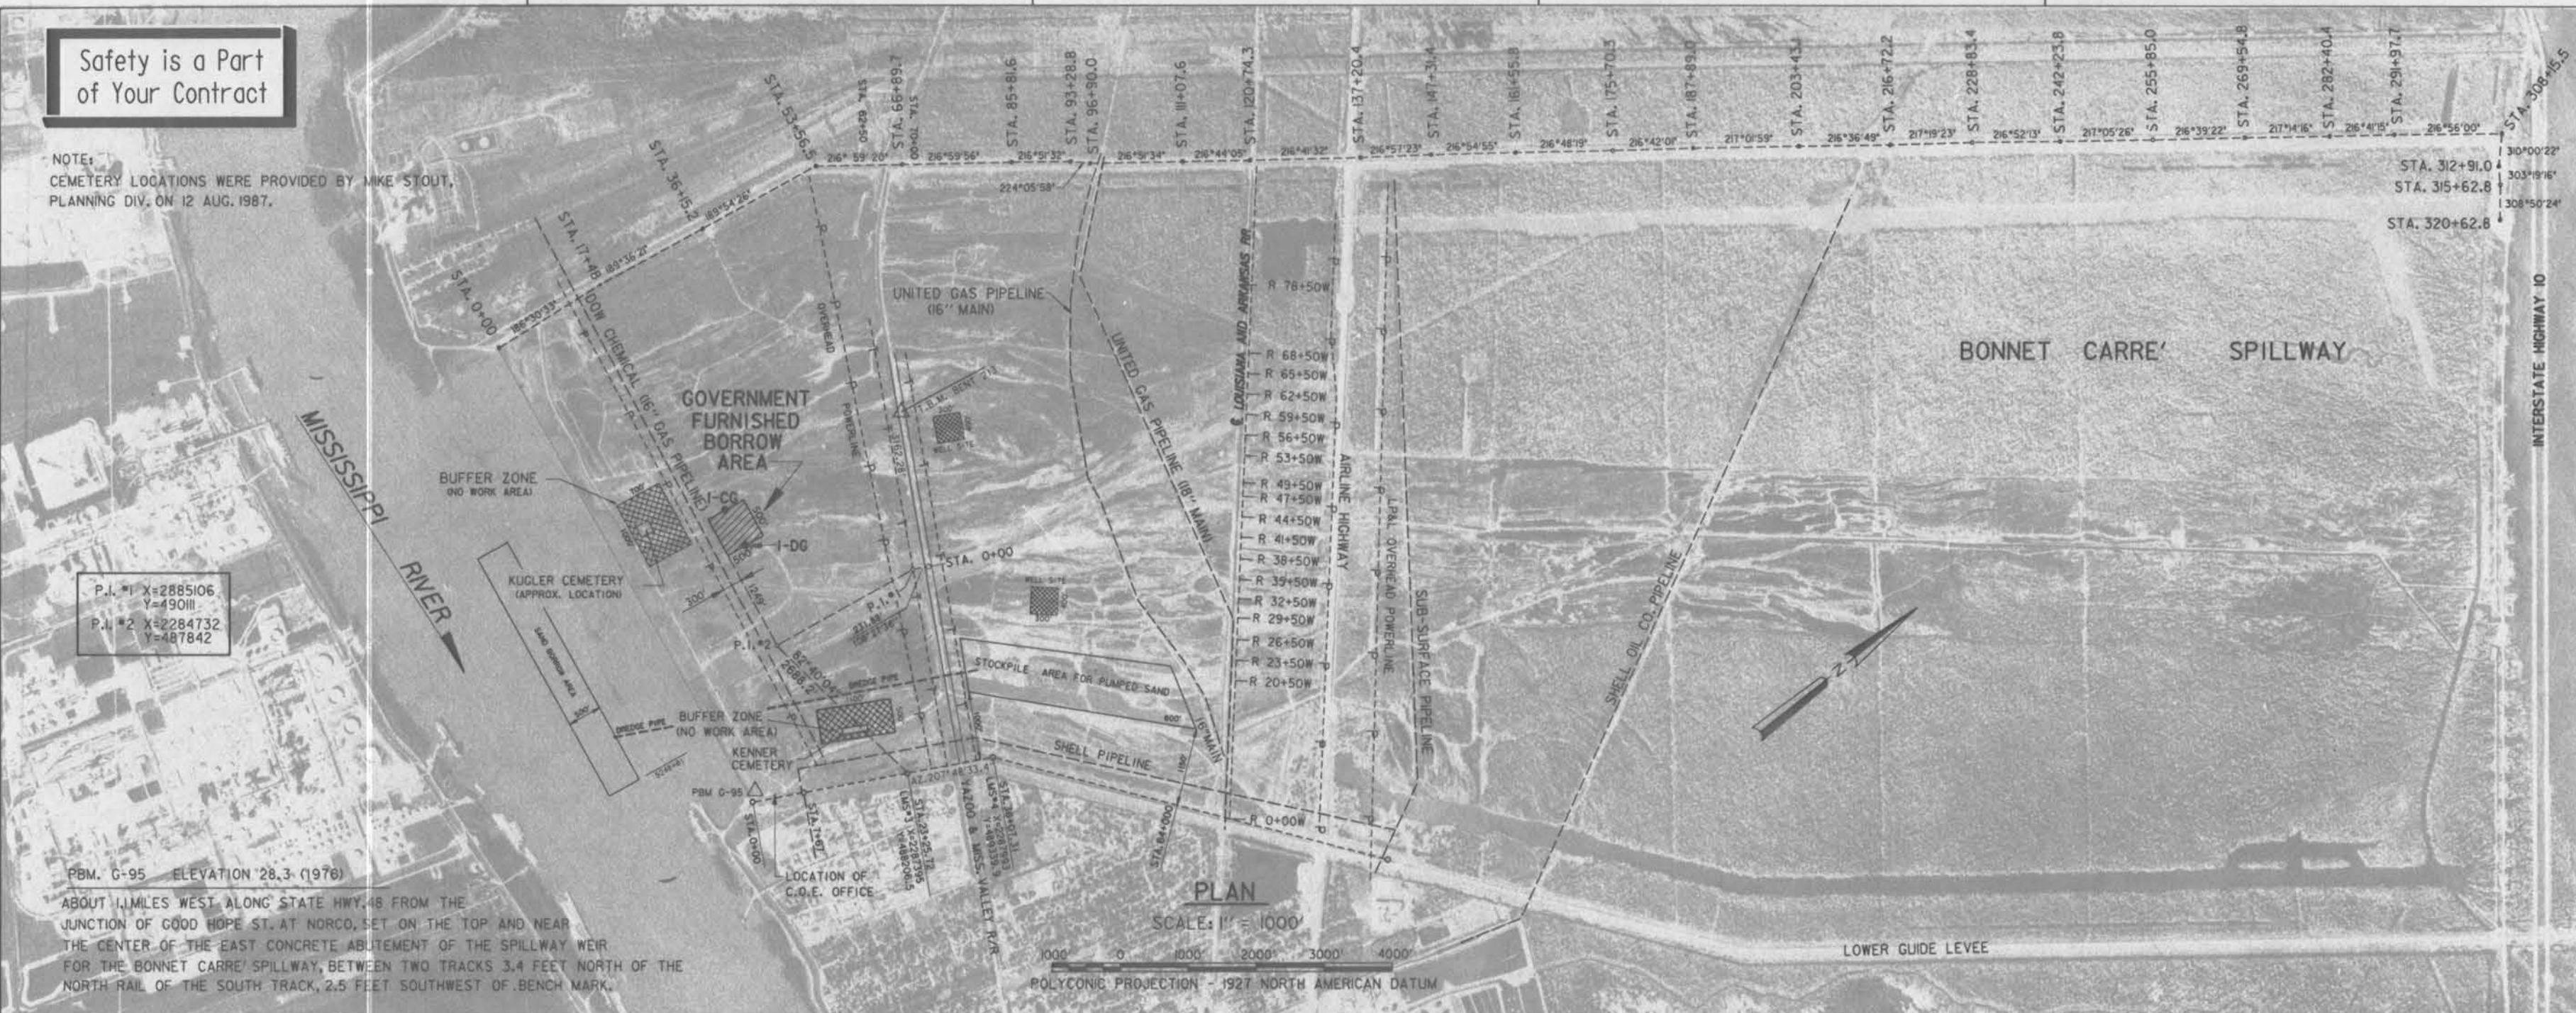

Safety is a Part
of Your Contract






5

4

3

2

1

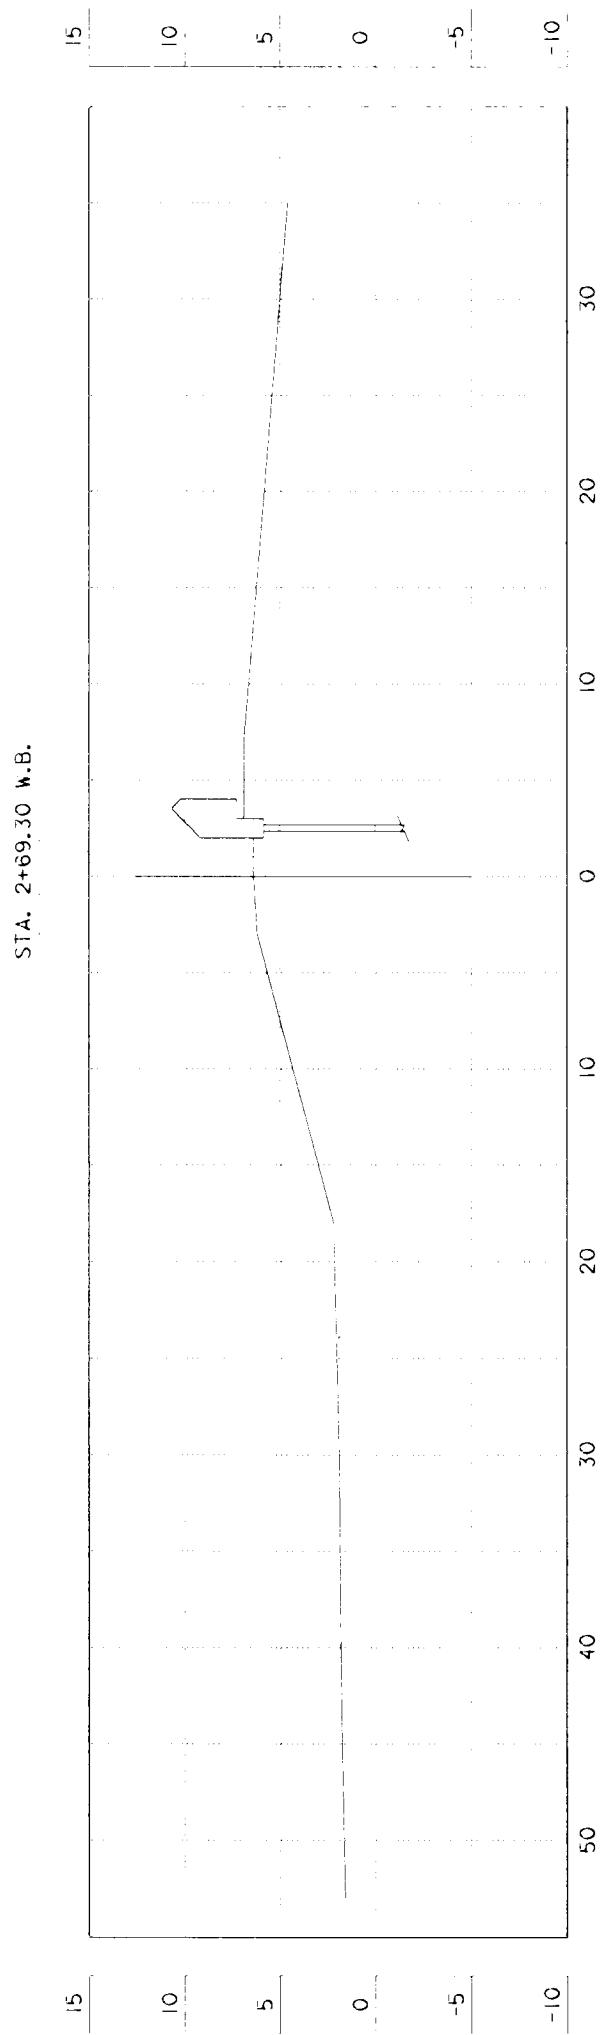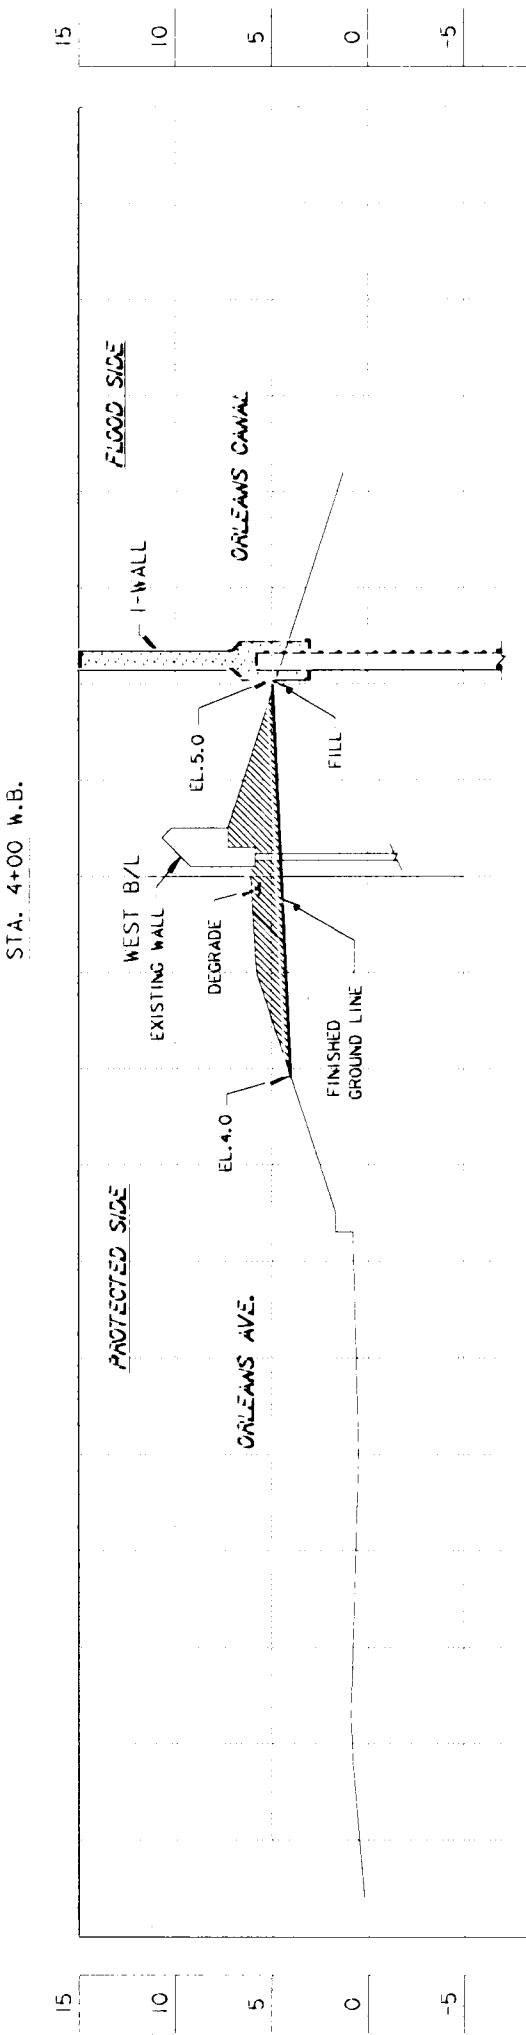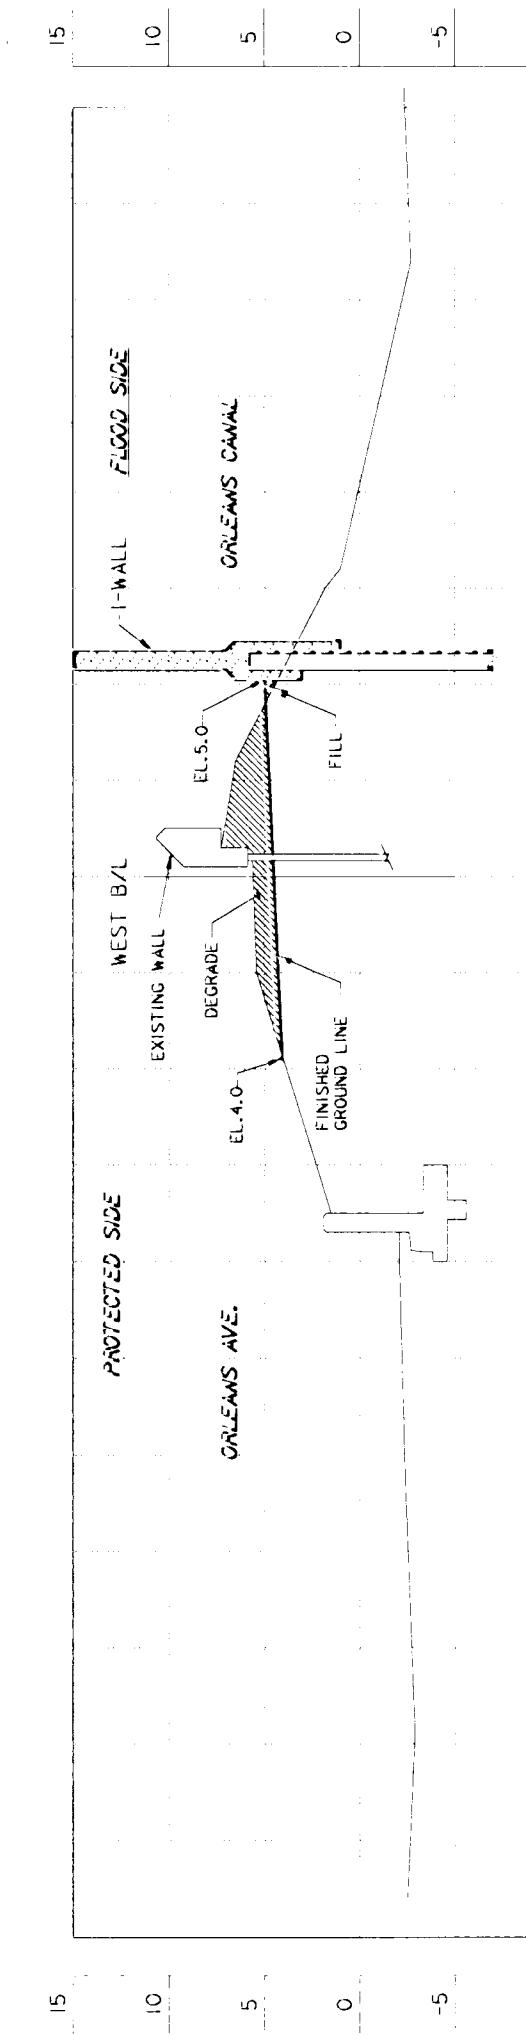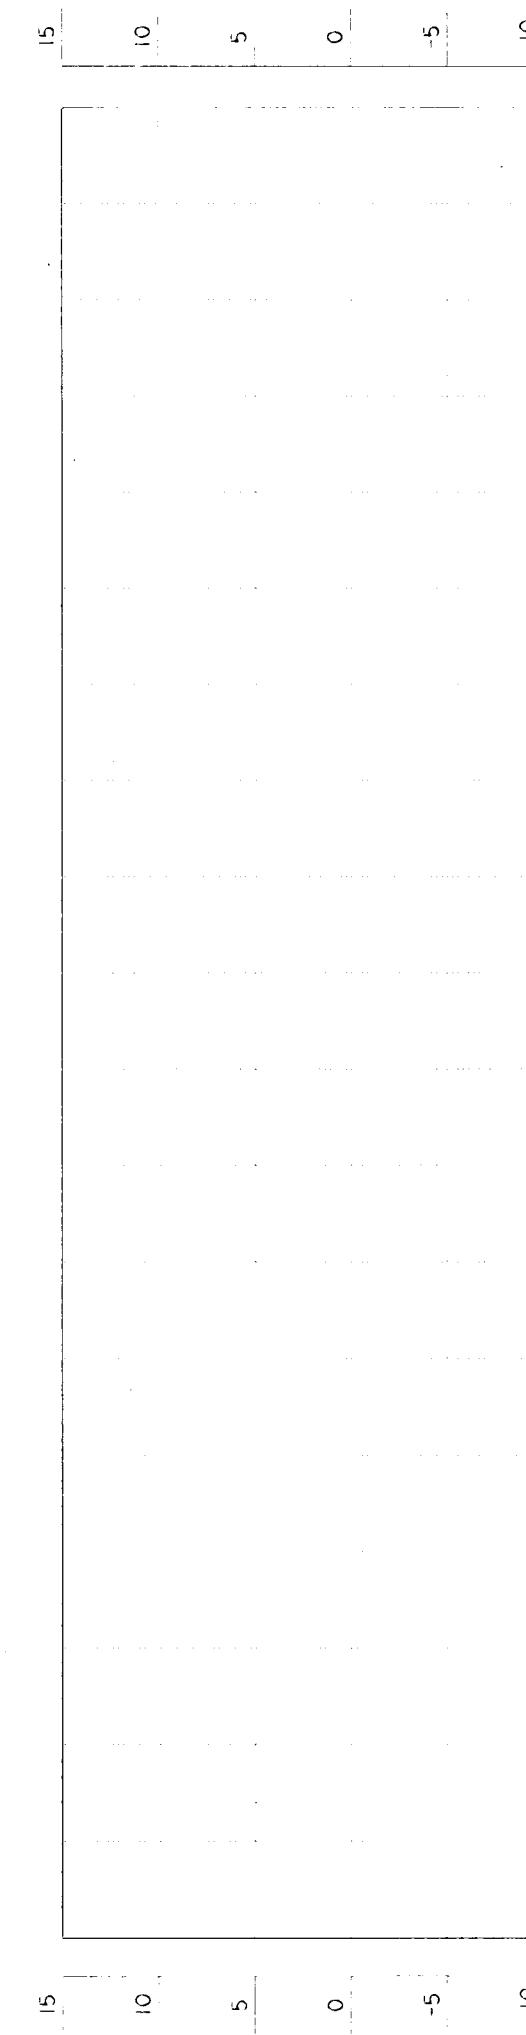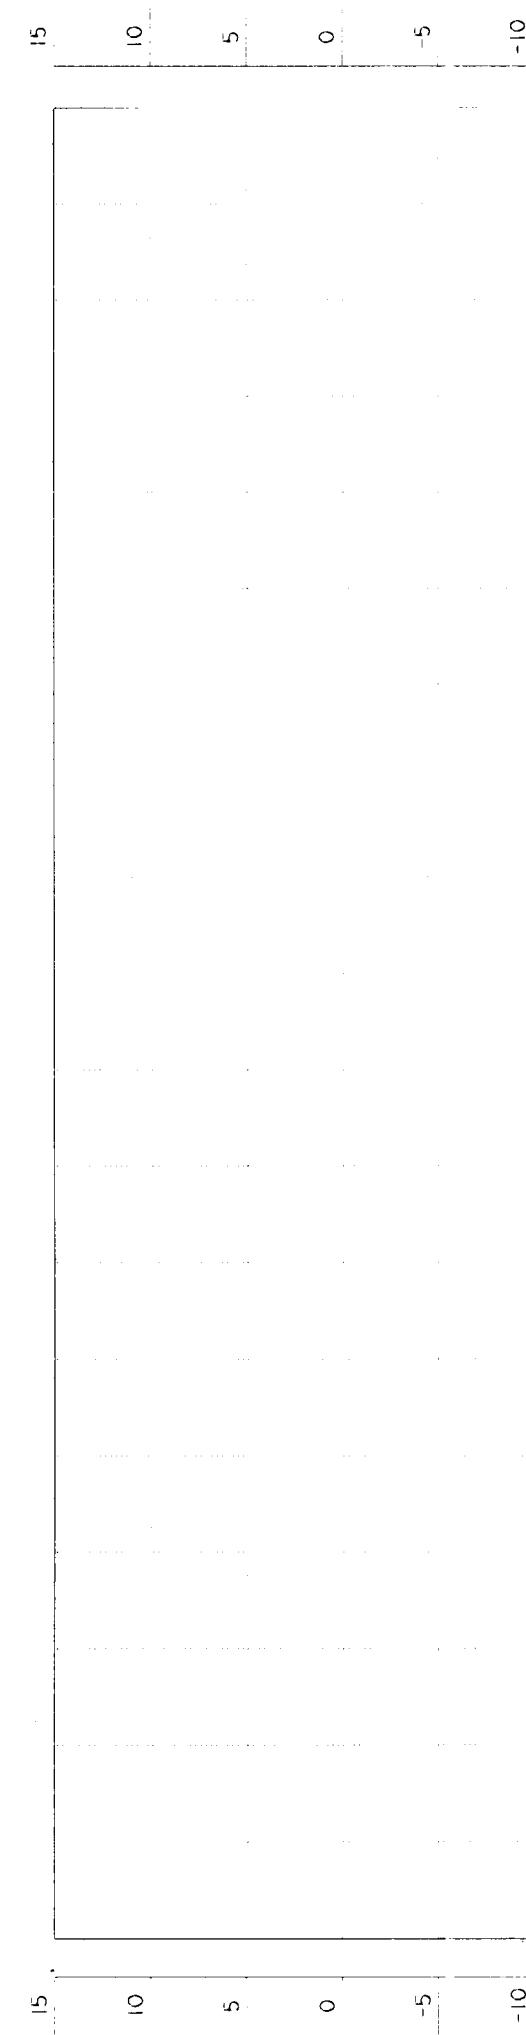

DISTANCE IN FEET

ELEVATIONS IN FEET - N.G.V.D.

A




5

4


3

2

1


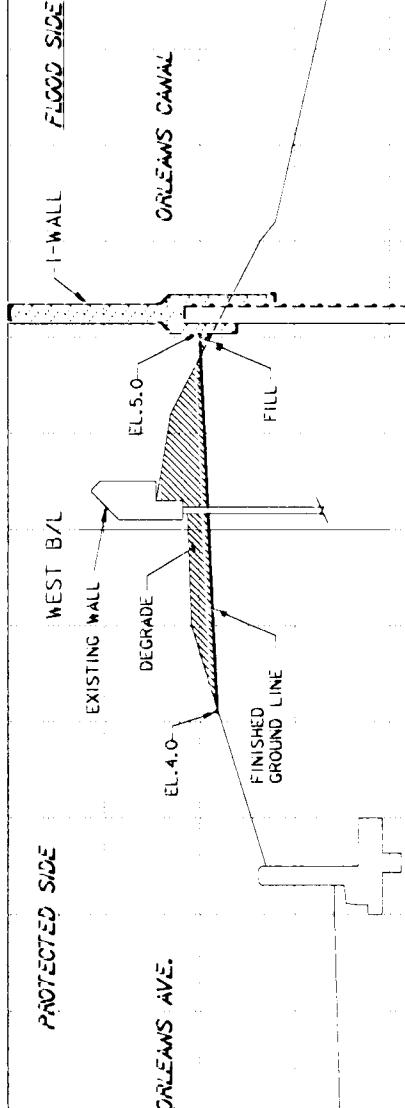


STA. 4+00 W.B.

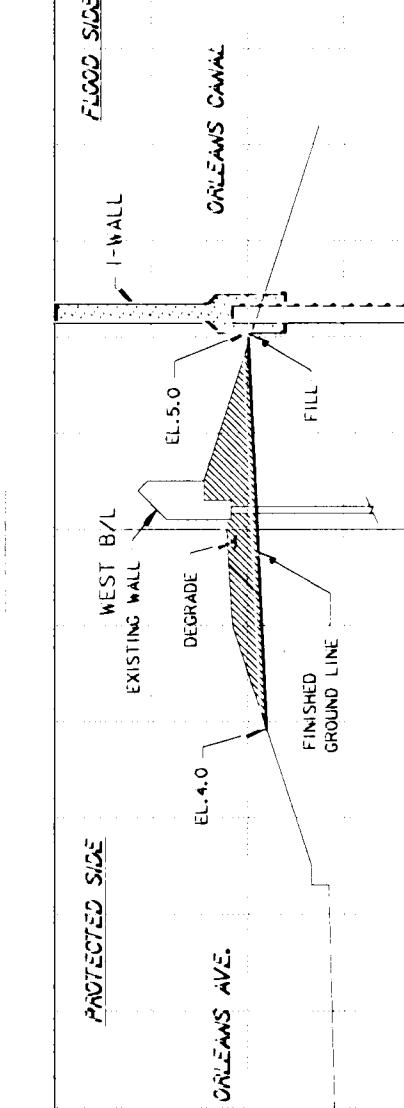

STA. 2+89.30 W.B.

SCALE: 1'' = 5'

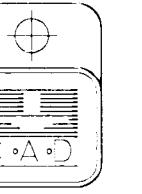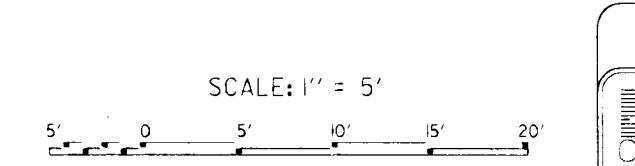

SYMBOL	DESCRIPTION	DATE APPROVED	REVISIONS
	U.S. ARMY ENGINEER DISTRICT, NEW ORLEANS CORPS OF ENGINEERS NEW ORLEANS, LOUISIANA		
BOARD OF LEVEE COMMISSIONERS LAKE PONTCHARTRAIN, LA. AND VICINITY NEW ORLEANS, LOUISIANA	DESIGN ENGINEERING INC. 333 BERNARD AVENUE S. METairie, LOUISIANA 70022		
LAKE PONTCHARTRAIN, LA. AND VICINITY HIGH LEVEL PLAN NEW ORLEANS LAKEFRONT LEVEE WEST OF I.H.N.C. ORLEANS AVE. CANAL FLOOD PROTECTION IMPROVEMENT PHASE II-D (WEST SIDE B/L STA. 2+39.00 TO STA. 29+07.50) ORLEANS PARISH, LOUISIANA			
CROSS SECTIONS			
DESIGNED BY: J.C. NOGUEIRA DRAWN BY: C.K. CARRERA CHECKED BY: T.M. SMITH SUBMITTED BY: DESIGN ENGINEERING, INC. DESIGN ENGINEER	PLOT SCALE: 60 PLOT DATE: MARCH 1993 FILE NO.: H-4-10205 CADD FILE: II-D 8	DATE: FEB., 1993 PLOT SCALE: 60 PLOT DATE: MARCH 1993 FILE NO.: H-4-10205 CADD FILE: II-D 8	DATE: FEB., 1993 PLOT SCALE: 60 PLOT DATE: MARCH 1993 FILE NO.: H-4-10205 CADD FILE: II-D 8
SOLICITATION NO.: DACW29-93-B-0042 Dwg. 13 of 24			

Safety is a Part
of Your Contract







5

4

3

2

1

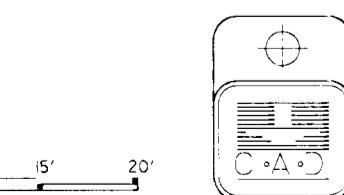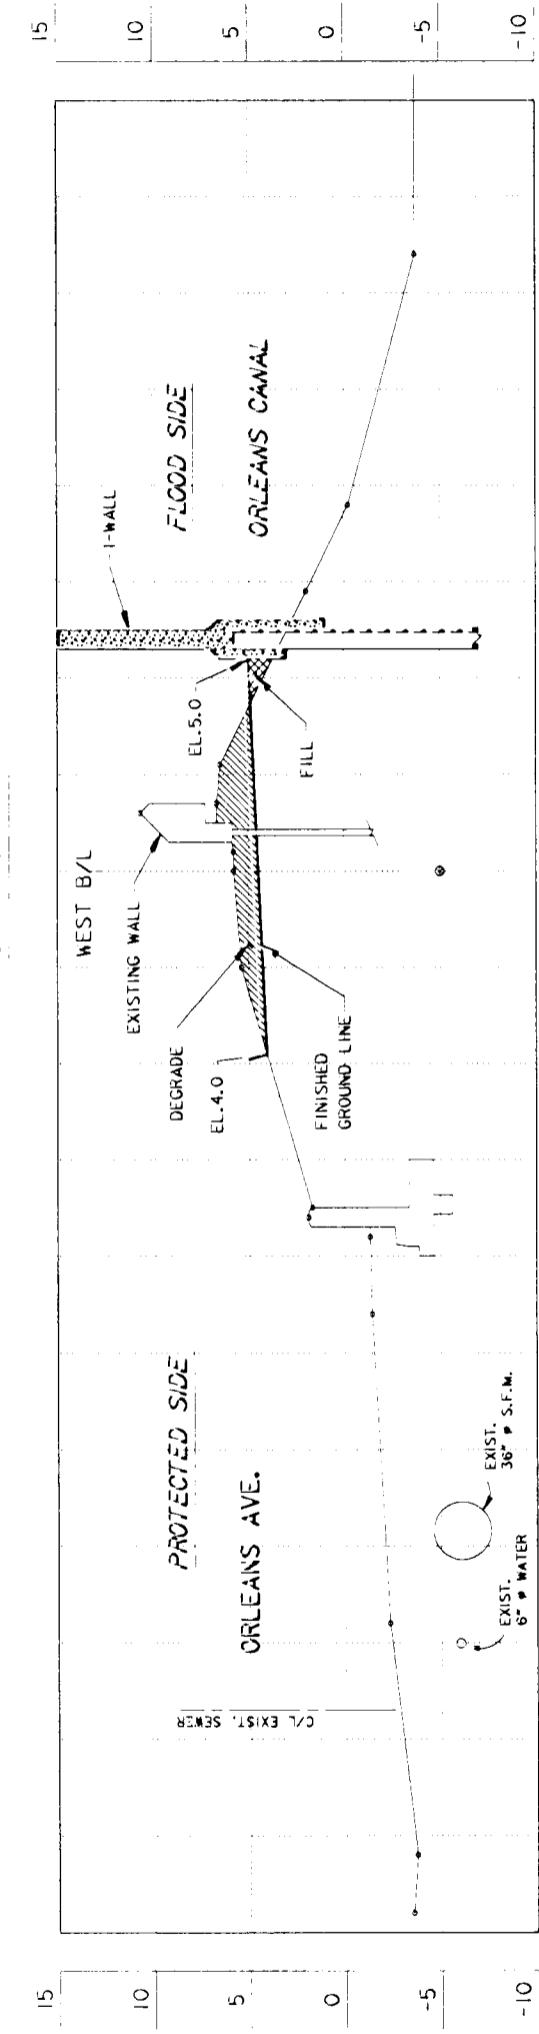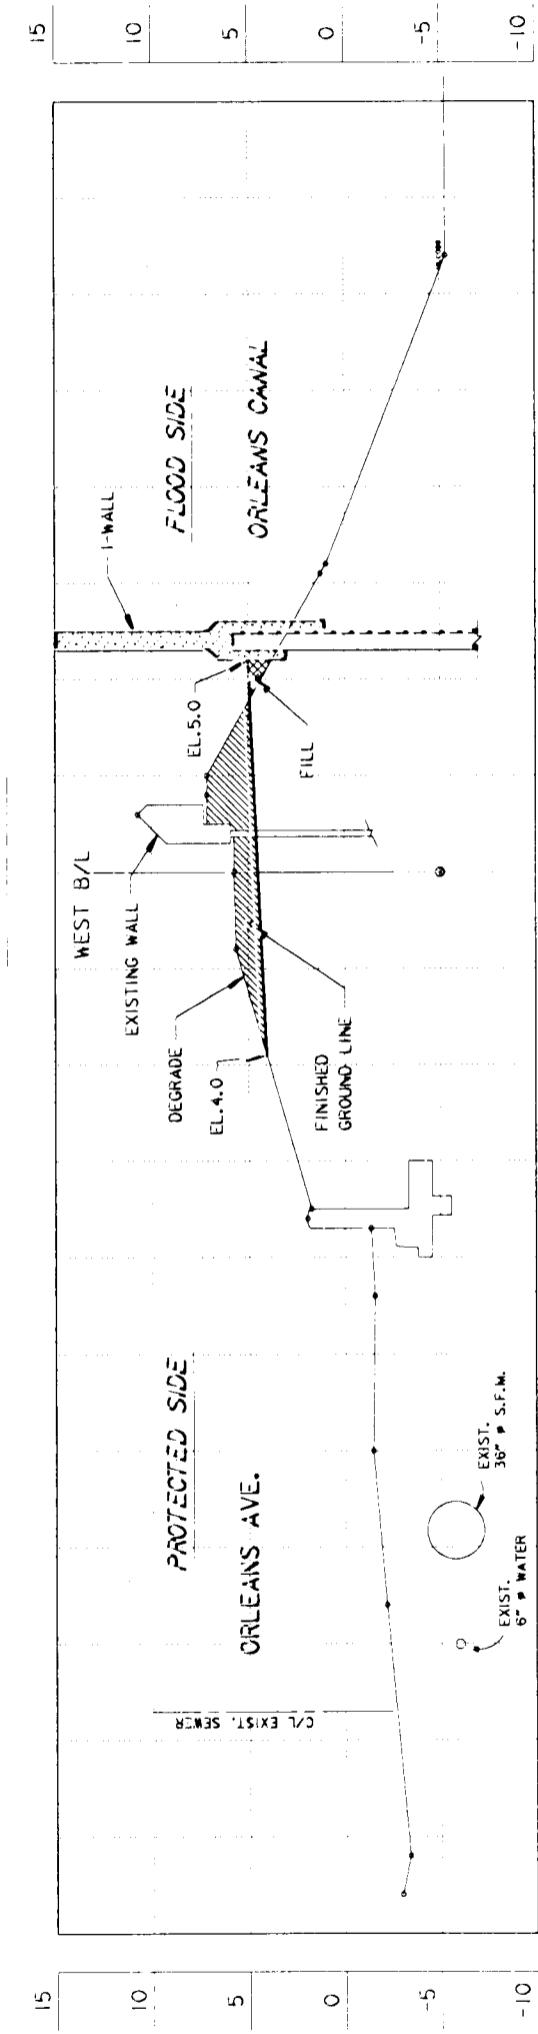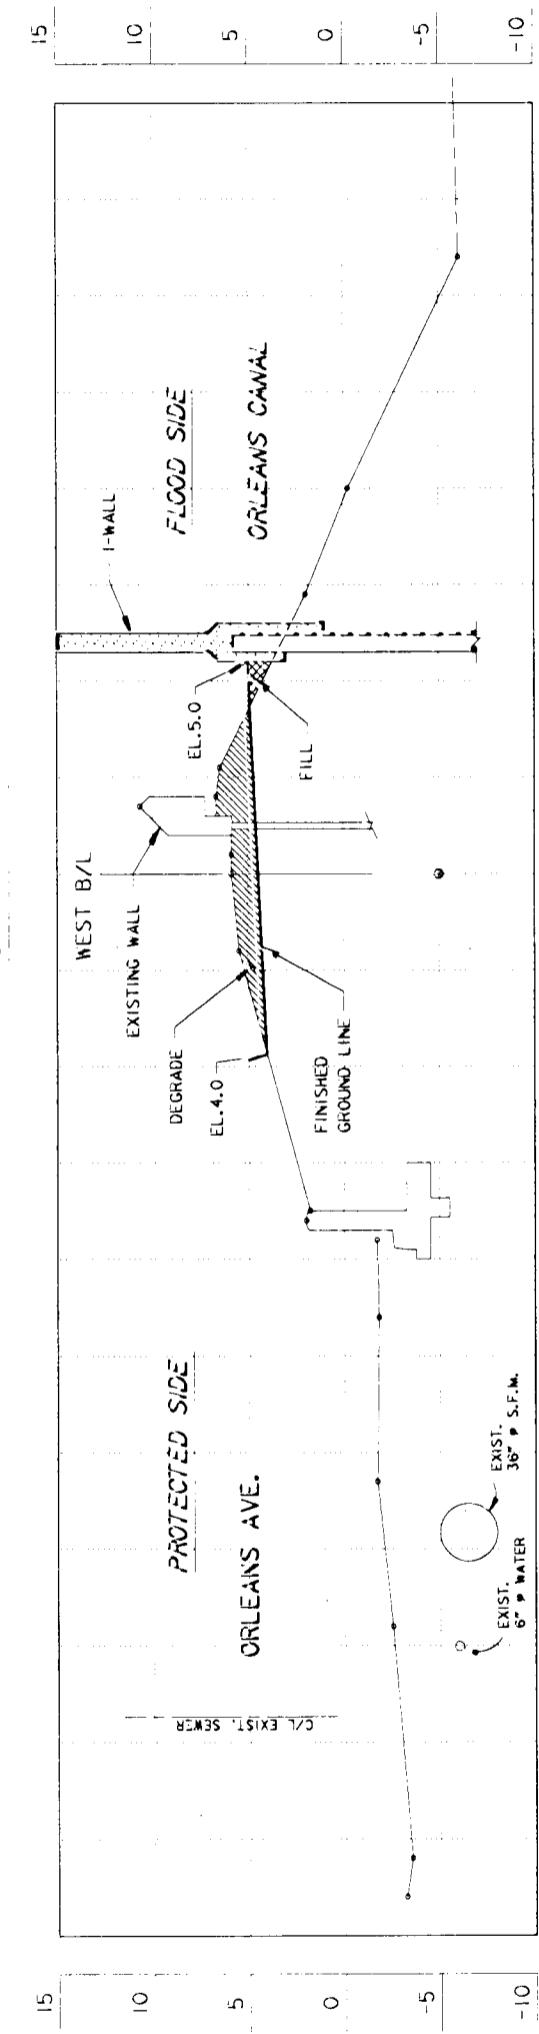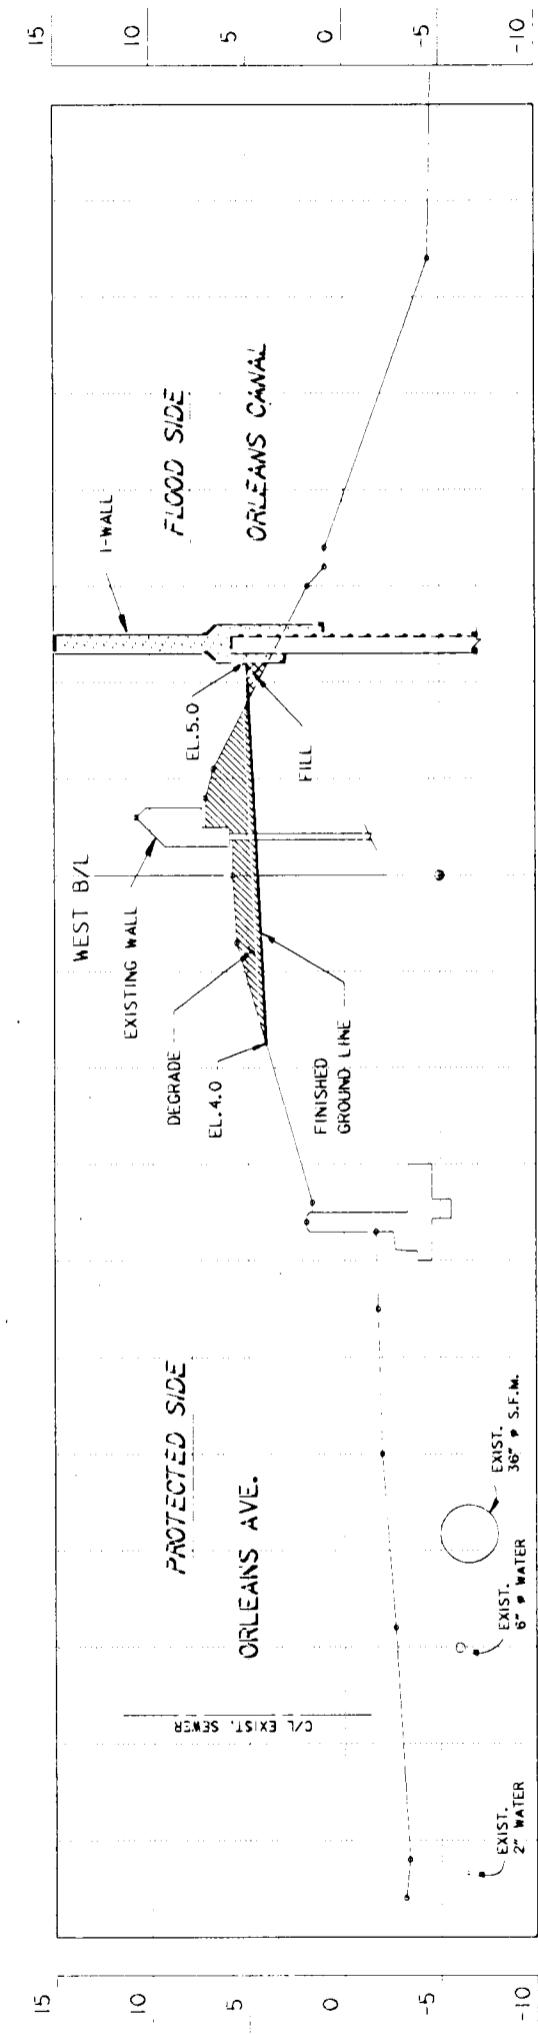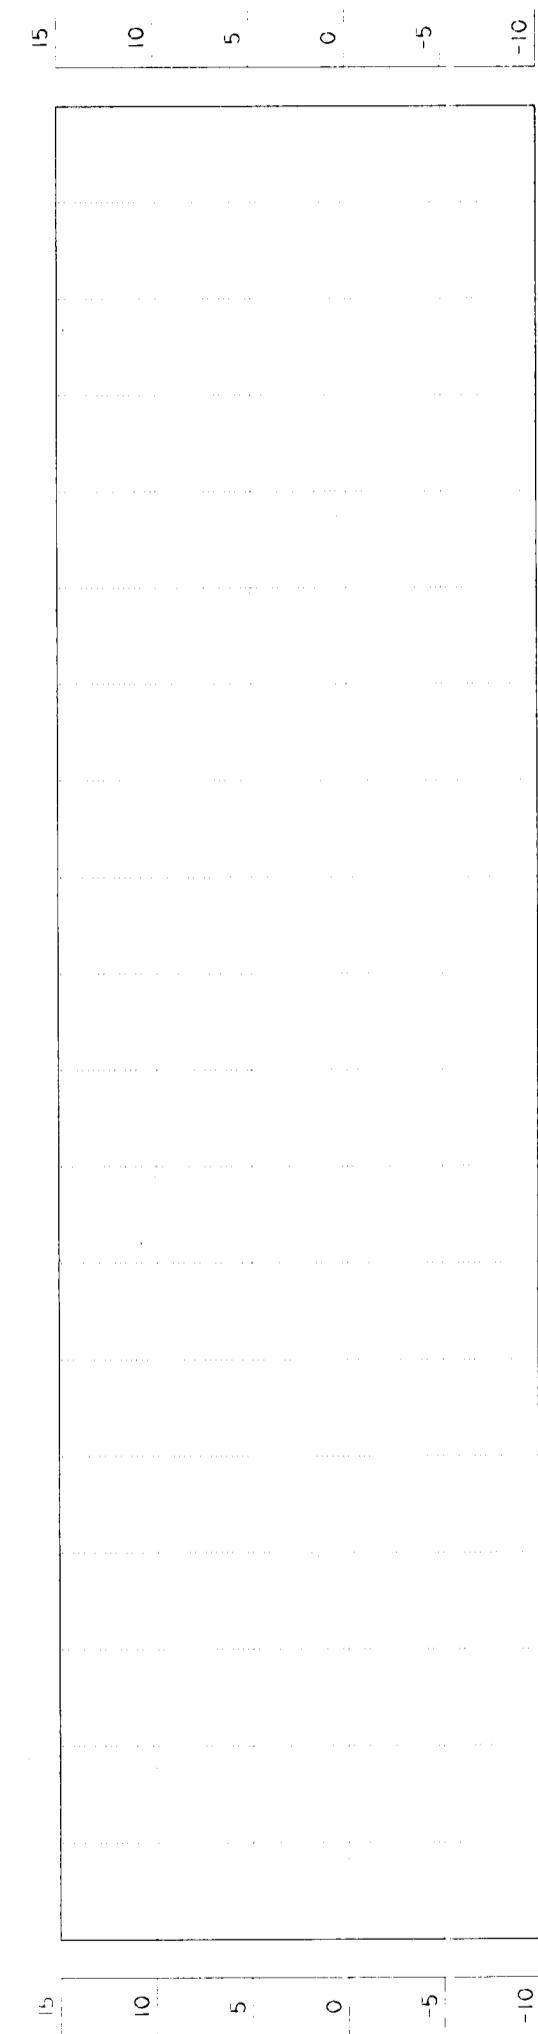


ELEVATIONS IN FEET - N.G.V.D.

DISTANCE IN FEET


REVISIONS	DATE APPROVED
	U.S. ARMY ENGINEER DISTRICT, NEW ORLEANS CORPS OF ENGINEERS NEW ORLEANS, LOUISIANA
BOARD OF LEVEE COMMISSIONERS NEW ORLEANS LEVEE DISTRICT NEW ORLEANS, LOUISIANA	DESIGN ENGINEER: JAHN INC. 1310 W. ESPALADE AVE. S. METairie, LOUISIANA 70002
LAKE PONTCHARTRAIN, LA. AND VICINITY HIGH LEVEL PLAN	DATE: MARCH 1993 PLOT SCALE: 60 PLOT DATE: MARCH 1993 FILE NO.: H-4-40205
NEW ORLEANS LAKEFRONT LEVEE WEST OF JAHN, ORLEANS AVE. CANAL FLOOD PROTECTION IMPROVEMENT PHASE II-D (WEST SIDE B/L STA. 2+39.00 TO STA. 29+07.50) ORLEANS PARISH, LOUISIANA	
CROSS SECTIONS	
DESIGNED BY: JAHN INC. DRAWN BY: C.K. CARRERA CHECKED BY: T.M. SMITH SUBMITTED BY: DESIGN ENGINEERING, INC. DESIGN ENGINEER	DATE: FEB. 1993 PLOT FILE: II-D19 SOLICITATION NO.: DACW29-93-B-0042 CNG. 19 OF 24

Safety is a Part
of Your Contract


ELEVATIONS IN FEET - N.G.V.D.

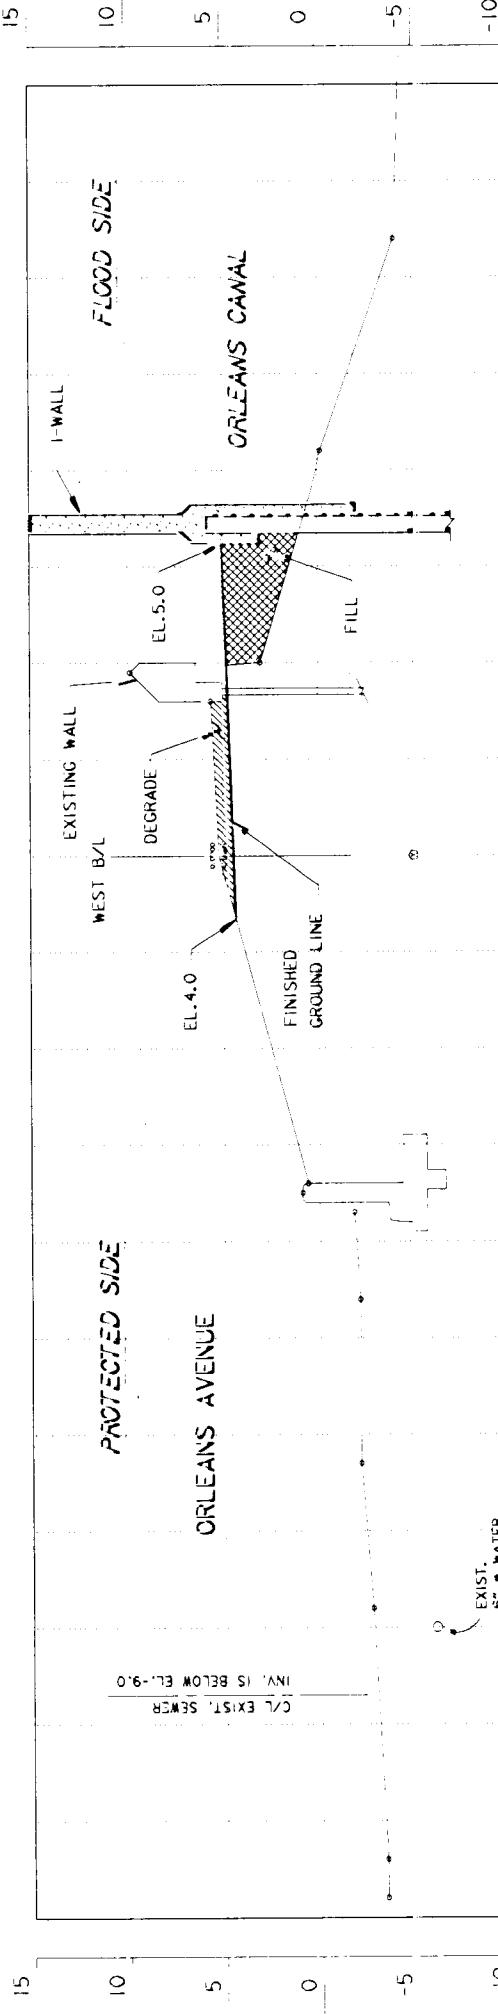


ELEVATIONS IN FEET - N.G.V.D.

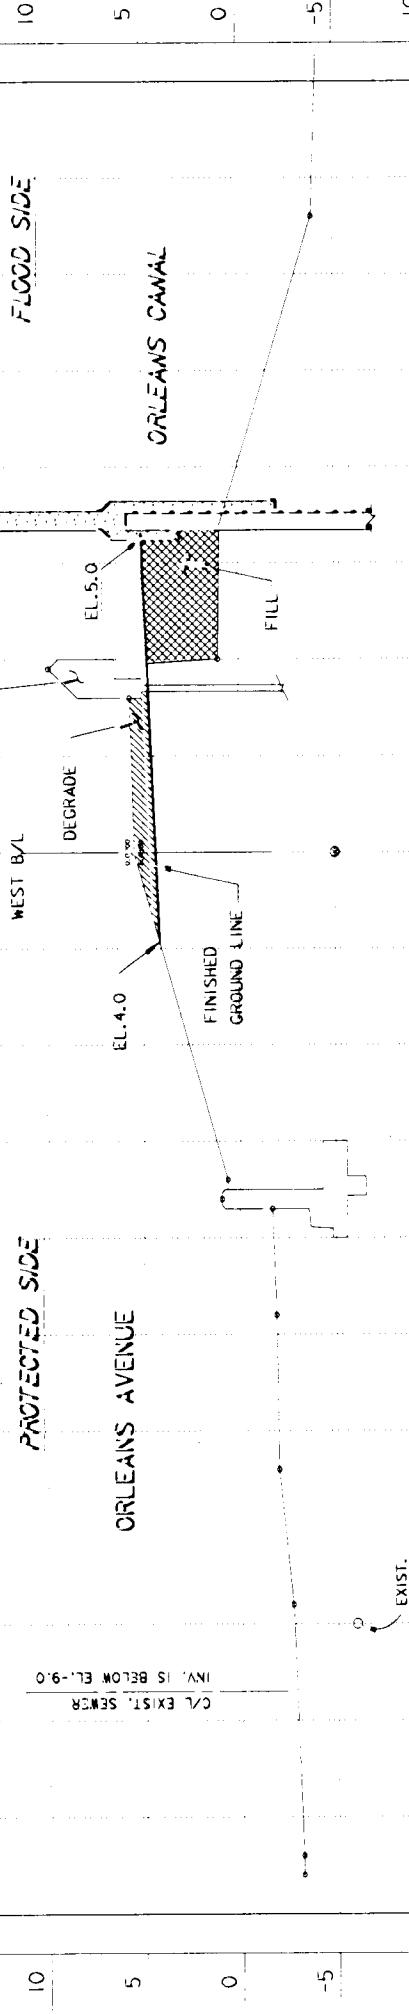


ELEVATIONS IN FEET - N.G.V.D.

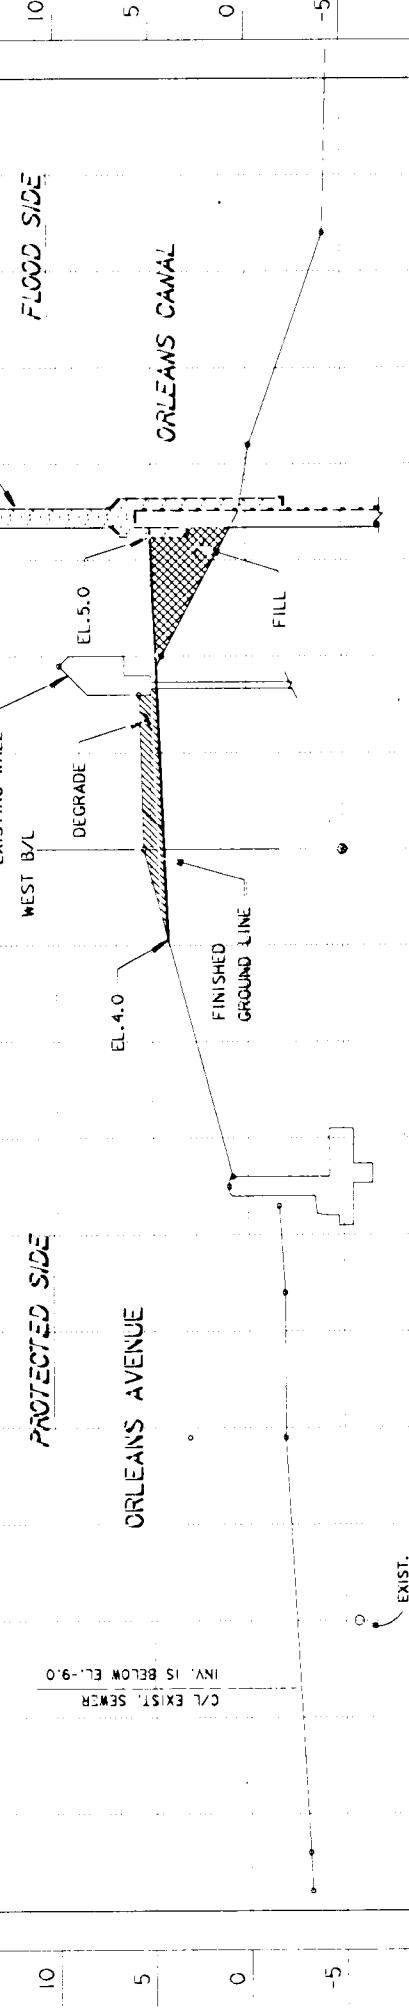

ELEVATIONS IN FEET - N.G.V.D.

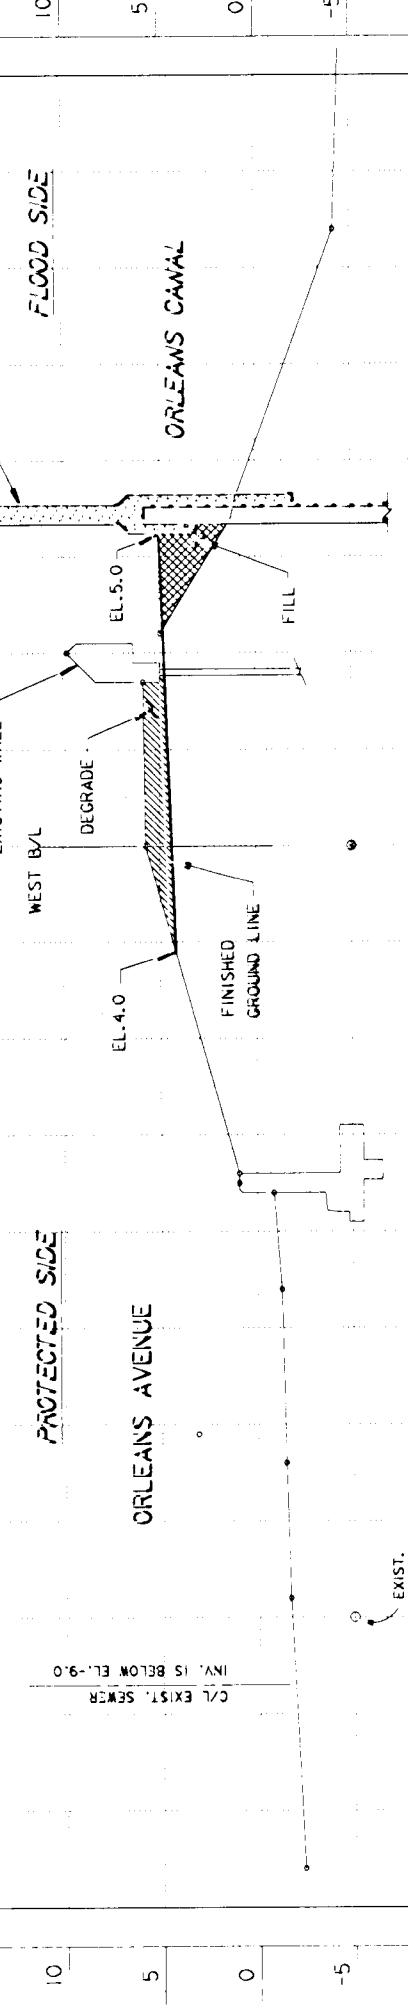

ELEVATIONS IN FEET - N.G.V.D.

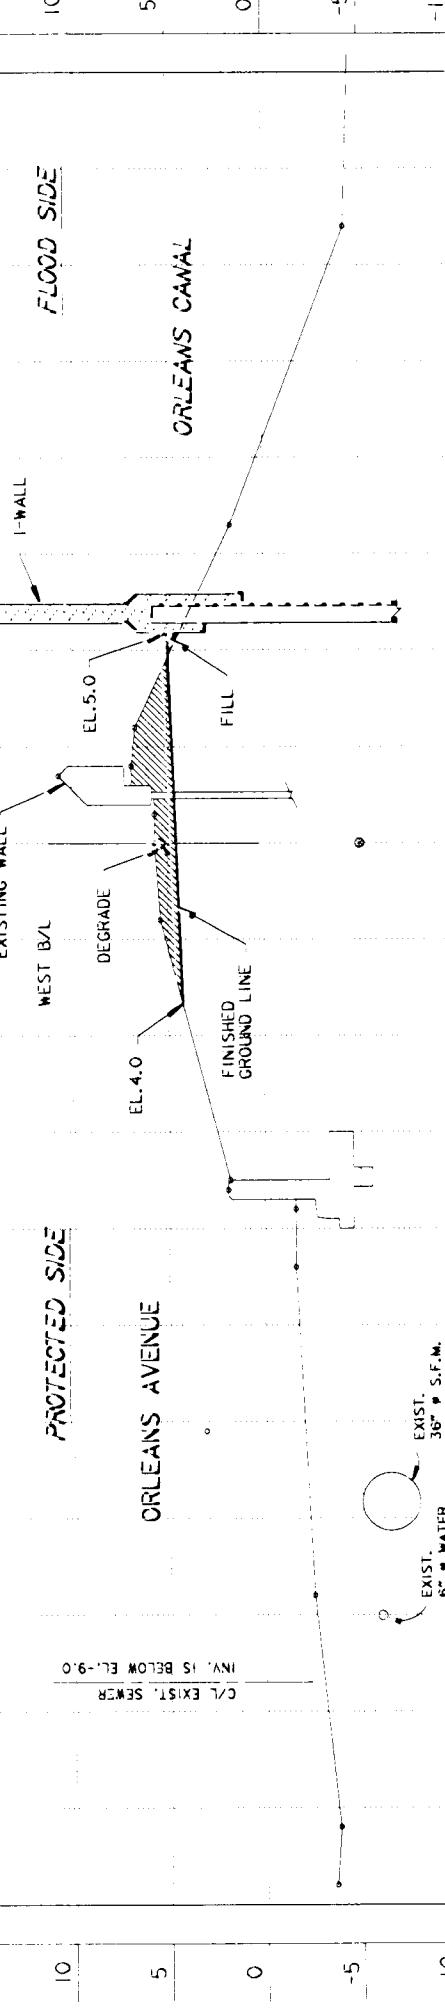

DISTANCE IN FEET

STA. 9+00 W.B.

STA. 10+00 W.B.


STA. 11+00 W.B.

STA. 12+00 W.B.






STA. 13+00 W.B.

SYMBOL	DESCRIPTION	DATE APPROVED
	U.S. ARMY ENGINEER DISTRICT, NEW ORLEANS CORPS OF ENGINEERS NEW ORLEANS, LOUISIANA	
BOARD OF LEVEE COMMISSIONERS NEW ORLEANS, LOUISIANA	DESIGN ENGINEERING, INC. 3330 W. ESPLANADE AVE., S. METairie, LOUISIANA 70002	
LAKE PONTCHARTRAIN, LA. AND VICINITY	HIGH LEVEL PLAN	
NEW ORLEANS LAKEFRONT LEVEE WEST OF I.H.N.C.		
ORLEANS AVE. CANAL FLOOD PROTECTION IMPROVEMENT		
PHASE II-D (WEST SIDE B/L STA. 2+39.00 TO STA. 29+07.50)		
ORLEANS PARISH, LOUISIANA		
CROSS SECTIONS		
DESIGNED BY: J.C. MOGUEA DRAWN BY: C.K. CARRERA CHECKED BY: T.M.S.W. SUBMITTED BY: DESIGN ENGINEERING, INC. DESIGN ENGINEER	PLOT DATE: MARCH 1993 CADD FILE #: D-220 FILE NO.: H-4-40205 SOLICITATION NO.: DACW29-93-B-0042 Dwg. 20 of 24	

SCALE: 1" = 5'

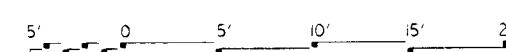


Safety is a Part
of Your Contract

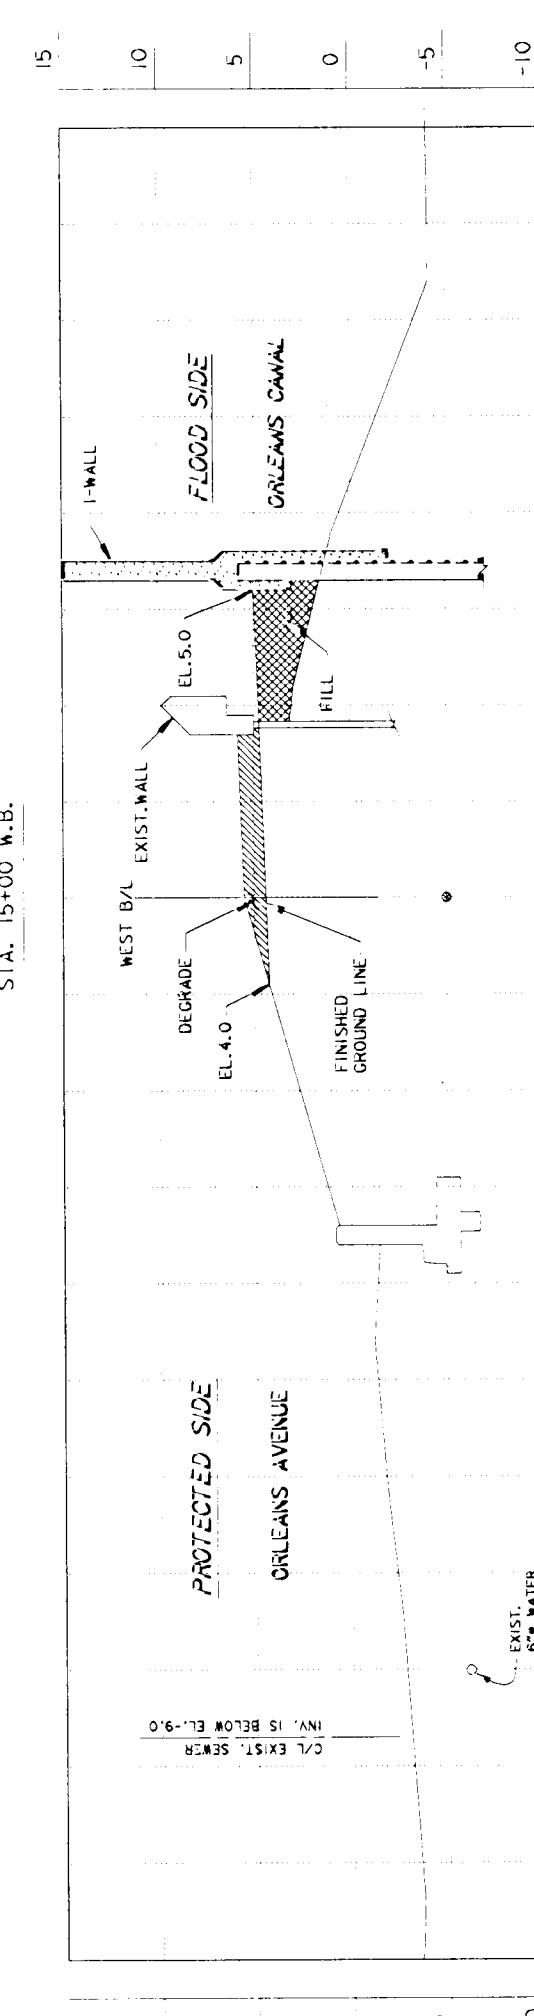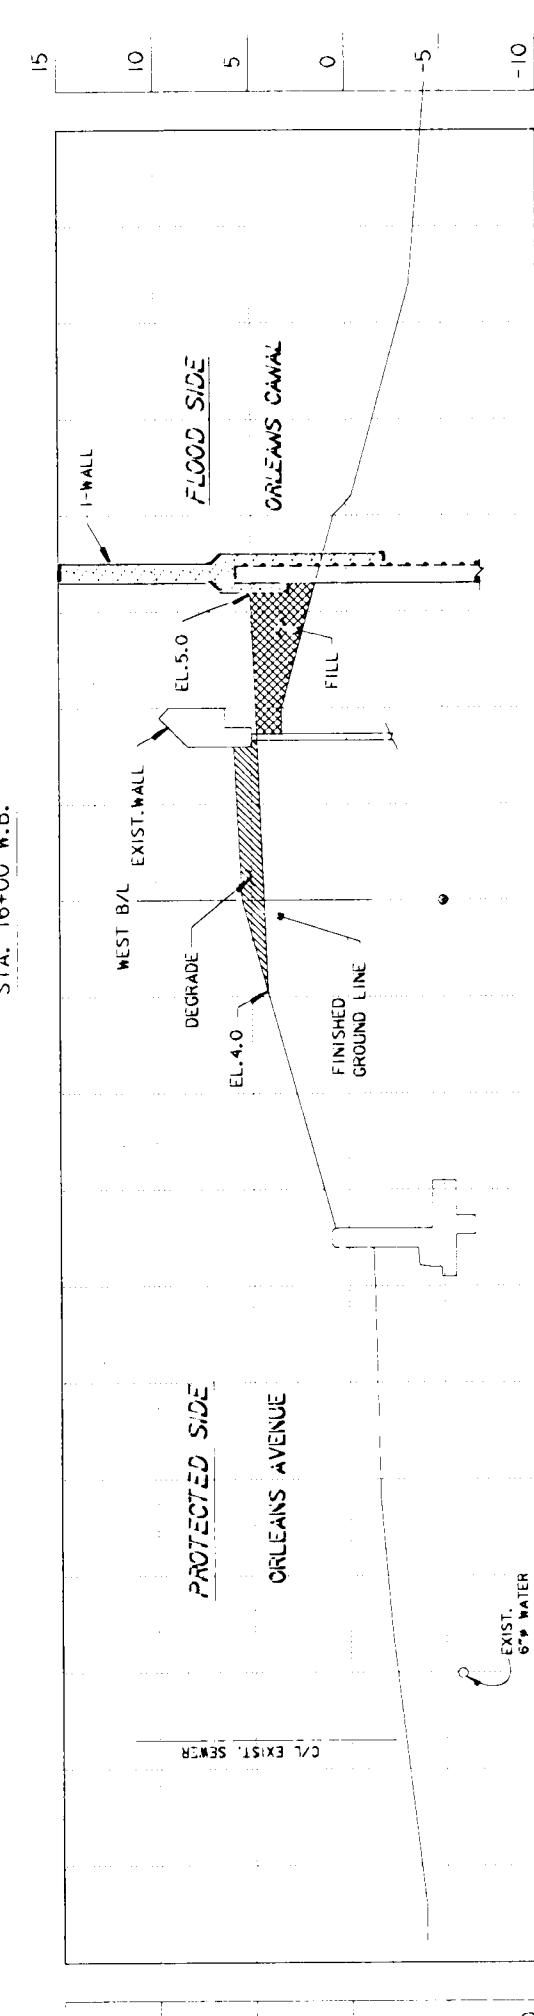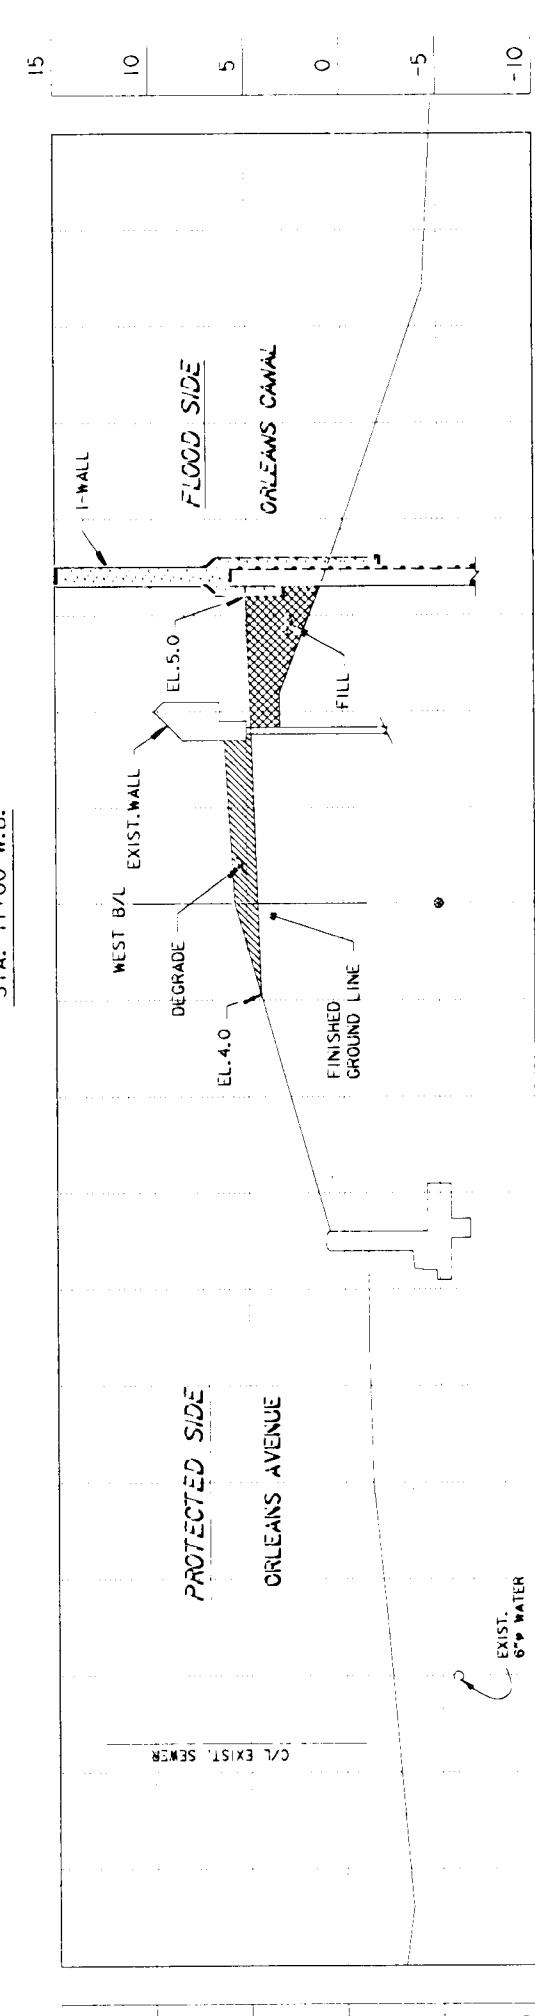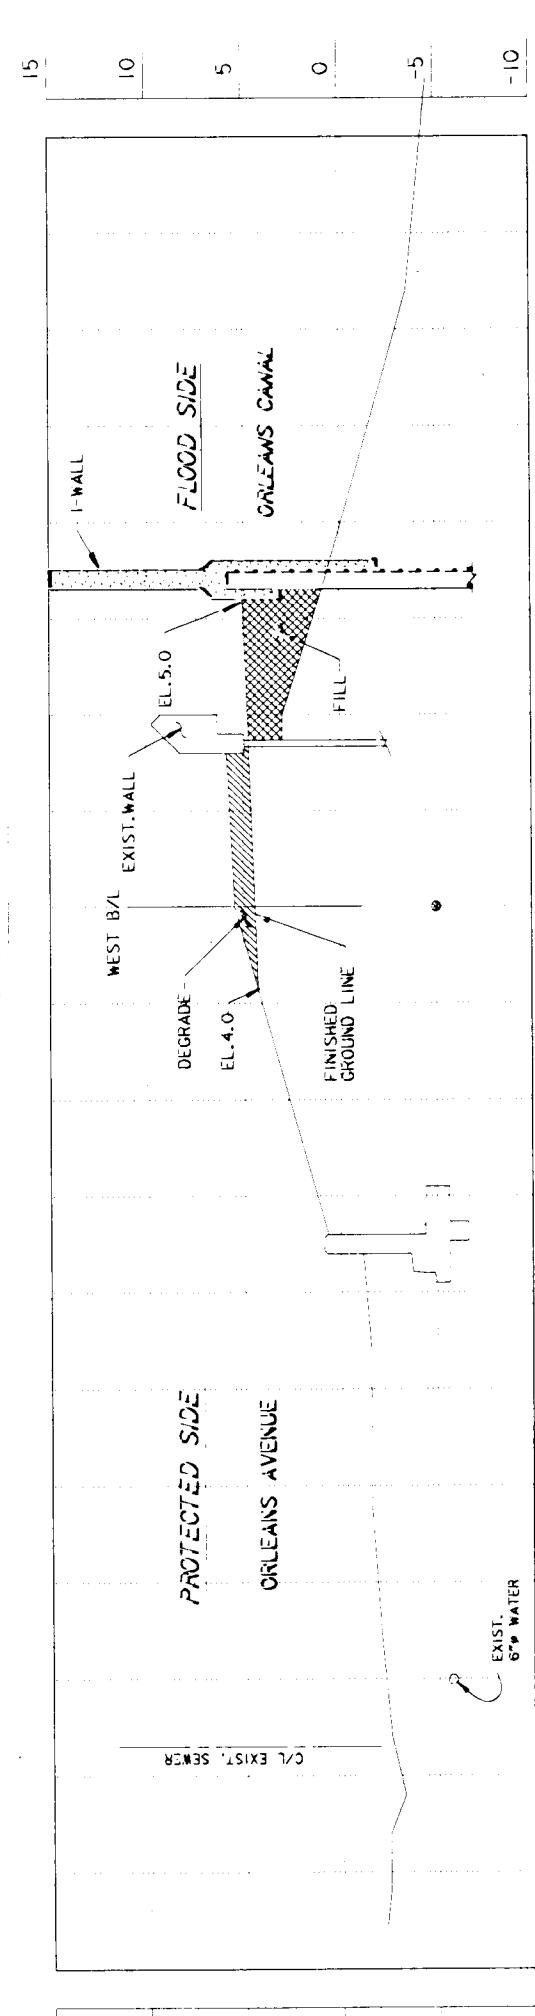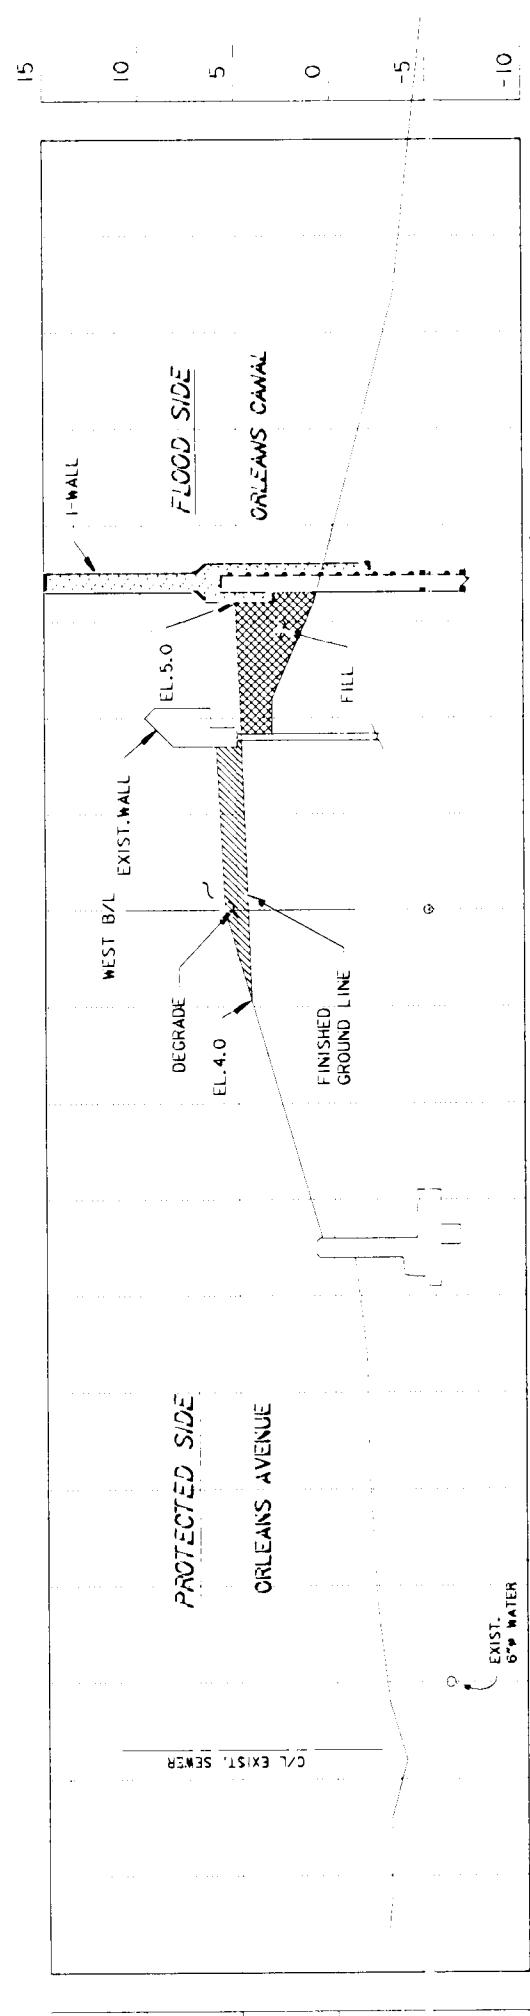






ELEVATIONS IN FEET - N.G.V.D.

SYMBOL	DESCRIPTION	DATE	APPROVED	REVISIONS	
	U.S. ARMY ENGINEER DISTRICT, NEW ORLEANS				
	CORPS OF ENGINEERS				
	NEW ORLEANS, LOUISIANA				
	BOARD OF LEVEE COMMISSIONERS	DESIGN ENGINEERING, INC.			
	ORLEANS LEVEE DISTRICT	3330 W. ESPLANADE AVE. S.			
	NEW ORLEANS, LOUISIANA	METairie, LOUISIANA 70022			
	LAKE PONTCHARTRAIN, LA. AND VICINITY				
	HIGH LEVEL PLAN				
	NEW ORLEANS LAKEFRONT LEVEE				
	WEST OF I.H.N.C.				
	ORLEANS AVE. CANAL FLOOD PROTECTION IMPROVEMENT				
	PHASE II-D (WEST SIDE B/L STA. 2+39.00 TO STA. 29+07.50)				
	ORLEANS PARISH, LOUISIANA				
	CROSS SECTIONS				
DESIGNED BY: J.C. NOGUERA	DATE: FEB. 1993	PLOT SCALE: 60'	PLOT DATE: MARCH 1993		
DRAWN BY: C.K. CAPRERA					
CHECKED BY: T.M. SMITH					
SUBMITTED BY: DESIGN ENGINEER, INC.	CADD FILE: I-021				
DESIGN ENGINEER	SOLICITATION NO.: H-4-40205				
	DACW93-B-0042				
	DWG. 21 OF 24				

SCALE: 1'' = 5'

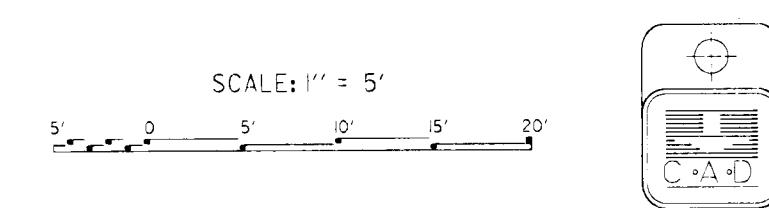

Safety is a Part
of Your Contract

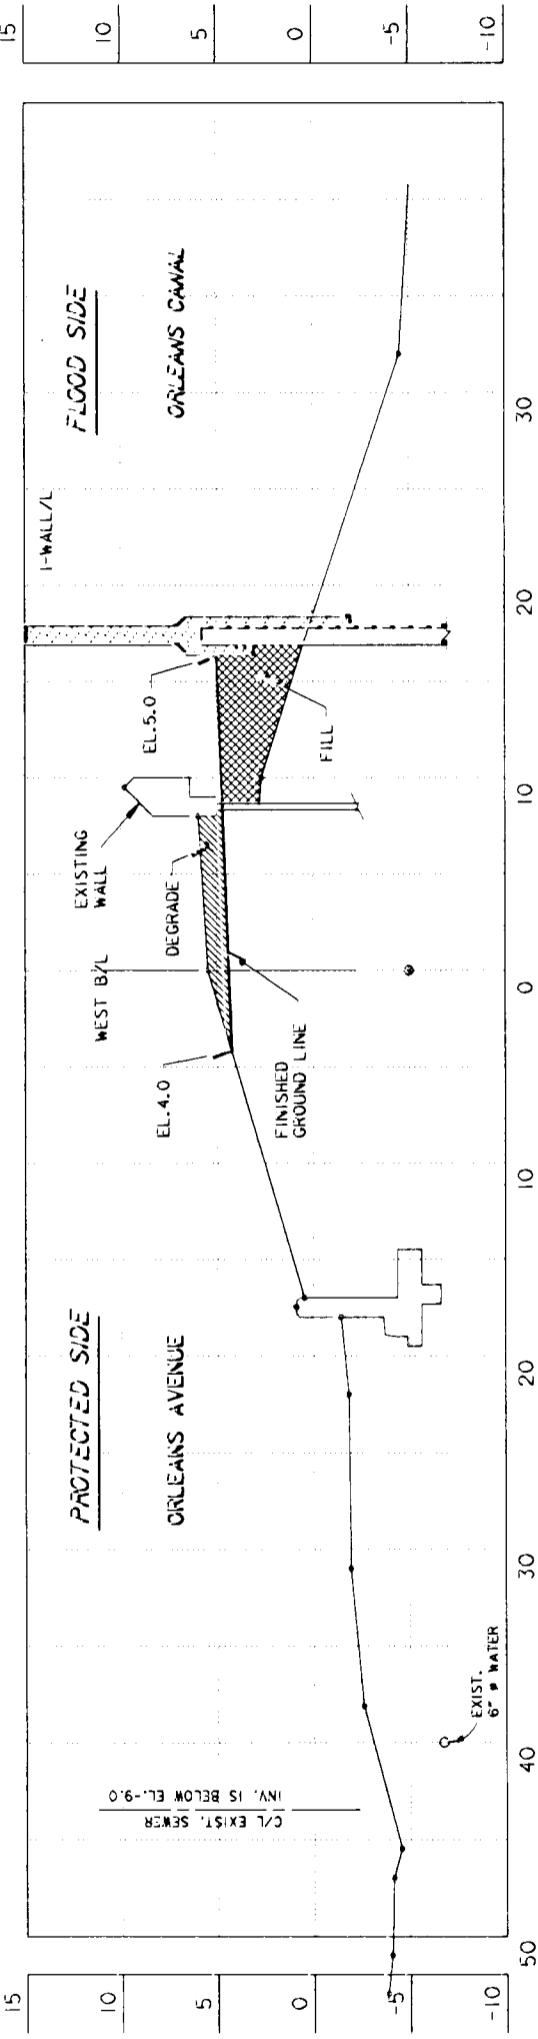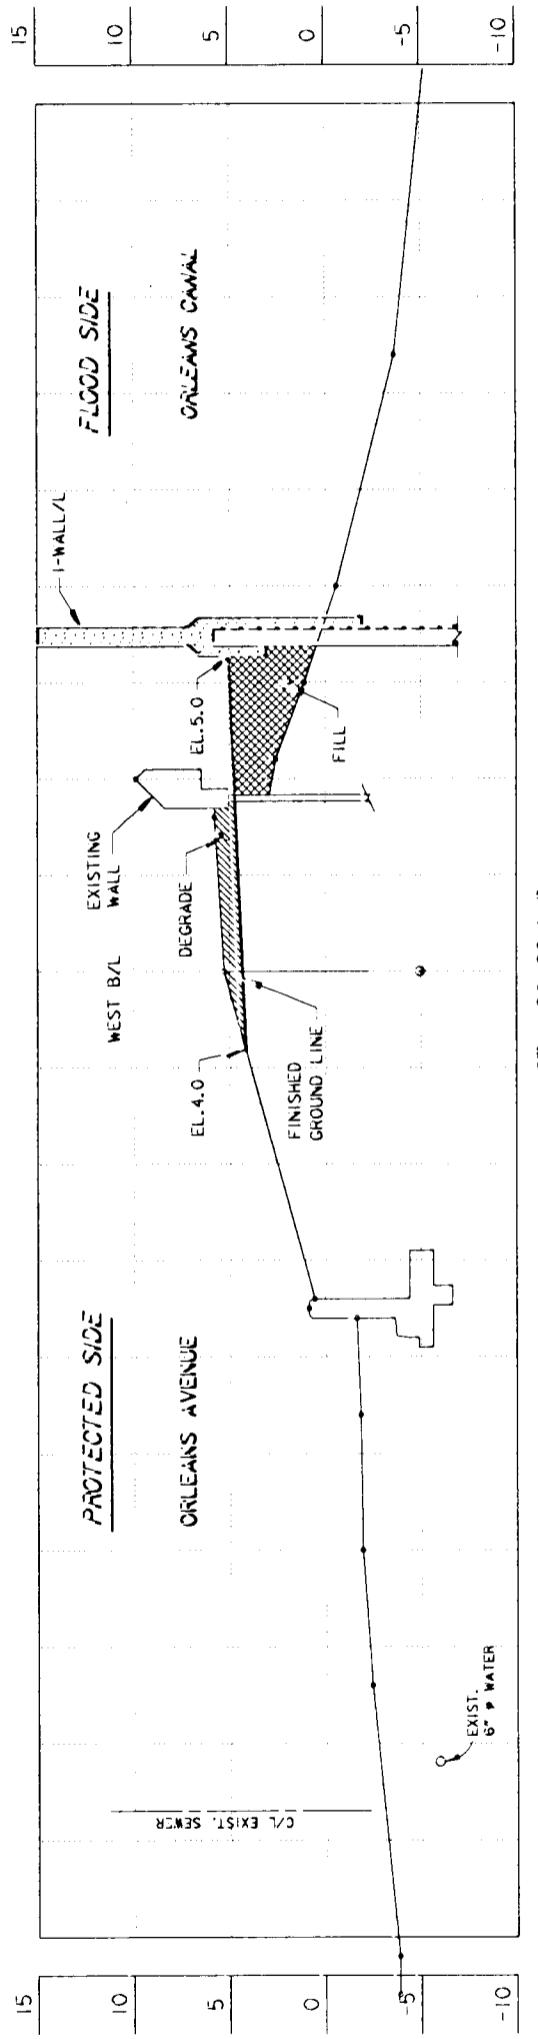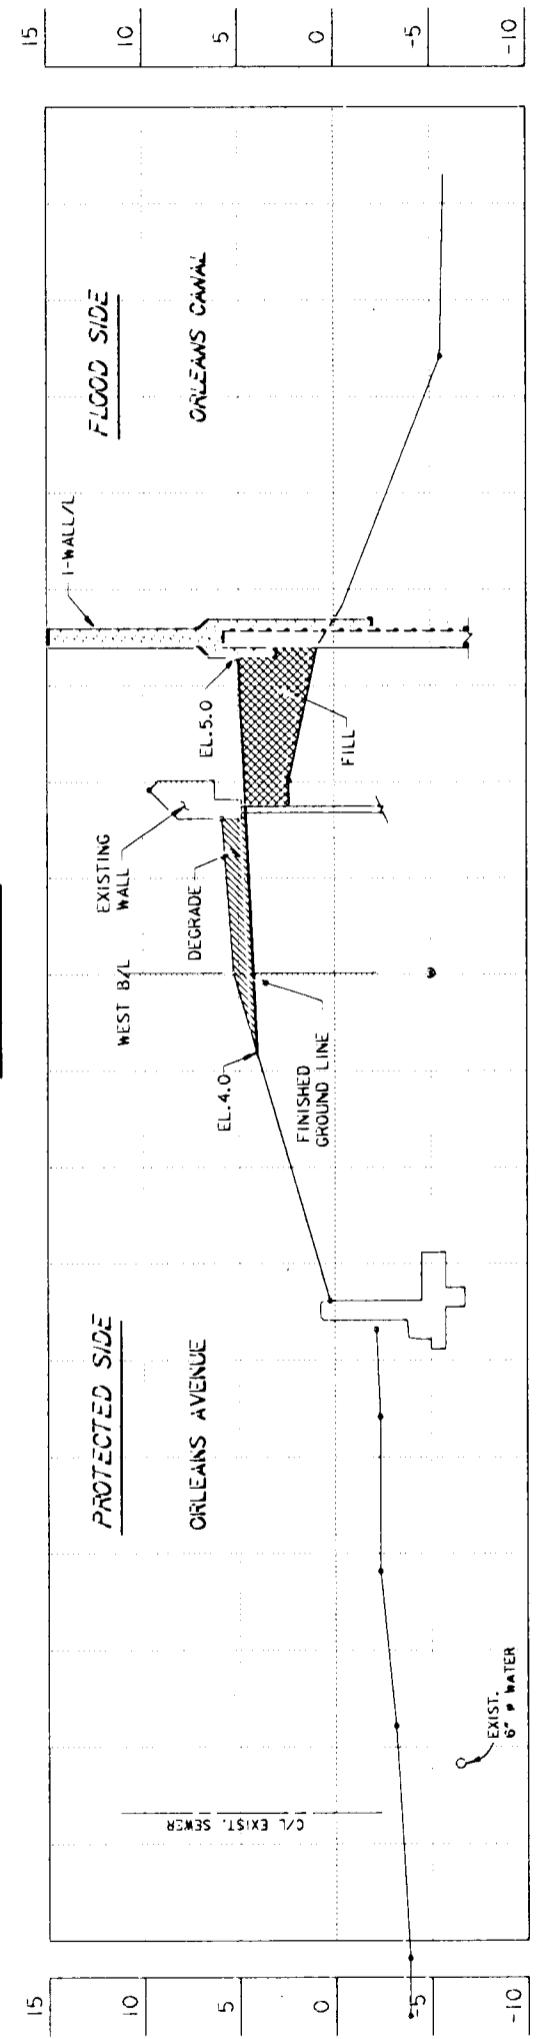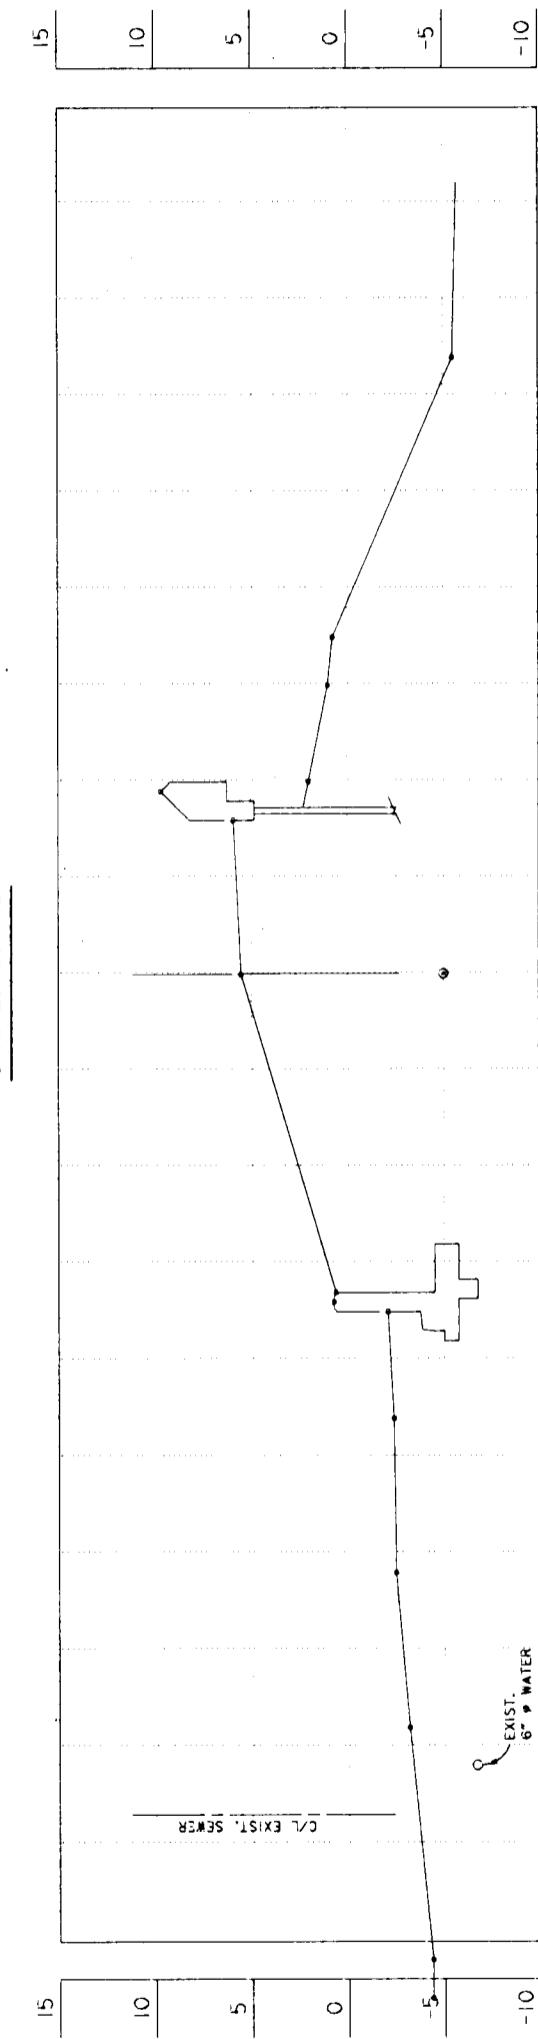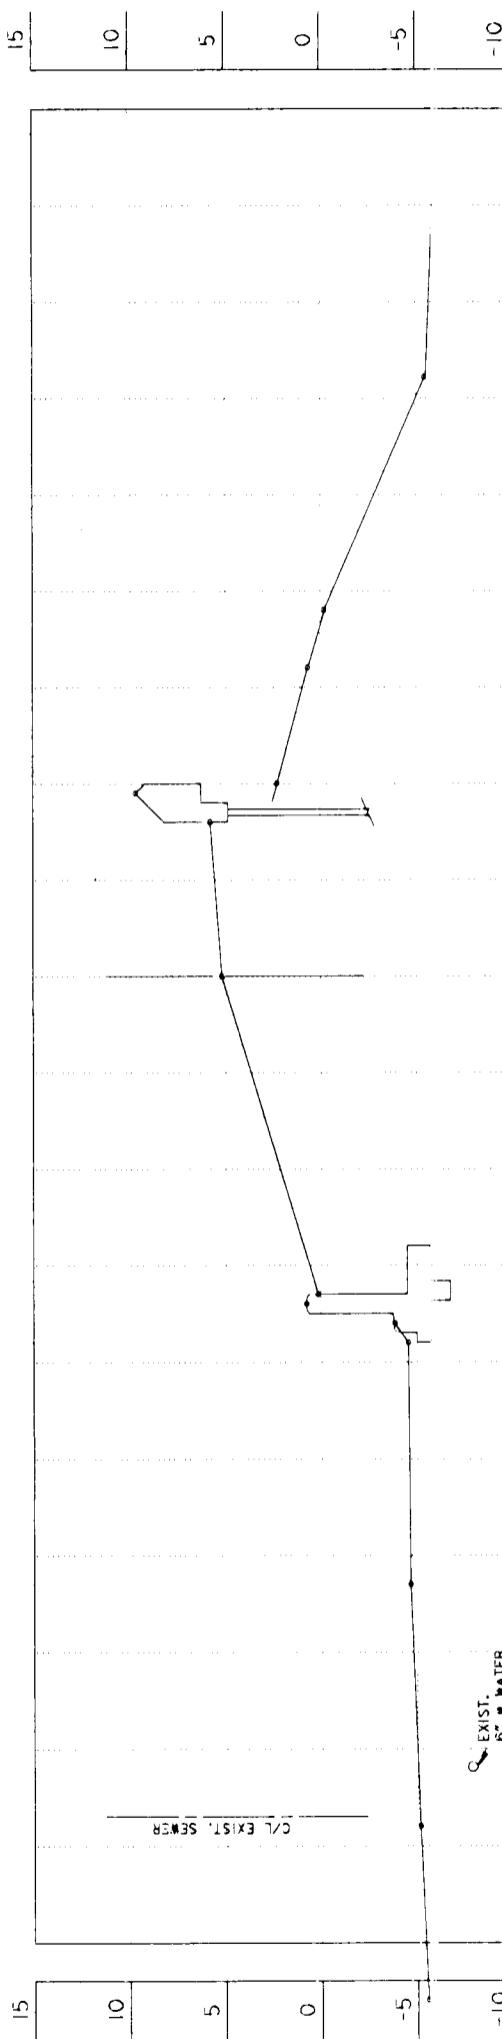

STA. 19+00 W.B.

DISTANCE IN FEET

SCALE: 1'' = 5'

5' 0' 5' 10' 15' 20'






CADD FILE: H-022

DACW29-93-B-0042



SYMBOL	DESCRIPTION	DATE APPROVED
REVISIONS		
U.S. ARMY ENGINEER DISTRICT, NEW ORLEANS		
CORPS OF ENGINEERS		
NEW ORLEANS, LOUISIANA		
BOARD OF LEVEE COMMISSIONERS		
NEW ORLEANS LEVEE DISTRICT		
NEW ORLEANS, LOUISIANA		
3330 W. ESPARADE AVE. S.		
METAIRIE, LOUISIANA 70002		
LAKE PONTCHARTRAIN, LA. AND VICINITY		
HIGH LEVEL PLAN		
NEW ORLEANS LAKEFRONT LEVEE		
WEST OF I.H.N.C.		
ORLEANS AVE. CANAL FLOOD PROTECTION IMPROVEMENT		
PHASE II-D (WEST SIDE; B/L STA. 2439.00 TO STA. 29+07.50)		
ORLEANS PARISH, LOUISIANA		
CROSS SECTIONS		
DESIGNED BY: J.C. NOGUEIRA	PLOT SCALE:	PLOT DATE:
DRAWN BY: C.K. CAPRERA	60	MARCH 1993
CHECKED BY: T.M. SMITH		
SUBMITTED BY: DESIGN ENGINEER, INC.	CADD FILE:	FILE NO.
	H-4-40205	
SOLICITATION NO. DACW29-93-B-0042		
C. 22 OF 24		

Safety is a Part
of Your Contract

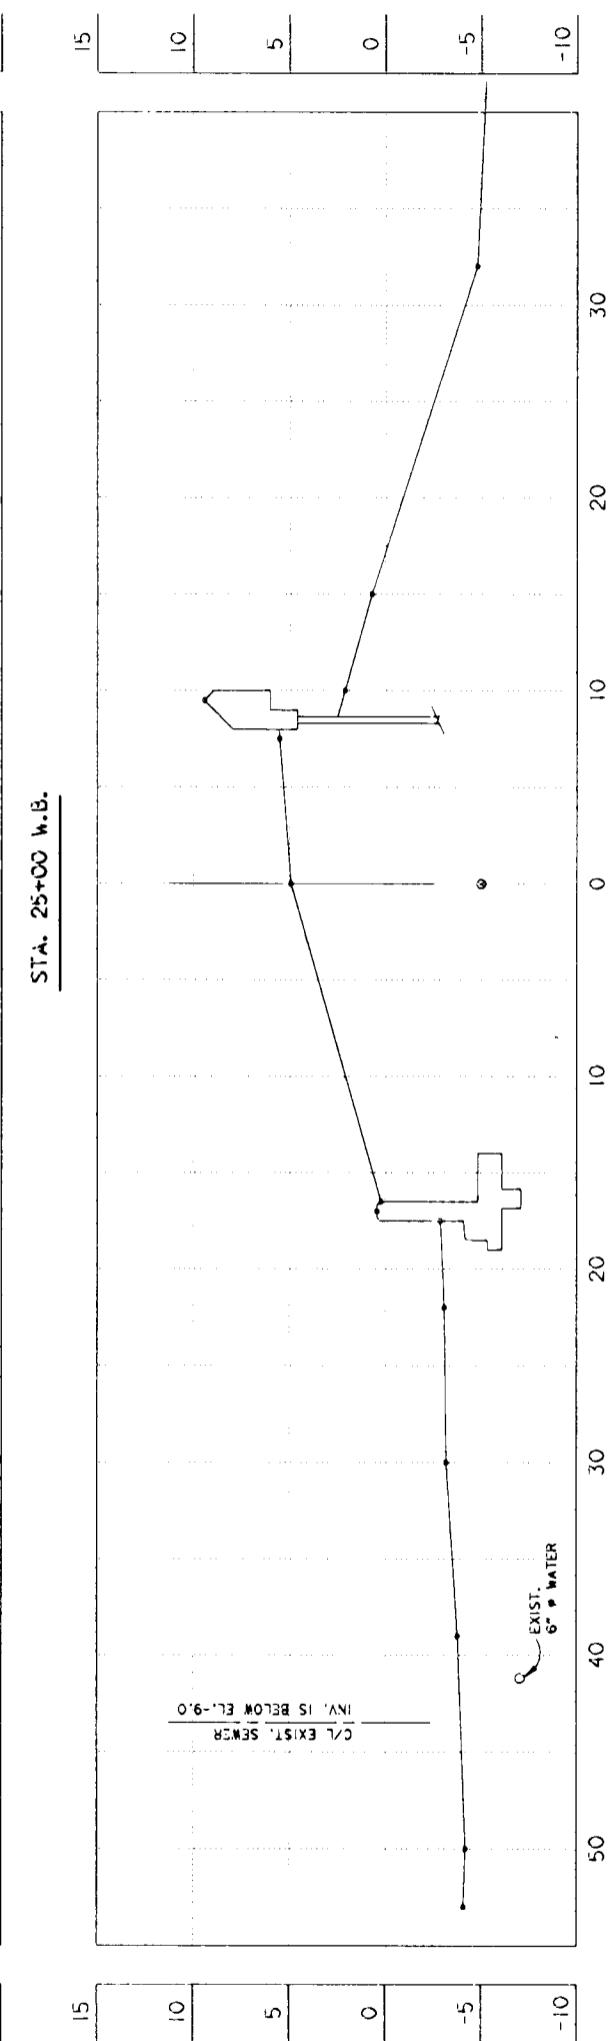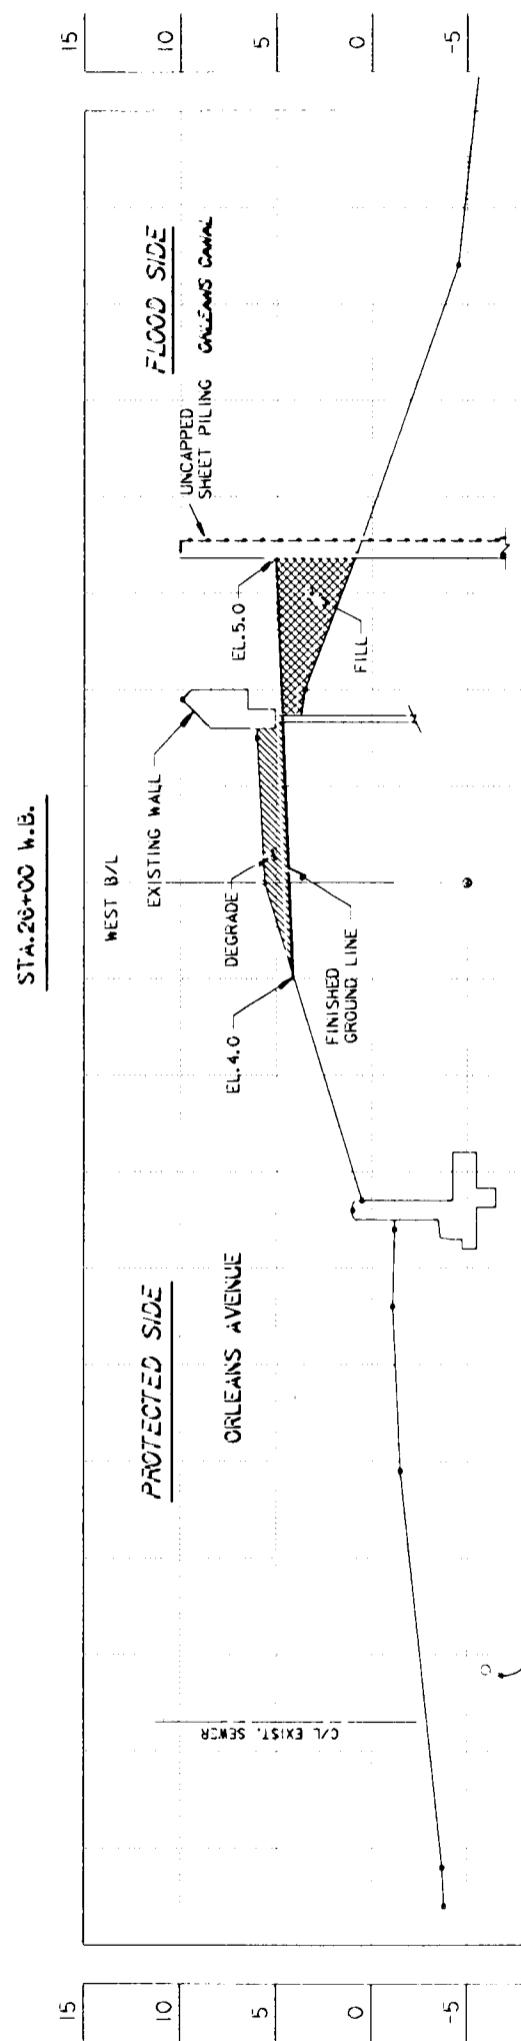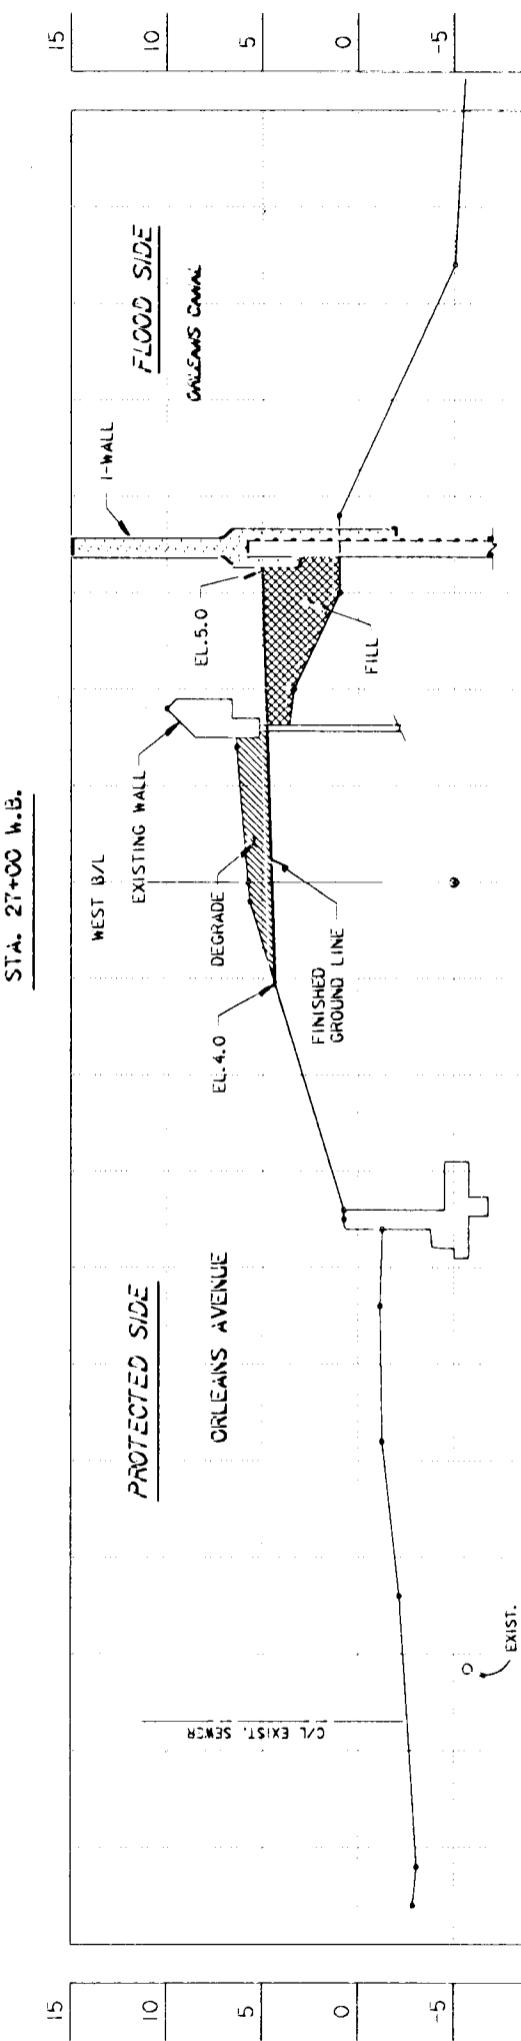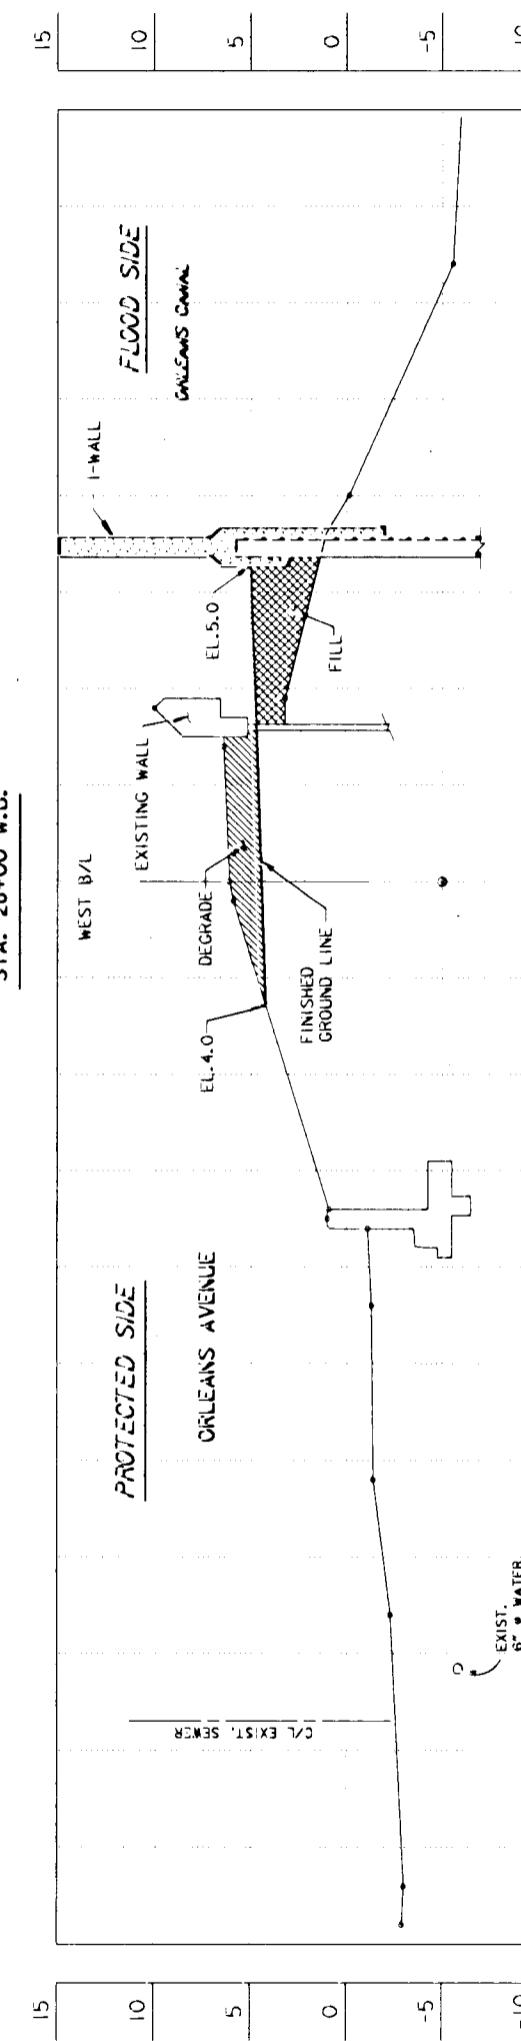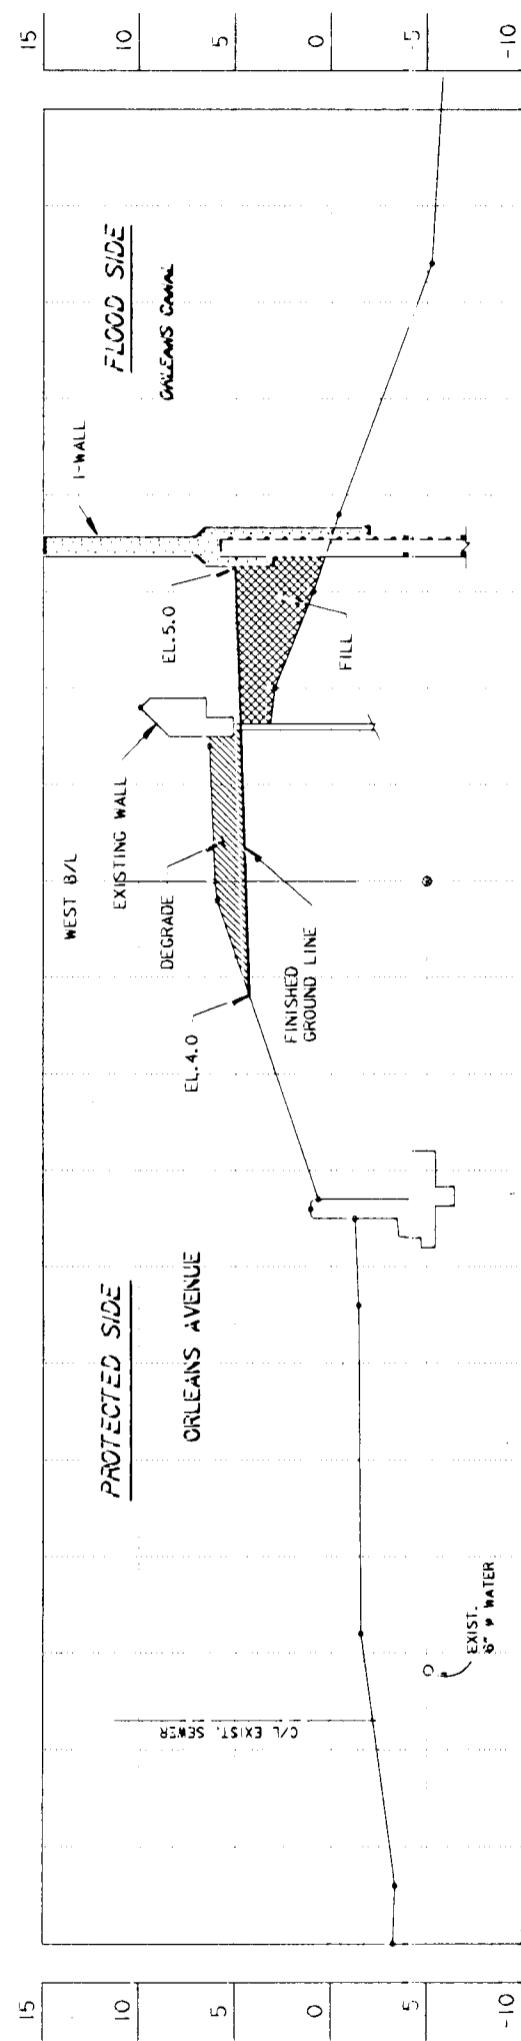


STA. 24+00 w.b.

ELEVATIONS IN FEET - N.G.V.D.


DISTANCE IN FEET

SYMBOL	DESCRIPTION	DATE	APPROVED
REVISIONS			
	U.S. ARMY ENGINEER DISTRICT, NEW ORLEANS CORPS OF ENGINEERS NEW ORLEANS, LOUISIANA		
BOARD OF LEVEE COMMISSIONERS NEW ORLEANS, LOUISIANA	DESIGN ENGINEERING, INC. 3330 W. ESPANADE AVE. #5 METairie, LOUISIANA 70002		
LAKE PONTCHARTRAIN, LA. AND VICINITY HIGH LEVEL PLAN			
NEW ORLEANS LAKEFRONT LEVEE WEST OF I.H.N.C. ORLEANS AVE. CANAL FLOOD PROTECTION IMPROVEMENT PHASE II-D (WEST SIDE B/L STA. 2+39.00 TO STA. 29+07.50) ORLEANS PARISH, LOUISIANA			
CROSS SECTIONS			
DESIGNED BY: J.C. NORQUIST DRAWN BY: C.K. CAPRERA CHECKED BY: T.M. SMITH SUBMITTED BY: DESIGN ENGINEERING, INC. DESIGN ENGINEER	PLOT SCALE: 1'' = 5' PLOT DATE: MARCH 993 FILE NO.: H-4-40205 CADD FILE #: II-D23	DATE: FEB. 1993 PLOT SCALE: 60 PLOT DATE: MARCH 993 FILE NO.: H-4-40205 CADD FILE #: II-D23	DATE: FEB. 1993 PLOT SCALE: 60 PLOT DATE: MARCH 993 FILE NO.: H-4-40205 CADD FILE #: II-D23
SOLICITATION NO.: DACW29-93-B-0042 CNG. 23 OF 24			

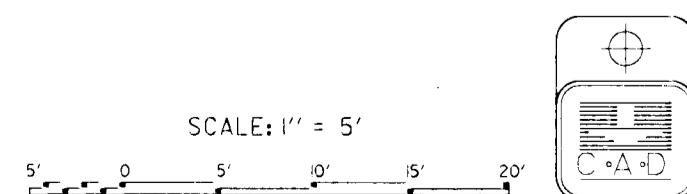


Safety is a Part
of Your Contract


15
10
5
0
-5
-10

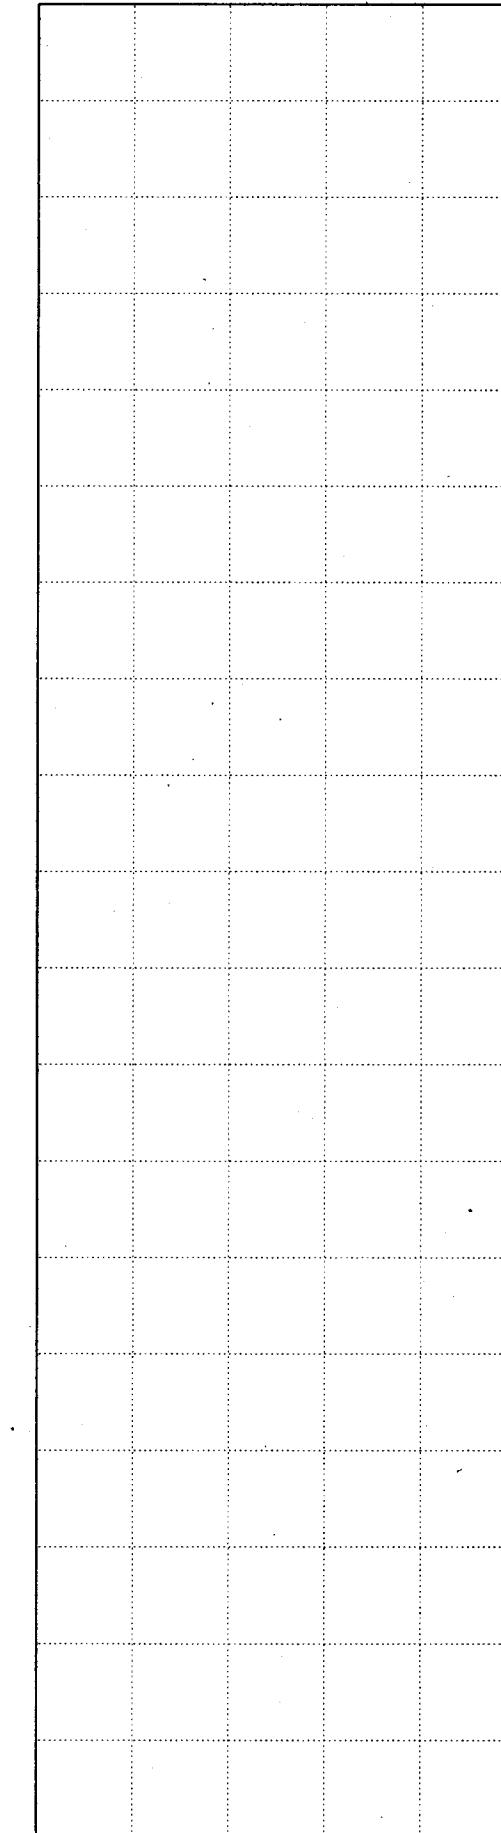


15
10
5
0
-5
-10

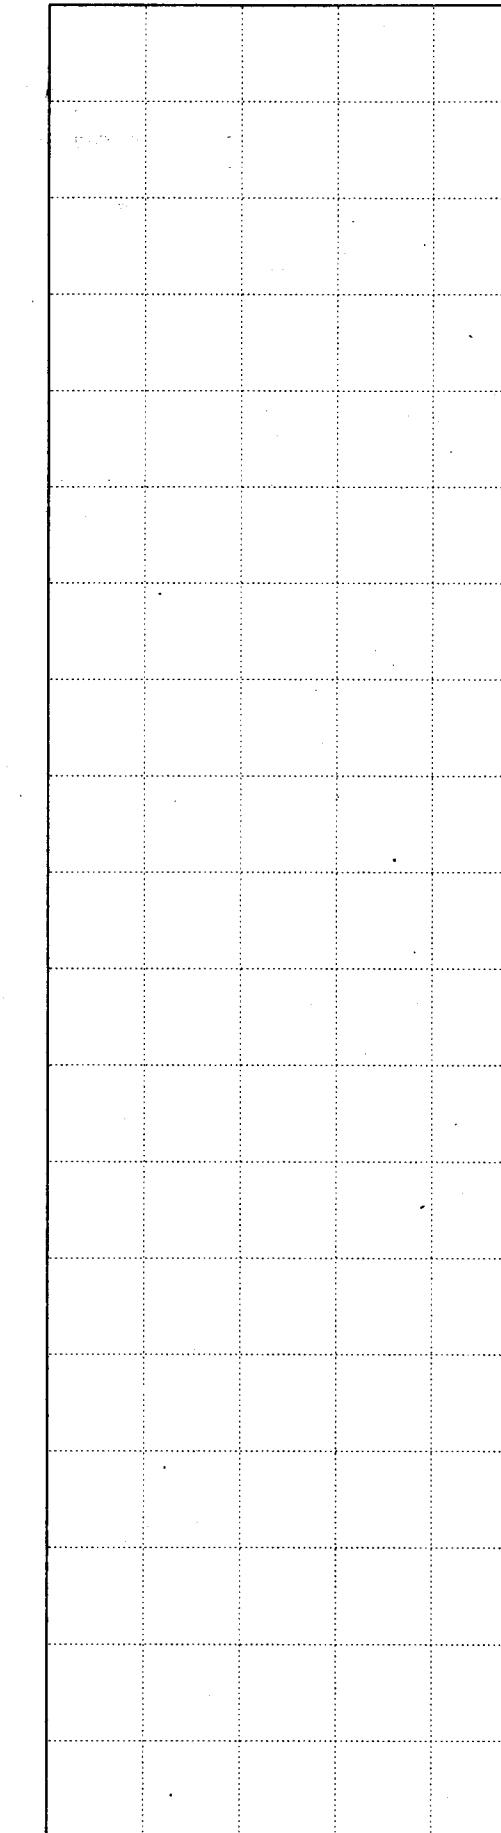


15
10
5
0
-5
-10

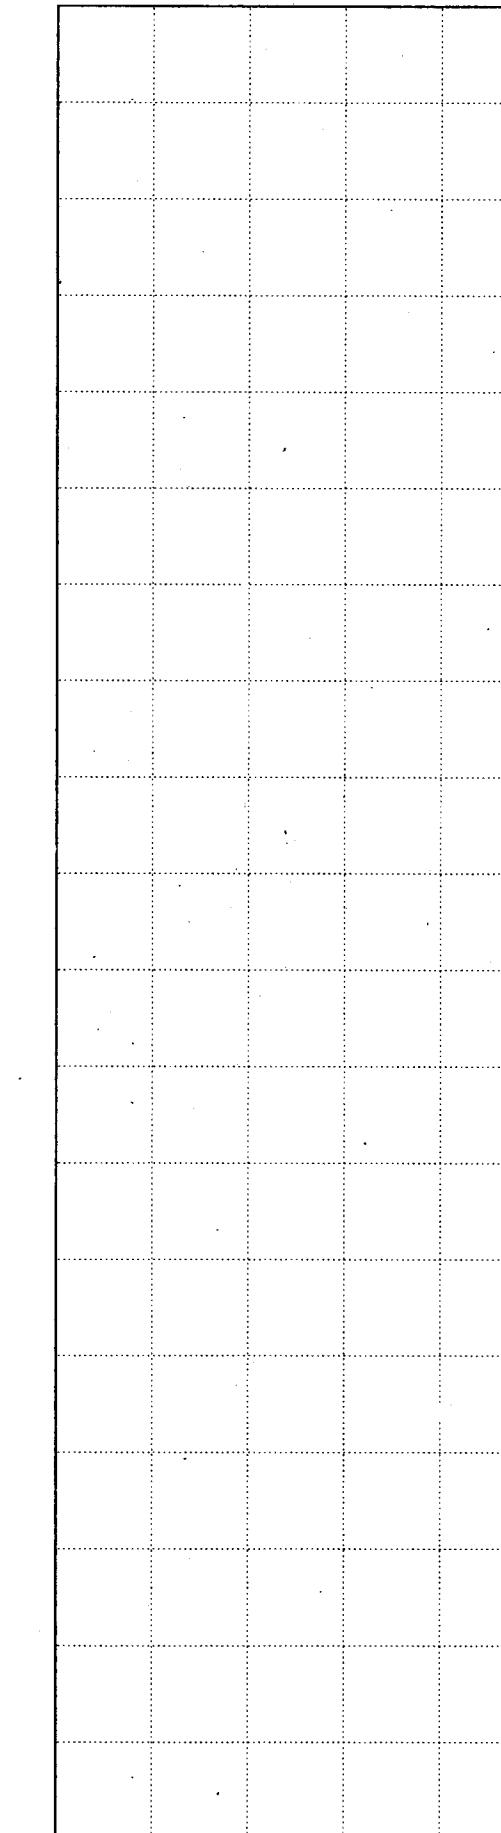

15
10
5
0
-5
-10

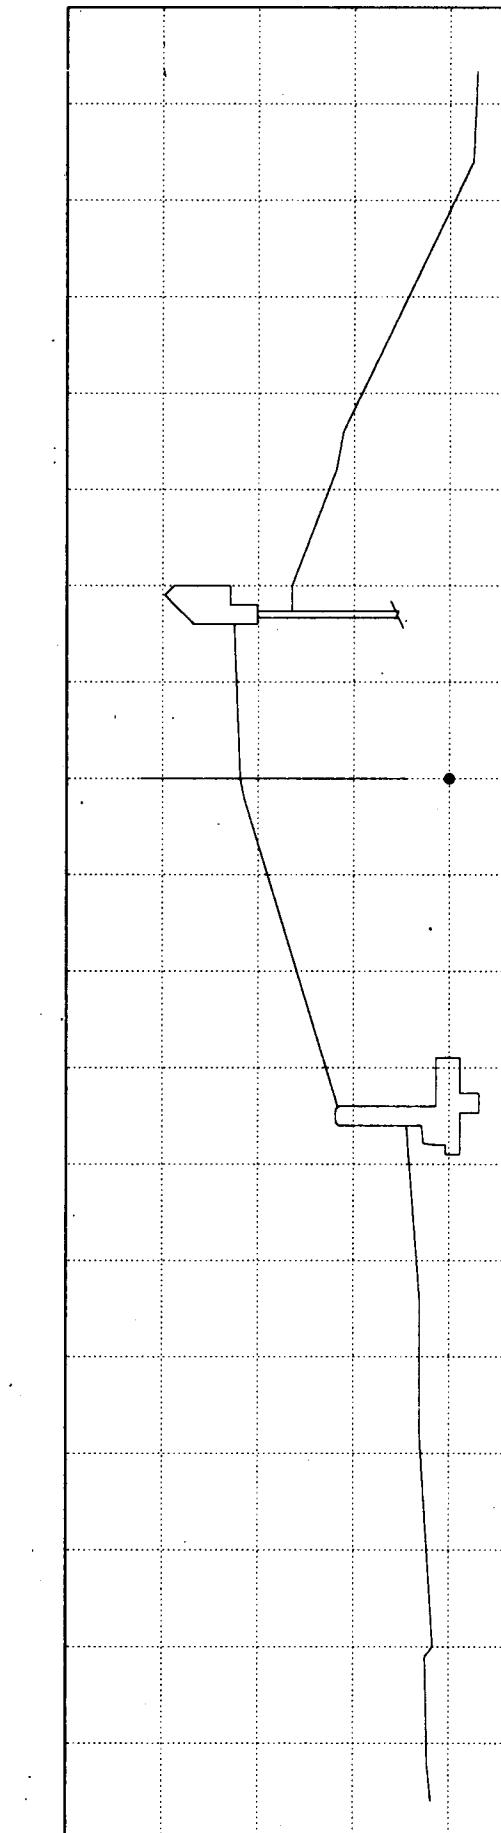


15
10
5
0
-5
-10

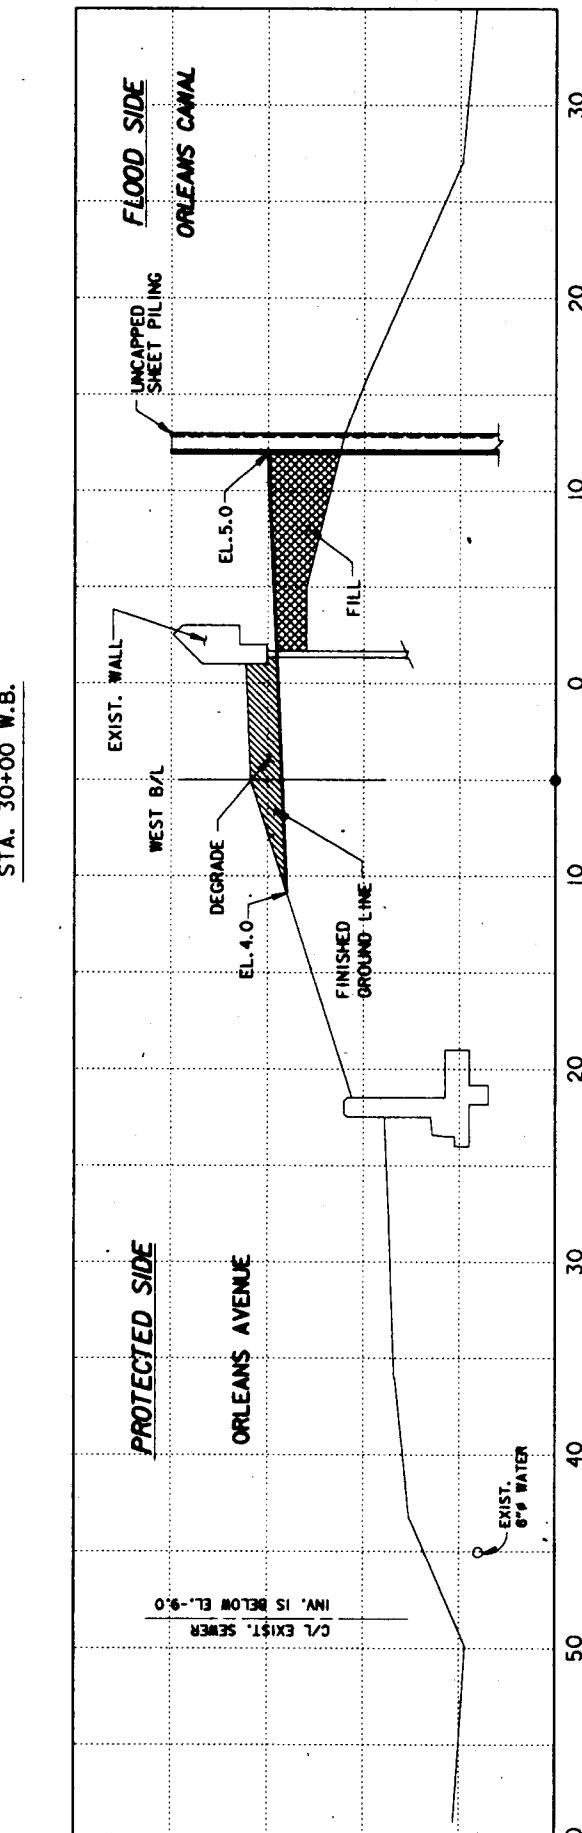

DISTANCE IN FEET


15
10
5
0
-5
-10

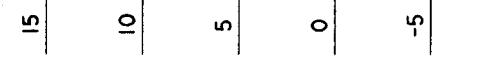

15
10
5
0
-5
-10

15
10
5
0
-5
-10

15
10
5
0
-5
-10

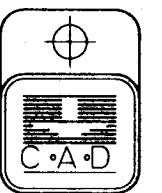

5

4

3

2

1

REVISIONS	DATE APPROVED
	U.S. ARMY ENGINEER DISTRICT, NEW ORLEANS CORPS OF ENGINEERS NEW ORLEANS, LOUISIANA
BOARD OF LEVEE COMMISSIONERS NEW ORLEANS LEVEE DISTRICT NEW ORLEANS, LOUISIANA	DESIGN ENGINEERING, INC. 3330 N. ESPLANADE AVE. S. METAIRIE, LOUISIANA 70002
LAKE PONTCHARTRAIN, LA. AND VICINITY HIGH LEVEL PLAN	
NEW ORLEANS LAKEFRONT LEVEE WEST OF I.H.N.C. ORLEANS AVE. CANAL FLOOD PROTECTION IMPROVEMENT PHASE II-D (WEST SIDE B/L STA. 2+39.00 TO STA. 29+07.50) ORLEANS PARISH, LOUISIANA	
CROSS SECTIONS	
DESIGNED BY: J.C. NOGUEIRA DRAWN BY: C.K. CAPRERA CHECKED BY: T.M. SMITH SUBMITTED BY: DESIGN ENGINEERING, INC. DESIGN ENGINEER	PLOT SCALE: 10 PLOT DATE: MARCH 1993 FILE NO.: H-4-40205 SOLICITATION NO.: DACW29-93-B-0042 DWG. 24 OF 24