


LAKE PONTCHARTRAIN, LOUISIANA AND VICINITY

CHALMETTE AREA PLAN

**BAYOU BIENVENUE
CONTROL STRUCTURE**

PERIODIC INSPECTION REPORT NO. 5

29 MARCH 1988

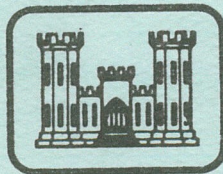

**United States Army
Corps of Engineers**

*... Serving the Army
... Serving the Nation*

New Orleans District

CELMV-ED-GG (CELMN-ED-DG/19 Sep 88) (1105-2-10c) 3d End Mr. Stegall/j1/634-5900
SUBJECT: Lake Pontchartrain, Louisiana and Vicinity, Chalmette Area Plan,
Bayou Bienvenue Control Structure, Periodic Inspection No. 5


DA, Lower Mississippi Valley Division, CE, Vicksburg, MS 39181-0080

17 JAN '89

FOR: Commander, New Orleans District, ATTN: CELMN-ED-DG

The actions taken in the preceding 2d End are satisfactory. No further action is required on this chain of correspondence.

FOR THE COMMANDER:

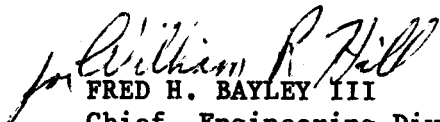
FRED H. BAYLEY III
Chief, Engineering Division

R 4 JAN 2
SA 3 Feb 1988
121 117

CELMN-ED-DG (CELMN-ED-DG/19 Sep 88) 2nd End Mr. Drummond/jaf/2711
SUBJECT: Periodic Inspection No. 5, Bayou Bienvenue Control
Structure

DA, New Orleans District, Corps of Engineers, P.O. Box 60267,
New Orleans, Louisiana 70160-0267 28 December 1988

MEMORANDUM FOR: Commander, Lower Mississippi Valley Division,
ATTN: CELMV-ED-GG

The disposition of comments presented in the 1st End follows.
Paragraph numbers refer to like numbered paragraphs in the
1st End.

a. Para. 4-03b, page IV-1. The comment has been corrected
in our file copy of this report.

b. Para. 6-02a, page VI-1. Upon further investigation, it
was concluded that no deficiency exists with regard to riprap
design. The riprap has not been replenished since construction
in the early 1970's. Based on a comparison to similar structures
in the area, this lifespan for forebay/tailbay bank protection is
normal. The Orleans Levee Board's schedule for riprap replacement
is uncertain. Although they have started plans and specifications
for the job, the project has been afforded a low priority because
of manpower and fiscal constraints. Since the rock depletion poses
no current threat to the structure, it has been categorized as
routine maintenance, to be accomplished according to maintenance
priorities. The situation will be monitored in the interim period
to assure the safety of the structure.

FOR THE COMMANDER:



FREDERIC M. CHATRY
Chief, Engineering Division

1 Encl
wd encl 1



DEPARTMENT OF THE ARMY
NEW ORLEANS DISTRICT, CORPS OF ENGINEERS
P.O. BOX 60267
NEW ORLEANS, LOUISIANA 70160-0267

REPLY TO
ATTENTION OF

CELMN-ED-DG

19 Sep 88

MEMORANDUM FOR: Commander, Lower Mississippi Valley Division,
ATTN: CELMV-ED-G

SUBJECT: Lake Pontchartrain, Louisiana and Vicinity, Chalmette
Area Plan, Bayou Bienvenue Control Structure, Periodic Inspection
No. 5

Subject report is submitted herewith for your approval.

FOR THE COMMANDER:

A handwritten signature in black ink, appearing to read "Frederic M. Chatry", written over a horizontal line.

1 Encl (6 cys)

FREDERIC M. CHATRY
Chief, Engineering Division

S: 30 Dec 88

CELMV-ED-GG (CELMN-ED-DG/19 Sep 88) (1105-2-10c) 1st End Mr. Stegall/jl/634-5900
SUBJECT: Lake Pontchartrain, Louisiana and Vicinity, Chalmette Area Plan,
Bayou Bienvenue Control Structure, Periodic Inspection No. 5

DA, Lower Mississippi Valley Division, CE, Vicksburg, MS 39181-0080

22 NOV '88

FOR: Commander, New Orleans District, ATTN: CELMN-ED-DG


1. The enclosed periodic inspection report is approved subject to the following comments:

a. Para 4-03b, page IV-1. Refer to comment marked in red which should be made in your file copies of this report.

b. Para 6-02a, page VI-1. Prior to preparation of plans and specifications, you should determine the reason displacement of the riprap protection occurred and then size (blanket thickness and gradation) the replacement stone to ensure that a similar deficiency does not reoccur at this location. The results of this determination should be documented in this report to help ensure that local interests will adequately repair these deficient areas.

2. The report should be revised in accordance with the comment in para 1b above, and revised pages should be submitted to this office by 30 Dec 88.

FOR THE COMMANDER:


FRED H. BAYLEY III.
Chief, Engineering Division

Encl (6 cys)
wd 2 cys

LAKE PONTCHARTRAIN, LOUISIANA AND VICINITY

CHALMETTE AREA PLAN

BAYOU BIENVENUE CONTROL STRUCTURE

PERIODIC INSPECTION REPORT NO. 5

29 MARCH 1988

U. S. ARMY ENGINEER DISTRICT

CORPS OF ENGINEERS

NEW ORLEANS, LA

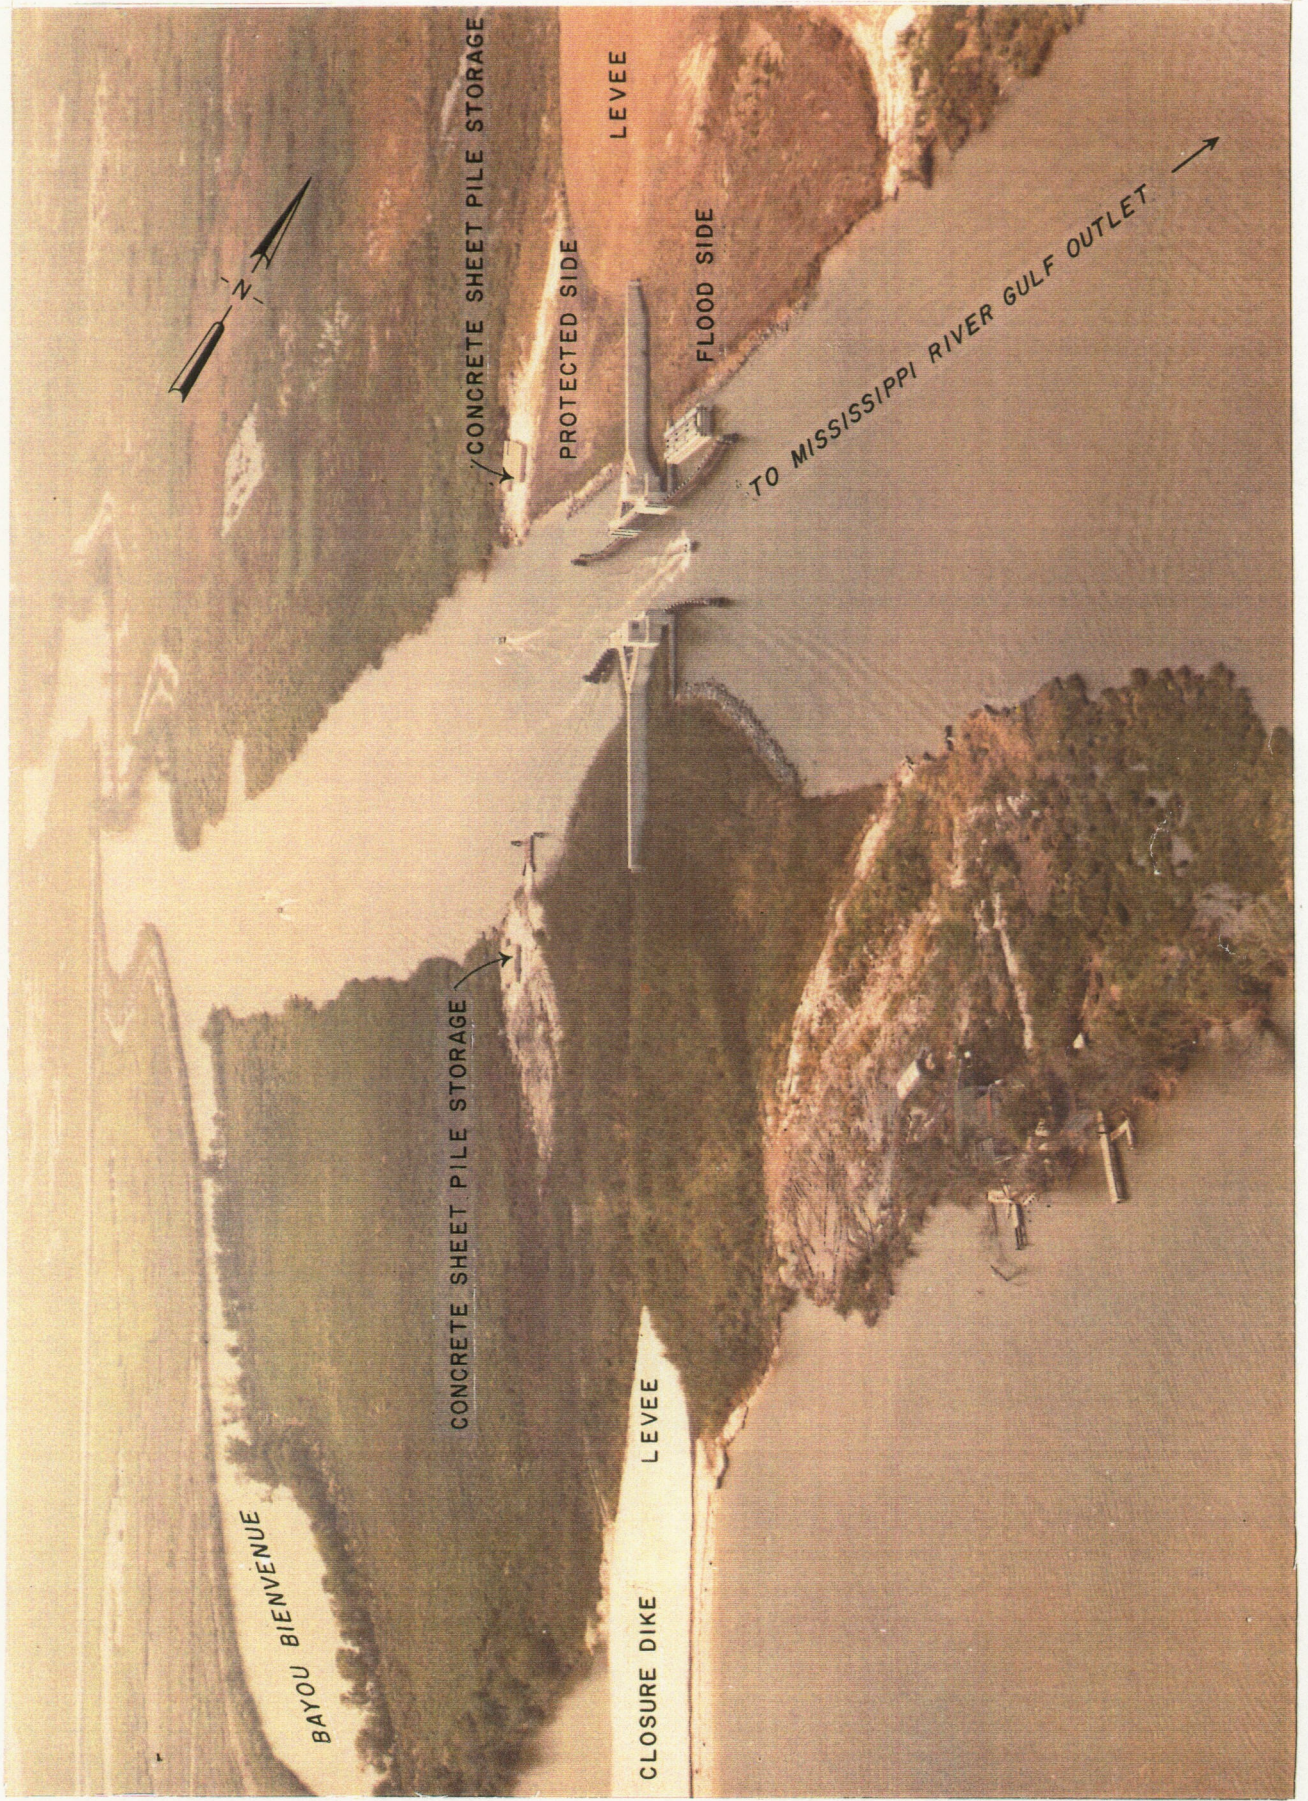


PHOTO TAKEN 27 SEPTEMBER 1974

BAYOU BIENVENUE CONTROL STRUCTURE

SUMMARY

The Bayou Bienvenue Control Structure was inspected on 29 March 1988 by representatives of NOD and the Orleans Levee Board. The structure was found to be stable and in good operating condition. Minor deficiencies are noted within.

BAYOU BIENVENUE CONTROL STRUCTURE

PERIODIC INSPECTION REPORT NO. 5

TABLE OF CONTENTS

<u>Para. No.</u>	<u>Description</u>	<u>Page No.</u>
<u>SECTION I - INTRODUCTION</u>		
1-01	Authority	I-1
1-02	Purpose and Scope	I-1
1-03	Datum	I-1
1-04	Previous Inspections	I-1
<u>SECTION II - PROJECT AUTHORIZATION AND BACKGROUND</u>		
2-01	General	II-1
<u>SECTION III - CURRENT OPERATION AND MAINTENANCE DATA</u>		
3-01	Maintenance & Operating Problems	III-1
3-02	Actions on Deficiencies from Last Inspection	III-1
<u>SECTION IV - REVIEW OF DESIGN AND ANALYSIS OF INSTRUMENTATION</u>		
4-01	Design Review	IV-1
4-02	Design Stress	IV-1
4-03	Analysis of Instrumentation Instrumentation Drawings	IV-1
<u>SECTION V - INSPECTION</u>		
5-01	Inspection Team	V-1
5-02	Orientation	V-2
5-03	Observations Photographs	V-2
<u>SECTION VI - CONCLUSIONS AND REMEDIAL ACTIONS</u>		
6-01	Conclusion	VI-1
6-02	Remedial Action	VI-1
6-03	Next Inspection	VI-1

SECTION I - INTRODUCTION

1-01 Authority. Authority is provided by ER 1110-2-100 subject "Periodic Inspection and Continuing Evaluation of Completed Civil Works Structures".

1-02 Purpose and Scope. This report presents the results and conclusions of the fifth periodic inspection of the Bayou Bienvenue Control Structure.

1-03 Datum. All elevations in this report, except where otherwise indicated, are in feet and refer to the National Geodetic Vertical Datum of 1929 (NGVD) formally mean sea level (m.s.l.).

1-04 Previous Inspections. Past inspections of the Bayou Bienvenue Control Structure are included in the following reports:

<u>Report No.</u>	<u>Inspection Date</u>
1	31 October 1973
2	27 July 1979
3	31 March 1983
4	7 March 1985 (Dewatered)

SECTION II - PROJECT DESCRIPTION AND BACKGROUND

2-01 General. The description of the structure, historical, and other general background information, are included in report No. 1, which also contains selected construction drawings illustrating typical sections and details. This report is supplementary to previously numbered reports.

SECTION III - OPERATION AND MAINTENANCE

3-01 Operating and Maintenance Problems. There were no accidents nor major operating problems since the previous inspection of the structure on 7 March 1985.

3-02 Actions on Deficiencies from the Last Inspection. The Orleans Levee Board has accomplished all remedial actions listed in Periodic Inspection Report No. 4, Section VI (6-02), except for placing riprap in deficient areas near the guidewalls (para. f).

SECTION IV - REVIEW OF DESIGN AND ANALYSIS OF INSTRUMENTATION

4-01 Review of Design. The original design was made in accordance with standard engineering practice and with criteria as set forth in engineering manuals for civil work construction, published by the Office of the Chief of Engineers. The original design criteria was given in report No. 1, Section III. Therefore a detailed review of the design is not required at this time.

4-02 Design Stress. The original design stress criteria as contained in Engineering Manual No. 1110-1-2101, dated November 1963, have not changed.

4-03 Analysis of Instrumentation.

a. Settlement Survey. Present survey, dated 25 February 1988, indicates no unusual settlement or rebound at any point of the structure. (See Plates 2 thru 7).



b. Scour. In the north approach channel, scour of about 4 feet is indicated for most of the cross sections. No significant changes are indicated for the remaining sections. Stone movement is evident between Stations 8+00 and 9+00 near the west side of the channel. Appreciable scour has occurred in the south approach channel between Stations 16+00 to 19+50. Scour holes of 6 feet and 9 feet are indicated at Stations 16+50 and 17+00 respectively. This scour is far away and does not

endanger the integrity and safety of the structure at this time. The scour will be monitored very closely in future surveys. (See Plates 8 thru 18).

c. Overbank Ranges. Present survey indicates no significant scour or shoaling. (See Plates 19 thru 23).


BAYOU BIENVENUE CONTROL STRUCTURE
INSTRUMENTATION DRAWINGS

<u>Plate No.</u>	<u>Title</u>	<u>File No.</u>
1	Location Map	H-4-24326
2	Settlement Reference Marks-Plan and Profile	H-4-26857
3	Settlement Reference Marks-Differential Settlement Chart	H-4-26857
4	Settlement Reference Marks-Differential Settlement Chart	H-4-26857
5	Settlement Reference Marks-Wingwall Plans and Tabulation	H-4-26857
6	Settlement Reference Marks-Wingwall Differential Settlement Chart	H-4-26857
7	Settlement Reference Marks-Wingwall Differential Settlement Chart	H-4-26857
8	Scour and Overbank Survey - Approach Channels - Closure Dam and Levees	
9	Comparative Profile	
10	Comparative Section	
11	Comparative Section	
12	Comparative Section	
13	Comparative Section	
14	Comparative Section	
15	Comparative Section	
16	Comparative Section	
17	Comparative Section	
18	Comparative Section	
19	Overbank Ranges	
20	Northwest Wingwall	
21	Northeast Wingwall	
22	Southwest Wingwall	
23	Southeast Wingwall	


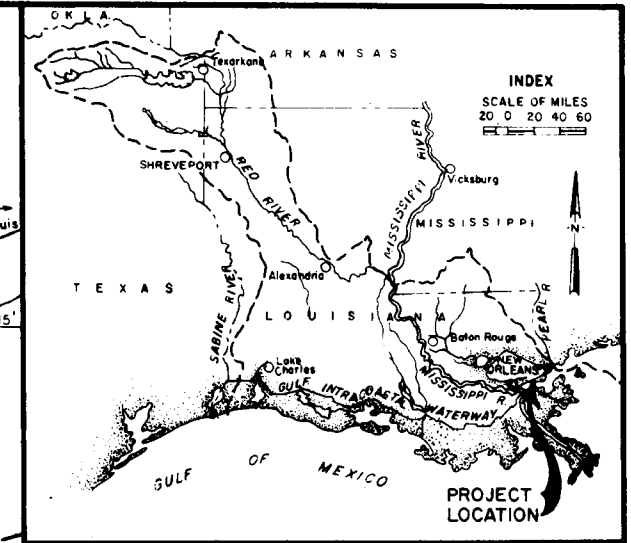
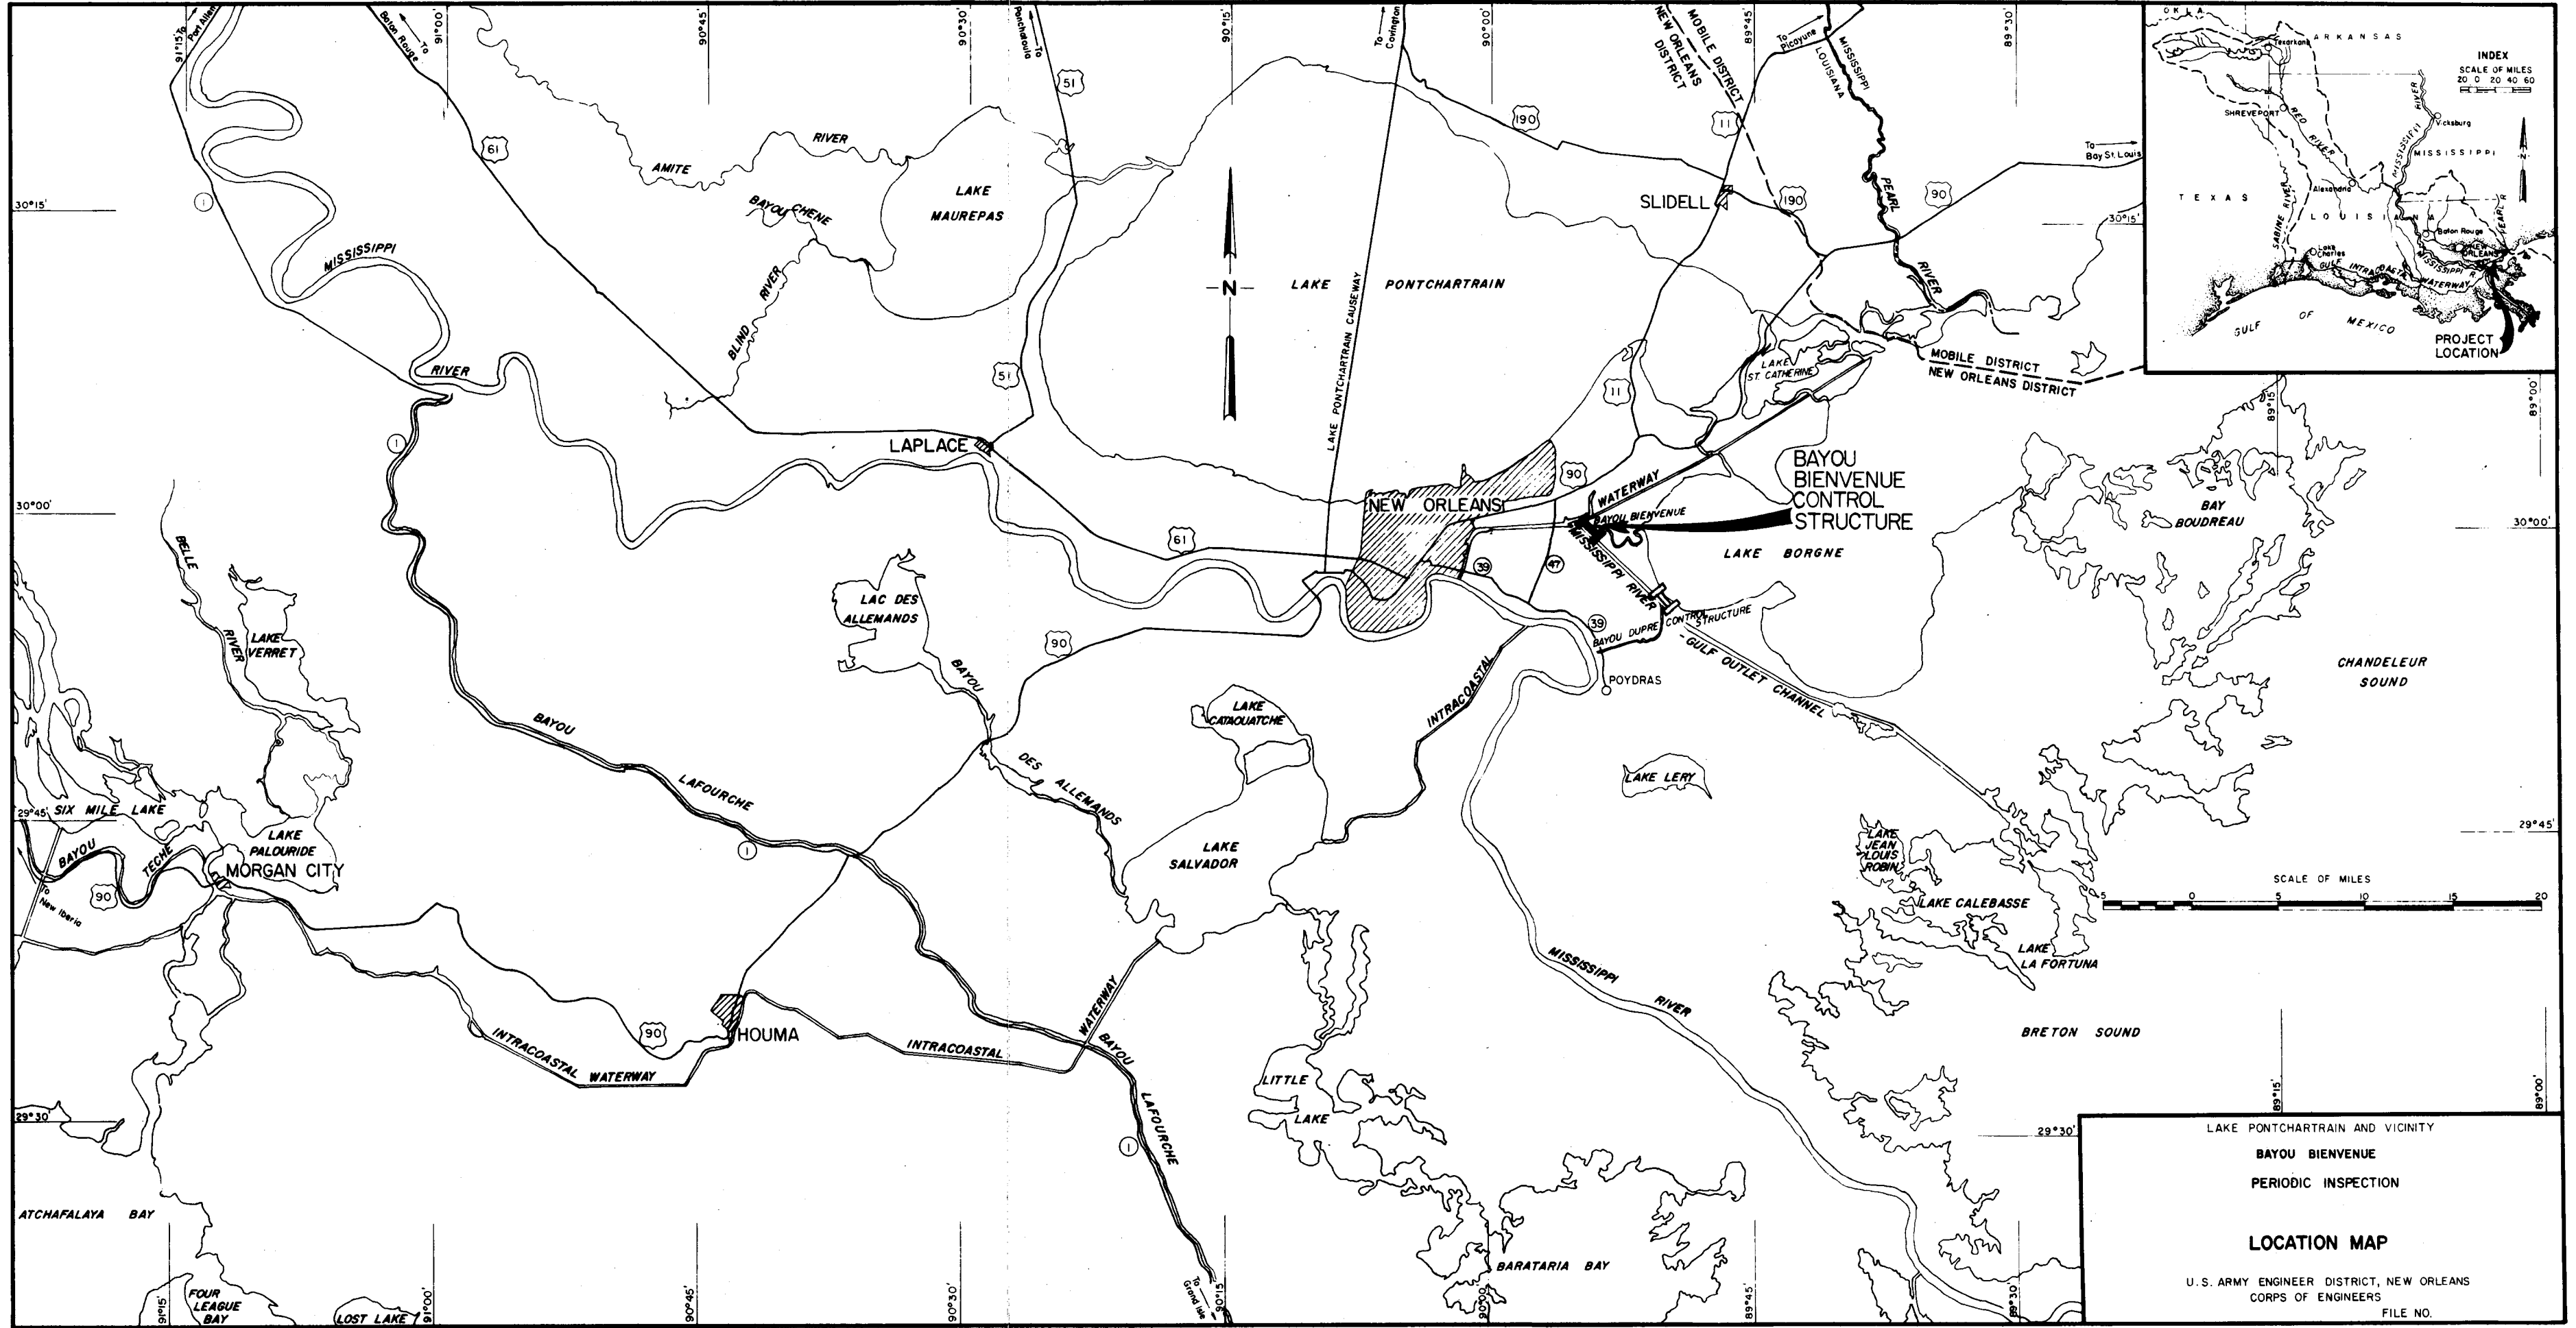


SCALE OF MILES
0 5 10 15 20

LAKE PONTCHARTRAIN AND VICINITY
BAYOU BIENVENUE
 PERIODIC INSPECTION
LOCATION MAP
 U. S. ARMY ENGINEER DISTRICT, NEW ORLEANS
 CORPS OF ENGINEERS
 FILE NO.

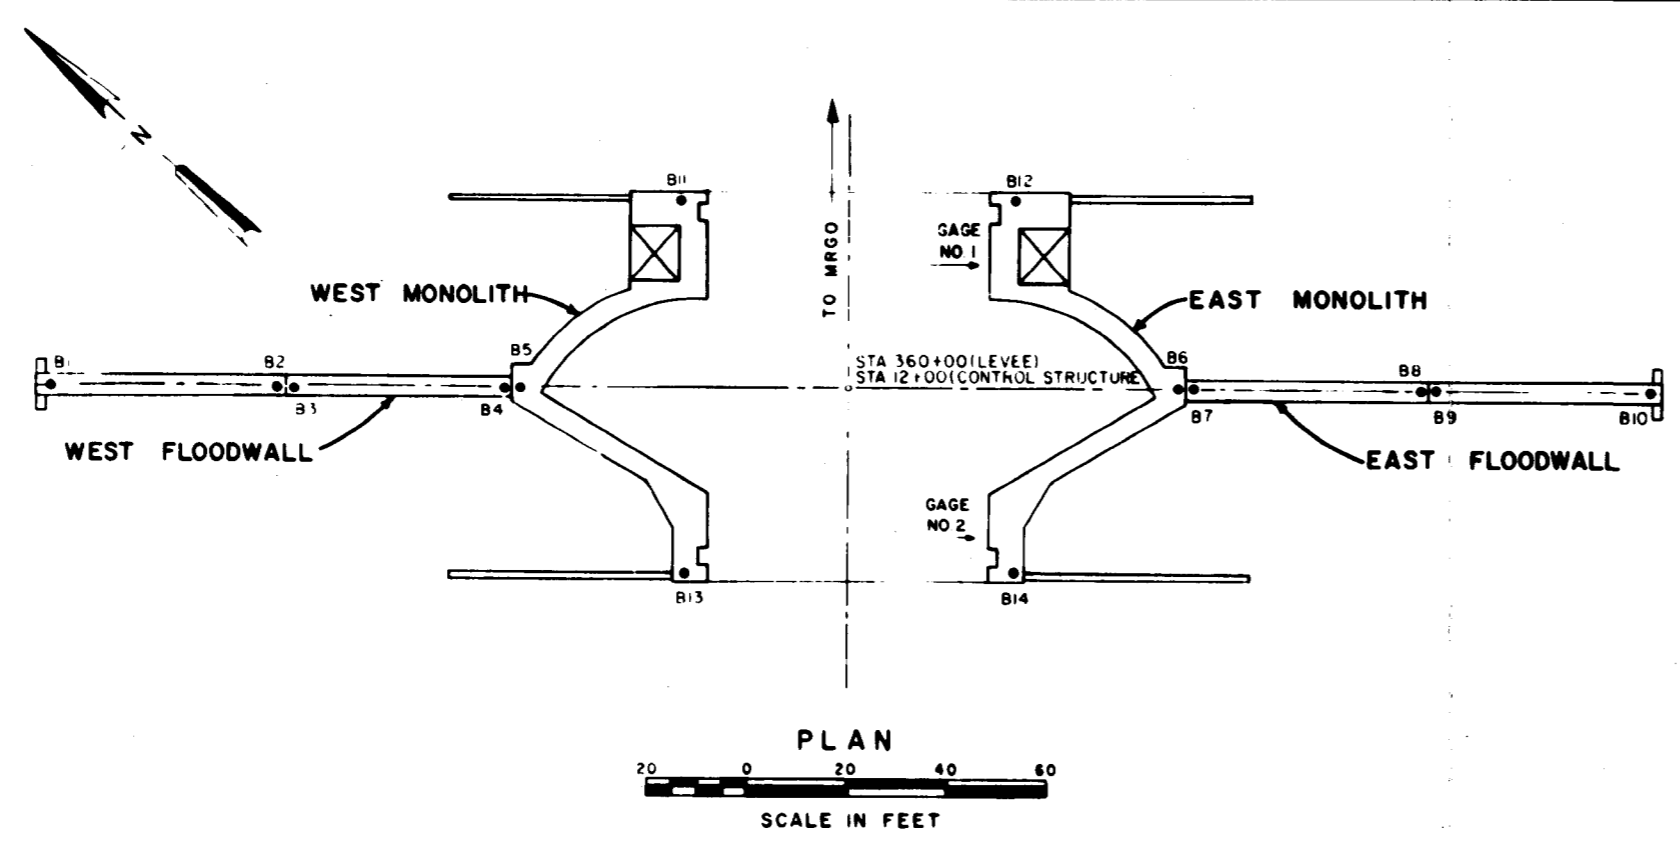



		SETTLEMENT REFERENCE MARKS																
NO OF REFERENCE MARK		B1	B2	B3	B4	B5	B6	B7	B8	B9	B10	B11	B12	B13	B14	TEMP	GAGE 1	GAGE 2
INITIAL DATE		6-25-74	6-25-74	6-25-74	6-25-74	6-25-74	6-25-74	6-25-74	6-25-74	6-25-74	6-25-74	6-25-74	6-25-74	6-25-74	6-25-74			
ORIGINAL READINGS		16.85	16.88	16.87	16.87	16.89	16.86	16.84	16.80	16.81	16.75	16.87	16.86	16.91	16.88	79°	1.9	1.9
22 OCT 1984		16.46	16.70	16.69	16.78	16.82	16.86	16.81	16.70	16.73	16.46	16.86	16.87	16.88	16.88	80°	2.5	2.5
11 AUG 1986		16.48	16.72	16.71	16.81	16.86	16.88	16.82	16.71	16.74	16.45	16.89	16.90	16.92	16.91	78°	1.1	1.0
3 MAR 1987		16.45	16.69	16.68	16.78	16.83	16.85	16.80	16.68	16.71	16.42	16.86	16.87	16.89	16.85	60°	1.9	1.7
25 FEB 1988		16.42	16.71	16.70	16.82	16.86	16.90	16.85	16.72	16.76	16.46	16.90	16.92	16.93	16.93	50°	-0.3	0.1

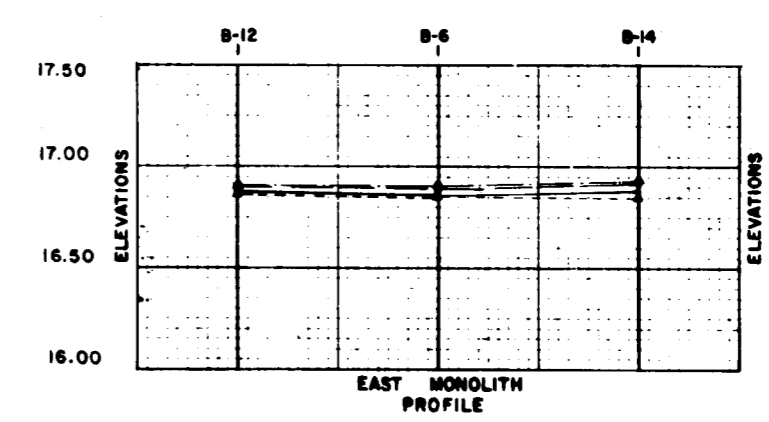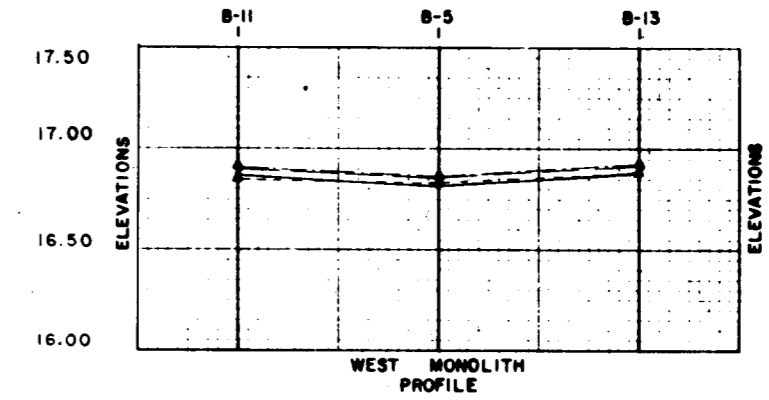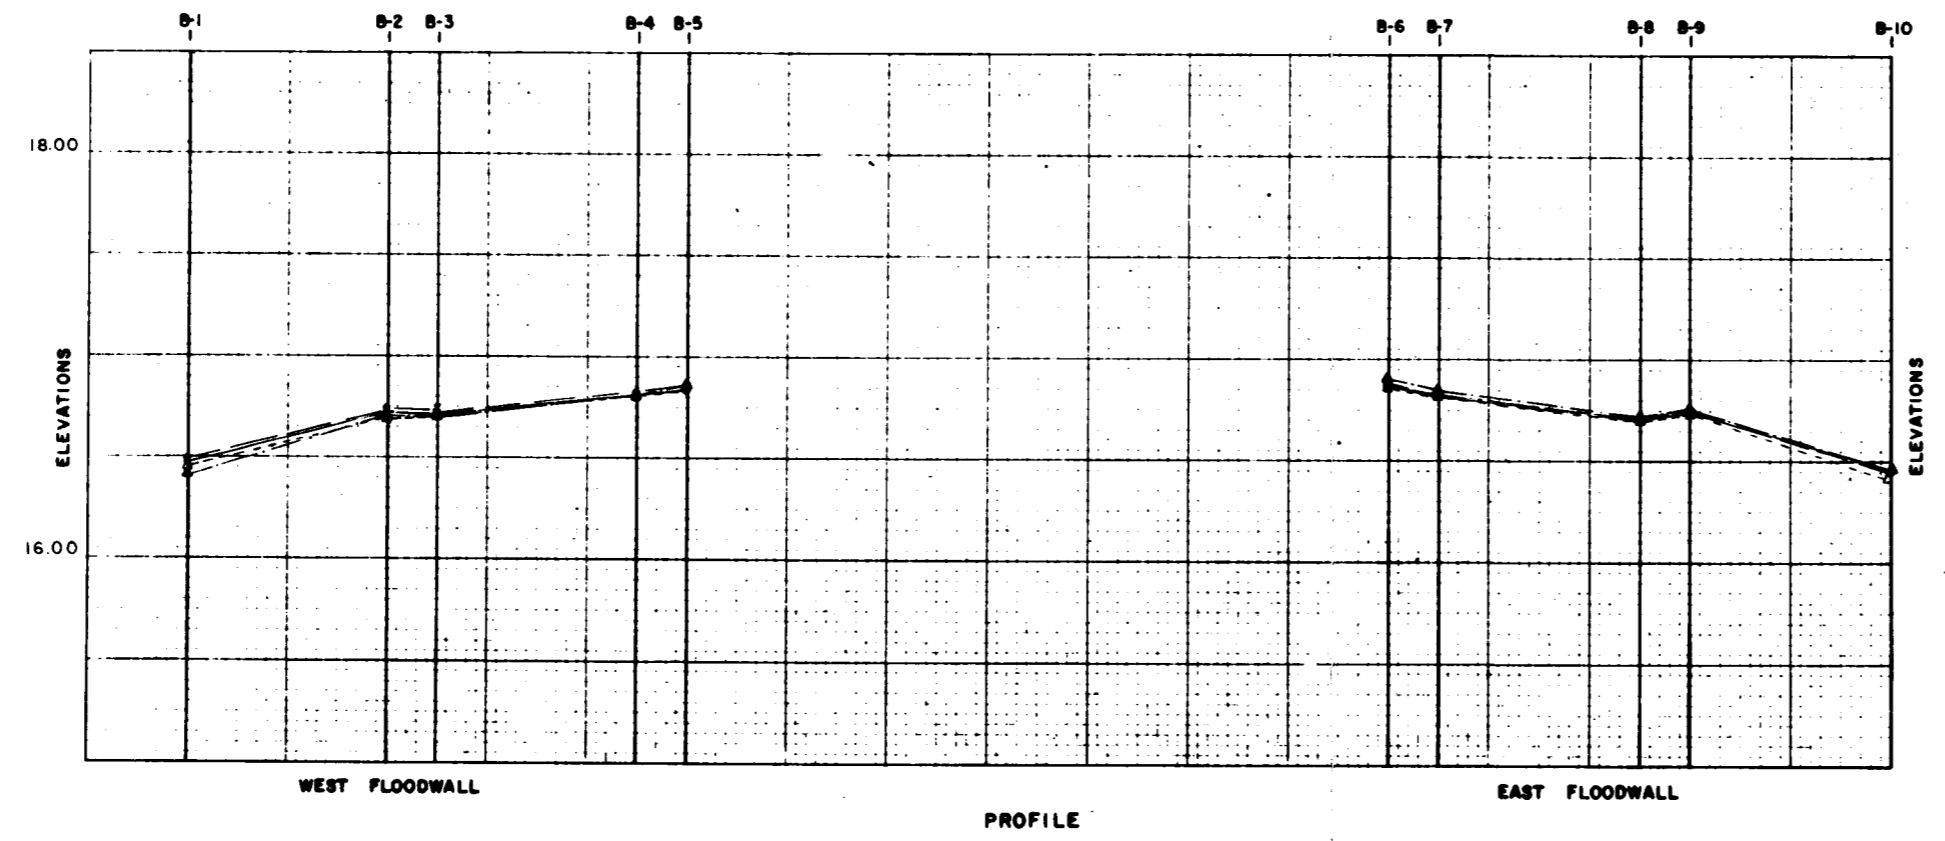


LEGEND
 ● 22 OCT 1984
 ○ 11 AUG 1986
 △ 3 MAR 1987
 ▲ 25 FEB 1988
 ■

LAKE PONTCHARTRAIN AND VICINITY
 BAYOU BIENVENUE
 PERIODIC INSPECTION
SETTLEMENT REFERENCE MARKS
 PLAN AND PROFILE
 U.S. ARMY ENGINEER DISTRICT, NEW ORLEANS
 CORPS OF ENGINEERS
 FILE NO. H-4-28857



WEST MONOLITH

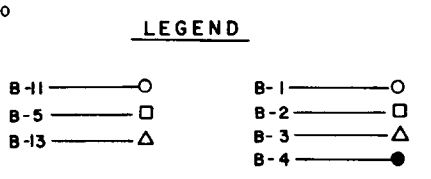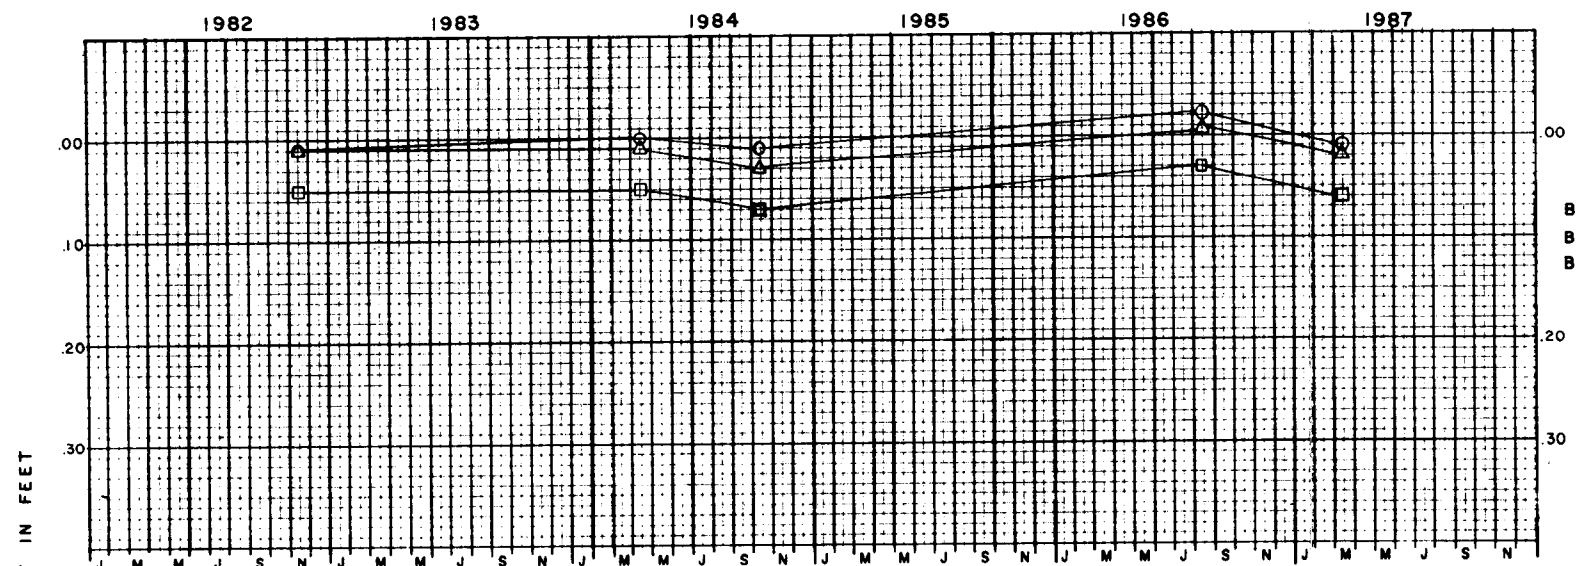


WEST FLOODWALL

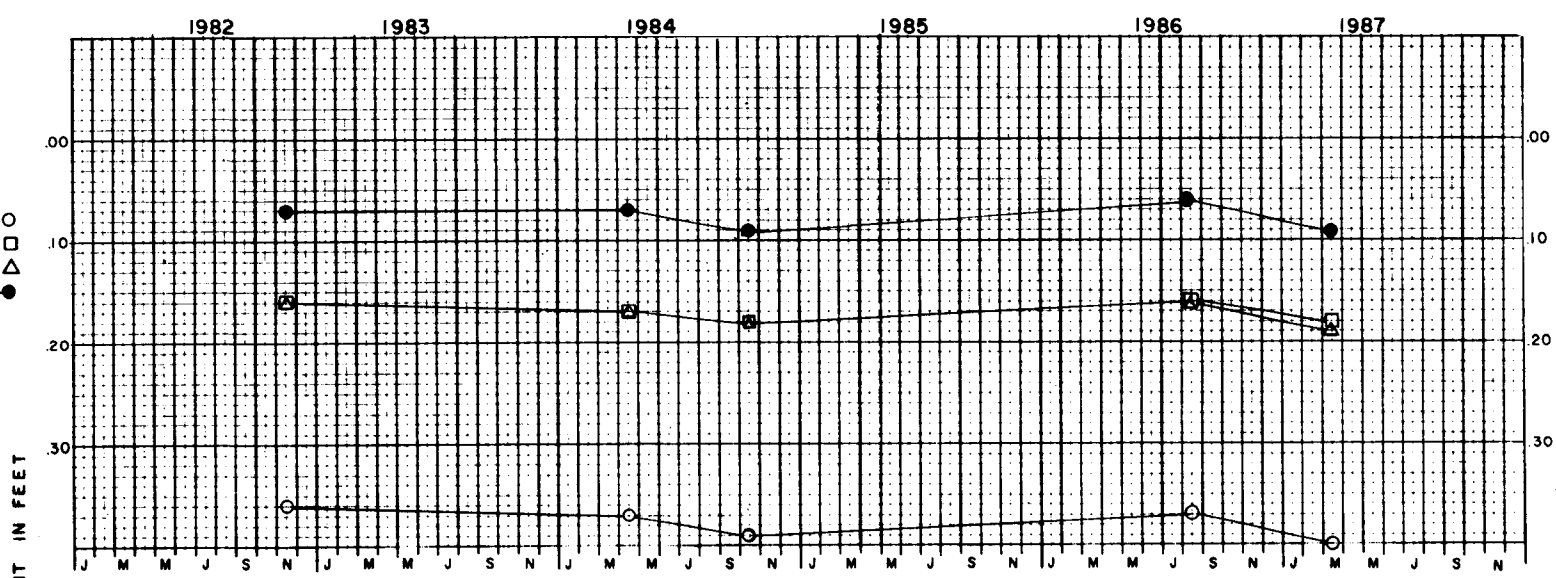

EAST MONOLITH

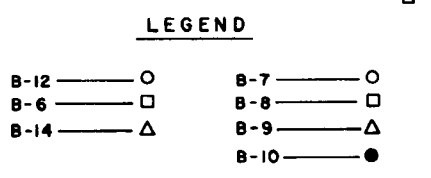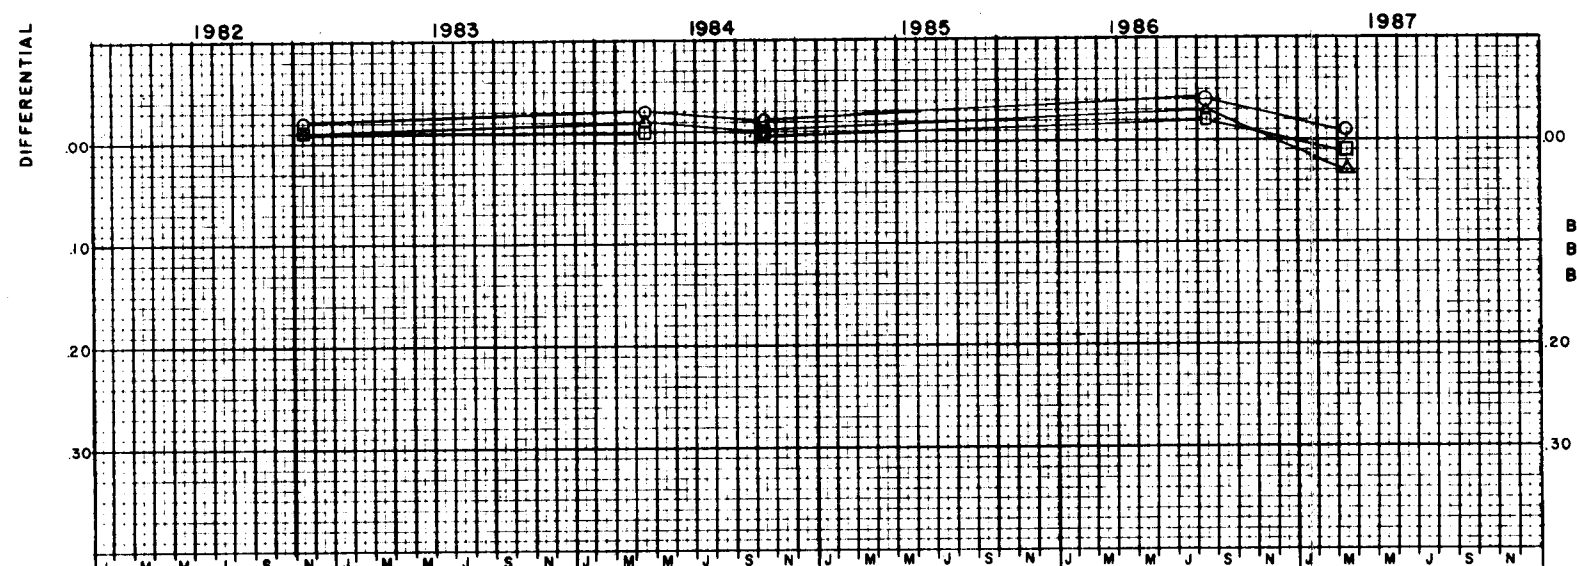

EAST FLOODWALL

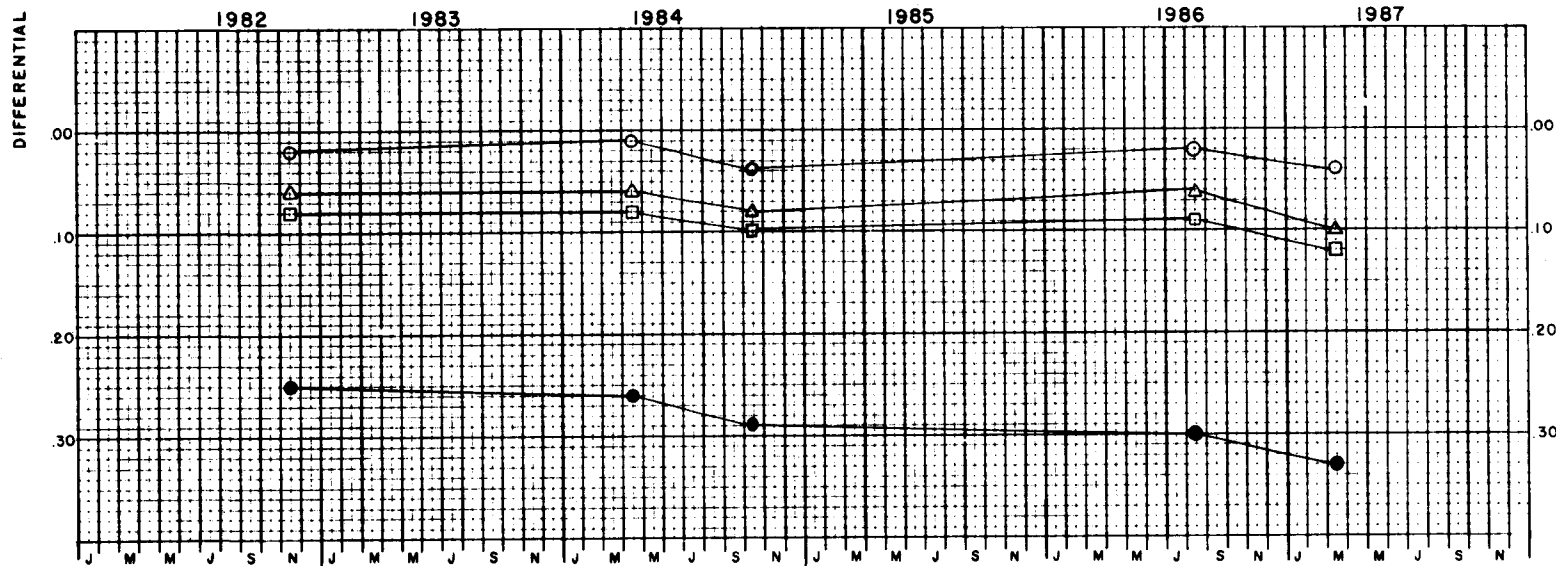

OBSERVATIONS	INITIAL DATE	DISTANCES BETWEEN REFERENCE MARKS						
		B2 TO B3	B4 TO B5	B6 TO B7	B8 TO B9	B10 TO B11	B12 TO B13	B14 TO B15
		4.97	3.98	13.35	64.17	64.19	2.48	5.00
	29 NOV. 1982	5.04	4.02		64.25	64.25	2.54	5.08
	13 APR. 1984	5.02	4.02				2.55	5.08
	22 OCT. 1984	5.02	4.02				2.54	5.08
	10 AUG. 1986	5.02	4.02				3.58 [Ⓞ]	5.08
	3 MAR. 1987	5.02	4.03				2.55	5.08

NOTE:
 For location and tabulation of settlement reference marks see plate
[Ⓞ]Appears to be a survey error.



LAKE PONTCHARTRAIN AND VICINITY
 BAYOU BIENVENUE
 PERIODIC INSPECTION

**SETTLEMENT REFERENCE MARKS
 DIFFERENTIAL SETTLEMENT CHART**


U.S. ARMY ENGINEER DISTRICT, NEW ORLEANS
 CORPS OF ENGINEERS

FILE NO. H-4-26857



WEST MONOLITH

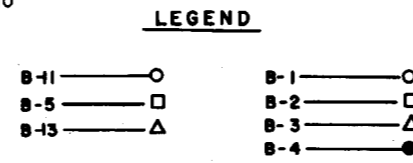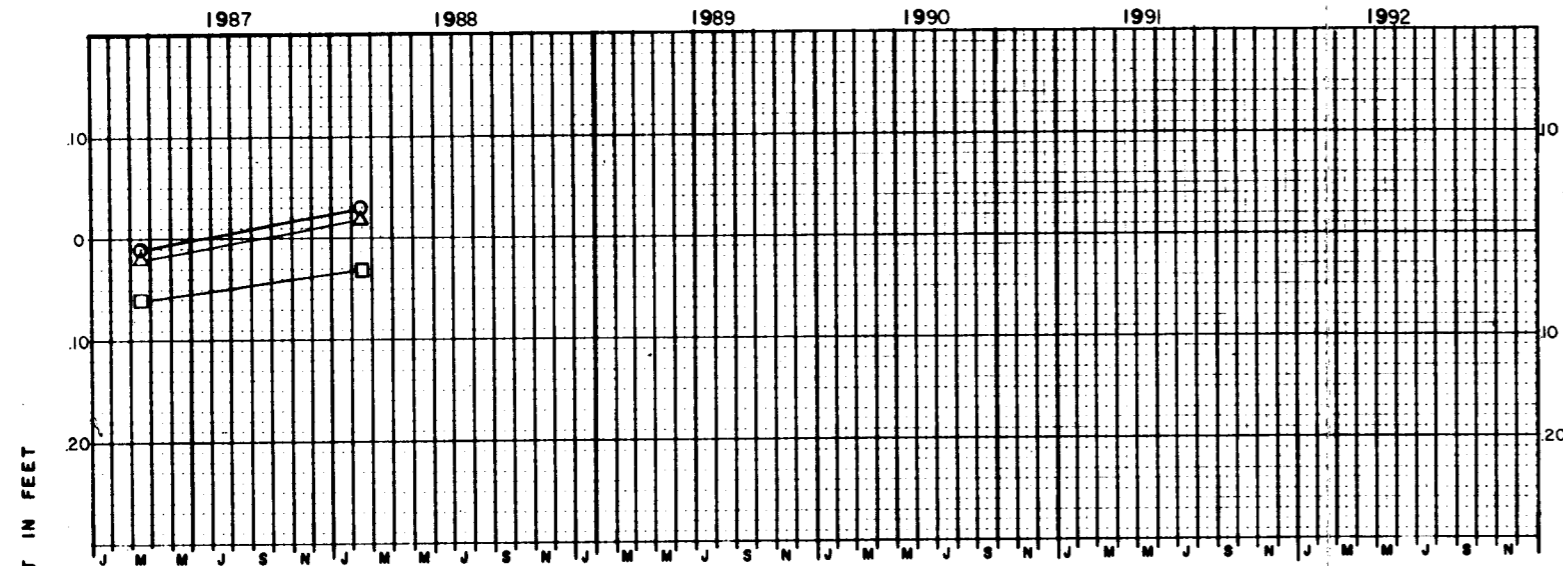


WEST FLOODWALL

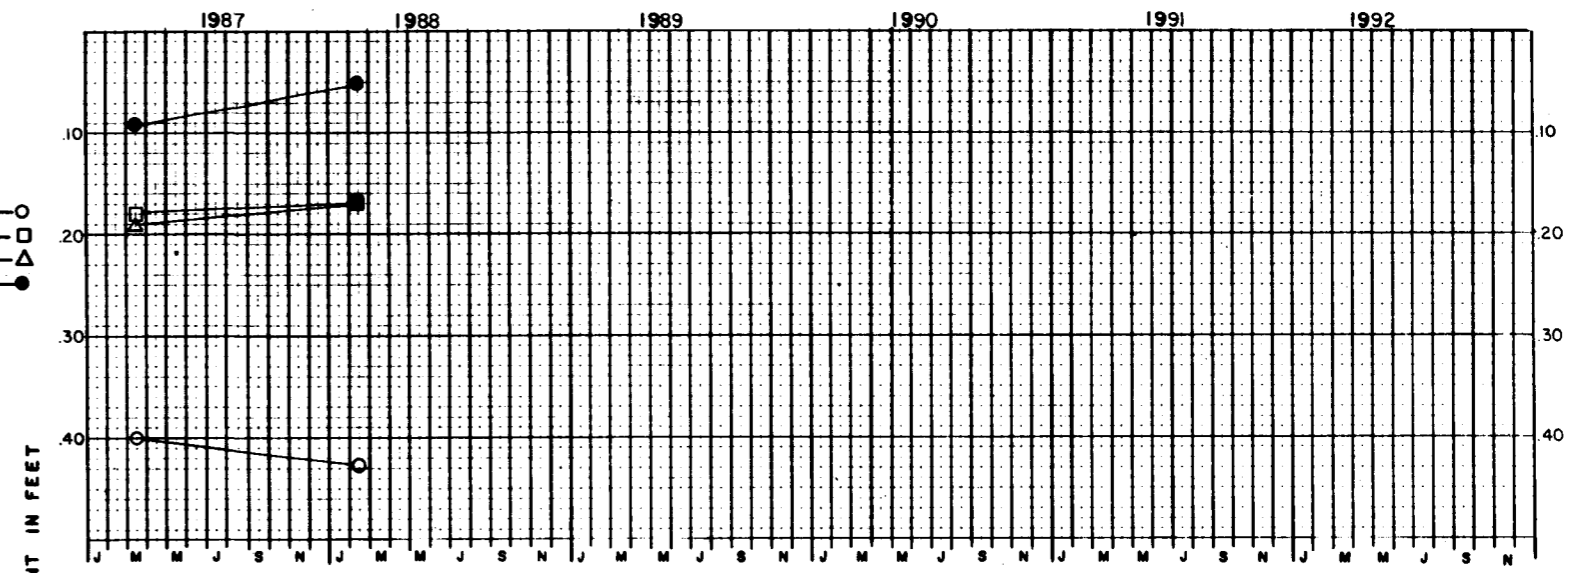

EAST MONOLITH

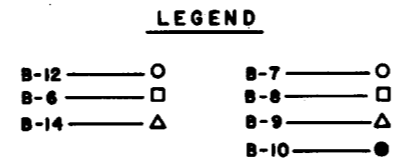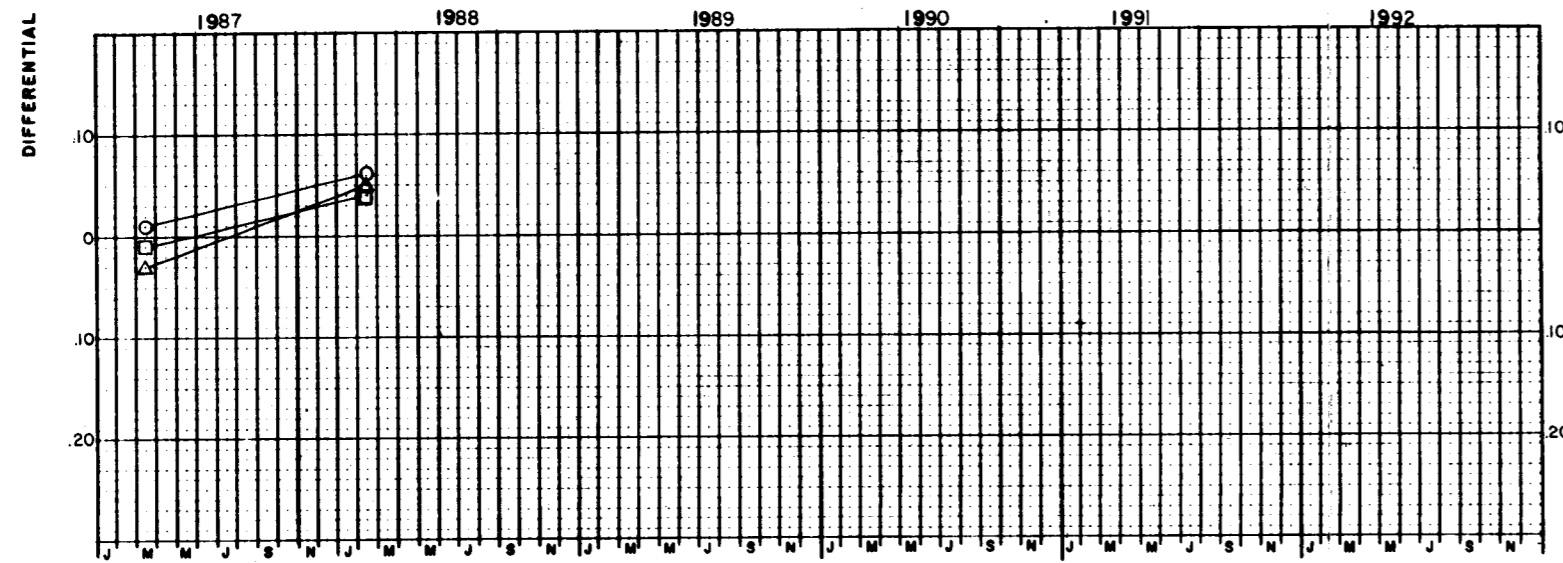

EAST FLOODWALL

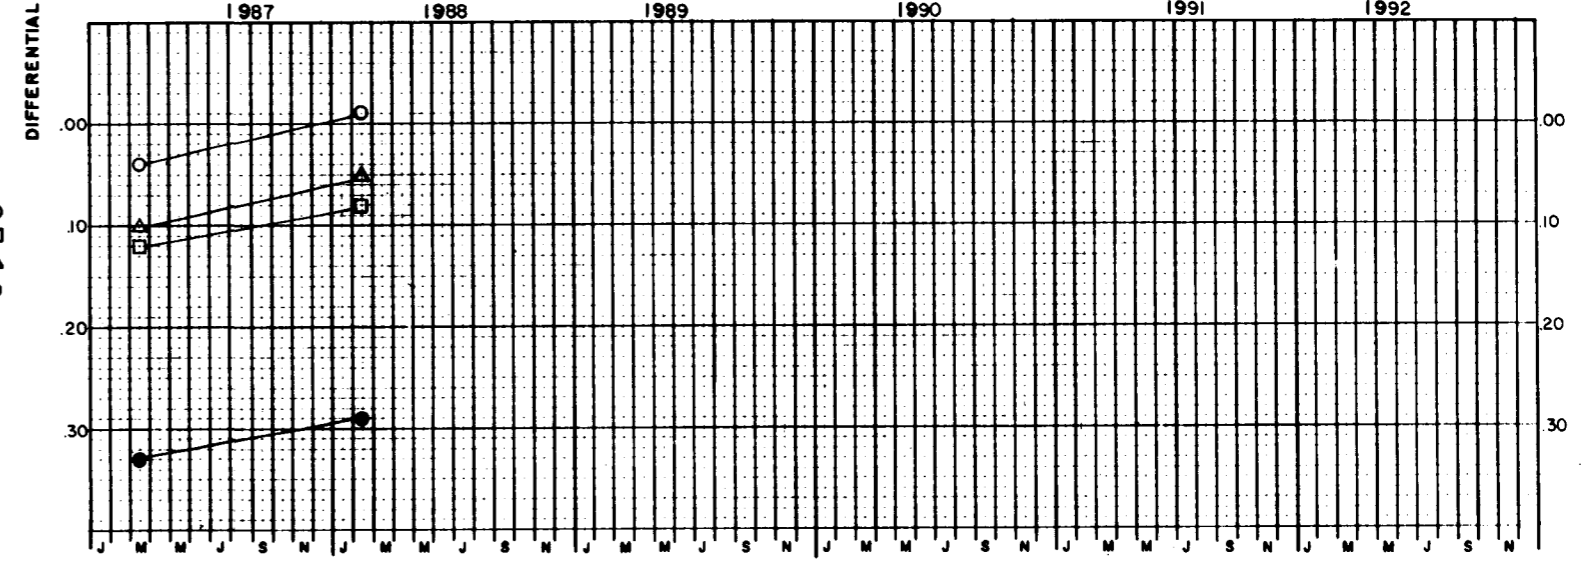

NO. OF REFERENCE MARKS	DISTANCES BETWEEN REFERENCE MARKS						
	B2 TO B3	B4 TO B5	B6 TO B7	B8 TO B9	B10 TO B11	B12 TO B13	B14 TO B15
INITIAL DATE	4-11-74	4-11-74	4-11-74	4-11-74	4-11-74	4-11-74	4-11-74
ORIGINAL READINGS (IN.)	4.97	3.98	131.35	64.17	64.19	2.48	5.00
3 MAR 1987	5.02	4.03	—	—	—	2.55	5.08
25 FEB 1988	5.04	4.03	—	—	—	2.56	5.08
OBSERVATIONS							


NOTE:
For location and tabulation of settlement reference marks see plate

LAKE PONTCHARTRAIN AND VICINITY
BAYOU BIENVENUE
PERIODIC INSPECTION

SETTLEMENT REFERENCE MARKS
DIFFERENTIAL SETTLEMENT CHART







U S ARMY ENGINEER DISTRICT, NEW ORLEANS
CORPS OF ENGINEERS

FILE NO. M-4-26857

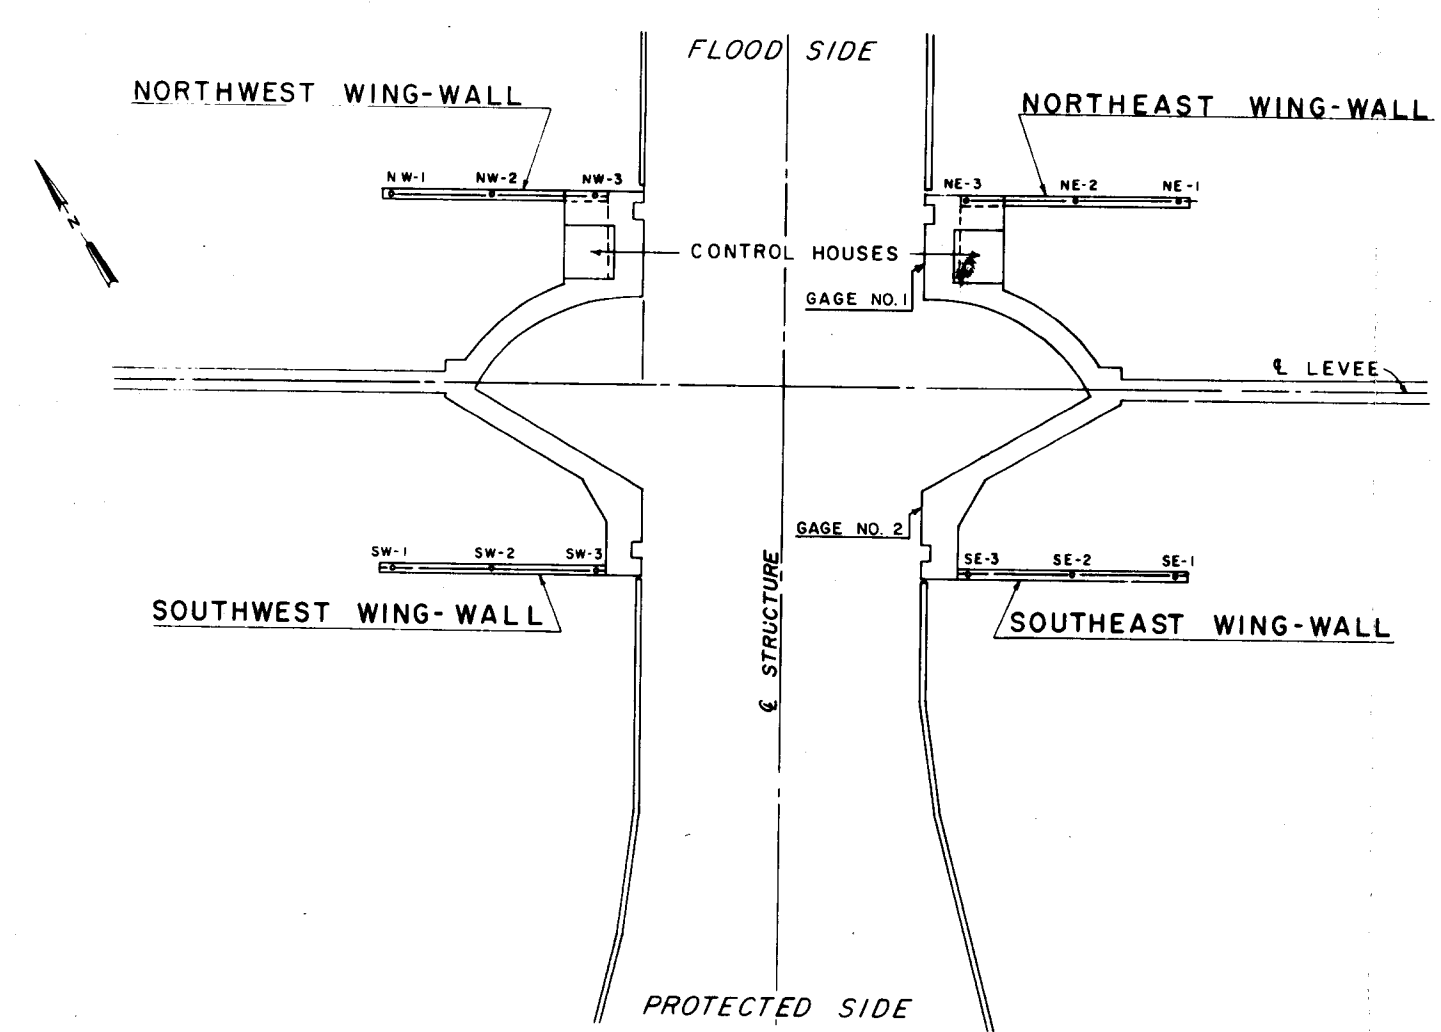

NO. OF REFERENCE MARK	SETTLEMENT									REFERENCE MARKS						TEMP	GAGE 1	GAGE 2	B.M.	ELEV.
	3-29-78	NW-1	NW-2	NW-3	NE-1	NE-2	NE-3	SW-1	SW-2	SW-3	SE-1	SE-2	SE-3	3-29-78	3-29-78					
ORIGINAL READINGS	5.02	5.17	5.32	4.83	5.00	5.23	5.02	5.12	5.26	4.86	4.99	5.32	61°	0.4	0.3	BB 2	6.279			
29 FEB 1980	4.87	5.04	5.18	4.68	4.86	5.11	4.89	5.02	5.16	4.71	4.85	5.21	58°	-0.3	0.1	BB 2	6.279			
11 NOV 1980	4.86	5.02	5.22	4.67	4.84	5.13	4.86	4.98	5.13	4.70	4.85	5.19	69°	1.9	1.4	BB 2	6.278			
31 MAY 1982	4.81	4.99	5.16	4.62	4.80	5.07	4.81	4.84	5.09	4.66	4.80	5.17	85°	1.8	1.9	BB 2	6.281			
29 NOV 1982	4.85	5.02	5.17	4.65	4.84	5.13	4.84	4.98	5.14	4.68	4.83	5.21	66°	1.1	1.6	BB 3	6.210			
13 APRIL 1984	4.84	5.02	5.21	4.65	4.84	5.12	4.84	4.98	5.15	4.68	4.83	5.22	67°	—	1.0	BB 3	6.210			
22 OCT 1984	4.84	5.03	5.21	4.64	4.83	5.11	4.84	4.97	5.15	4.68	4.83	5.21	80°	2.5	2.5	BB 3	6.210			
11 AUG 1986	4.81	5.03	5.20	4.62	4.83	5.07	4.82	4.97	5.15	4.65	4.75	5.19	78°	1.1	1.0	BB 3	6.210			
3 MAR 1987	4.81	5.00	5.20	4.59	4.79	5.08	4.80	4.94	5.12	4.62	4.78	5.18	60°	1.9	1.7	BB 3	6.210			
25 FEB 1988	4.82	5.00	5.21	4.64	4.85	5.14	4.80	4.95	5.13	4.64	4.82	5.22	50°	-0.3	0.10	BB 3	6.210			

LAKE PONTCHARTRAIN AND VICINITY
 BAYOU BIENVENUE
 PERIODIC INSPECTION
WING-WALL
SETTLEMENT REFERENCE MARKS
PLAN AND TABULATION
 U.S. ARMY ENGINEER DISTRICT, NEW ORLEANS
 CORPS OF ENGINEERS
 FILE NO. H-4-26857

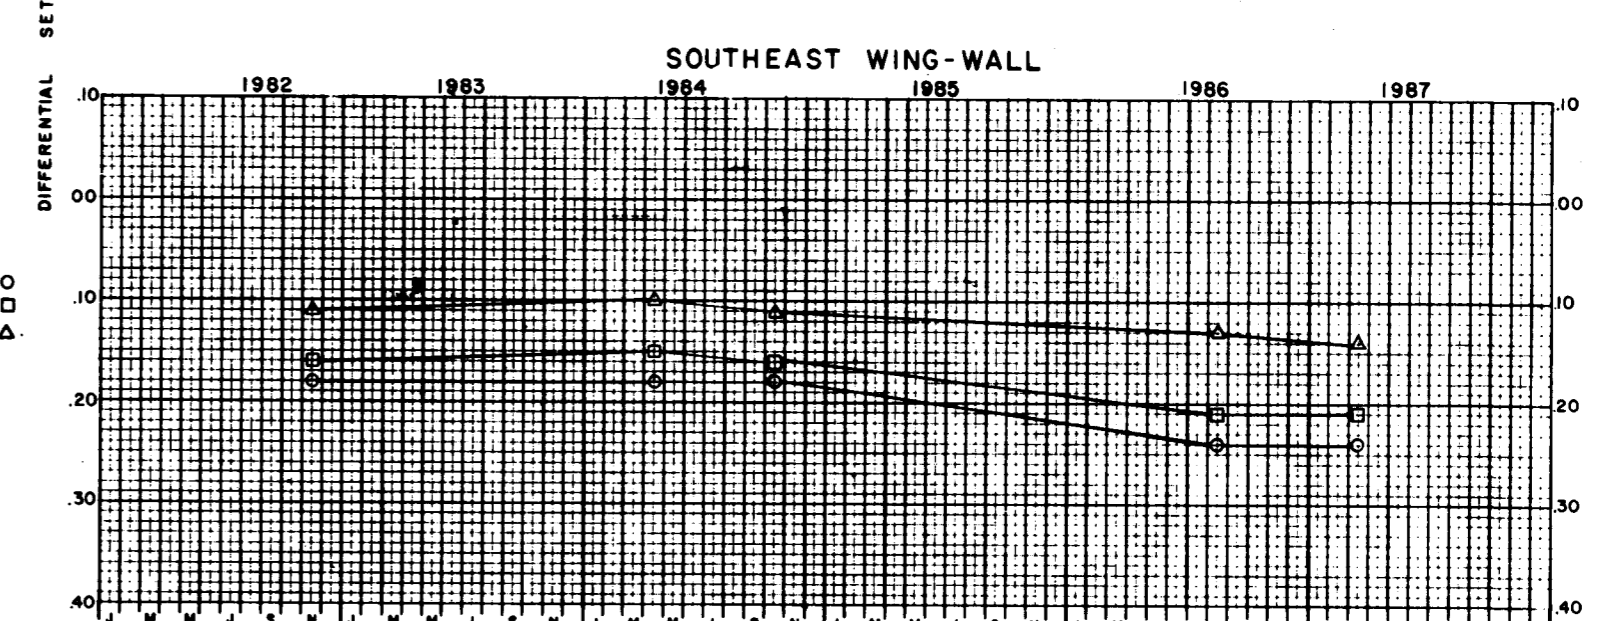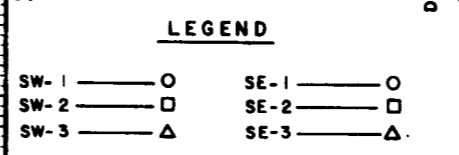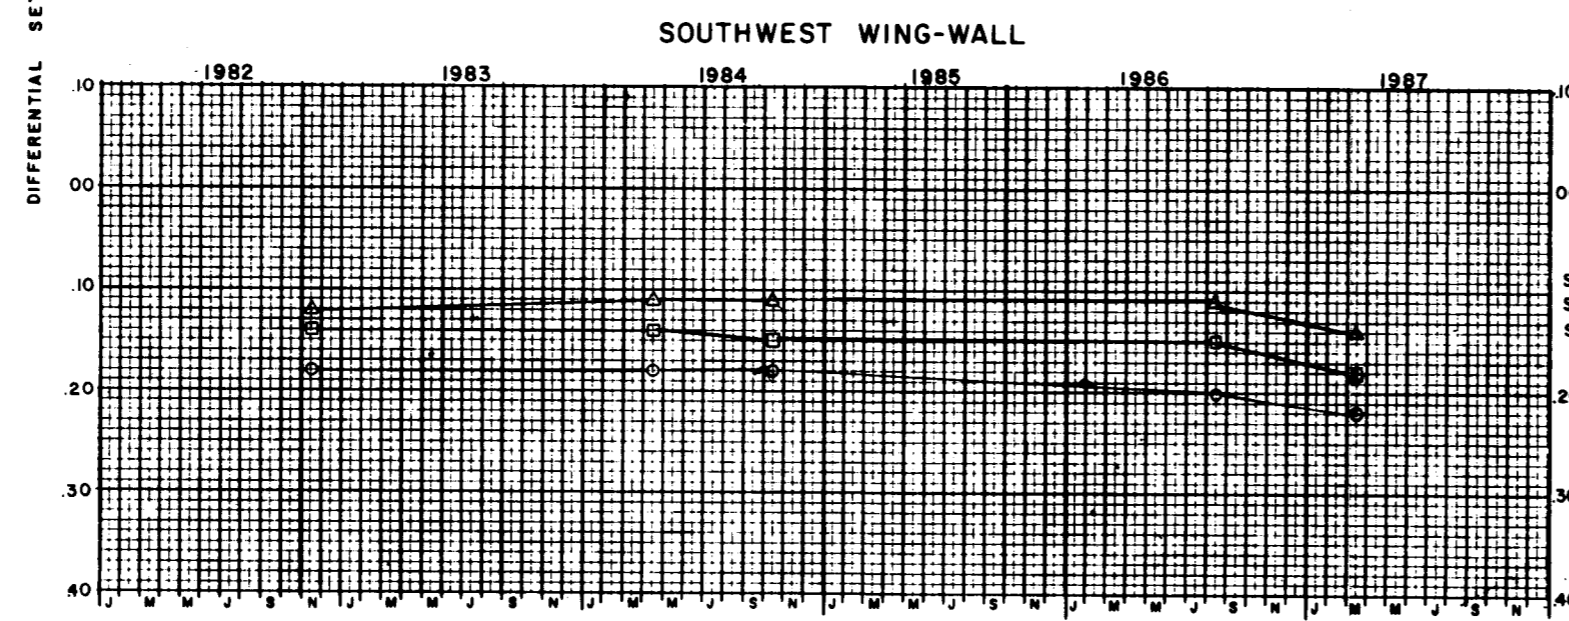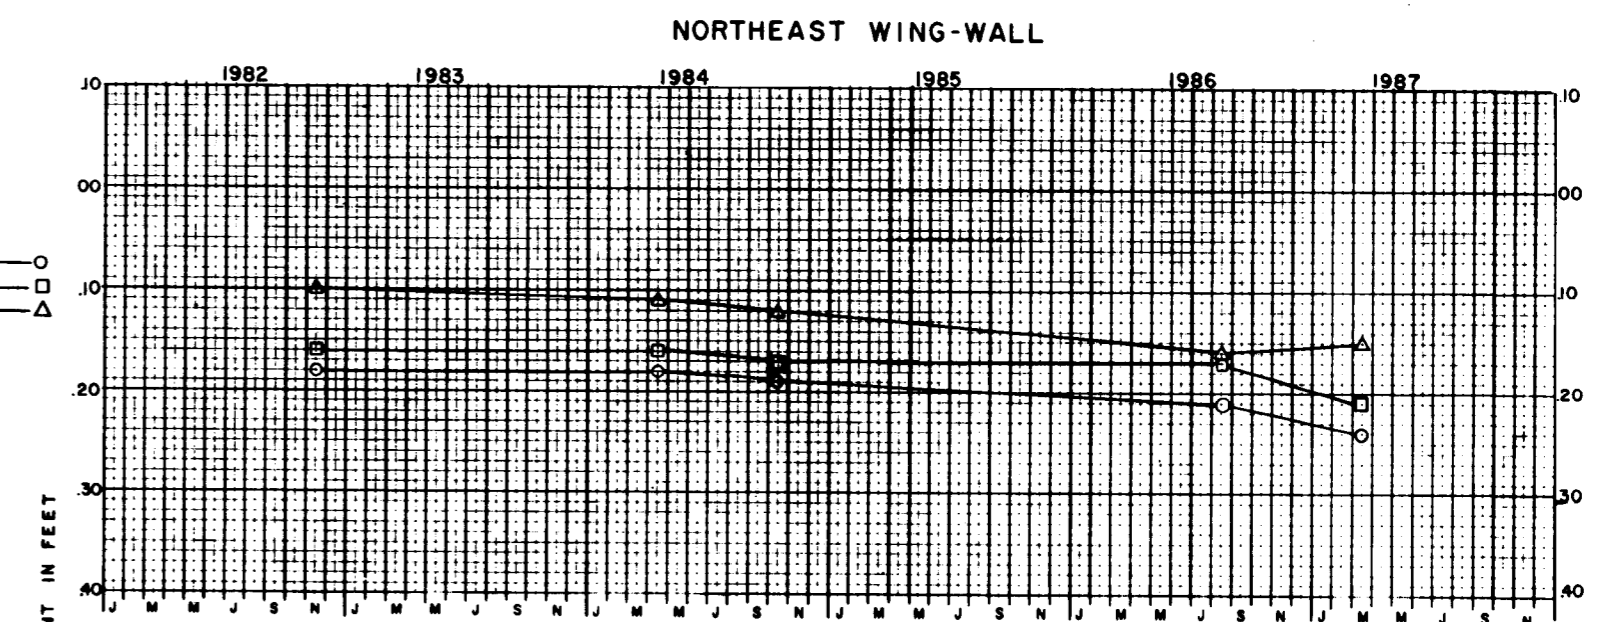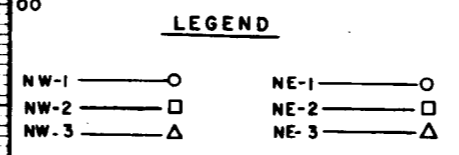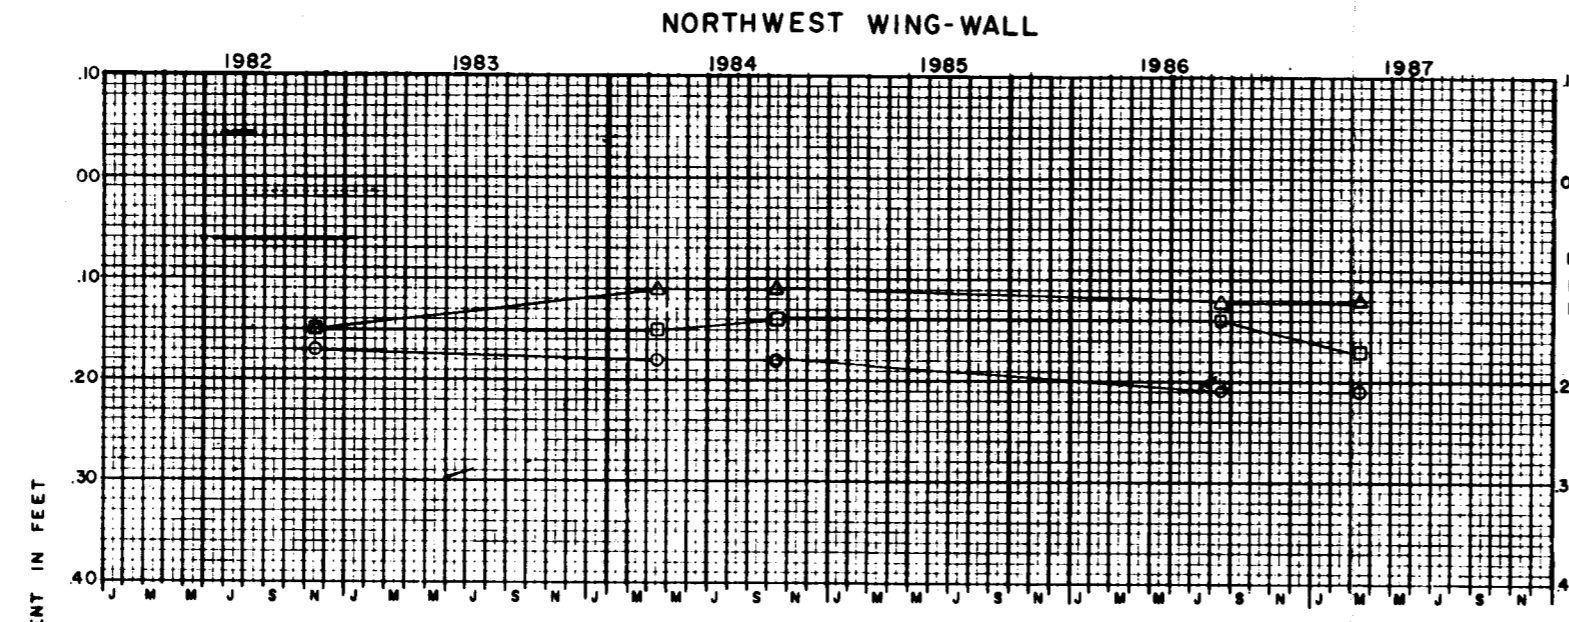


NOTE:
For location and tabulation of settlement reference marks see plate

LAKE PONTCHARTRAIN AND VICINITY
BAYOU BIENVENUE
PERIODIC INSPECTION
WING-WALL
SETTLEMENT REFERENCE MARKS
DIFFERENTIAL SETTLEMENT CHART

U S ARMY ENGINEER DISTRICT, NEW ORLEANS
CORPS OF ENGINEERS

FILE NO. H-4-26657


NORTHWEST WING-WALL

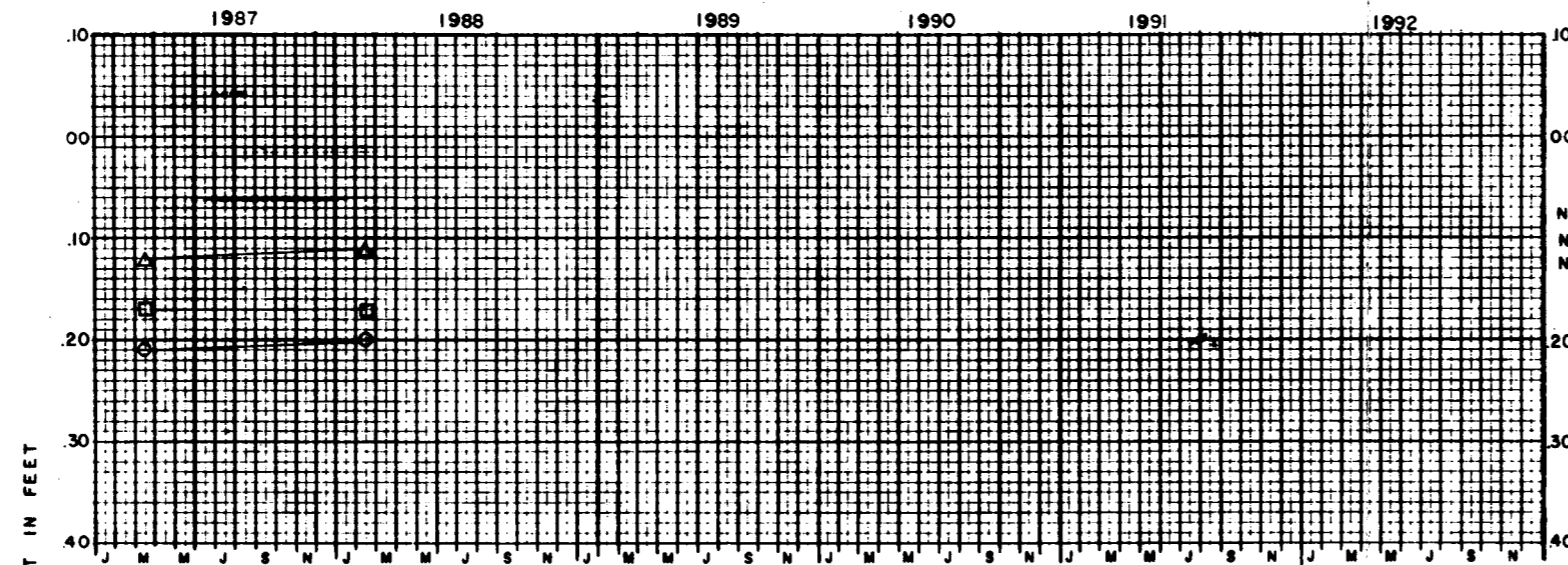


LEGEND

- | | | | |
|------|---|------|---|
| NW-1 | ○ | NE-1 | ○ |
| NW-2 | □ | NE-2 | □ |
| NW-3 | △ | NE-3 | △ |

NORTHEAST WING-WALL

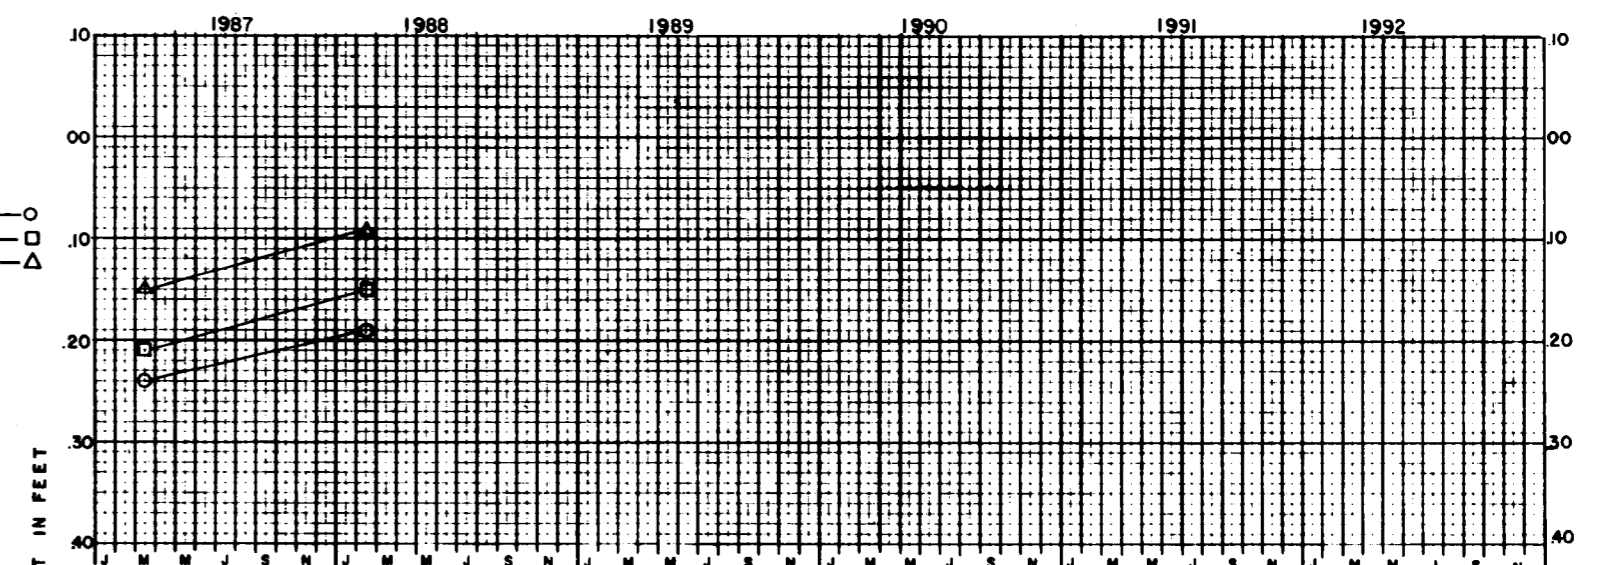


SOUTHWEST WING-WALL

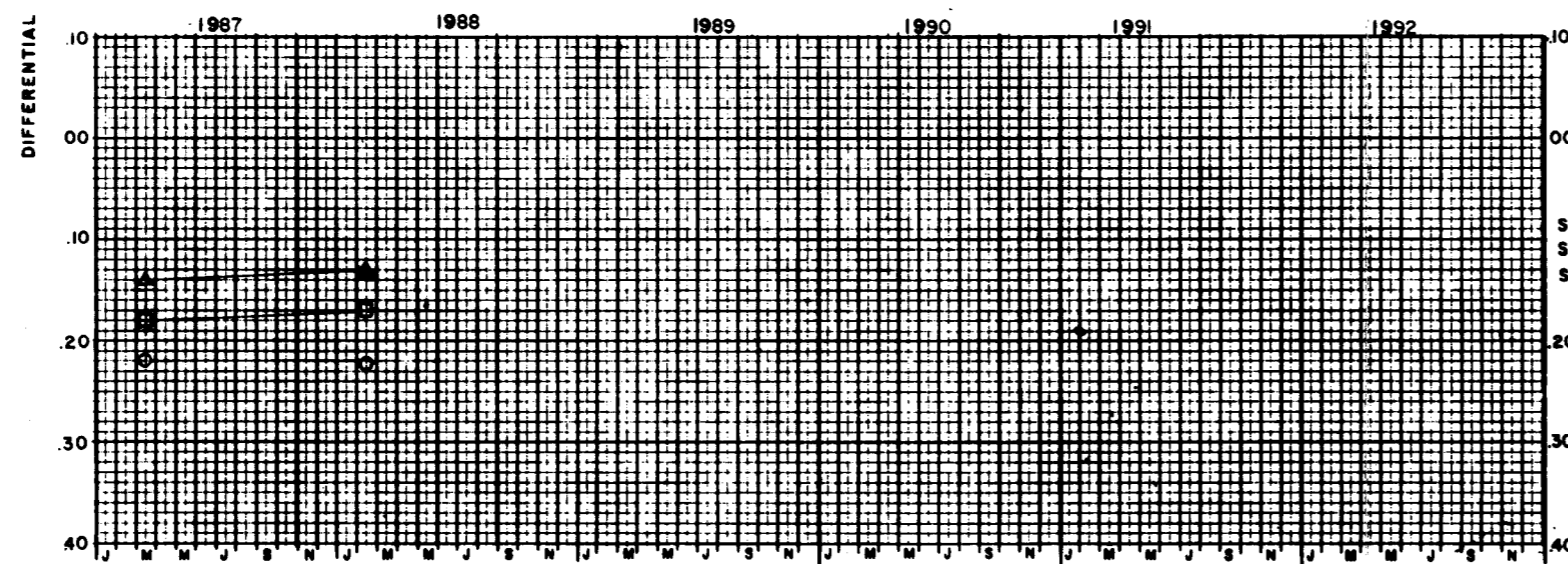

LEGEND

- | | | | |
|------|---|------|---|
| SW-1 | ○ | SE-1 | ○ |
| SW-2 | □ | SE-2 | □ |
| SW-3 | △ | SE-3 | △ |

SOUTHEAST WING-WALL

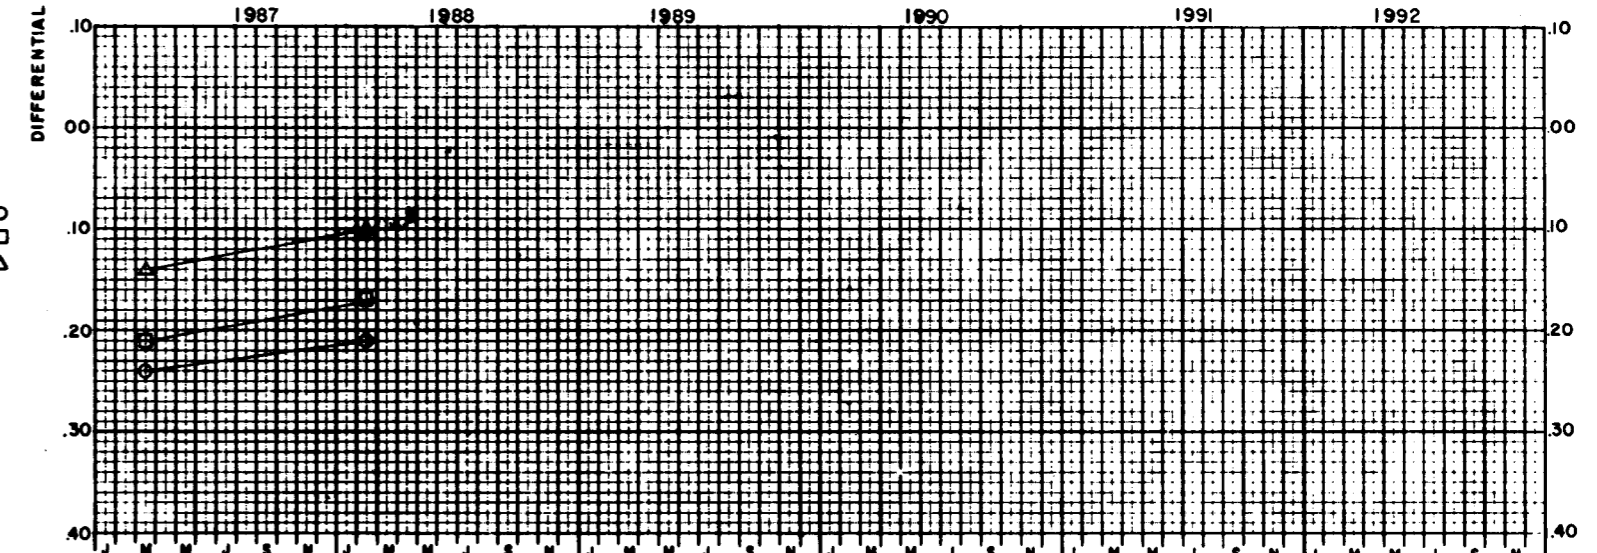


NOTE:
For location and tabulation of
settlement reference marks see
plate

LAKE PONTCHARTRAIN AND VICINITY
BAYOU BIENVENUE
PERIODIC INSPECTION
WING-WALL
SETTLEMENT REFERENCE MARKS
DIFFERENTIAL SETTLEMENT CHART

U S ARMY ENGINEER DISTRICT, NEW ORLEANS
CORPS OF ENGINEERS


FILE NO. H-4-26857

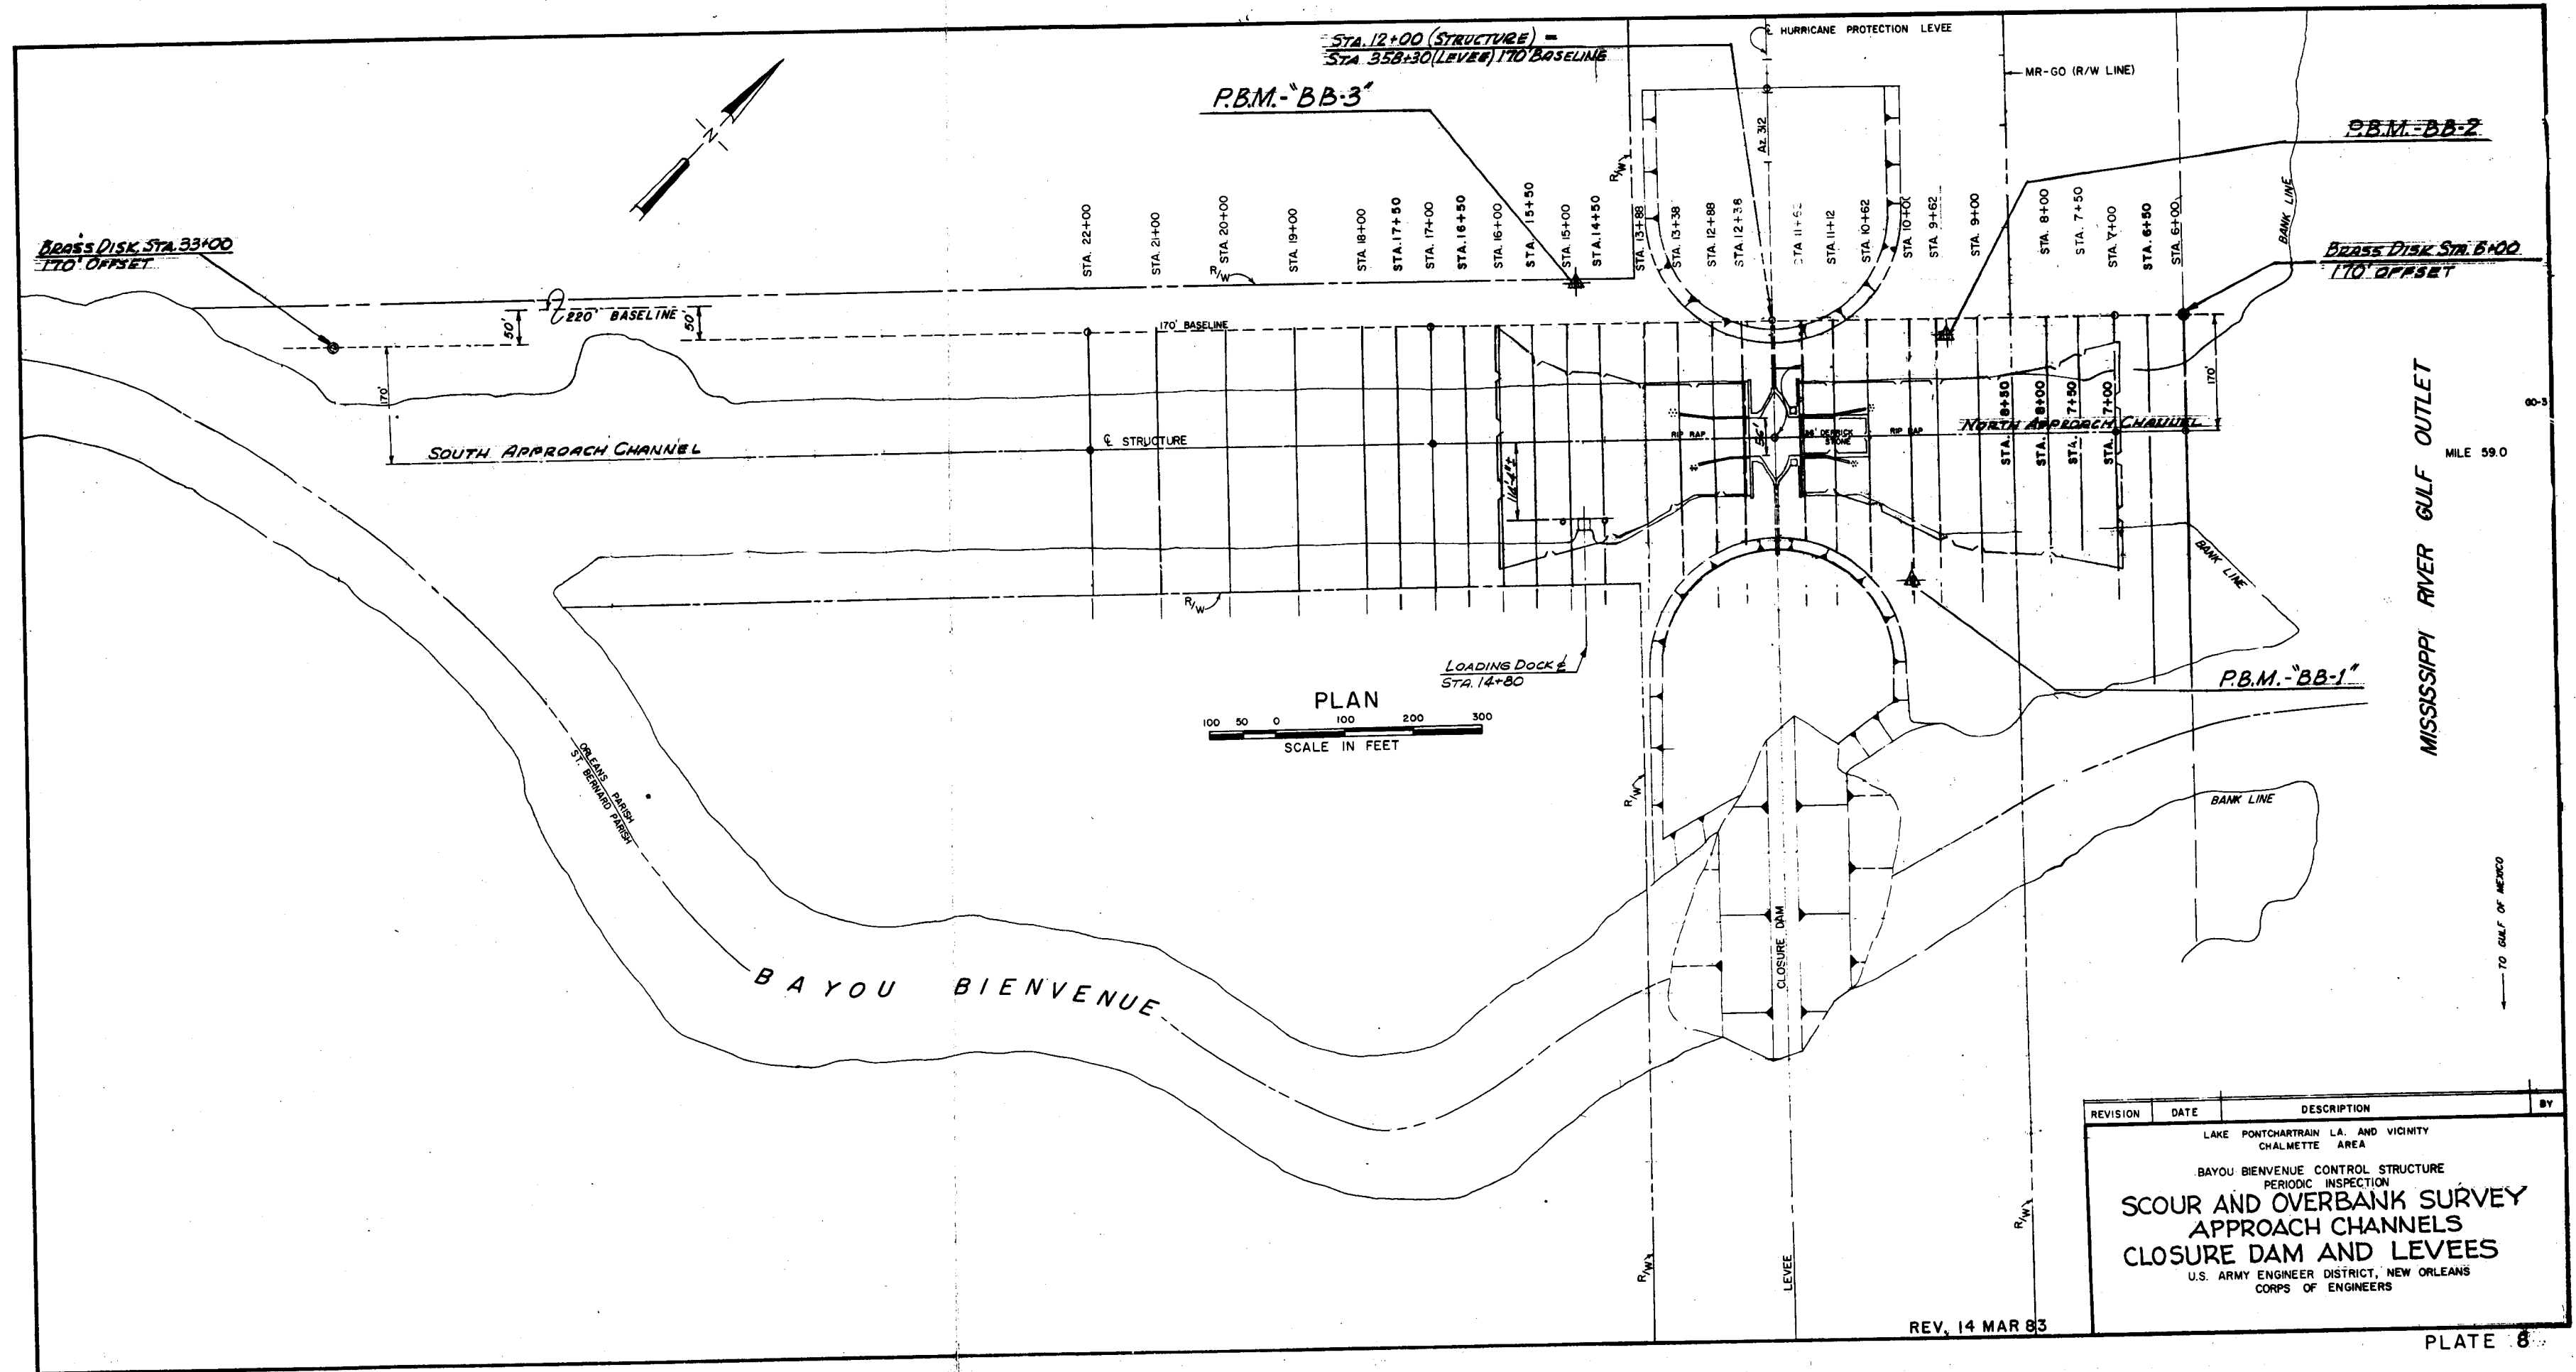

PLAN
SCALE IN FEET

REVISION	DATE	DESCRIPTION	BY
		LAKE PONTCHARTRAIN L.A. AND VICINITY CHALMETTE AREA	
		BAYOU BIENVENUE CONTROL STRUCTURE PERIODIC INSPECTION	
		SCOUR AND OVERBANK SURVEY	
		APPROACH CHANNELS	
		CLOSURE DAM AND LEVEES	
		U.S. ARMY ENGINEER DISTRICT, NEW ORLEANS	
		CORPS OF ENGINEERS	

REV. 14 MAR 83

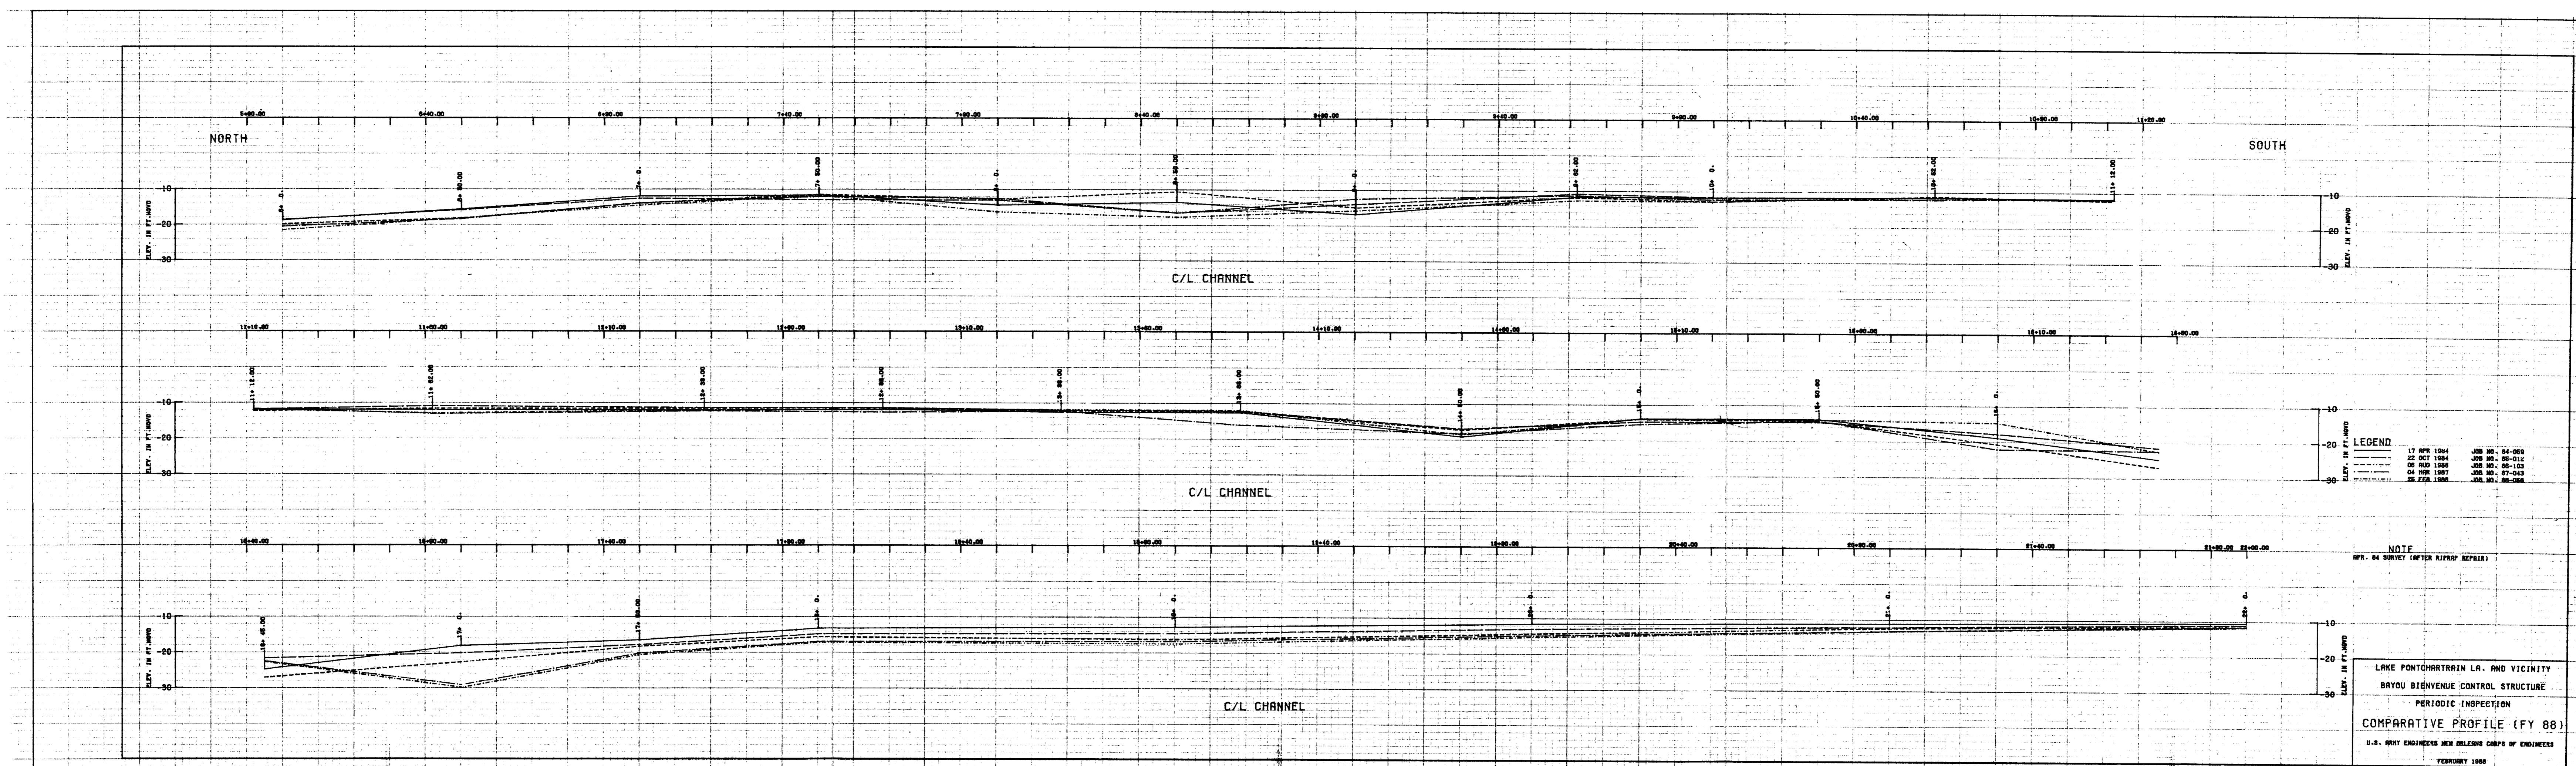


LEGEND

—	17 APR 1964	JOB NO. 84-089
- - -	22 OCT 1964	JOB NO. 85-012
—	08 MAR 1988	JOB NO. 88-103
- - -	04 MAR 1987	JOB NO. 87-043
—	25 FEB 1988	JOB NO. 88-088

NOTE
 APR. 84 SURVEY (AFTER RIPRAP REPAIR)

LAKE PONCHARTRAIN LA. AND VICINITY
 BAYOU BIENVENUE CONTROL STRUCTURE
 PERIODIC INSPECTION
 COMPARATIVE PROFILE (FY 88)
 U.S. ARMY ENGINEERS NEW ORLEANS CORPS OF ENGINEERS
 FEBRUARY 1988

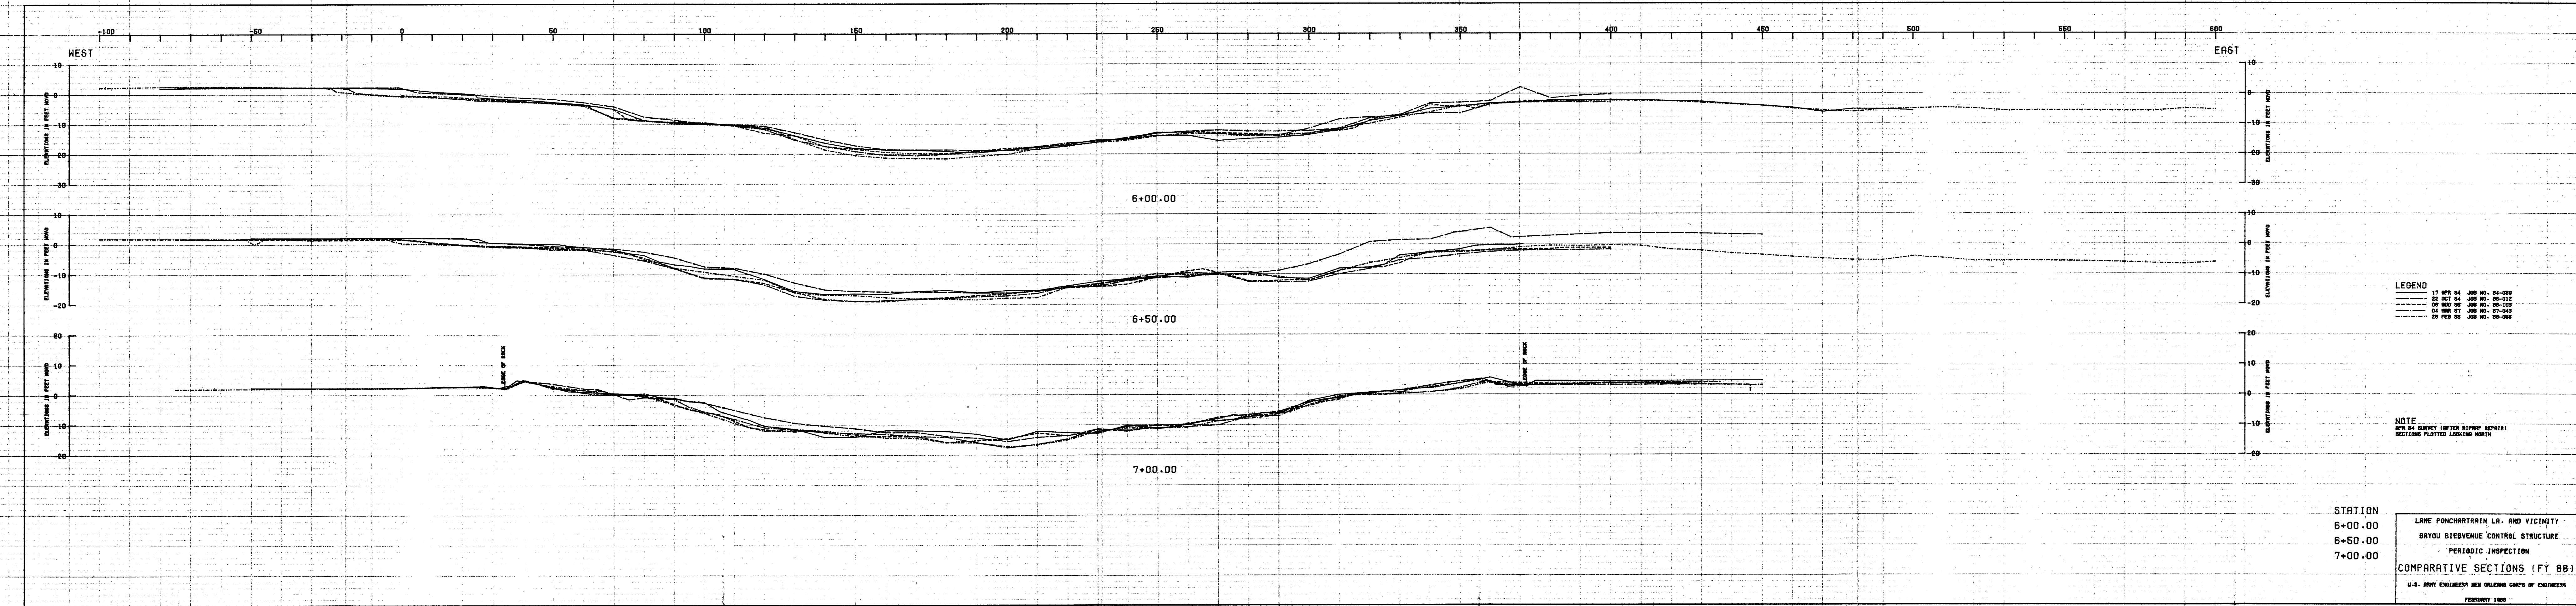


LEGEND

—	17 APR 84	JOB NO. 84-089
- - -	22 OCT 84	JOB NO. 86-012
— · —	06 NOV 86	JOB NO. 86-103
— · — · —	04 MAR 87	JOB NO. 87-043
- - - · - - -	26 FEB 88	JOB NO. 88-068

NOTE
 RPR 84 SURVEY (AFTER RIPRAP REPAIR)
 SECTIONS PLOTTED LOOKING NORTH

STATION
 6+00.00
 6+50.00
 7+00.00

LARUE PONCHARTRAIN LA. AND VICINITY
 BAYOU BIEBVENUE CONTROL STRUCTURE
 PERIODIC INSPECTION
 COMPARATIVE SECTIONS (FY 88)
 U.S. ARMY ENGINEERS' NEW ORLEANS CORPS OF ENGINEERS
 FEBRUARY 1988

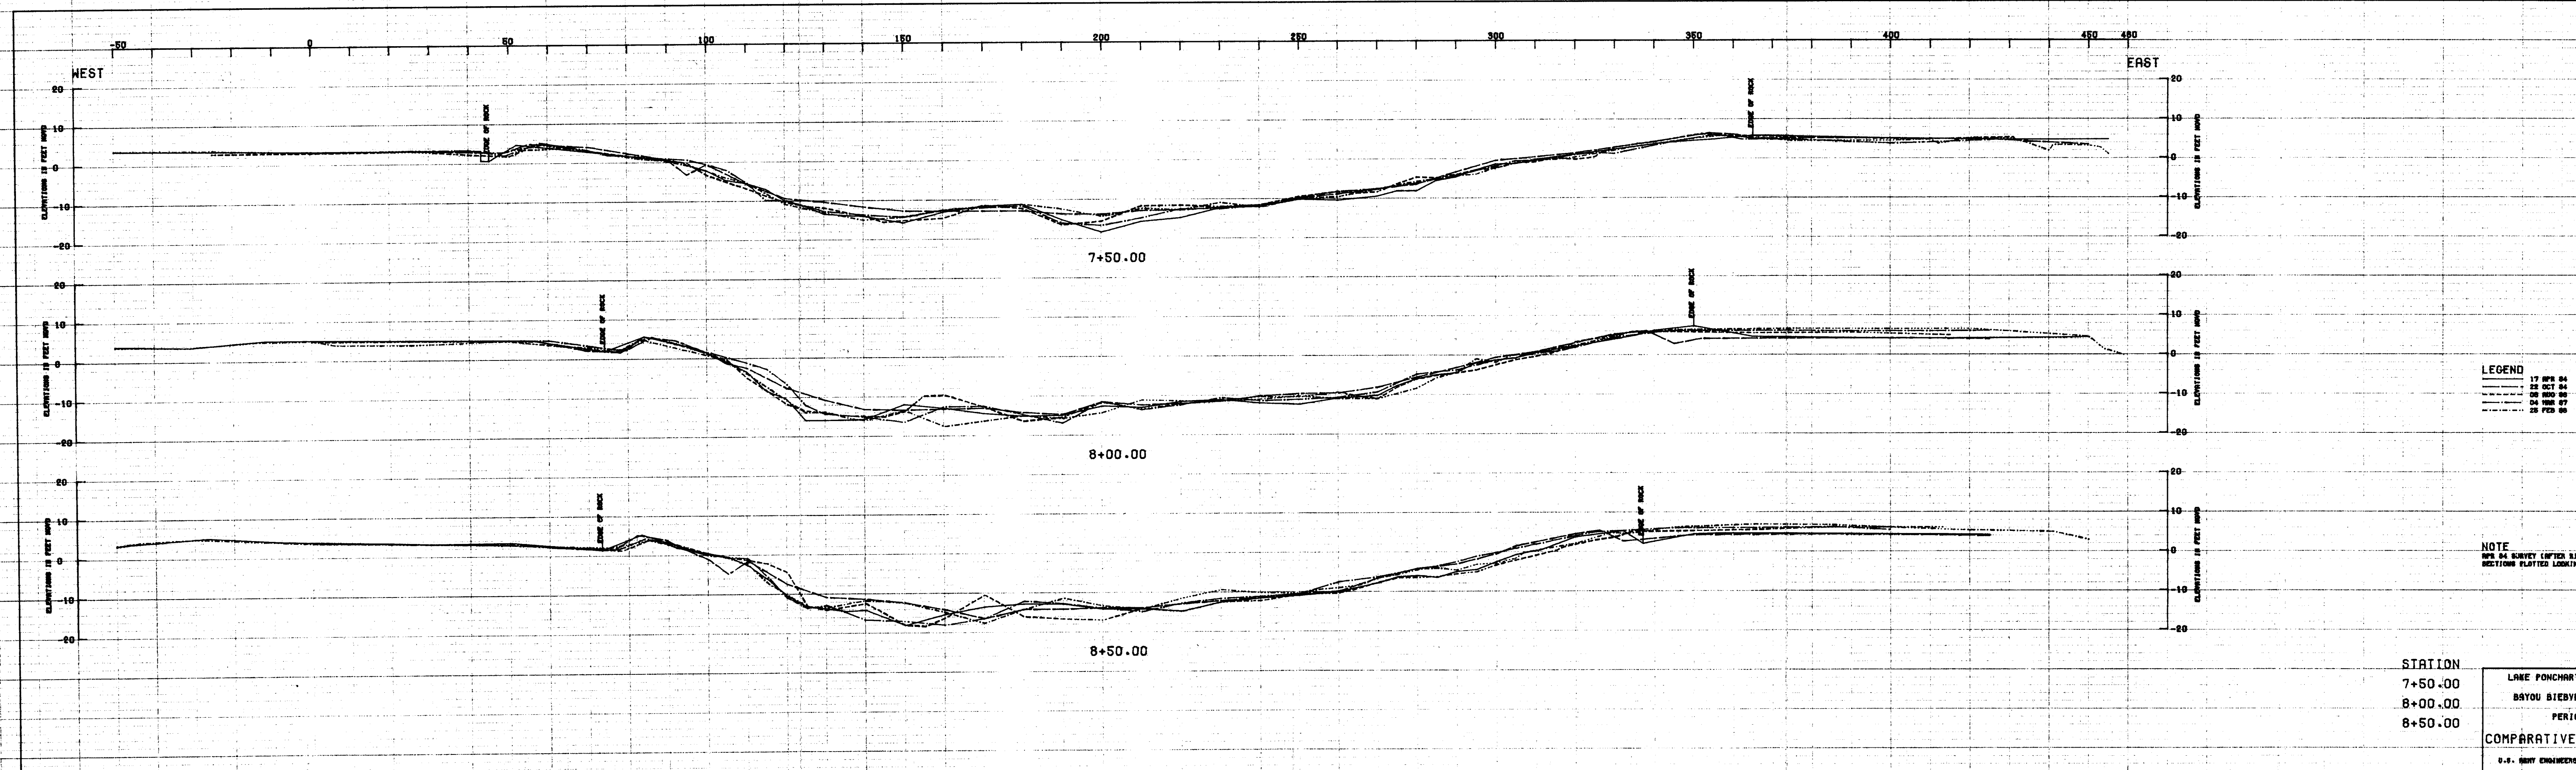


LEGEND

- 17 APR 84 JOB NO. 84-089
- - - 22 OCT 84 JOB NO. 88-012
- · · 02 NOV 84 JOB NO. 88-108
- 04 MAR 87 JOB NO. 87-043
- - - 25 FEB 88 JOB NO. 88-088

NOTE
 APR 84 SURVEY (AFTER REPAIR REPAIR)
 SECTIONS PLOTTED LOOKING NORTH

STATION
 7+50.00
 8+00.00
 8+50.00

LAKE PONCHARTRAIN LA. AND VICINITY
BAYOU BIEBVENUE CONTROL STRUCTURE
 PERIODIC INSPECTION
COMPARATIVE SECTIONS (FY 88)
 U.S. ARMY ENGINEERS NEW ORLEANS CORPS OF ENGINEERS
 FEBRUARY 1988

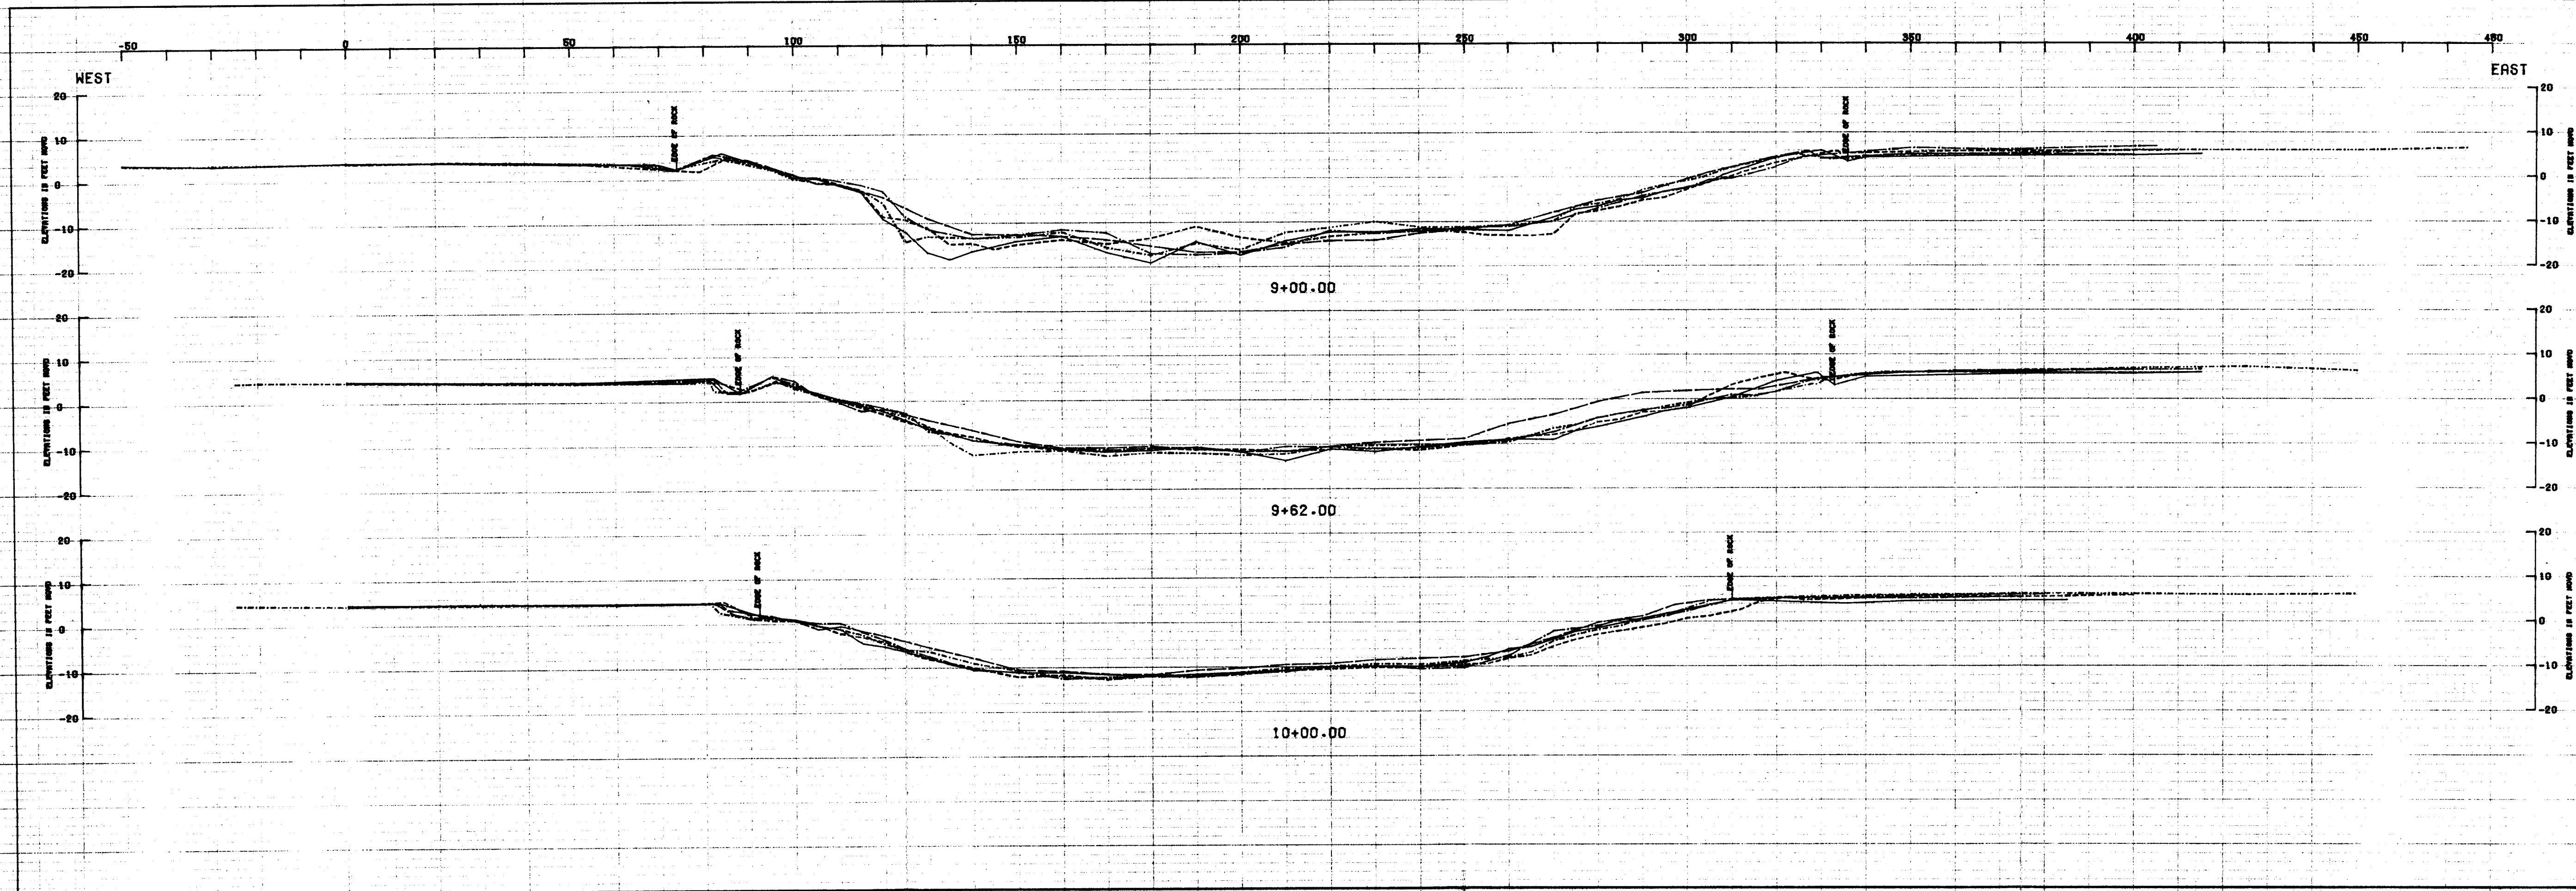


LEGEND

- 17 APR 84 JOB NO. 84-099
- 22 OCT 84 JOB NO. 84-012
- 07 MAR 86 JOB NO. 86-103
- 04 MAR 87 JOB NO. 87-043
- 28 FEB 88 JOB NO. 88-089

NOTE
 APR 84 SURVEY (AFTER REPAIR WORK)
 SECTIONS PLOTTED LOOKING NORTH

STATION
 9+00.00
 9+62.00
 10+00.00

LAKE PONCHARTRAIN LA. AND VICINITY
BAYOU BIEBVENUE CONTROL STRUCTURE
PERIODIC INSPECTION
COMPARATIVE SECTIONS (FY 88)
 U.S. ARMY ENGINEERS NEW ORLEANS CORPS OF ENGINEERS
 FEBRUARY 1988

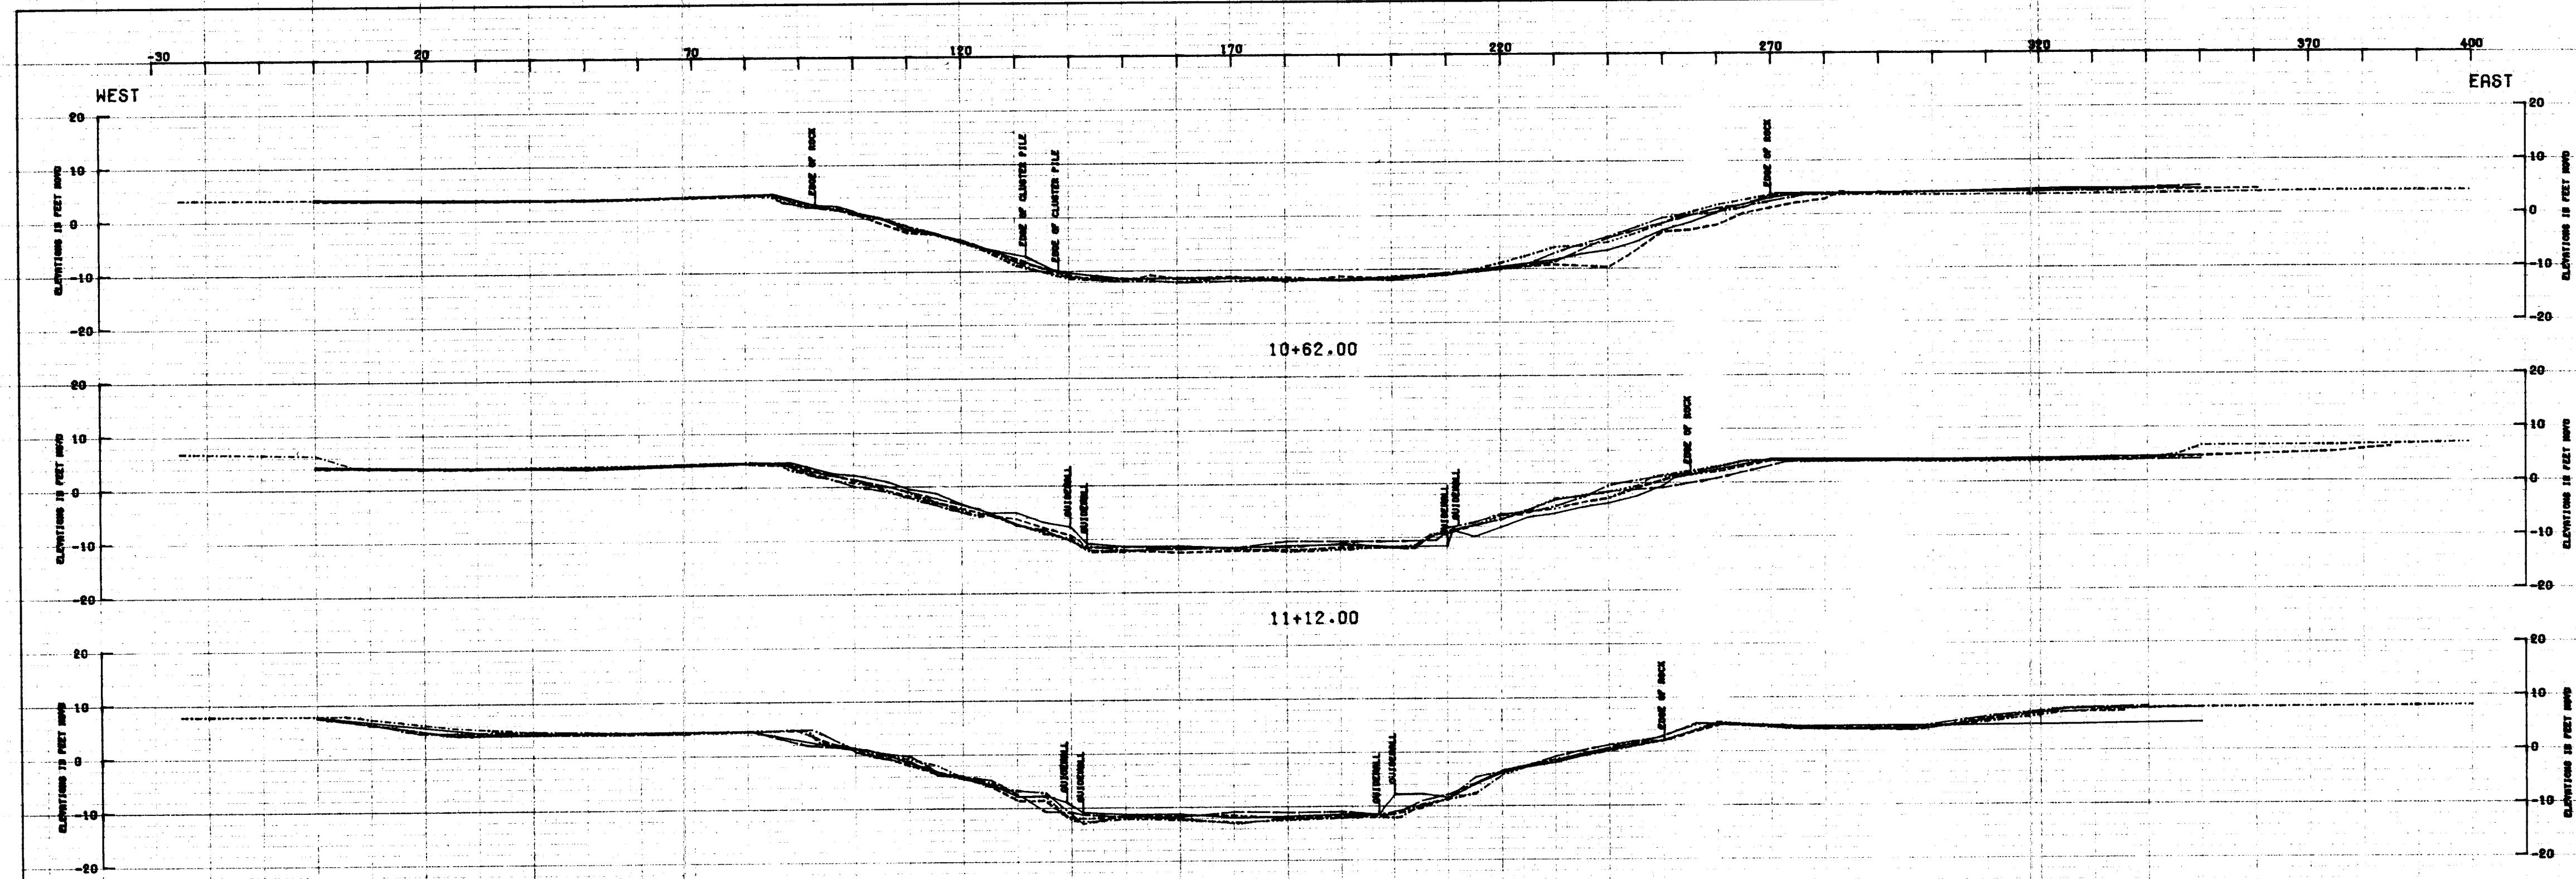


LEGEND

17 APR 84	JOB NO. 84-088
22 OCT 84	JOB NO. 84-012
06 MAR 86	JOB NO. 86-103
04 MAR 87	JOB NO. 87-043
28 FEB 88	JOB NO. 88-088

NOTE
 APR 84 SURVEY (AFTER RIPRAP REPAIR)
 SECTIONS PLOTTED LOOKING NORTH

STATION
 10+62.00
 11+12.00
 11+62.00

LAKE PONCHARTRAIN LA. AND VICINITY
 BAYOU BIEBVENUE CONTROL STRUCTURE
 PERIODIC INSPECTION
COMPARATIVE SECTIONS (FY 88)
 U.S. ARMY ENGINEERS AND ARCHITECTS CORPS OF ENGINEERS
 FEBRUARY 1988

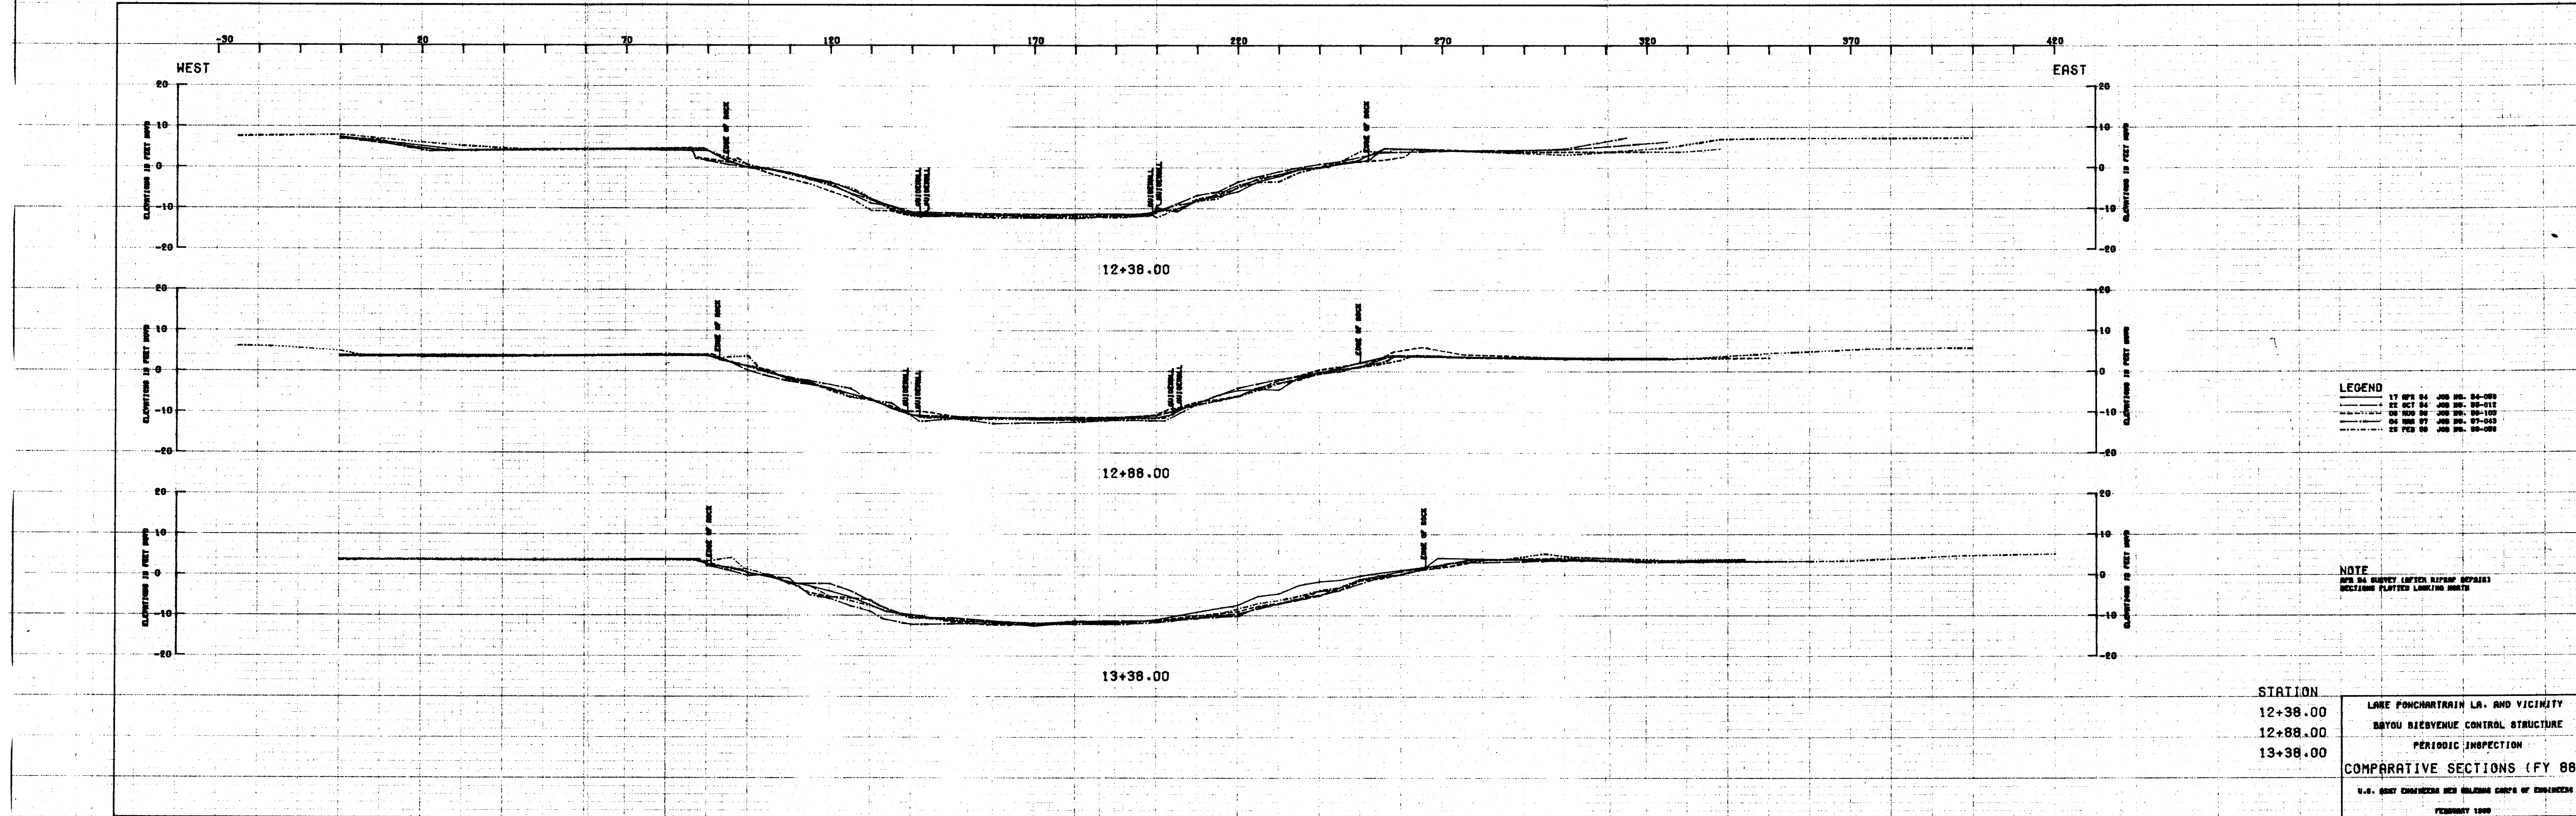


LEGEND

---	17 APR 84	JOB NO. 84-089
---	22 OCT 84	JOB NO. 84-118
---	08 NOV 84	JOB NO. 84-105
---	04 NOV 87	JOB NO. 87-043
---	23 FEB 88	JOB NO. 88-088

NOTE
 NEW SURVEY (AFTER REPAIRS)
 SECTIONS PLATED LOOKING NORTH

STATION
 12+38.00
 12+88.00
 13+38.00

LAKE PONCHARTRAIN LA. AND VICINITY
BAYOU BIENVENUE CONTROL STRUCTURE
PERIODIC INSPECTION
COMPARATIVE SECTIONS (FY 88)
 U.S. ARMY ENGINEERS AND ARCHITECTS CORPS OF ENGINEERS
 FEBRUARY 1988

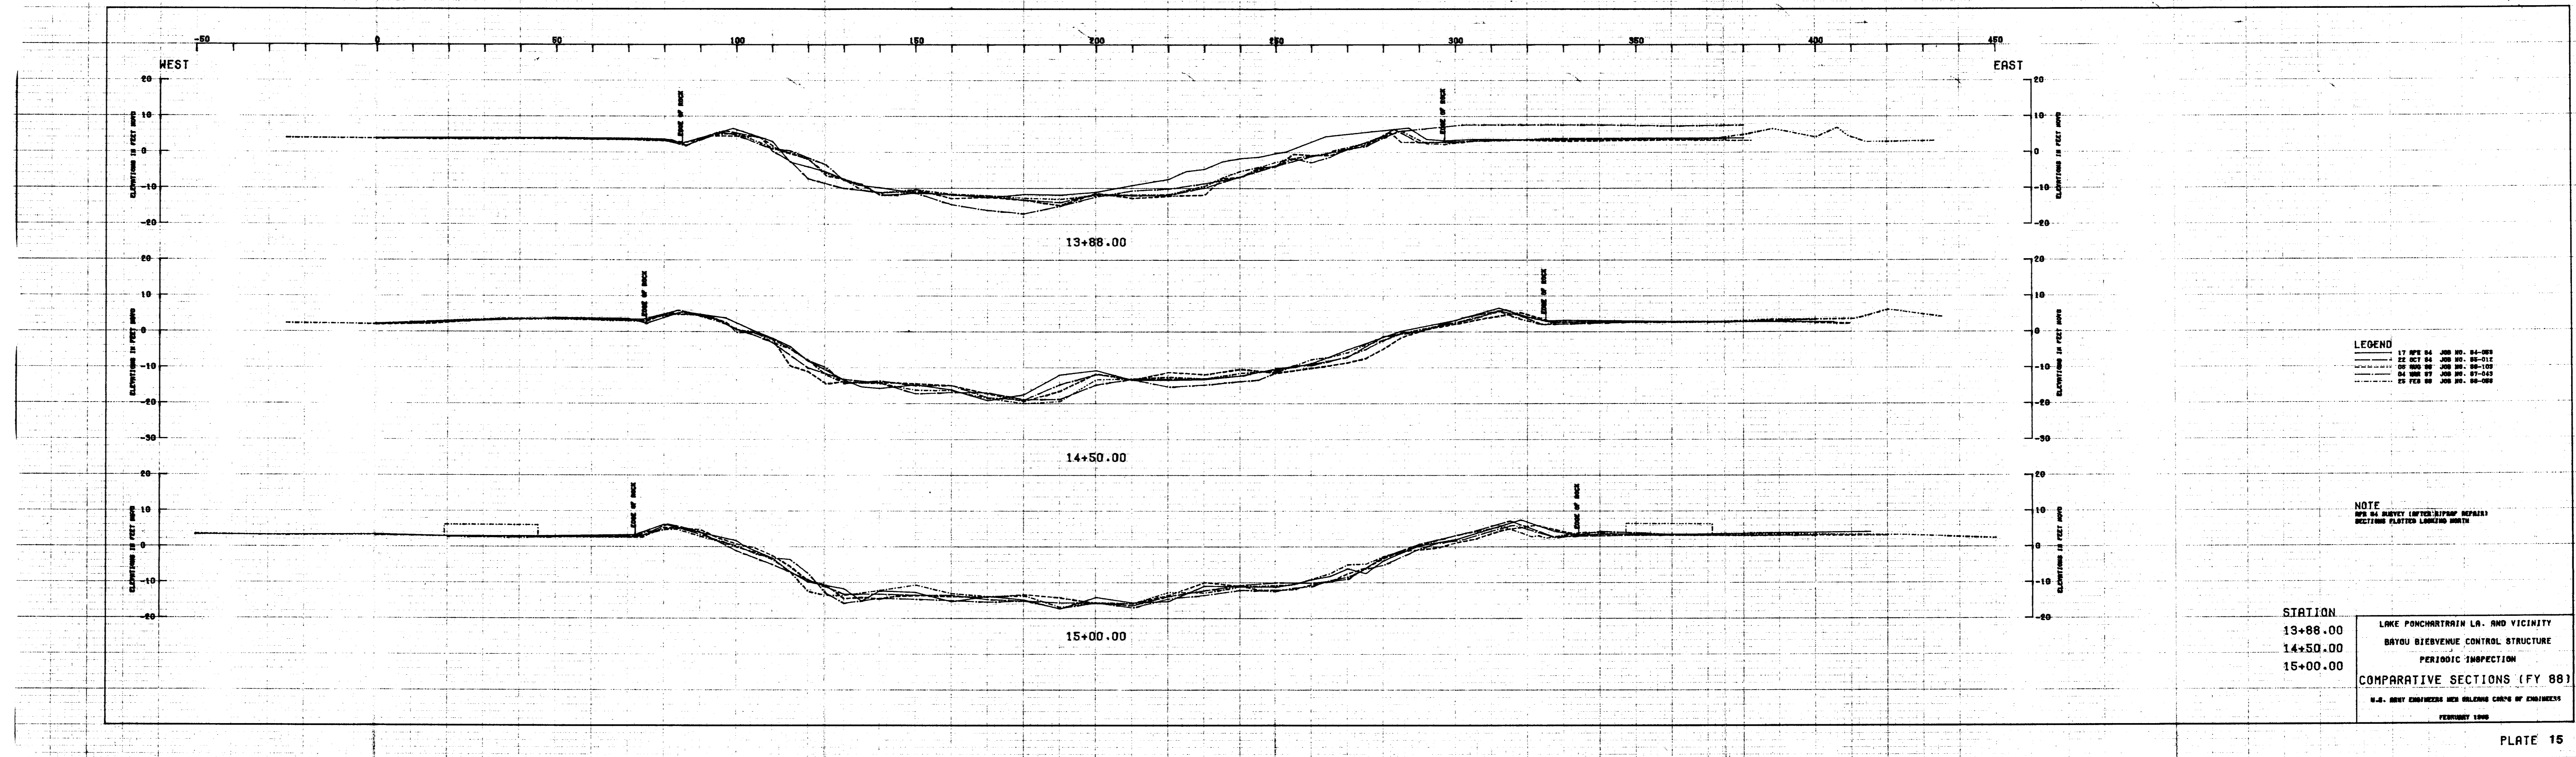


LEGEND

—	17 APR 84	JOB NO. 84-083
- - -	22 OCT 84	JOB NO. 85-012
· · ·	06 NOV 87	JOB NO. 88-105
—	04 NOV 87	JOB NO. 87-045
- - -	26 FEB 88	JOB NO. 88-088

NOTE
 APR 84 SURVEY (AFTER RIPRAP REPAIR)
 SECTIONS PLOTTED LOOKING NORTH

STATION
 13+88.00
 14+50.00
 15+00.00

LAKE PONCHARTRAIN LA. AND VICINITY
 BAYOU BIEBVENUE CONTROL STRUCTURE
 PERIODIC INSPECTION
COMPARATIVE SECTIONS (FY 88)
 U.S. ARMY ENGINEERS AND WATERS COURSE OF ENGINEERS
 FEBRUARY 1988

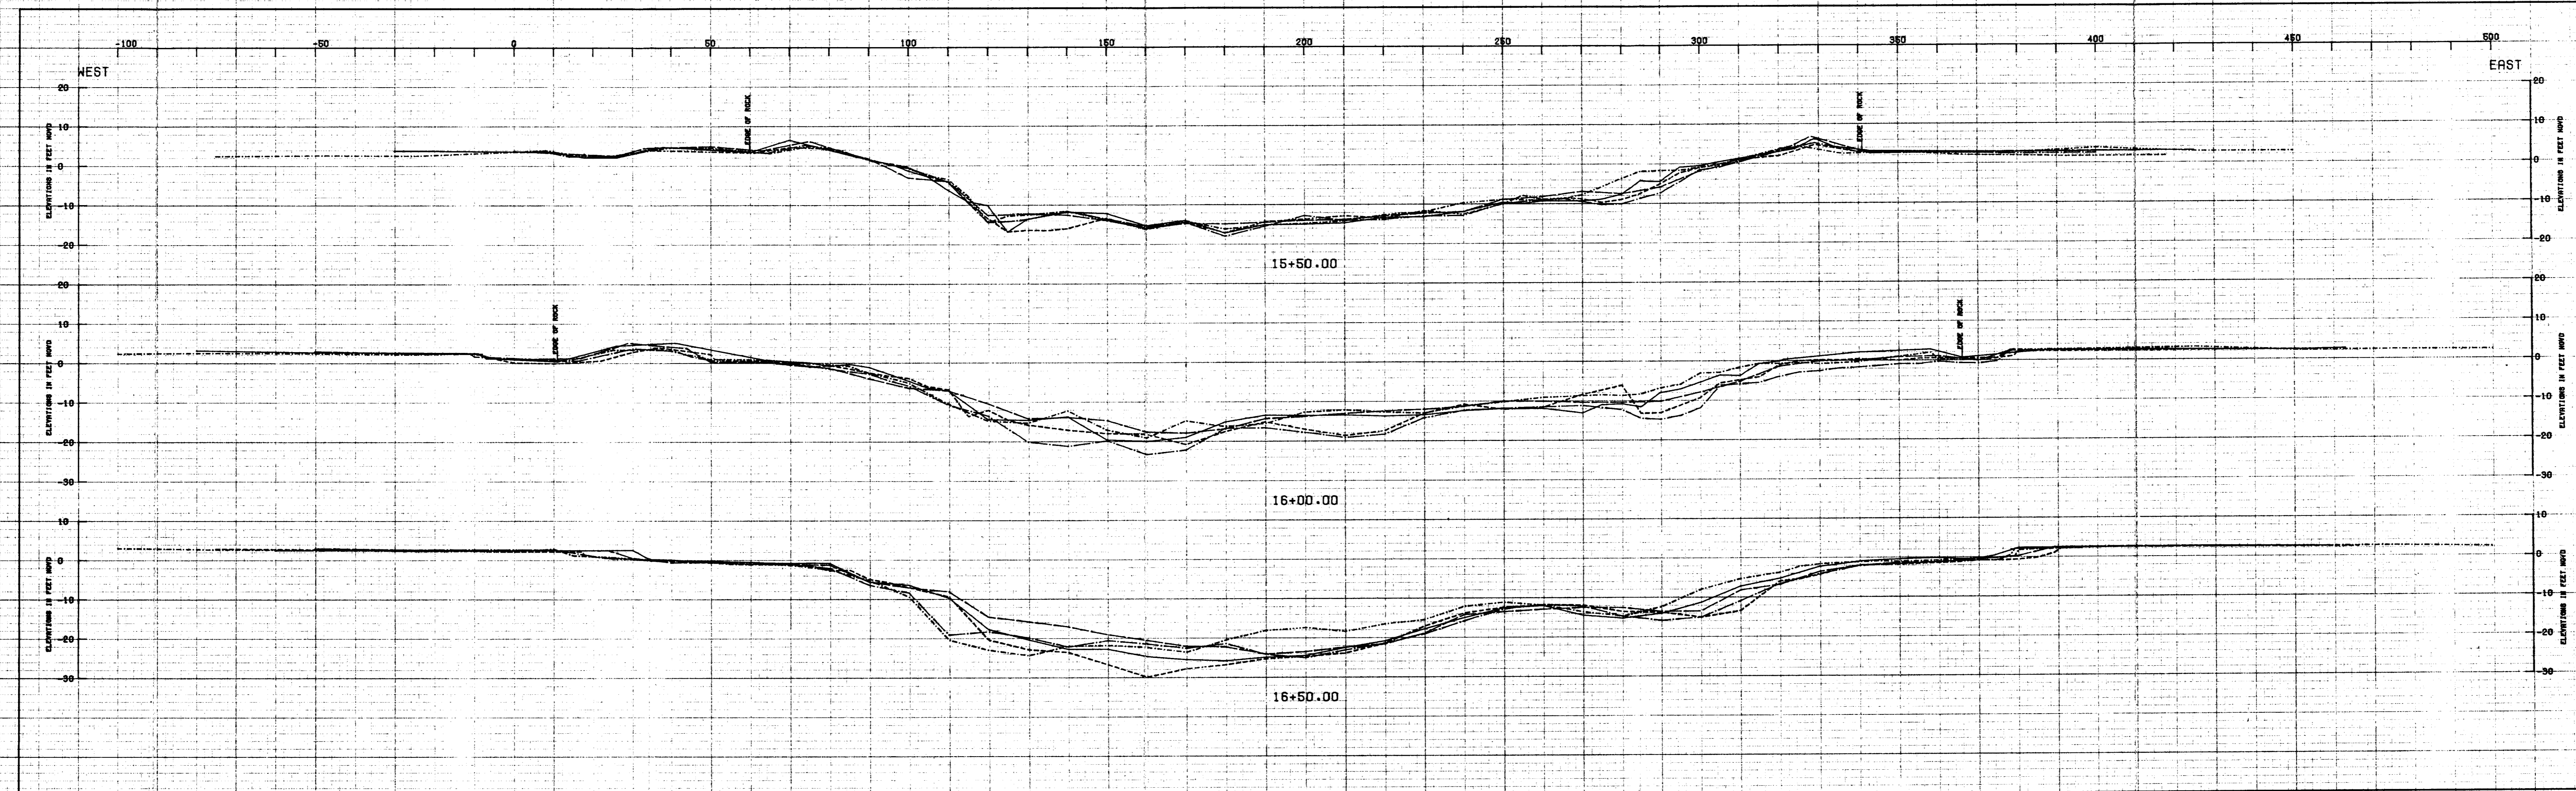


LEGEND

—	17 APR 84	JOB NO. 84-058
- - -	22 OCT 84	JOB NO. 85-012
— · — · —	06 MAR 86	JOB NO. 86-102
— · — · —	04 MAR 87	JOB NO. 87-043
- - -	25 FEB 88	JOB NO. 88-058

NOTE
 APR 84 SURVEY (INTER RIBBED REPAIR)
 SECTIONS PLOTTED LOOKING NORTH

STATION
 15+50.00
 16+00.00
 16+50.00

LAKE PONCHARTRAIN LA. AND VICINITY
 BAYOU BIENVENUE CONTROL STRUCTURE
 PERIODIC INSPECTION
COMPARATIVE SECTIONS (FY 88)
 U.S. ARMY ENGINEERS NEW ORLEANS CORPS OF ENGINEERS
 FEBRUARY 1988

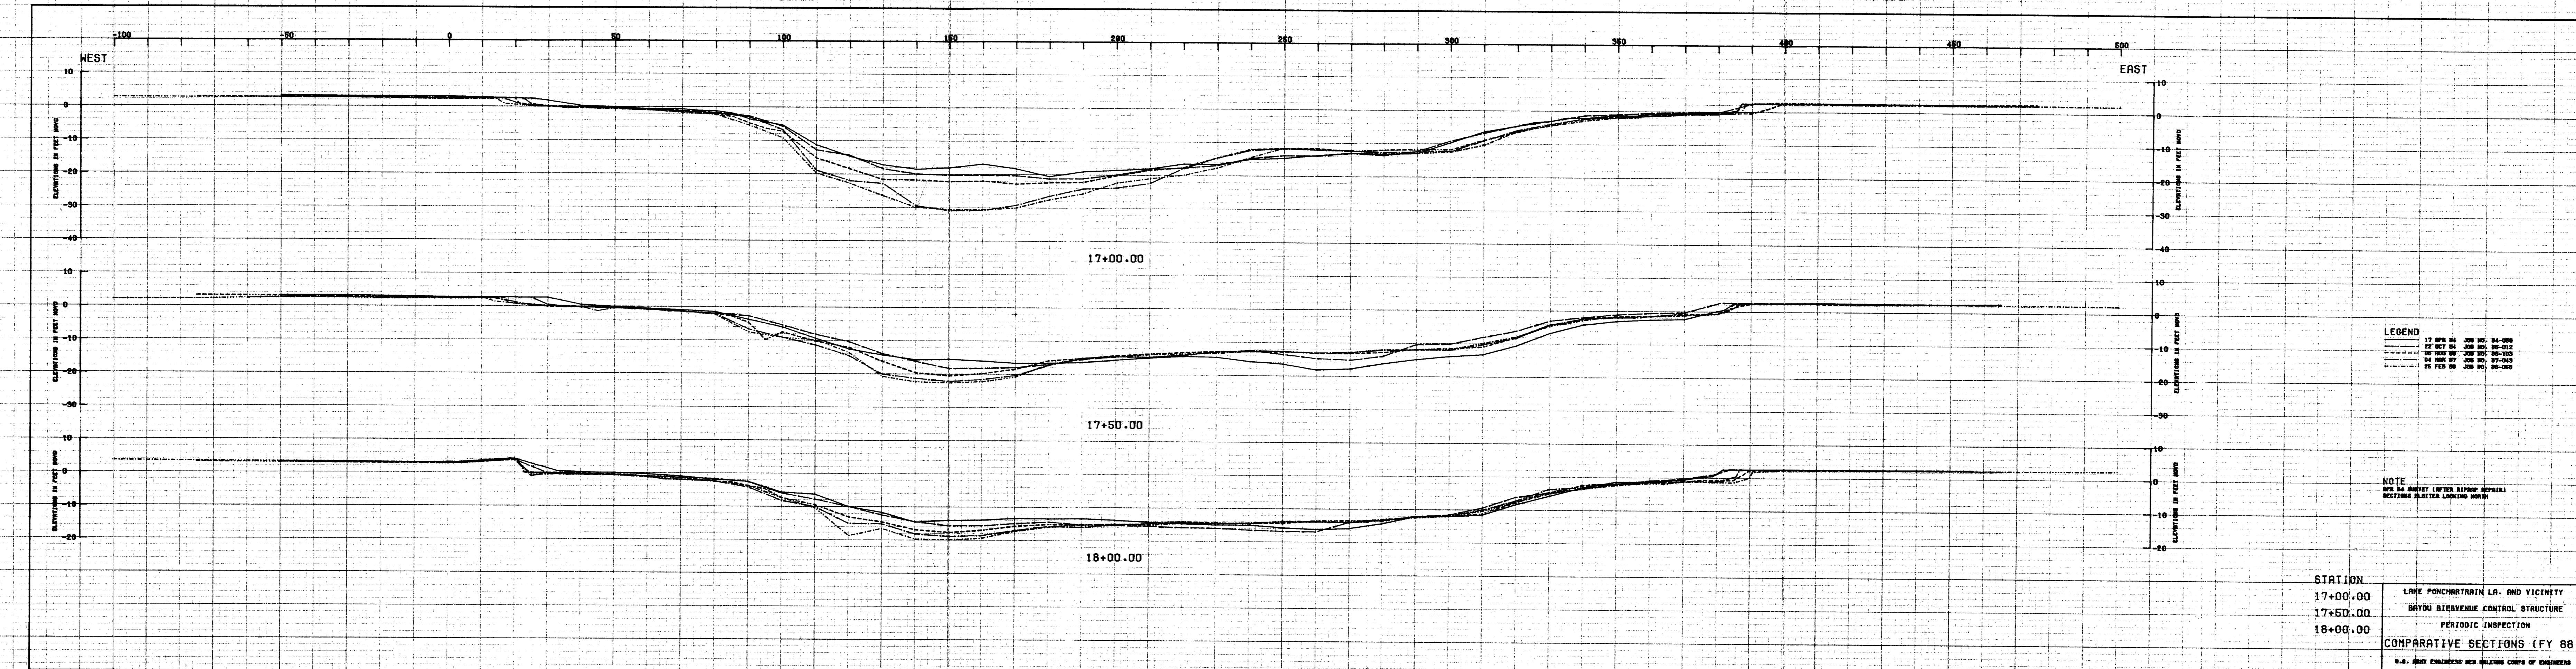


LEGEND

- 17 APR 84 JOB NO. 84-080
- - - 22 FEB 84 JOB NO. 85-012
- 05 MAR 86 JOB NO. 86-105
- 04 MAR 87 JOB NO. 87-043
- - - 25 FEB 88 JOB NO. 88-080

NOTE
 APR 84 SURVEY (AFTER RIPRAP REPAIR)
 SECTIONS PLOTTED LOOKING NORTH

STATION
 17+00.00 LAKE PONCHARTRAIN LA. AND VICINITY
 17+50.00 BAYOU BIENVENUE CONTROL STRUCTURE
 18+00.00 PERIODIC INSPECTION
COMPARATIVE SECTIONS (FY 88)
 U.S. ARMY ENGINEERS AND ARCHITECTS CORPS OF ENGINEERS
 FEBRUARY 1988

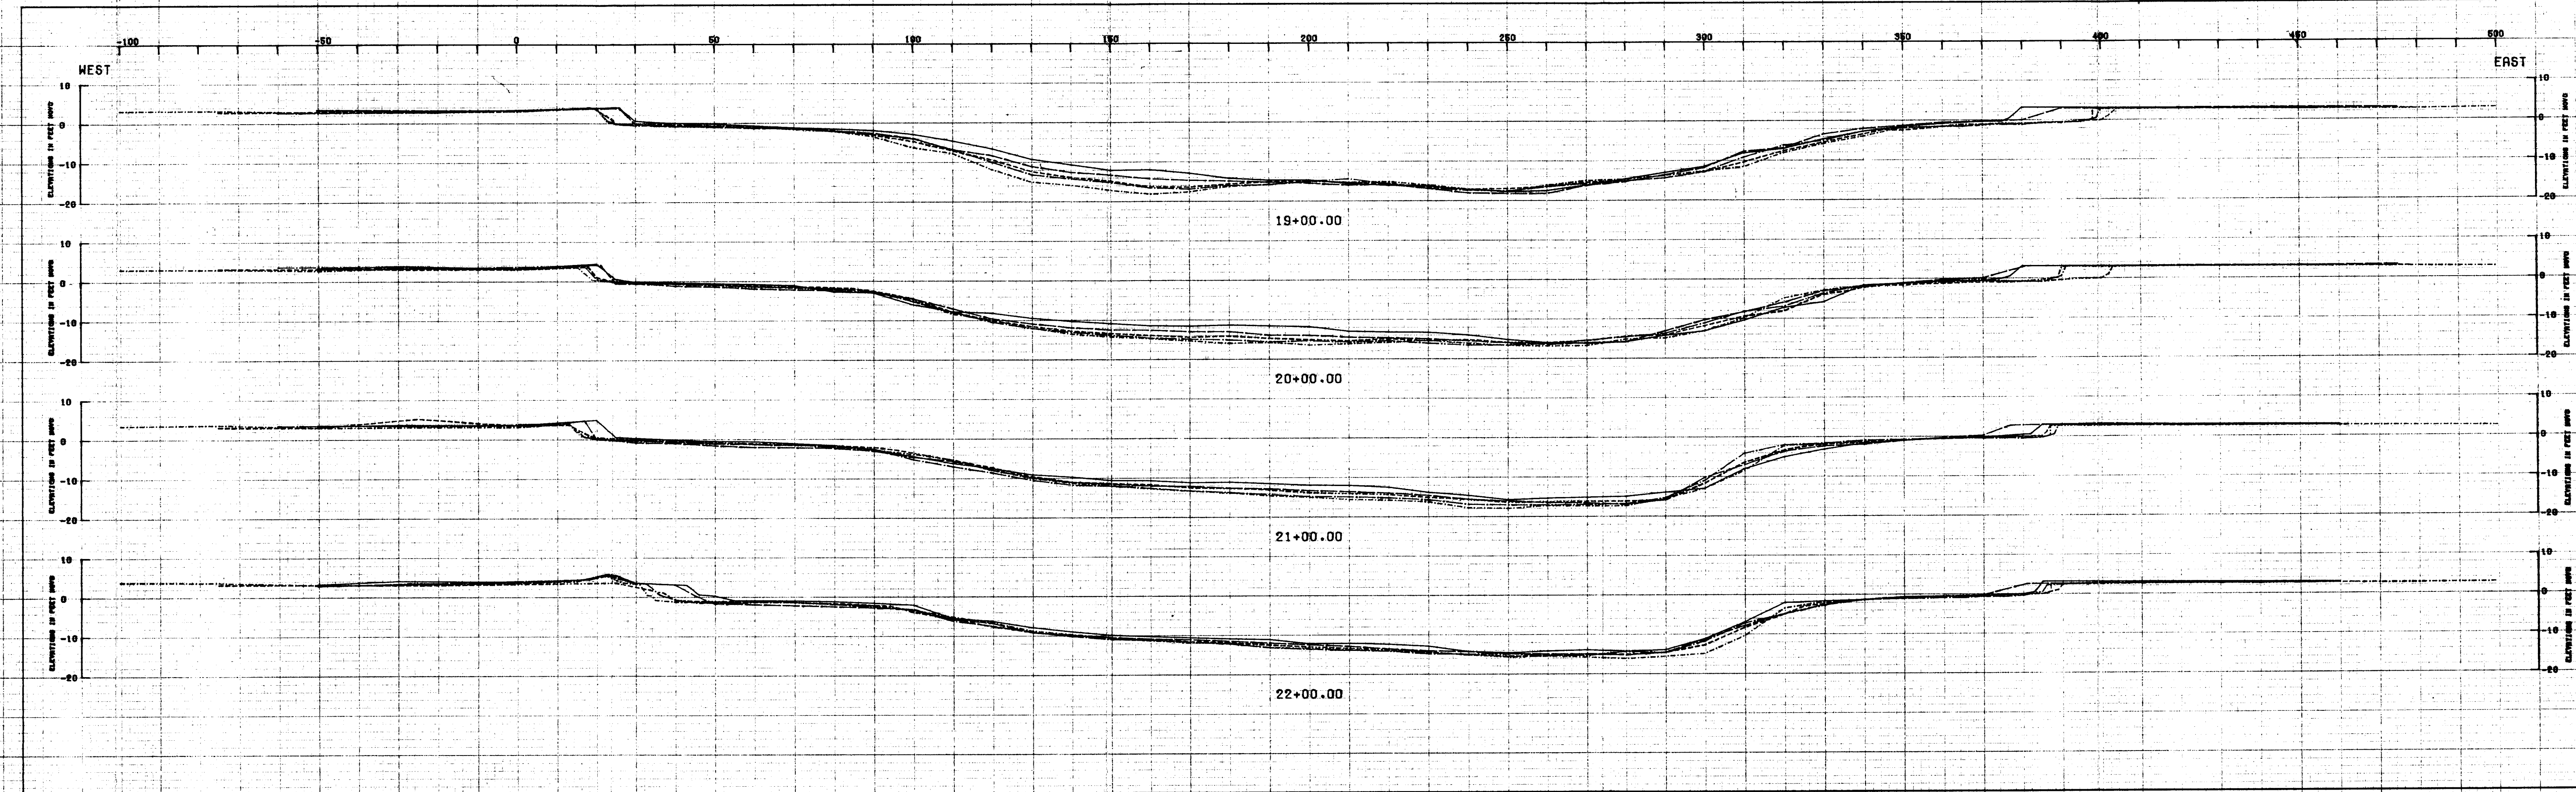


LEGEND

- 17 APR 64 JOB NO. 94-069
- 22 OCT 64 JOB NO. 88-012
- 09 NOV 64 JOB NO. 88-103
- 04 MAR 67 JOB NO. 87-043
- 26 FEB 68 JOB NO. 88-068

NOTE
 1948 SURVEY (AFTER RIPRAP REPAIR)
 SECTIONS PLOTTED LOOKING WEST

STATION	LAKE PONCHARTRAIN LA. AND VICINITY
19+00.00	BAYOU SIEBVENUE CONTROL STRUCTURE
20+00.00	PERIODIC INSPECTION
21+00.00	COMPARATIVE SECTIONS (FY 88)
22+00.00	U.S. ARMY ENGINEERS AND ARCHITECTS CORPS OF ENGINEERS
	FEBRUARY 1988

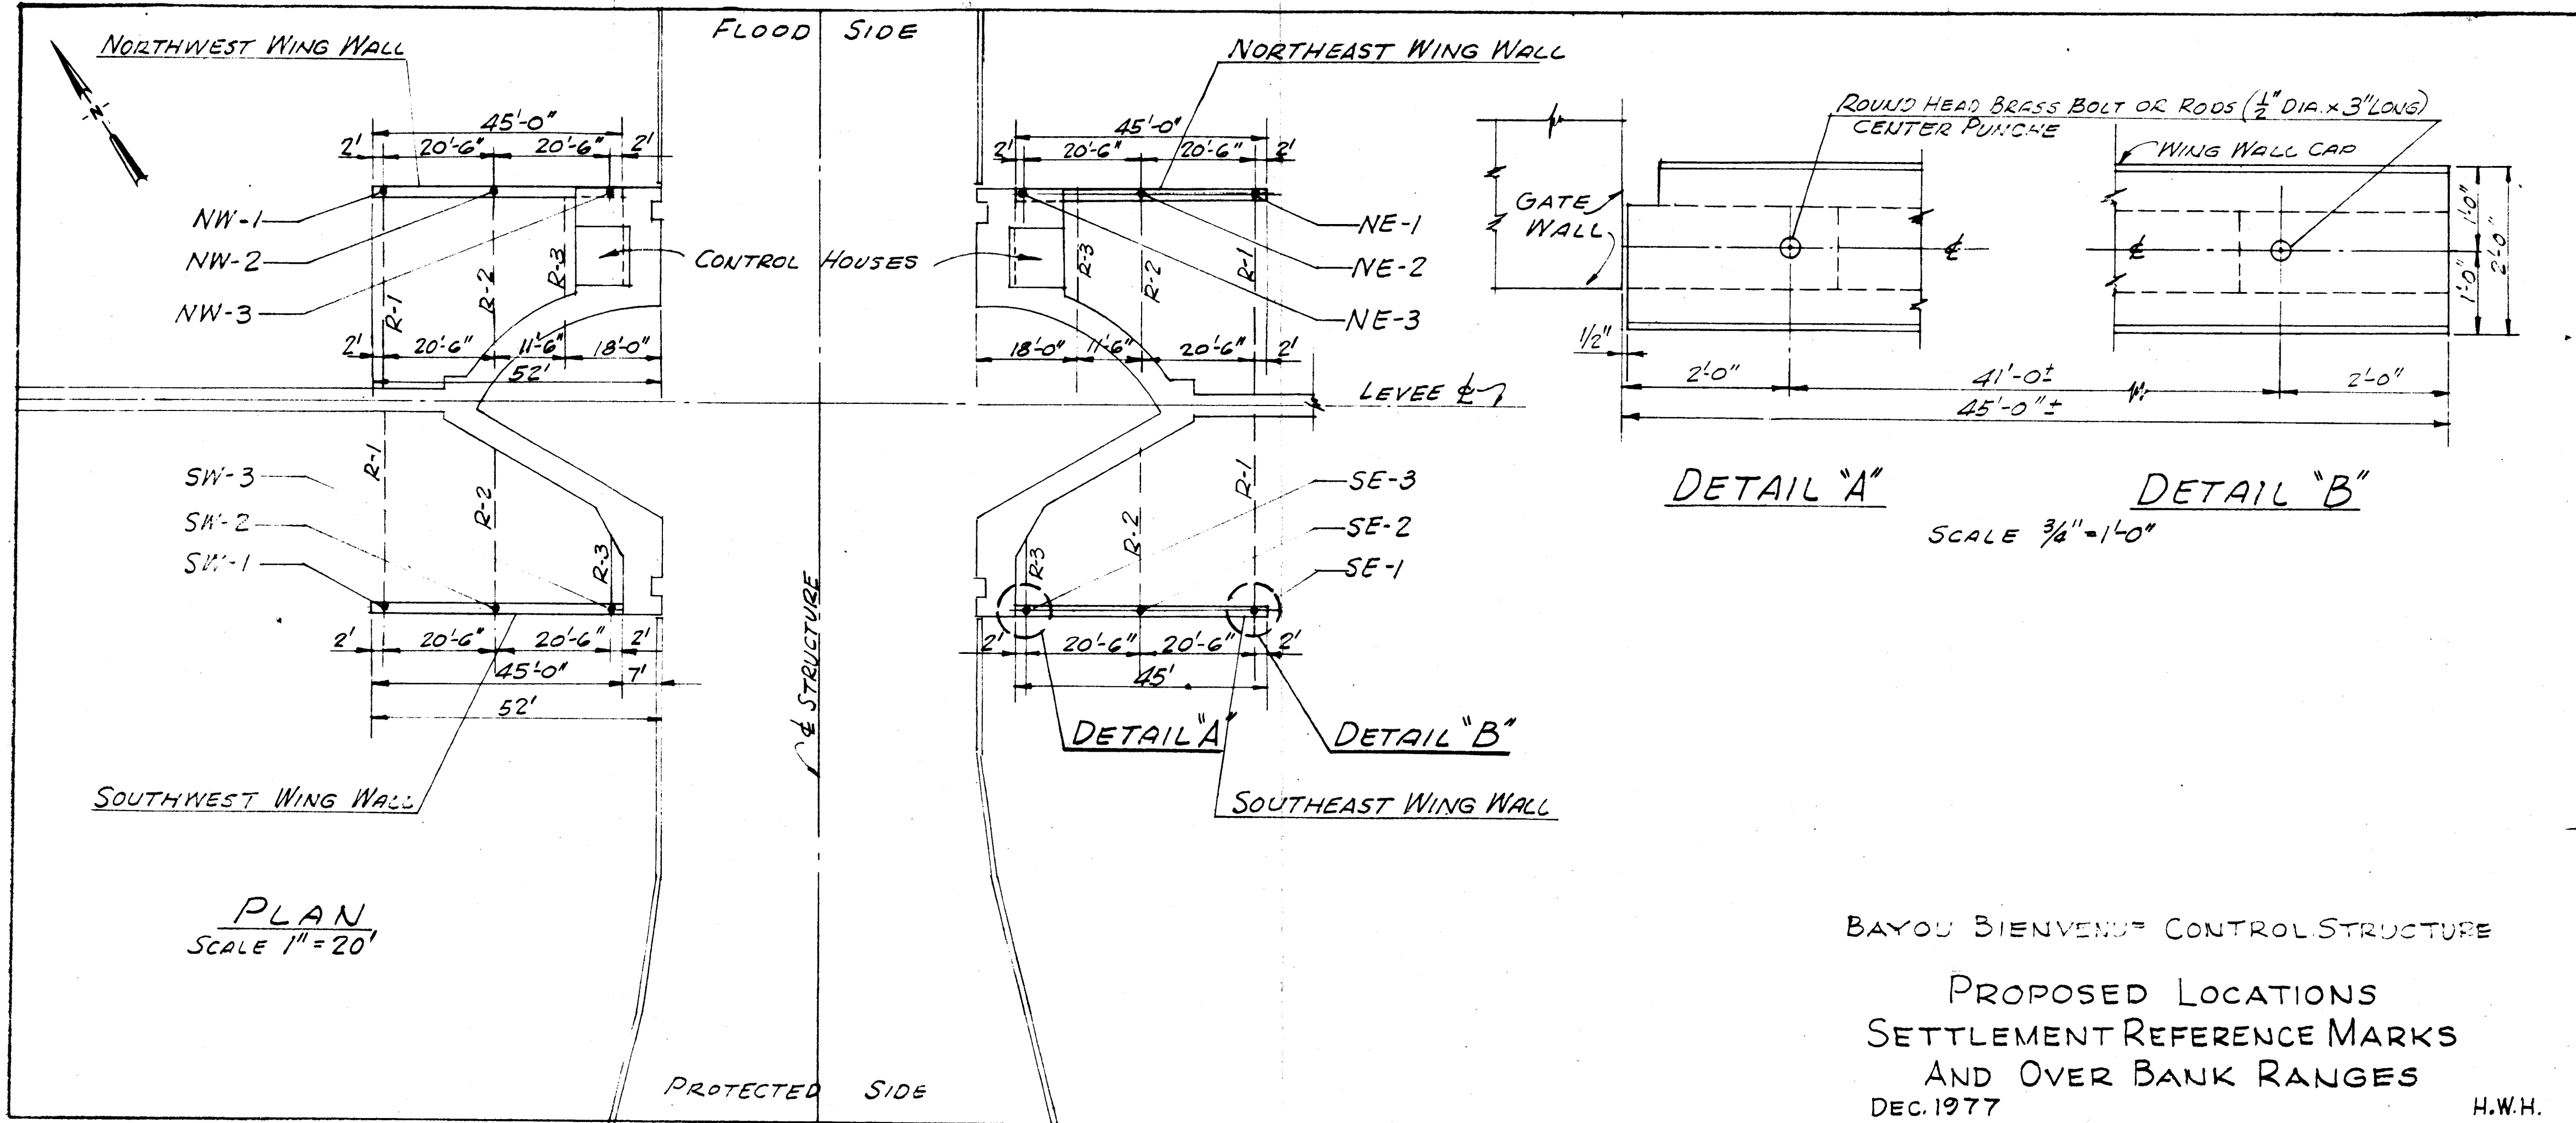

NORTHWEST WING WALL

FLOOD SIDE

NORTHEAST WING WALL

NW-1
NW-2
NW-3

CONTROL HOUSES

NE-1
NE-2
NE-3

ROUND HEAD BRASS BOLT OR RODS (1/2" DIA. x 3" LONG)
CENTER PUNCHES

WING WALL CAP

GATE WALL

LEVEE 7

SW-3
SW-2
SW-1

SE-3
SE-2
SE-1

DETAIL "A"

DETAIL "B"

SCALE 3/4" = 1'-0"

SOUTHWEST WING WALL

STRUCTURE

SOUTHEAST WING WALL

PLAN
SCALE 1" = 20'


PROTECTED SIDE


BAYOU BIENVENUE CONTROL STRUCTURE

PROPOSED LOCATIONS
SETTLEMENT REFERENCE MARKS
AND OVER BANK RANGES

DEC. 1977

H.W.H.

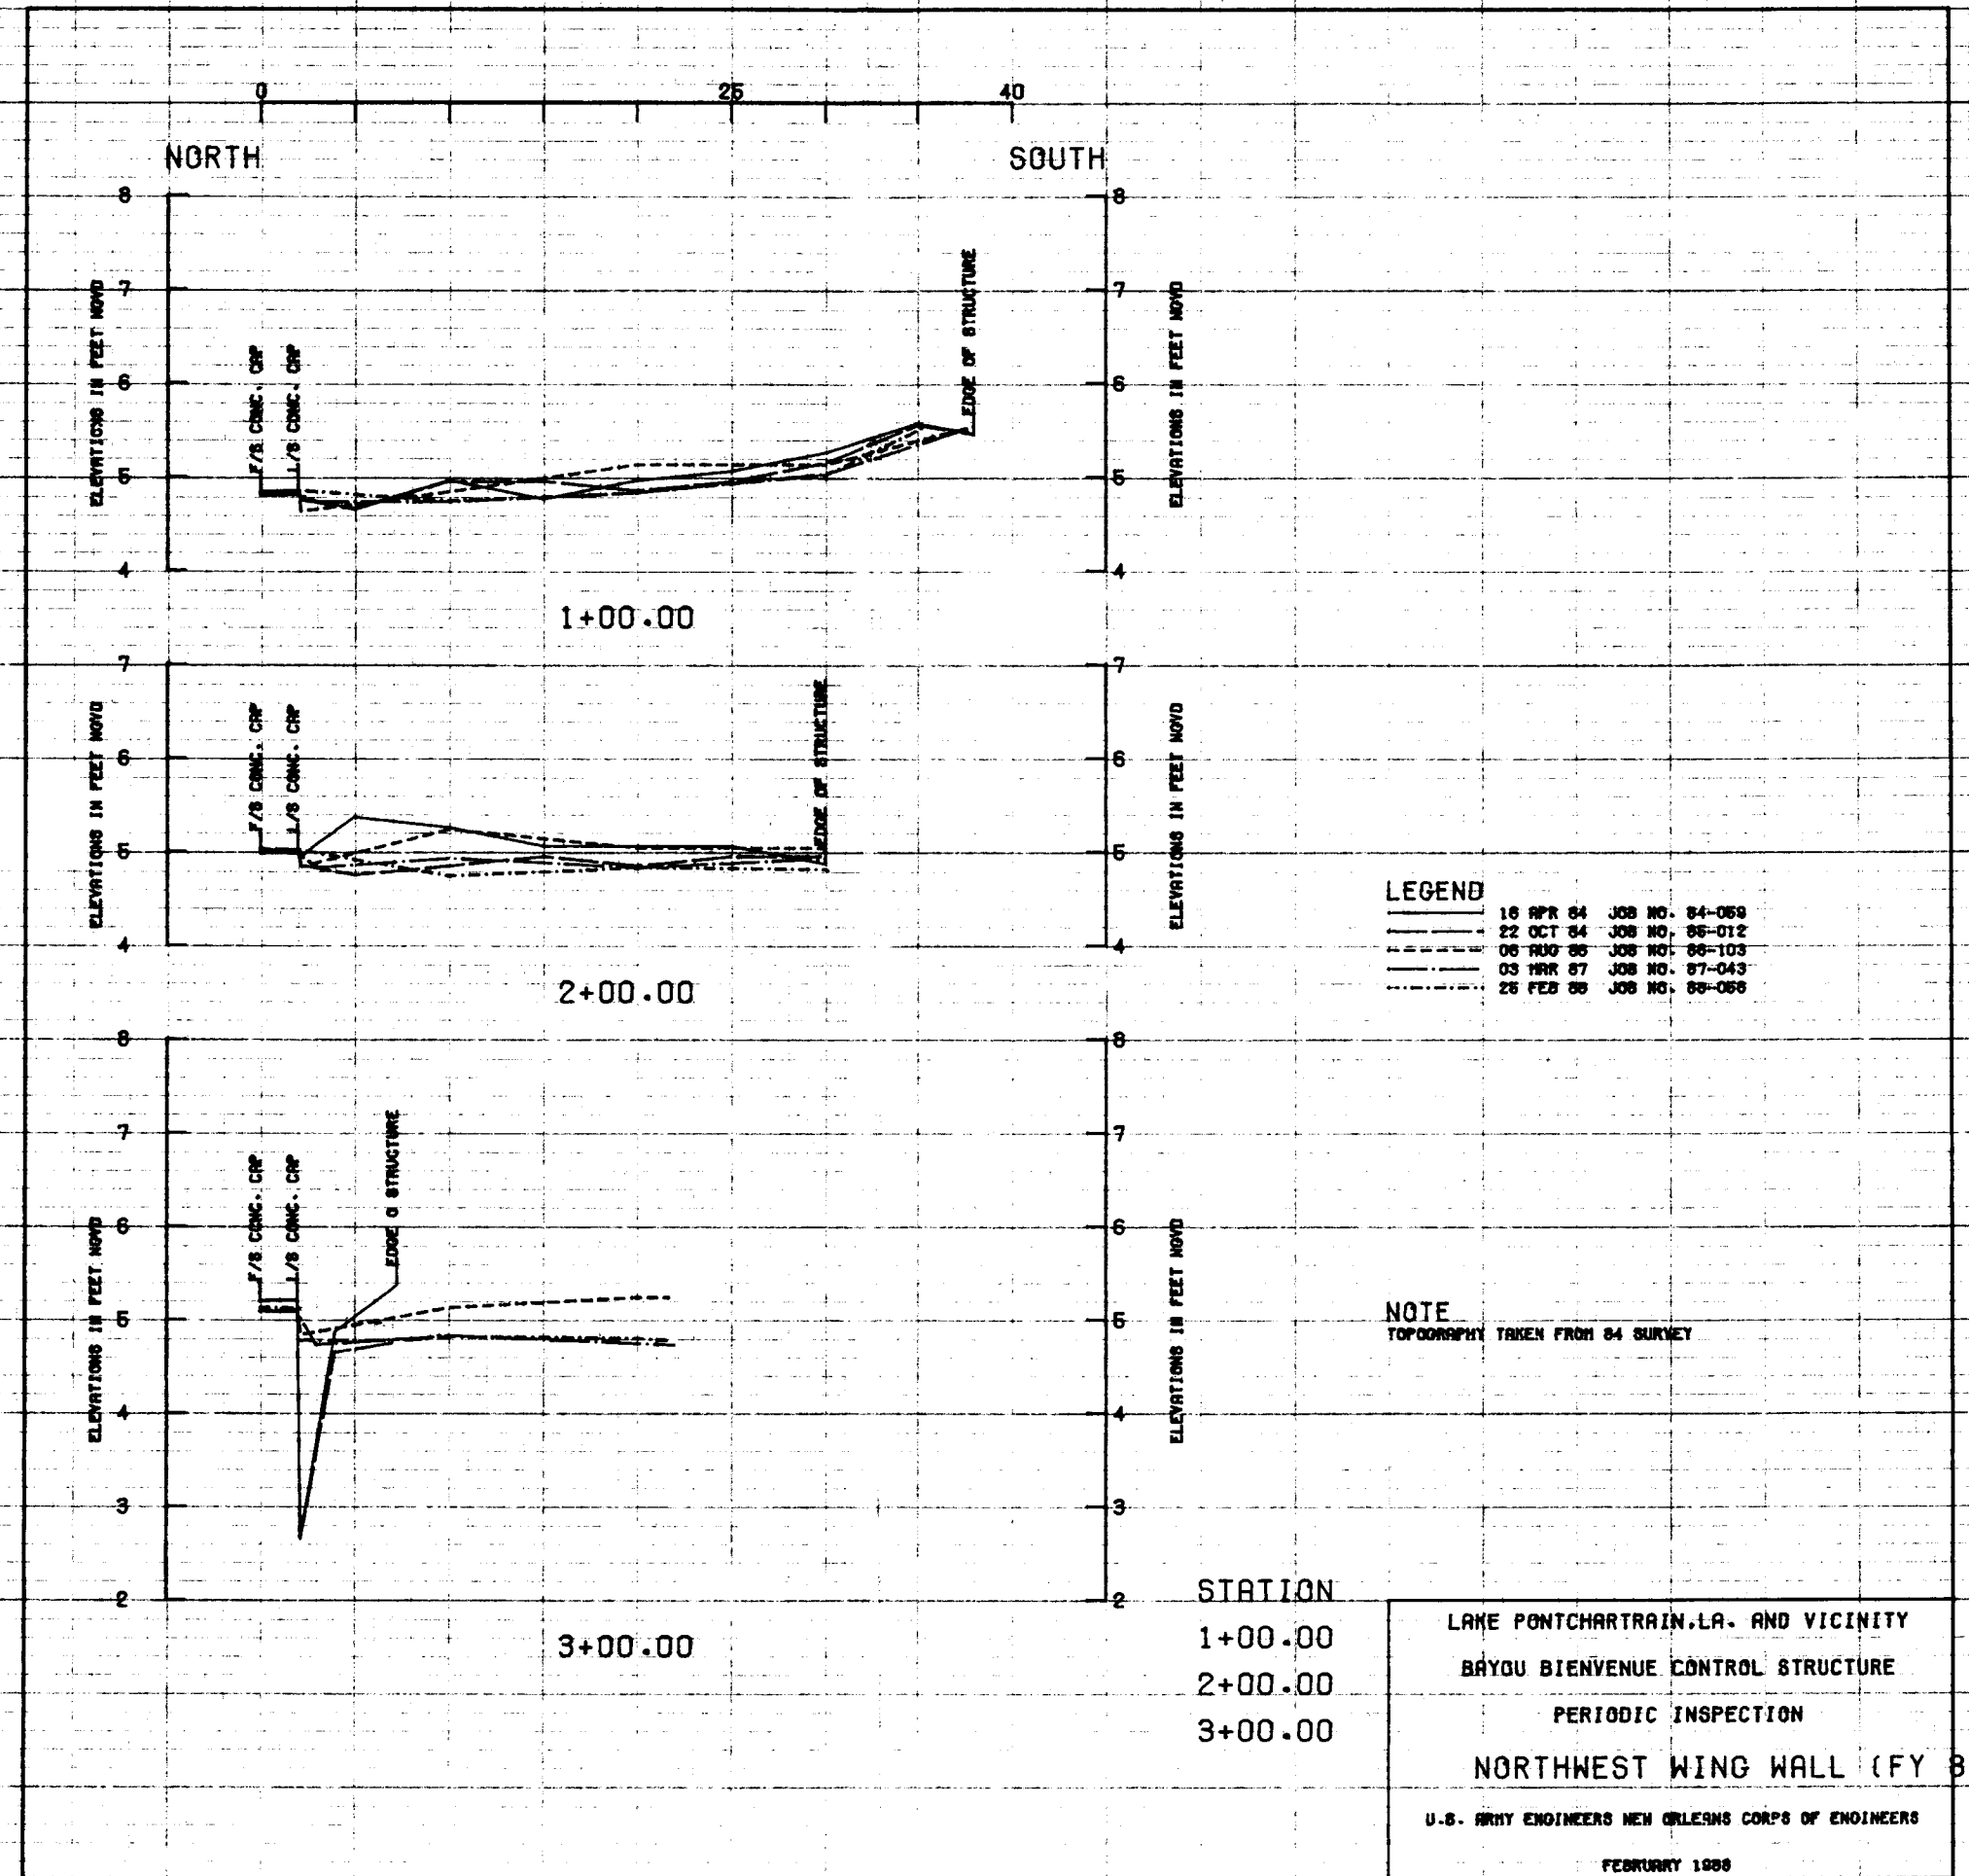

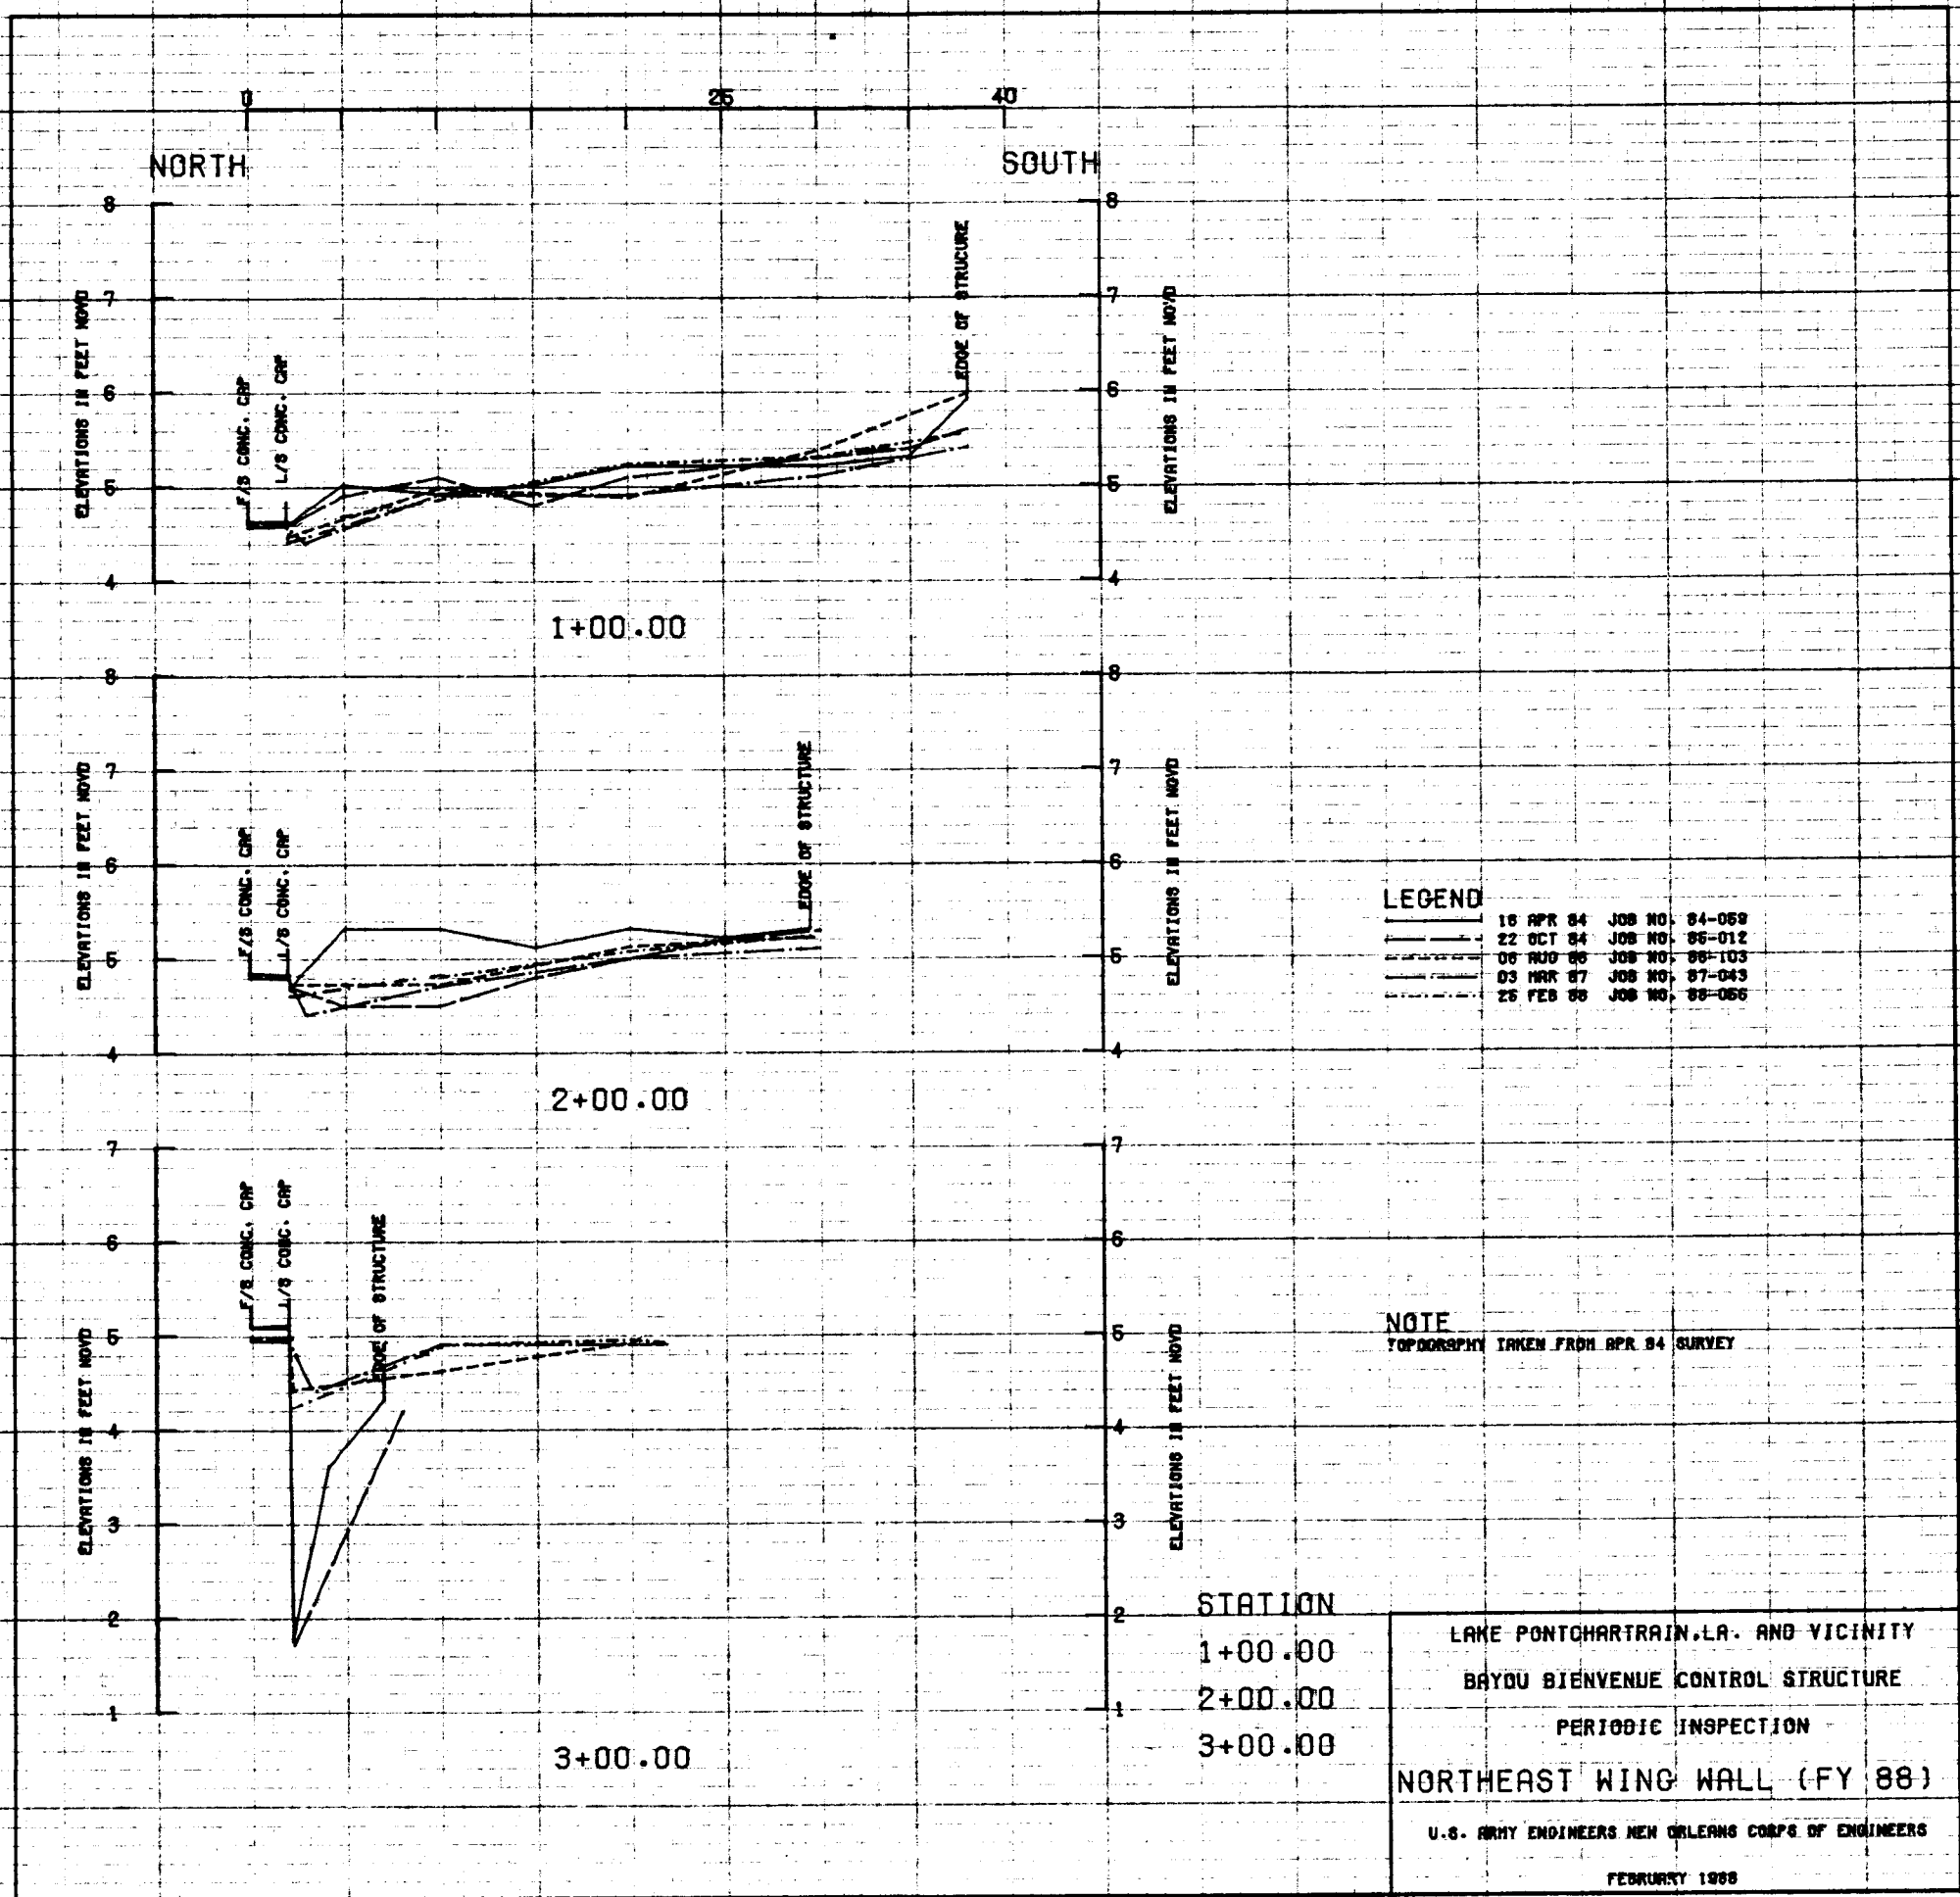


LEGEND

16 APR 84	JOB NO.	84-069
22 OCT 84	JOB NO.	86-012
08 NOV 86	JOB NO.	88-103
03 MAR 87	JOB NO.	87-043
26 FEB 88	JOB NO.	88-066

NOTE
 TOPOGRAPHY TAKEN FROM APR 84 SURVEY

STATION
 1+00.00
 2+00.00
 3+00.00

LAKE PONTCHARTRAIN, LA. AND VICINITY
 BAYOU BIENVENUE CONTROL STRUCTURE
 PERIODIC INSPECTION
 NORTHEAST WING WALL (FY 88)
 U.S. ARMY ENGINEERS NEW ORLEANS CORPS OF ENGINEERS
 FEBRUARY 1988

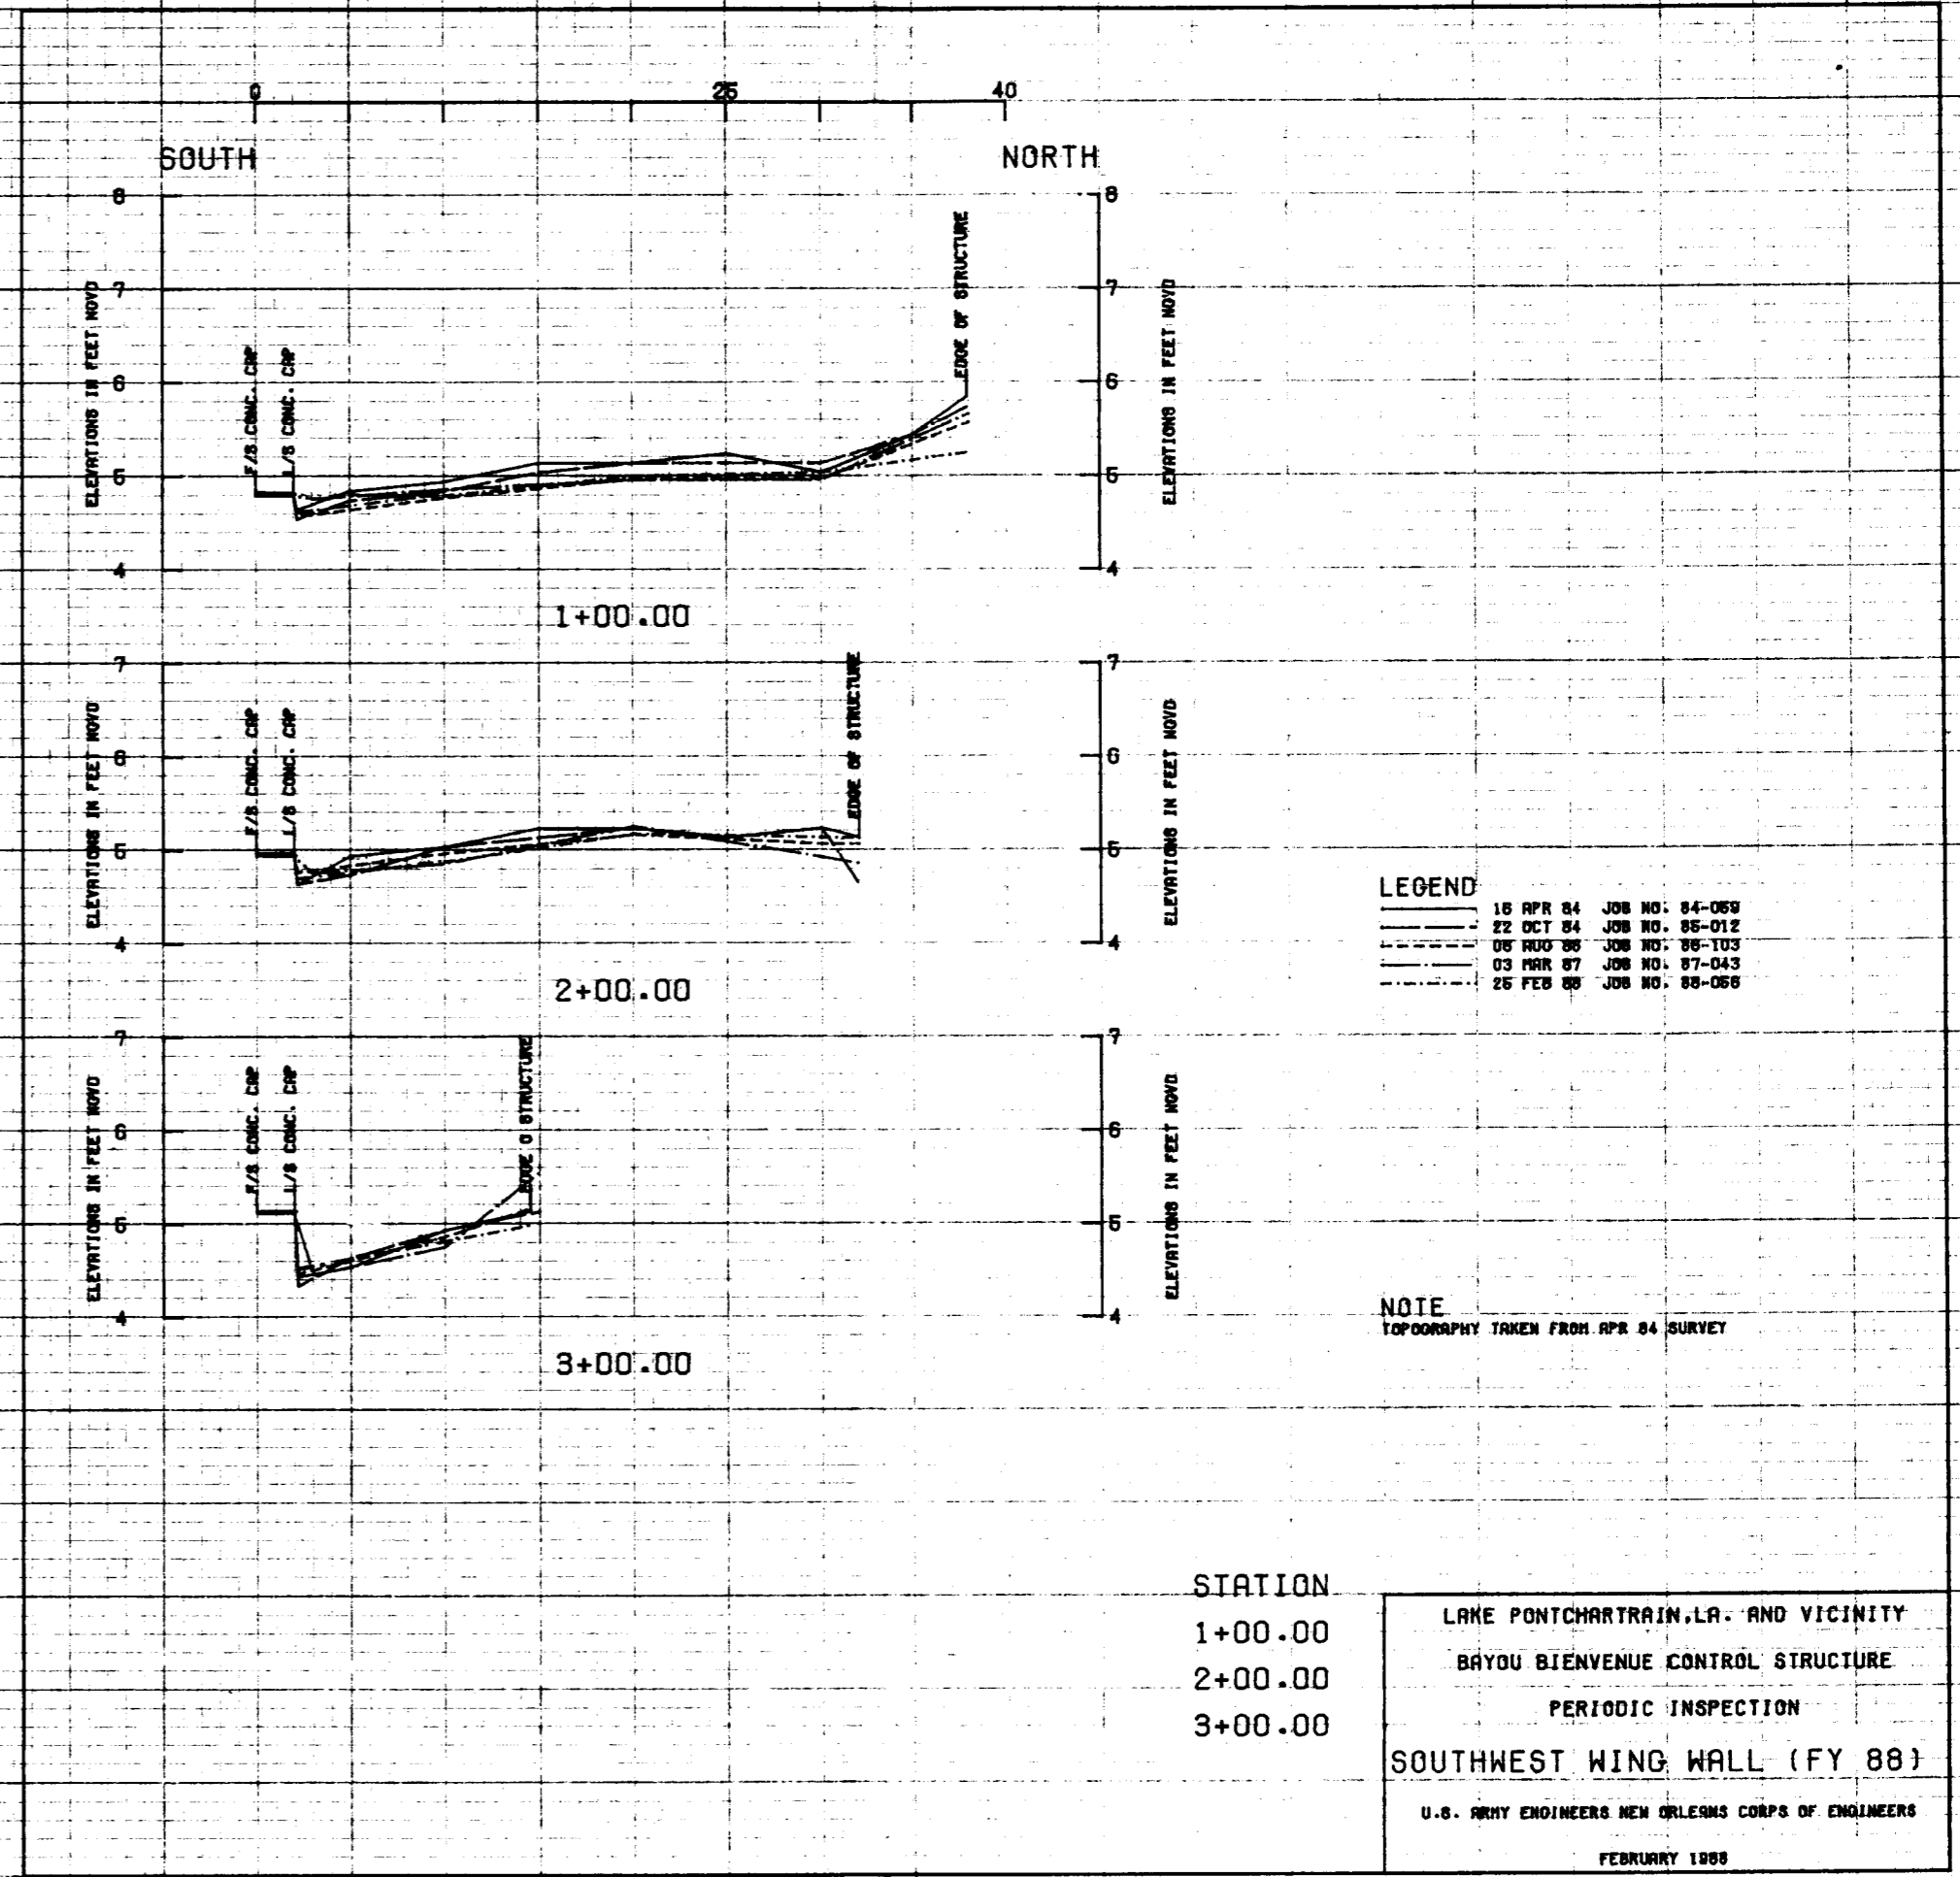


LEGEND

16 APR 84	JOB NO: 84-069
22 OCT 84	JOB NO: 85-012
08 AUG 86	JOB NO: 86-103
03 MAR 87	JOB NO: 87-043
26 FEB 88	JOB NO: 88-068

NOTE
 TOPOGRAPHY TAKEN FROM APR 84 SURVEY

STATION
 1+00.00
 2+00.00
 3+00.00

LAKE PONTCHARTRAIN, LA. AND VICINITY
 BAYOU BIENVENUE CONTROL STRUCTURE
 PERIODIC INSPECTION
 SOUTHWEST WING WALL (FY 88)
 U.S. ARMY ENGINEERS NEW ORLEANS CORPS OF ENGINEERS
 FEBRUARY 1988

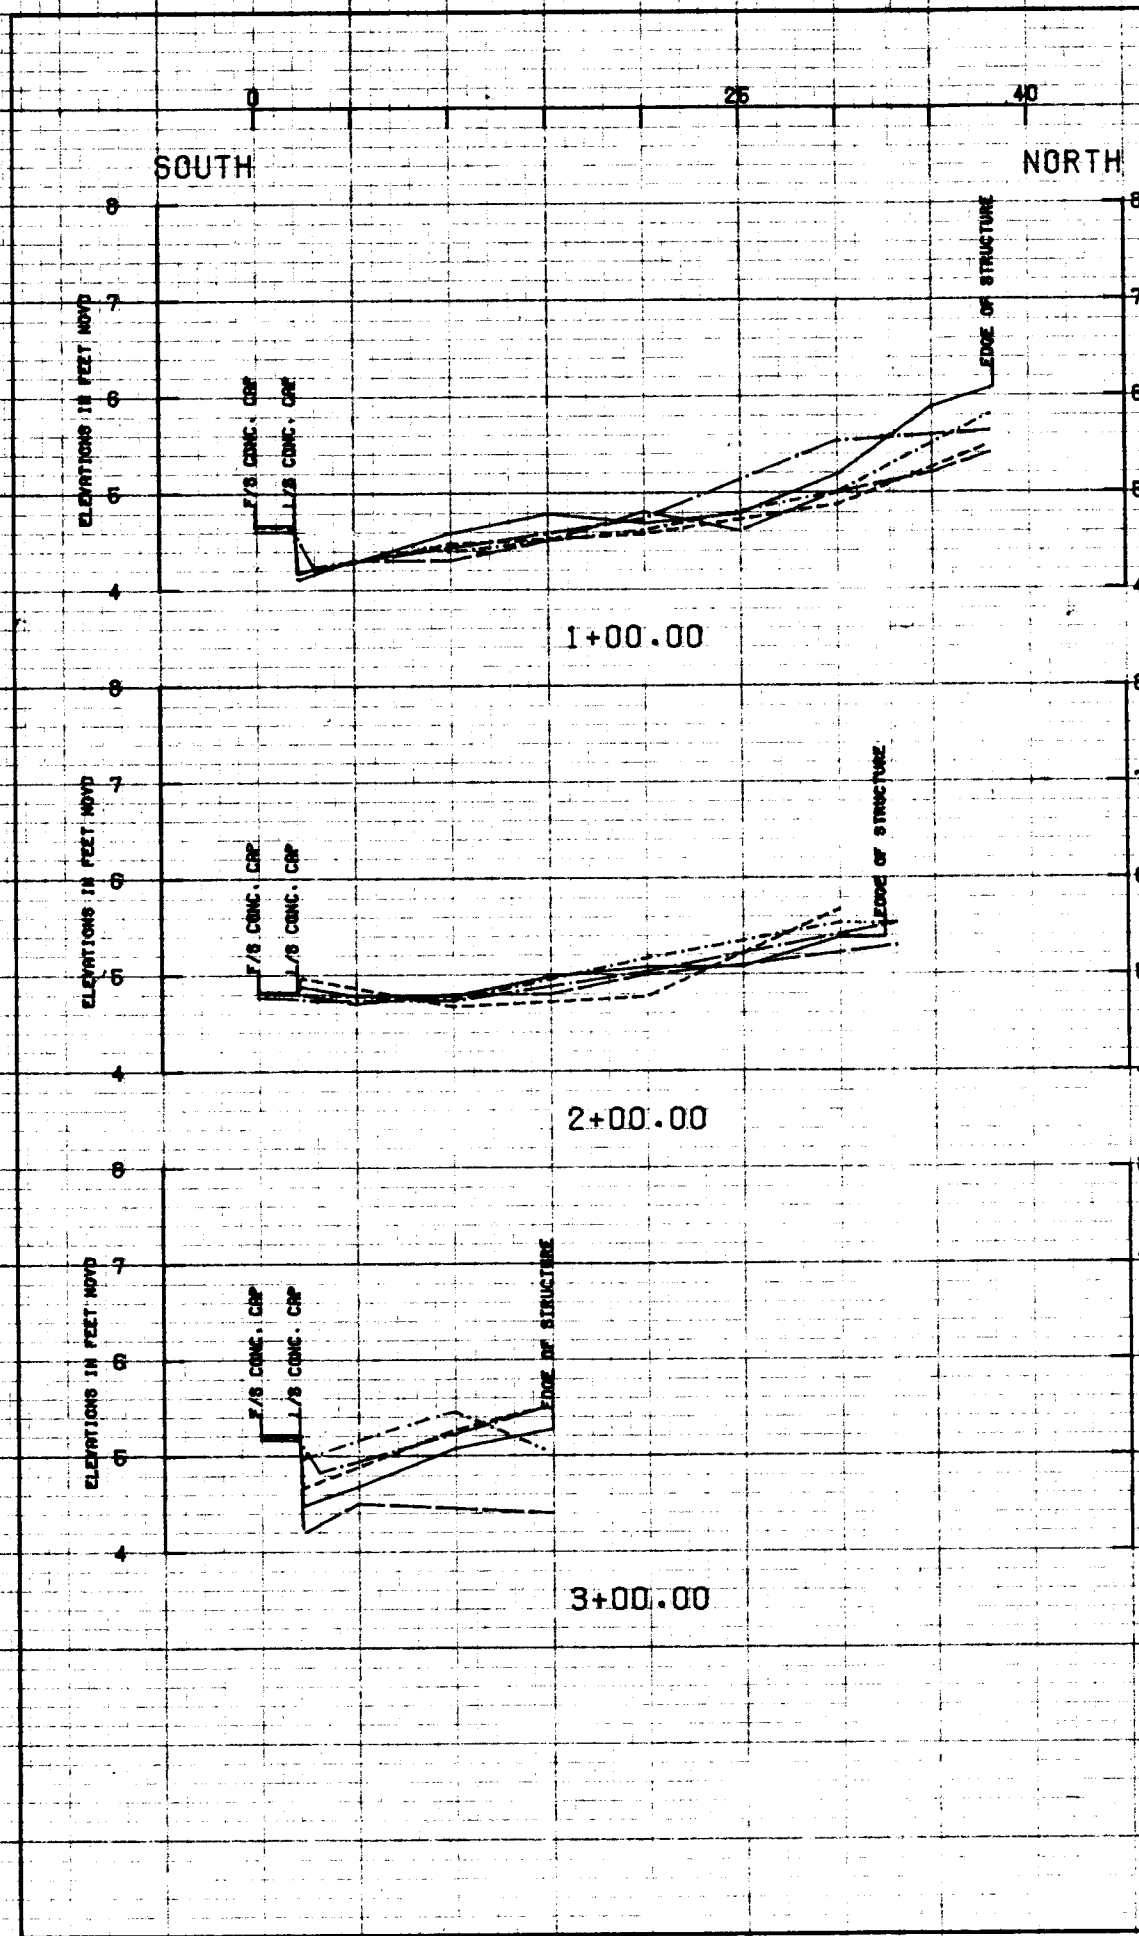

LEGEND

—	16 APR 84	JOB NO. 84-088
- - -	22 OCT 84	JOB NO. 85-012
- · - · -	08 AUG 86	JOB NO. 86-103
- · - · -	03 MAR 87	JOB NO. 87-043
- · - · -	26 FEB 88	JOB NO. 88-088

NOTE
 TOPOGRAPHY TAKEN FROM APR. 84 SURVEY.

STATION
 1+00.00
 2+00.00
 3+00.00

LAKE PONTCHARTRAIN LA. AND VICINITY
 BAYOU BIENVENUE CONTROL STRUCTURE
 PERIODIC INSPECTION
 SOUTHEAST WING WALL (FY 88)
 U.S. ARMY ENGINEERS NEW ORLEANS CORPS OF ENGINEERS
 FEBRUARY 1988

SECTION V - INSPECTION

5-01 Inspection Team. The inspection of the Bayou Bienvenue Control Structure was conducted on 29 March 1988 by the following personnel:

NOD

Johnny Drummond	Gen Engr Sec
Charles Laborde	Struc Des Sec
Gerard Jesclard	Gen Engr Sec (Elec)
Dennis Strecker	Gen Engr Sec (Mech)
Troy Constance	H&H Br
Roberto Estrada	F&M Br (Struc)
Charles Rome	F&M Br (Materials)
Jerry Colletti	O&R Div
Colette Duffour	O&R Div

Orleans Levee Board

Tony Bertucci
Guy Dutsch
Frank Vicidomina

5-02 Orientation. Prior to the inspection, team members were given a brief orientation of the following features of the structure: Structural Considerations, Hydraulics and Hydrology, Foundations and Materials, and Operating Machinery.

5-03 Observations. The inspection was limited to those portions of the structure visible above the water surface. Staff gage readings were 1.5 feet NGVD on the protected side and 1.2 feet NGVD on the MRGO side. The structure was found to be in good condition.

- a. The riprap along the banks of the north and south approach channels behind the guidewalls is deficient. See Photo No. 1.
- b. A navigation light on the northeast timber guide was broken.
- c. The ladder attached to the west sector gate was corroded at the tidal zone.
- d. Rust spots were found at the tidal zone on the structural steel members of the east sector gate.
- e. The steel plates attached to the needle girder recesses were corroded.
- f. All staff gages on the structure need to be cleaned and repaired.
- g. The differential settlement between reference marks B8 & B9 has not increased since the last inspection. This was a point of previous concern.
- h. The gates and electrical equipment were in good operating condition.



Photo 1-Deficient Riprap(Typical for the banks along the north and south approach channels)

SECTION VI-CONCLUSIONS AND REMEDIAL ACTIONS

6-01 Conclusions. It is concluded that the Bayou Bienvenue Control Structure is safe, structurally stable and in satisfactory operating condition.

6-02 Remedial Actions. The following work will be accomplished by local interest, the Orleans Levee Board, during periodic maintenance repairs to the structure.

a. Plans and specifications are being prepared to install riprap along the banks of the north and south approach channels behind the guidewalls. This work is estimated for completion in the 4th Quarter of FY 89.

b. Navigation lights are repaired or replaced shortly after problems are noted. Due to the isolated location of the structure, broken lights resulting from gun shots are a continuous problem.

c. Rust and corrosion on steel members, ladders and steel plates will be repaired periodically when tidal conditions permit.

d. Staff gages will be cleaned, repaired or replaced periodically.

6-03 Next Inspection. The next inspection of the Bayou Bienvenue Control Structure is scheduled for March 1991.