

CEMVN-CD-NO-Q

28-Apr-00

MEMORANDUM THRU Area Engineer, NOAO
C/Const Div ATTN: Contract Admin Sec.

FOR C/Eng Div.

SUBJECT: Narrative Completion Report for Contract Number DACW29-98-C-0050, Lake Ponchartrain, Louisiana and Vicinity, Hurricane Protection Project, High Level Plan, Orleans Parish Lakefront Levee, Orleans Marina Phase V – Sluice Gates, Orleans Parish, Louisiana.

1. The subject contract was awarded on 18 June 1998, to Boh Bros Construction Company, L.L.C., 730 S. Toni St., New Orleans, LA 70153. The Notice to Proceed was issued on 18 July 1998, with construction scheduled to commence no later than 28 July 1998. The original completion date was scheduled for 14 September 1999 and the original contract amount was \$2,774, 760.00.
2. Required work under this contract included construction of an H-Pile supported foundation slab, reinforced concrete structure, aluminum bulkheads, sluice gates with electrical operators, access stairway and walkway, and other work as needed.
3. The Preconstruction Conference was held at the New Orleans Area Office on 16 July 1998. The detailed minutes of the meeting are located in the contract file. The Notice to Proceed was issued to the contractor at the Preconstruction Conference and physical construction began on 23 July 1998 with the mobilization of the field offices and the erection of the safety fence.
4. The contract provided for the following construction phases: (1) Electrical Ductbank Installation, (2) Underwater Excavation, (3) Temporary Cofferdam Construction, (4) Driving Steel H-Piles, (5) Catwalk and Weir Flap Gate, (6) Stone Placement, (7) Dewatering, (8) Concrete Demolition, (9) Misc. Metalwork, and (10) Sluice Gate Structure Construction.
5. Electrical Ductbank Installation: On 29 October 1998, the contractor held the preparatory meeting for installing the ductbank from Sewer and Water Board Pumping Station #12 to the location of the sluice gates structure. On 9 November 1998, the contractor began to selectively saw-cut sections of Lake Marina Dr. and Pontchartrain Blvd. in preparation for the ductbank installation. After saw-cutting the roadway material, asphalt and concrete, an 18" wide by 54" deep excavation was made for installation of the ductbank. The bottom of the ductbank was covered with an 8" layer of crushed concrete before various lengths of 16" x 16" ductbank sections were placed in the hole and covered with 18" of red color coded concrete. The remaining 14" of the excavation was filled with the previously excavated material followed by 8" of compacted crushed concrete and approximately 6" of hot asphaltic concrete to match the existing pavement. The work was done in various segments as

the ductbank was fabricated offsite and to avoid inconvenience to traffic. The electrical work was not complete until the sluice gate structure was brought on line in February 2000. During the construction, access to the local businesses was not interrupted, as 1" steel plates were used to cover all open excavations.

6. Underwater Excavation: On 3 November 1998, the contractor held the preparatory meeting for the underwater excavation. On 6 November 1998, the contractor began excavating the New Basin Canal within the jobsite construction limits. The contractor used a 4,000 Manitowoc crane to dig the canal to elevation -17.5', and watertight dump trucks hauled the excavated material to the disposal site at the New Orleans Lakefront Airport. All work associated with excavation of the canal was completed on 19 November 1998.
7. Temporary Cofferdam: On 20 November 1998, the contractor held the preparatory meeting for installation of the temporary cofferdam. On 1 December 1998, the contractor began driving the steel sheet piles for the cofferdam using an ICE 812 vibratory hammer. During this operation the contractor drove (24) 81.5' long AZ48 steel sheets piles, (38) 61.0' long AZ48 steel sheet piles, (6) 81.5' long AZ48 steel sheet piles and (14) 63.5' long AZ48 steel piles. The cofferdam was completed on 31 December 1998. Reference MOD A00009 attached.
8. Steel H-Piles: On 14 January 1999, the contractor began setting the template to assist in guiding the steel H-Piles underwater. On 20 January 1999, the contractor held the preparatory meeting for driving Steel H-Piles, and on 21 January 1999, the contractor drove the first H-Pile in the designated area for the sluice gate structure. A Boh/Vulcan 08 impact hammer and a Manitowoc 4000 crane were used to drive the 101' long piles to the required tip elevation. All of the piles had staggered splice marks, with the splice at least 40' from the end of the pile. The contractor completed driving of all H-Piles except the 7 affected by the underwater, concrete obstruction on 8 February 1999. These remaining 7 H-Piles were driven between 5-7 October 1999.
9. Catwalk and Weir Flap Gate: On 3 February 1999, the contractor held the preparatory meeting for the installation of the catwalk and weir flap gates along the temporary cofferdam. From 18 February 1999 through 22 February 1999, the contractor placed the catwalk with aluminum handrail and iron weir flap gates along the cofferdam on the north side of the project. The weir flap gates were steel plates totaling 91' 7" from east to west under the walkway, with the top elevation of 4.5 NGVD and the bottom elevation of 2.5 NGVD. The catwalk was 110' long from east to west and made of steel angle iron, aluminum grating and aluminum handrails equipped with Nu-Rail accessories. Once the work on the sluice gate structure was completed, the temporary cofferdam and catwalk system was removed from the New Basin Canal.
10. Stone: On 3 February 1999, the contractor held the preparatory meeting for bedding material and stone protection. On 24 February 1999, the contractor began placing the bedding material under water in the New Basin Canal starting at elevation -17.5' up to elevation -15.33', the bottom of the 4" stabilization slab. On 26 February 1999, the

contractor began placing the stone "A" along the south side of the cofferdam around the limits of the foundation slab. The stone "A" was placed from elevation -16.0 NGVD to elevation -11.5 NGVD. A 4,000 Manitowoc crane was used to place the stone in the flooded cofferdam and a survey party was present to verify the final grades. Throughout construction of the structure, the stone elevations were monitored and brought back to design grade as necessary. All stone work was completed on 2 March 1999 with final placement of the 18" riprap required for scour protection.

11. Dewatering: On 16 June 1999, the contractor held a Preconstruction meeting for dewatering the temporary cofferdam. On 6 July 1999, the contractor began the dewatering process by activating 2 pumps to remove the surface water from the cofferdam and discharge it into the adjacent New Basin Canal. When the surface water elevation, inside the cofferdam dropped from approximate elevation 3.0 NGVD to elevation -8.0 NGVD, the temporary cofferdam began to show signs of deflection and possible failure. To avoid a collapse of the cofferdam, the hole was flooded and the dewatering operation was shutdown until an analysis could be made to determine the necessity for added bracing to the cofferdam. The result of the analysis was to add a whale and strut system and to place additional crushed concrete to stabilize the cofferdam. On 31 August 1999, after placement of added bracing to both the west and east side of the cofferdam, the contractor was able to completely dewater the cofferdam. Through the use of sump pumps, ground water pumps and piezometers, the contractor was able to keep the cofferdam dewatered within acceptable limits during construction. Several times during the project, the Sewer & Water Board flooded the cofferdam area to facilitate operation of Pumping Station #12. All such occurrences took place without incidence and when pumping was complete, the flooded cofferdam area was again dewatered. It would take roughly 4 to 6 hours to pump all water from the cofferdam area. Upon completion of the sluice gate structure, the cofferdam was flooded a final time and the catwalk and all steel sheet pile were removed with an ICE 812 vibratory hammer and a Manitowoc 3900 crane.
12. Demolition of Concrete: On 13 September 1999, the contractor held a preparatory meeting on removal of the concrete face of the existing concrete. After this meeting, the contractor's subcontractor, A & A Enterprises, began to work to remove the portion of the concrete face from the existing culverts necessary for grouting of the new waterstop. The initial work was to saw-cut an outline in the concrete to be used as a guide for the jackhammers and chipping guns. When A & A Enterprises completed saw-cutting this outline in the concrete, jackhammers and chipping guns were brought in to complete the removal of the concrete face. On 1 October 1999, all work was complete with concrete removal from the face of the culverts. On 22 October 1999, after cleaning and smoothing the culvert face, #6 rebar dowels were inserted into the culverts and epoxied with HILTI HVU M20X170. To complete the new culvert face, a 9" waterstop was set in formwork around the culverts and #6 rebar, and concreted with 4000 psi concrete.
13. Sluice Gate Structure: On 14 October 1999, the contractor began setting the formwork for the 4" stabilization slab. This slab was poured in four segments

between 14 and 19 October 1999 with the use of an American 5399 crane and a ¾ CY concrete bucket. After placement of the stabilization slab was complete, the contractor began work on the foundation slab for the new structure. Daily quality assurance inspection was supplied to verify the correct formwork, steel rebar, and clearances, and on 5 November 1999, the foundation slab was placed with a concrete pump truck . After placement of the foundation slab, the contractor proceeded with construction of the walls and slabs necessary to frame the new structure. By 20 January 2000, all concrete placements had been made and the formwork removal began. A Combination of concrete buckets and pump trucks was used to place the concrete for these walls and slabs. By 27 January 2000, all of the formwork had been removed and the structure was ready to accept the new sluice gates and bulkheads. All handrails and finishing work on the new structure took place in the weeks that followed 27 January 2000.

14. Misc. Metalwork: On 21 June 1999, the contractor began driving the treated timber piles for the access walkway/stairway with a Lorraine 70 ton mobile crane and a Vulcan #1 air impact hammer. Once the timber piles were driven, 2 steel reinforced concrete pads were constructed as a foundation for the walkway/stairway. On 13 July 1999, the contractor began assembling the aluminum walkway over the floodway at gate L-4. On 15 July 1999, all work on the walkway over gate L-4 was complete with aluminum rails, grating and NU-Rail accessories installed where required. On 20 January 2000, the contractor began installing the walkway and handrails across the floodwall to the new sluice gate structure. The contractor used the required aluminum railings, grating and accessories where required. On 3 February 2000, all the misc. metalwork on the contract was complete.
15. Sluice Gates: On 4 February 2000, the contractor used a 3900 Manitowoc crane to start installing the sluice gates in the concrete structure. On 9 February 2000, the contractor had completed installing the four new sluice gates, stems, and motors. On 23 February 2000, all the electrical boxes were in place and power was connected to the sluice gates, and all interested parties were onsite to witness a successful demonstration of the new facility.
16. Demobilization: By 6 April 2000, the contractor had removed all equipment, scaffolds, fencing and containers from the job site. The roadways had been cleared, temporary roads and parking areas had been returned to their pre-construction conditions, and the project was called substantially complete.
17. Included herewith is a comparison of contract quantities versus actual quantities. A copy of the “As Built” drawings is also included.

Item	Description	Contract Quantity	Unit Price	Estimated Amount	Actual Quantity	Actual Amount
0001	Mob. & Demob.	Lump Sum	L.S.	\$150,000.00	100%	\$150,000.00
0002	Reserved	-	-	-	-	-
0003	Selective Demolition	Lump Sum	L.S.	\$20,000.00	100%	\$20,000.00
0004	Modifications to Existing Orleans Marina Boat Dock	Lump Sum	L.S.	\$1,000.00	100%	\$1,000.00
0005	Construction Dewatering	Lump Sum	L.S.	\$100,000.00	100%	\$100,000.00
0006	Cofferdam	Lump Sum	L.S.	\$600,000.00	100%	\$600,000.00
0007	Excavation	Lump Sum	L.S.	\$468,053.02	100%	\$468,053.02
0008	Riprap	415 Tons	\$50.00	\$20,750.00	351.40 Tons	\$17,570.00
0009	Stone "A"	340 Tons	\$50.00	\$17,000.00	343.33 Tons	\$17,166.50
0010	Bedding	230 CY	\$55.00	\$12,650.00	607.27 Tons	\$33,399.85
0011	Drainage Material	230 CY	\$55.00	\$12,650.00	0 Tons	\$0.00
0012	Timber Piles	2,550 LF	\$9.00	\$22,950.00	499.30 LF	\$4,493.70
0013	Pulled and Redriven Mooring Piles	Lump Sum	L.S.	\$100.00	100%	\$100.00
0014	Removal and Disposal of Existing Mooring Piles	Lump Sum	L.S.	\$12,000.00	100%	\$12,000.00
0015	Steel H-Piles	6,262 LF	\$30.00	\$187,860.00	6,262.00 LF	\$187,860.00
0016	Diving Services	Lump Sum	L.S.	\$22,500.00	100%	\$22,500.00
0017	Paving	Lump Sum	L.S.	\$20,000.00	100%	\$20,000.00
0018	Concrete	Lump Sum	L.S.	\$542,553.00	100%	\$542,553.00
0019	Tremie Stabilization Slab	Lump Sum	L.S.	\$0.00	0%	\$0.00
0020	Miscellaneous Metalwork	Lump Sum	L.S.	\$96,000.00	100%	\$96,000.00
0021	Aluminum Bulkheads	Lump Sum	L.S.	\$100,000.00	100%	\$100,000.00

Item	Description	Contract Quantity	Unit Price	Estimated Amount	Actual Quantity	Actual Amount
0022	Sluice Gates	Lump Sum	L.S.	\$380,000.00	100%	\$380,000.00
0023	Electrical Work	Lump Sum	L.S.	\$50,000.00	100%	\$50,000.00
0024	Removal of Local/Remote Switches	Lump Sum	L.S.	\$902.00	100%	\$902.00
0025	Constructive Suspense Costs Associated with Delays for Rewinding Electric Motors	Lump Sum	L.S.	\$84,391.48	100%	\$84,391.48
0026	Flood Repairs	Lump Sum	L.S.	\$14,657.36	100%	\$14,657.36
0027	Removal of Obstruction and Add Bracing N.W. Corner of Cofferdam	Lump Sum	L.S.	\$170,864.00	100%	\$170,864.00
0028	Add Bracing N.E. Corner of Cofferdam	Lump Sum	L.S.	\$133,694.00	100%	\$133,694.00
0029	Non Destructive Testing of Bulkheads	Lump Sum	L.S.	\$2,975.55	100%	\$2,975.55
0030	Reinforcement of Vertical Splice of Aluminum Bulkheads	Lump Sum	L.S.	\$4,052.07	100%	\$4,052.07

18. There were 36 modifications to the contract and a summary of each follows:

- a. P00001 (CAN-01) - Modified Payment Office. No changes to contract price or time.
- b. P00002 (CAN-03) - Incorporated Year 2000 Compliance. No changes to contract price or time.
- c. P00003 (FM-001) - Increased Available Funds by \$2,000,000.00. No changes to contract price or time.
- d. P00004 (FM-002) - Increased Available Funds by \$174,460.00. No changes to contract price or time.
- e. P00005 (CO-02) - Cancelled by P00006. No changes to contract price or time.
- f. P00006 (CO-02) - Allowed for removal of an underwater obstruction by replacing the 12-inch tremie slab with a 4-inch stabilization slab, replacing all drainage material with bedding material and adding additional reinforcement to the temporary cofferdam so that dewatering could take place in advance of foundation slab placement. No changes to contract price or time.
- g. P00007 (CAN-02) - Incorporated Electronic Funds Transfer Clause. No changes to contract price or time.
- h. P00008 (FM-003) - Decreased Available Funds by \$400,000.00. No changes to contract price or time.
- i. P00009 (FM-004) - Increased Available Funds by \$44,200.00. No changes to contract price or time.
- j. P00010 (FM-005) - Increased Available Funds by \$100,000.00. No changes to contract price or time.
- k. P00011 (CO-08) - Revised cofferdam bracing to avoid interference with upper walls. No changes to contract price or time.
- l. P00012 (FM-006) - Increased Available Funds by \$329,455.00. No changes to contract price or time.
- m. P00014 (CIN 05 and CIN 09) - Settled CO-02, CO-05 and CO-06 which allowed for removal of an underwater obstruction by replacing the 12-inch tremie slab with a 4-inch stabilization slab, replaced all drainage material with bedding material and added additional reinforcement to the temporary cofferdam so that dewatering could take place in advance of foundation slab placement. Increased contract price by \$269,558.00. Increased contract time increased by 98 calendar days. Increased Available Funds by \$269,558.00.

- n. P00015 (CAN-04) - CT Administrative Modification. No changes to contract price or time.
- o. P00016 (FM-007) - Increased Available Funds by \$129,929.48. No changes to contract price or time.
- p. A00001 (CO-01) - Provided for rewinding of the butterfly gate valve operators from 60 Hz to 25 Hz. No changes to contract price or time.
- q. A00002 (CIN-02) - Provided for addition re-steel at H-Piles. Increased contract price by \$1,554.00. No changes to the contract time.
- r. A00003 (CIN-01) - Definitized CO-01 which allowed for rewinding of the butterfly gate valve operators from 60 Hz to 25 Hz. No changes to contract price or time.
- s. A00004 (CO-03) - Removed the Local/Off/Remote switch from both the butterfly gate valve operator panels and the sluice gate operator panels. No changes to contract price or time.
- t. A00005 (CIN-04) - Revised the design of the sluice gate hoist beam. Increased contract price by \$26,000.00. No changes to the contract time.
- u. A00006 (CO-04) - Directed excavation of material from behind the dock. No changes to contract price or time.
- v. A00007 (CIN-06) - Definitized CO-03 which removed the Local/Off/Remote switch from both the butterfly gate valve operator panels and the sluice gate operator panels. Increased contract price by \$902.00. No changes to the contract time.
- w. A00008 (CO-05) - Directed the contractor to stop dewatering the cofferdam. No changes to contract price or time.
- x. A00009 (CO-06) - Added bracing to the northeast corner of the cofferdam. No changes to contract price or time.
- y. A00010 (CO-07) - Cancelled.
- z. A00011 (CIN-12) - Removed debris from 200 linear feet of box culvert downstream of Pumping Station #12. Increased contract price by \$44,200.00. Increased contract time by 11 calendar days.
 - aa. A00012 (CIN-10) - Added a concrete bonding agent between the new and existing culverts. Increased contract price by \$999.00. No change to contract time.

- bb. A00013 (CIN-16) - Reimbursed contractor for costs incurred as a result of delays associated with rewinding butterfly gate valve operators. Increased contract price by \$84,391.48. Increased contract time by 80 calendar days.
- cc. A00014 (CIN-11) - Reimbursed contractor for damage caused by operation of Pumping Station #12's pumps on 2 September 1999. Increased contract price by \$8,426.67. Increased contract time by 2 calendar days.
- dd. A00015 (CIN-15) - Reimbursed contractor for damage caused by operation of Pumping Station #12's pumps on 12 December 1999. Increased contract price by \$930.49. No change to contract time.
- ee. A00016 (CO-09) - Added a 3/8" thick by 6" wide flat bar over the bottom 10' of the vertical splice of bulkhead skin plate. No changes to contract price or time.
- ff. A00017 (CIN-07) - Definitized CO-04 which directed excavation of material from behind the dock. Contract price increased by \$23,853.02. Contract time increased by 14 calendar days.
- gg. A00018 (TE-001) - Extended contract time due to unusually severe weather between 17 July 1998 and 31 January 2000. No change to contract price. Increased contract time by 2 calendar days.
- hh. A00019 (CIN-17) - Reimbursed contractor for setting aluminum bulkheads on stands for nondestructive weld testing. Increased contract price by \$2,975.55. No change to contract time.
- ii. A00020 (CIN-18) - Definitized CO-09 which added a 3/8" thick by 6" wide flat bar over the bottom 10' of the vertical splice of bulkhead skin plate. Increased contract price by \$4,052.07. No change to contract time.
- jj. A00021 (CIN-19) - Reimbursed contractor for damage caused by operation of Pumping Station #12's pumps on 20 and 21 September 1999 and 11 October 1999. Increased contract price by \$5,300.20. No change to contract time.
- kk. A00022 (CAN-05) - Added drawings that were omitted from P00011.
- ll. A00023 (CIN-14) - Definitized CO-08 which revised cofferdam bracing to avoid interference with upper walls. Increased contract price by \$22,962.83. Increased contract time by 9 calendar days.

19. Subcontractors performing work on this contract along with their responsibilities were also follows:

- a. Barnes Electric Co., Inc., 432 Dakin St., Jefferson, LA. Installed all electrical ductbank and conduits.

- b. A & A Enterprises Inc., 2401 Piedmont St., Kenner LA. Demolition of existing culvert.
- 20. The contractor submitted and enforced an adequate Accident Prevention Program. The contractor performed daily safety inspections and weekly toolbox safety meetings. Monthly manager's safety meetings were also held. There were no accidents during the contract performance period.
- 21. The contractor was efficient, professional and cooperative in the performance of the contract work, and Quality Control activities were performed throughout the life of the project. All noted deficiencies were promptly corrected.

Henry Carr
Quality Assurance Representative

SUBJECT: Narrative Completion Report for Contract Number DACW29-98-C-0050,
Lake Ponchartrain, Louisiana and Vicinity, Hurricane Protection Project, High Level
Plan, Orleans Parish Lakefront Levee, Orleans Marina Phase V – Sluice Gates, Orleans
Parish, Louisiana.

Project Engineer (Gremillion)

Project Inspector (Carr)

Team Leader (Wagner)

~~Office~~ Office Engineer w/ as built (Thurmond)

CEMVN-CD-CS w/ as built

CEMVN-CD-C

CEMVN-CD-Q

CEMVN-CT

CEMVN-ED-C

CEMVN-ED-TF

CEMVN-PM


OFFICE ENGE "As Built" C.R.S

Safety is a Part
of Your Contract

PLANS FOR
HURRICANE PROTECTION
LAKE PONTCHARTRAIN, LOUISIANA
AND VICINITY
HIGH LEVEL PLAN
ORLEANS PARISH, LA.

NEW ORLEANS LAKEFRONT LEVEE
WEST OF I.H.N.C.

ORLEANS MARINA PHASE V - SLUICE GATES
ORLEANS PARISH, LOUISIANA

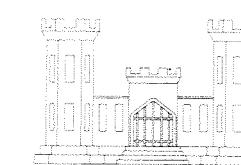


US Army Corps
of Engineers
New Orleans District



1997

DRAWINGS IN THIS FOLIO
HAVE BEEN REDUCED ONE
HALF THE ORIGINAL SCALE



H-4-44778

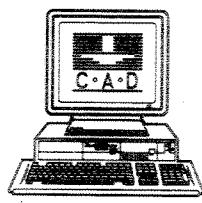

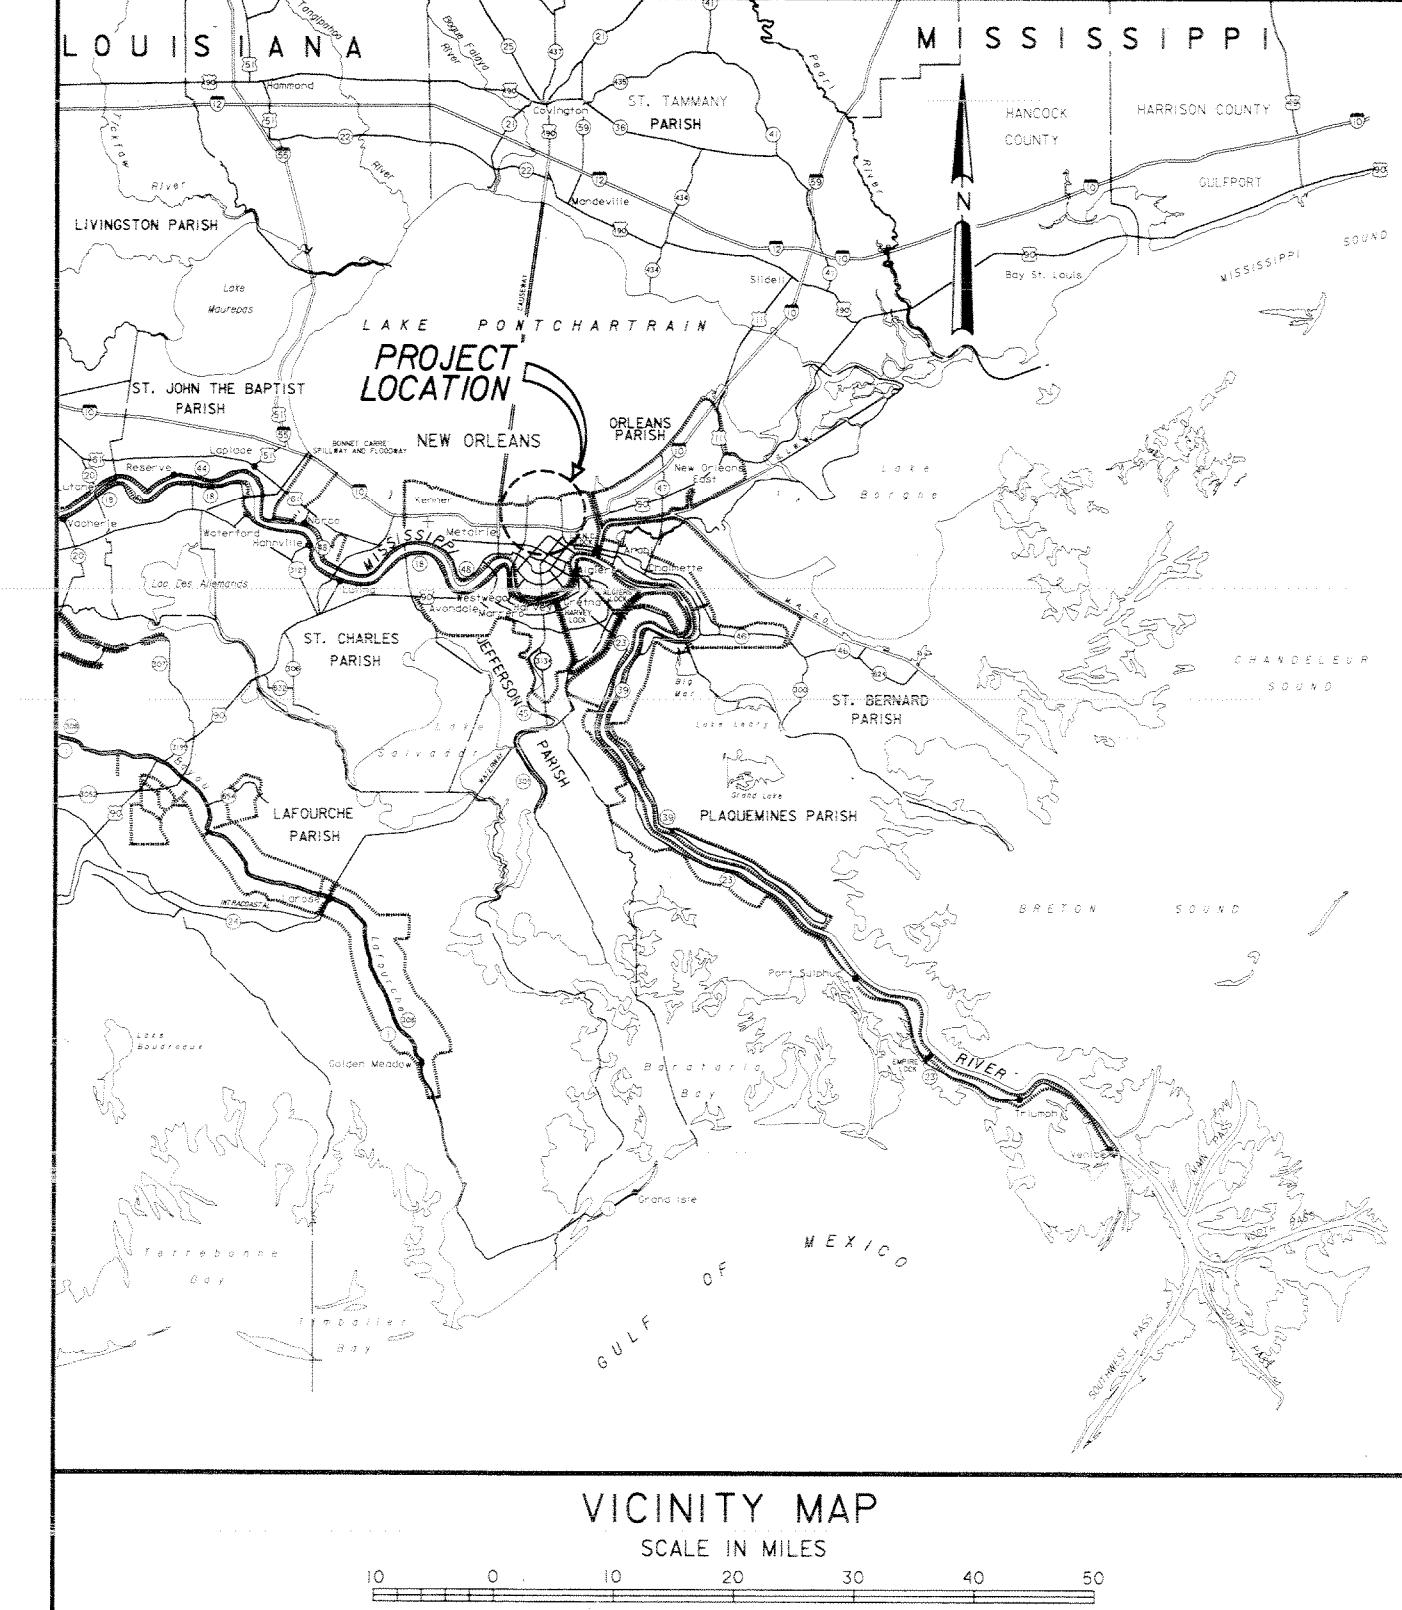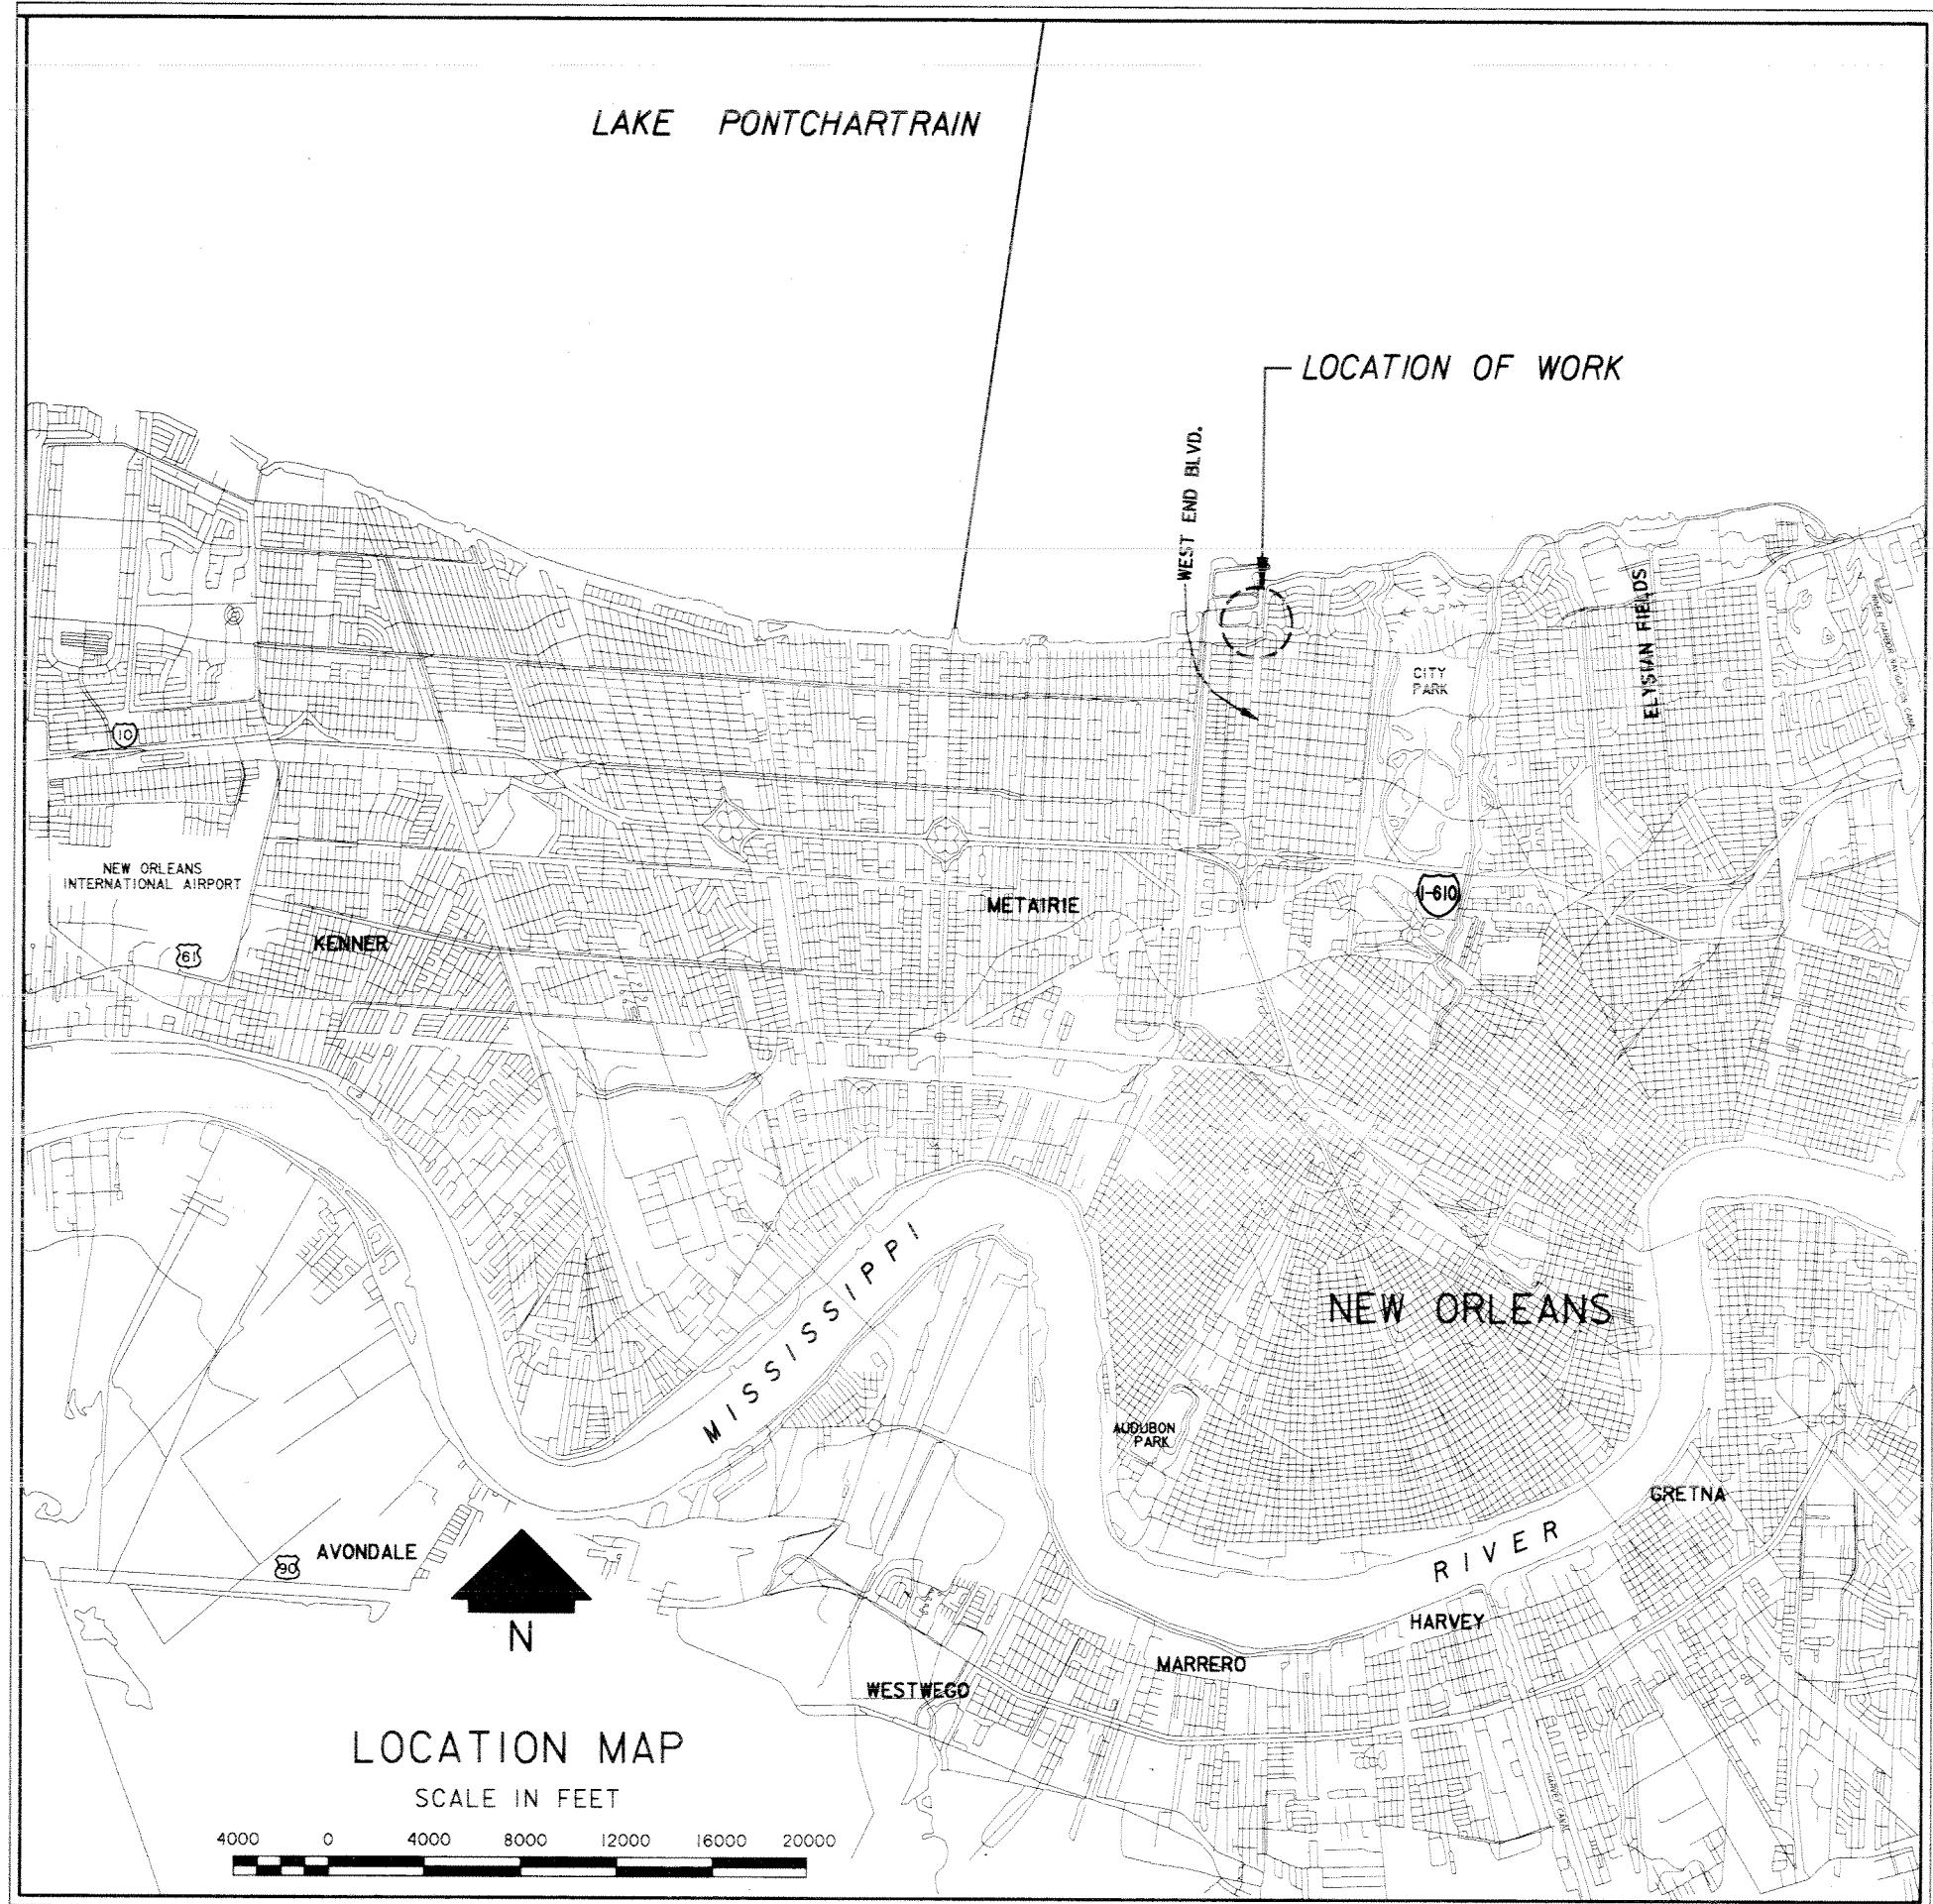

TABULATION OF BENCH MARK		
DESIGNATION	DESCRIPTION	ELEVATION
N GATE 2 NO. 3 1966	LOCATED IN THE NORTHWEST SECTION OF NEW ORLEANS, AT WEST END NEAR THE LAKE FRONT, BETWEEN PONTCHARTRAIN BLVD. AND WEST END BLVD. JUST NORTH OF ROBERT E. LEE BLVD., AT THE NEW ORLEANS SEWERAGE AND WATER BOARD PUMPING STATION NO. 12. IT IS 27.82 FEET SOUTH OF TRIANGULATION STATION N GATE 2 1966. ONE (1) FOOT NORTH OF THE NORTHEAST CORNER OF THE STAIRS 4 FEET EAST OF THE WEST RAIL OF THE HOIST. IT IS A STANDARD REFERENCE MARK DISK SET IN A DRILLED HOLE IN THE CONCRETE DECKING OF THE PUMPING STATION.	11.478 N.G.V.D. (1964 EPOCH)

THIS PROJECT WAS DESIGNED BY THE NEW ORLEANS DISTRICT OF THE U.S. ARMY CORPS OF ENGINEERS. THE INITIALS OR SIGNATURES AND REGISTRATION DESIGNATIONS OF INDIVIDUALS APPEARING ON THESE PROJECT DOCUMENTS ARE WITHIN THE SCOPE OF THEIR EMPLOYMENT AS REQUIRED BY ER 1110-1-8152.

Safety is a Part
of Your Contract

SYMBOL	DESCRIPTION	DATE APPROVED
	U.S. ARMY ENGINEER DISTRICT, NEW ORLEANS CORPS OF ENGINEERS NEW ORLEANS, LOUISIANA	
LAKE PONTCHARTRAIN, LOUISIANA AND VICINITY HIGH LEVEL PLAN NEW ORLEANS LAKEFRONT LEVEE WEST OF I.H.N.C.		
ORLEANS MARINA PHASE V - SLUICE GATES ORLEANS PARISH, LOUISIANA		
INDEX, LOCATION, AND VICINITY MAP		
DESIGNED BY: C.LABORDE DRAWN BY: J.DARBY CHECKED BY: C.MESTAYER APPROVED BY: C.MESTAYER SOLICITATION NO. DACW29-98-B-0001 PLOT DATE: 12/15/97 PLOT SCALE: 4800 FILE NO. H-4-44778 SUBMITTED BY: C.A.D. CHIEF, STRUCTURES AND UTILITIES SECTION, DISTRICT ENGINEER Albert Ruizinger, PE John S. Baker, PE		
DWG. OF 46		

**Safety is a Part
of Your Contract**

GENERAL NOTES:

1. AZIMUTHS SHOWN ARE MEASURED CLOCKWISE FROM THE SOUTH.
2. ELEVATIONS ARE IN FEET AND REFER TO NATIONAL GEODETIC VERTICAL DATUM (N.G.V.D.).
3. DIMENSIONS AND/OR ELEVATIONS MARKED THUS (\pm) ARE APPROXIMATE. CONTRACTOR SHALL VERIFY ACTUAL DIMENSIONS IN THE FIELD.
4. DIMENSIONS AND/OR ELEVATIONS MARKED THUS (N.T.S.) ARE NOT SHOWN TO SCALE.
5. DRAWINGS ARE GENERALLY TO SCALE, BUT SHOULD NOT BE SCALED. N.T.S. IS SHOWN ONLY WHERE DRAWING IS OBVIOUSLY OUT OF SCALE.
6. BENCH MARKS AND BASE LINES HAVE BEEN ESTABLISHED AT THE SITE BY THE GOVERNMENT.
7. WALL LINE (W/L) STATIONING IS MEASURED ALONG THE FLOOD SIDE FACE OF THE WALL.
1. CONCRETE SHALL HAVE A MINIMUM COMPRESSIVE STRENGTH (F'_c) OF 4000 PSI AT 28 DAYS, UNLESS OTHERWISE NOTED.
2. STABILIZATION SLAB CONCRETE SHALL HAVE A MINIMUM COMPRESSIVE STRENGTH (F'_c) OF 3000 PSI AT 28 DAYS, 90 DAYS IF POZZOLAN IS USED.
3. REINFORCING STEEL SHALL HAVE A MINIMUM YIELD STRENGTH (F_y) OF 60,000 PSI.
4. RESERVED.
5. CONSTRUCTION JOINTS SHALL BE PROVIDED WHERE SHOWN. WHERE NOT SHOWN, CONSTRUCTION JOINTS SHALL BE PLACED AT LOCATIONS LEAST LIKELY TO IMPAIR THE INTEGRITY OF THE CONCRETE STRUCTURE. CONSTRUCTION JOINT LOCATIONS SHALL BE APPROVED BY THE CONTRACTING OFFICER.
6. UNLESS OTHERWISE NOTED, PROVIDE $\frac{3}{4}$ " CHAMFER AT ALL EXPOSED JOINTS, EDGES, EXTERNAL CORNERS, AND VERTICAL EXPANSION JOINTS.
7. ALL PRIMARY REINFORCEMENT SHALL HAVE A MINIMUM COVER OF 3" UNLESS OTHERWISE NOTED. THE COVER FOR SECONDARY REINFORCEMENT MAY BE REDUCED FROM THE ABOVE BY THE DIAMETER OF THE BAR.
8. ALL BENDS OF REINFORCEMENT AND ALL BAR SPACERS AND SUPPORTS SHALL BE IN ACCORDANCE WITH SP-66, AMERICAN CONCRETE INSTITUTE DETAILING MANUAL - 1980.
9. REINFORCING BAR DESIGNATION NUMBERS CONFORM TO THE NUMBERING SYSTEM OF THE CONCRETE REINFORCING STEEL INSTITUTE.
10. REINFORCING BARS SHALL BE CONTINUOUS AT ALL CORNERS UNLESS OTHERWISE NOTED.
11. REINFORCEMENT, WHERE NECESSARY TO AVOID OPENINGS, PIPES, EMBEDDED ITEMS AND OTHER OBSTRUCTIONS, SHALL BE BENT OR SHIFTED AS DIRECTED BY THE CONTRACTING OFFICER.
12. THE EMBEDMENT AND SPLICE TABLE SHALL BE USED IN DETERMINING LAP SPLICES AND EMBEDMENT LENGTHS WHERE LENGTHS ARE NOT OTHERWISE INDICATED. SPLICE LENGTHS SHALL BE BASED ON THE SMALLER BAR BEING LAPPED. THE CONTRACTOR WILL BE ALLOWED TO MAKE SPLICES IN ADDITION TO THOSE INDICATED IN THE DRAWINGS, WHERE ESSENTIAL TO CONSTRUCTIBILITY, SUBJECT TO APPROVAL BY THE CONTRACTING OFFICER. SPLICES OTHER THAN THOSE SHOWN ON THE DRAWINGS AND OTHER THAN ANY ADDITIONAL SPLICES REQUIRED BY THE CONTRACTING OFFICER, WILL BE AT THE CONTRACTOR'S EXPENSE.
13. ALL EXTERIOR FORMED SURFACES NOT COVERED BY BACKFILL SHALL BE CLASS "A" FINISH AND SURFACES COVERED BY BACKFILL SHALL BE CLASS "D" FINISH, UNLESS OTHERWISE NOTED.

STEEL NOTES:

1. ALL STRUCTURAL STEEL SHALL BE ASTM A36, UNLESS OTHERWISE NOTED.
2. TO PREVENT CORROSION BY MOISTURE BETWEEN STEEL SURFACES IN CONTACT, ALL SUCH CONTACTS SHALL BE SEALED WATERTIGHT BY RUNNING A CONTINUOUS $\frac{1}{8}$ " FILLET WELD ALONG ALL EDGES OF THE CONTACT, UNLESS OTHERWISE NOTED.
3. ALL WELDING SHALL BE ELECTRIC WELDING. WORKMANSHIP AND TECHNIQUE, WHERE APPLICABLE, SHALL CONFORM TO THE AMERICAN WELDING SPECIFICATIONS (SEE SPECS.) STRUCTURAL WELDING CODE.
4. WELDING SYMBOLS SHOWN ARE THOSE ADOPTED BY THE AMERICAN WELDING SOCIETY AND INDICATE ONLY SIZE AND TYPE OF WELDS REQUIRED. DETAILED INFORMATION SHALL BE SHOWN ON THE SHOP DRAWINGS AND SUBMITTED BY THE CONTRACTOR FOR APPROVAL.
5. DIMENSIONS SHOWN OR CALLED FOR ARE THE FINAL DIMENSIONS; ALLOWANCES MUST BE MADE FOR MACHINING.
6. ITEMS MARKED C.R.S. SHALL BE CORROSION RESISTANT STEEL (STAINLESS STEEL), SEE SPECIFICATIONS.

BAR SIZE	BASIC TABLE				ALTERNATE TABLE			
	MINIMUM EMBEDMENT LENGTH, INCHES		MINIMUM LAP LENGTH INCHES		MINIMUM EMBEDMENT LENGTH, INCHES		MINIMUM LAP LENGTH INCHES	
	TOP	OTHER	TOP	OTHER	TOP	OTHER	TOP	OTHER
3	18	14	24	18	12	12	14	12
4	25	19	32	25	15	12	19	15
5	31	24	40	31	18	14	24	18
6	37	28	48	37	22	17	29	22
7	54	42	70	54	32	25	42	32
8	62	47	80	62	37	28	48	37
9	69	53	90	69	42	32	54	42
10	77	59	100	77	46	36	60	46
11	85	65	110	85	51	39	66	51

NOTES:

1. USE THE BASIC TABLE IF ALL OF THE FOLLOWING CONDITIONS ARE MET:
 - A) CENTER TO CENTER BAR SPACING LATERALLY IS AT LEAST 3 BAR DIAMETERS
 - B) DISTANCE FROM THE CENTER OF A BAR TO THE NEAREST CONCRETE SURFACE MUST BE AT LEAST 2 BAR DIAMETERS.
2. THE ALTERNATE TABLE MAY BE USED IF ALL OF THE FOLLOWING CONDITIONS ARE MET:
 - A) CENTER TO CENTER BAR SPACING LATERALLY IS AT LEAST 5 BAR DIAMETERS
 - B) DISTANCE FROM THE CENTER OF A BAR TO THE NEAREST CONCRETE SURFACE MUST BE AT LEAST 2 $\frac{1}{2}$ BAR DIAMETERS.
3. IF CONCRETE COVER OR EDGE DISTANCE IS LESS THAN 1 BAR DIAMETER OR THE CENTER TO CENTER BAR SPACING LATERALLY IS LESS THAN 3 BAR DIAMETERS, SEE ACI 318 FOR APPROPRIATE GUIDANCE.
4. TOP BARS ARE HORIZONTAL BARS AND BARS INCLINED LESS THAN 45 DEGREES WITH RESPECT TO A HORIZONTAL PLANE WHICH ARE PLACED SUCH THAT MORE THAN 12 INCHES OF CONCRETE IS CAST IN THE MEMBER BELOW THE BAR.
5. THE TABLES SHOWN ABOVE ARE FOR NORMAL WEIGHT CONCRETE AND UNCOATED REINFORCING BARS. IF LIGHTWEIGHT CONCRETE OR EPOXY COATED BARS ARE USED, SEE ACI 318 FOR ADDITIONAL CONSIDERATIONS.

ABBREVIATIONS

B/L	= BASELINE
BF	= BOTTOM FACE
BL	= BOTTOM LAYER
C	= CENTER
CB	= CATCH BASIN
C/E	= CONSTRUCTION EASEMENT
C.I.	= CAST IRON
CJ	= CONSTRUCTION JOINT
CL	= CLEAR COVER
C/L OR €	= CENTER LINE
C.R.S.	= CORROSION RESISTANT STEEL
Ø	= DIAMETER
D	= DRAIN
D.I.	= DROP INLET
D.P.	= DRAIN PIPE
D/S	= DOWN STREAM
DV MH	= DRAIN VALVE MANHOLE
E	= ELECTRICAL
EF	= EACH FACE
EJB	= ELECTRICAL JUNCTION BOX
EL.	= ELEVATION
ES	= EQUALLY SPACED
FH	= FIRE HYDRANT
FF	= FAR FACE
G	= GAS
LP	= LIGHT POLE
LS	= LIGHT STANDARD
LTF	= LOWER TOP FACE
MH	= MANHOLE
NF	= NEAR FACE
O.C.	= ON CENTER
OPT.	= OPTIONAL
PP	= POWER POLE
P.C.	= POINT OF CURVATURE
P.T.	= POINT OF TANGENCY
R/W	= RIGHTS OF WAY
S	= SEWER
S&WB	= NEW ORLEANS SEWERAGE & WATER BOARD
SB/L	= SUBBASELINE
SB/L	= SUB BASELINE
SC	= SEWER CLEANOUT
STD. HK.	= STANDARD HOOK
STA.	= STATION
T	= TELEPHONE
TD	= TRENCH DRAIN
TF	= TOP FACE
TEL MH	= TELEPHONE MANHOLE
TL	= TOP LAYER
TP	= TEST PILE
U/S	= UP STREAM
W	= WATER
W/L	= WALL LINE
WM	= WATER METER
WV	= WATER VALVE
WP	= WORKING POINT


SYMBOL	DESCRIPTION	DATE	APPROVED
REVISIONS			
U.S. ARMY ENGINEER DISTRICT, NEW ORLEANS CORPS OF ENGINEERS NEW ORLEANS, LOUISIANA			
LAKE PONTCHARTRAIN, LA. AND VICINITY HIGH LEVEL PLAN NEW ORLEANS LAKEFRONT LEVEE WEST OF I.H.N.C. ORLEANS MARINA PHASE V - SLUICE GATES ORLEANS PARISH, LOUISIANA			
GENERAL NOTES			
 DESIGNED BY: C.WAUGAMAN DATE: PLOT SCALE: PLOT DATE: DRAWN BY: C.WAUGAMAN DEC. 97 1 DEC. 15, 1997 CHECKED BY: C. LABORDE CAD FILE: 4477BD15.DWG SUBMITTED BY: CHARLES A. LABORDE, P.E. SOLICITATION NO.: DESIGN ENGINEER DACW29-98-B-0001 DWG. 2 OF 46			



Safety is a Part
of Your Contract

PONTCHARTRAIN BLVD.

STA. 4+75 SB/L

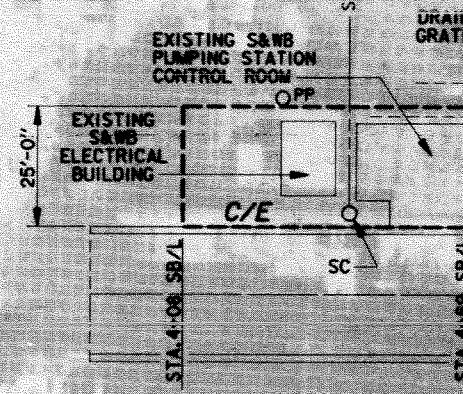

PROTECTED SIDE

NOTES:

1. UNLESS NOTED OTHERWISE ALL DRAINAGE, SEWERAGE, AND WATER LINES AND FIRE HYDRANTS LOCATED WITHIN THE EASEMENTS SHOWN ARE OWNED AND MAINTAINED BY THE NEW ORLEANS SEWERAGE AND WATER BOARD. THESE UTILITIES WILL NOT BE DISTURBED.
2. ALL ELECTRIC AND GAS LINES LOCATED WITHIN THE EASEMENTS SHOWN ARE OWNED AND MAINTAINED BY ENERTY. THESE UTILITIES WILL NOT BE DISTURBED.
3. REMOVE, SALVAGE AND REPLACE THE EXISTING TIMBER DOCK AS REQUIRED.
4. THE EXISTING BOAT DOCK CONTAINS NUMEROUS STORAGE CONTAINERS, BOAT MOORING CLEATS, ELECTRIC AND WATER UTILITIES, DAVIT CRANES, LIGHT STANDARDS, ETC. THESE ITEMS MAY BE REMOVED AND STORED ON SITE BY THE CONTRACTOR PROVIDED THEY ARE RETURNED TO THEIR ORIGINAL LOCATIONS AND CONDITIONS TO THE SATISFACTION OF THE CONTRACTING OFFICER PRIOR TO COMPLETION AND ACCEPTANCE OF THE PROJECT. (SEE SPECS.)
5. SEE DRAWING 39 FOR ADDITIONAL DETAILS OF THE EXISTING UTILITIES ALONG PONTCHARTRAIN BLVD. AND A PUMP STATION NO. 12.
6. PROVIDE SAFETY FENCE AROUND TEMPORARY ACCESS EASEMENT WHEN IT IS IN USE. REMOVE FENCE WHEN TEMPORARY ACCESS EASEMENT IS NOT IN USE.
7. EXISTING MOORING PILE LOCATIONS ARE APPROXIMATE. CONTRACTOR SHALL VERIFY LOCATIONS OF ALL MOORING PILES. REPLACEMENT PILES SHALL BE PLACED AT THE SAME LOCATIONS AS THE ORIGINAL PILES. (SEE SPECS.)

LEGEND


- TEMPORARY ACCESS EASEMENT (SEE SPECS)
- CONTRACTOR STAGING AREA
- SOIL BORING
- GAS LINE
- UNDERGROUND TELEPHONE LINE
- UNDERGROUND ELECTRIC LINE
- SEWER LINE
- WATER LINE
- LIGHT STANDARD
- DRAIN LINE
- LIMITS OF SAFETY FENCE
- LIMITS OF CONSTRUCTION EASEMENT
- RIGHTS OF WAY LIMIT
- EXISTING MOORING PILES
- EXISTING DAVIT CRANES

UTILITY RELOCATIONS

ITEM	DESCRIPTION	W/L STA.	OWNER	DISPOSITION
E-1	UNDERGROUND TELEPHONE CABLE	STA 406+84±	ENERGY	ABANDONED UTILITY (REMOVE AS REQUIRED)
E-2	UNDERGROUND ELECTRIC SERVICE	AS SHOWN	WEST END LANDING, INC.	TEMPORARILY RELOCATE AS REQUIRED (SEE SPECS)
T-1	UNDERGROUND TELEPHONE CABLE	STA 406+81±	BELL SOUTH	RELOCATION BY OWNER (SEE SPECS)
T-2	UNDERGROUND TELEPHONE CABLE	AS SHOWN	BELL SOUTH	RELOCATION BY OWNER (SEE SPECS)
W-1	WATER SERVICE	AS SHOWN	WEST END LANDING, INC.	TEMPORARILY RELOCATE AS REQUIRED (SEE SPECS)

SCALE: 1" = 20'


20' 0' 20' 40' 60' 80'

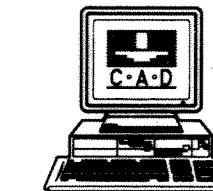

SYMBOL	DESCRIPTION	DATE	APPROVED
REVISIONS			
U.S. ARMY ENGINEER DISTRICT, NEW ORLEANS CORPS OF ENGINEERS NEW ORLEANS, LOUISIANA			
LAKE PONTCHARTRAIN, LA. AND VICINITY HIGH LEVEL PLAN NEW ORLEANS LAKEFRONT LEVEE WEST OF I.H.N.C.			
ORLEANS MARINA PHASE V - SLUICE GATES ORLEANS PARISH, LOUISIANA			
SITE PLAN			
DESIGNED BY: C.LABORDE DATE: DEC. 97 PLOT SCALE: 240 PLOT DATE: DEC. 15, 1997 DRAWN BY: C.BRAND CHECKED BY: C.LABORDE FILE NO. H-4-44778 SUBMITTED BY: CHARLES A. LABORDE, P.E. SOLICITATION NO. DACW29-95-B-000 DESIGN ENGINEER DWG. 3 OF 46			

Safety is a Part
of Your Contract

PONTCHARTRAIN BLVD.

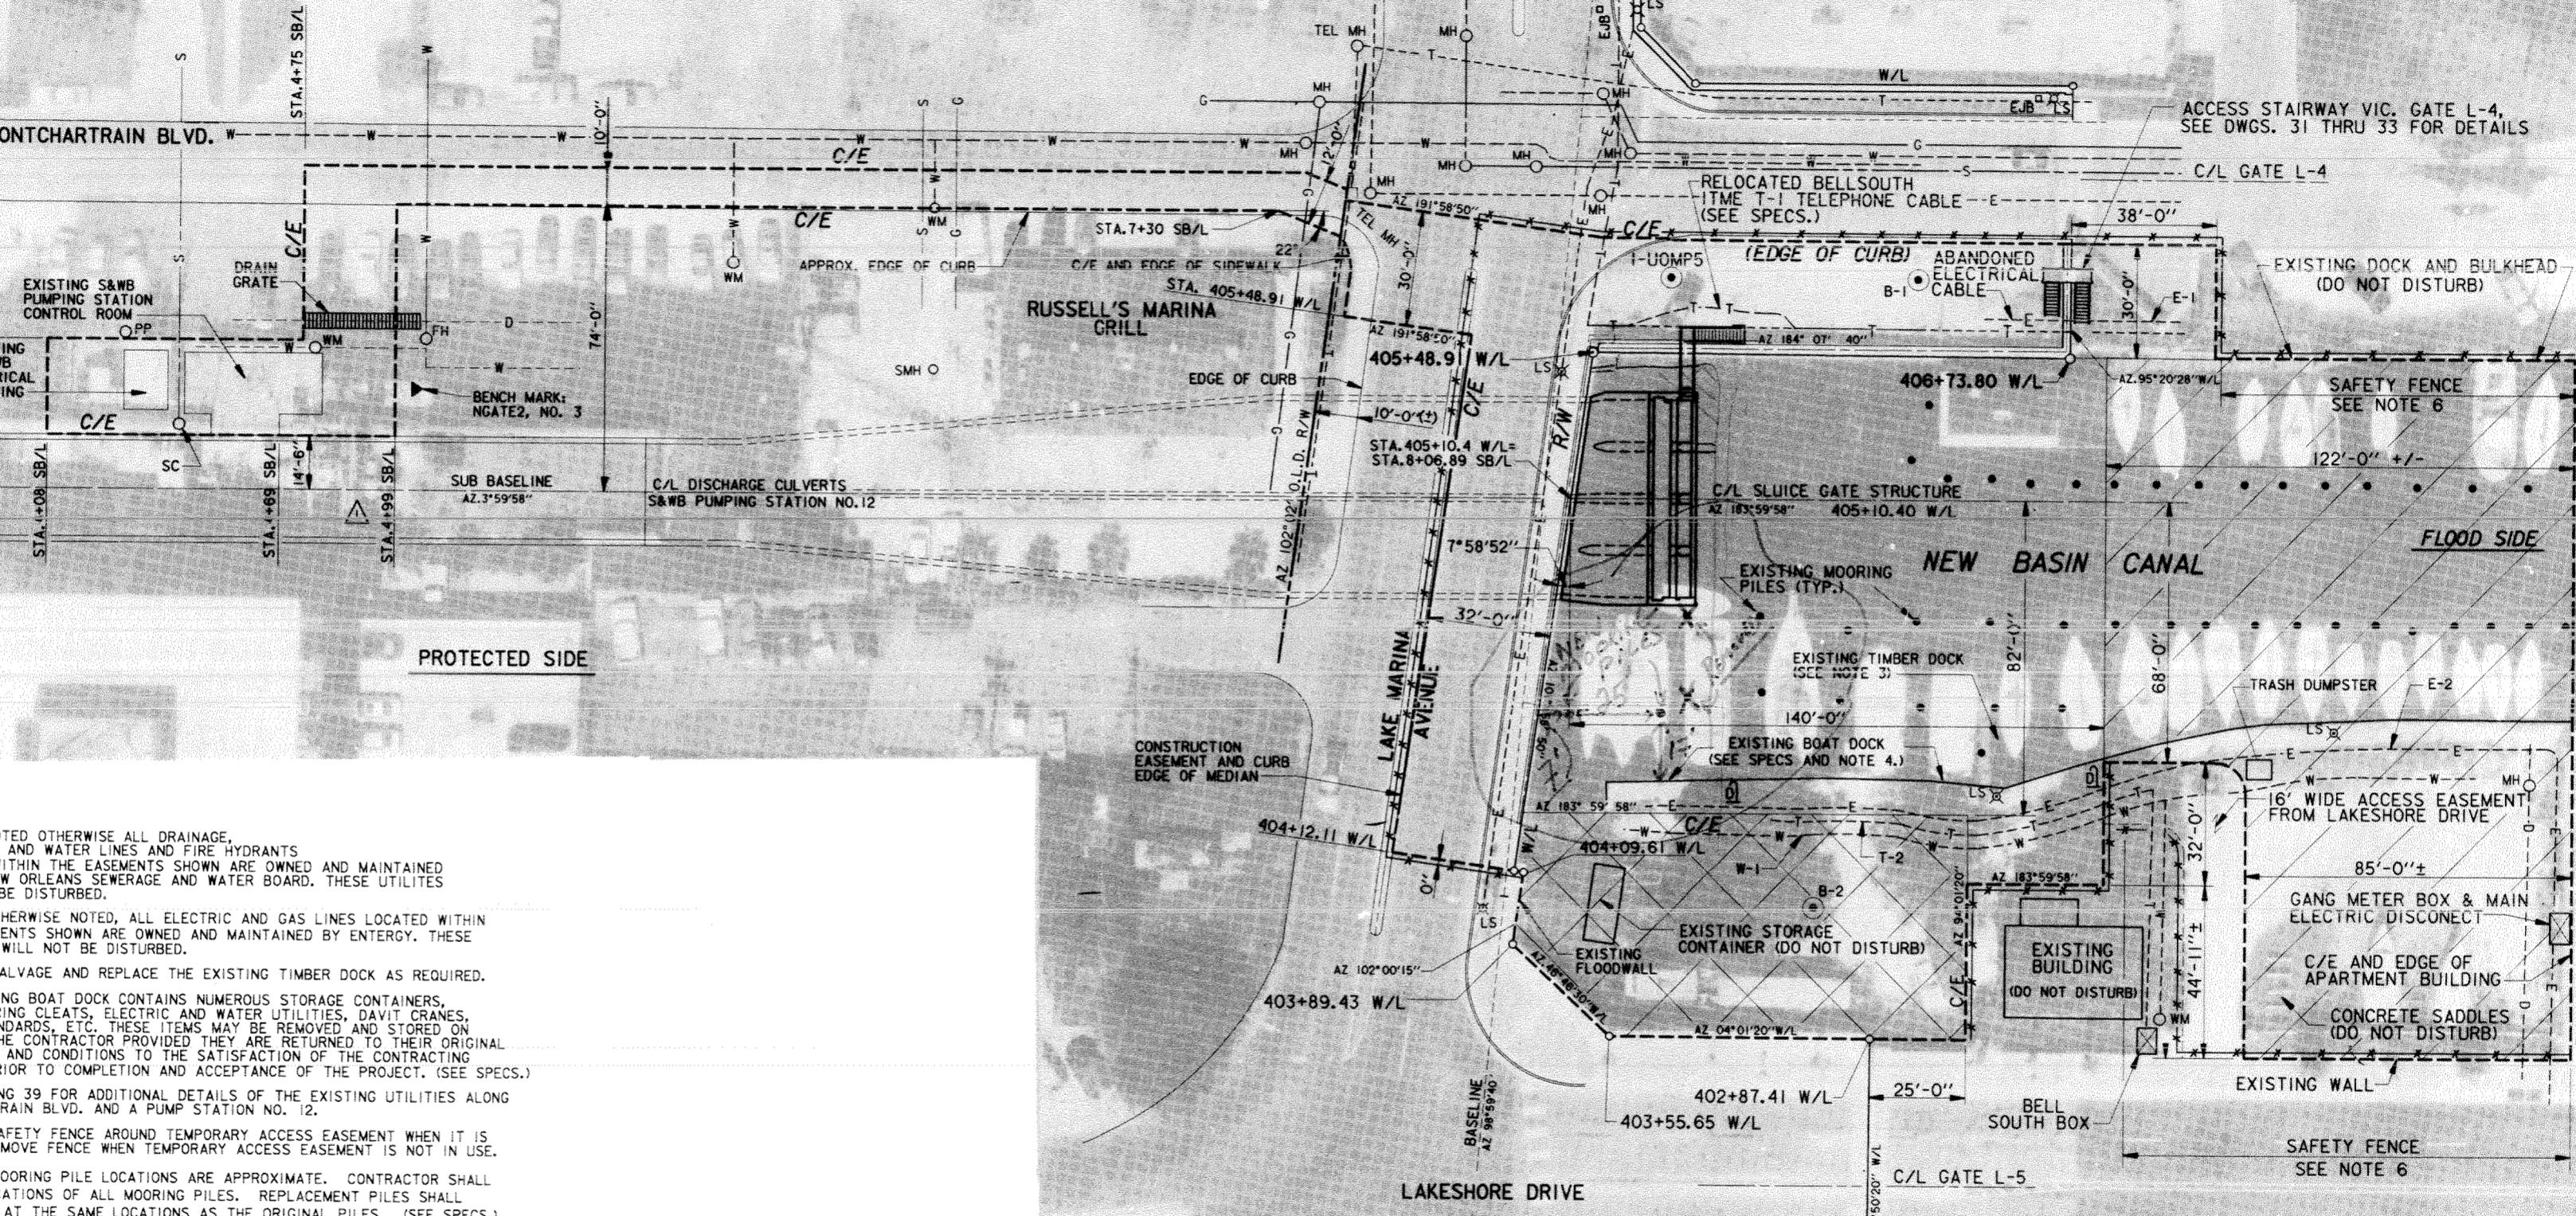

LEGEND

- TEMPORARY ACCESS EASEMENT (SEE SPECS)
- CONTRACTOR STAGING AREA
- SOIL BORING
- G - GAS LINE
- T - UNDERGROUND TELEPHONE LINE
- E - UNDERGROUND ELECTRIC LINE
- S - SEWER LINE
- W - WATER LINE
- X - LIGHT STANDARD
- D - DRAIN LINE
- * - LIMITS OF SAFETY FENCE
- - - - LIMITS OF CONSTRUCTION EASEMENT
- - - - RIGHTS OF WAY LIMIT
- • - EXISTING MOORING PILES
- □ - EXISTING DAVID CRANES

UTILITY RELOCATIONS


ITEM	DESCRIPTION	W/L STA.	OWNER	DISPOSITION
E-1	UNDERGROUND ELECTRIC SERVICE	STA 406+84±	ENERGY	ABANDONED UTILITY (REMOVE AS REQUIRED)
E-2	UNDERGROUND ELECTRIC SERVICE	AS SHOWN	WEST END LANDING, INC.	TEMPORARILY RELOCATE AS REQUIRED (SEE SPECS)
T-1	UNDERGROUND TELEPHONE CABLE	STA 406+81±	BELL SOUTH	RELOCATION BY OWNER (SEE SPECS)
T-2	UNDERGROUND TELEPHONE CABLE	AS SHOWN	BELL SOUTH	RELOCATION BY OWNER (SEE SPECS)
W-1	WATER SERVICE	AS SHOWN	WEST END LANDING, INC.	TEMPORARILY RELOCATE AS REQUIRED (SEE SPECS)

SCALE: 1' = 20'
20' 0' 20' 40' 60' 80'



REVISED CONSTRUCTION EASEMENT VICTORY OF PUMP STATION AND NOTE 2, AMEND. #0003		1/23/98 CAL
REVISIONS	DESCRIPTION	DATE APPROVED
U.S. ARMY ENGINEER DISTRICT, NEW ORLEANS CORPS OF ENGINEERS NEW ORLEANS, LOUISIANA		
LAKE PONTCHARTRAIN, LA. AND VICINITY HIGH LEVEL PLAN NEW ORLEANS LAKEFRONT LEVEE WEST OF I.H.N.C. ORLEANS MARINA PHASE V - SLUICE GATES ORLEANS PARISH, LOUISIANA		
SITE PLAN		
DESIGNED BY: C.LABORDE	DATE: DEC. 97	PLOT SCALE: 240
DRAWN BY: C.BRAND	DATE: MAR. 6, 1998	PLOT DATE: 1/23/98
CHECKED BY: C.LABORDE	FILE NO.: H-4-44778	CADD FILE: 44778CII.DGN
SUBMITTED BY: CHARLES A. LABORDE, P.E.	SOLICITATION NO.: DACW29-98-B-0001	DWG. 3 OF 46
DESIGN ENGINEER		



Safety is a Part of Your Contract

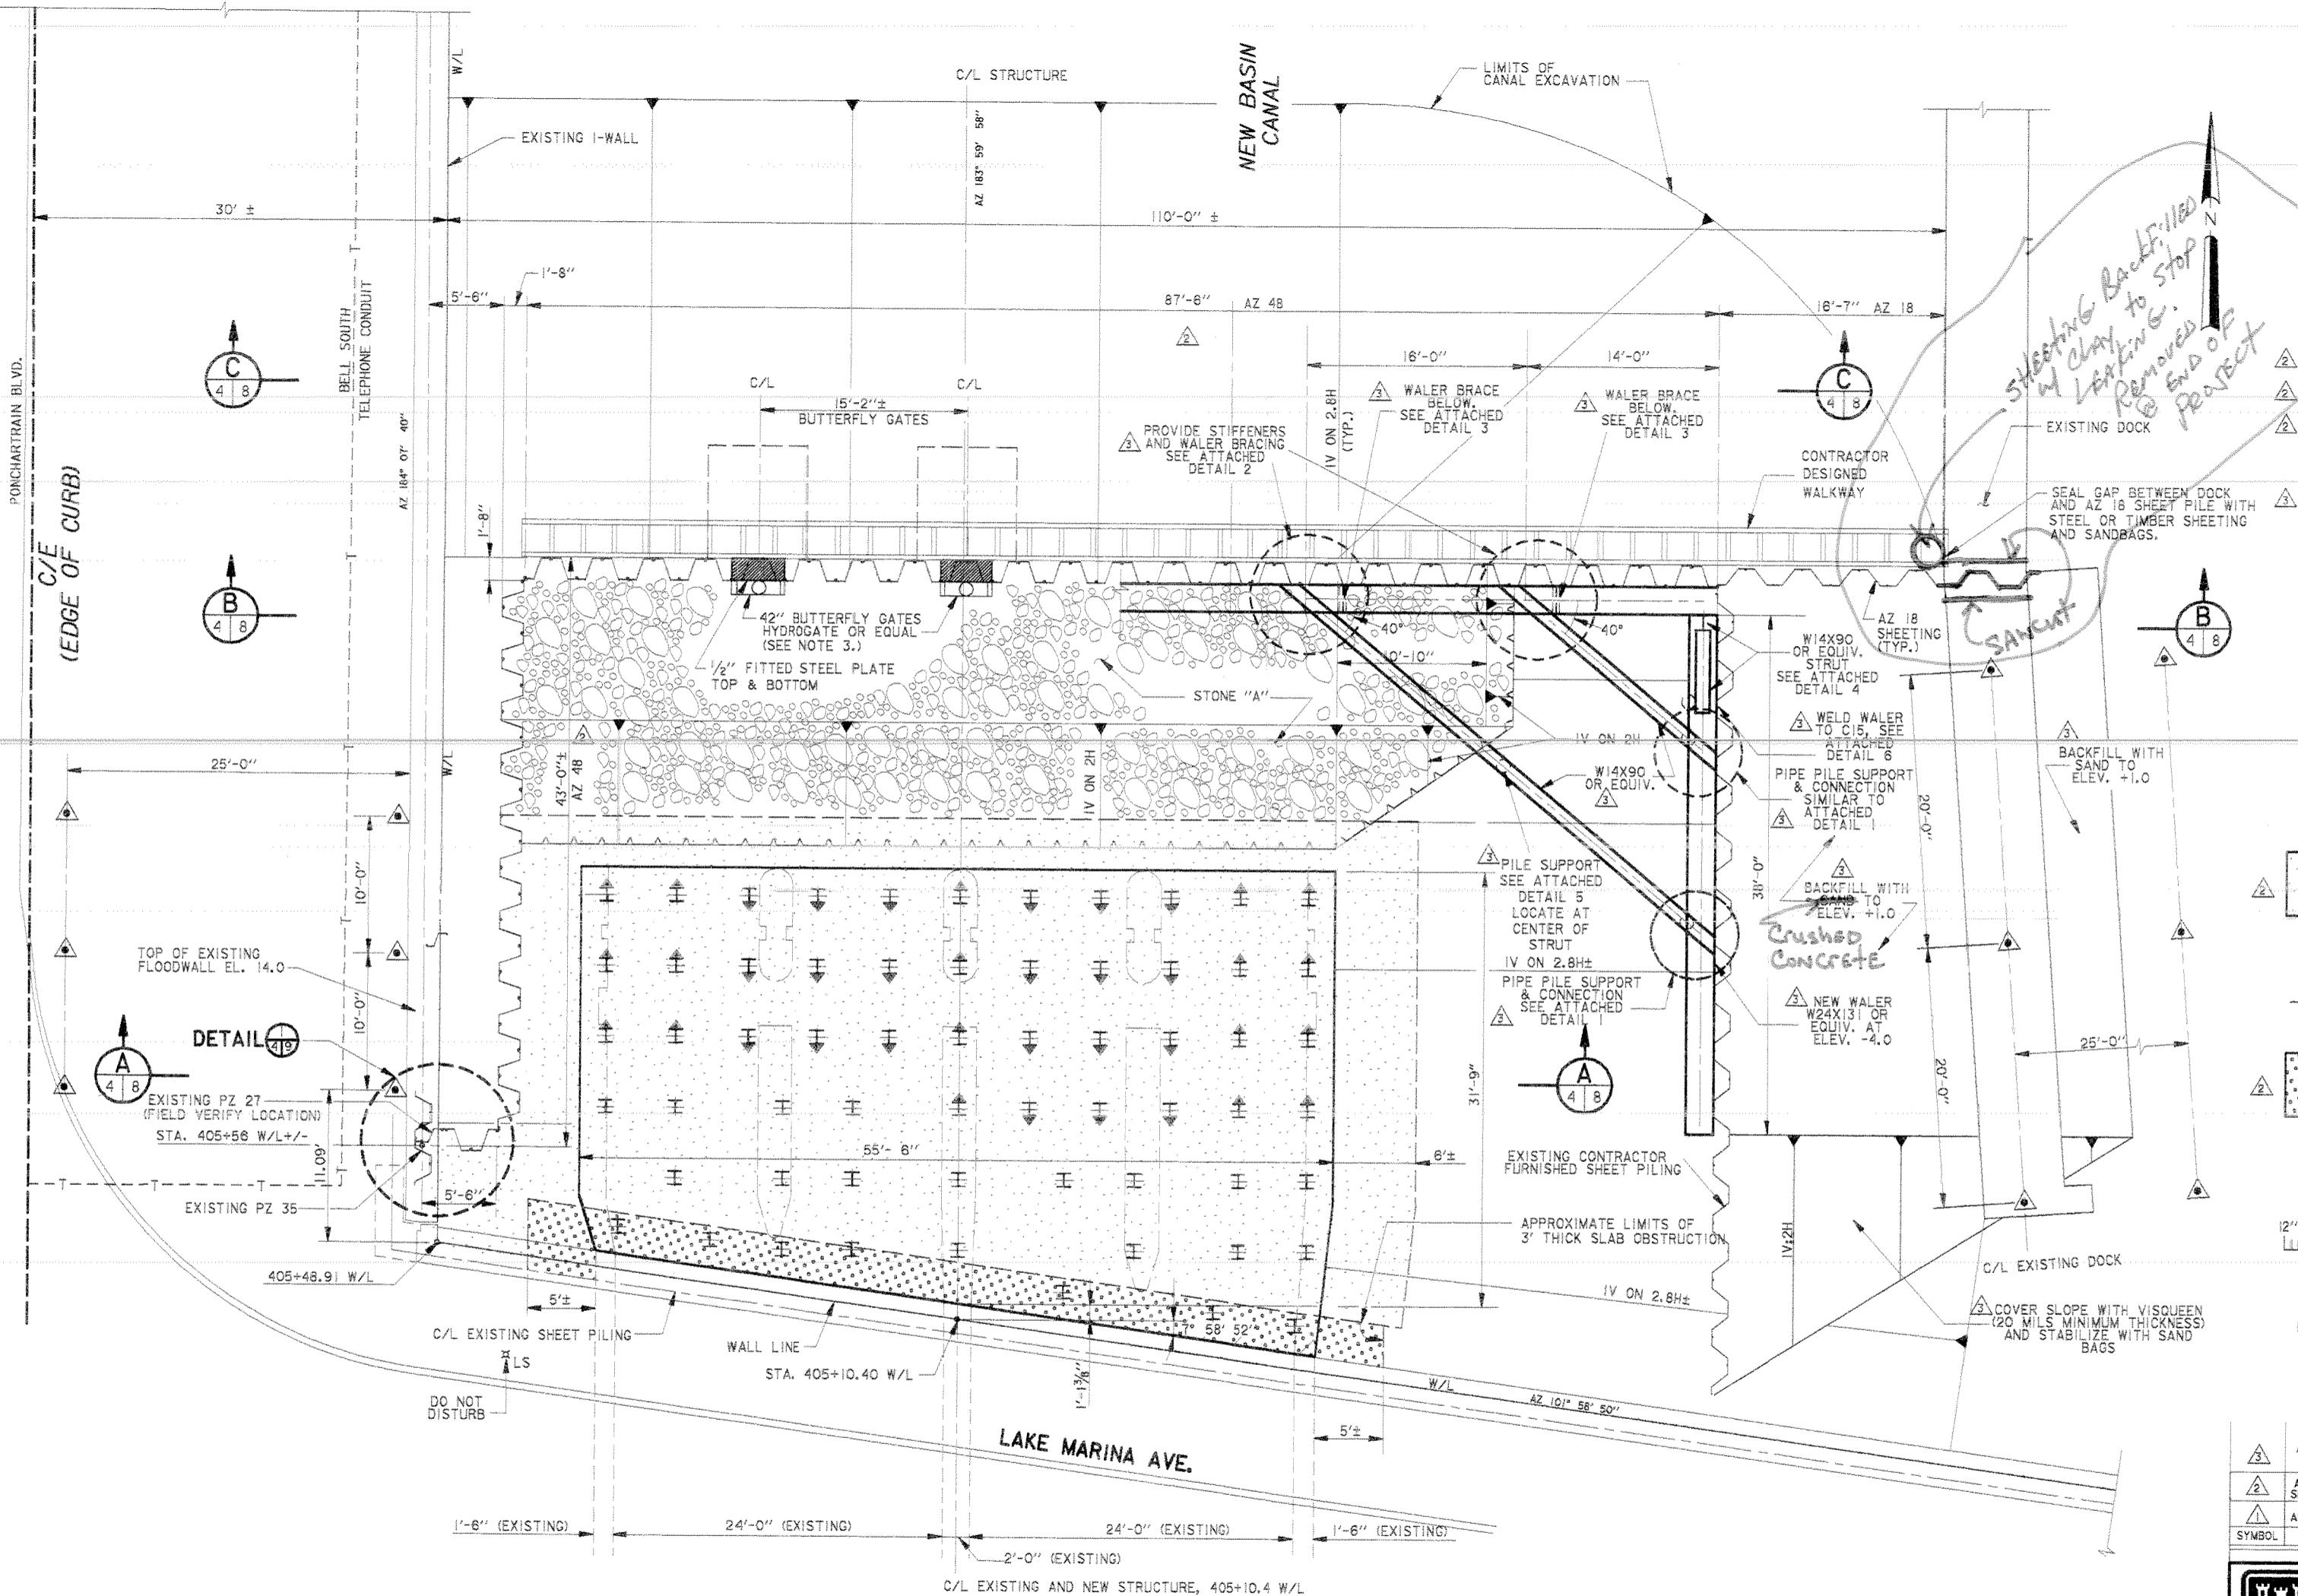

SLUICE GATE STRUCTURE

PLA

SCALE: $\frac{3}{16}'' = 1'-0''$

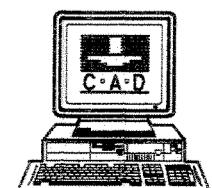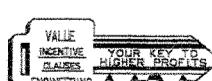

REVISIONS

U.S. ARMY ENGINEER DISTRICT, NEW ORLEANS

CORPS OF ENGINEERS

NEW ORLEANS, LOUISIANA

LAKE PONTCHARTRAIN, LA. AND VICINITY

HIGH LEVEL PLAN

NEW ORLEANS LAKEFRONT LEVEE

WEST OF I.H.N.C.


ORLEANS MARINA PHASE V - SLUICE GATES

ORLEANS PARISH, LOUISIANA

COFFERDAM AND EXCAVATION


PLAN			
SIGNED BY: C.LABORDE AWN BY: V.COUVILLION CKED BY: C.LABORDE MITTED BY: RLES A. LABORDE, P.E. DESIGN ENGINEER	DATE: NOV. 97	PLOT SCALE: 64	PLOT DATE: DEC. 15, 1998 FILE NO. H-4-44778
	CADD FILE: 4477BN08.DGN	SOLICITATION NO. DACW29-98-B-0001	DWG. 4 OF 46

Safety is a Part of Your Contract

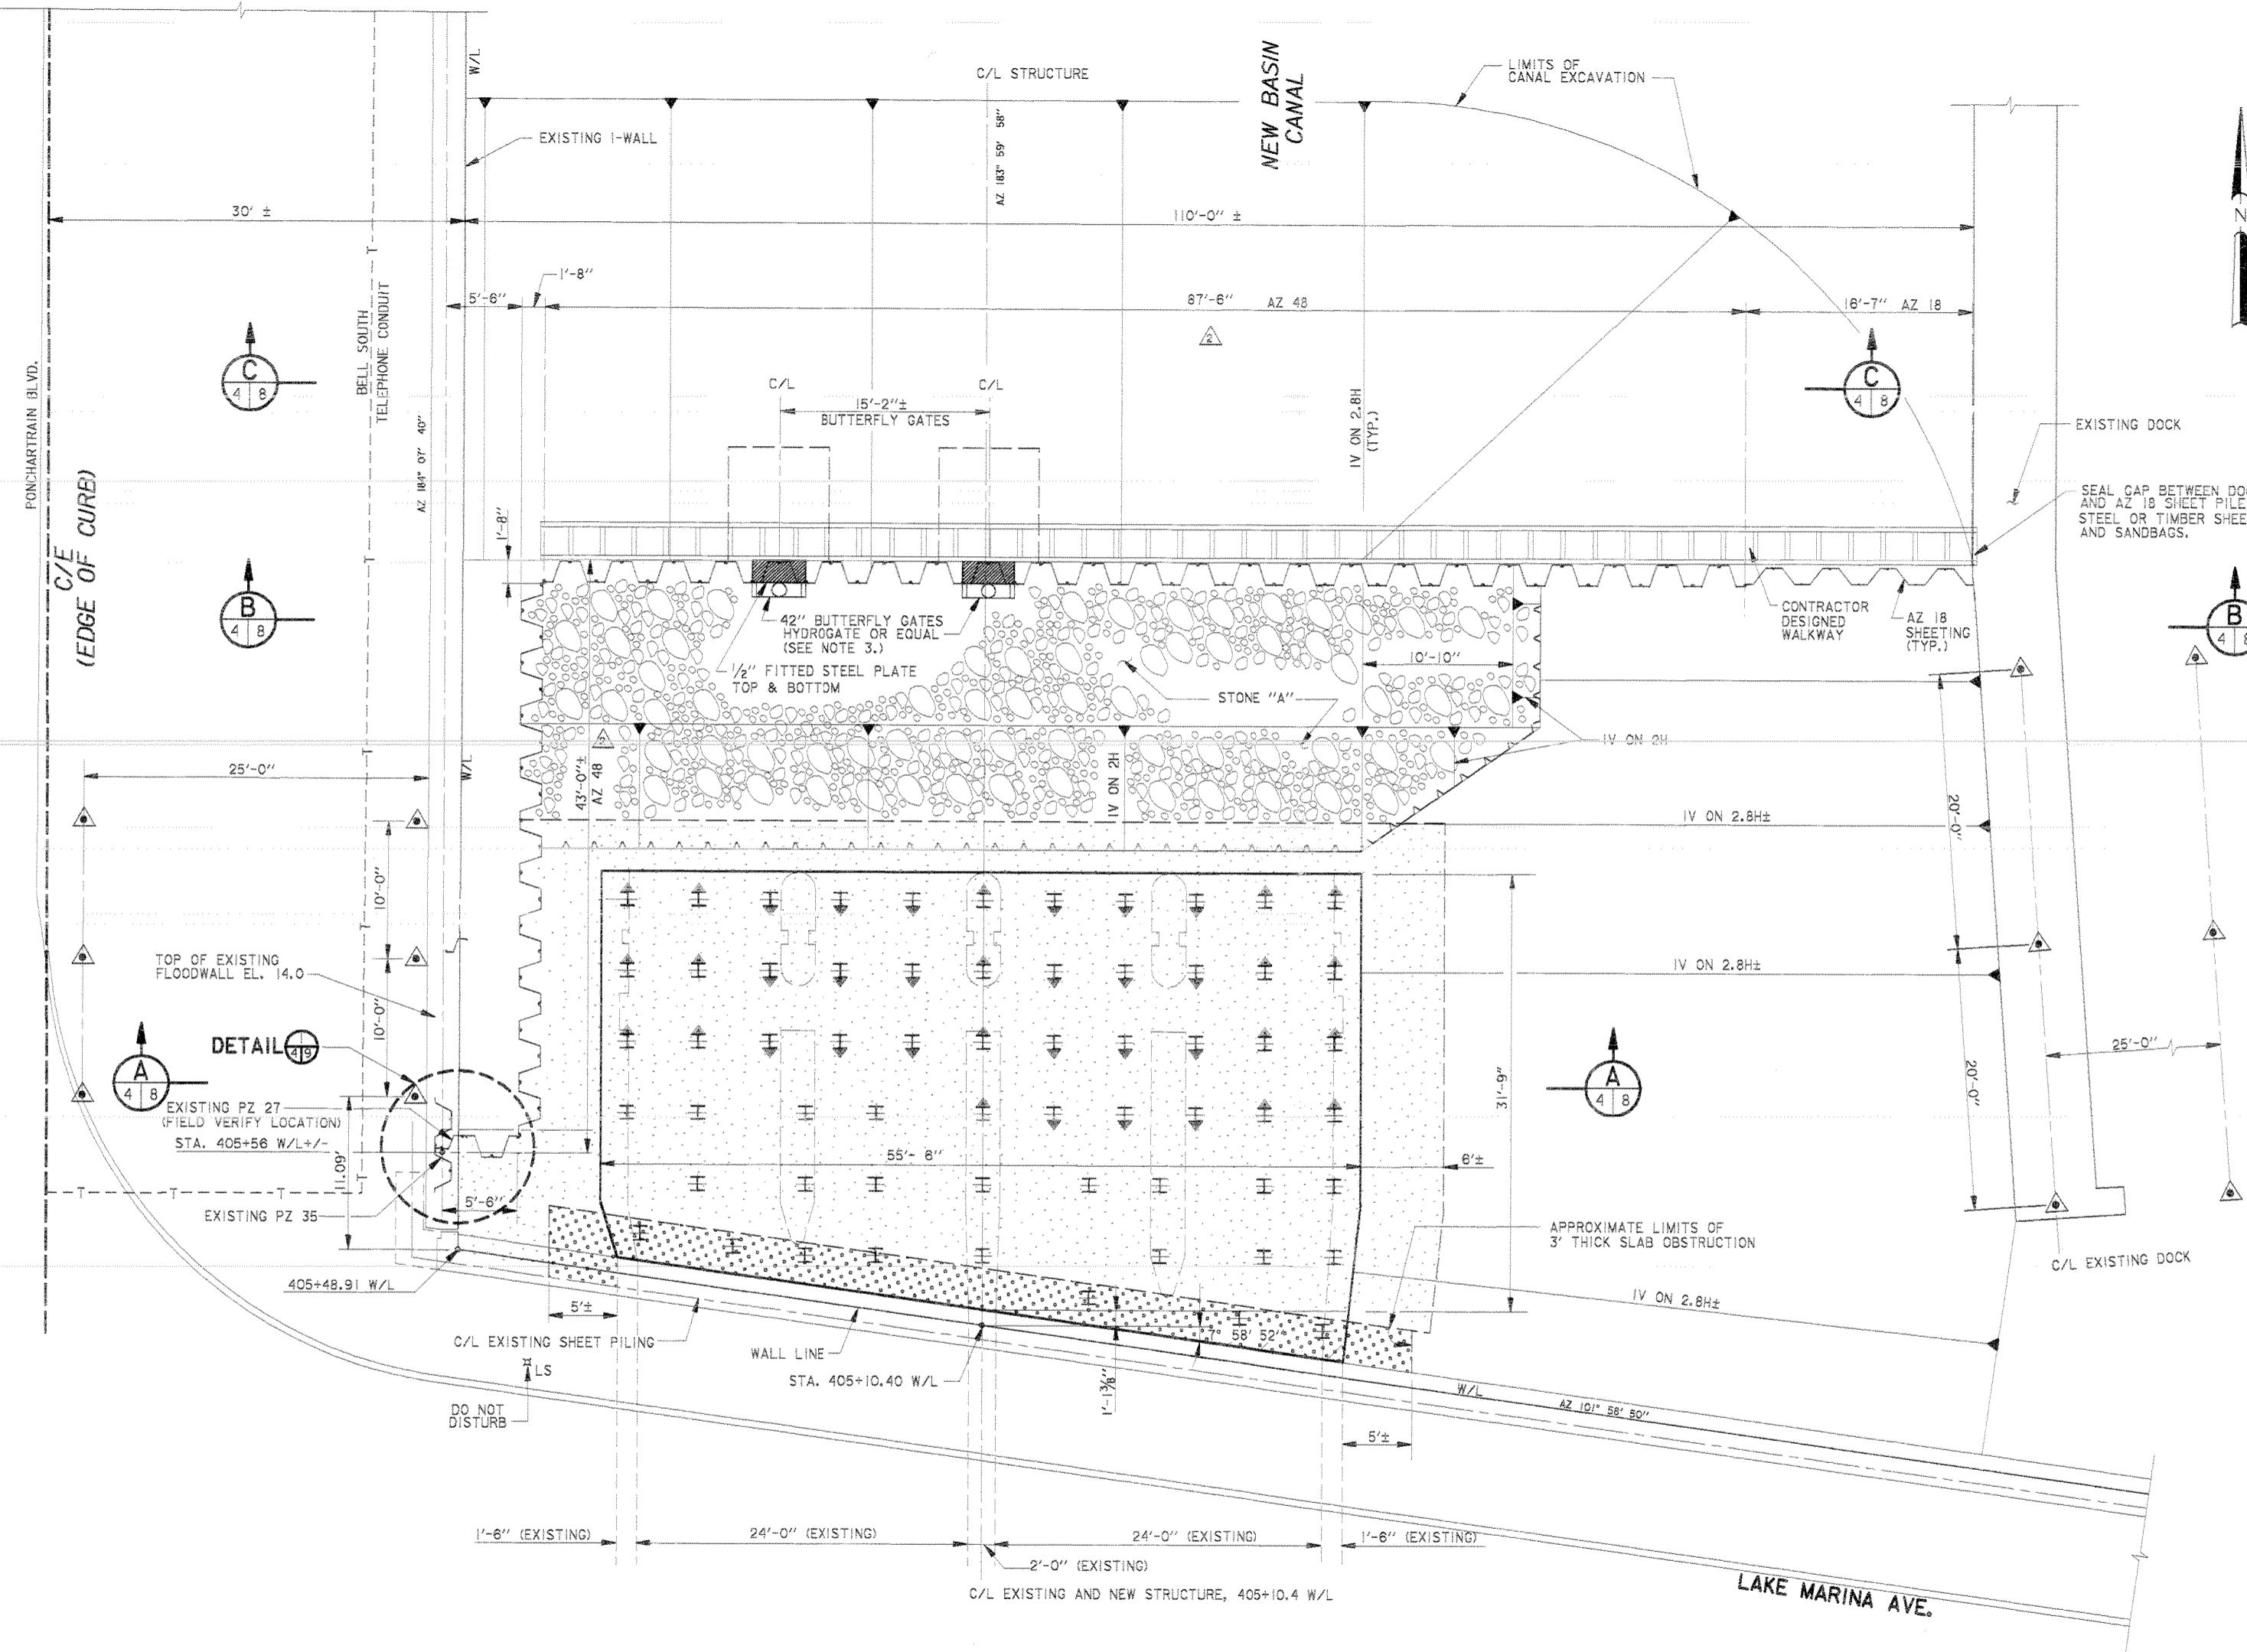

SLUICE GATE STRUCTURE

PLA

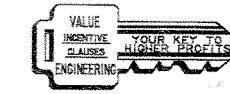

	ADDED SLAB OBSTRUCTION, REVISED COFFERDAM SHEET PILES, REMD TRECIE CONC., & PVC PIPE	DEC 98	CAL
	ADDED NOTES 5 & 6, AMEND. #1	1/23/98	CAL
SYMBOL	DESCRIPTION	DATE	APPROVED
	REVISIONS		

U.S. ARMY ENGINEER DISTRICT, NEW ORLEANS
CORPS OF ENGINEERS
NEW ORLEANS, LOUISIANA

LAKE PONTCHARTRAIN, LA. AND VICINITY
HIGH LEVEL PLAN

HIGH LEVEL PLAN
NEW ORLEANS LAKEFRONT LEVEE

WEST OF I.H.N.C.
MARINA PHASE V - SLUDGE

**MARINA PHASE V - SCOTCH GATES
ORLEANS PARISH, LOUISIANA**

IR DAM AND EXCAVATION

PLAN


ABORDE DATE: PLOT SCALE: PLOT DATE:

WILLION NOV. 97 64 DEC. 3, 1998
ADOREE FILE NO.


ABORDE CADD FILE: 44778N08.DGN FILE NO.
H-4-44778

SOLICITATION NO. DACW29-98-B-0001 DWG. 4 OF 4

Digitized by srujanika@gmail.com

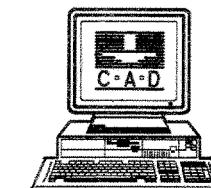

Safety is a Part
of Your Contract

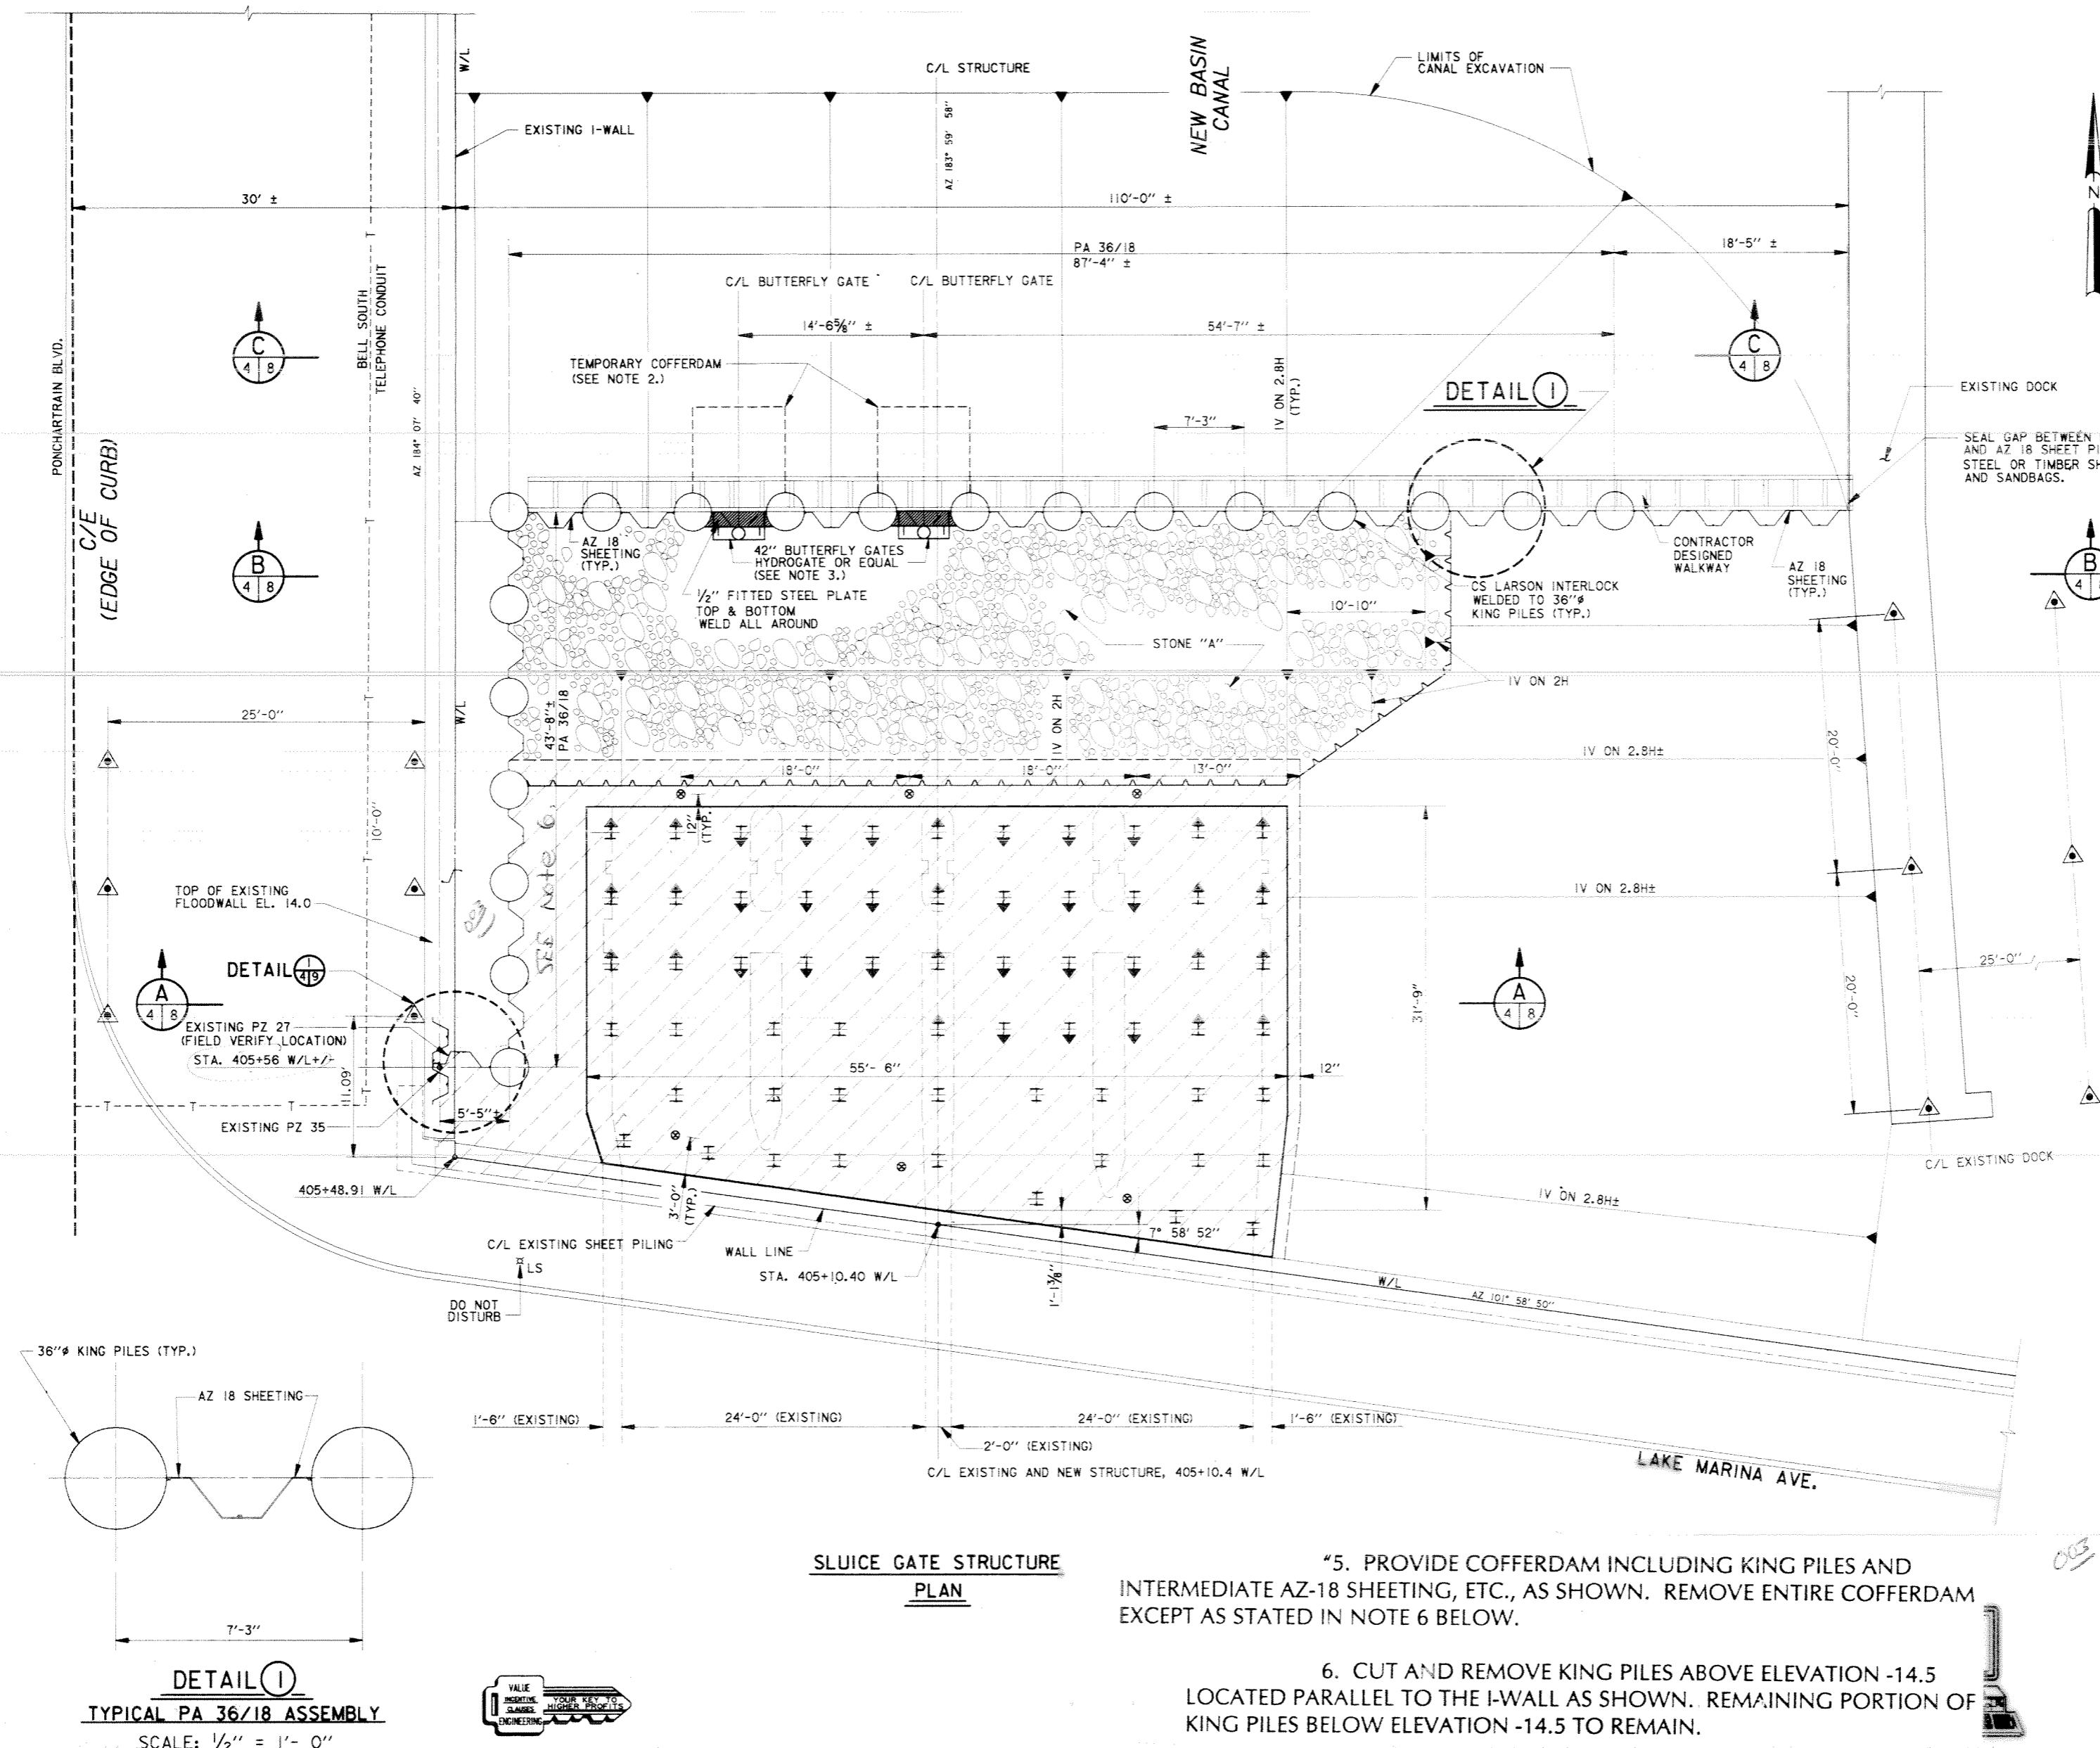

Safety is a Part
of Your Contract

TOP OF EXISTING
FLOODWALL EL. 14.0

WALER DESIGN LOADING 9200 #/FT AT ELEV. +2.0.

AZ 184° 07' 40"

44'-6" +/-
MINIMUM LENGTH OF NORTH SIDE WALER

C/L
15'-2" ±
BUTTERFLY GATES
C/L

CONTRACTOR DESIGNED CONNECTIONS
INCLUDING GUSSET, STIFFENERS, WELDED
AND BOLTED CONNECTIONS AS REQUIRED
ARE SHOWN FOR ILLUSTRATION PURPOSES
ONLY.

CONTRACTOR DESIGNED
WALER AT ELEV. +2.0

CONTRACTOR DESIGNED STRUTS SHOWN
FOR ILLUSTRATION PURPOSES ONLY,
(NUMBER AND LOCATION AS PER
CONTRACTOR DESIGN).

BUTTERFLY
VALVE
STEM

COLUMN SUPPORT BELOW
(LOCATION, NUMBER, AND
DESIGN PER CONTRACTOR)

STA. 405+56 W/L +/-

EXISTING PZ 35

5'-6"

31'-0"

W/L



AZ 184° 07' 40"

NOTES:

1. RIPRAP AND BEDDING NOT SHOWN FOR CLARITY.
2. DESIGN OF ALL WALERS, BRACING, PLATES, STRUTS, SUPPORTS AND ALL APPLICABLE DETAILS SHALL BE BY THE CONTRACTOR. (SEE SPECS.)

SCALE: $\frac{3}{8}'' = 1'-0''$
12' 0" 2' 4' 6' 8' 10'


COFFERDAM BRACING

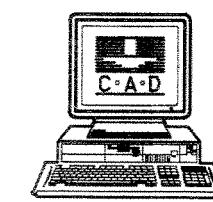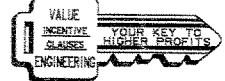

U.S. ARMY ENGINEER DISTRICT, NEW ORLEANS
CORPS OF ENGINEERS
NEW ORLEANS, LOUISIANA
LAKE PONTCHARTRAIN, LA. AND VICINITY
HIGH LEVEL PLAN
NEW ORLEANS LAKEFRONT LEVEE
WEST OF I.H.N.C.
ORLEANS MARINA PHASE V - SLUICE GATES
ORLEANS PARISH, LOUISIANA


COFFERDAM BRACING

DESIGNED BY: C.LABORDE	DATE: NOV. 97	PLOT SCALE: 32	PLOT DATE: DEC. 7, 1998
DRAWN BY: V.COUVILLION			
CHECKED BY: C.LABORDE			
SUBMITTED BY: CHARLES A. LABORDE, P.E. DESIGN ENGINEER	SOLICITATION NO. DACW29-98-B-0001		FILE NO. H-4-44778

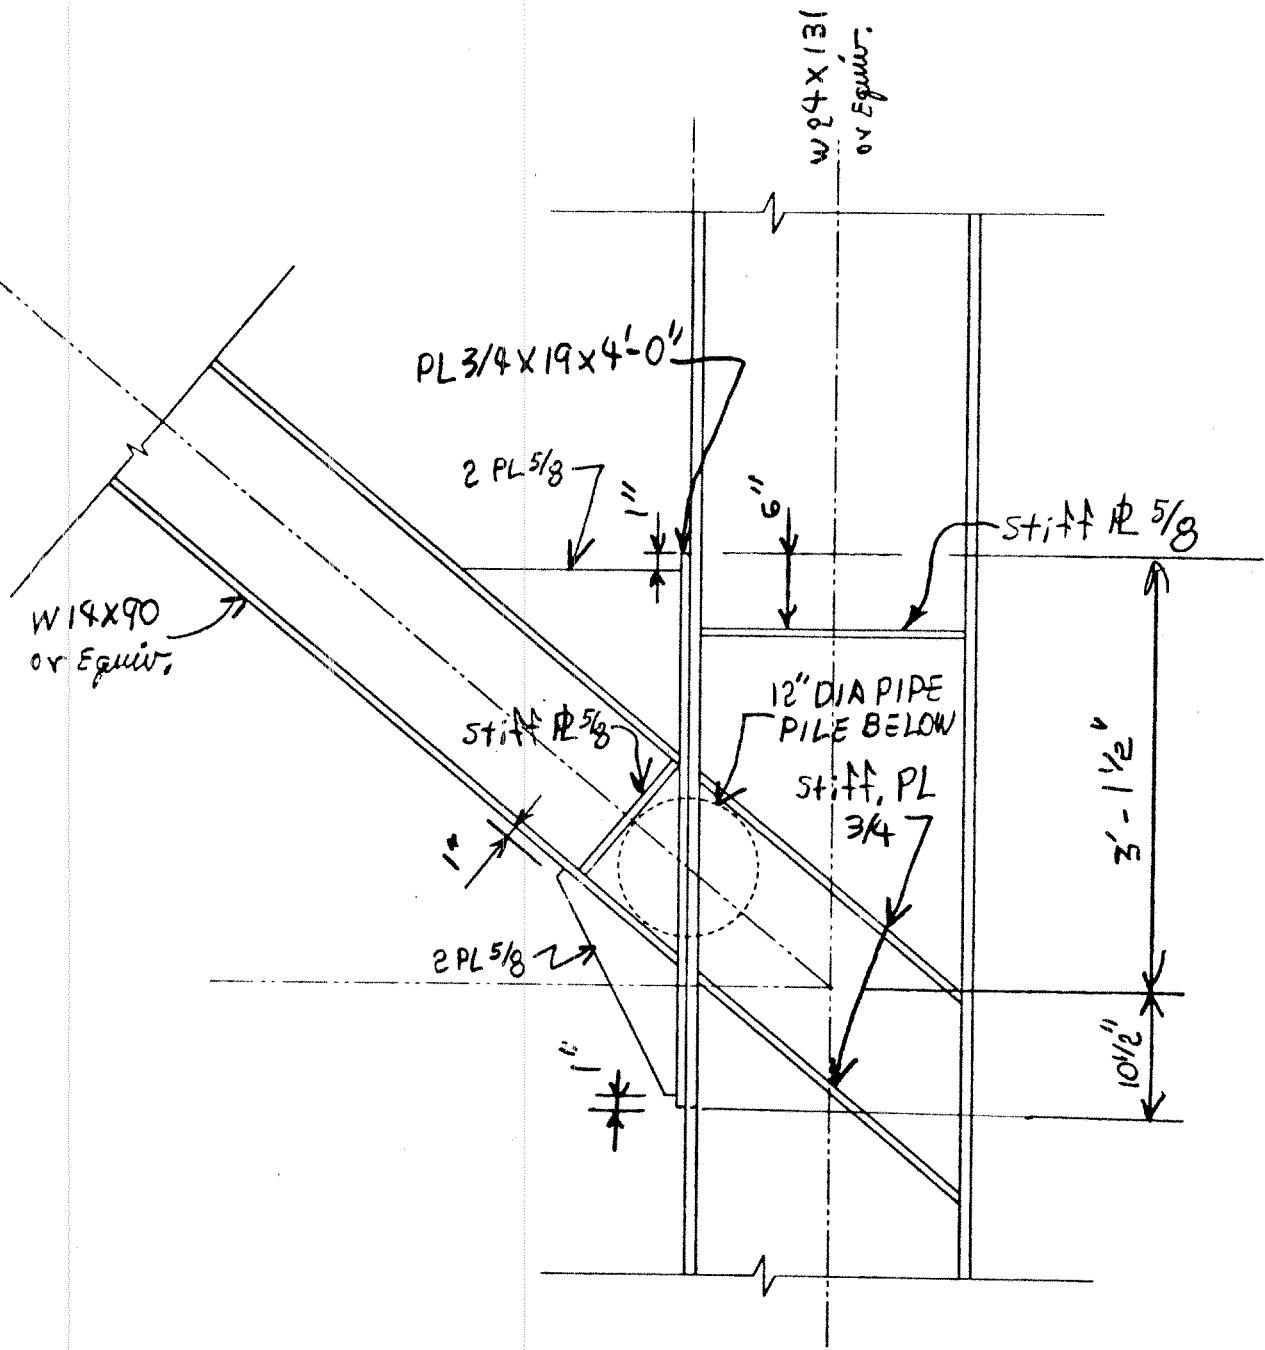

DETAIL 1
NTS
(SIZES)

SKETCH 1


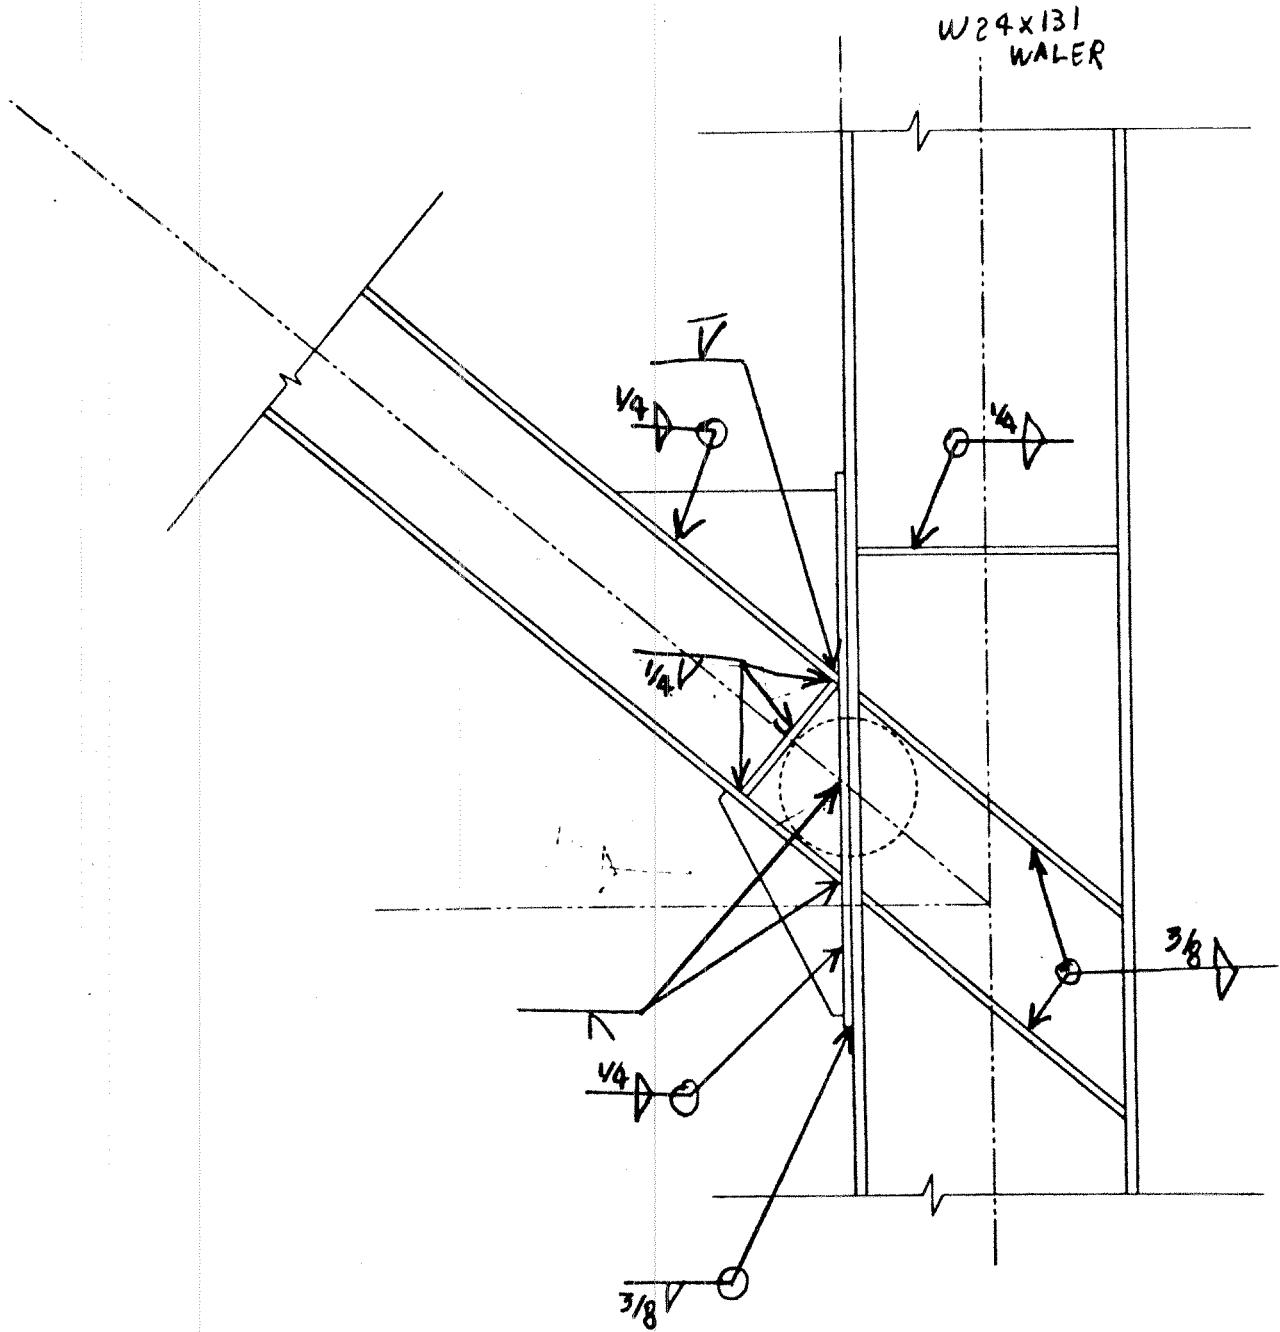


DETAIL ①

NTS
(WELDS)


SKETCH 2

Sketches

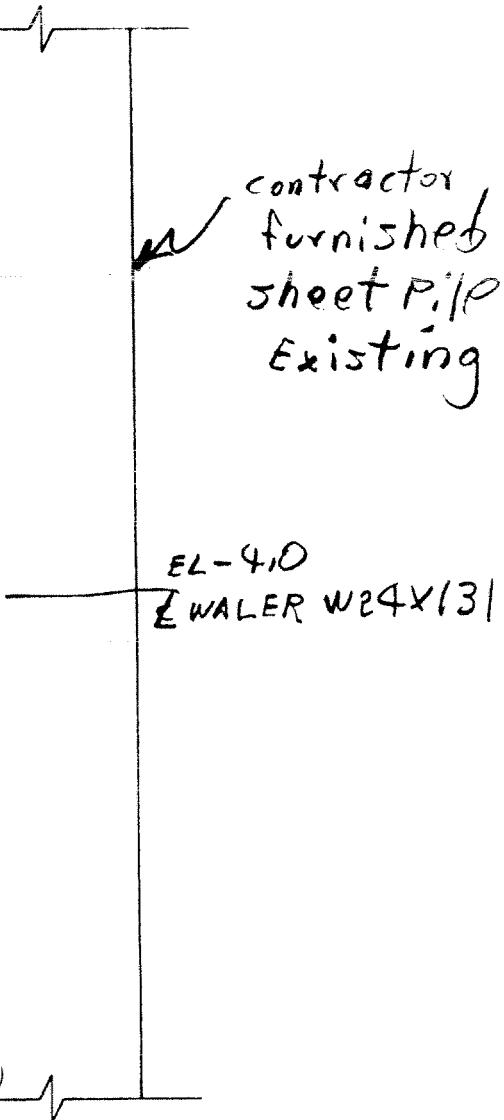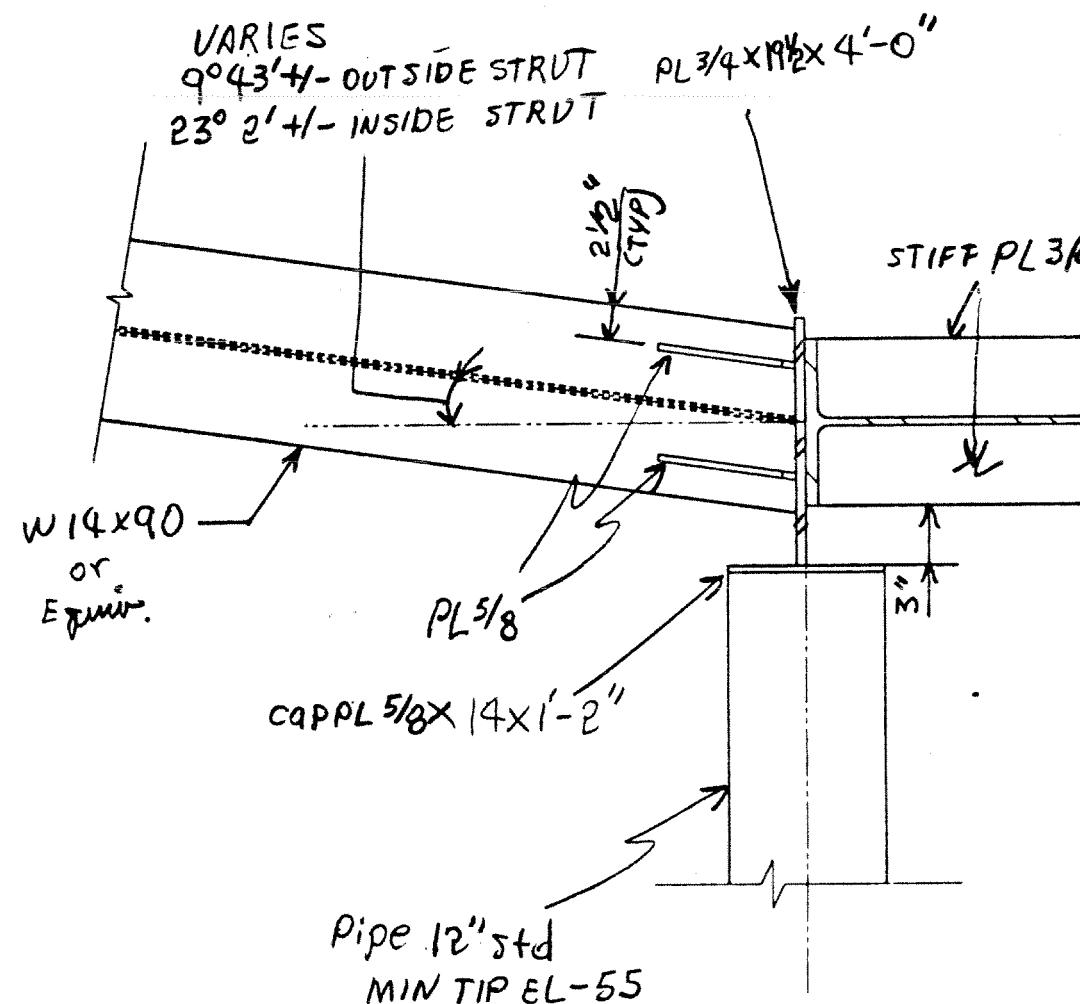


DETAIL ①
(ELEVATIONAL SIZES)
NTS

52244

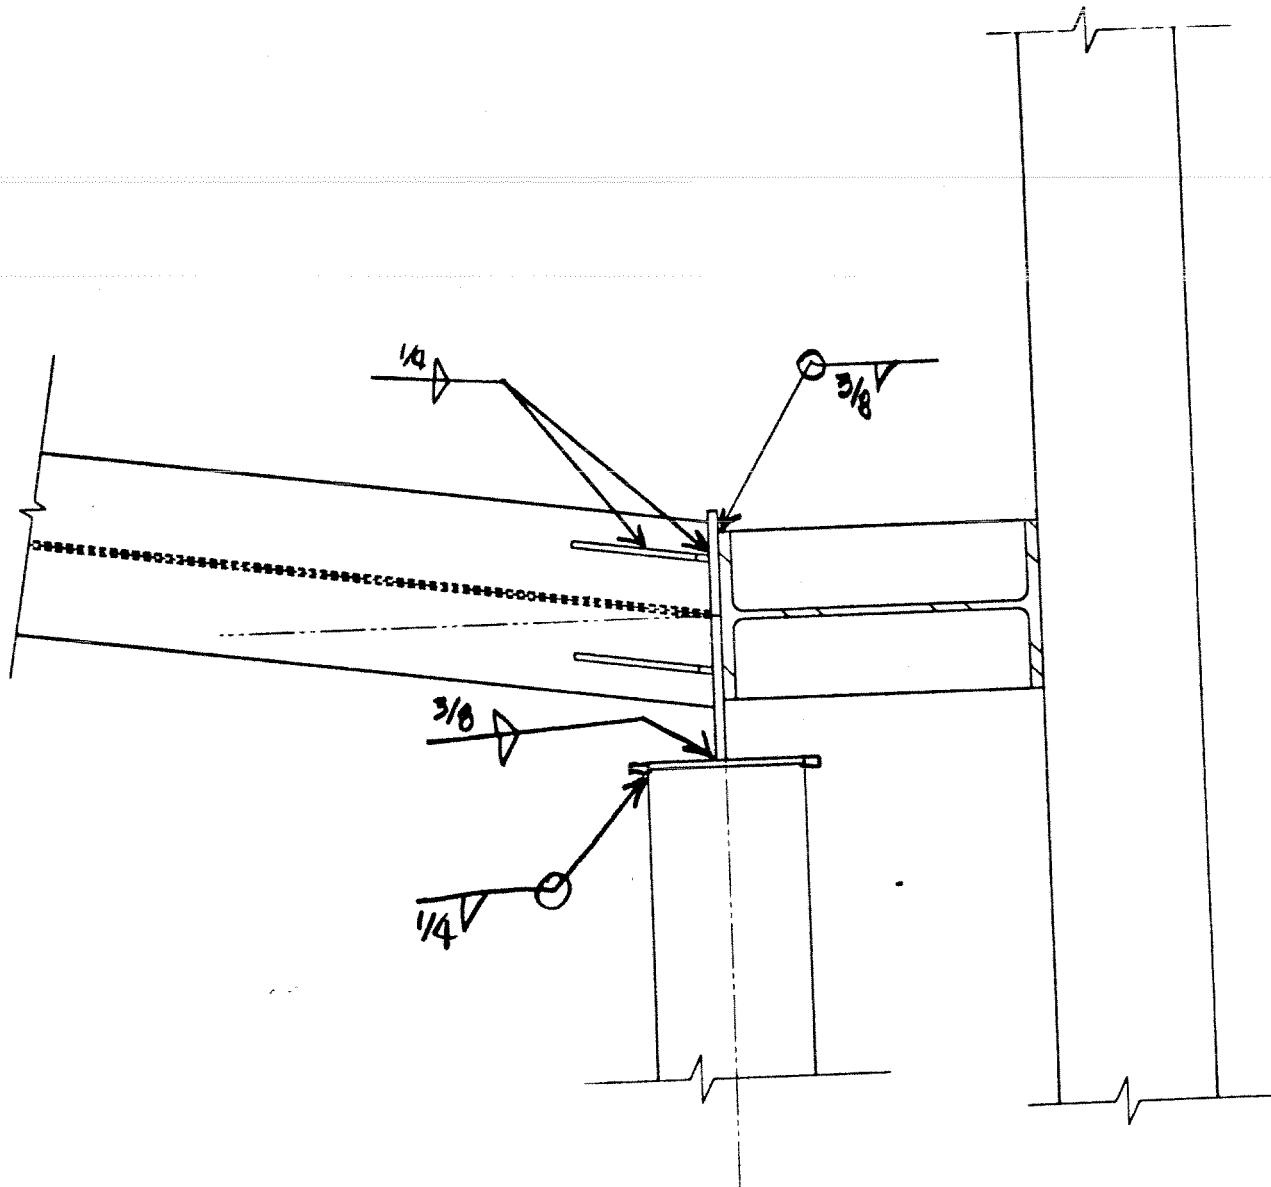

DETAIL ①
NTS
(ELEVATION WELDS)

9 #20715

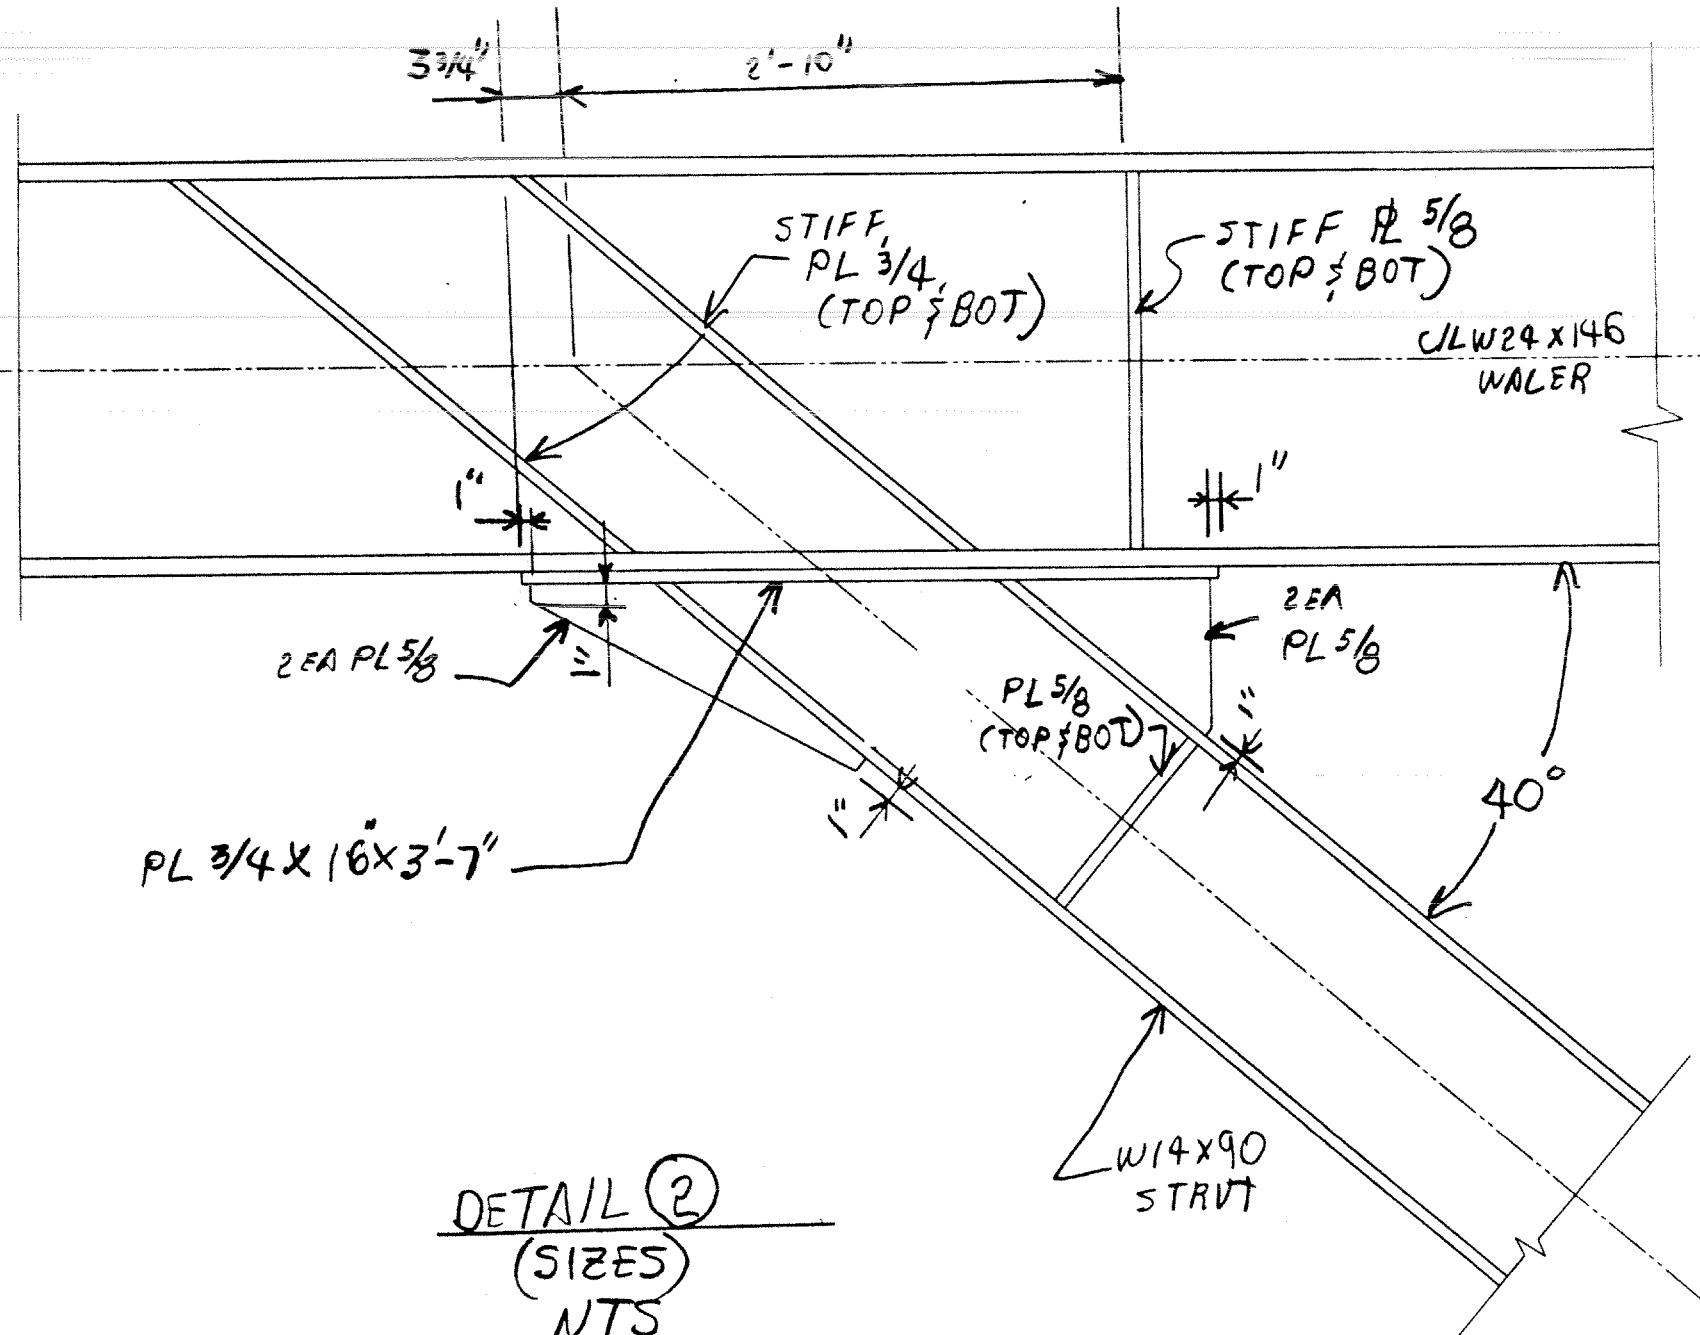

W 24x145

Sketch 6


DETAIL ②
(WELDS)
NTS


TYP. $\frac{1}{4}$

W14x90
STRUT

PL $\frac{5}{8}$
BELOW
SEE DETAIL


VARIES
LOCATE AT
NEAREST AZ
48 FLANGE

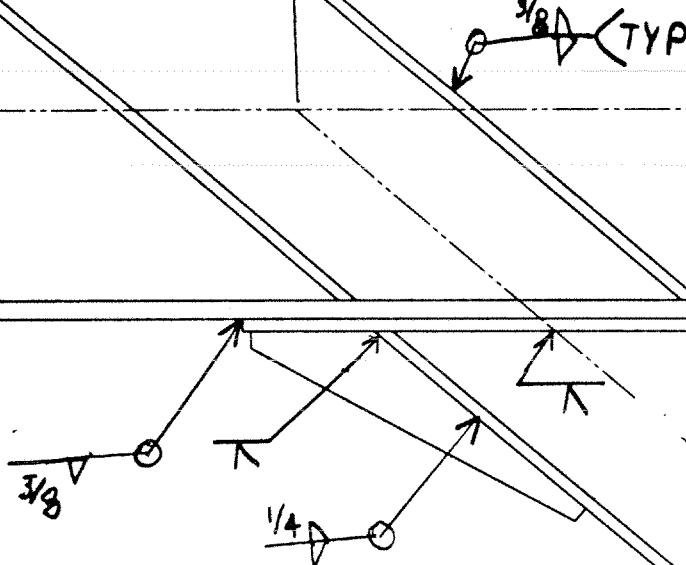

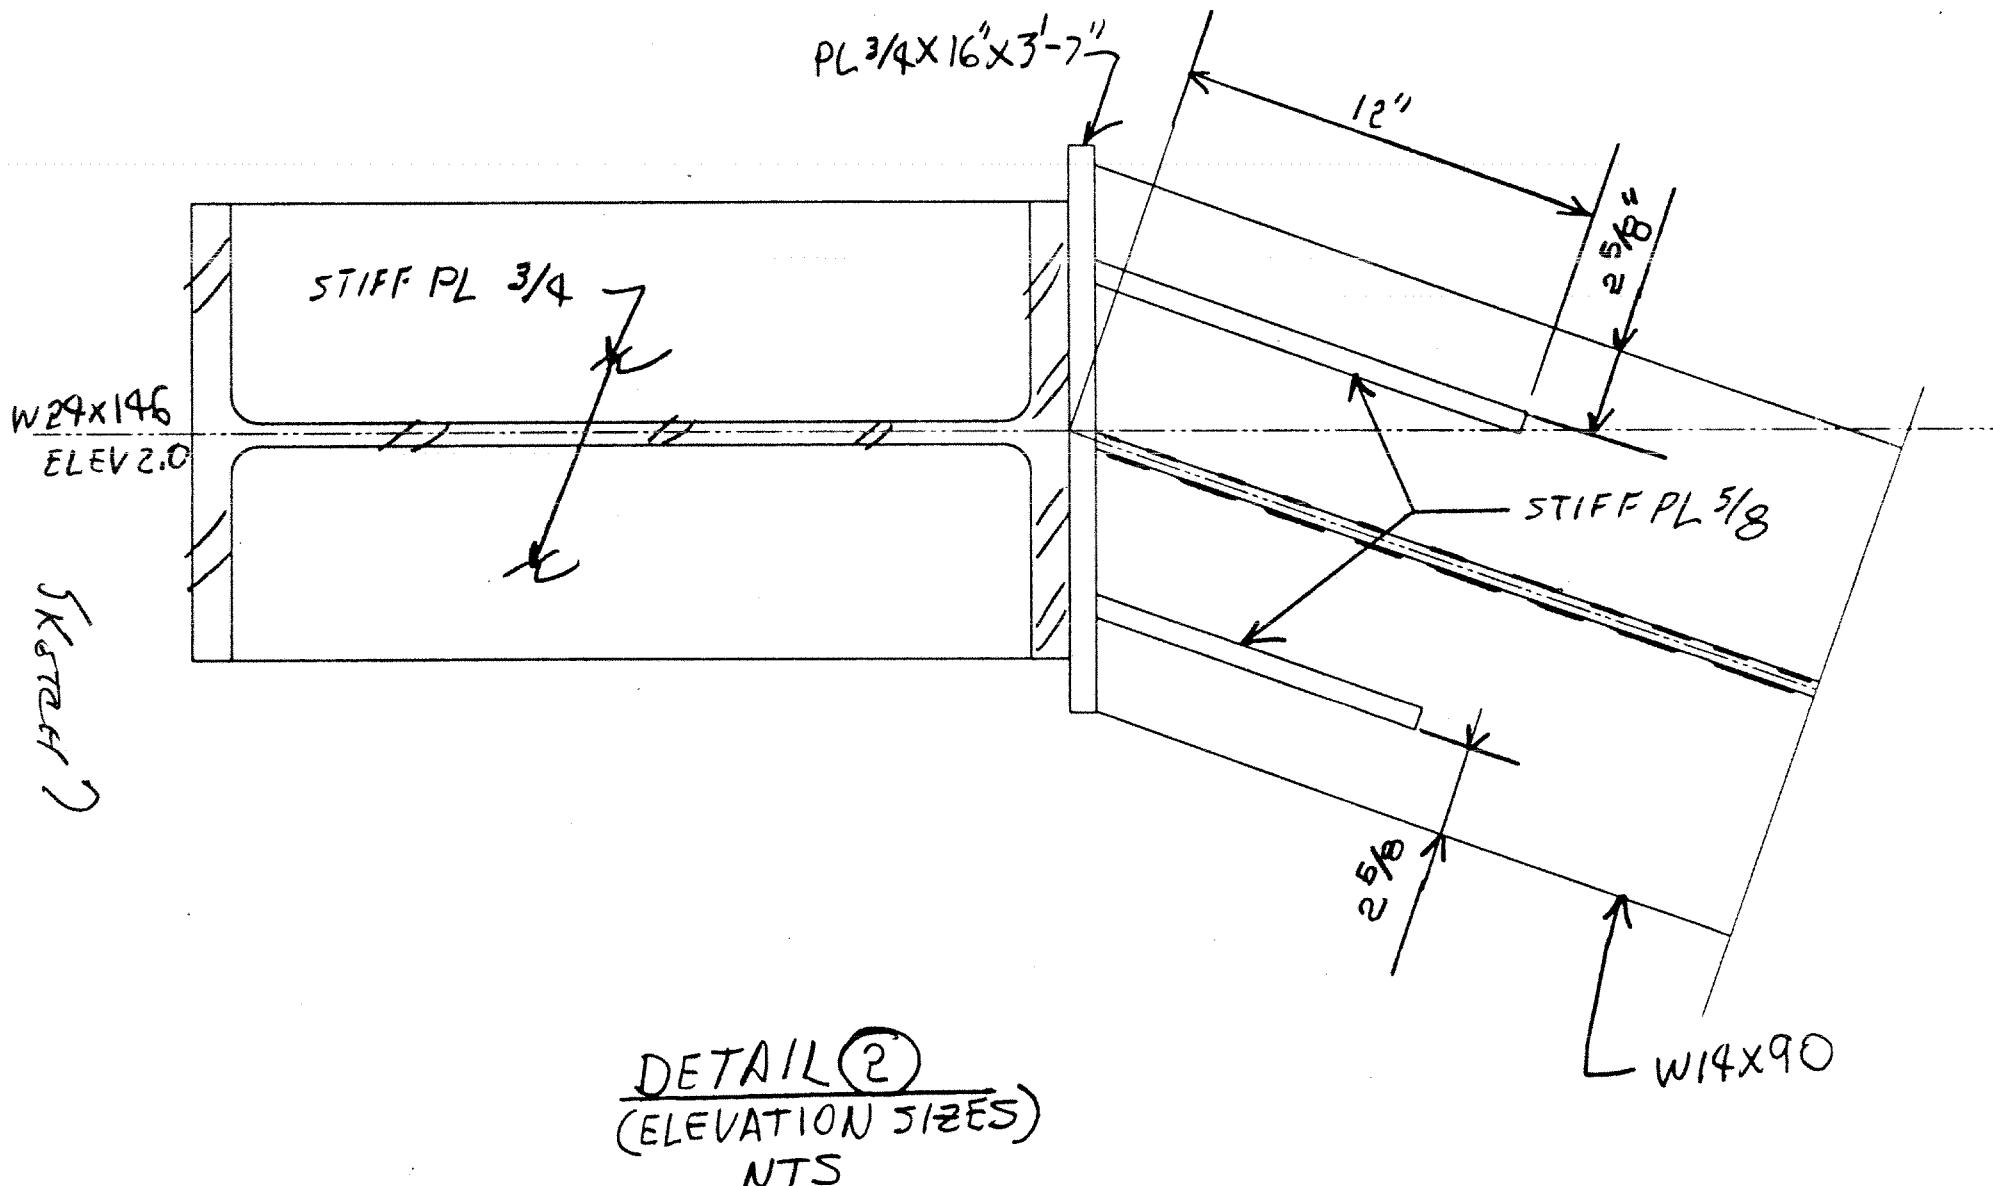


W24x146
EL 2.0


Sketch

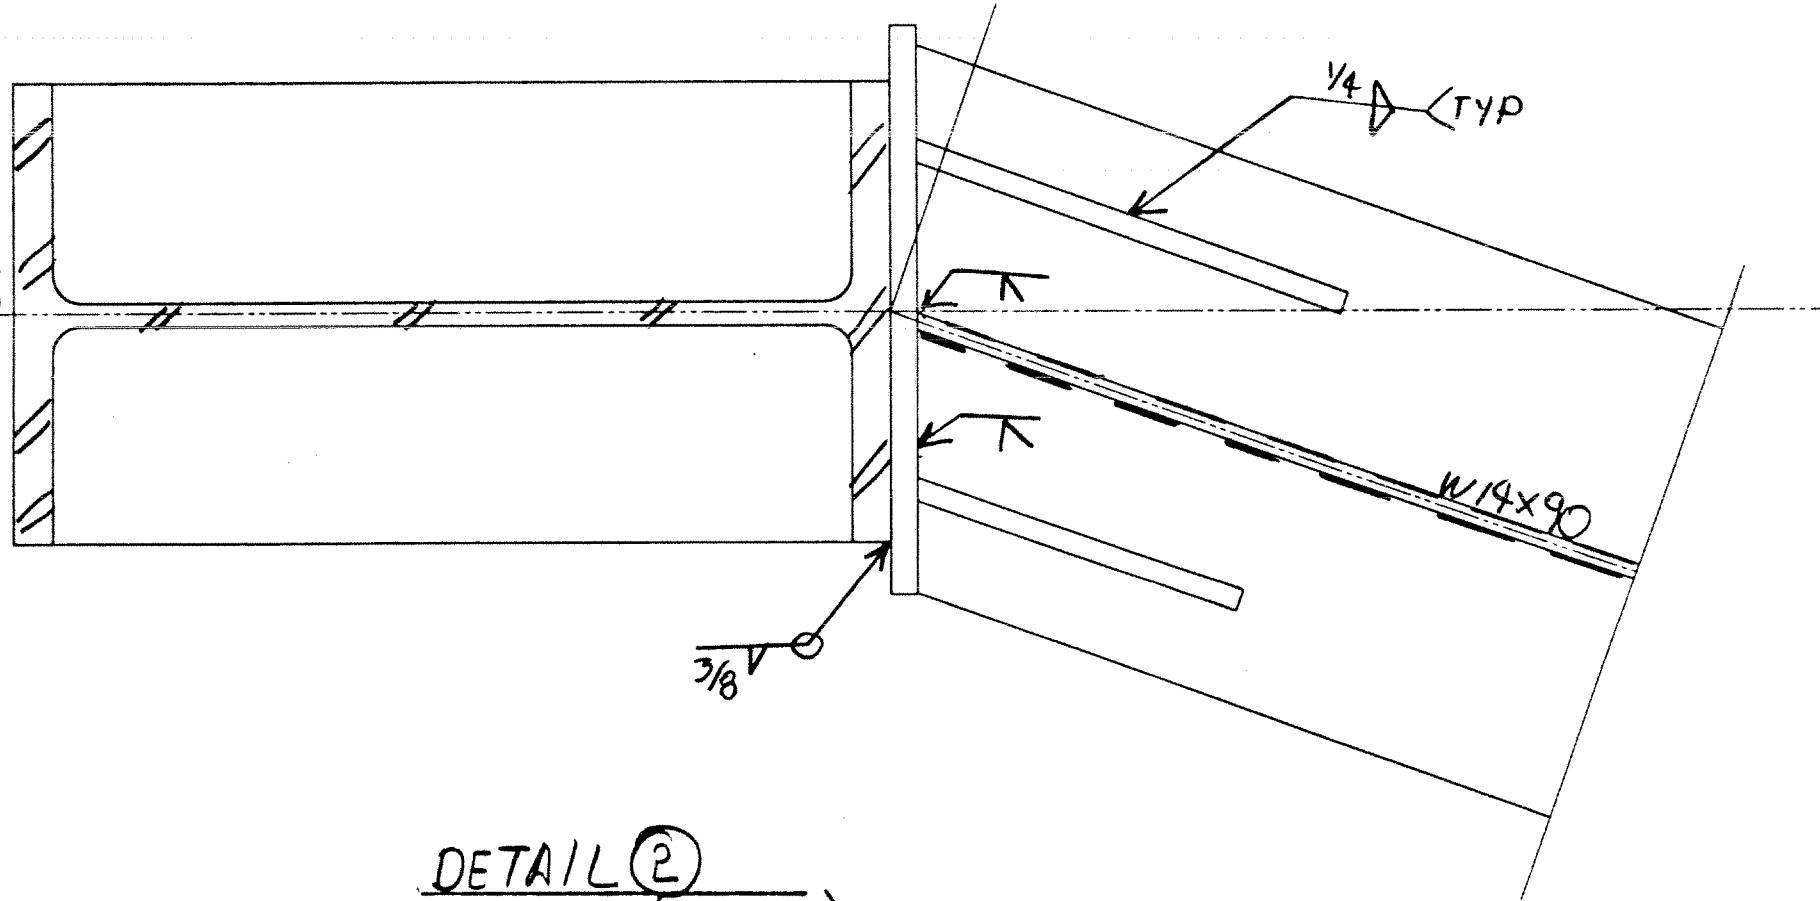



DETAIL (2)
(ELEVATION SIZES)
- NTS

Sheet 9

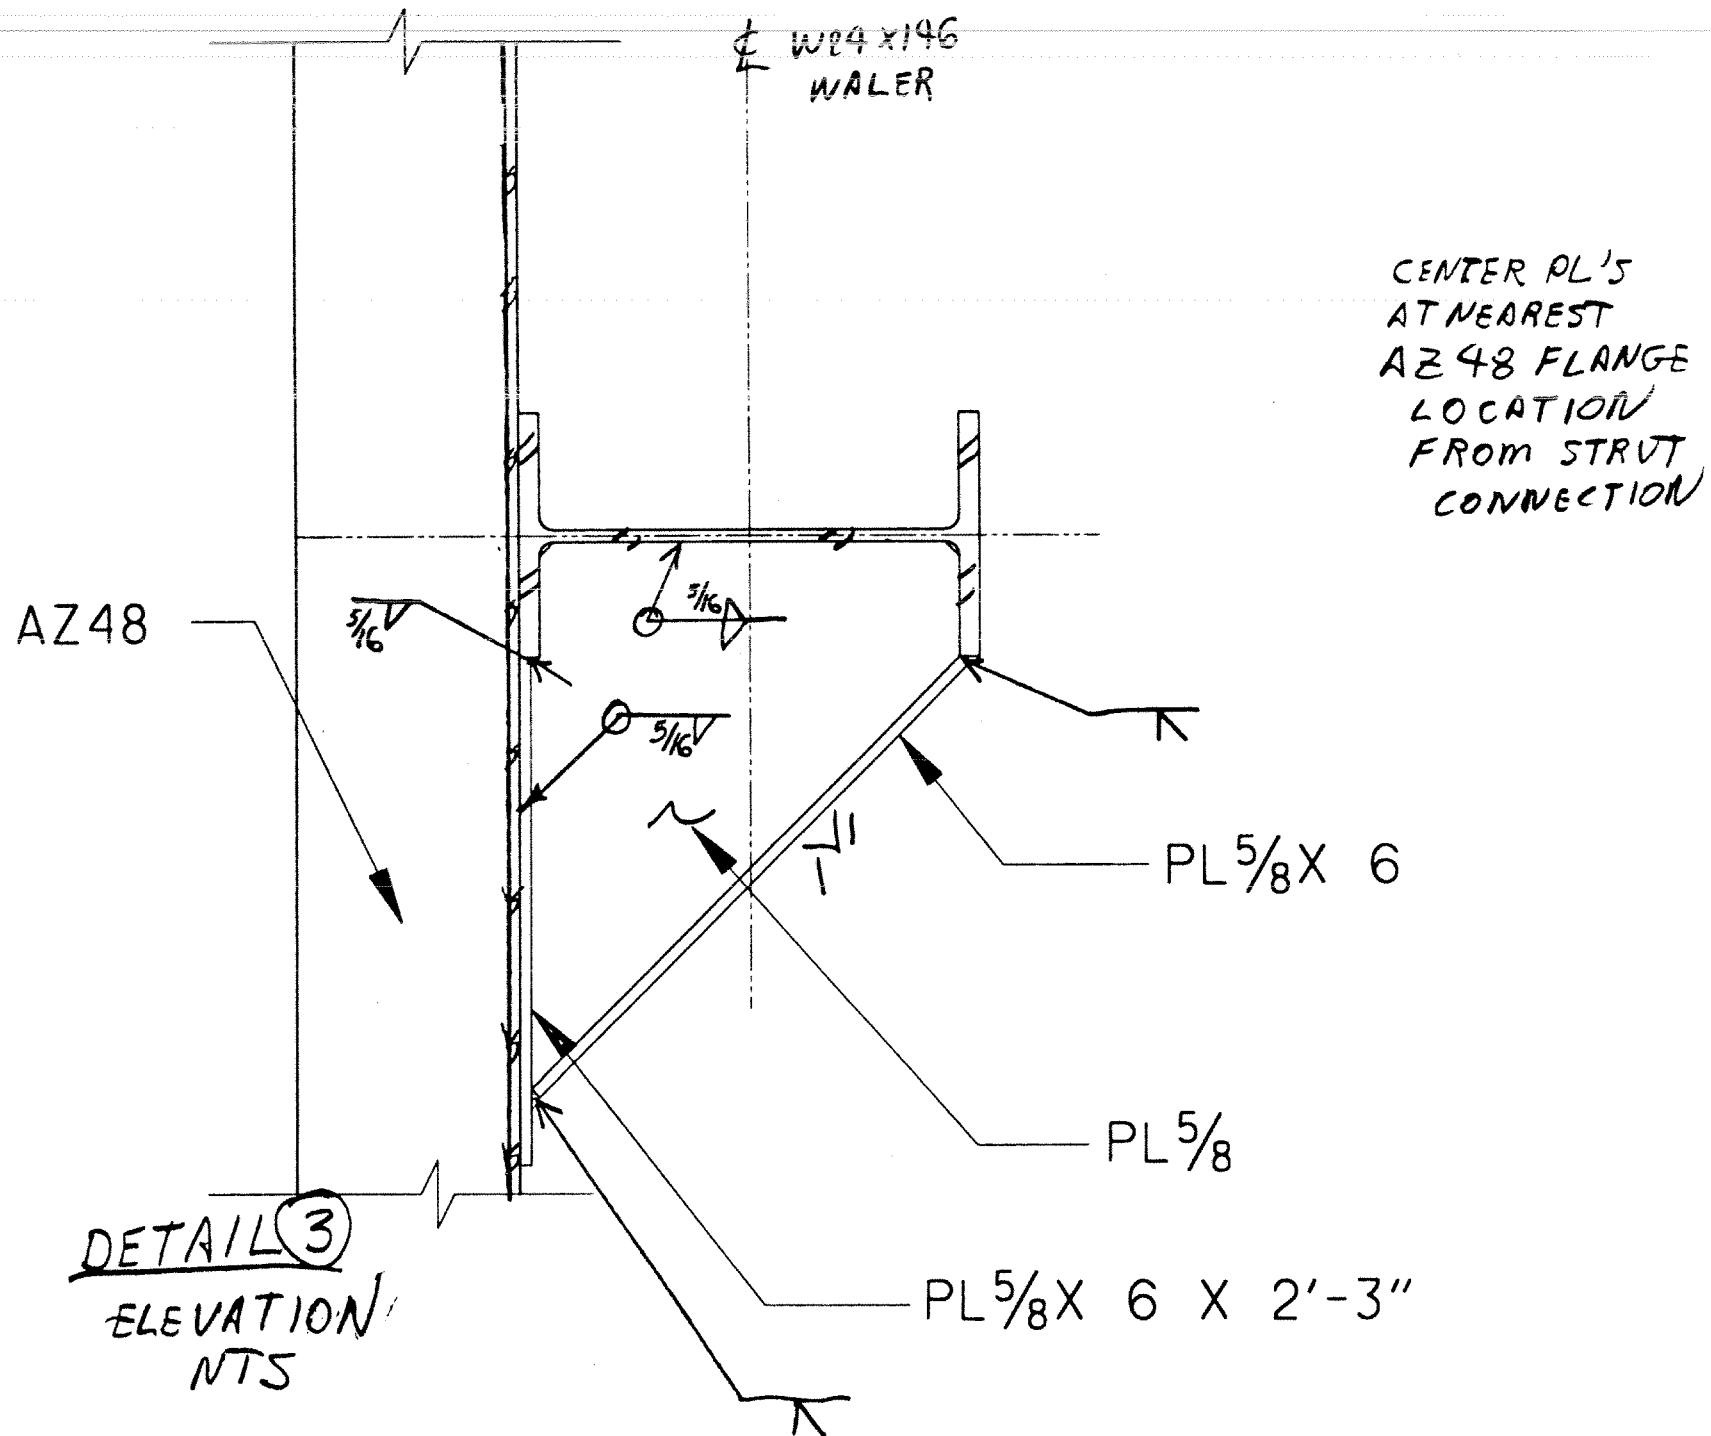

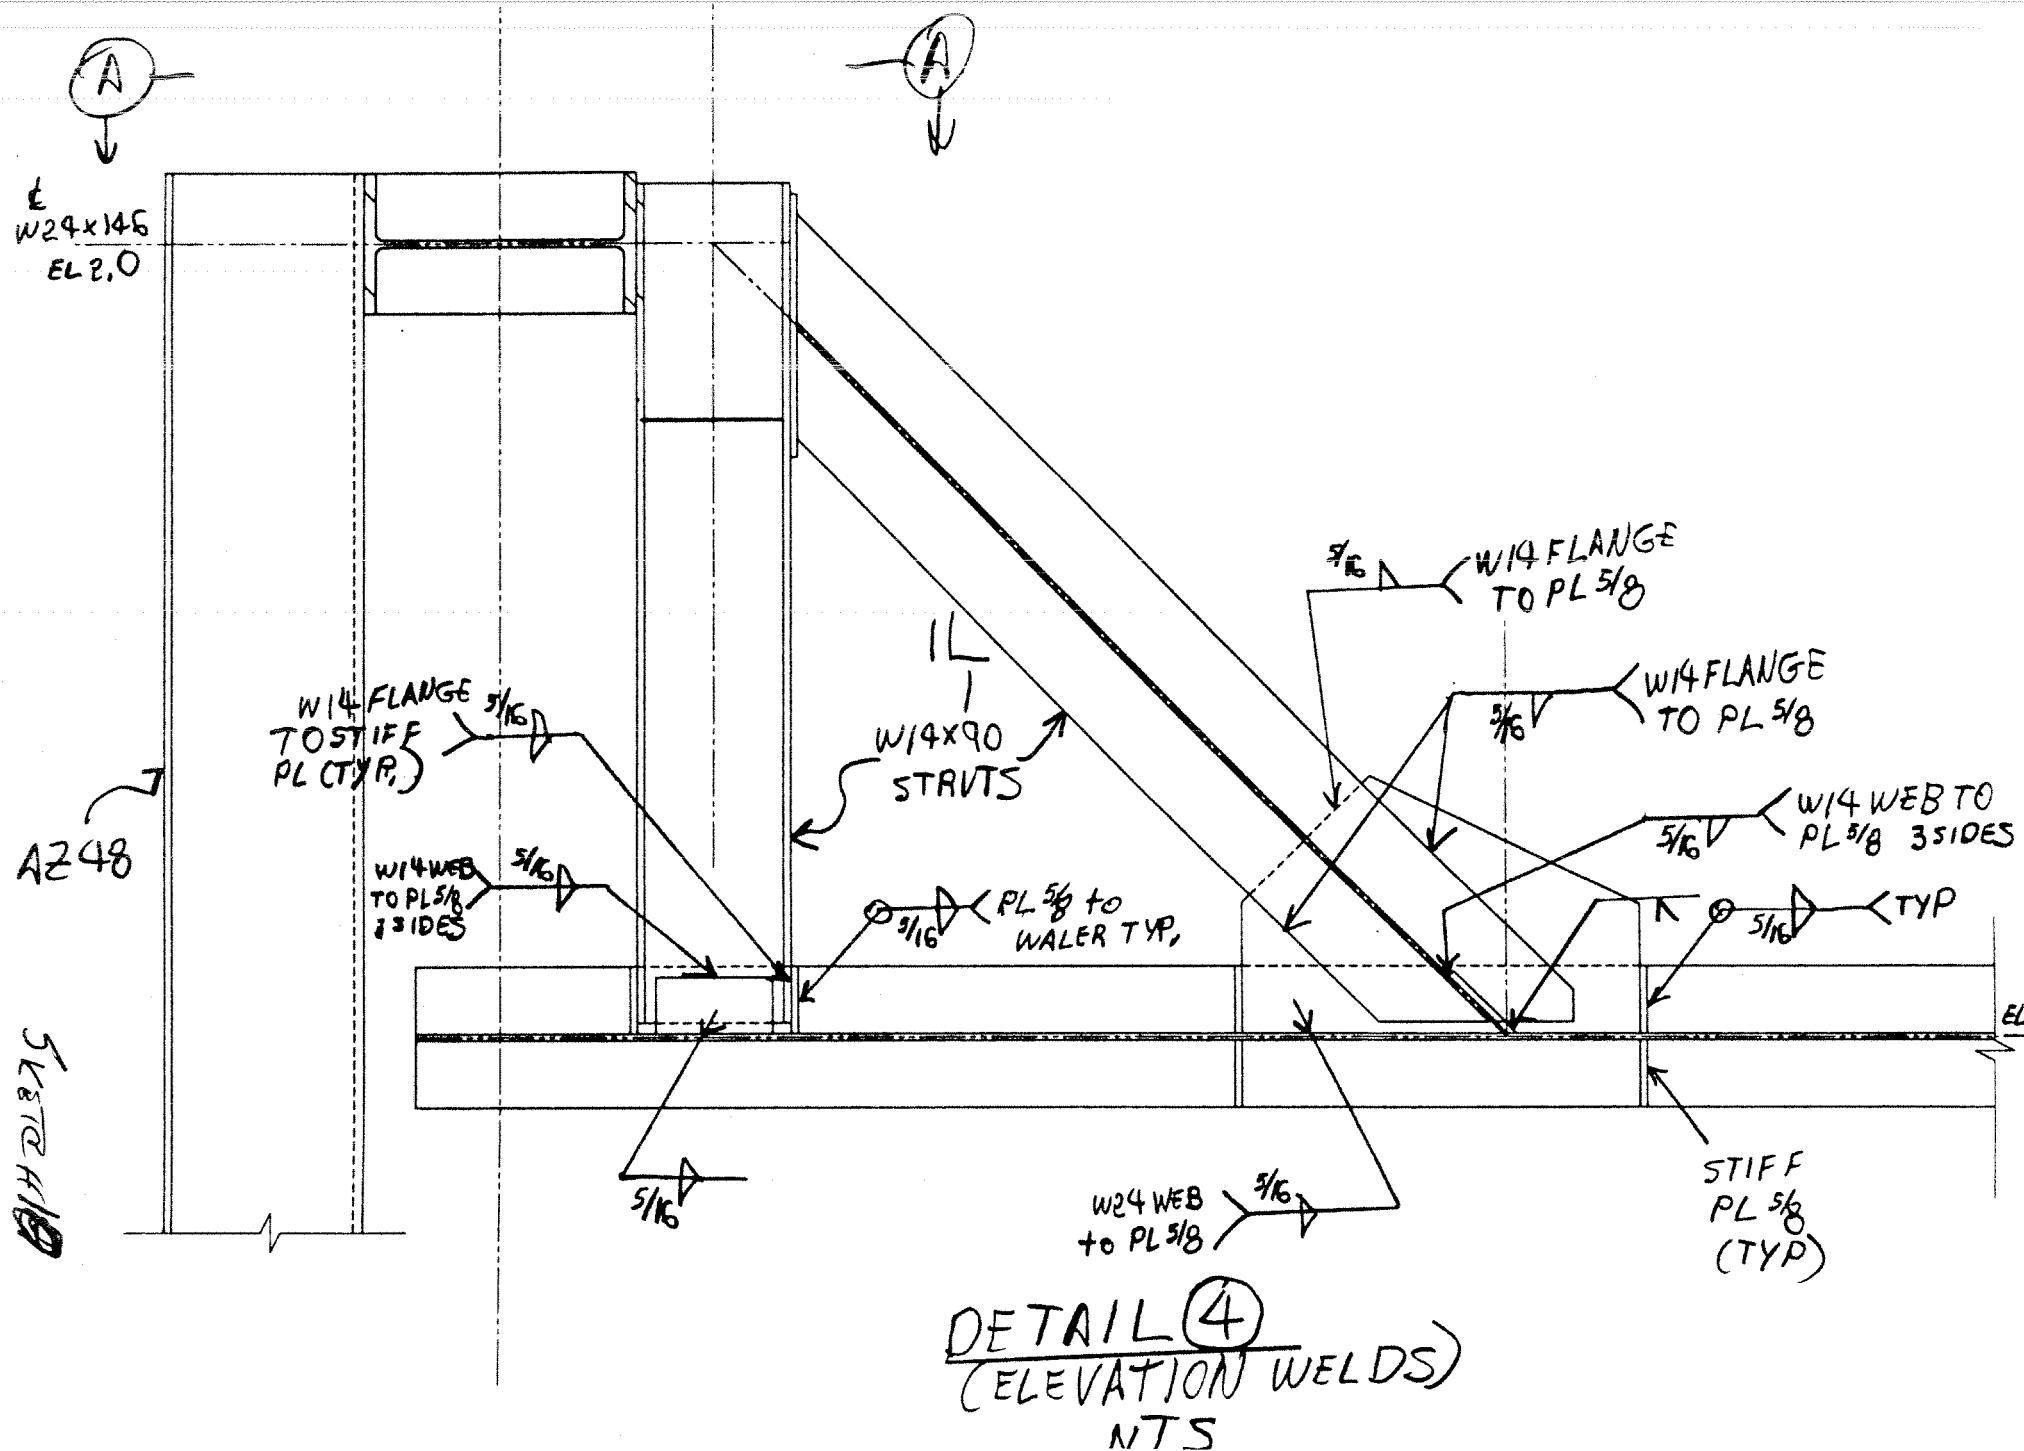


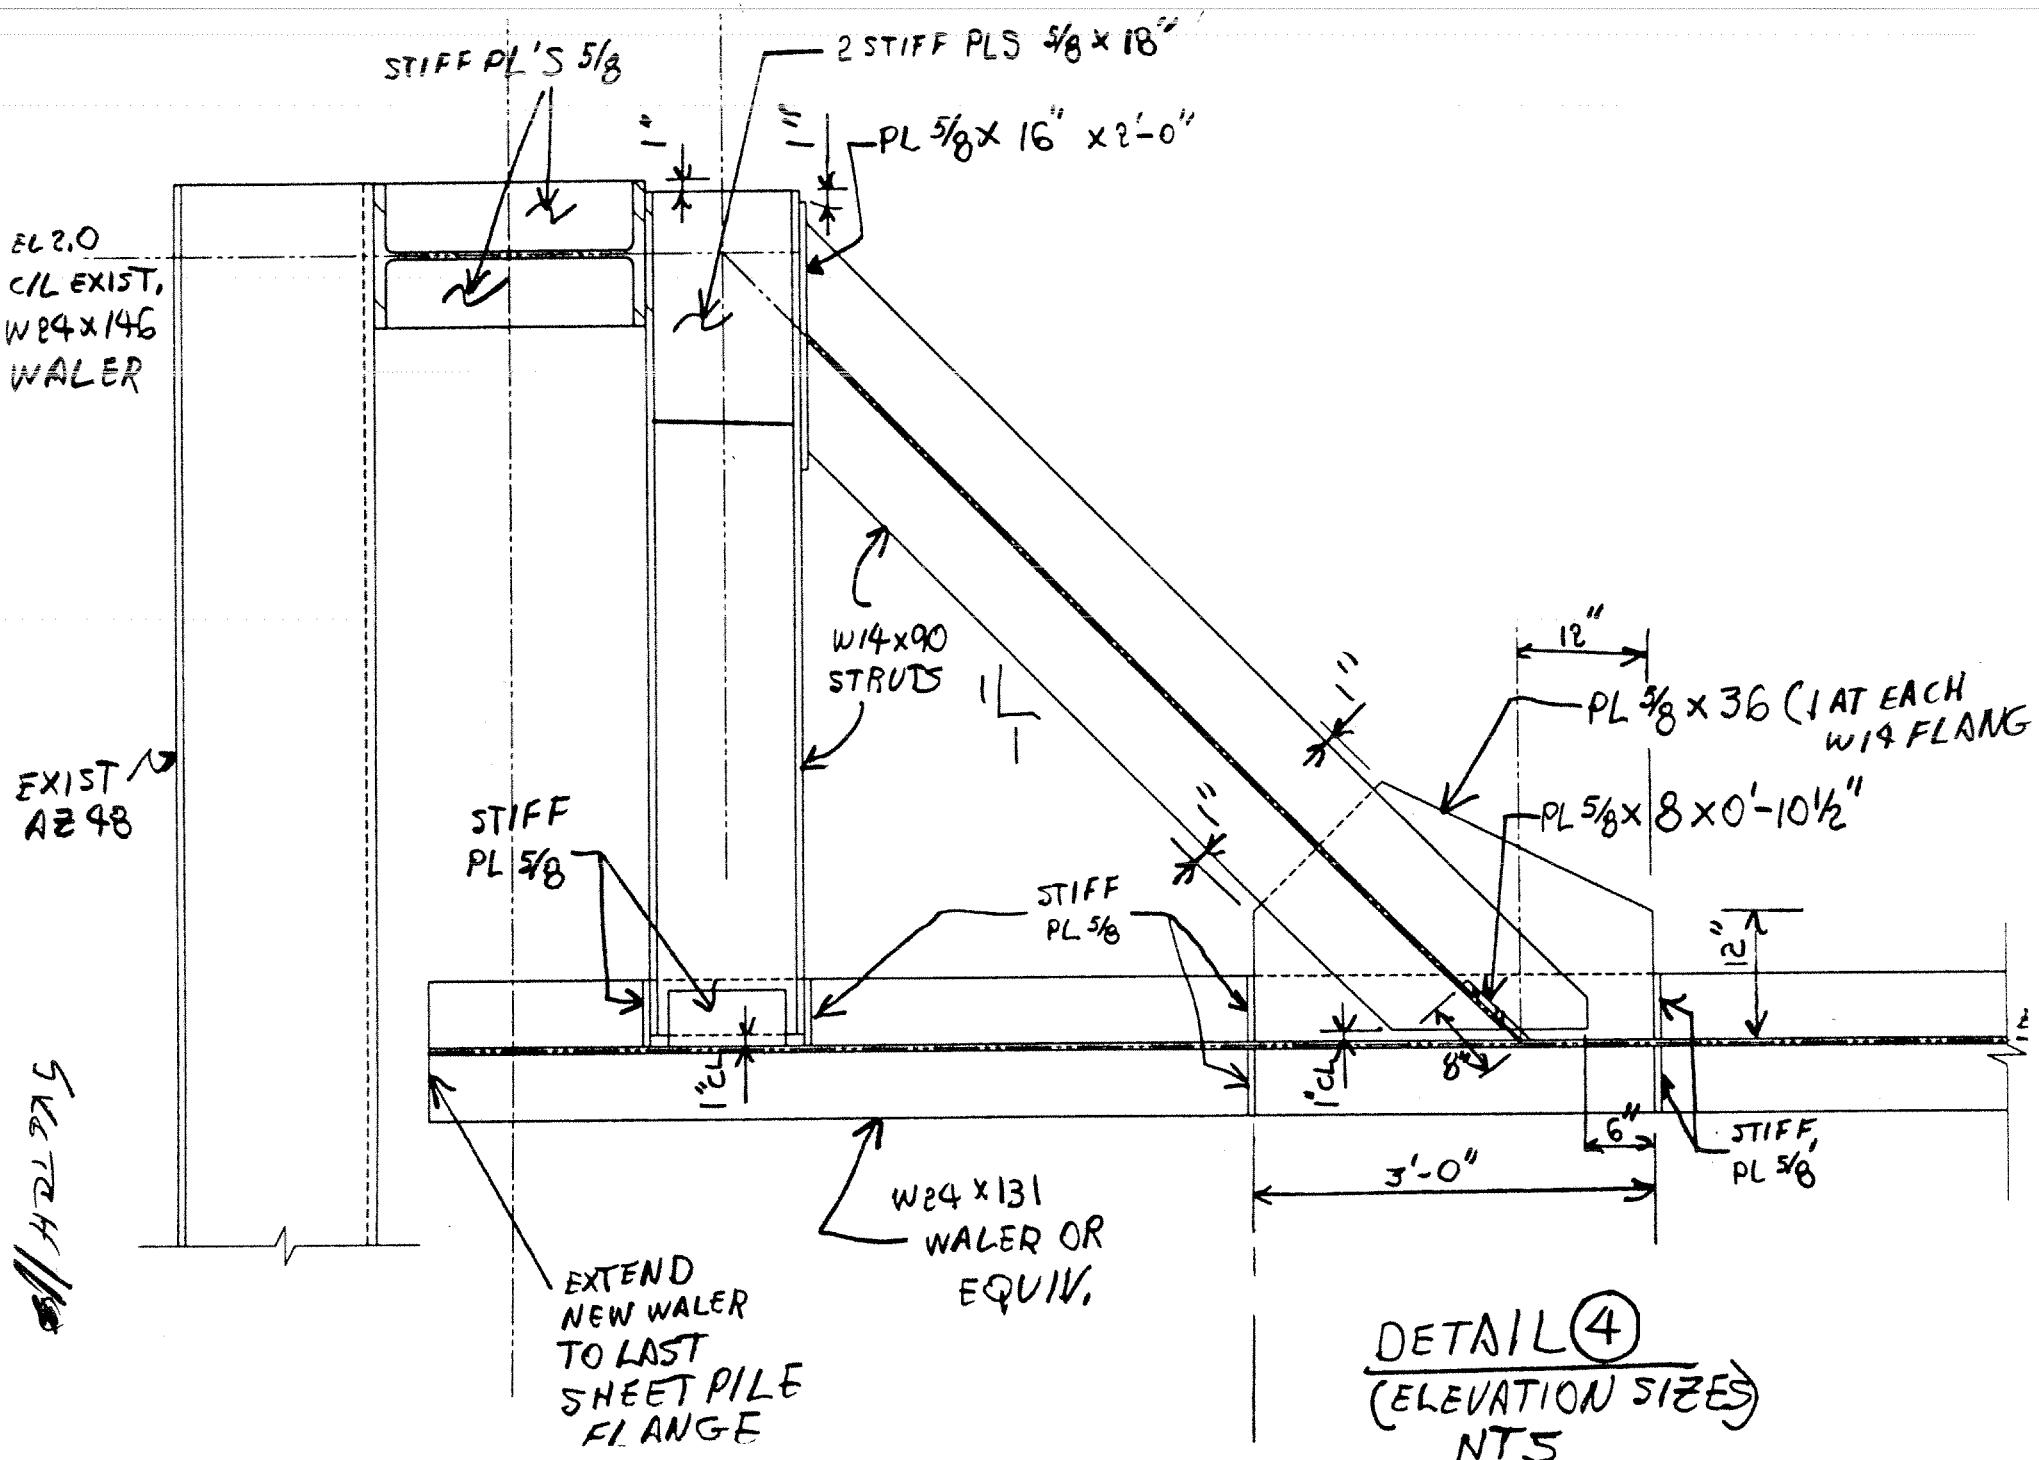

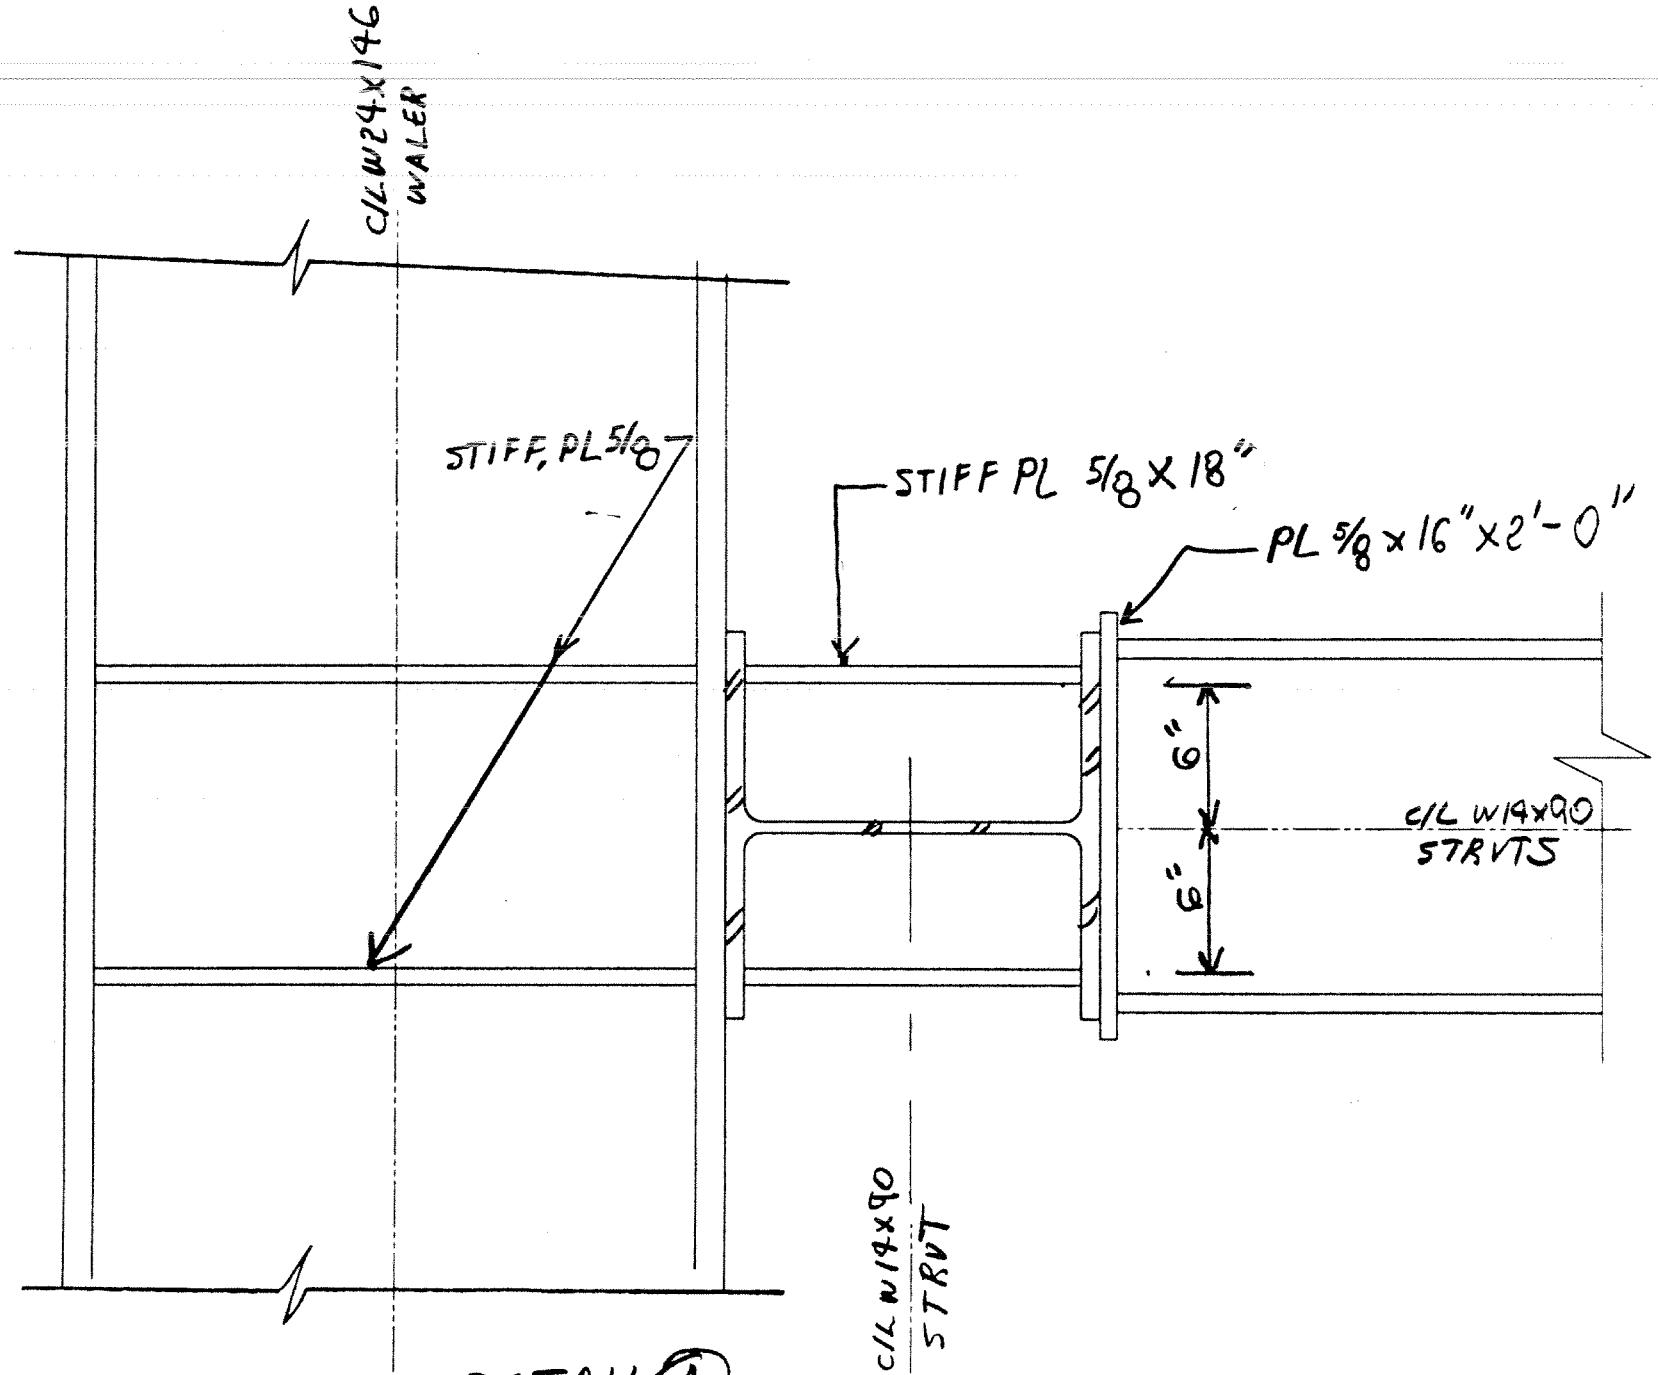


DETAIL 4
SECTION A
(SIZES) NTS


Sketch # 13

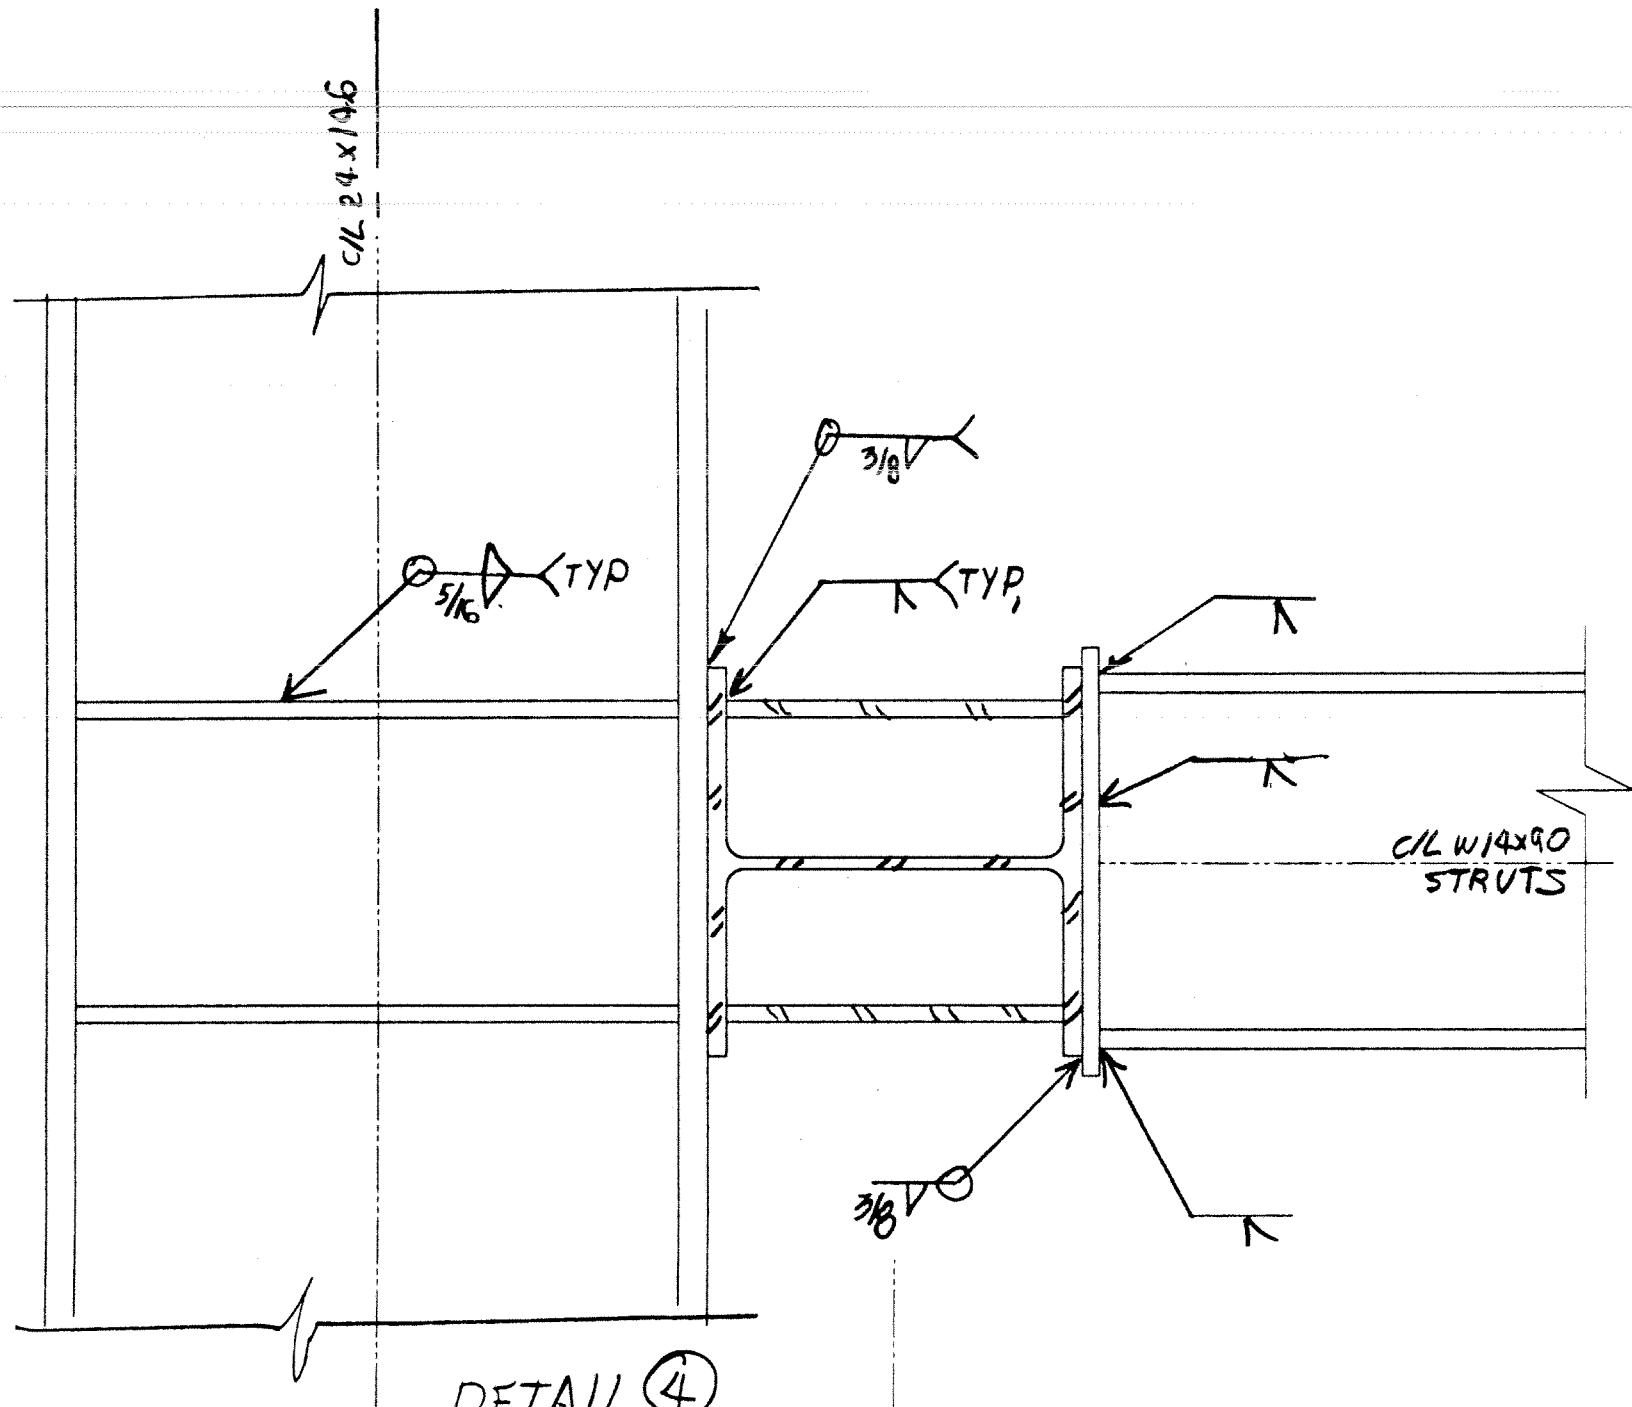

DETAIL ④
SECTION A
(SIZES) NTS


Sketch 13

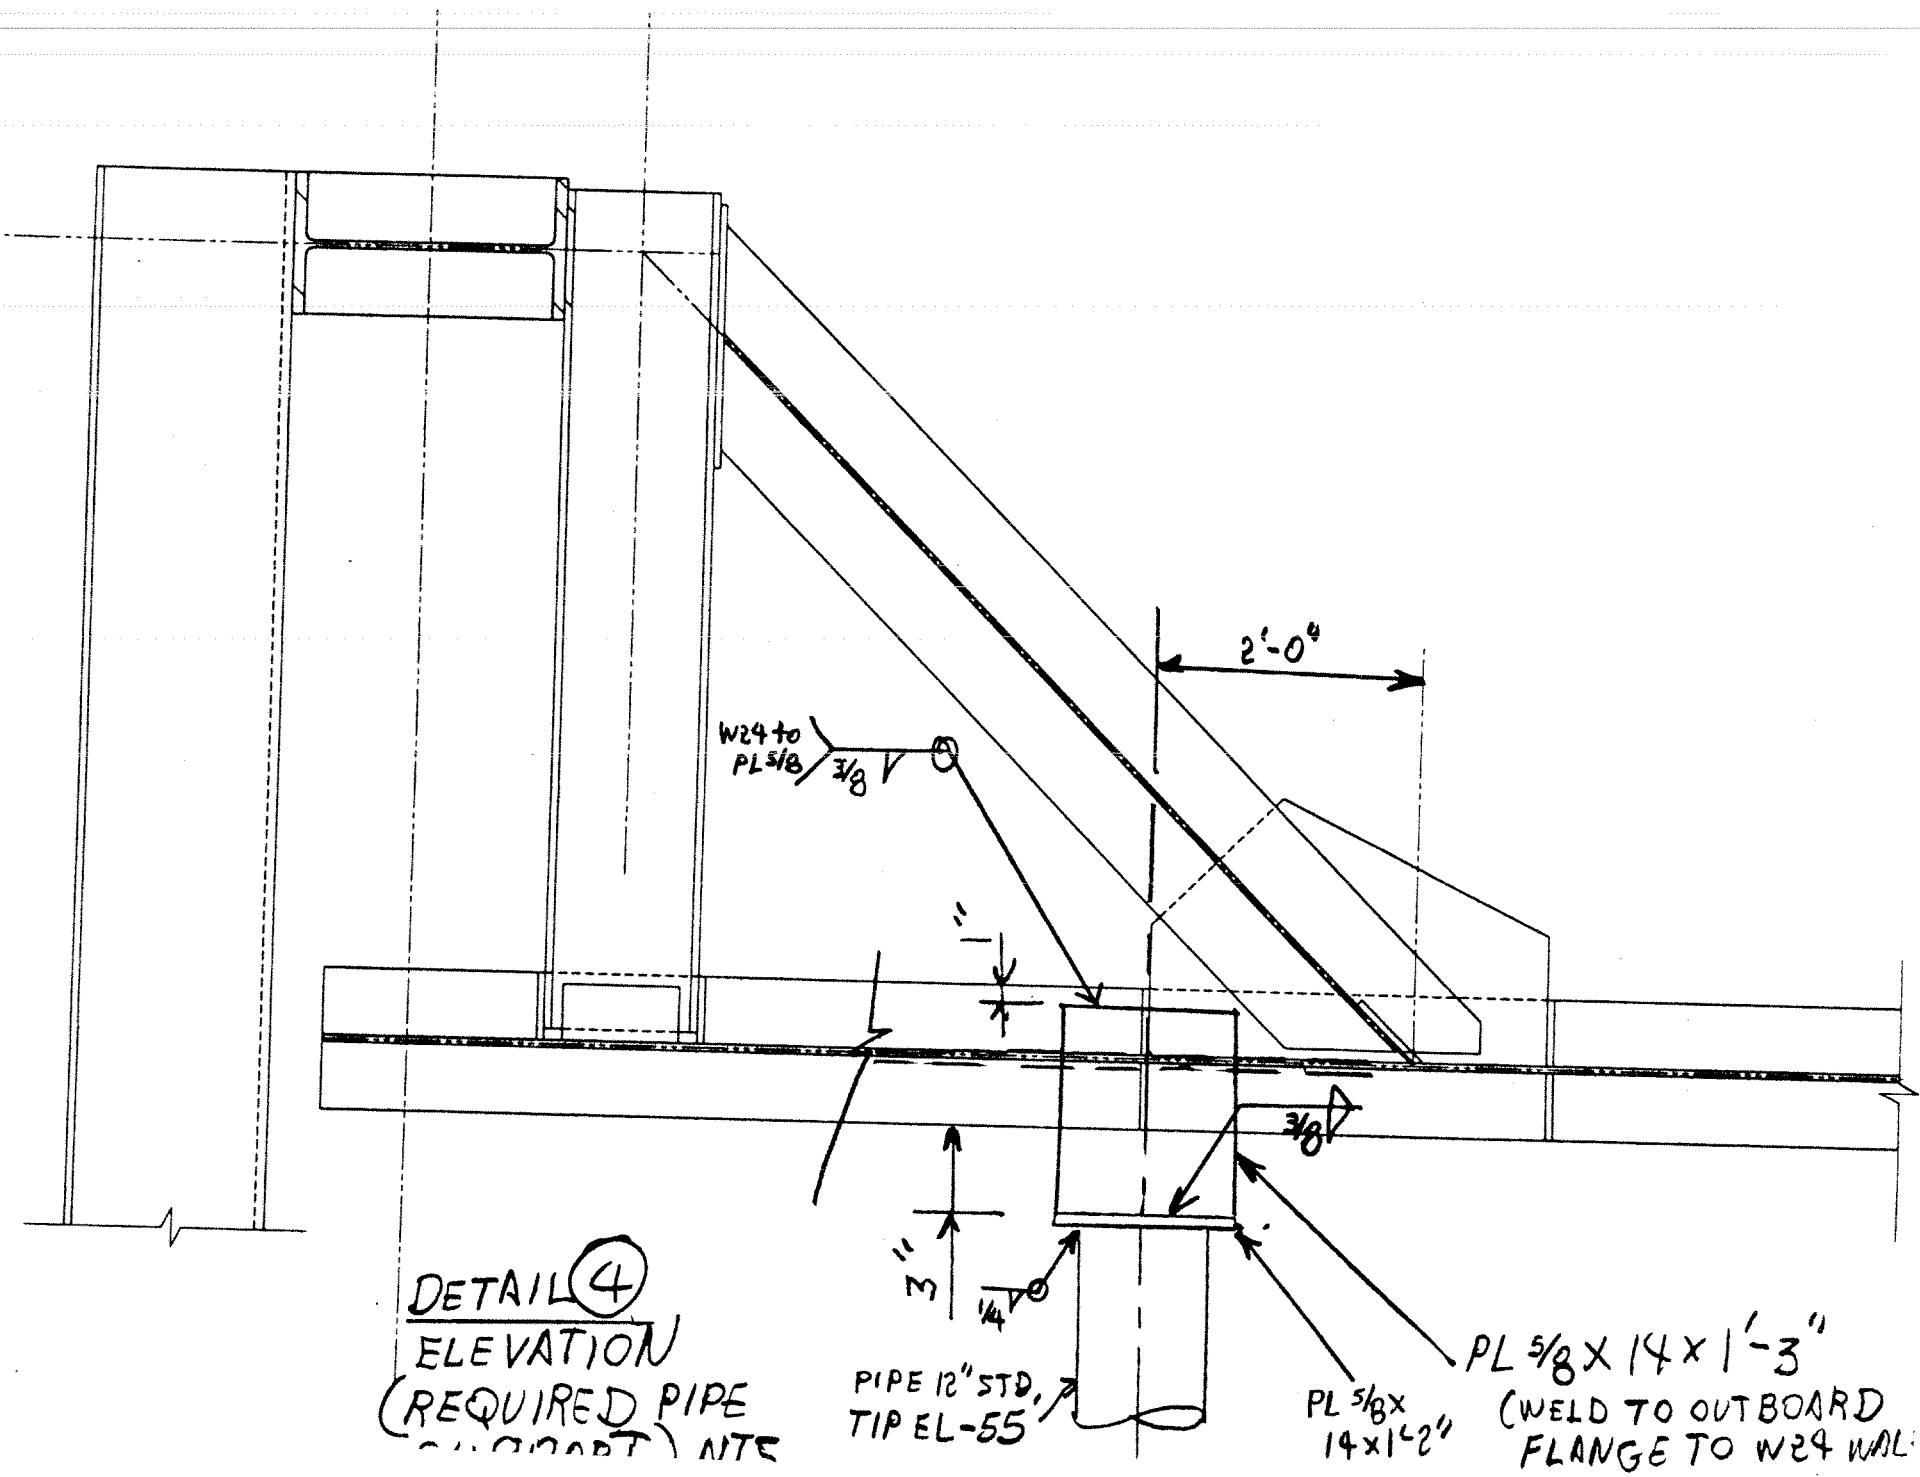

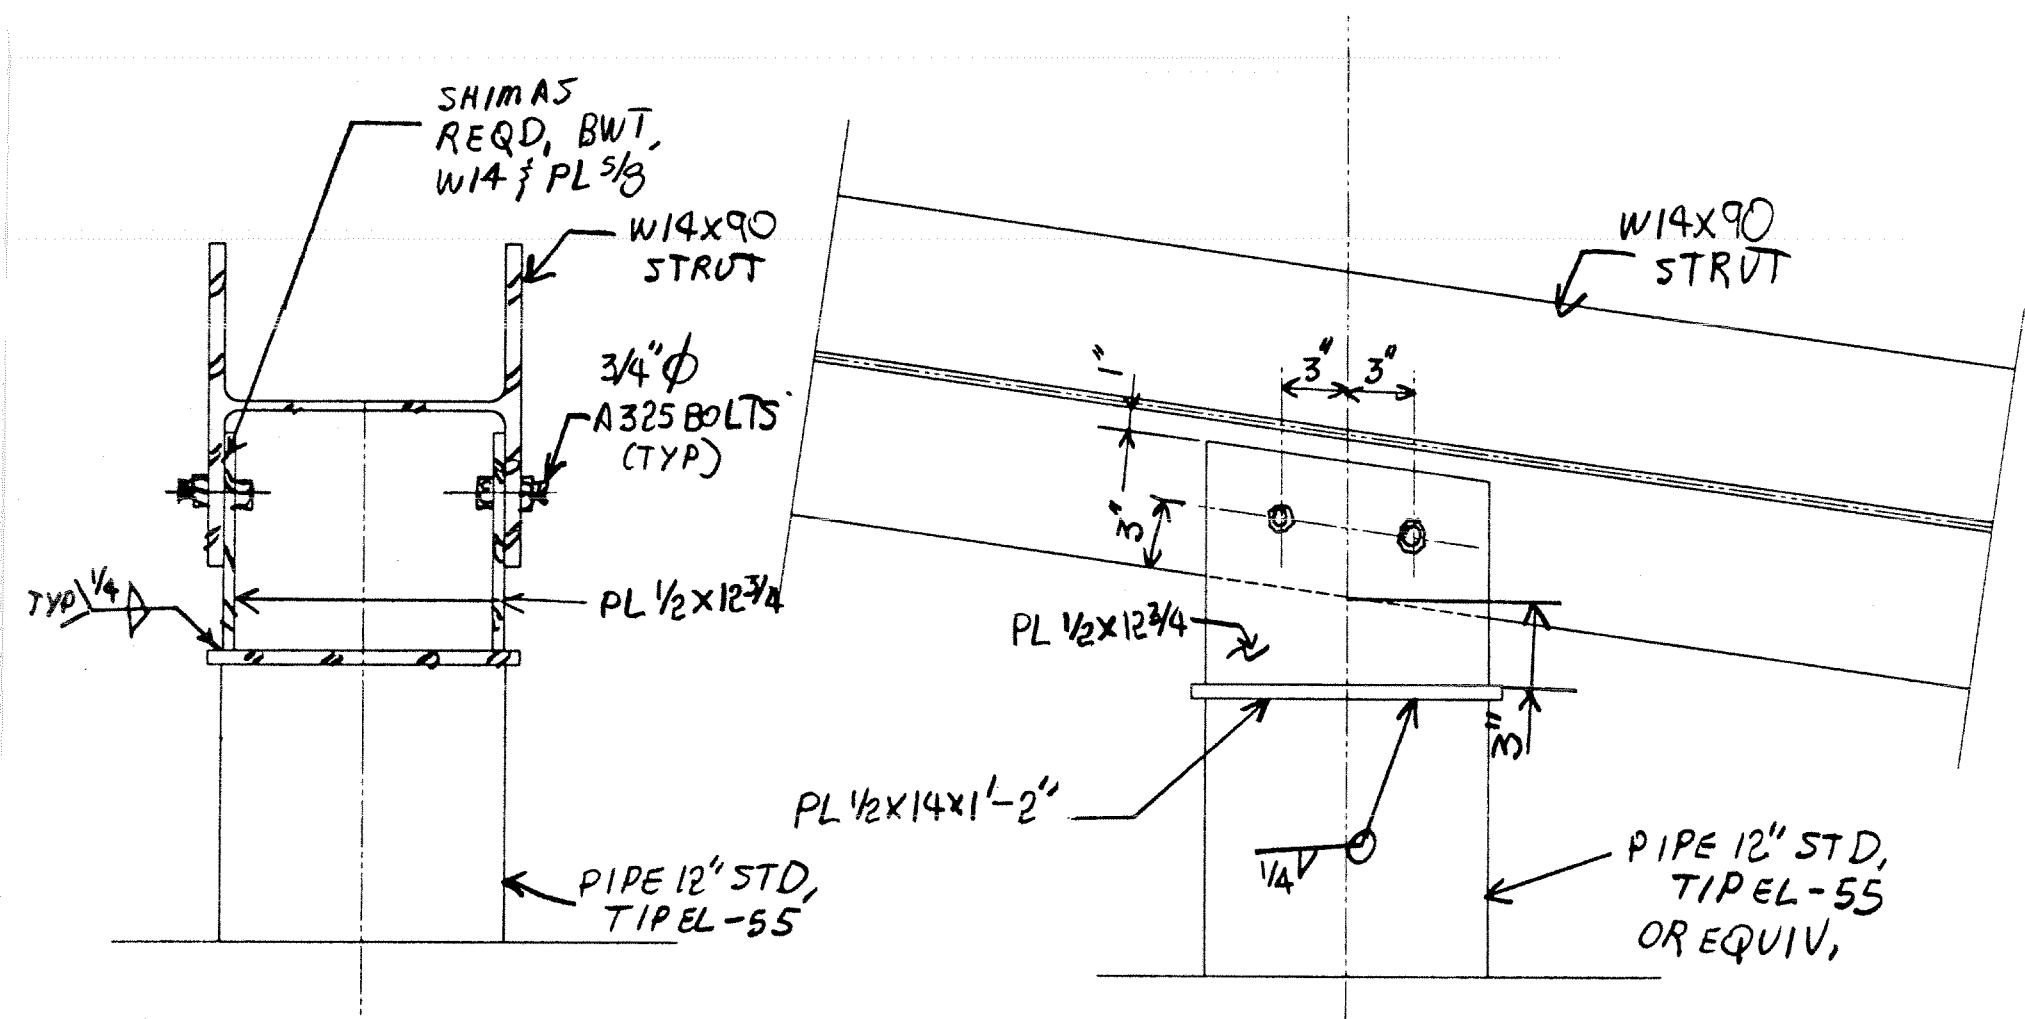

DETAIL 5
 (SIZES & WELDS
 NTS


Sketch 15

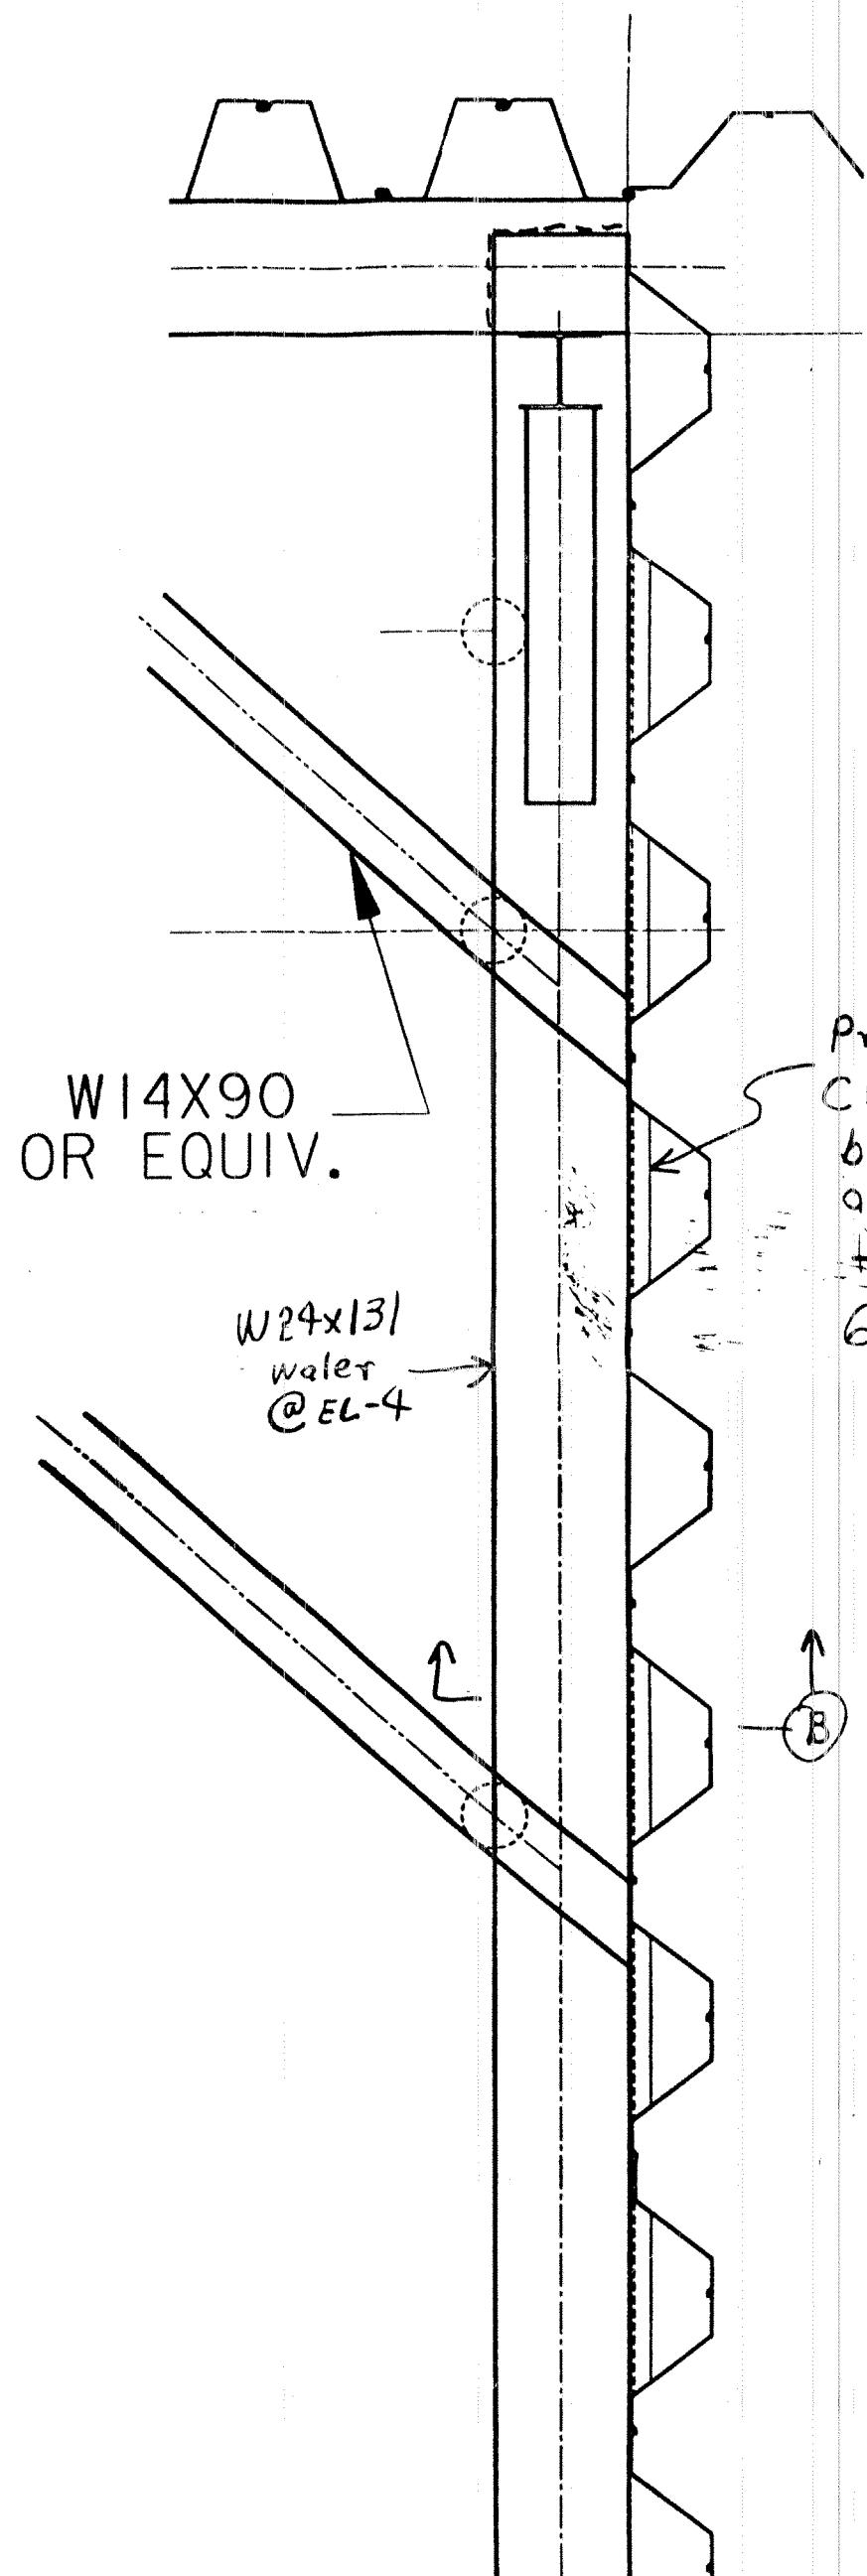


Provide
C15x50 connection
bwt. W24x131 Water
and Contractor
furnished sheet pile,
6 Locations as shown

DETAIL ⑥
NTS

C1 Hangers

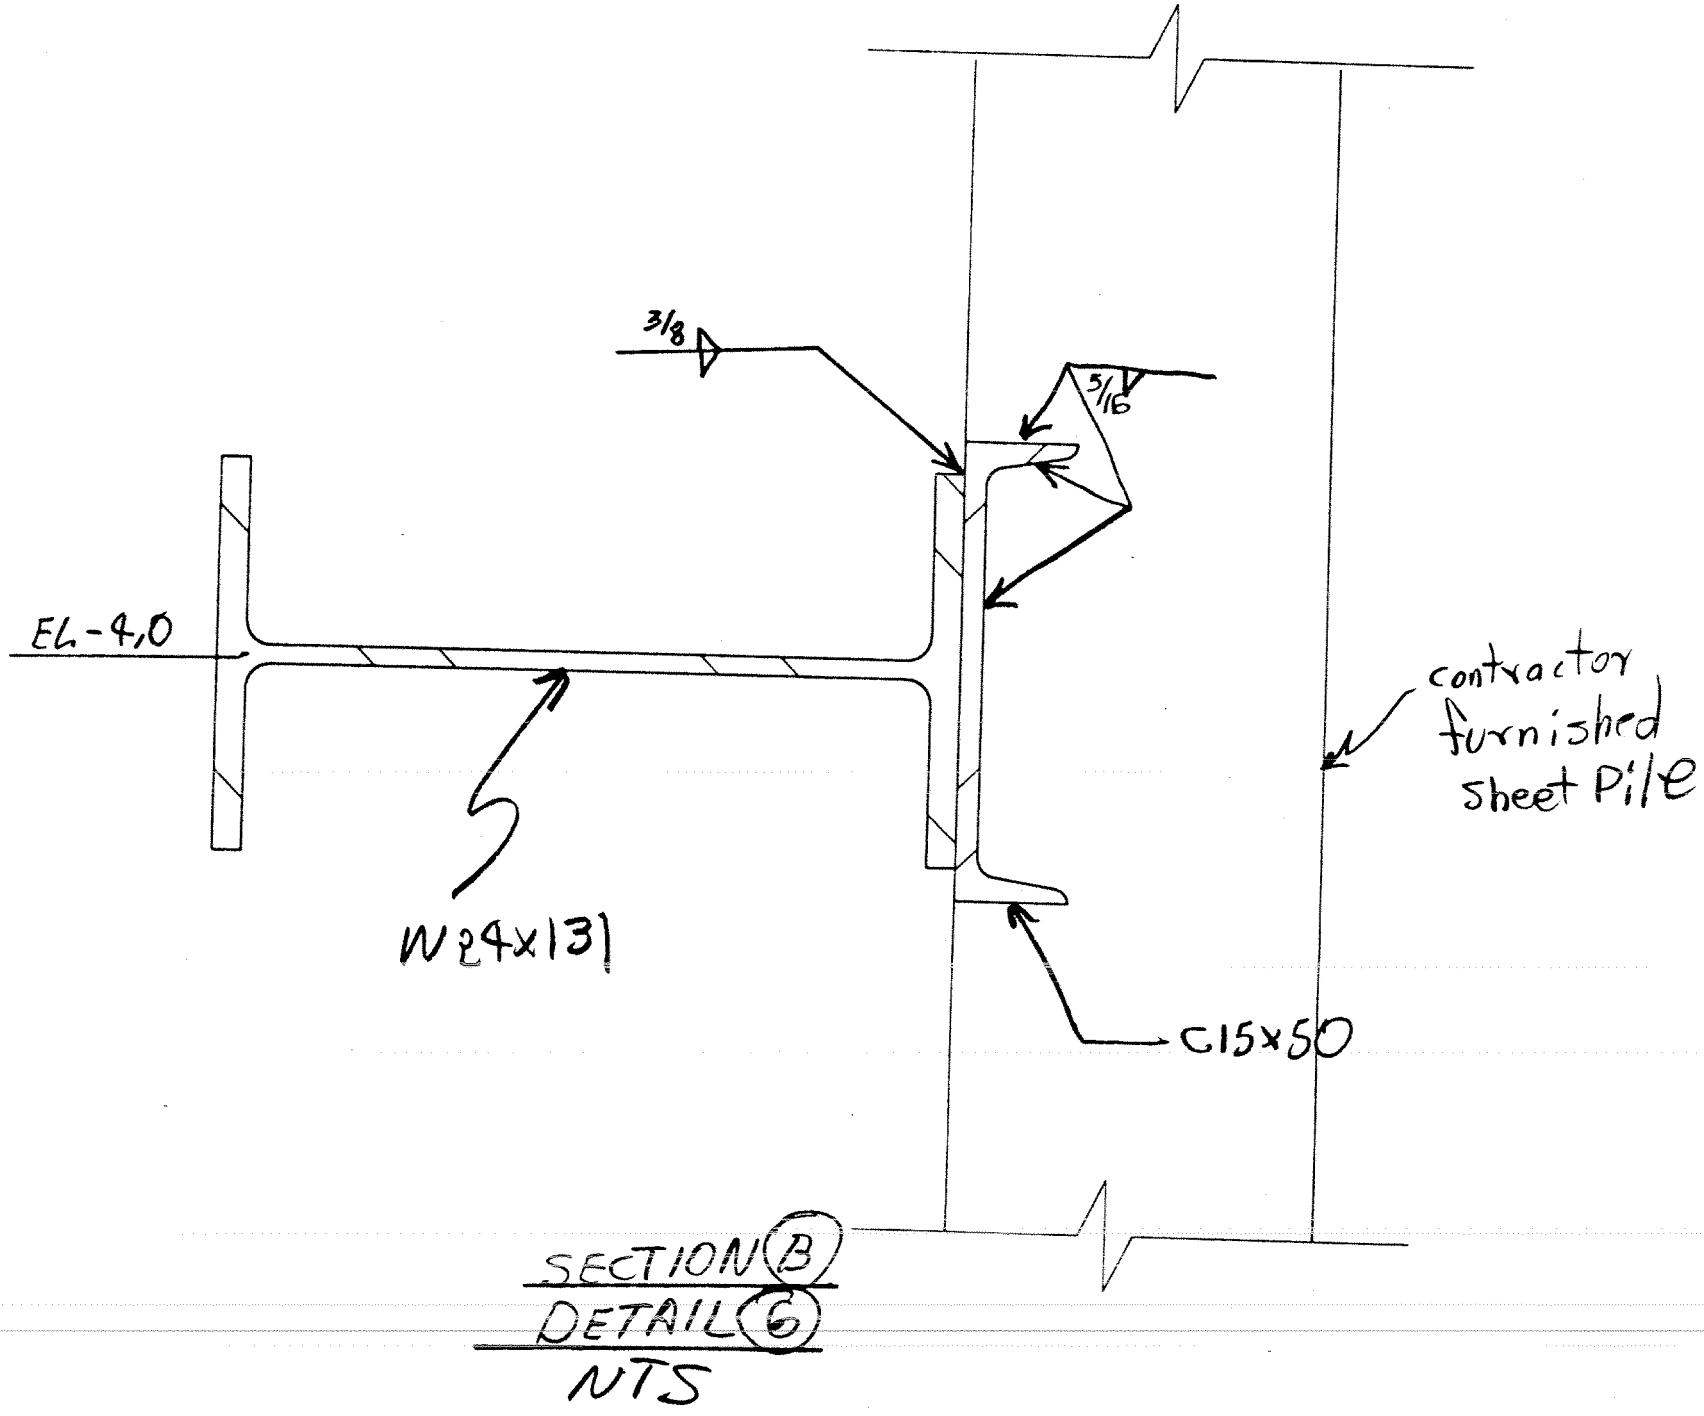


Safety is a Part of Your Contract

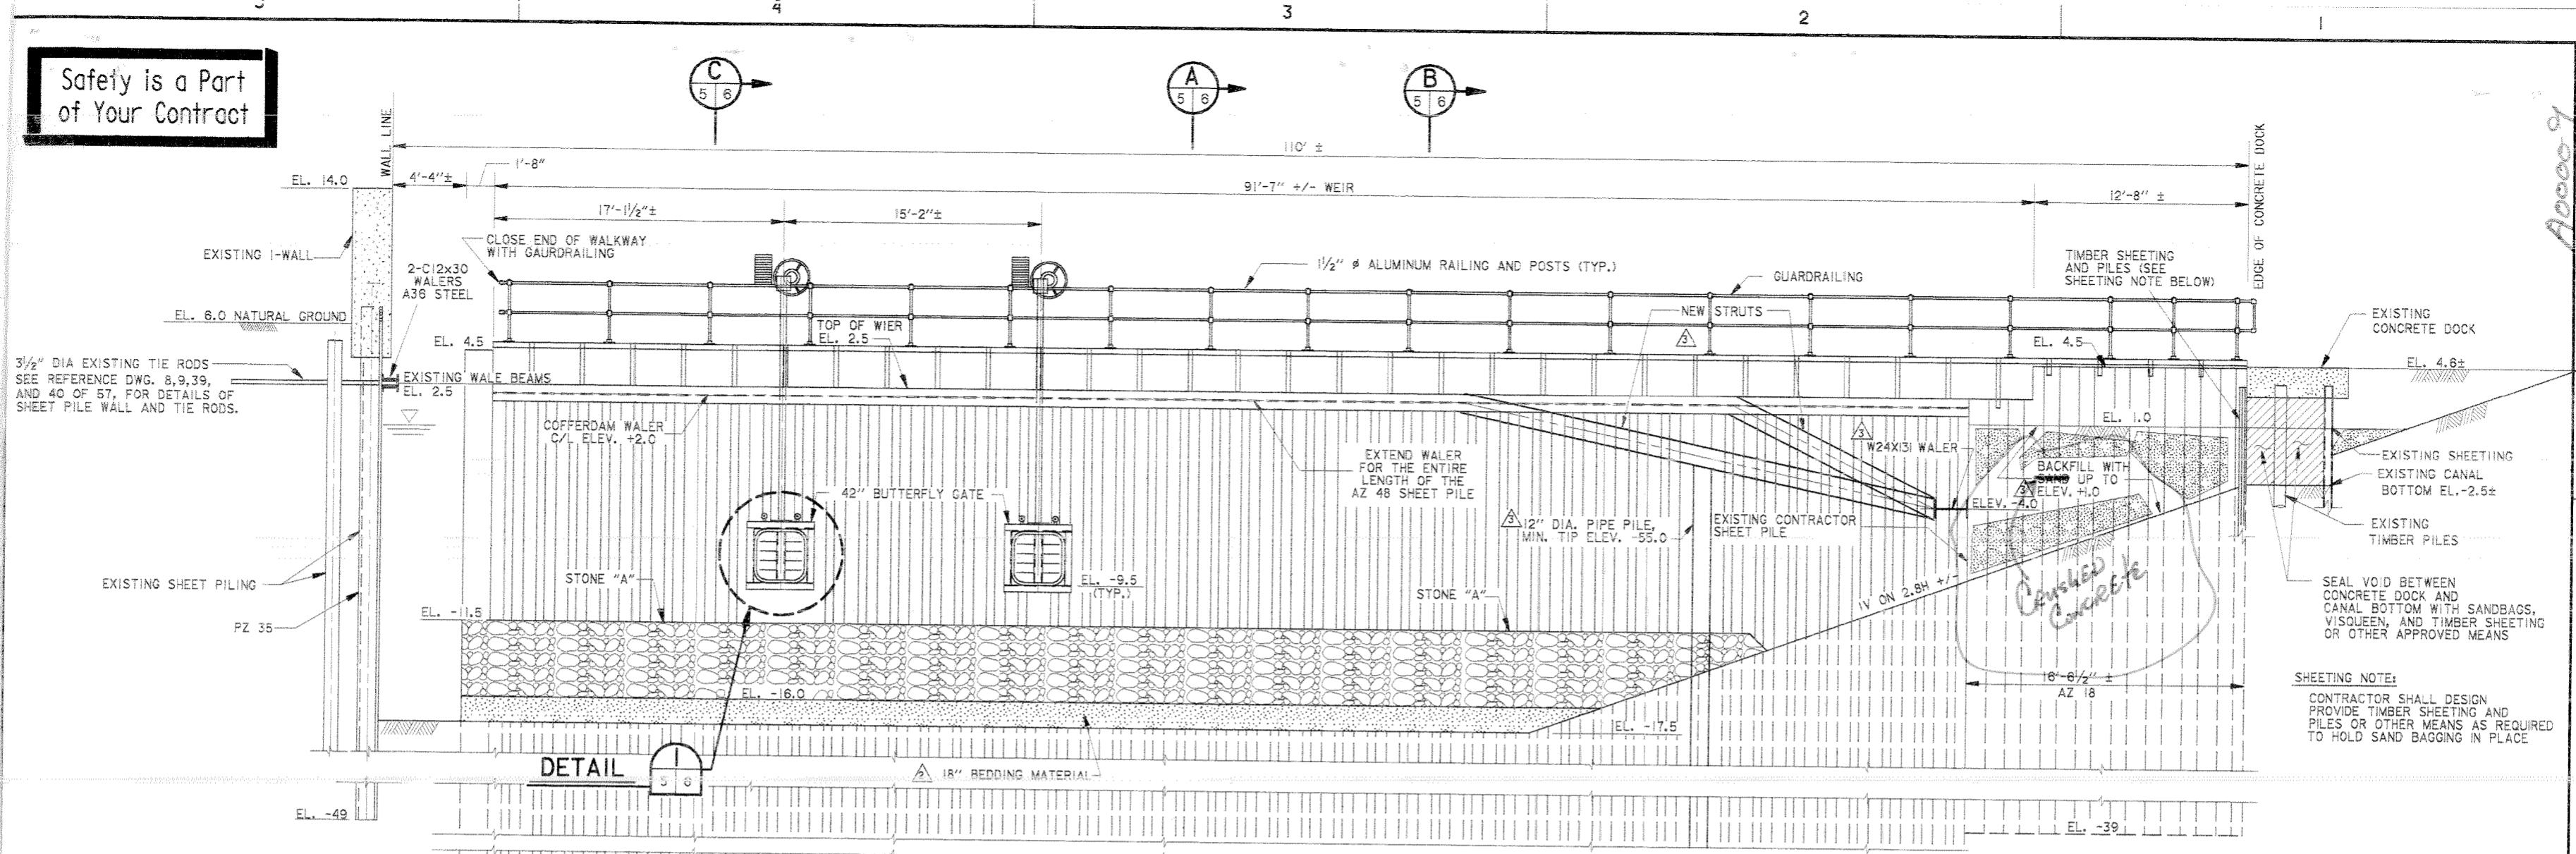

SOUTH ELEVATION
COFFERDAM

SCALE: $\frac{1}{4}'' = 1'-0''$

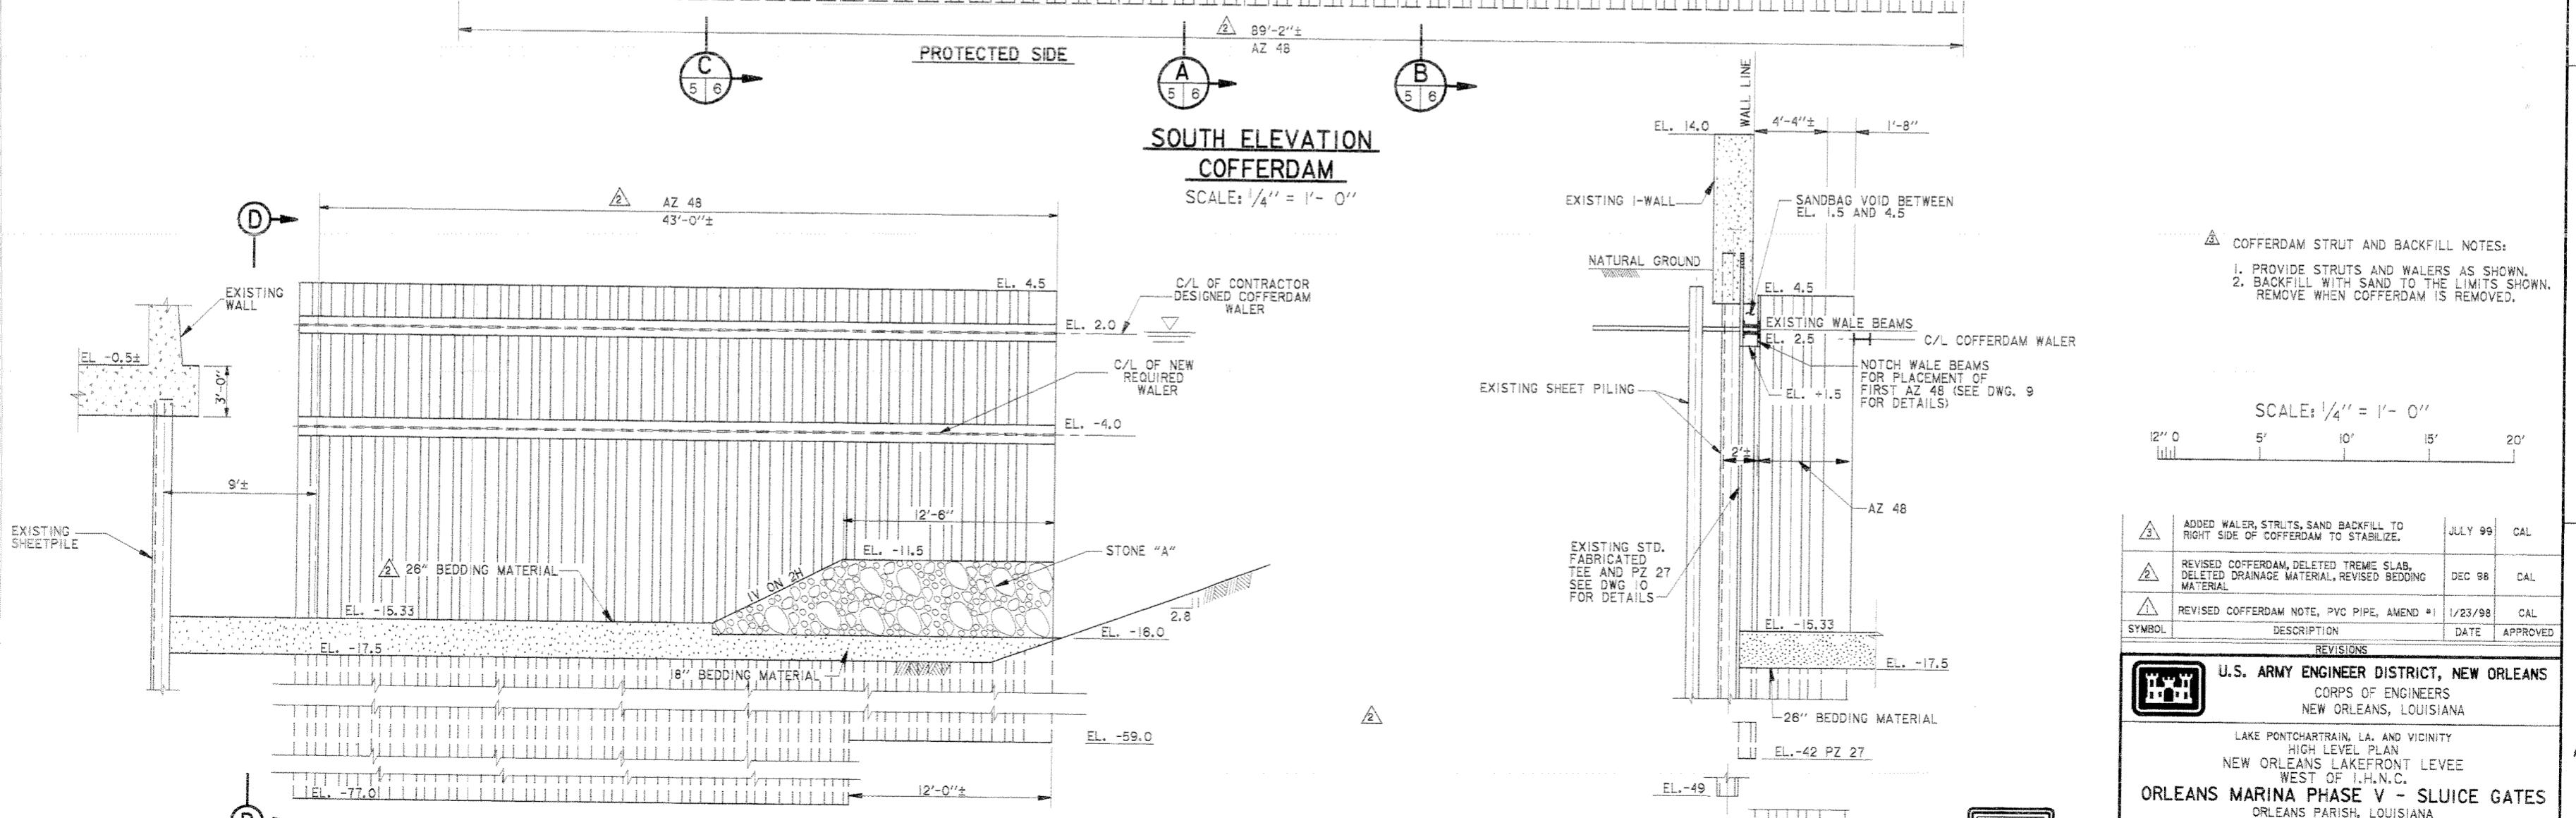

EAST ELEVATION COFFERDAM

SCALE: $\frac{1}{4}'' = 1'-0''$


SECTION D

SECTION D




SYMBOL	DESCRIPTION	DATE	APPROVED
	ADDED WALER, STRUTS, SAND BACKFILL TO RIGHT SIDE OF COFFERDAM TO STABILIZE.	JULY 99	CAL
	REVISED COFFERDAM, DELETED TREMIE SLAB, DELETED DRAINAGE MATERIAL, REVISED BEDDING MATERIAL	DEC 98	CAL
	REVISED COFFERDAM NOTE, PVC PIPE, AMEND #1	1/23/98	CAL
REVISIONS			
U.S. ARMY ENGINEER DISTRICT, NEW ORLEANS CORPS OF ENGINEERS NEW ORLEANS, LOUISIANA			
LAKE PONTCHARTRAIN, LA. AND VICINITY HIGH LEVEL PLAN NEW ORLEANS LAKEFRONT LEVEE WEST OF I.H.N.C. ORLEANS MARINA PHASE V - SLUICE GATES ORLEANS PARISH, LOUISIANA			
COFFERDAM SECTIONS & BUTTERFLY GATES			
DESIGNED BY: C. LABORDE	DATE:	PLOT SCALE:	PLOT DATE:
DRAWN BY: C.BRANDSTETTER	NOV.97	48	DEC. 15, 1998
CHECKED BY: C. LABORDE			FILE NO.
SUBMITTED BY:			H-4-44778
CHARLES A. LABORDE, P.E.	SOLICITATION NO.	DACW29-98-B-0001	DWG. 5 OF 46

Safety is a Part of Your Contract

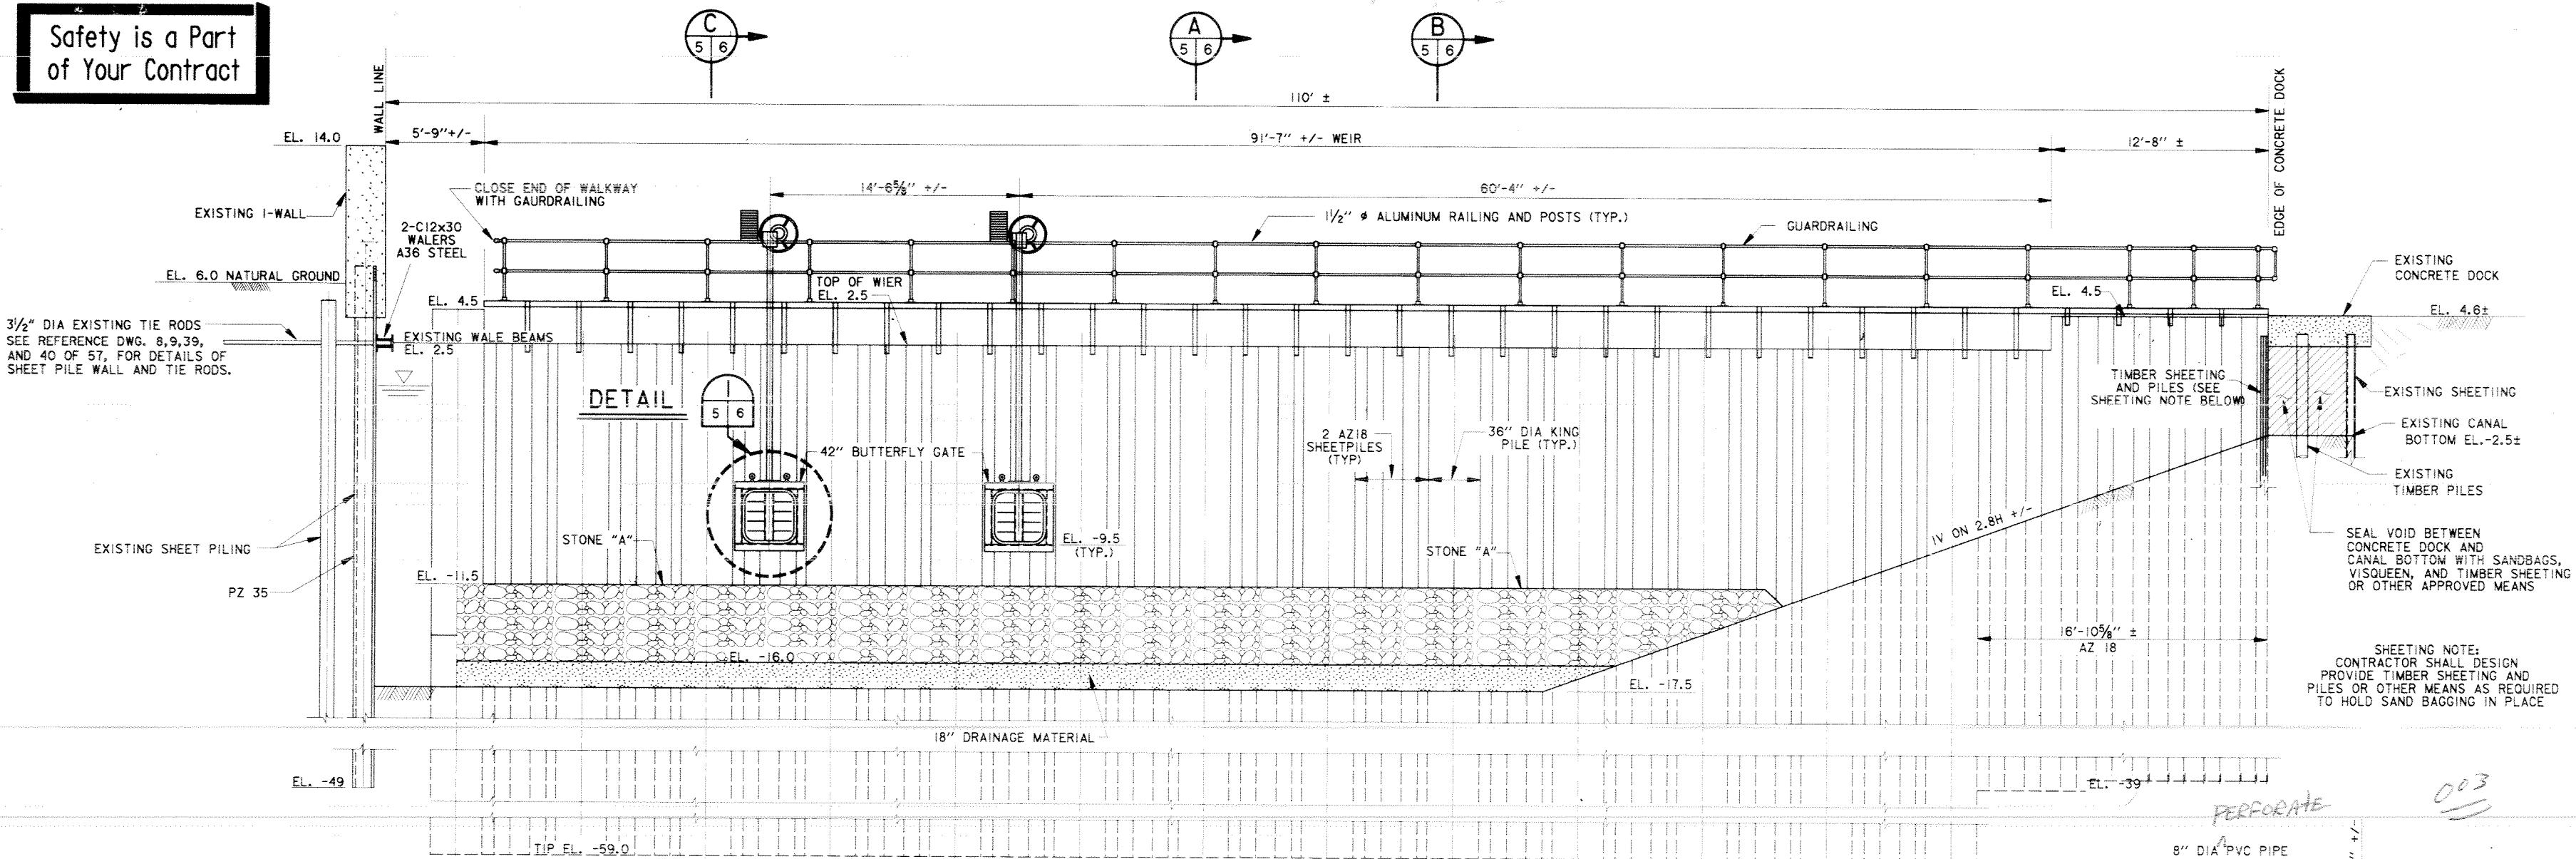

SOUTH ELEVATION
COFFERDAM

SCALE: $\frac{1}{4}'' = 1'-0''$

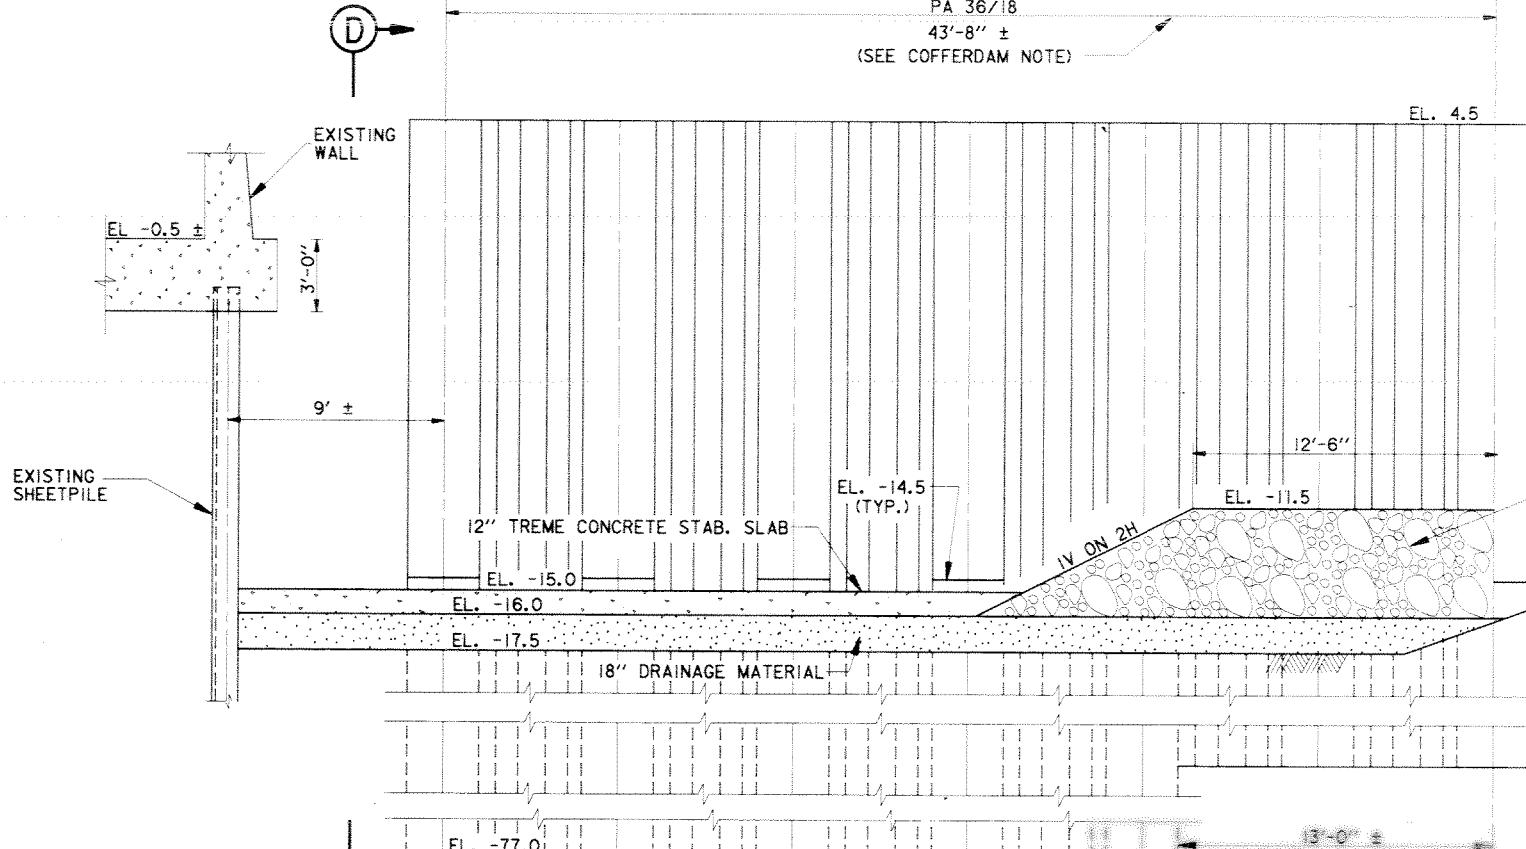

PROTECTED SIDE

EAST ELEVATION COFFERDAM

SCALE: $\frac{1}{4}'' = 1'-0''$

"REMOVE 36" DIA. KING PILES

OF EAST ELEVATION COFFERDAM ABOVE ELEV. -14.5. PORTION OF KING PILES

BELOW ELEV. -14.5 SHALL REMAIN. ALL INTERMEDIATE AZ 18 SHEETING SHAL

REMOVED. ALL 36" DIA. KING WITHIN THE 91'-7" +/- WEIR SECTION O

SCALE: $\frac{1}{4}'' = 1'-0''$



ORLEANS PARISH, LOUISIANA
**COFFERDAM SECTIONS &
BUTTERFLY GATES**

DESIGNED BY: C. LABORDE	DATE:	PLOT SCALE:	PLOT DATE:
DRAWN BY: C. BRANDSTETTER	NOV. 97	48	DEC. 15, 1997
CHECKED BY: C. LABORDE	CADD FILE: 44778c03.dgn		FILE NO.
SUBMITTED BY: CHARLES A. LABORDE, P.E. DESIGN ENGINEER	SOLICITATION NO. DACPW29-98-B-0001		H-4-44778
	DWG.	5	OF 46

DATE 12-1-99 SHEET NO. 1 OF 3

(F2)

EXISTING Copperdam Bracing

STRUT TO BE REMOVED

STRUT TO BE ADDED

* SEE SHEET 2

USE 8" skd steel pipe

STRUT TO BE ADDED

* SEE SHEET 2

FACE OF SLAB

≈ 2'-2"

VERTICAL I
BEAM w/
S PIPING

≈ 8'-0"

* SEE SHEET 3

PLAN VIEW

SOUTHWEST CORNER!
Tie-IN DESIGN
From Coats to
BE UTILIZED



P.O. Box 53268
NEW ORLEANS, LA 70163
(504) 821-2400
FAX 821-0714

ORLEANS MARINA SLICE GATE STRUCTURE
COFFERDAM BRACING MODIFICATIONS


DATE 12-1-99 SHEET NO. 2 OF 3

(KS)

COFFERDAM WALES

Add stiff plates, $\frac{1}{2}$ " thick.

ELEV. +2.00

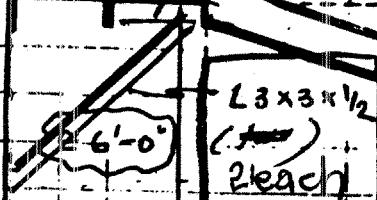

NORTH

STRUT TO BE DESIGNED

w/ Q LENGTH \approx 19'-0"

USE W24x146

ELEV. -4.00

$\leq 18'$ -0"

$\frac{1}{2}$ OF A 30° CAN
PL 1/2" min.

ELEV. -11.50

13'

ELEV. +15.00

NORTH COFFERDAM STRUT
ELEVATION

COFFERDAM SHEETING

BEARING PLATE

8'-3"

13" RADIUS

STRUT
(E @ ELEV. -4.00)

(TO BE DESIGNED)

$\frac{1}{2}$ OF A 30° CAN


NORTH


PIER TO WALL TIE-IN
PLAN VIEW



P.O. Box 53266
NEW ORLEANS, LA 70153
(504) 821-2400
FAX 821-0714


ORLEANS MARINA SERVICE GATE STRUCTURE
COFFERDAM BRACING MODIFICATIONS
DATE 12-1-99 SHEET NO. 3 OF 3
(KS)

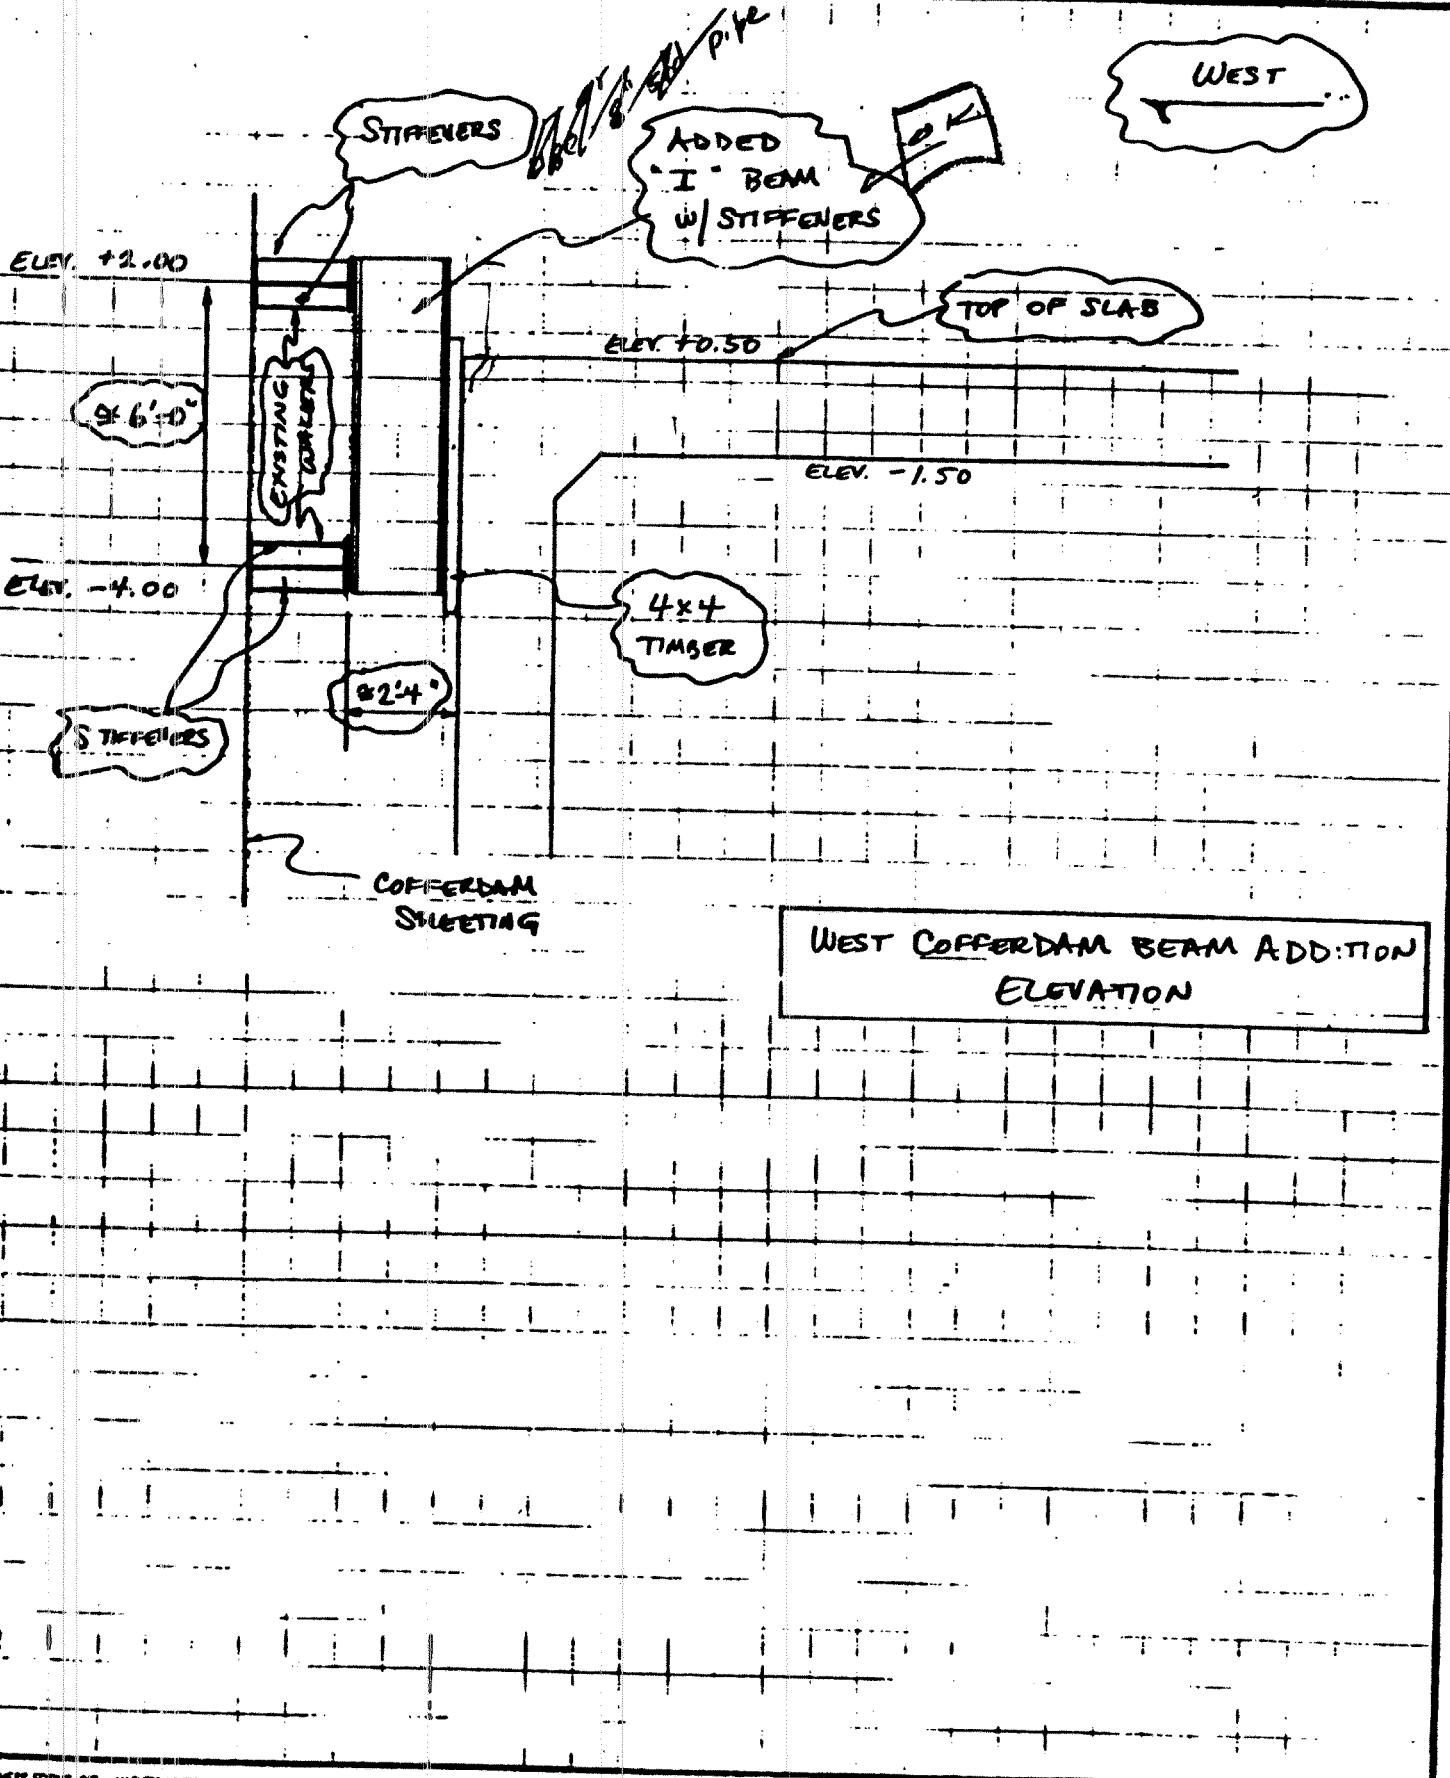

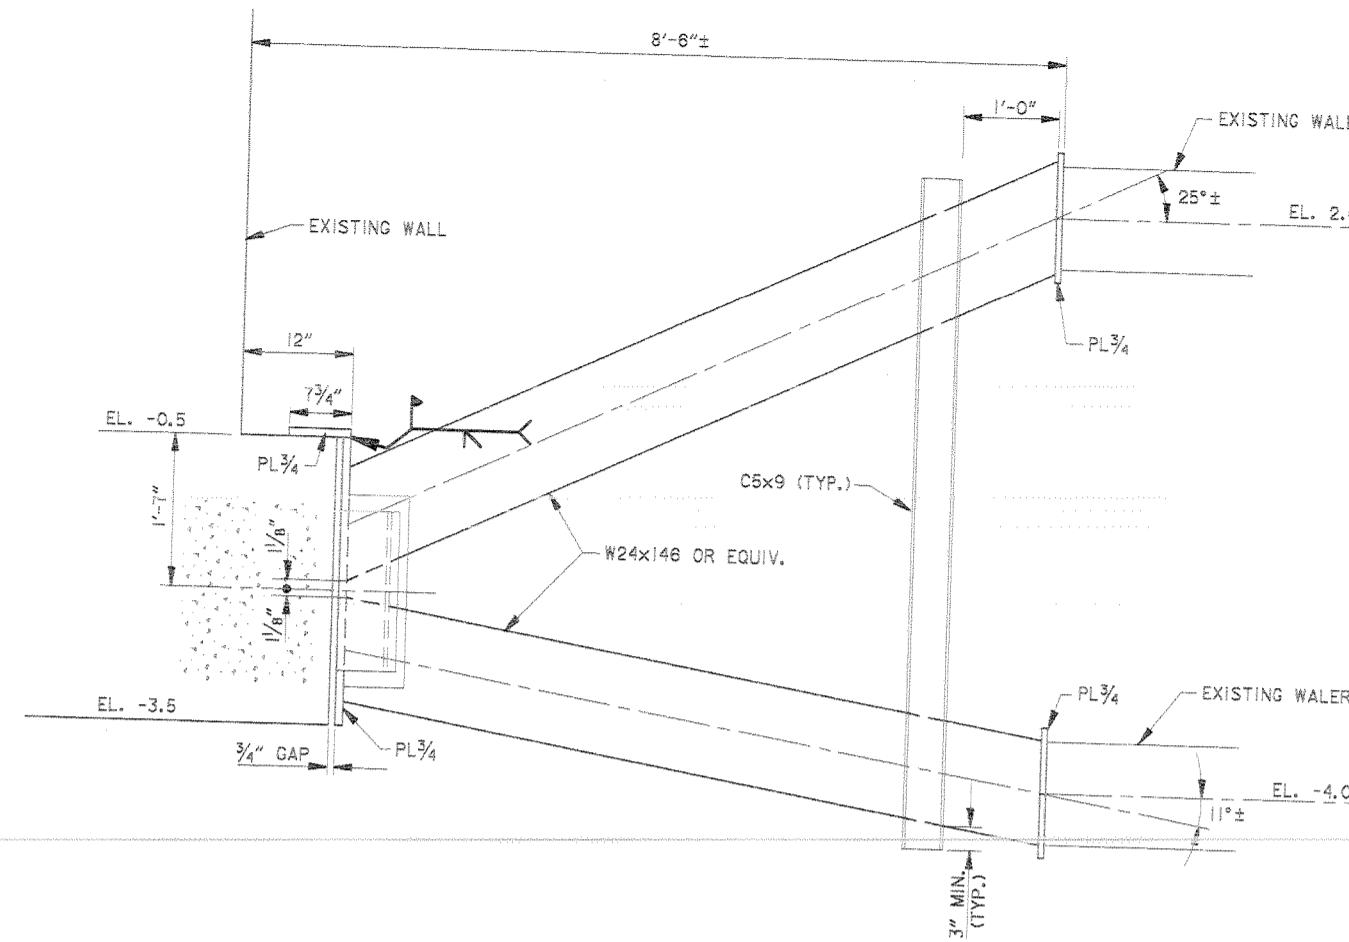

ELEVATION VIEW


SCALE: 1'' = 1'- 0''

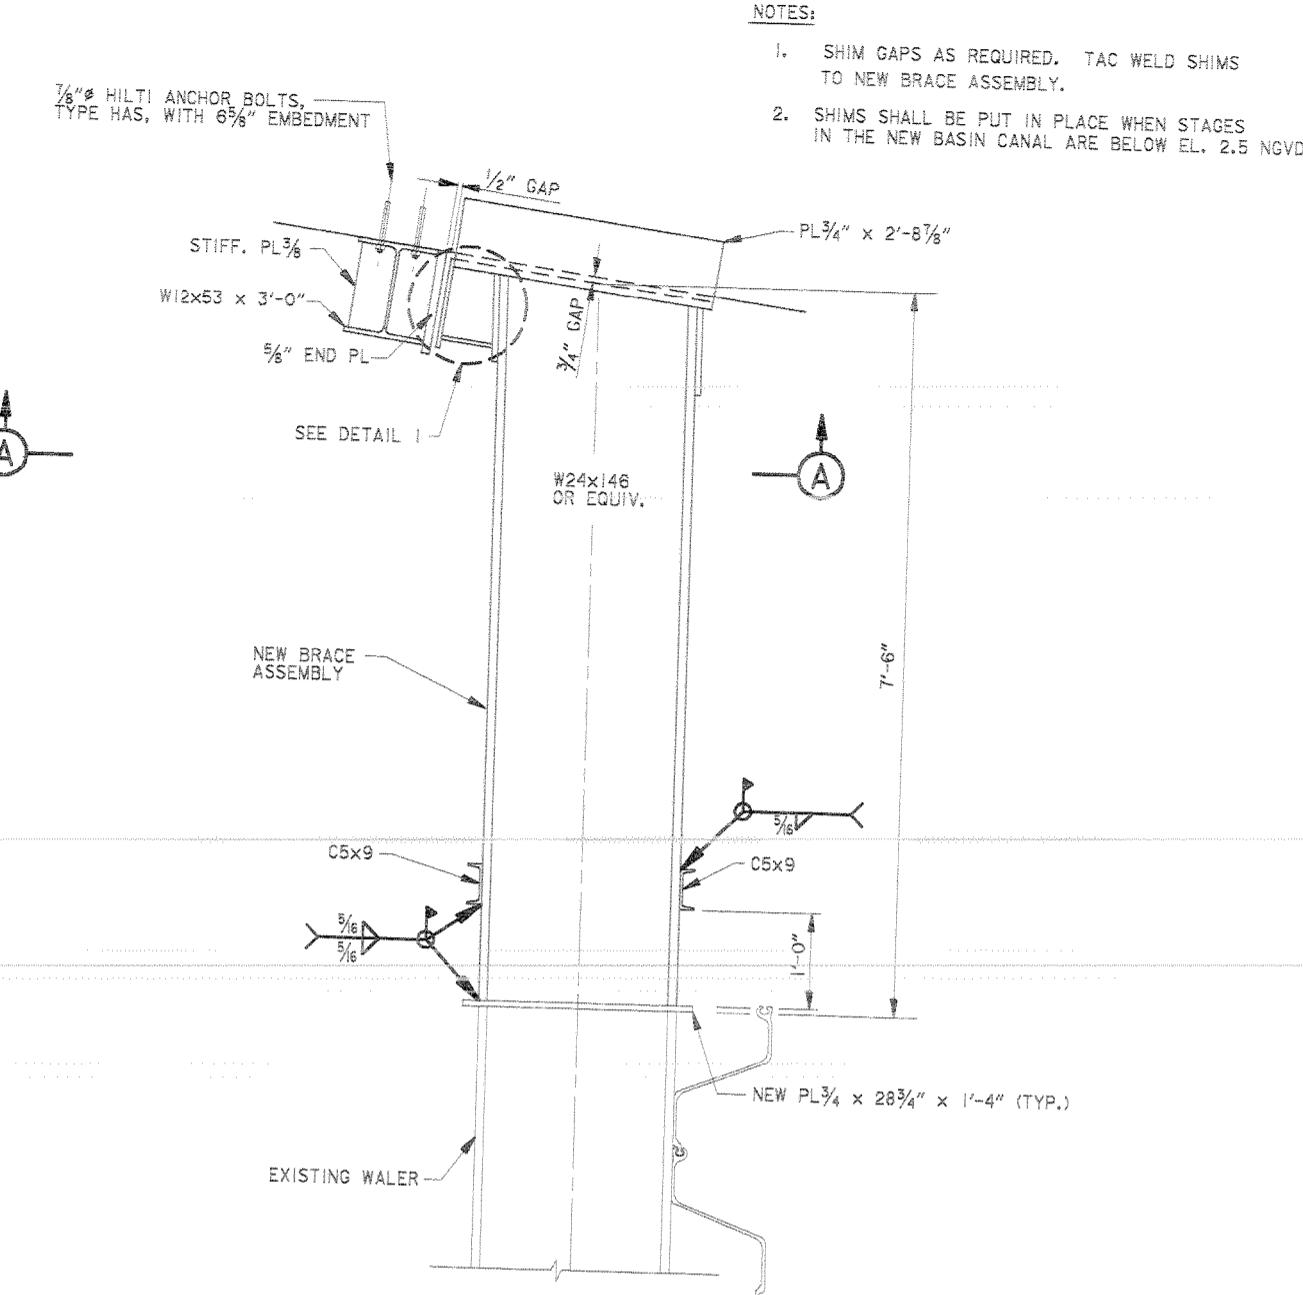

PLAN VIEW


SCALE: 1'' = 1'- 0''

NOTE: ALL STEEL SHALL BE ASTM A36

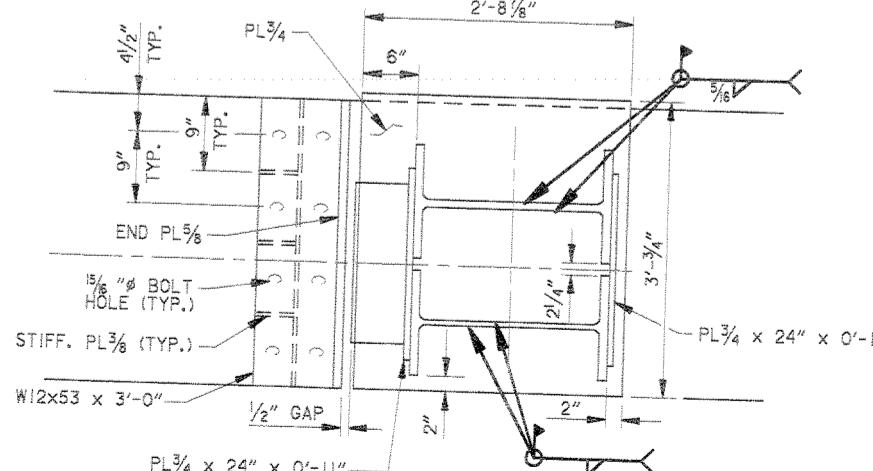


SECTION A

SCALE: 1'' = 1'- 0''

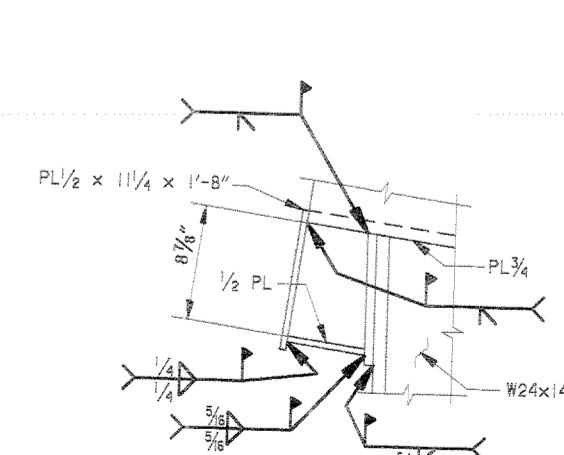

DETAIL 1

SCALE: 1 1/2'' = 1'- 0''

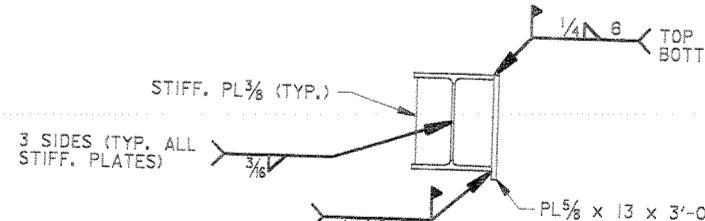

W12x53 DETAIL




SCALE: 1'' = 1'- 0''

SCALE: 1 1/2'' = 1'- 0''

SCALE: 1'' = 1'- 0''

SYMBOL	DESCRIPTION	DATE	APPROVED
	U.S. ARMY ENGINEER DISTRICT, NEW ORLEANS CORPS OF ENGINEERS NEW ORLEANS, LOUISIANA		
	LAKE PONTCHARTRAIN, LA. AND VICINITY HIGH LEVEL PLAN NEW ORLEANS LAKEFRONT LEVEE WEST OF I.H.N.C.		
	ORLEANS MARINA PHASE V - SLUICE GATES ORLEANS PARISH, LOUISIANA		
	TEMPORARY COFFERDAM BRACE ASSEMBLY		
DESIGNED BY: C.WAUGAMAN	DATE: OCT. 99	PLOT SCALE: 12	PLOT DATE: NOV. 1, 1999
DRAWN BY: C.WAUGAMAN			FILE NO. H-4-44778
CHECKED BY: C. LABORDE			CADD FILE: TEMPBRAC.DGN
SUBMITTED BY: CHARLES A. LABORDE, P.E. DESIGN ENGINEER			SOLICITATION NO. DACW29-98-B-0001
			DWG. 5A OF 46


Safety is a Part of Your Contract

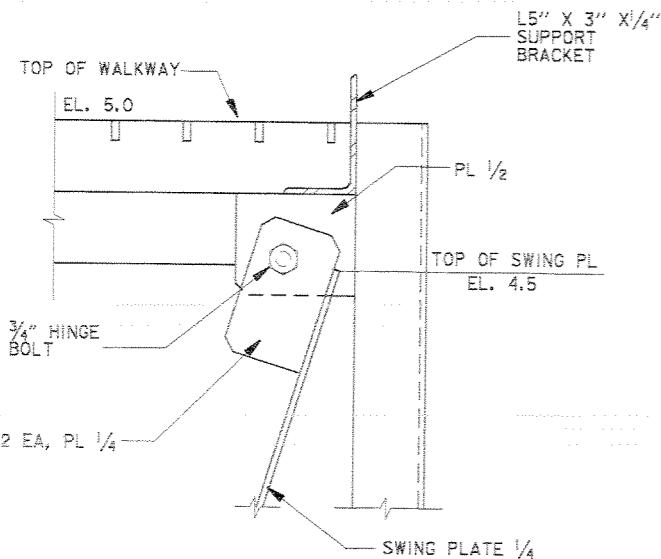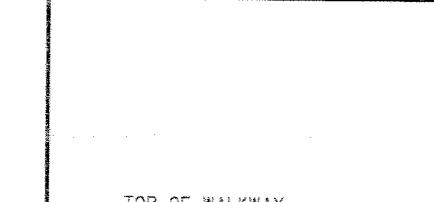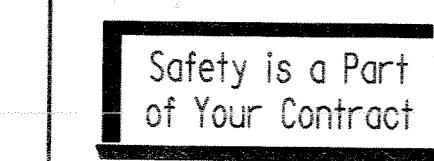

DETAIL 2


DETAIL 3 SIMILAR

SCALE: 3" = 1' - 0"

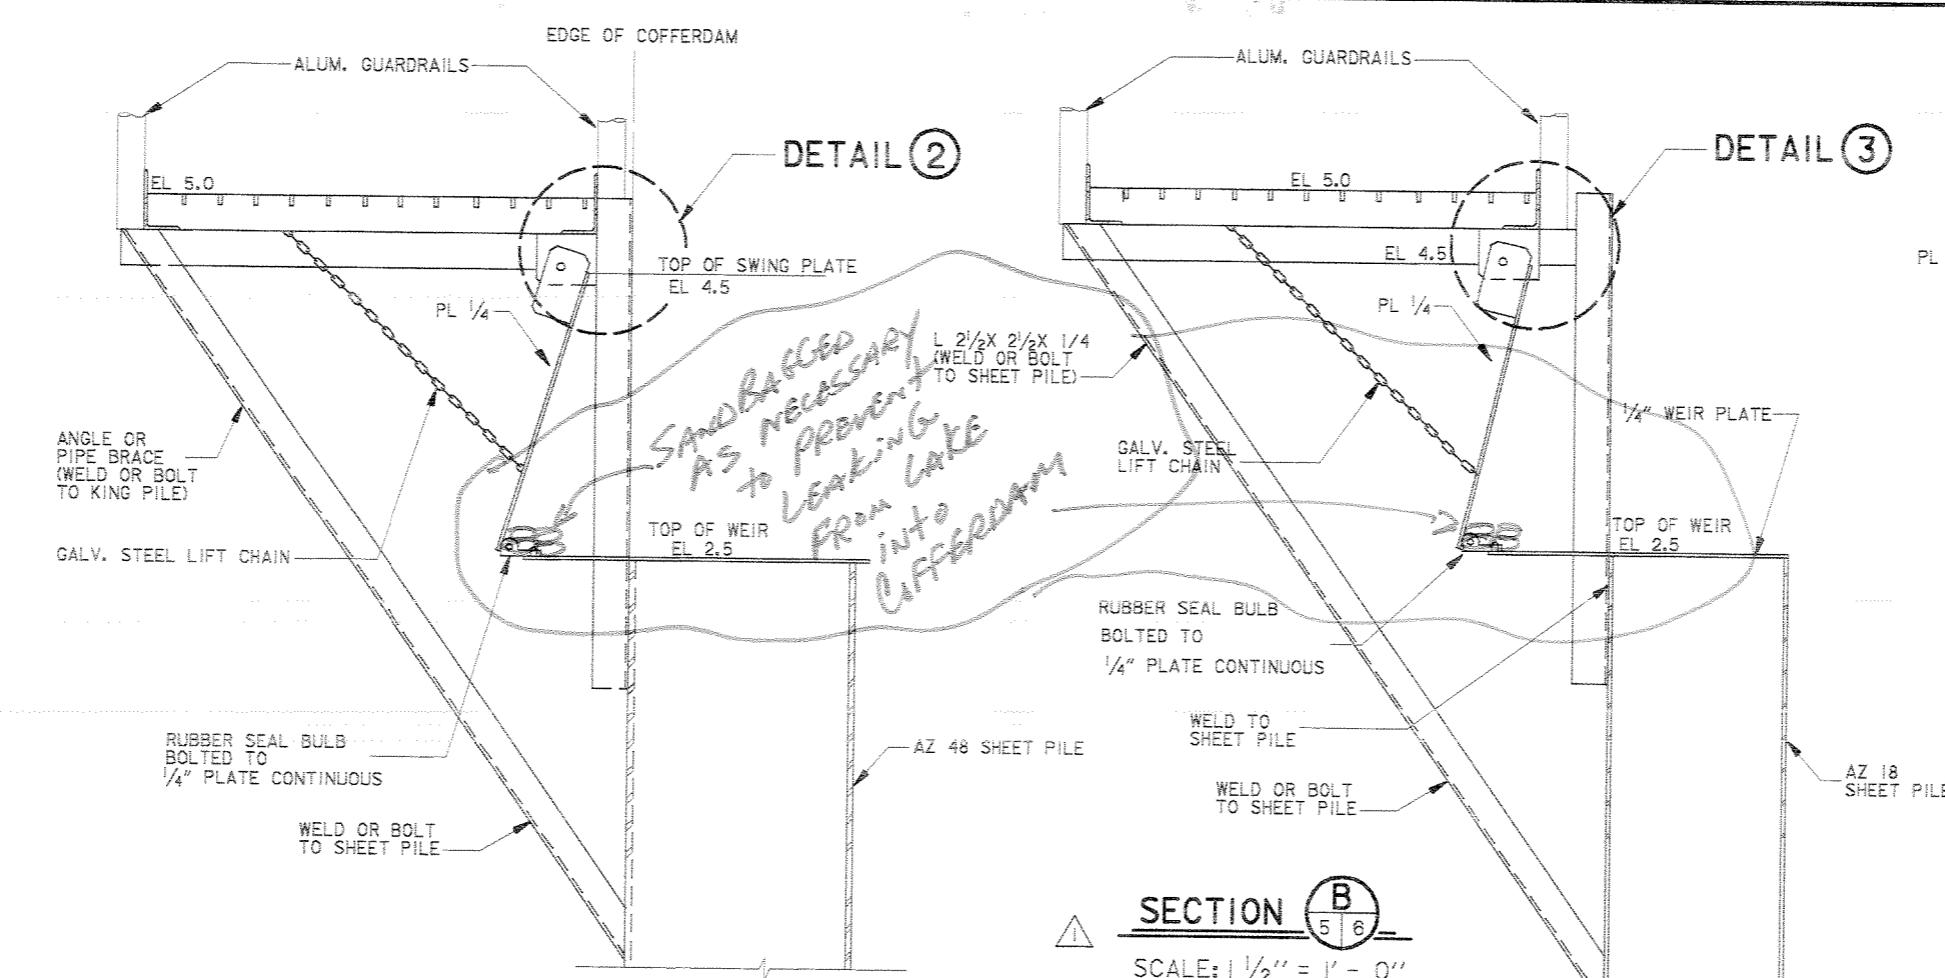


SECTION B
5 6

SCALE: $\frac{1}{2}'' = 1' - 0$

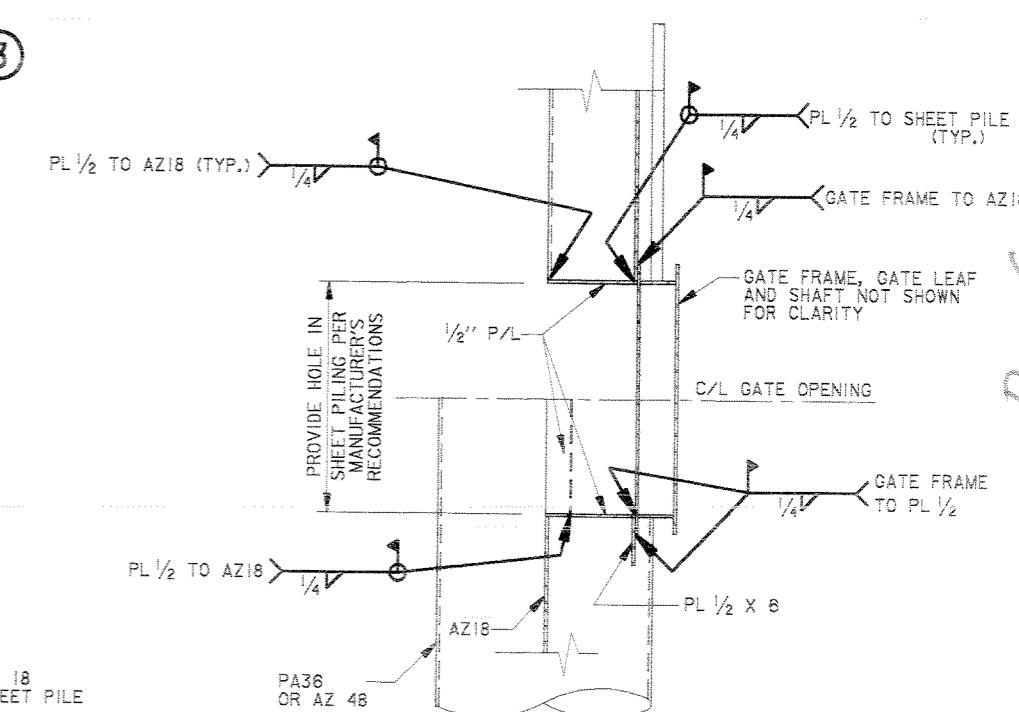

SECTION D


SCALE: $\frac{3}{4}'' = 1'-0''$

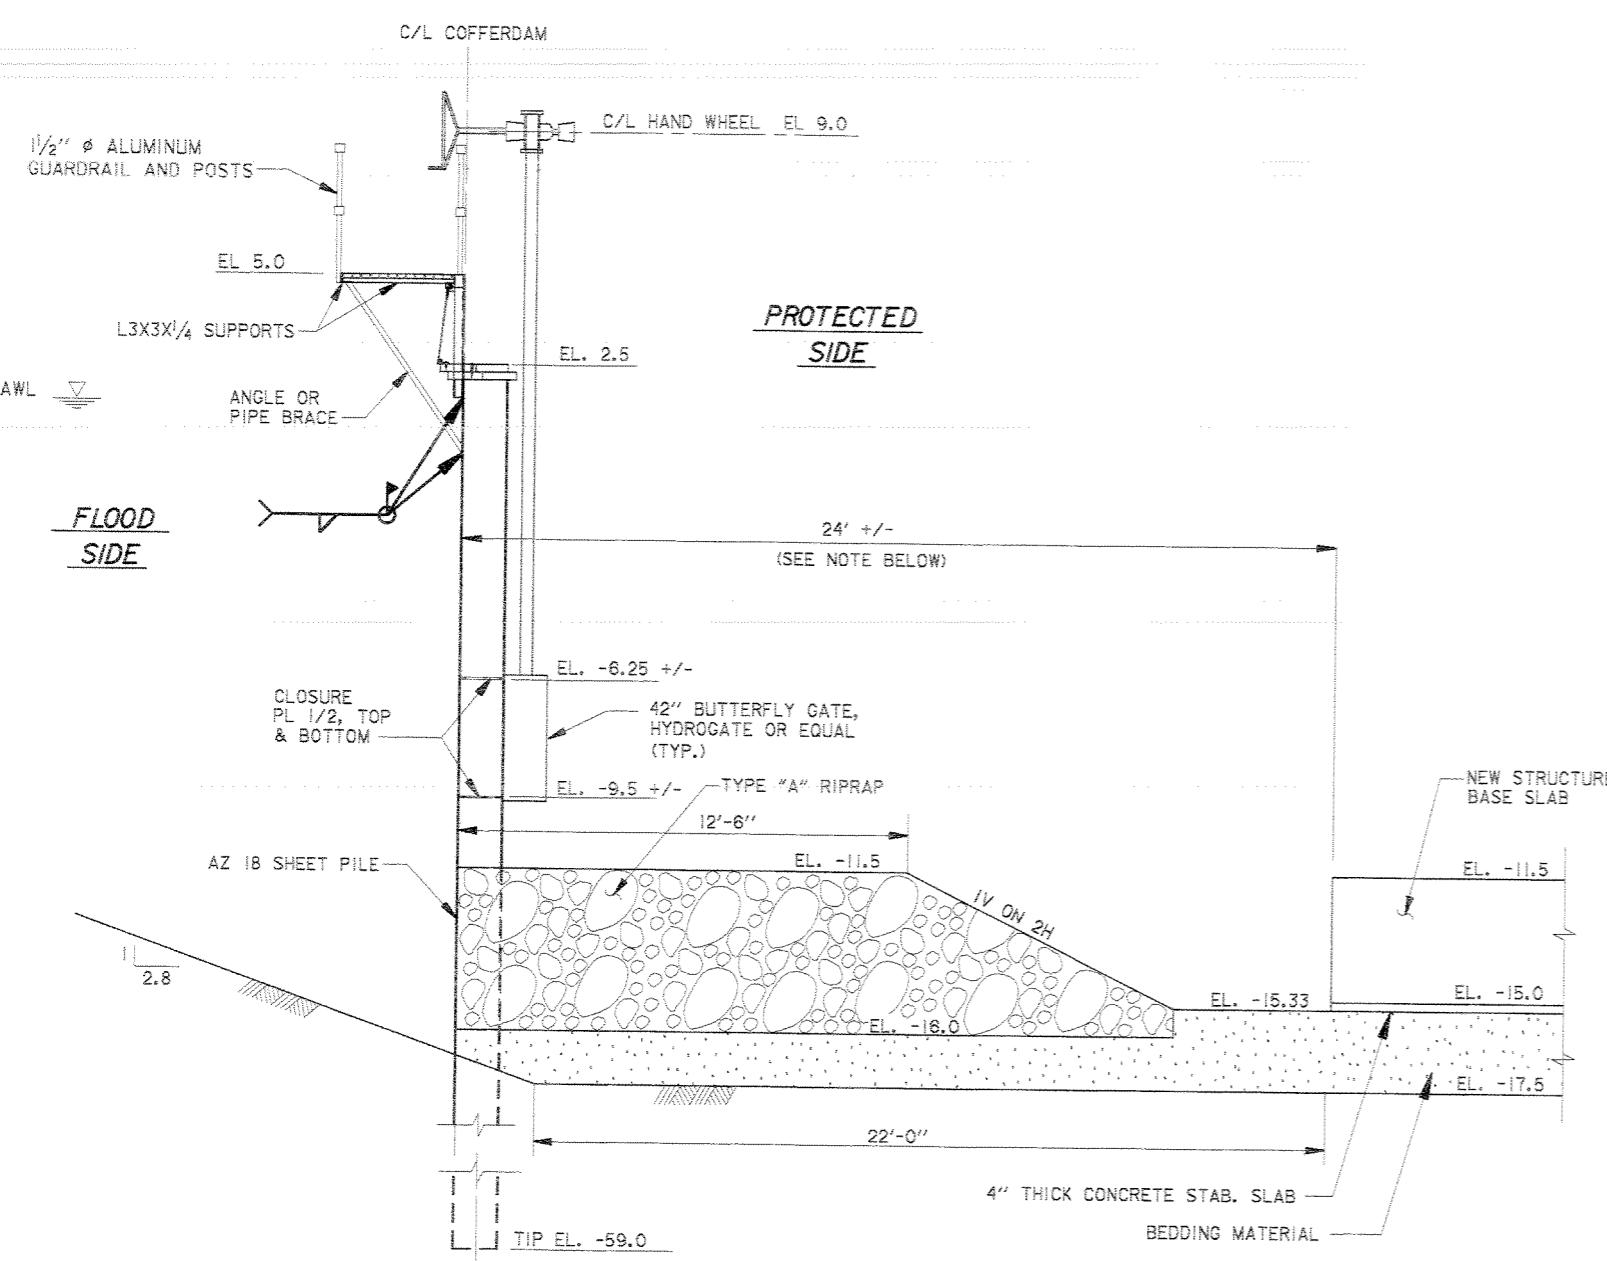

SECTION C


SCALE: $\frac{3}{8}'' = 1' - 0''$

NOTE: DISTANCE WILL VARY AND IS
DEPENDENT UPON EXACT LOCATION
OF SHEETPILE TIE IN AT THE EXISTING
WALL AT STATION 405+56 W/L +/-

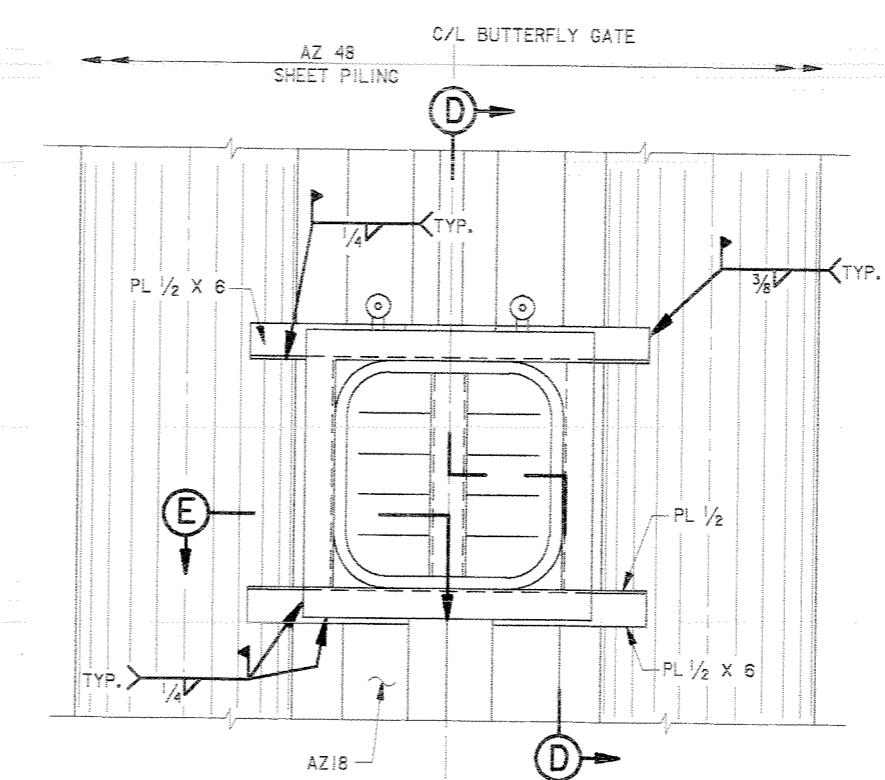



DETAIL

SCALE: $\frac{3}{4}'' = 1'-0''$

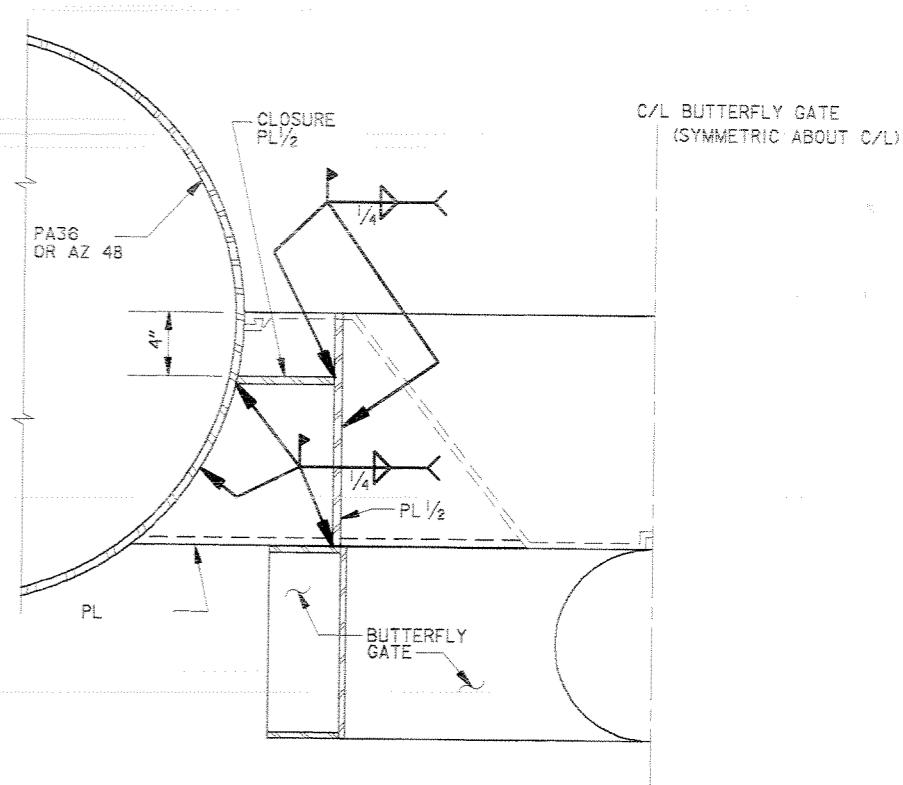


SECTION E

SCALE: $\frac{1}{3}'' = 1'-0''$

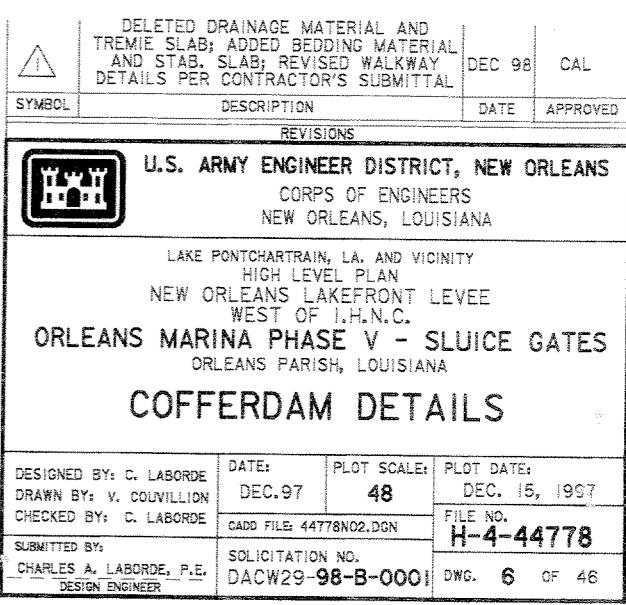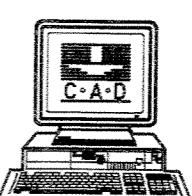


Safety is a Part of Your Contract

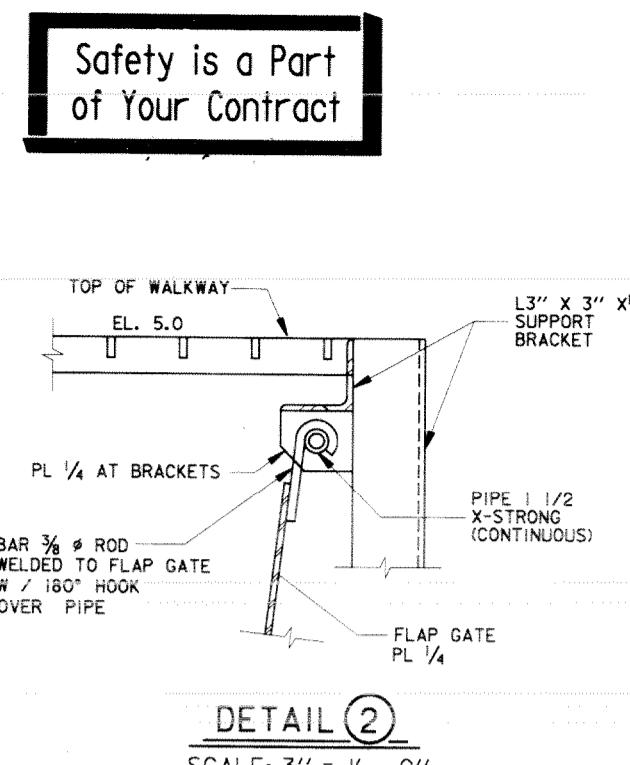


DETAIL 2


SCALE: 3'' = 1' - 0''

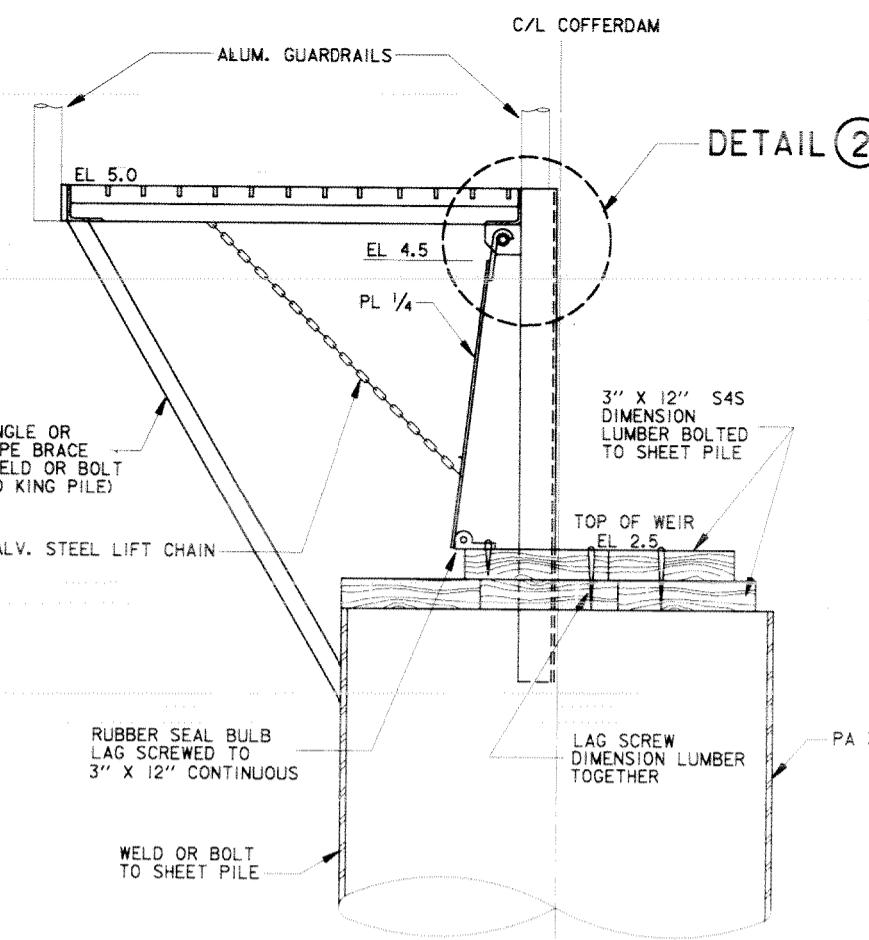

DETAIL

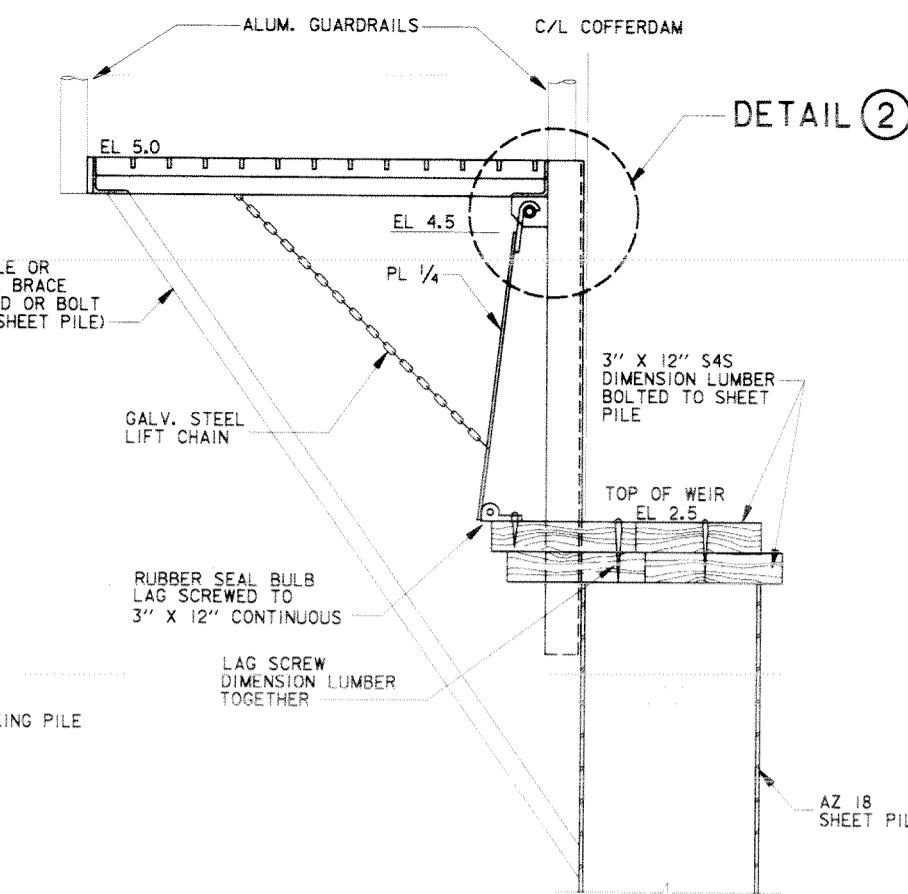


— DETAIL 2

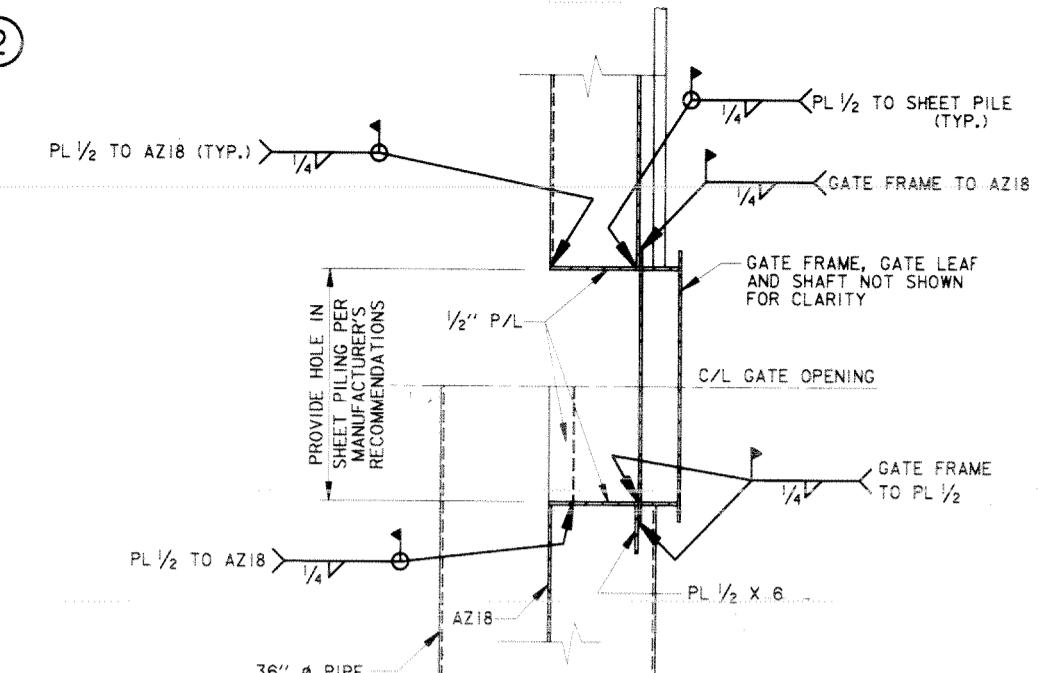


SECTION D

SCALE: $\frac{3}{4}'' = 1'-0''$

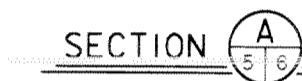


SCALE: $1 \frac{1}{2}'' = 1' - 0$

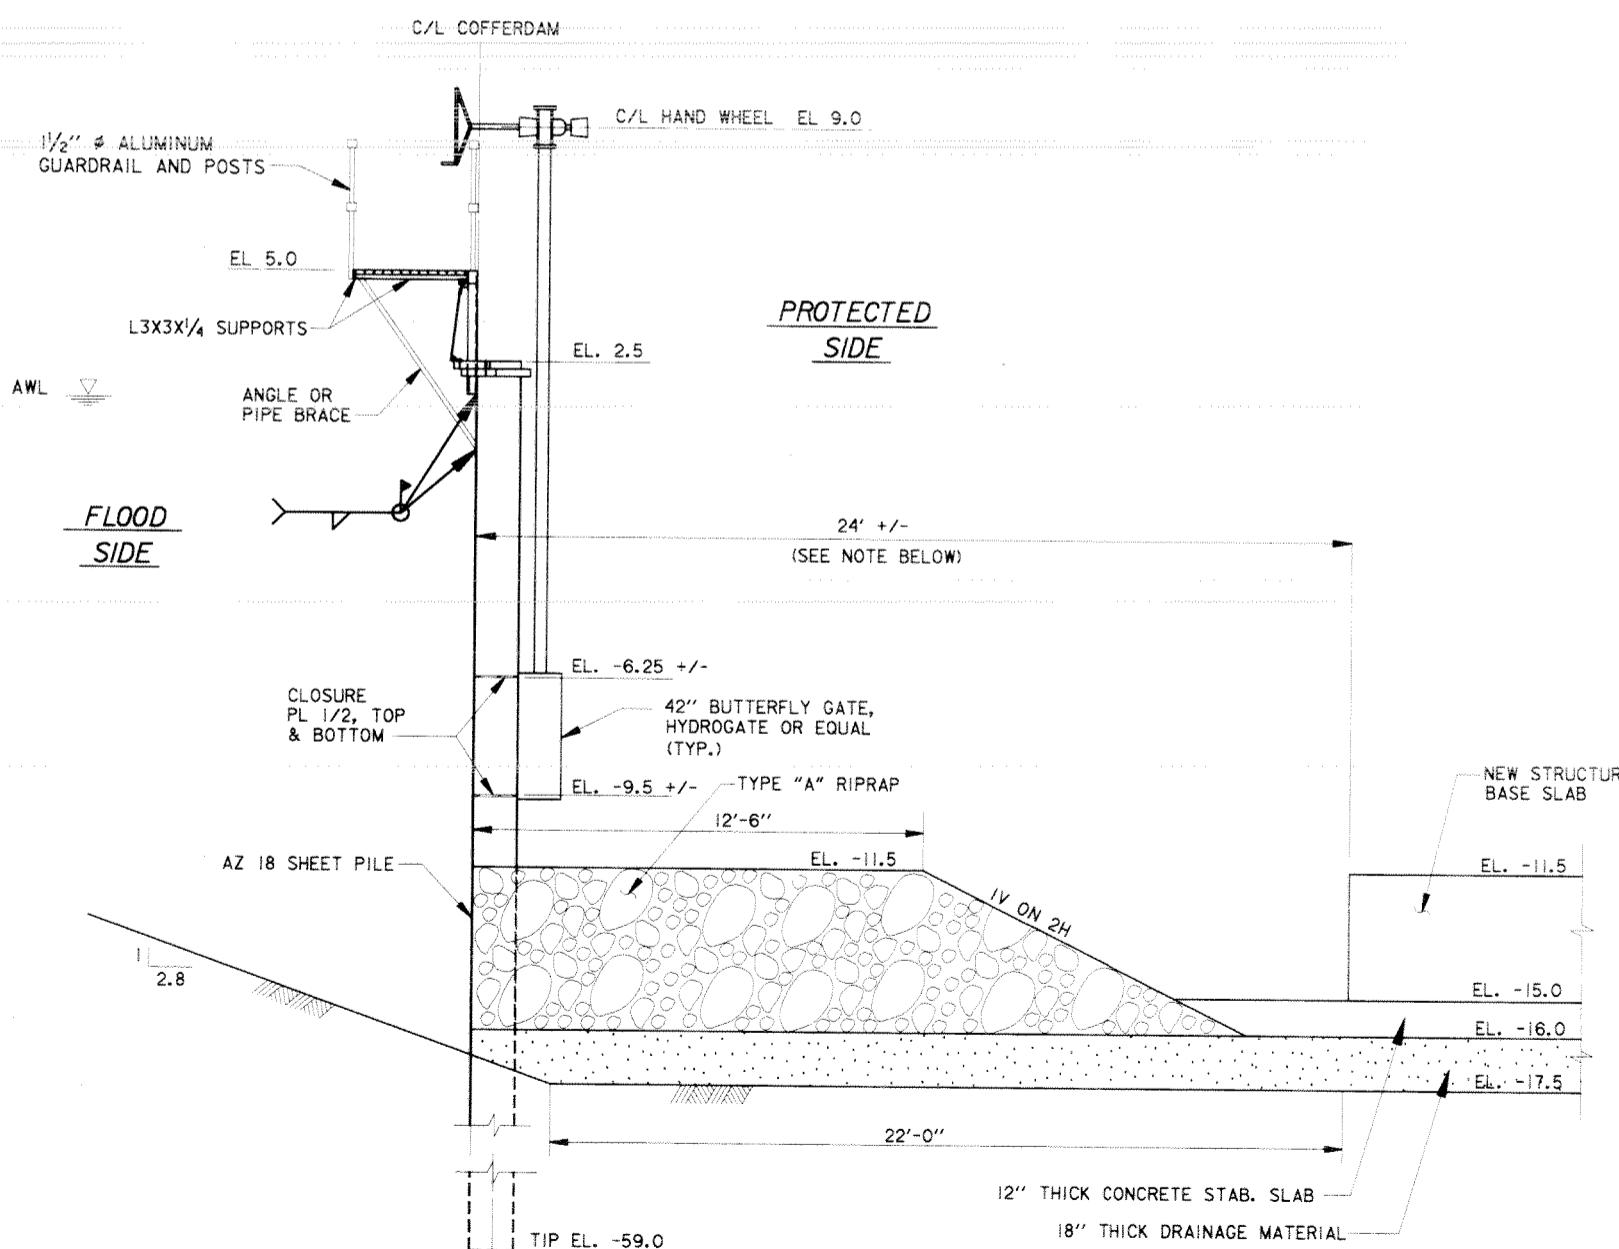

SECTION C
5 6
SCALE 3/4" = 1'-0"


SCALE: $\frac{1}{8}'' = 1' - 0''$

NOTE: DISTANCE WILL VARY AND IS
DEPENDENT UPON EXACT LOCATION
OF SHEETPILE TIE IN AT THE EXISTING
WALL AT STATION 405+56 W/L +/-

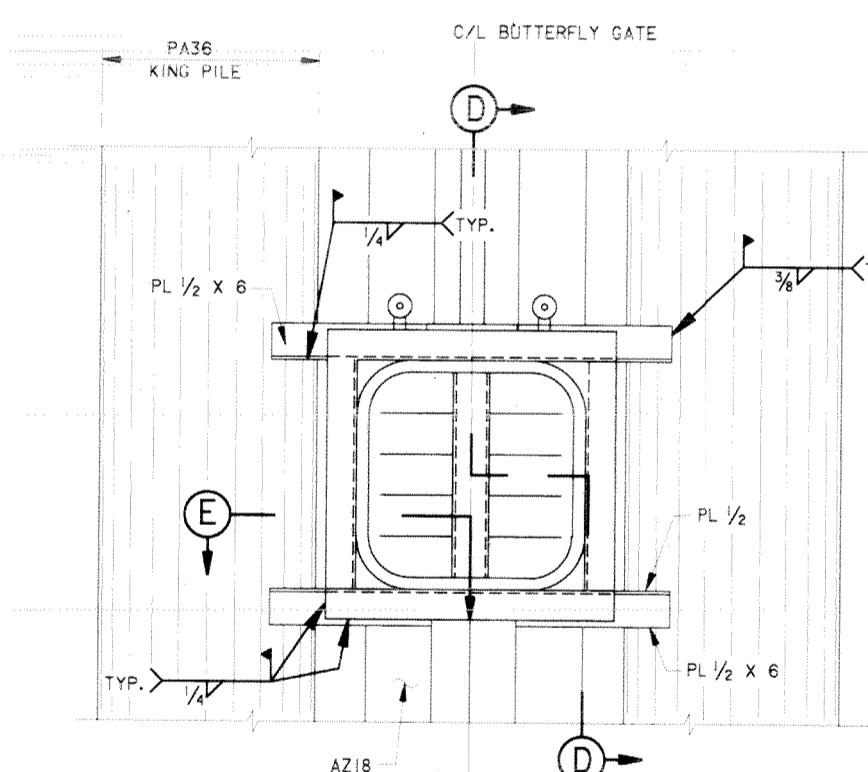


DETAIL



SCALE: $\frac{3}{4}'' = 1'$

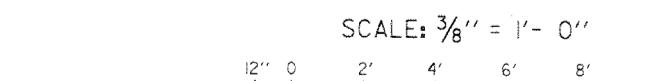

SCALE: 3/4" = 1'

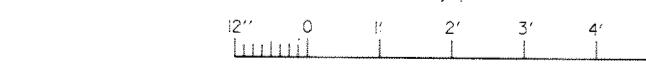


SCALE: $1 \frac{1}{2}'' = 1'$

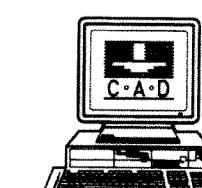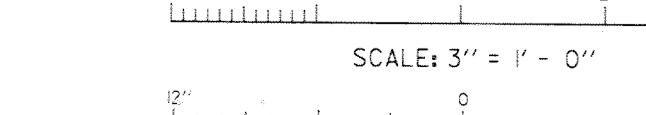


SYMBOL	DESCRIPTION	DATE	APPROVED
	REVISIONS U.S. ARMY ENGINEER DISTRICT, NEW ORLEANS CORPS OF ENGINEERS NEW ORLEANS, LOUISIANA		
LAKE PONTCHARTRAIN, LA. AND VICINITY HIGH LEVEL PLAN NEW ORLEANS LAKEFRONT LEVEE WEST OF I.H.N.C. ORLEANS MARINA PHASE V - SLUICE GATES ORLEANS PARISH, LOUISIANA			
COFFERDAM DETAILS			
DESIGNED BY: C. LABORDE	DATE:	PLOT SCALE:	PLOT DATE:
DRAWN BY: V. COUVILLION	DEC. 97	48	DEC. 15, 1997
CHECKED BY: C. LABORDE	CADD FILE: 44778NO2.DGN		
SUBMITTED BY:	SOLICITATION NO.		
CHARLES A. LABORDE, P.E. DESIGN ENGINEER	DACPW29-98-B-0001		
	DWG. 6	OF 46	
	H-4-44778		

Safety is a Part of Your Contract

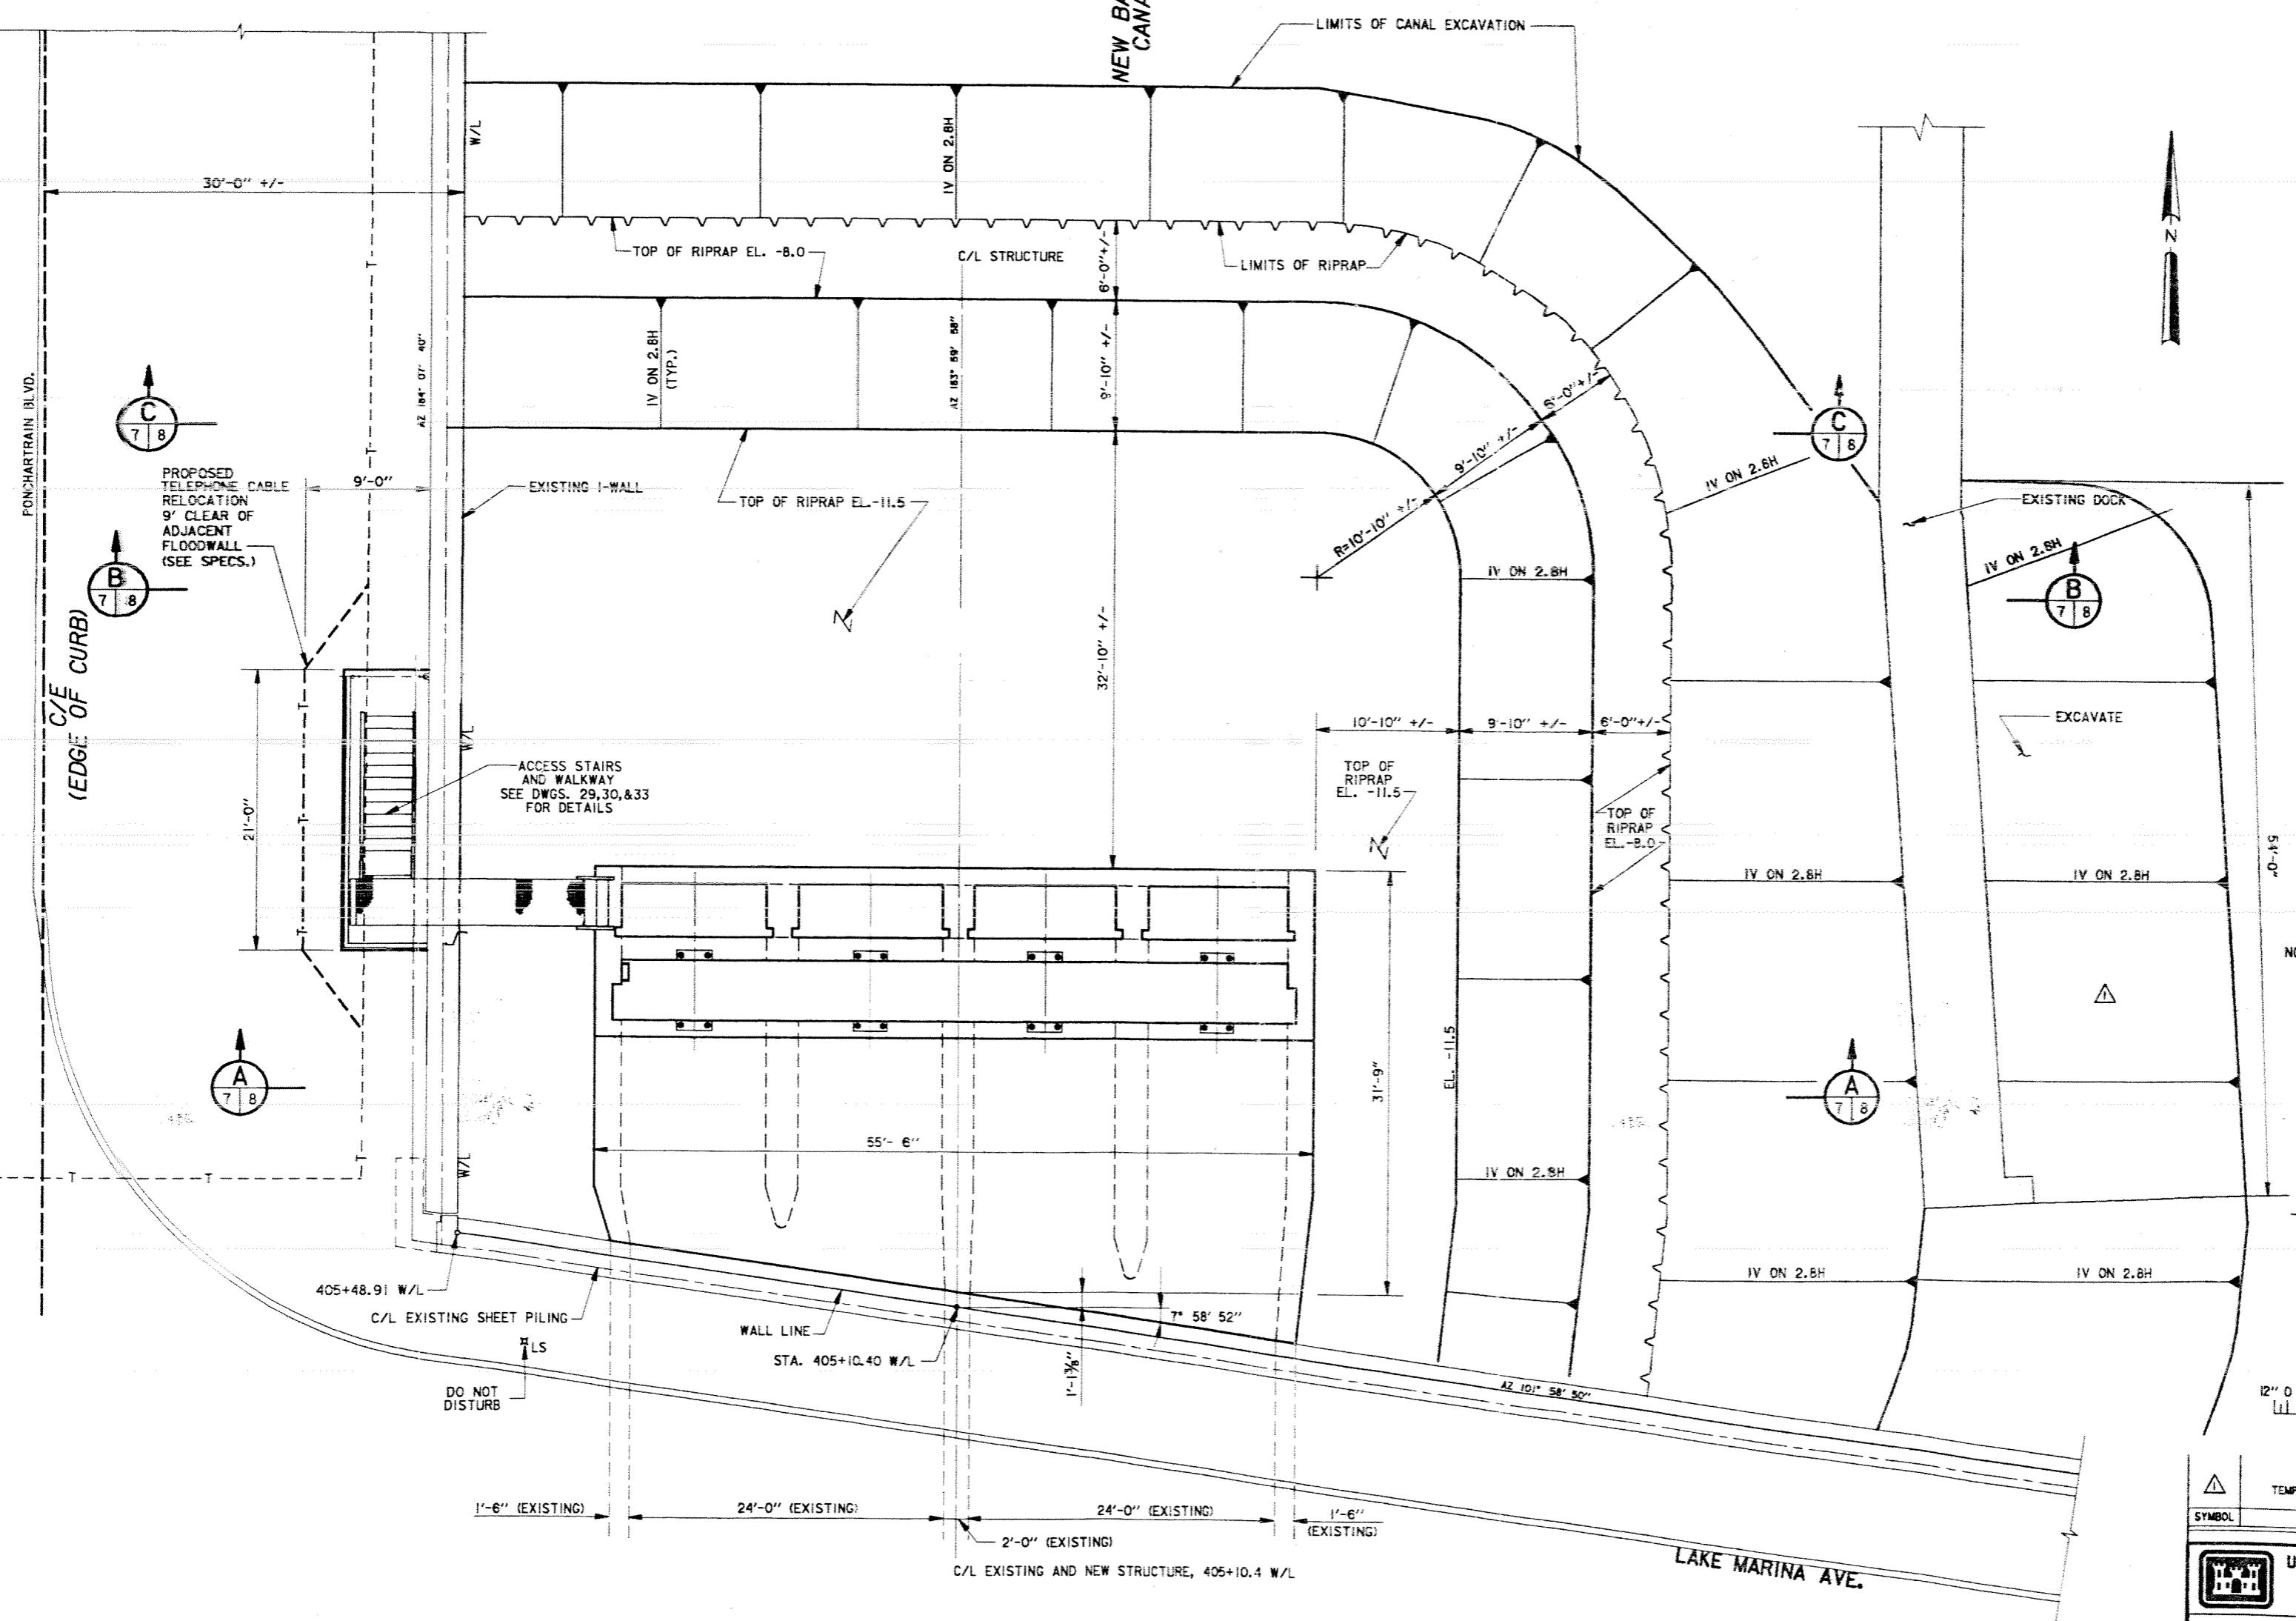

SLUICE GATE STRUCTURE
PLAN

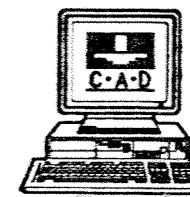


STRUCTURE PLAN

DESIGNED BY: C.LABORDE	DATE:	PLOT SCALE:	PLOT DATE:
DRAWN BY: C.WALGAMAN	NOV.97	64	NOV. 10, 1997
CHECKED BY: C.LABORDE	FILE NO.		
SUBMITTED BY: CHARLES A. LABORDE P.E. DESIGN ENGINEER	H-4-44778		
	SOLICITATION NO.	DWG. 7 OF 46	
	DACW29-98-B-0001		


Safety is a Part of Your Contract

SEE SPECS FOR REQUIRED
SURFACE PREPARATION
UPON REMOVAL OF SLAB
OBSTRUCTION.

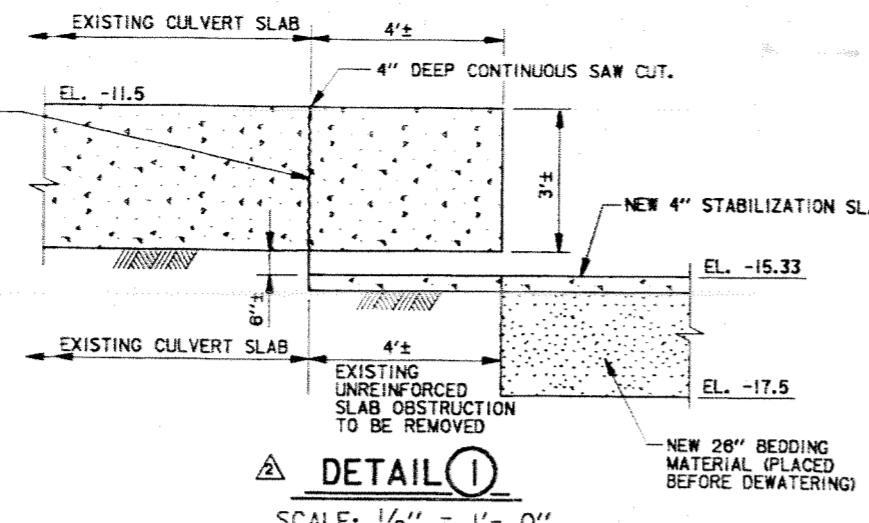


▲ DETAIL

SCALE: $\frac{1}{2}'' = 1'$



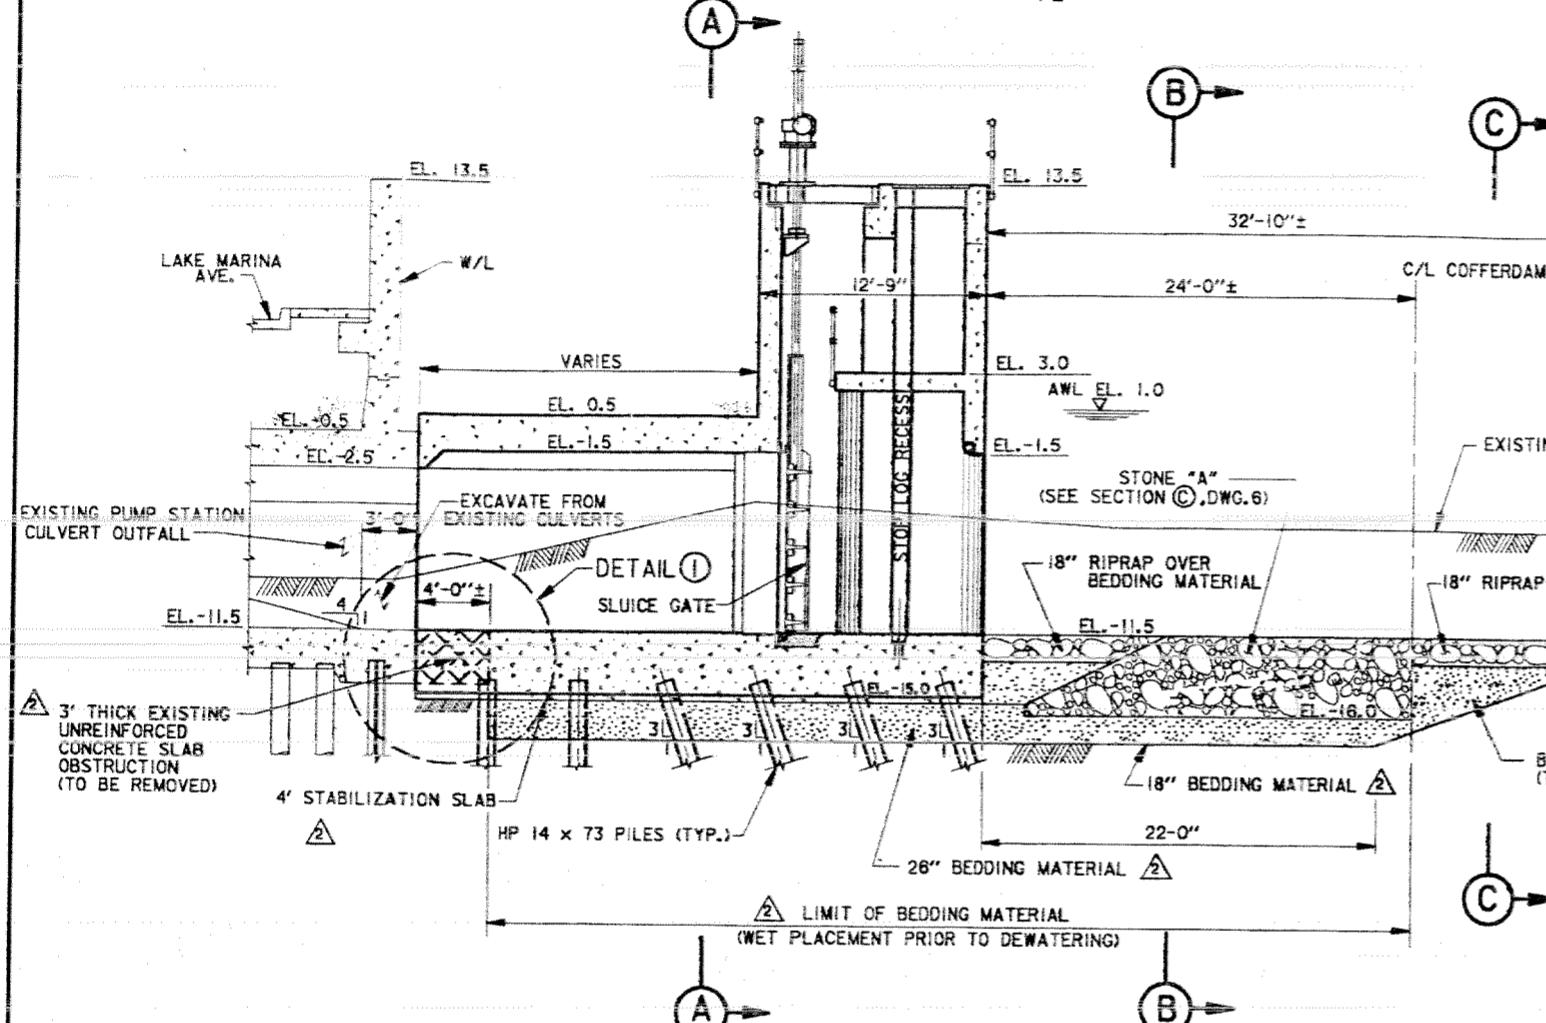


SECTION AT C/L OF STRUCTURE

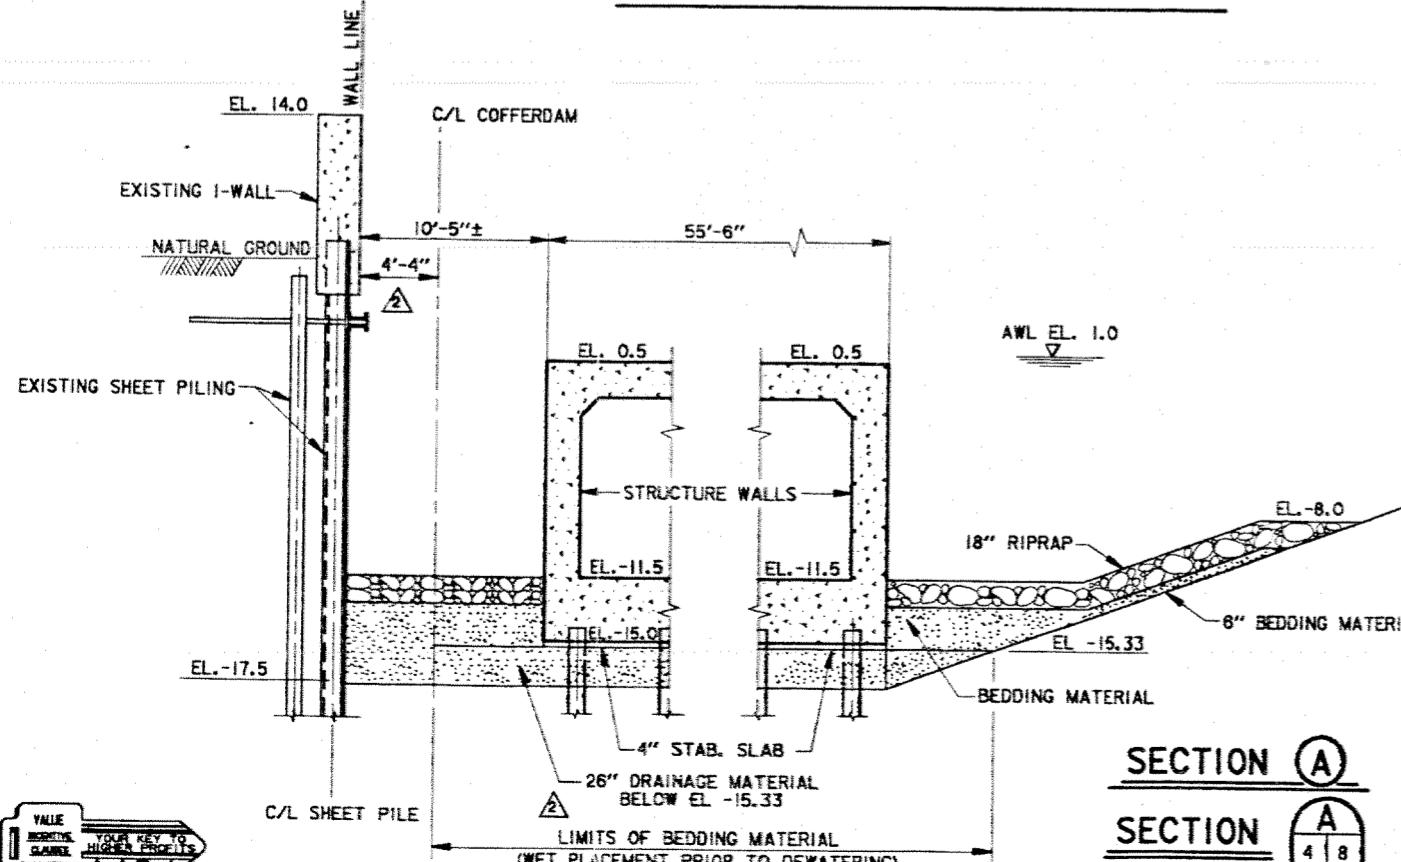

SECTION 6


SECTION

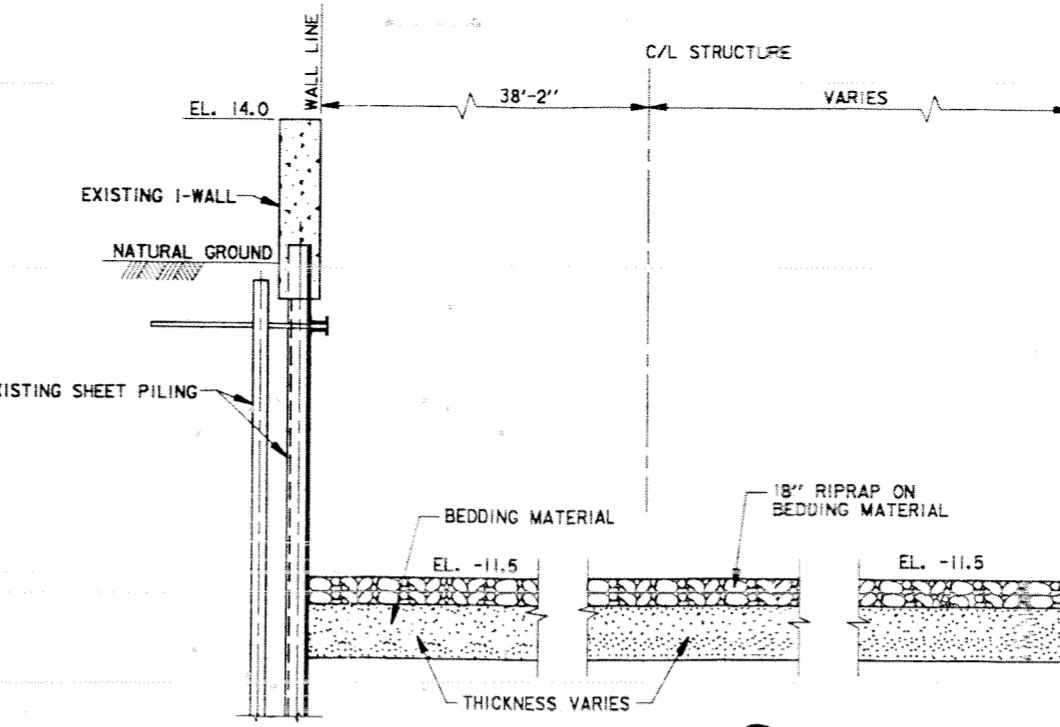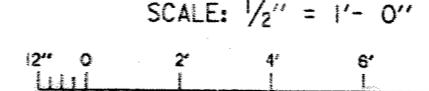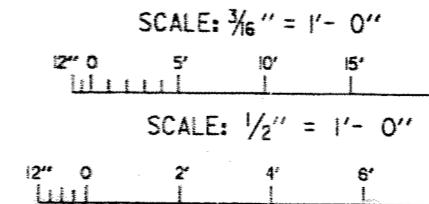


SECTION C

SECTION

4
7

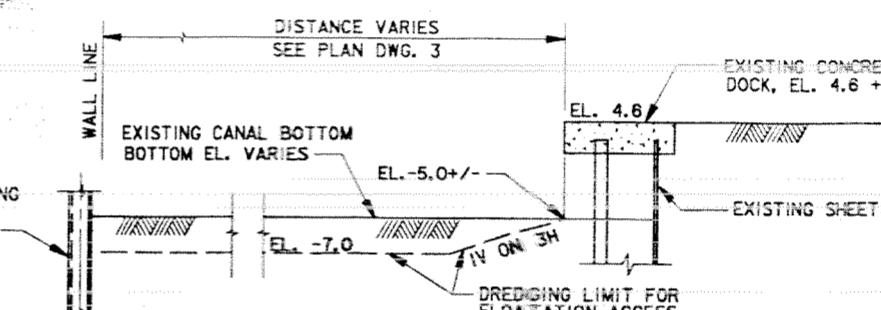

FLOATATION ACCESS DETAIL

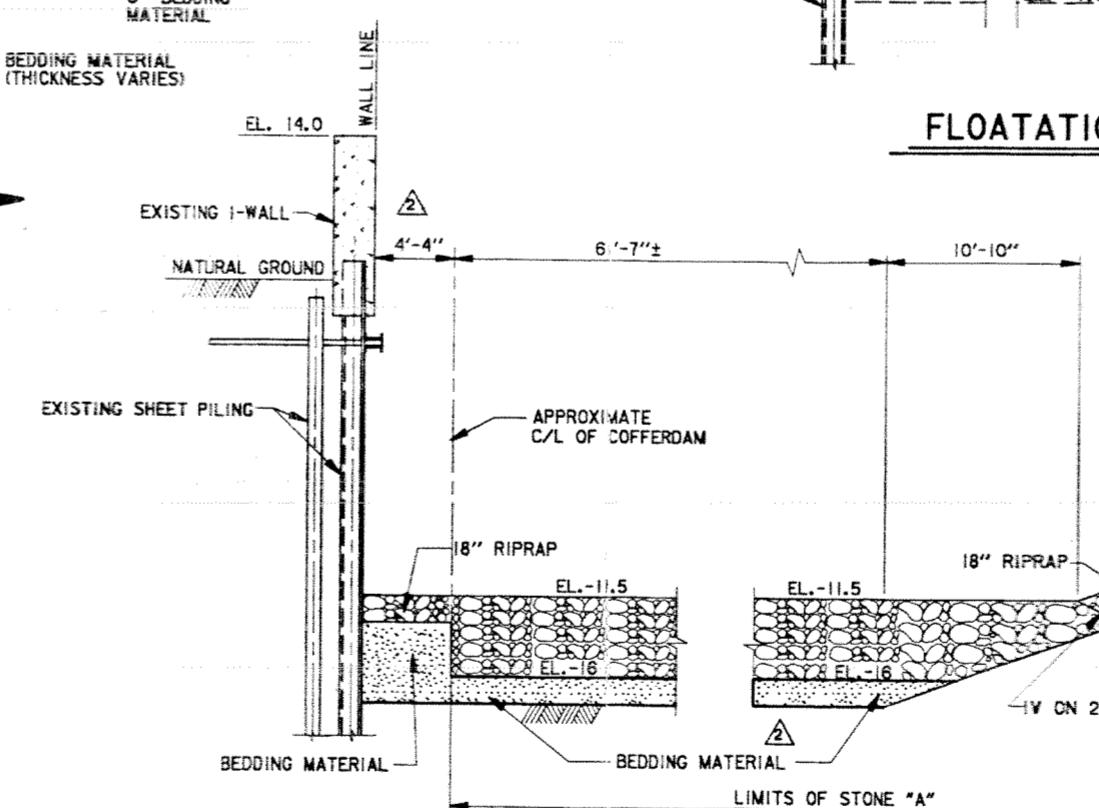

SECTION B

SECTION B

	TEMPORARY EXCAVATION AT BOAT DOCK	JUNE 99	CAL
	DELETED TREMIE SLAB, AND DRAINAGE MATERIAL, ADDED SLAB OBSTRUCTION REMOVAL, ADDED 4" STAB. SLAB., ADDED BEDDING MATERIAL BELOW STAB. SLAB.	DEC. 98	CAL
	REVISED DIMENSIONS IN SECTIONS A&B, AMEND #1	1/23/98	CAL



REVISIONS
S. ARMY ENGINEER DISTRICT, NEW ORLEANS
CORPS OF ENGINEERS
NEW ORLEANS, LOUISIANA

LAKE PONTCHARTRAIN, LA. AND VICINITY

HIGH LEVEL PLAN
NEW ORLEANS LAKEFRONT LEVEE

**WEST OF I.H.N.C.
MARINA PHASE V - SLUICE**


**MARINA PHASE V - SLICE GATES
ORLEANS PARISH, LOUISIANA**

LARGE AREA SECTIONS


DISCHARGE AREA SECTIONS

DESIGNED BY: CLABORDE	DATE: NOV.97	PLOT SCALE: 64	PLOT DATE: DEC. 15, 1998
DRAWN BY: JDARBY			FILE NO.
CHECKED BY: CLABORDE	CADD FILE: 4477BE07.DGN		H-4-44778
SUBMITTED BY:	SOLICITATION NO.		
CHARLES A. LABORDE, P.E. DESIGN ENGINEER	DACPW29-98-B-0001		DWG. 8 OF 46

Safety is a Part
of Your Contract

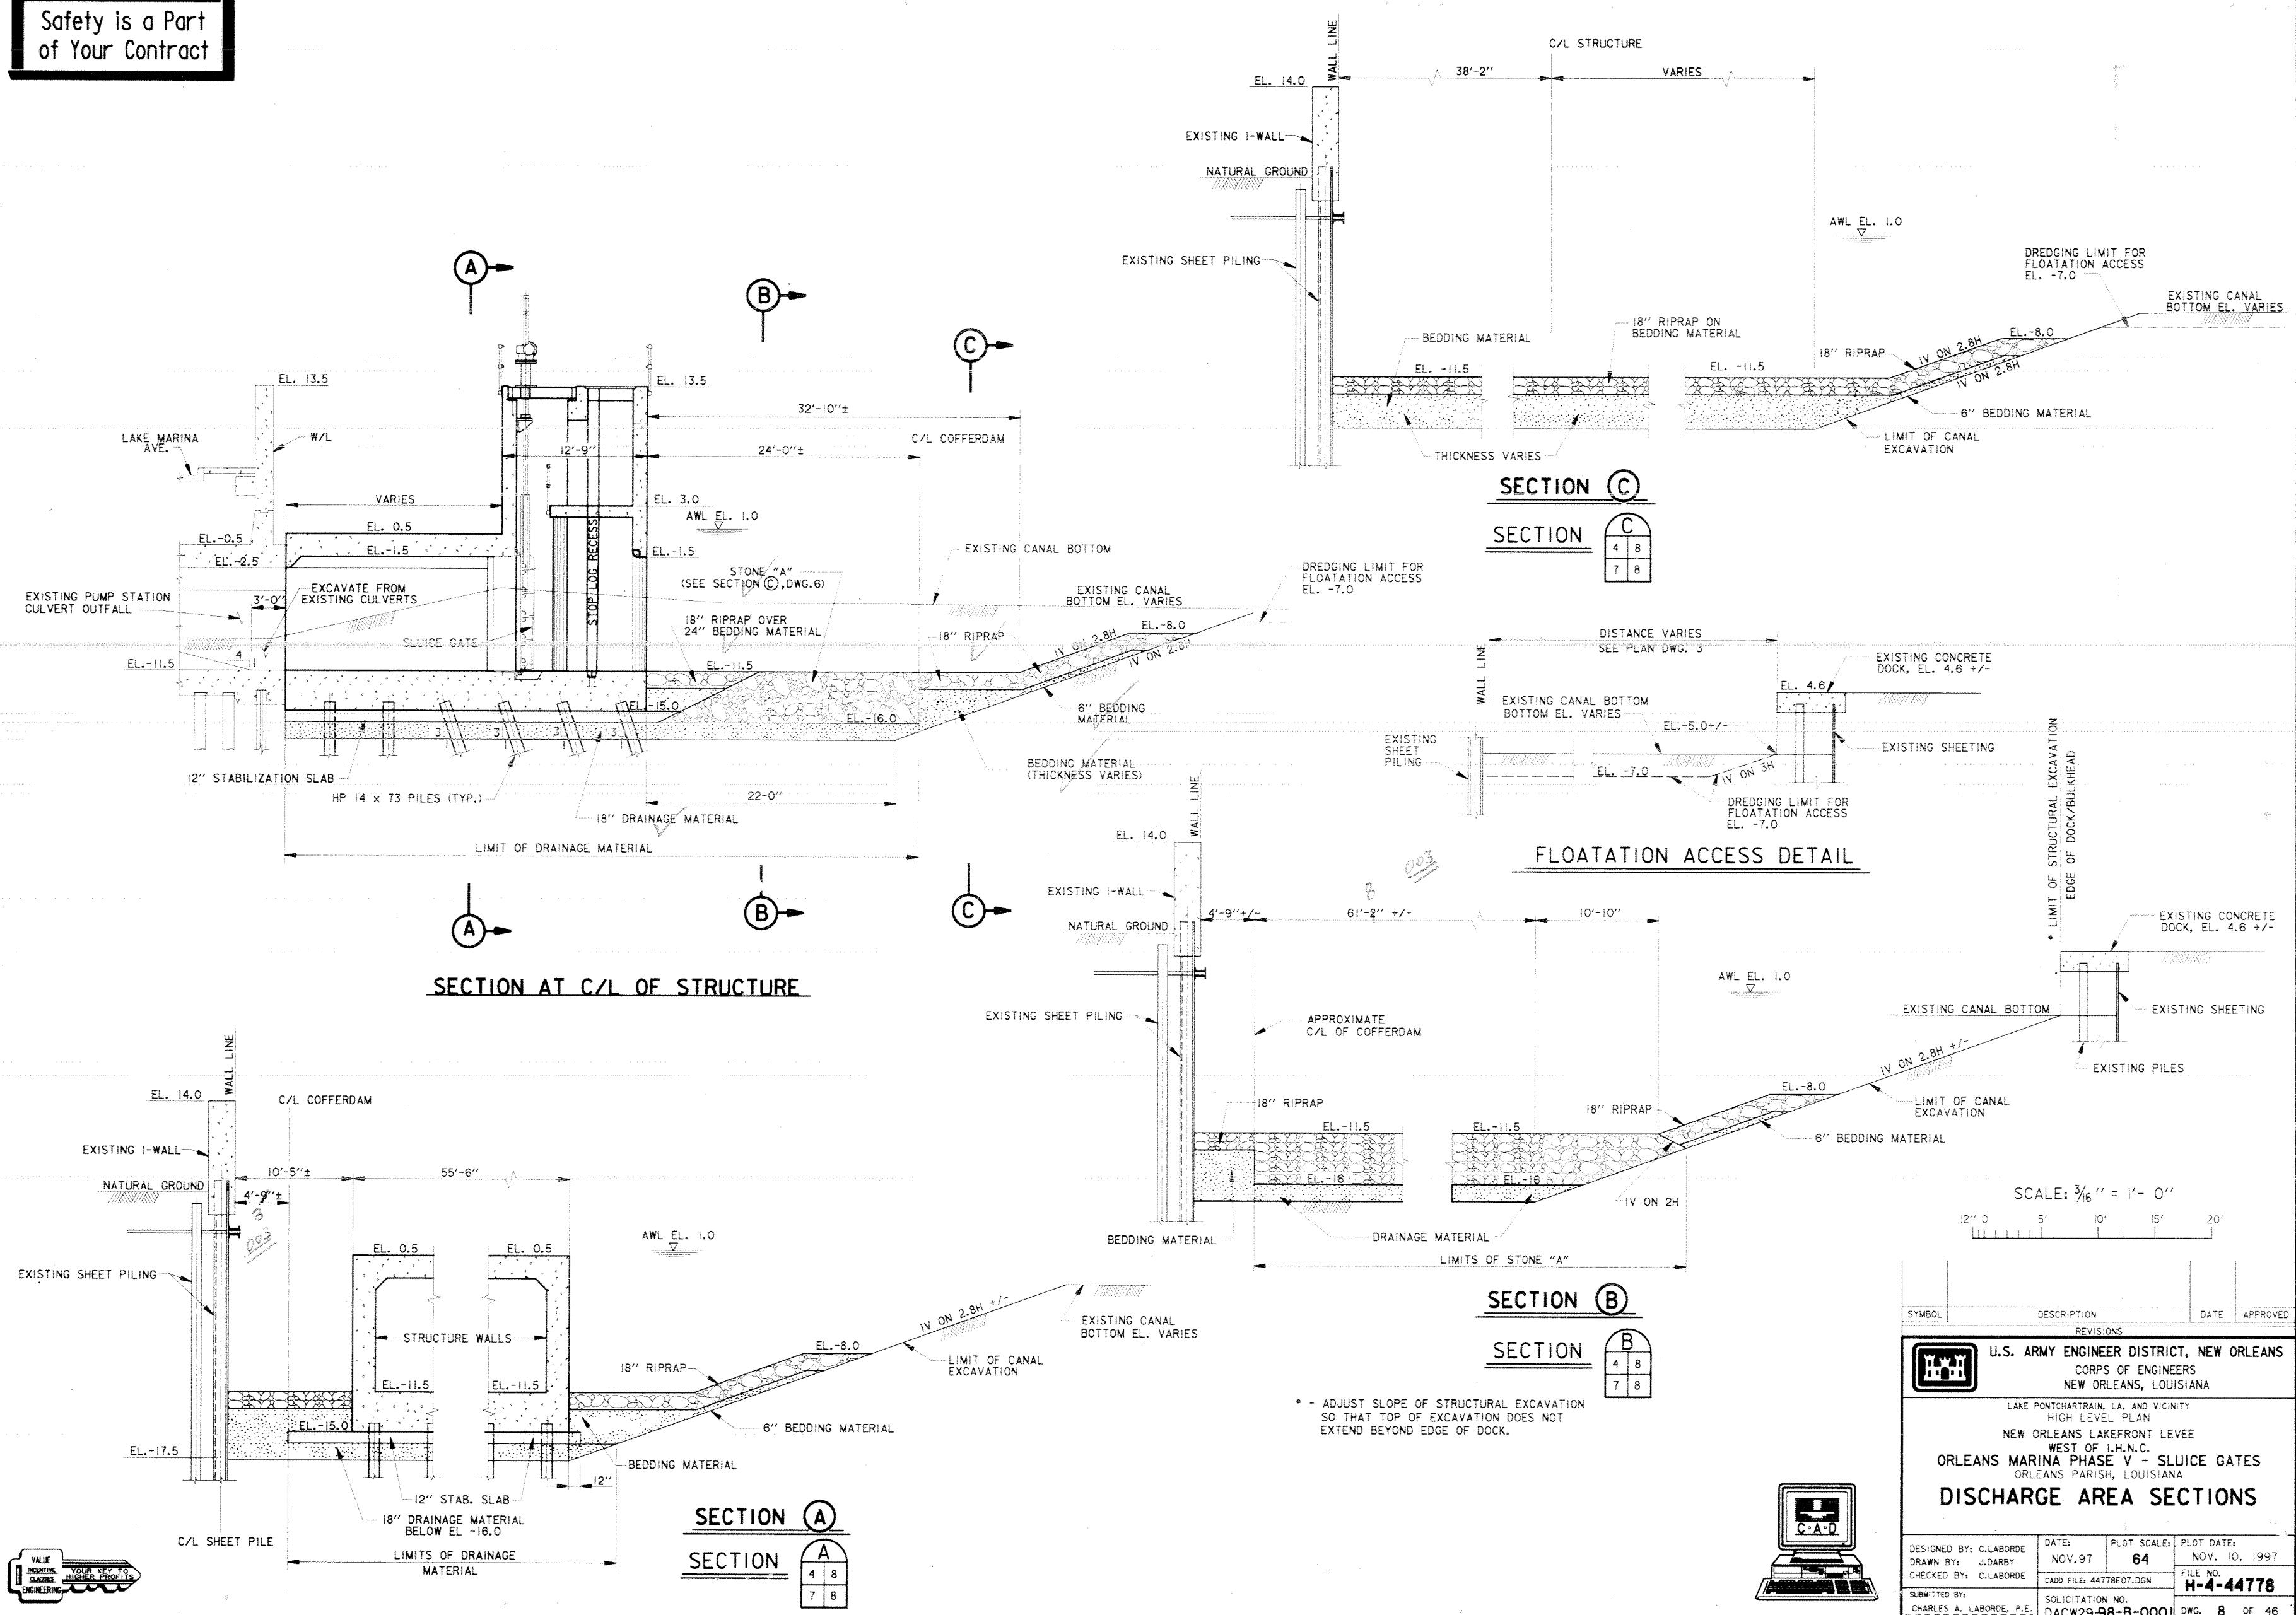


Safety is a Part of Your Contract

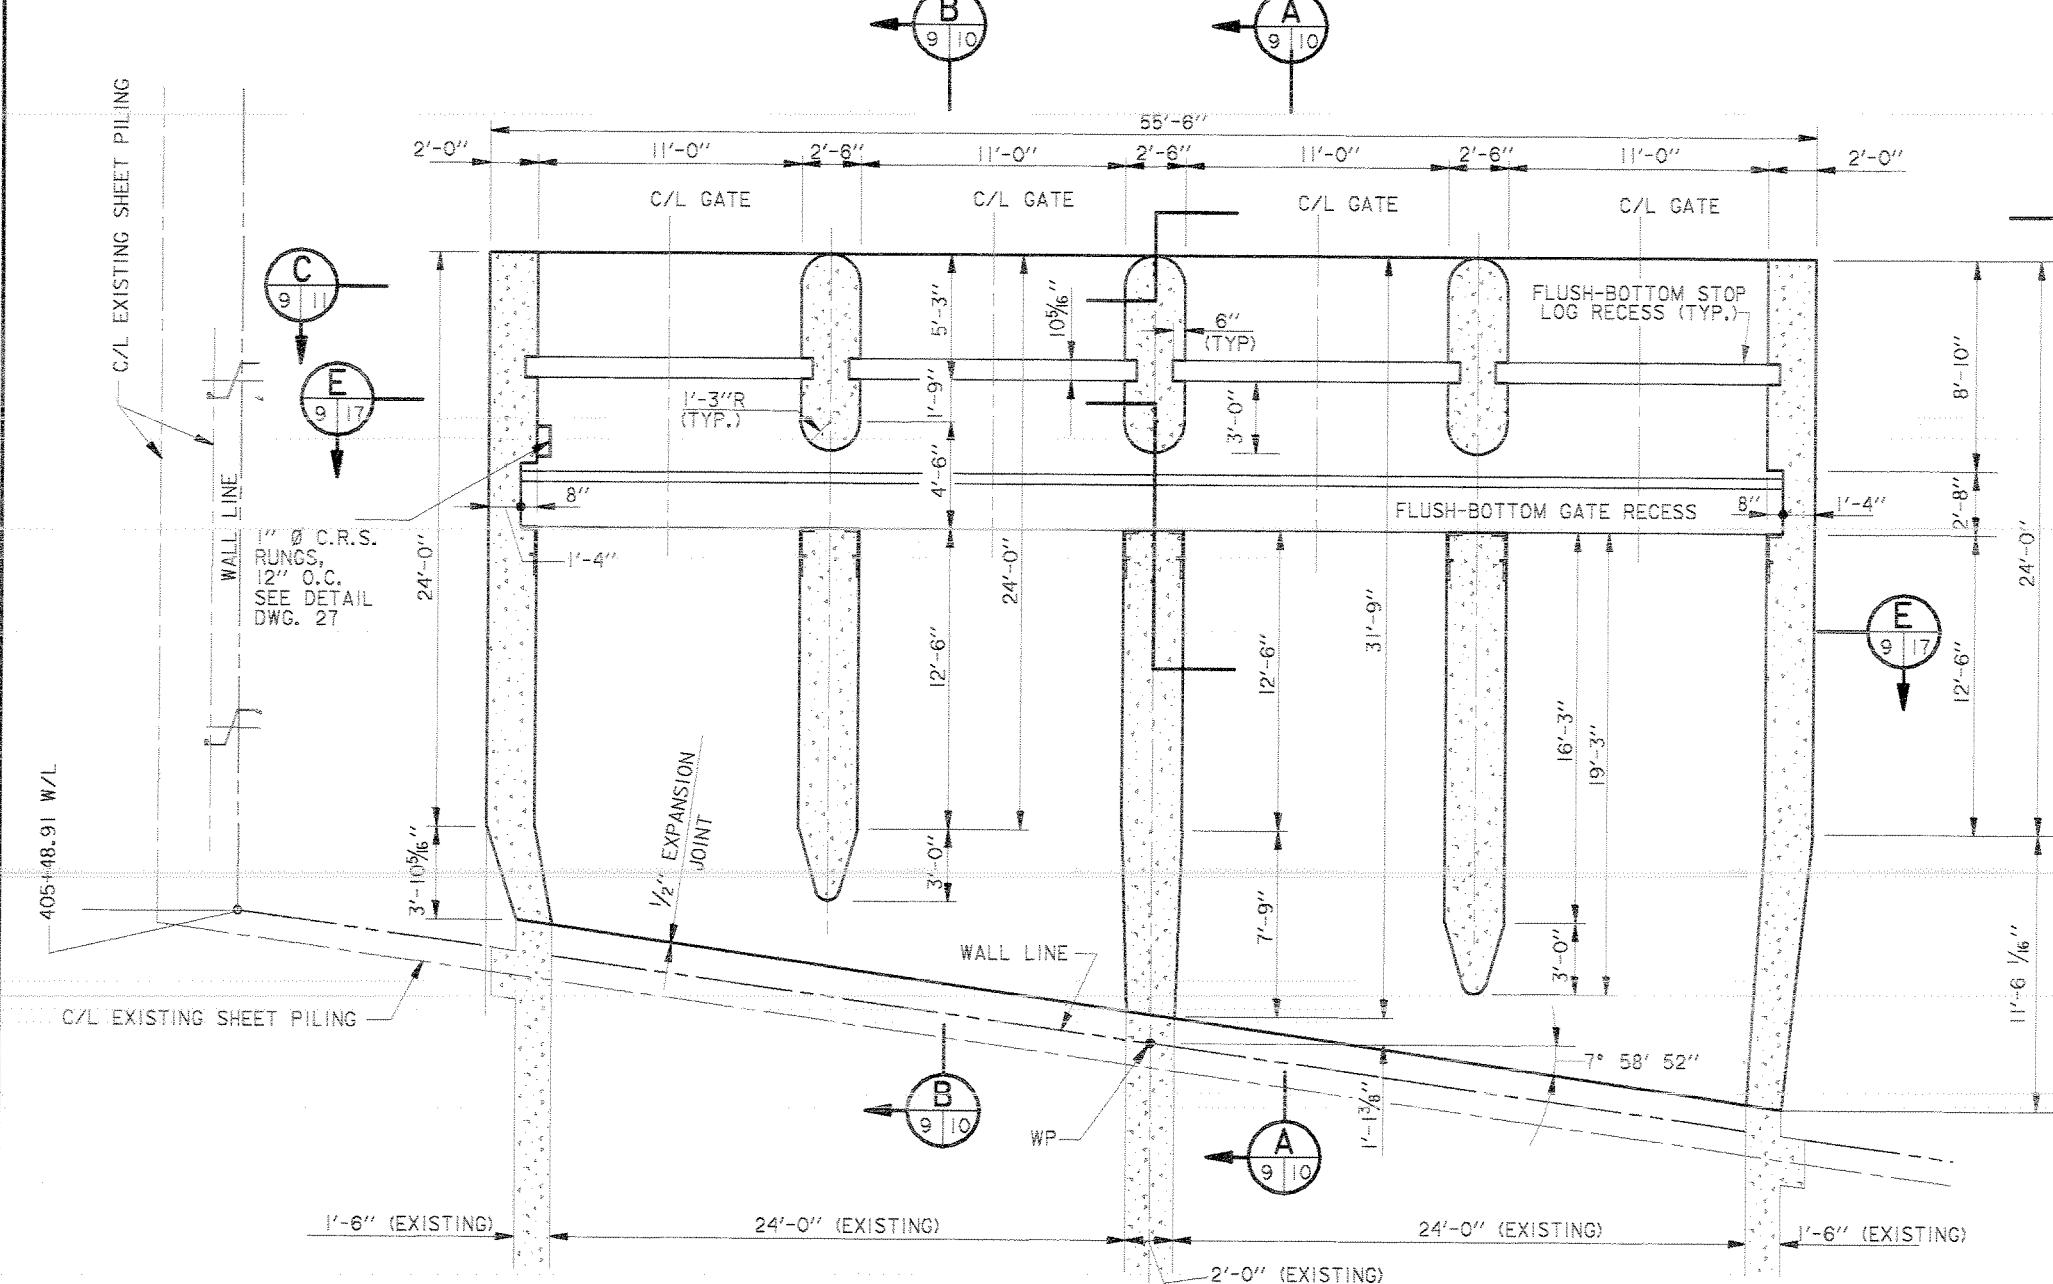


SLUICE GATE STRUCTURE
PLAN AT ELEV.-11.0

SCALE: $\frac{1}{4}'' = 1'-0''$

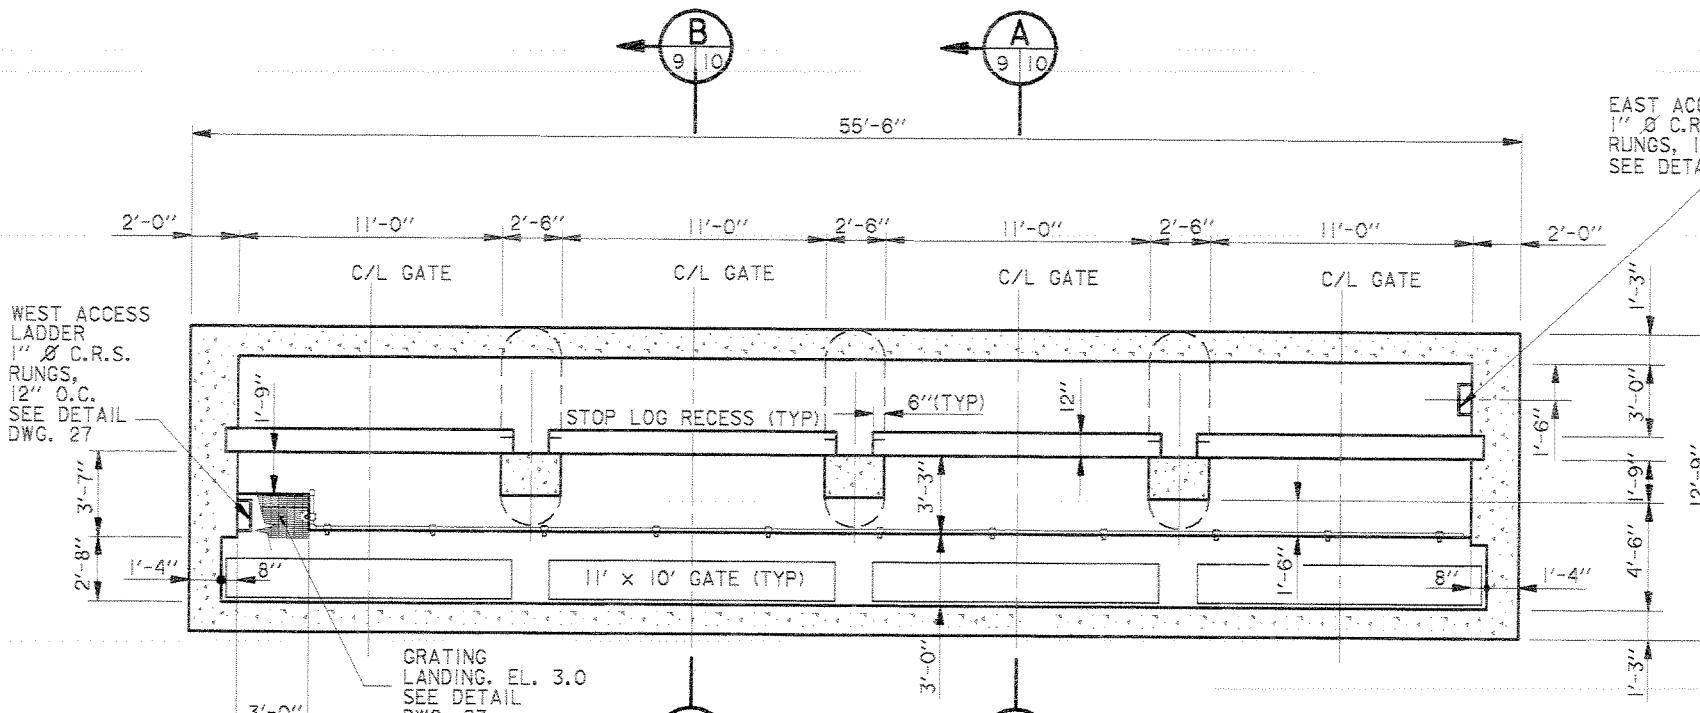

SLUICE GATE STRUCTURE
PLAN AT FL. 8.0

SCALE: $\frac{1}{4}'' = 1'-0''$

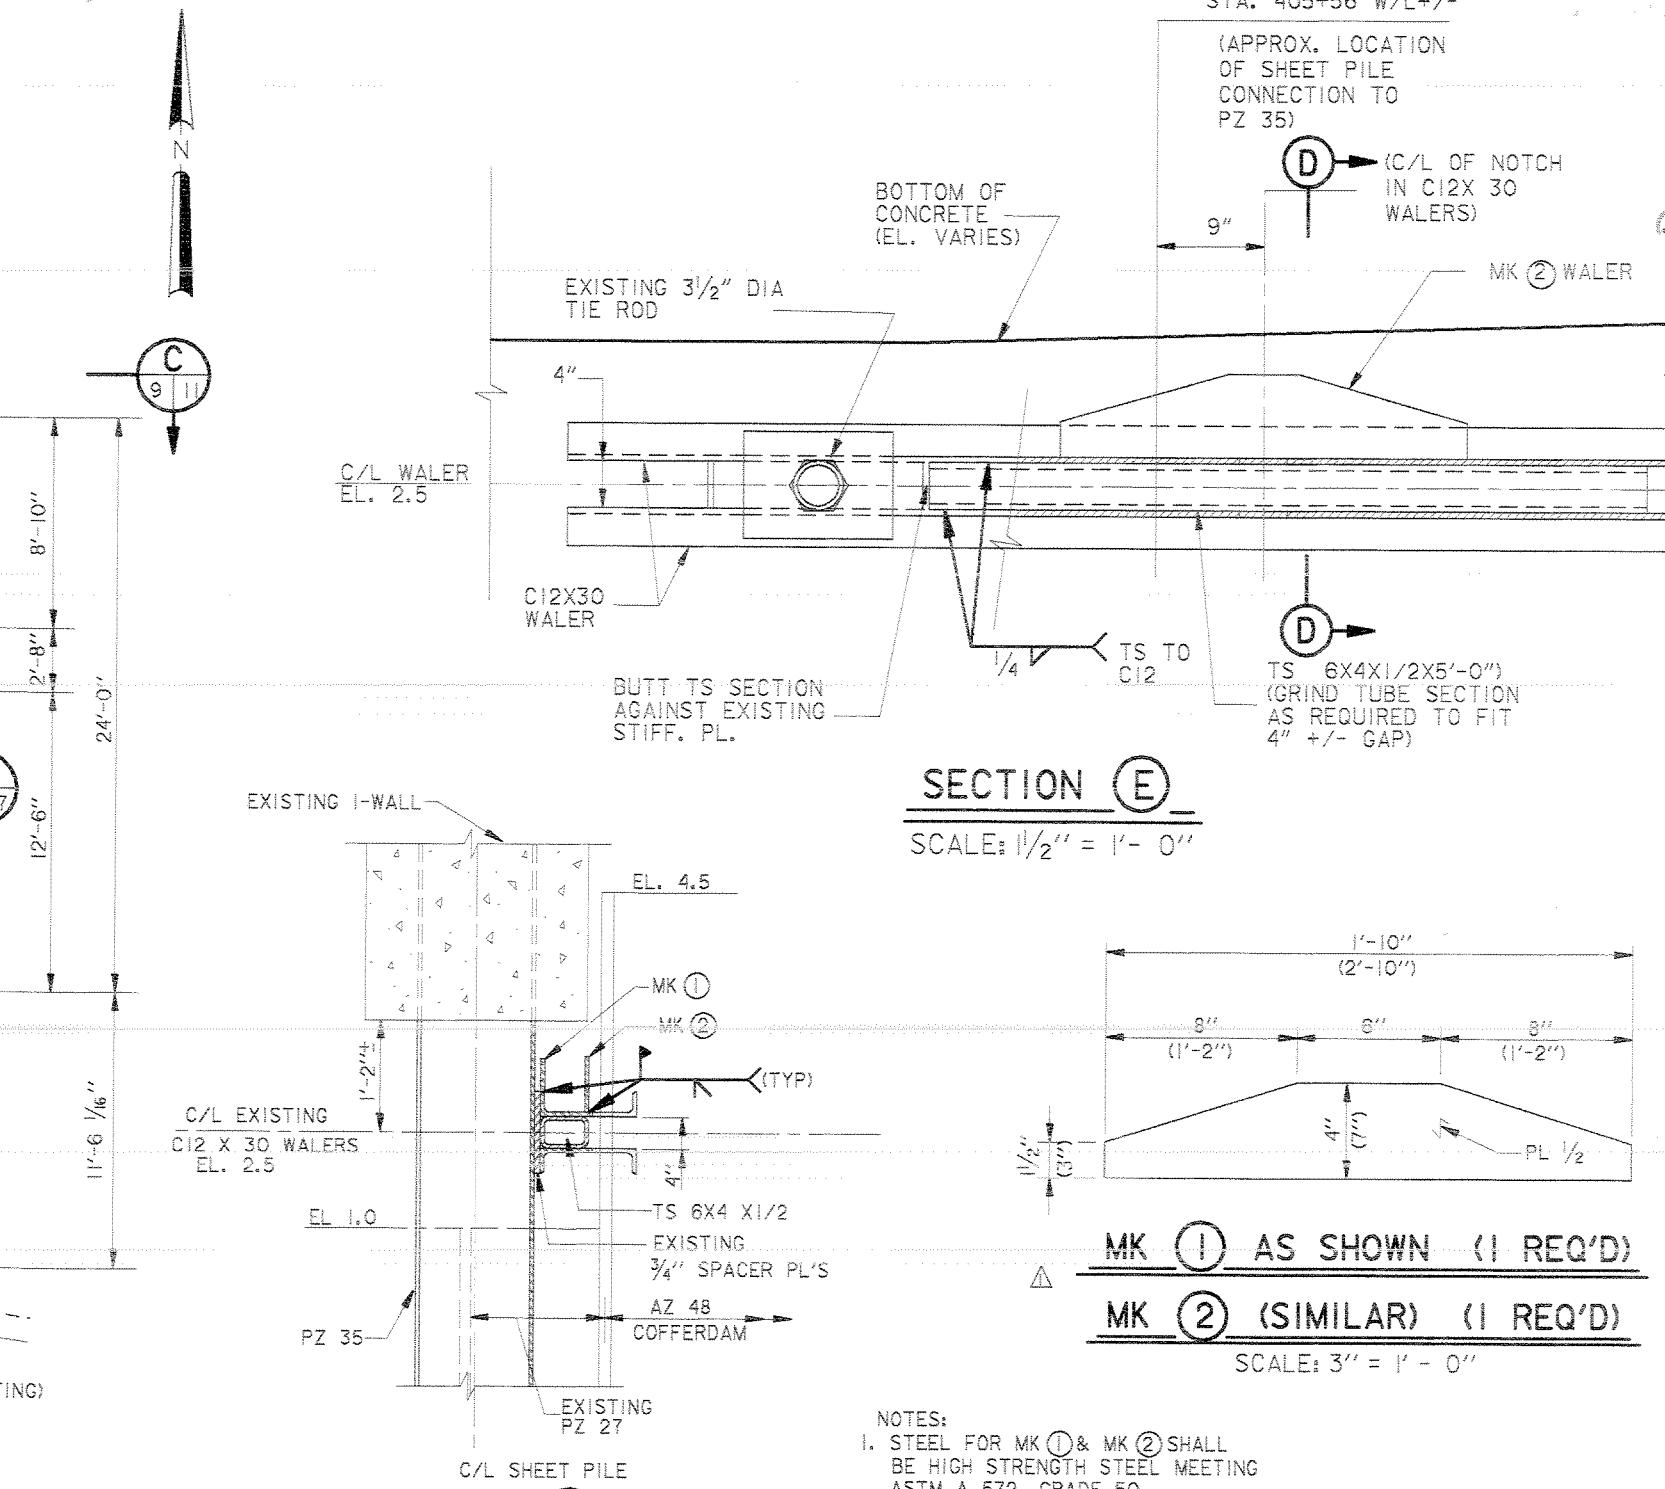


SECTION D

SCALE 1:100 = 1" - 0"

- NOTES:

 1. STEEL FOR MK ① & MK ② SHALL BE HIGH STRENGTH STEEL MEETING ASTM A 572, GRADE 50
 2. GALVANIZE MK ① & MK ② AFTER FABRICATION.
 3. CENTER MK ① & MK ② PLATES ABOUT THE NOTCH IN C12 X 30 WALTERS.

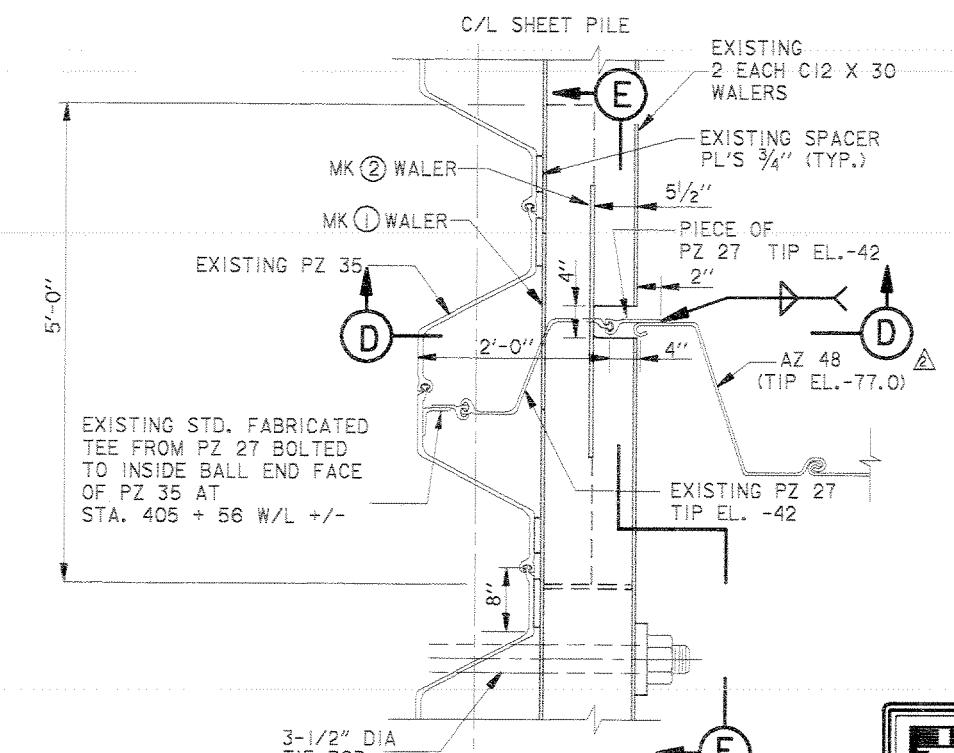

DETAIL


SCALE: 1' = 1'- 0"



SLUICE GATE MASONRY SECTIONS (SHT 1 OF 2)


SIGNED BY: P. SCHAEFER AWN BY: MAGEE ECKED BY: C.LABORDE	DATE: NOV. 97	PLOT SCALE: 48	PLOT DATE: DEC. 7, 1998
		GADD FILE: 4477BPC2.DGN	
MITTED BY: CHARLES A. LABORDE, P.E. DESIGN ENGINEER	SOLICITATION NO. DACP29-98-B-0001		FILE NO. H-4-44778 DWG. 9 OF 46

Safety is a Part
of Your Contract

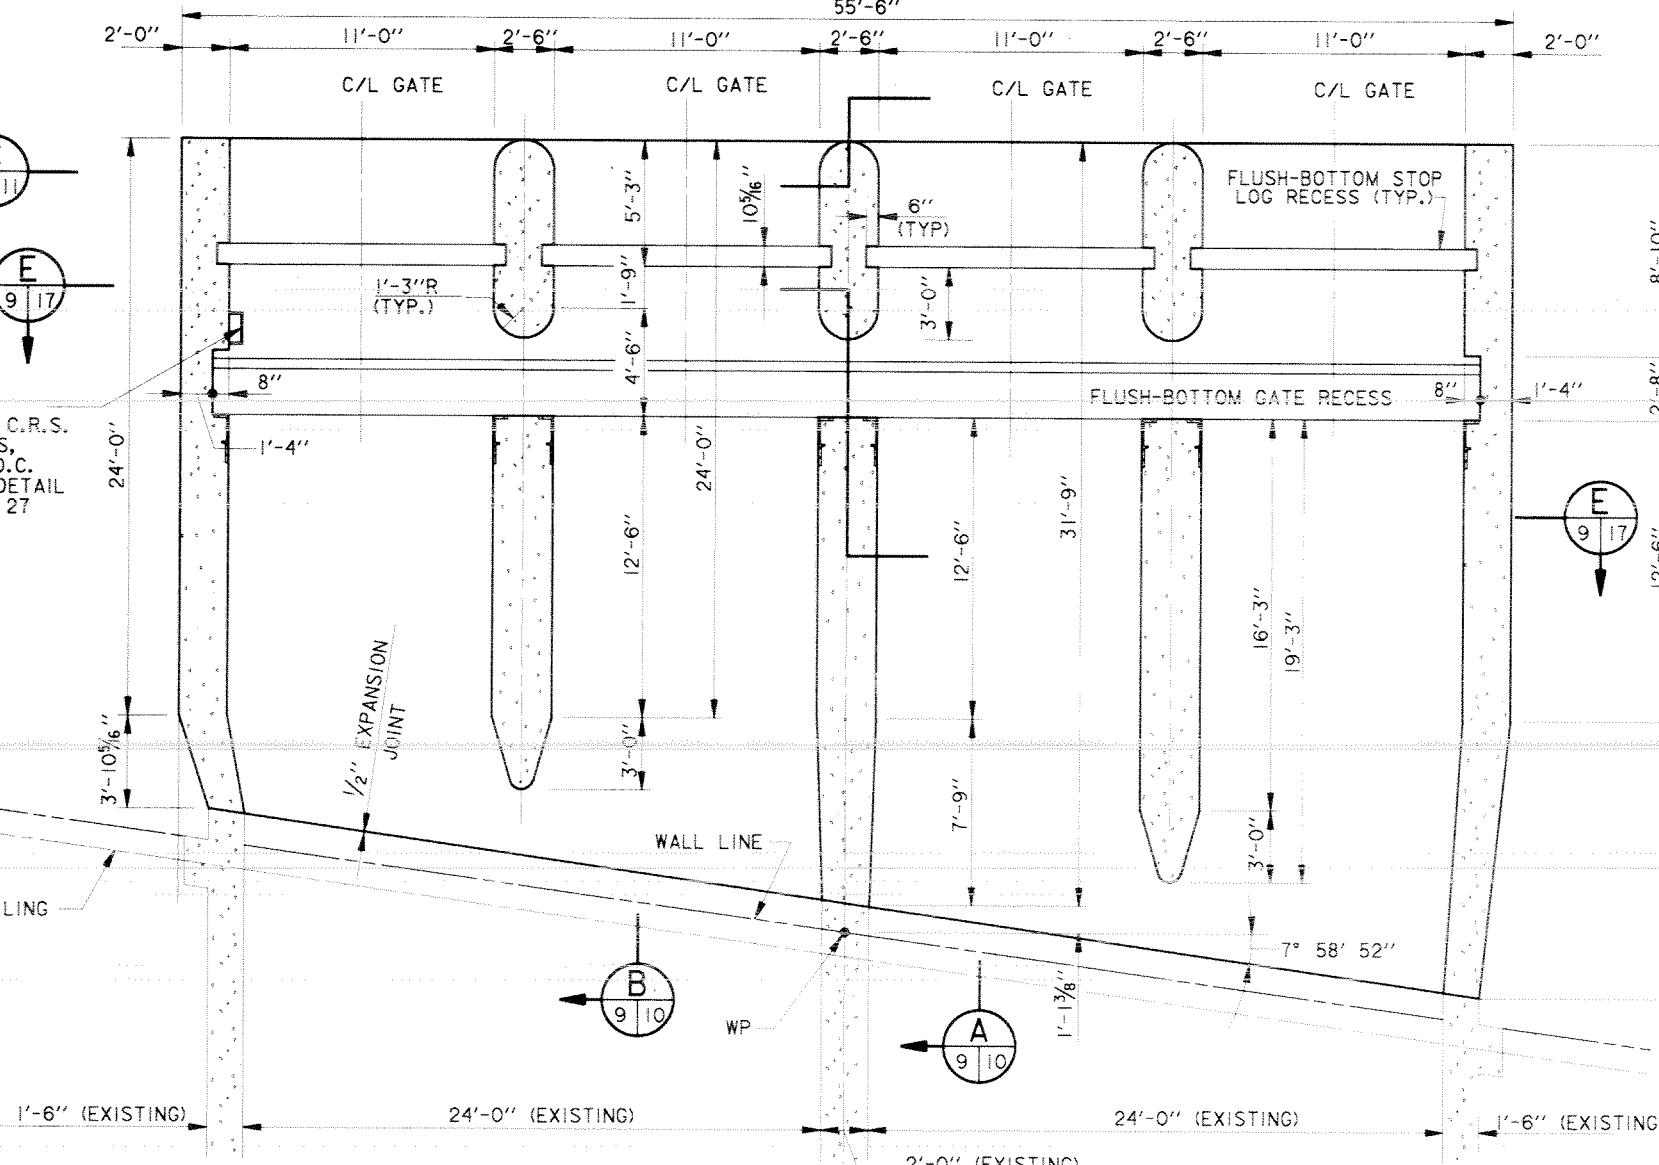


**SLUICE GATE STRUCTURE
PLAN AT ELEV. -11.0**

SCALE: $\frac{1}{4}$ " = 1'- 0"

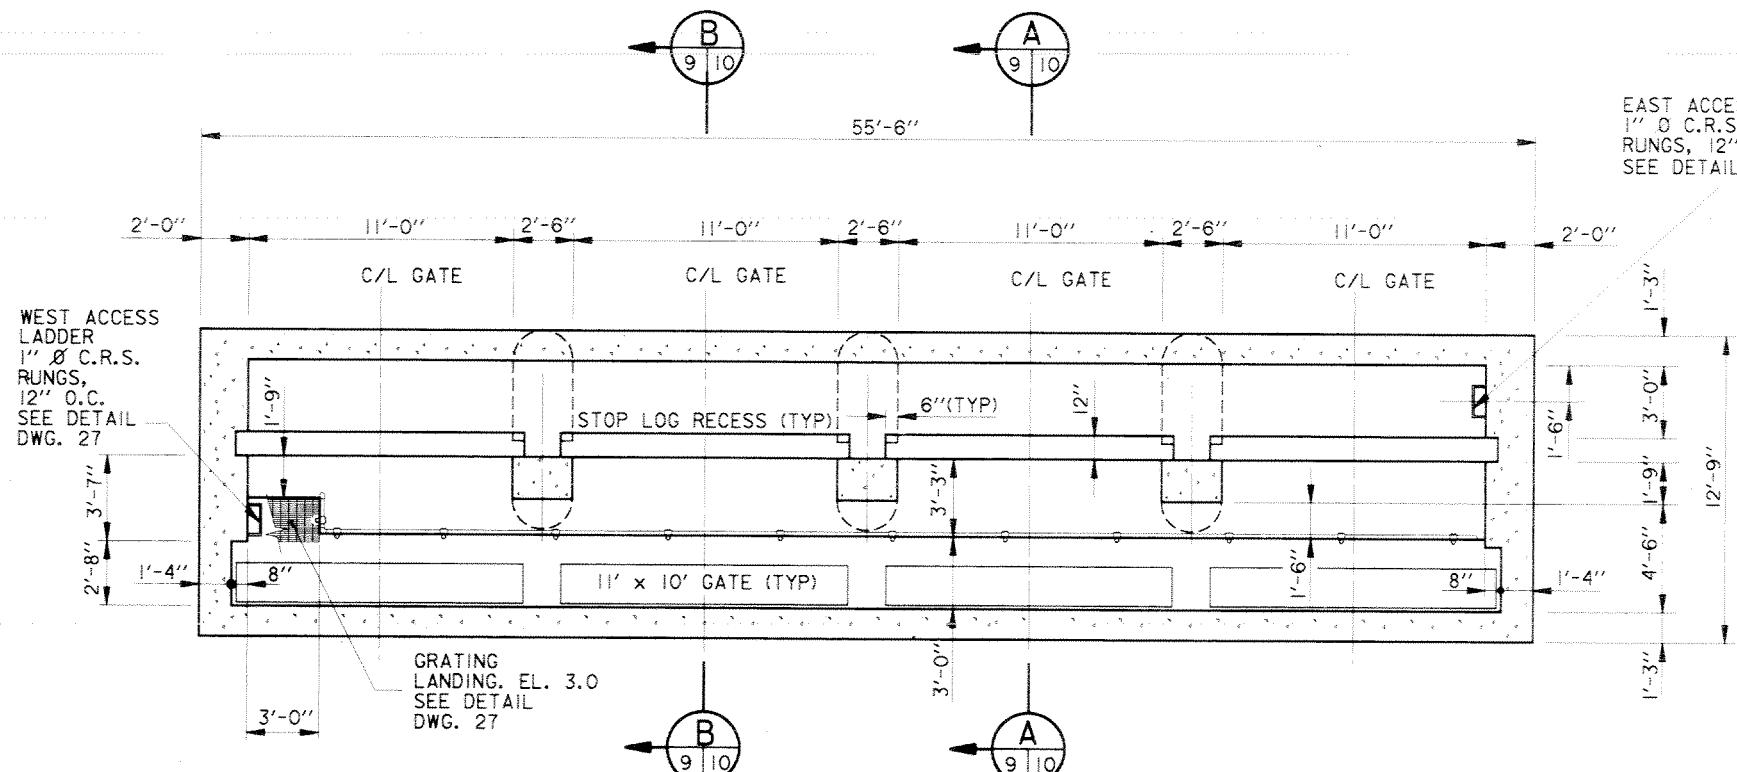

**SLUICE GATE STRUCTURE
PLAN AT EL. 8.0**

SCALE: $\frac{1}{4}$ " = 1'- 0"

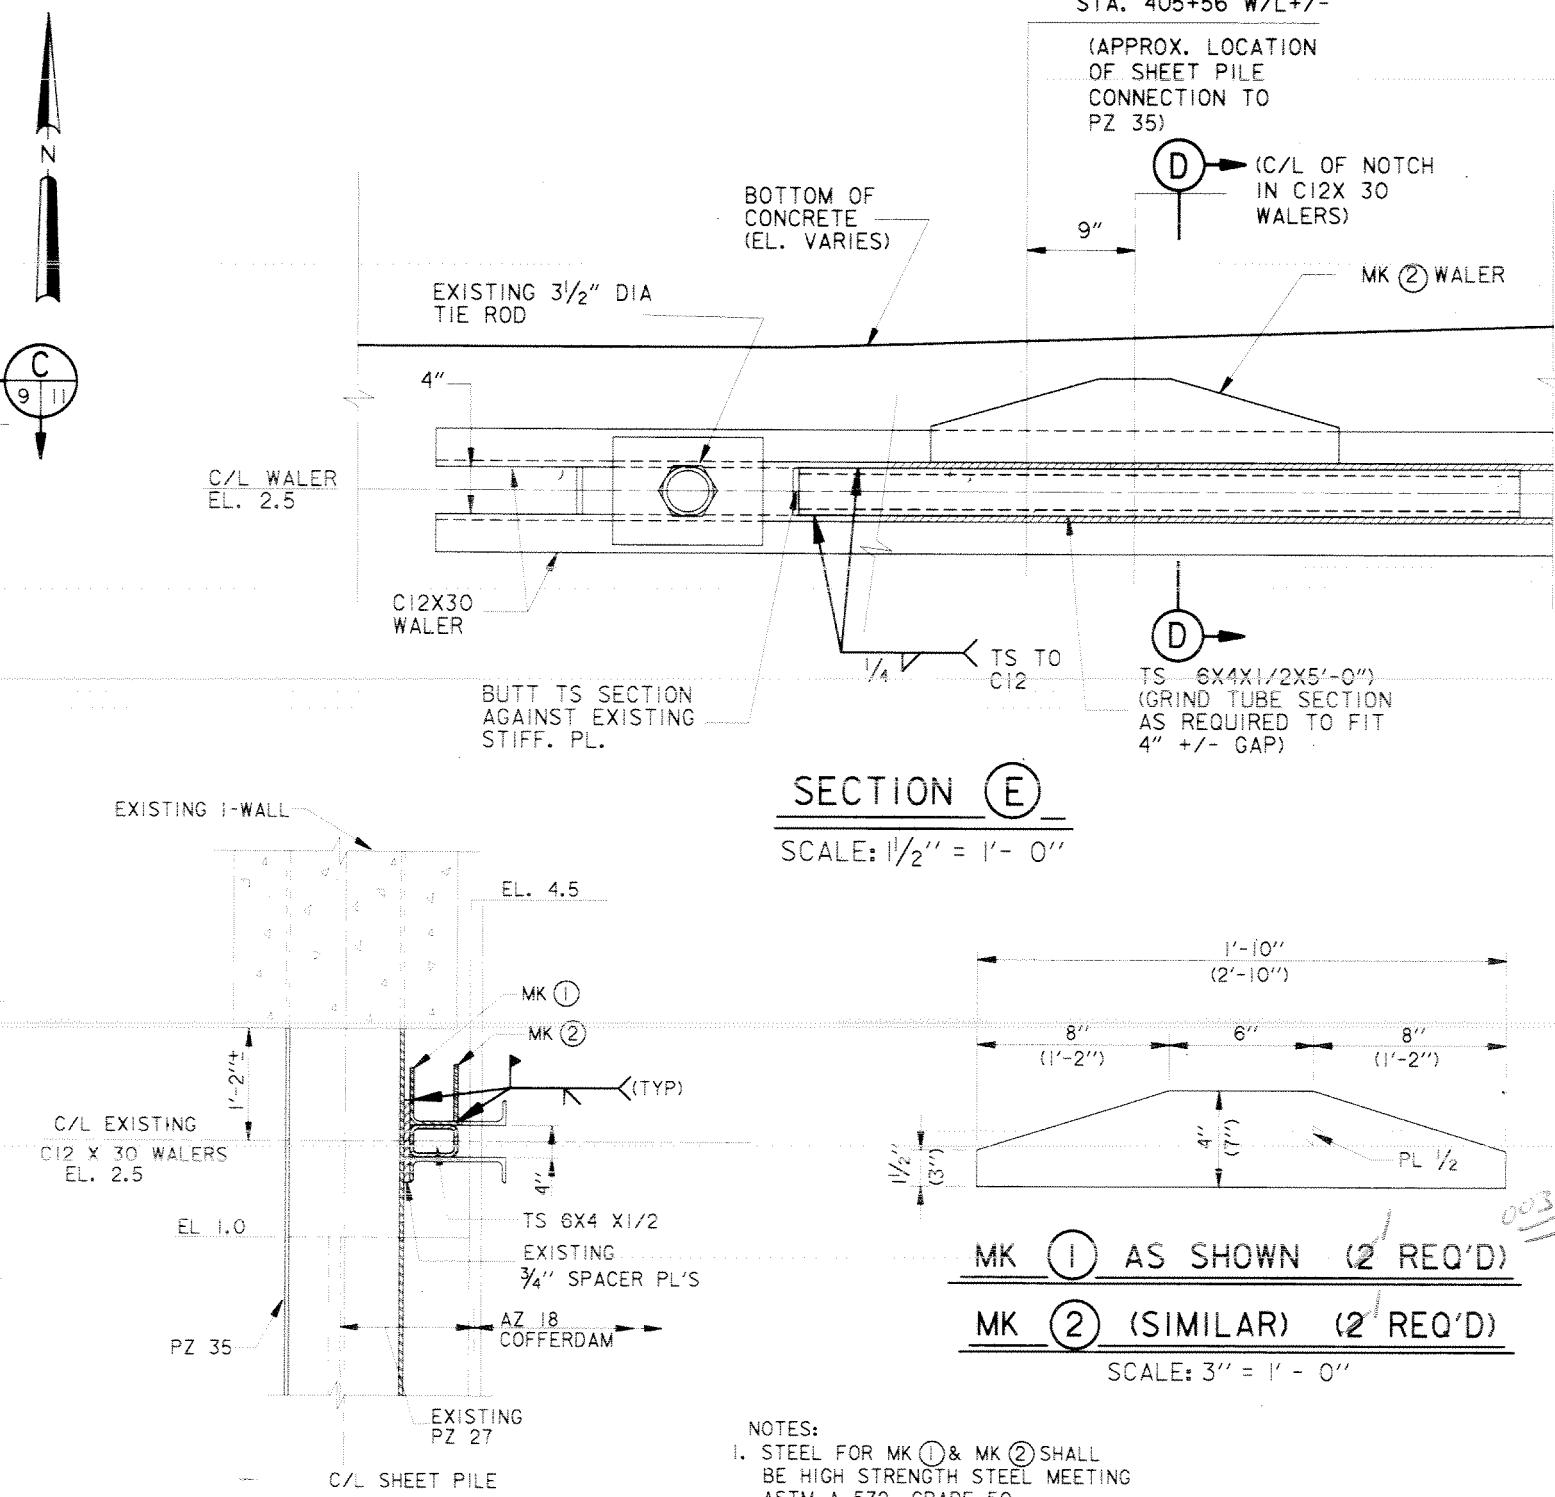


SECTION (E)

SCALE: $\frac{1}{2}$ " = 1'- 0"

MK ① AS SHOWN (2 REQ'D)
MK ② (SIMILAR) (2 REQ'D)

SCALE: 3" = 1'- 0"

- NOTES:
1. STEEL FOR MK ① & MK ② SHALL BE HIGH STRENGTH STEEL MEETING ASTM A 572, GRADE 50.
 2. GALVANIZE MK ① & MK ② AFTER FABRICATION.
 3. CENTER MK ① & MK ② PLATES ABOUT CENTER OF NOT CHIN C12 X 30 WALERS.

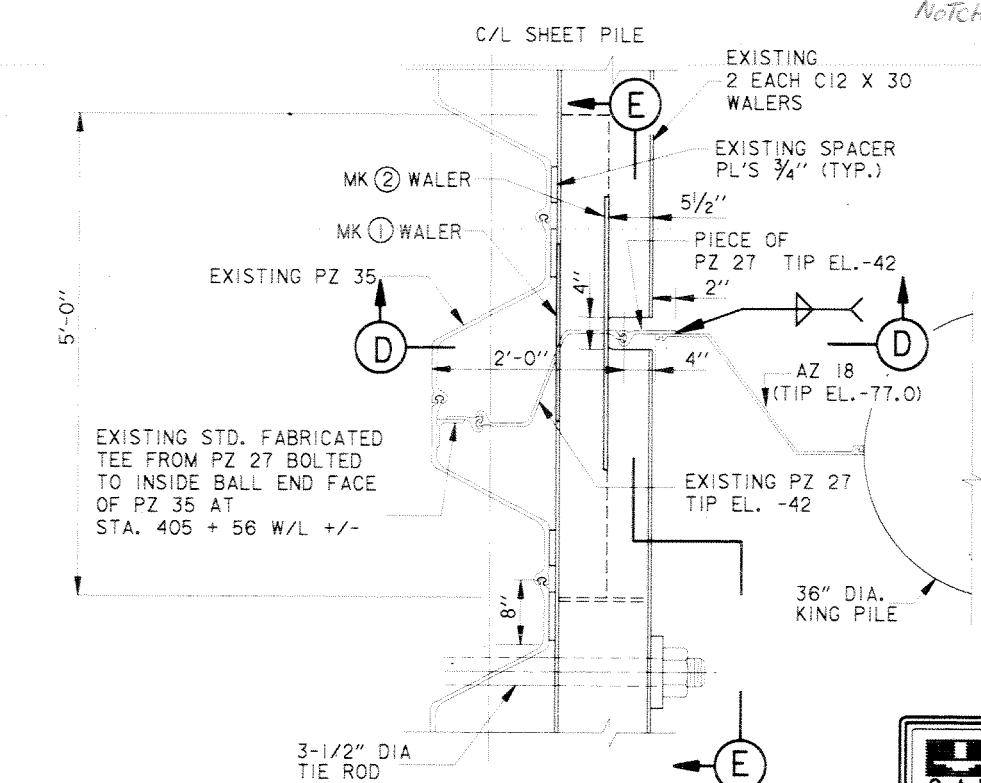


DETAIL

SCALE: $\frac{1}{4}$ " = 1'- 0"

SYMBOL	DESCRIPTION	DATE	APPROVED
	U.S. ARMY ENGINEER DISTRICT, NEW ORLEANS CORPS OF ENGINEERS NEW ORLEANS, LOUISIANA		
LAKE PONTCHARTRAIN, LA. AND VICINITY HIGH LEVEL PLAN NEW ORLEANS LAKEFRONT LEVEE WEST OF I.H.N.C.			
ORLEANS MARINA PHASE V - SLUICE GATES ORLEANS PARISH, LOUISIANA			
SLUICE GATE MASONRY SECTIONS (SHT 1 OF 2)			
DESIGNED BY: P. SCHAEFER DRAWN BY: MAGEE CHECKED BY: LABORDE SUBMITTED BY: CHARLES A. LABORDE, P.E. DESIGN ENGINEER	PLOT DATE: NOV. 97 PLOT SCALE: 48 FILE NO. H-4-44778 CADD FILE: 44778P02.DGN	PLOT DATE: DEC. 11, 1997 FILE NO. H-4-44778 SOLICITATION NO. DACW29-98-B-0001 DWG. 9 OF 46	

Safety is a Part
of Your Contract

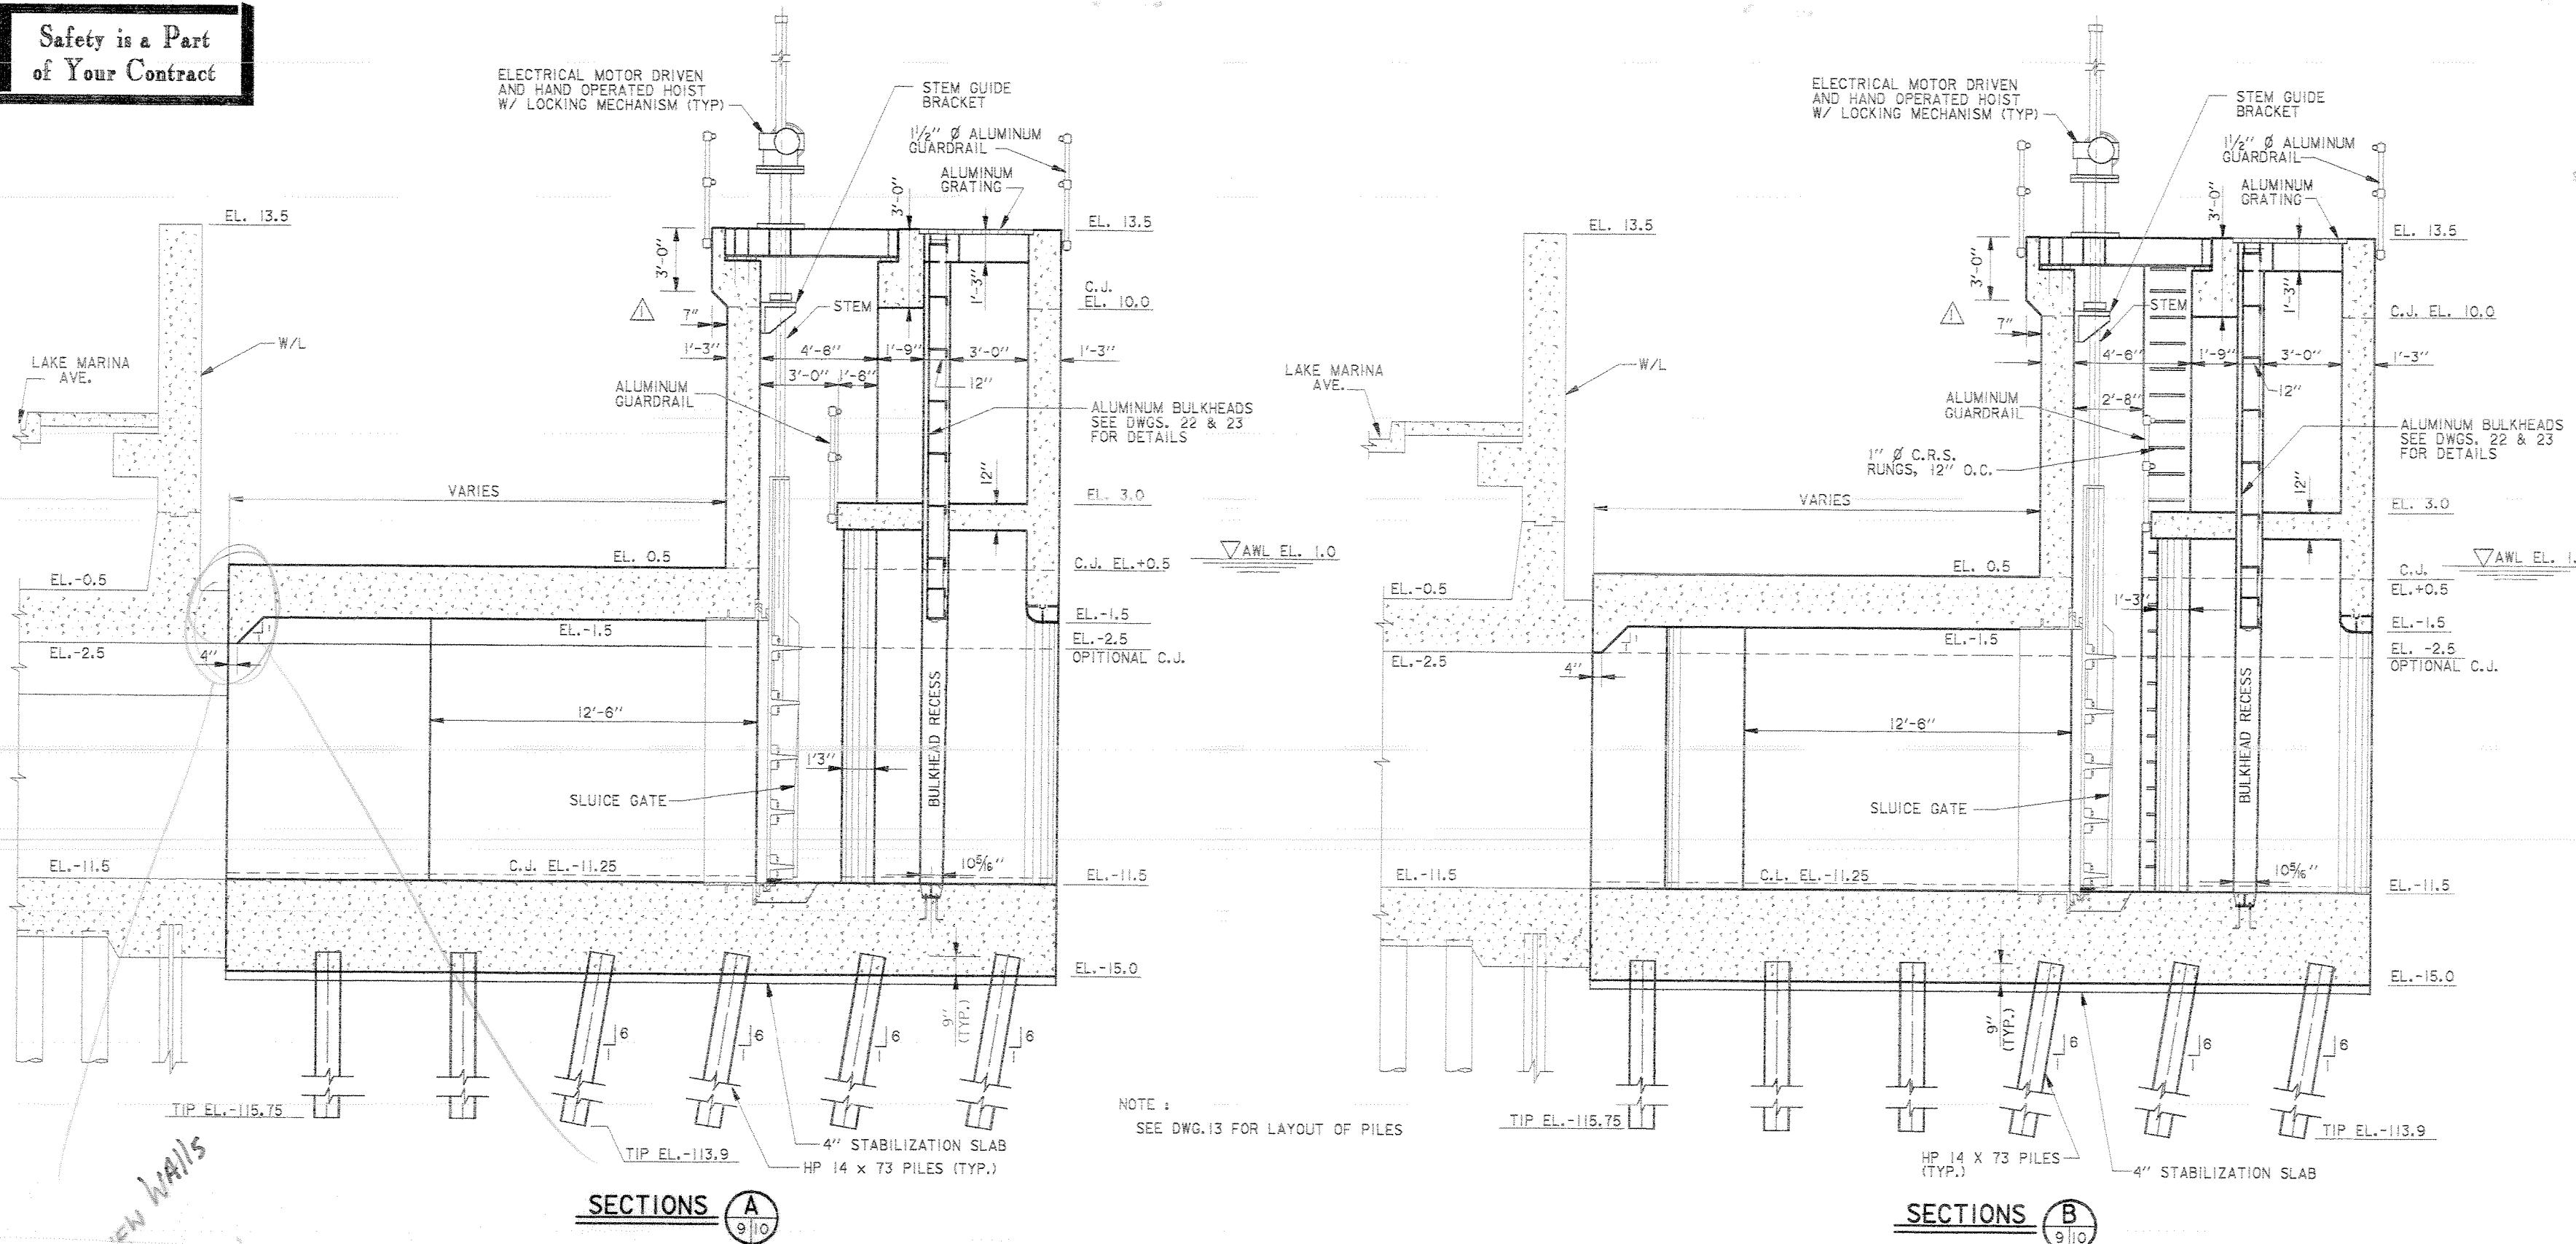


SCALE: $\frac{3}{8}'' = 1'-0''$

12' 0" 2' 4' 6' 8' 10'

REVISED HOIST BEAM & WALL GEOMETRY	2/1/99	CAL
SYMBOL	DESCRIPTION	DATE APPROVED
REVISIONS		
U.S. ARMY ENGINEER DISTRICT, NEW ORLEANS		
CORPS OF ENGINEERS		
NEW ORLEANS, LOUISIANA		
LAKE PONTCHARTRAIN, LA. AND VICINITY		
HIGH LEVEL PLAN		
NEW ORLEANS LAKEFRONT LEVEE		
WEST OF I.H.N.C.		
ORLEANS MARINA PHASE V - SLUICE GATES		
ORLEANS PARISH, LOUISIANA		
SLUICE GATE MASONRY SECTIONS		
(SHT. 2 OF 2)		
DESIGNED BY: C. LABORDE	DATE: NOV. 97	PLOT SCALE: 32
DRAWN BY: HOWAT		PLOT DATE: FEB. 1, 1999
CHECKED BY: C. LABORDE		
SUBMITTED BY: CHARLES A. LABORDE, P.E.	SOLICITATION NO. DACW29-98-B-0001	FILE NO. H-4-44778
CADD FILE: 44778B16.DGN		
DESIGN ENGINEER	DWG. 10 OF 46	

Safety is a Part
of Your Contract


ELECTRICAL MOTOR DRIVEN
AND HAND OPERATED HOIST
W/ LOCKING MECHANISM (TYP)

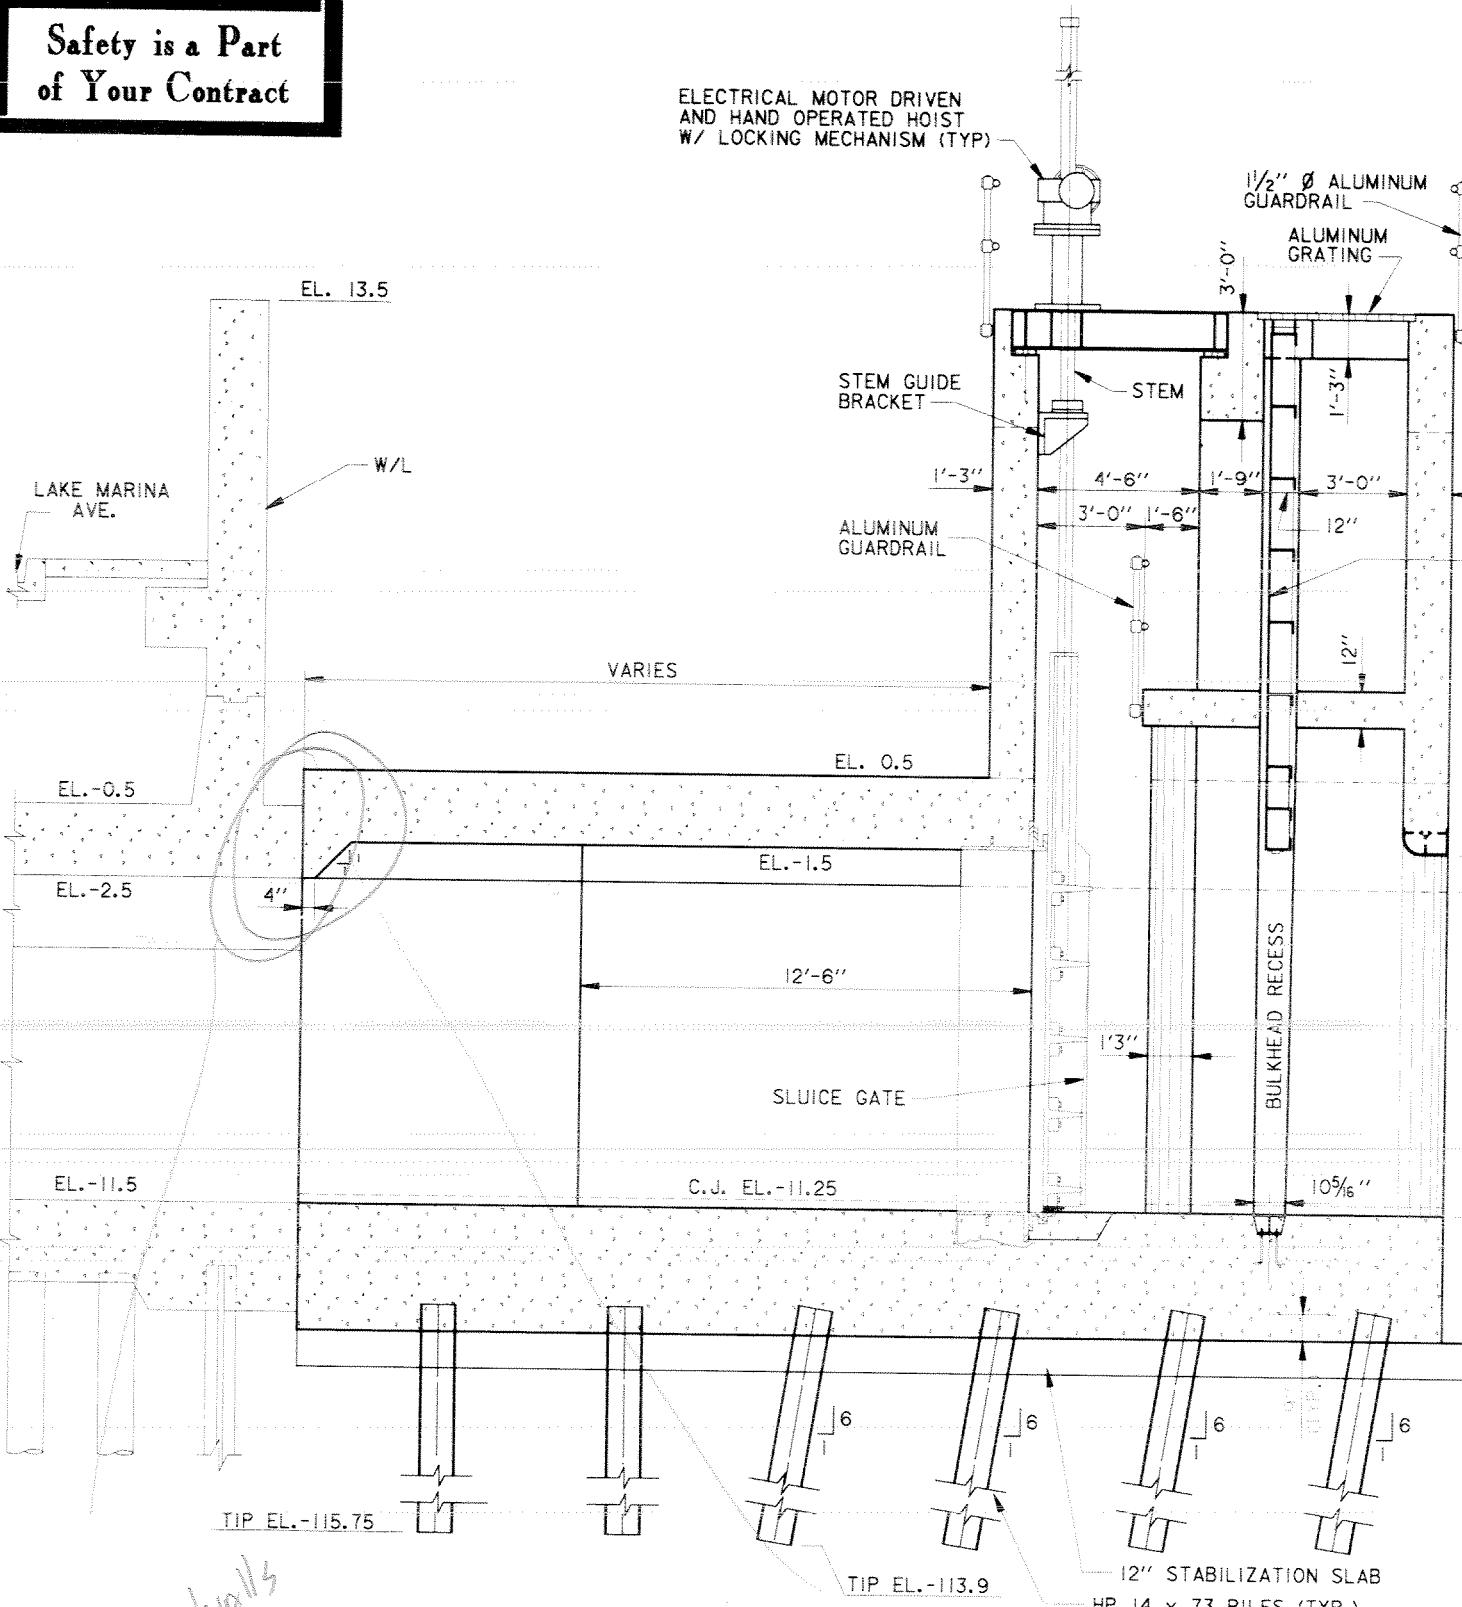

SECTION A



ELECTRICAL MOTOR DRIVEN
AND HAND OPERATED HOIST
W/ LOCKING MECHANISM (TYP)

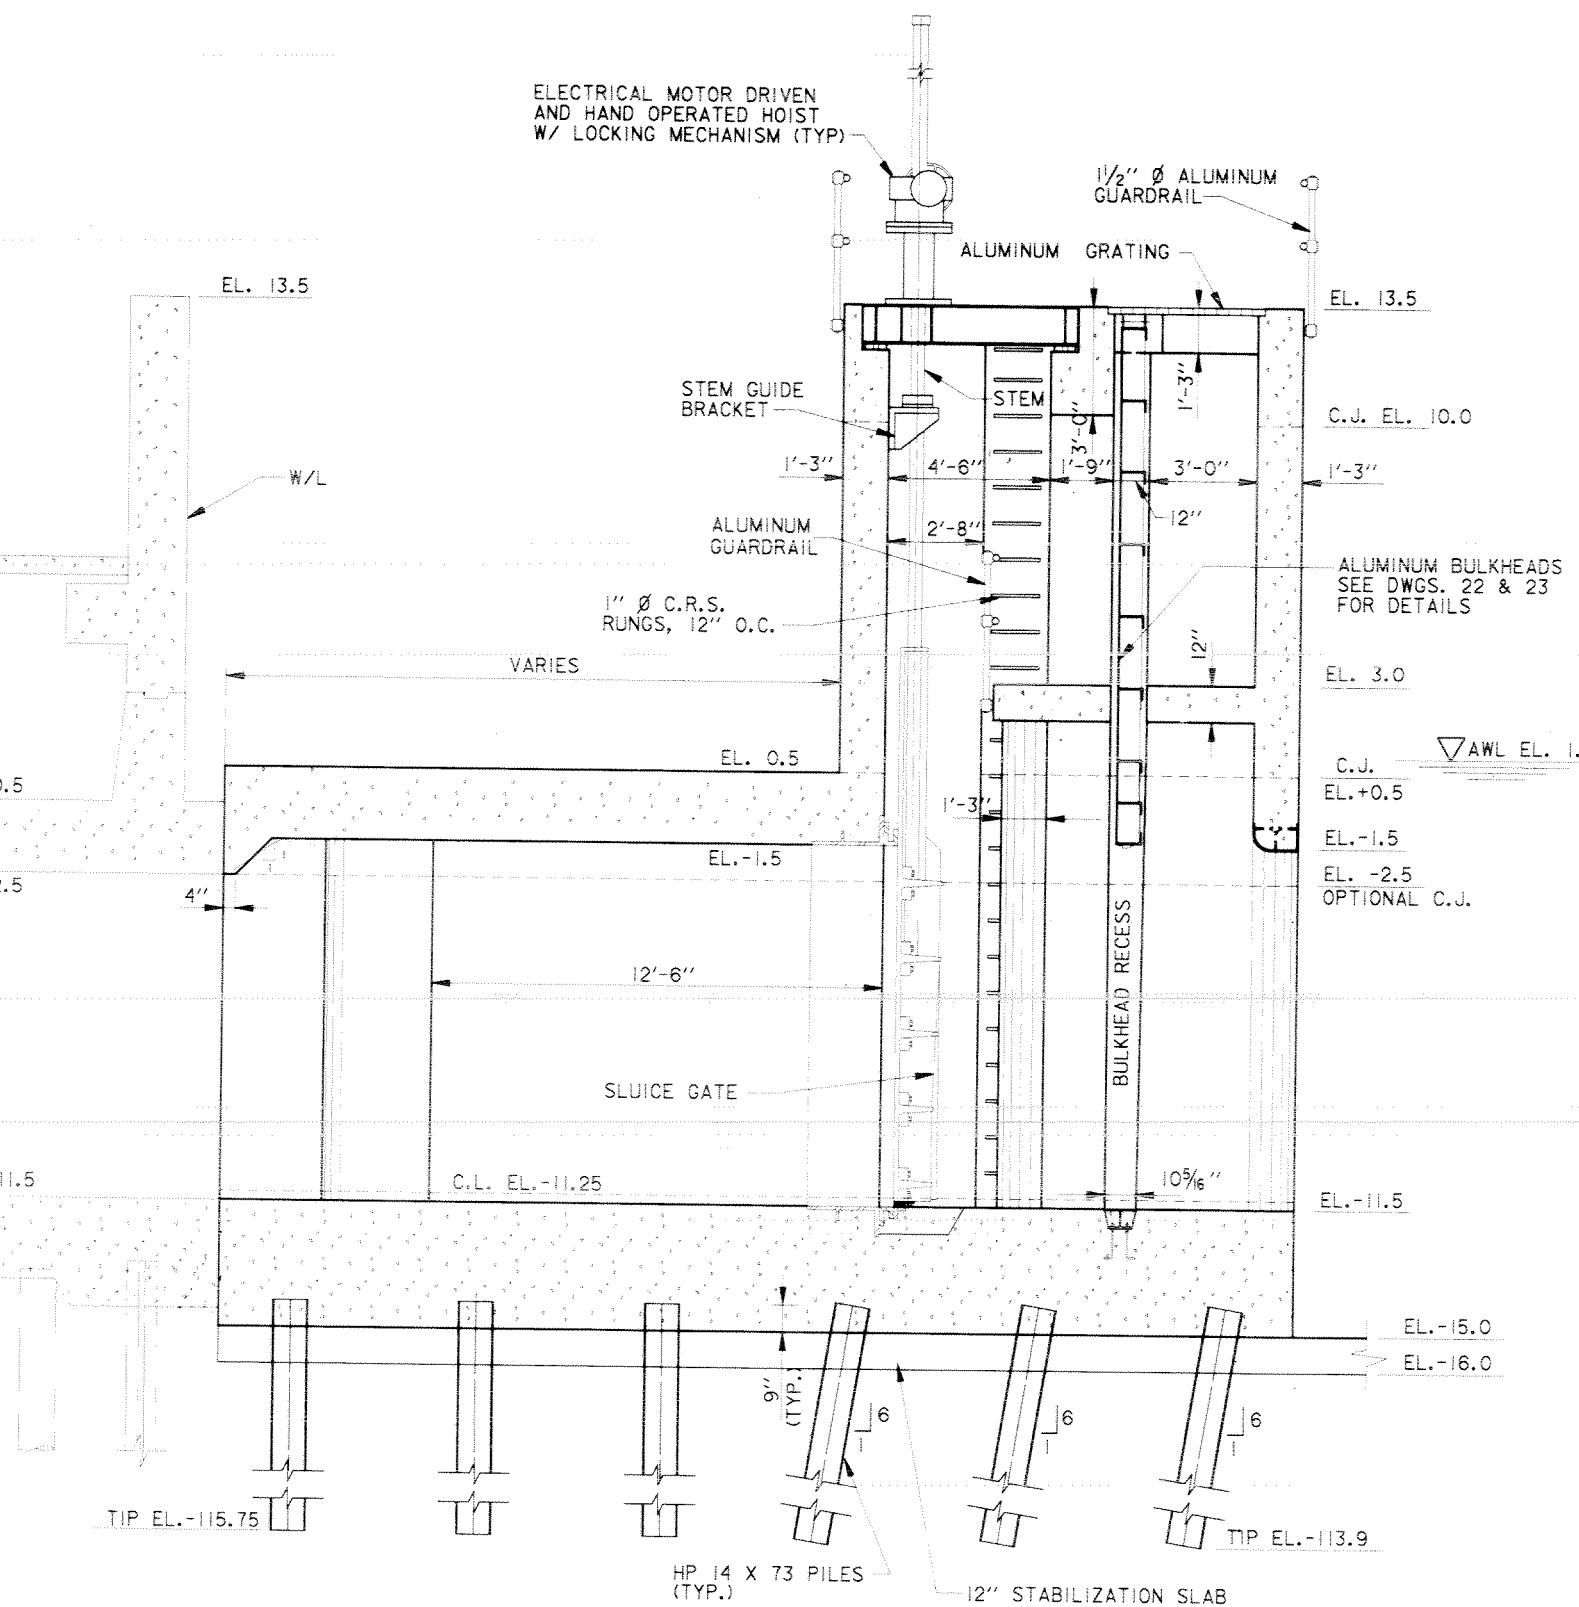

SECTION B

SCALE: $\frac{3}{8}$ " = 1'- 0"

SCALE: 1' = 1'- 0"

SCALE: 3' = 1'- 0"

SYMBOL	DESCRIPTION	DATE	APPROVED
REVISIONS			

U.S. ARMY ENGINEER DISTRICT, NEW ORLEANS
CORPS OF ENGINEERS
NEW ORLEANS, LOUISIANA

LAKE PONTCHARTRAIN, LA. AND VICINITY
HIGH LEVEL PLAN
NEW ORLEANS LAKEFRONT LEVEE

WEST OF I.H.N.C.
ORLEANS MARINA PHASE V - SLUICE GATES
ORLEANS PARISH, LOUISIANA

SLUICE GATE MASONRY SECTIONS (SHT. 2 OF 2)


DESIGNED BY: C. LABORDE	DATE: NOV. 97	PLOT SCALE: 32	PLOT DATE: NOV. 25, 1997
DRAWN BY: HOWAT			
CHECKED BY: C. LABORDE			
SUBMITTED BY: CHARLES A. LABORDE, P.E.			
SOLICITATION NO: DACW29-98-B-0001			
DESIGN ENGINEER			

CADD FILE: 44778B19.DGN

FILE NO. H-4-44778

DWG. 10 OF 46


Safety is a Part
of Your Contract

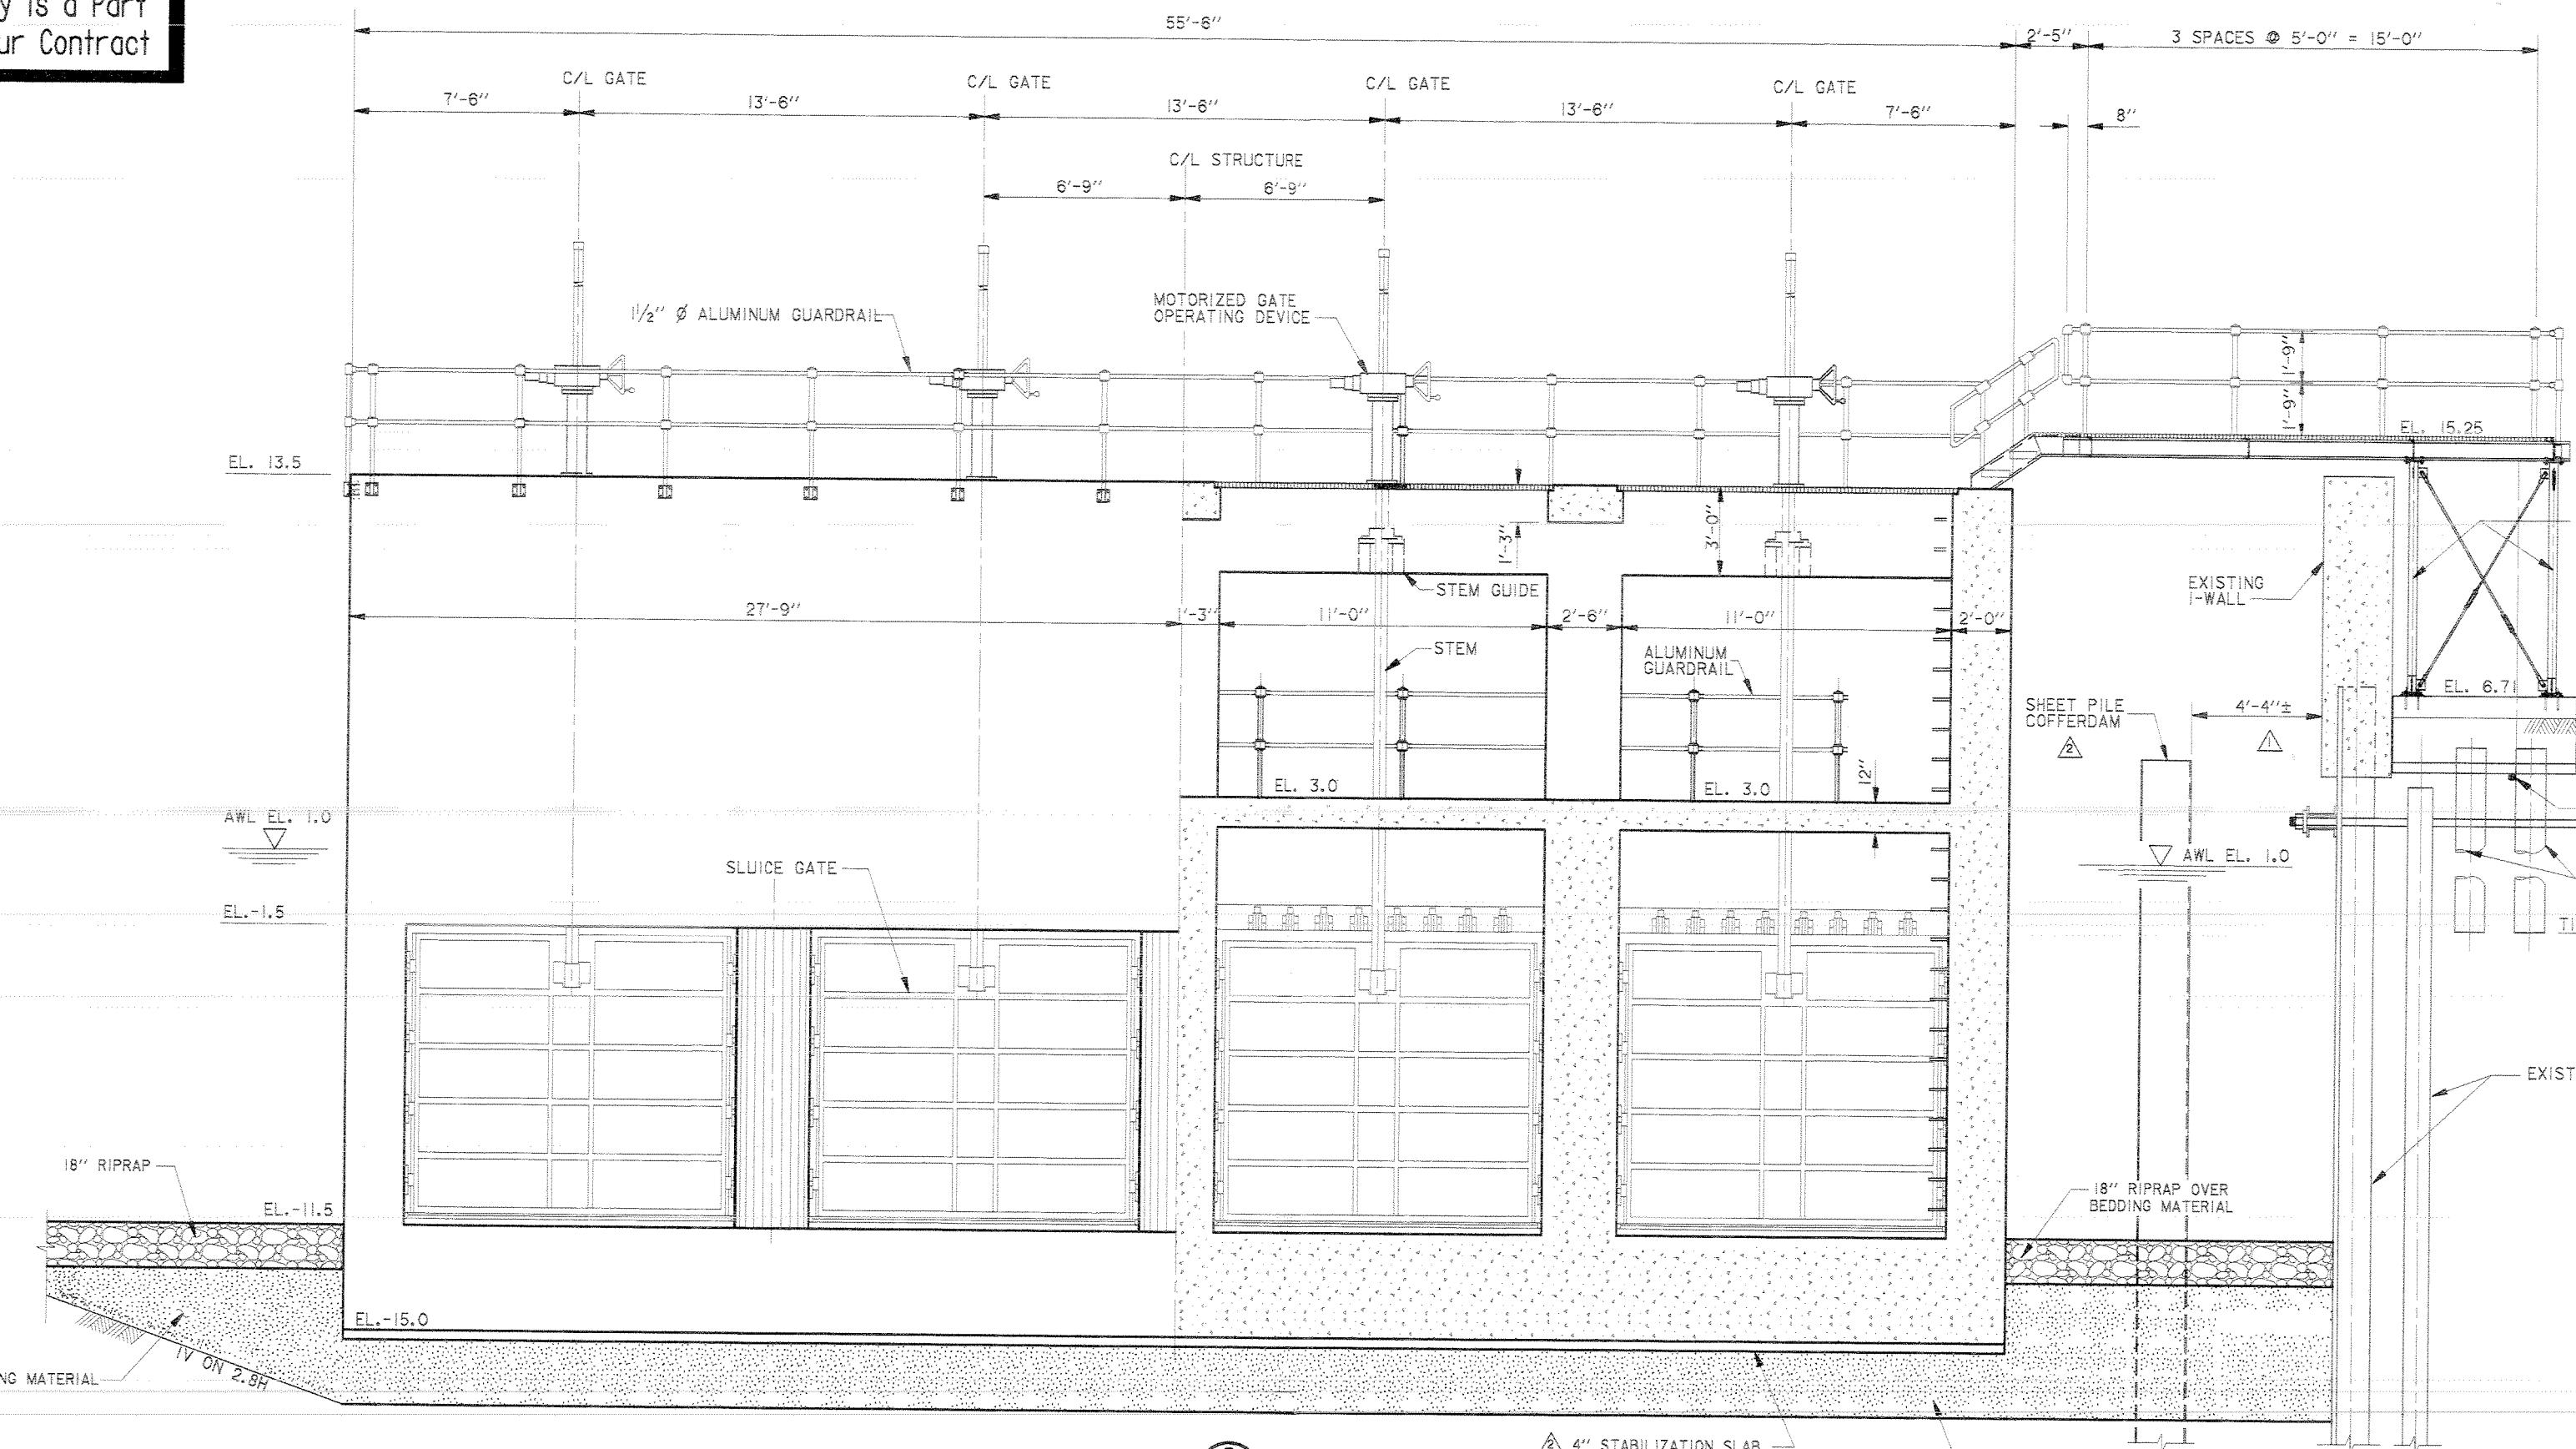

SECTION C


SCALE: $\frac{3}{8}'' = 1'-0''$

12' 0" 2' 4' 6' 8' 10'

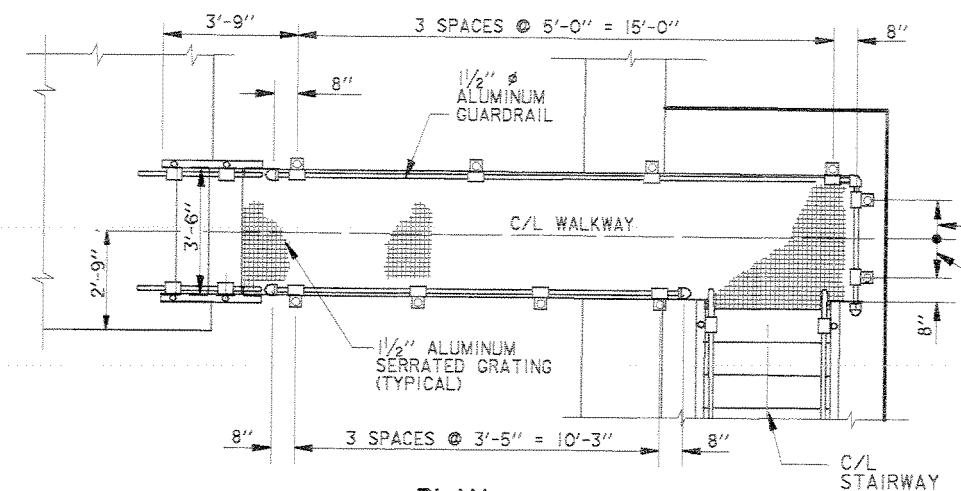

PLAN

ACCESS WALKWAY GUARDRAILING

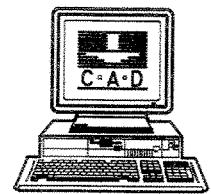

DELETED TREMIE SLAB AND DRAINAGE MATERIAL ADDED 4" STAB. SLAB	1/2/98	CAL
CORRECTED DIMENSION, AMEND #1	1/23/98	CAL
REVISIONS		
U.S. ARMY ENGINEER DISTRICT, NEW ORLEANS CORPS OF ENGINEERS NEW ORLEANS, LOUISIANA		
LAKE PONTCHARTRAIN, LA. AND VICINITY HIGH LEVEL PLAN NEW ORLEANS LAKEFRONT LEVEE WEST OF I.H.N.C.		
ORLEANS MARINA PHASE V - SLUICE GATES ORLEANS PARISH, LOUISIANA		
SLUICE GATE SECTIONAL ELEVATION		
DESIGNED BY: C. LABORDE	DATE: NOV. 1997	PLOT SCALE: 32
DRAWN BY: JCM		PLOT DATE: DEC. 1998
CHECKED BY: C. LABORDE		
SUBMITTED BY: CHARLES A. LABORDE, P.E.	SOLICITATION NO. DACW29-98-B-0001	FILE NO. H-4-44778
DESIGN ENGINEER		
	DWG.	OF 46

Safety is a Part of Your Contract

C/L

1" Ø GALV. STEEL
RUNGS, 12' O.C.

VARIABLES FROM
10½" AT ELEV. 11.5
TO 12" AT ELEV. +2.0

1'-6" 6" 5'-3"
12" 3'-7" 2'-8"
1'-4" 2' 12' - 6" 12' - 6"

162° 47' 4C
4-2½"

169° 59' 08"
4-3¾"

4-2½"

41-2½"

63½"

11-1"

SECTION POINT

NOTE: ALL DIMENSIONS INCLUDE
1/2" EXPANSION JOINT


This figure shows a detailed architectural floor plan of a building section. The overall width of the section is 27'-0". The plan includes a central rectangular room with a width of 12'-6" and a depth of 27'-0". To the right of this room is a large, irregularly shaped room with a height of 163° 44' 23". The plan also features several smaller rooms and a central corridor. Various dimensions are indicated throughout the plan, such as 3'-0", 6", 3'-0", 4'-0", 6", 1'-6", 6", 2'-9", 2'-6", 3'-3", 3'-0", 6", 1'-6", 6", and 1'-3". A note on the right side states "VARIES FROM".

This architectural floor plan illustrates a building section with various dimensions and features:

- The overall width of the main rectangular section is 16'-3".
- The height of the main rectangular section is 3'-0".
- The total height of the entire section, including the rounded end, is 6'-0".
- The width of the rounded end is 2'-6".
- The height of the rounded end is 5'-3".
- The distance from the center of the rounded end to the vertical wall is 1'-6".
- The distance from the vertical wall to the right edge of the main rectangle is 6".
- The distance from the left edge of the main rectangle to the vertical wall is 6".
- The height of the vertical wall is 3'-0".
- The width of the vertical wall is 2'-6".
- The angle of the rounded end is specified as 63° 44' 23".
- A north arrow indicates the orientation, labeled "N 11° 30' E".
- A small circle with "P" inside is located near the top of the vertical wall.
- A small circle with "R" inside is located at the bottom right corner of the main rectangle.

PLAN

SCALE: $\frac{1}{2}'' = 1'-0''$

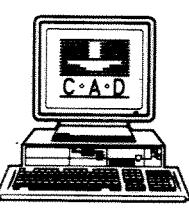

REVISIONS

U.S. ARMY ENGINEER DISTRICT, NEW ORLEANS

CORPS OF ENGINEERS

NEW ORLEANS, LOUISIANA

LAKE PONTCHARTRAIN, LA. AND VICINITY

HIGH LEVEL PLAN


NEW ORLEANS LAKEFRONT LEVEE

WEST OF I.H.N.C.


ORLEANS MARINA PHASE V - SLUICE GATES

**SLUICE GATE
WALL GEOMETRY**

DESIGNED BY: P. SCHAEFER	DATE:	PLOT SCALE:	PLOT DATE:
DRAWN BY: V. COUVILLION	NOV. 1997	24	DEC. 15, 1997
CHECKED BY: C. LABORDE	FILE NO.		
	H-4-44778		
SUBMITTED BY: CHARLES A. LABORDE, P.E. DESIGN ENGINEER	SOLICITATION NO. DACW29-98-B-0001		DWG. 12 OF 46

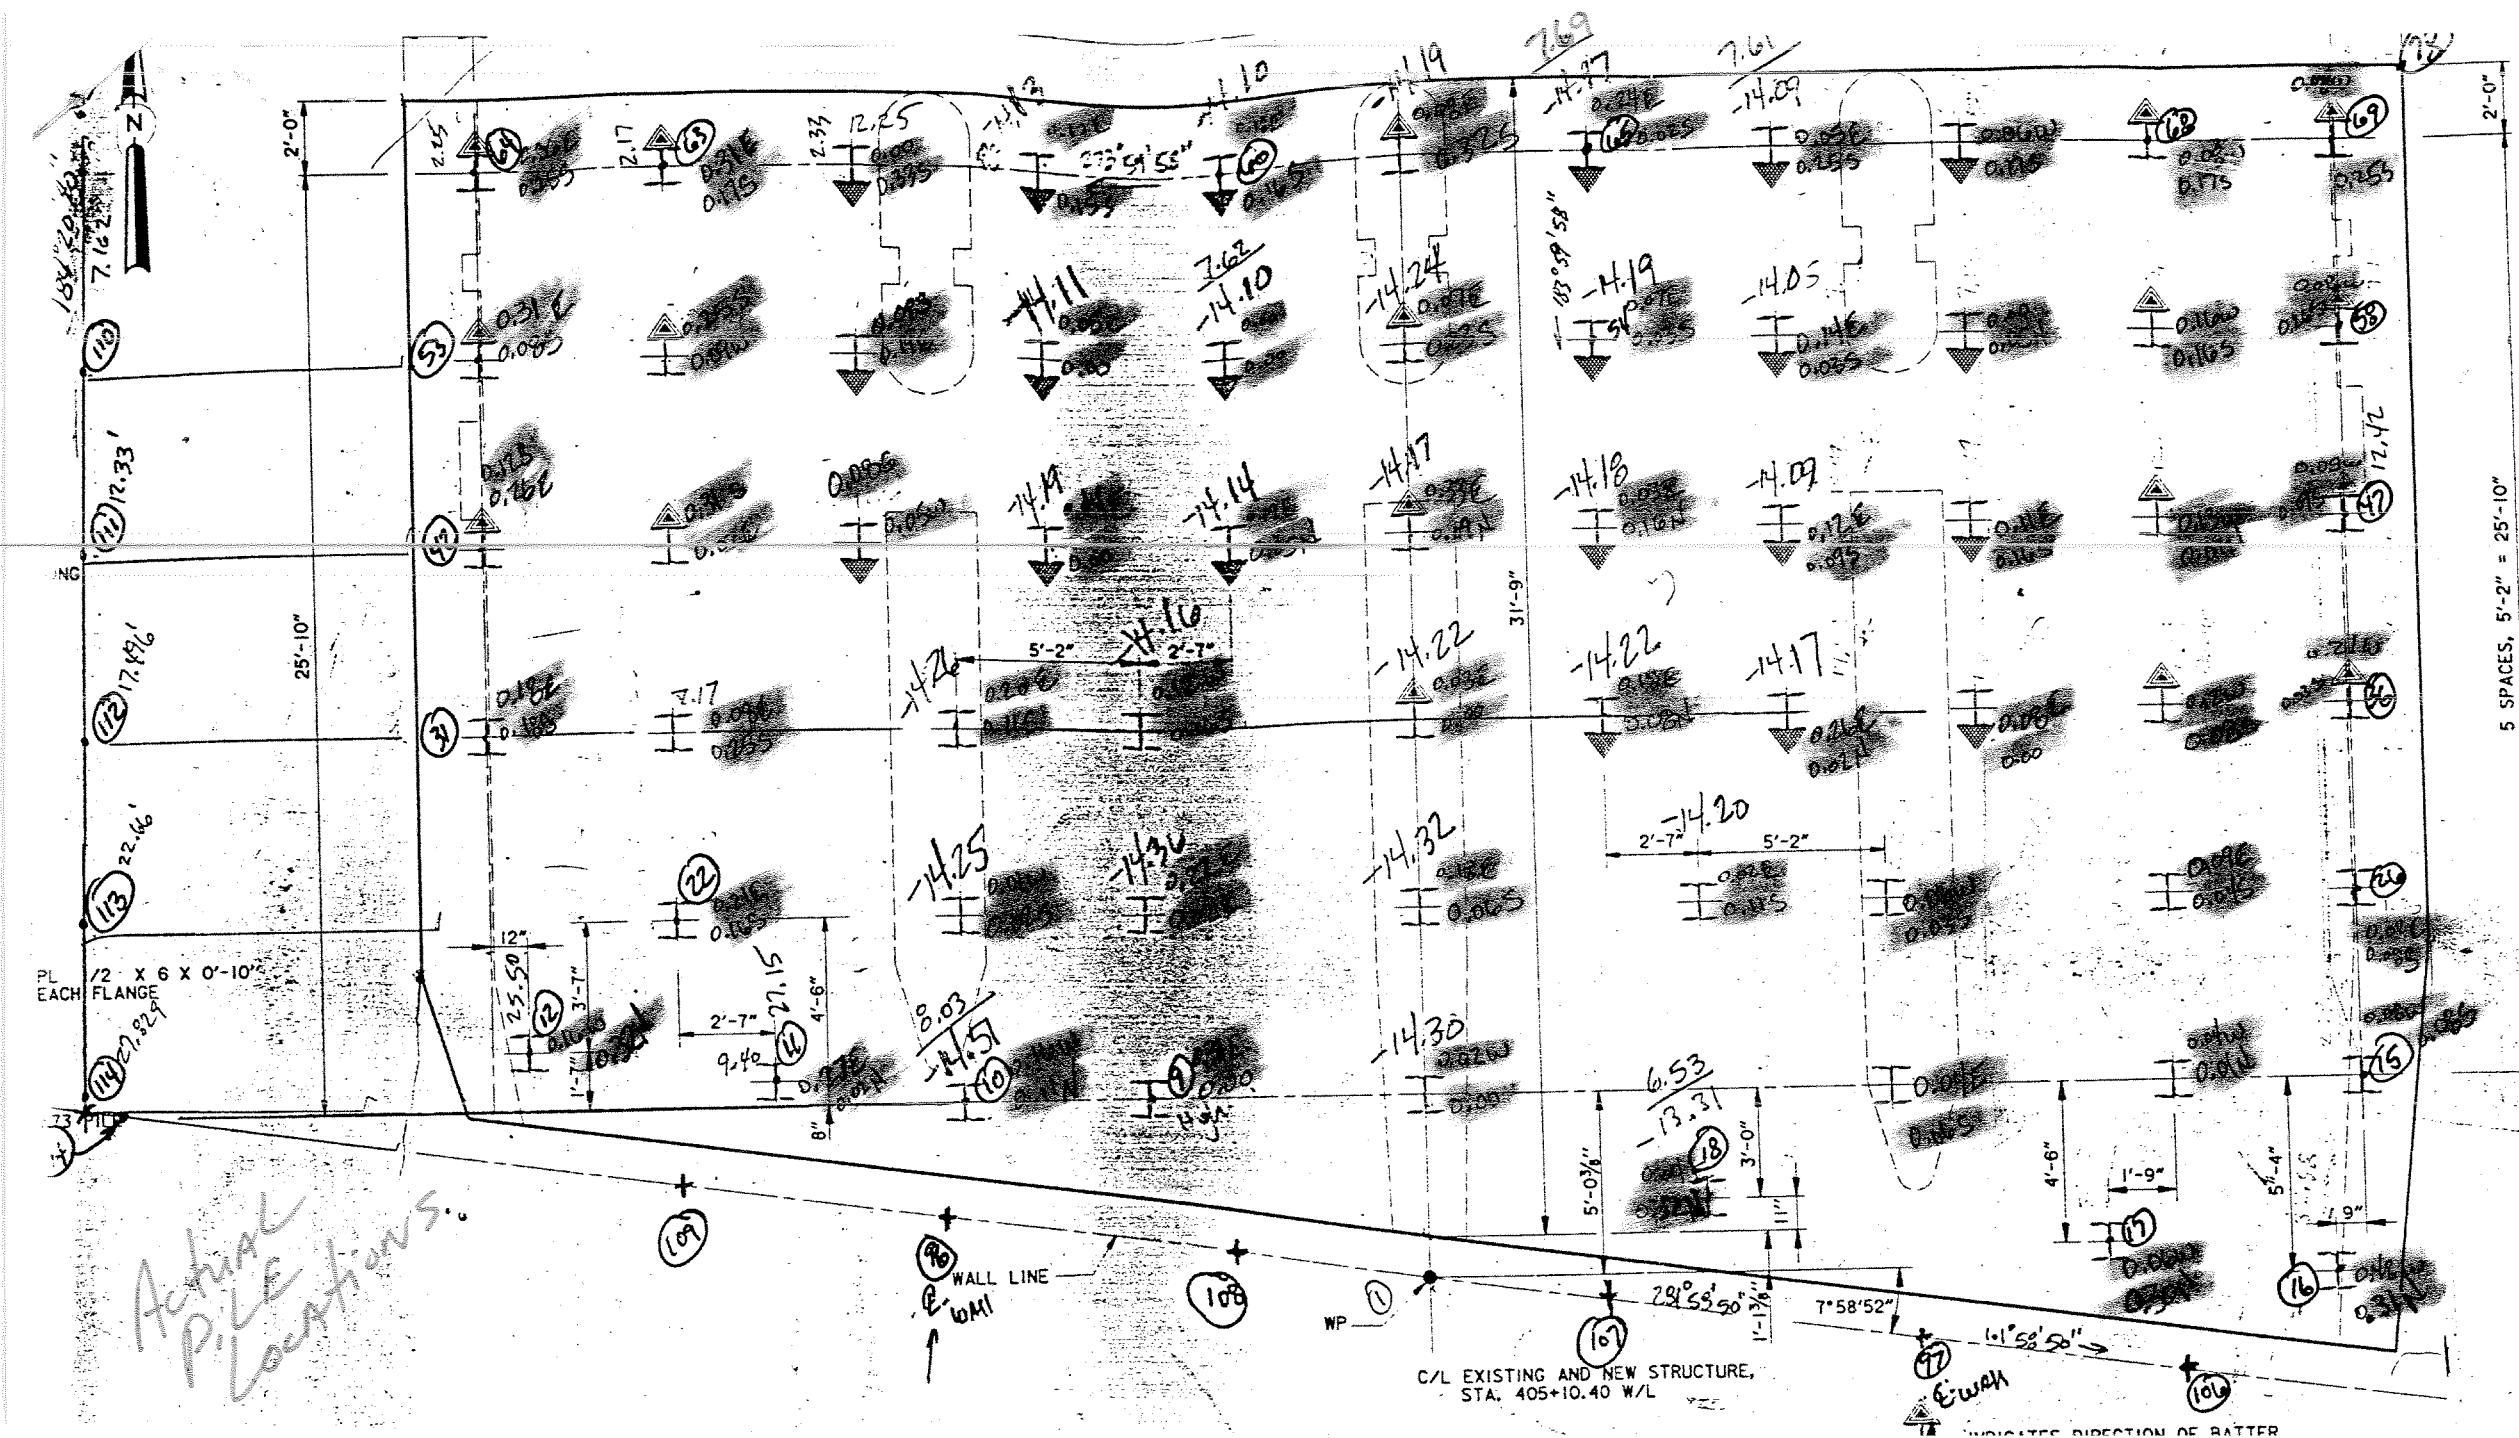

Safety is a Part of Your Contract

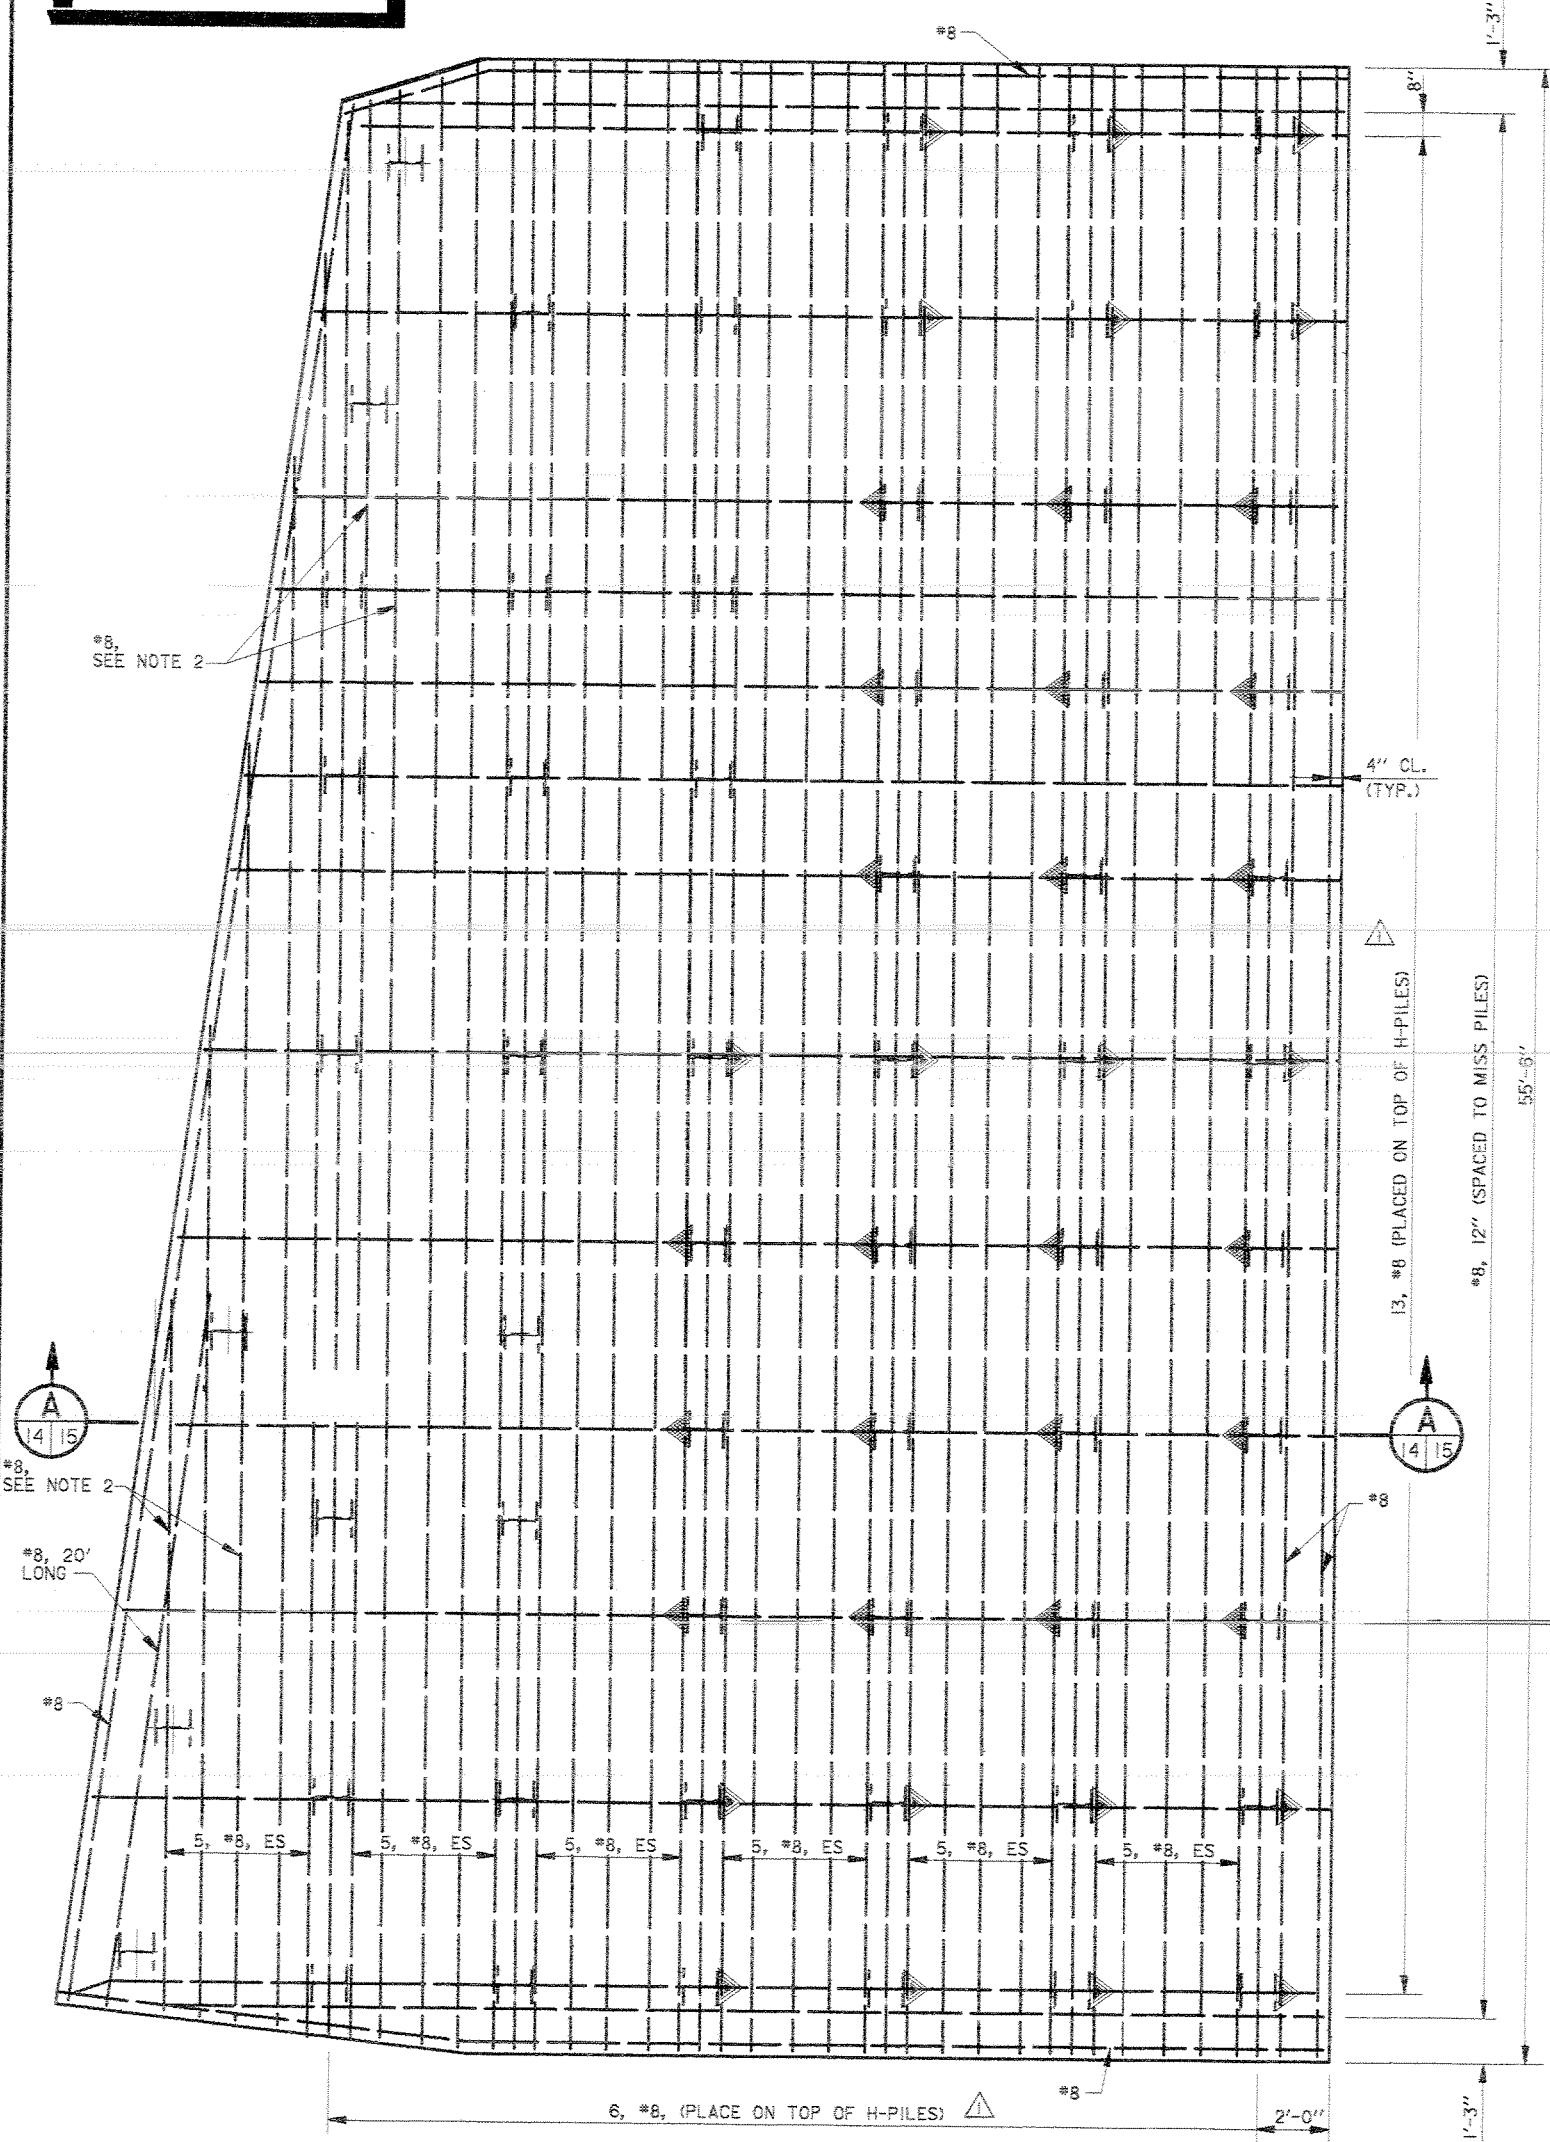


BOTTOM FACE

PLAN REINFORCEMENT

NOTES :

1. FOR FILE LAYOUT SEE DWG.13
2. *8, CONTINUOUS THROUGH H-PILE
WEB, BURN 2" & MAX HOLE IN
WEB TO PASS REINFORCEMENT

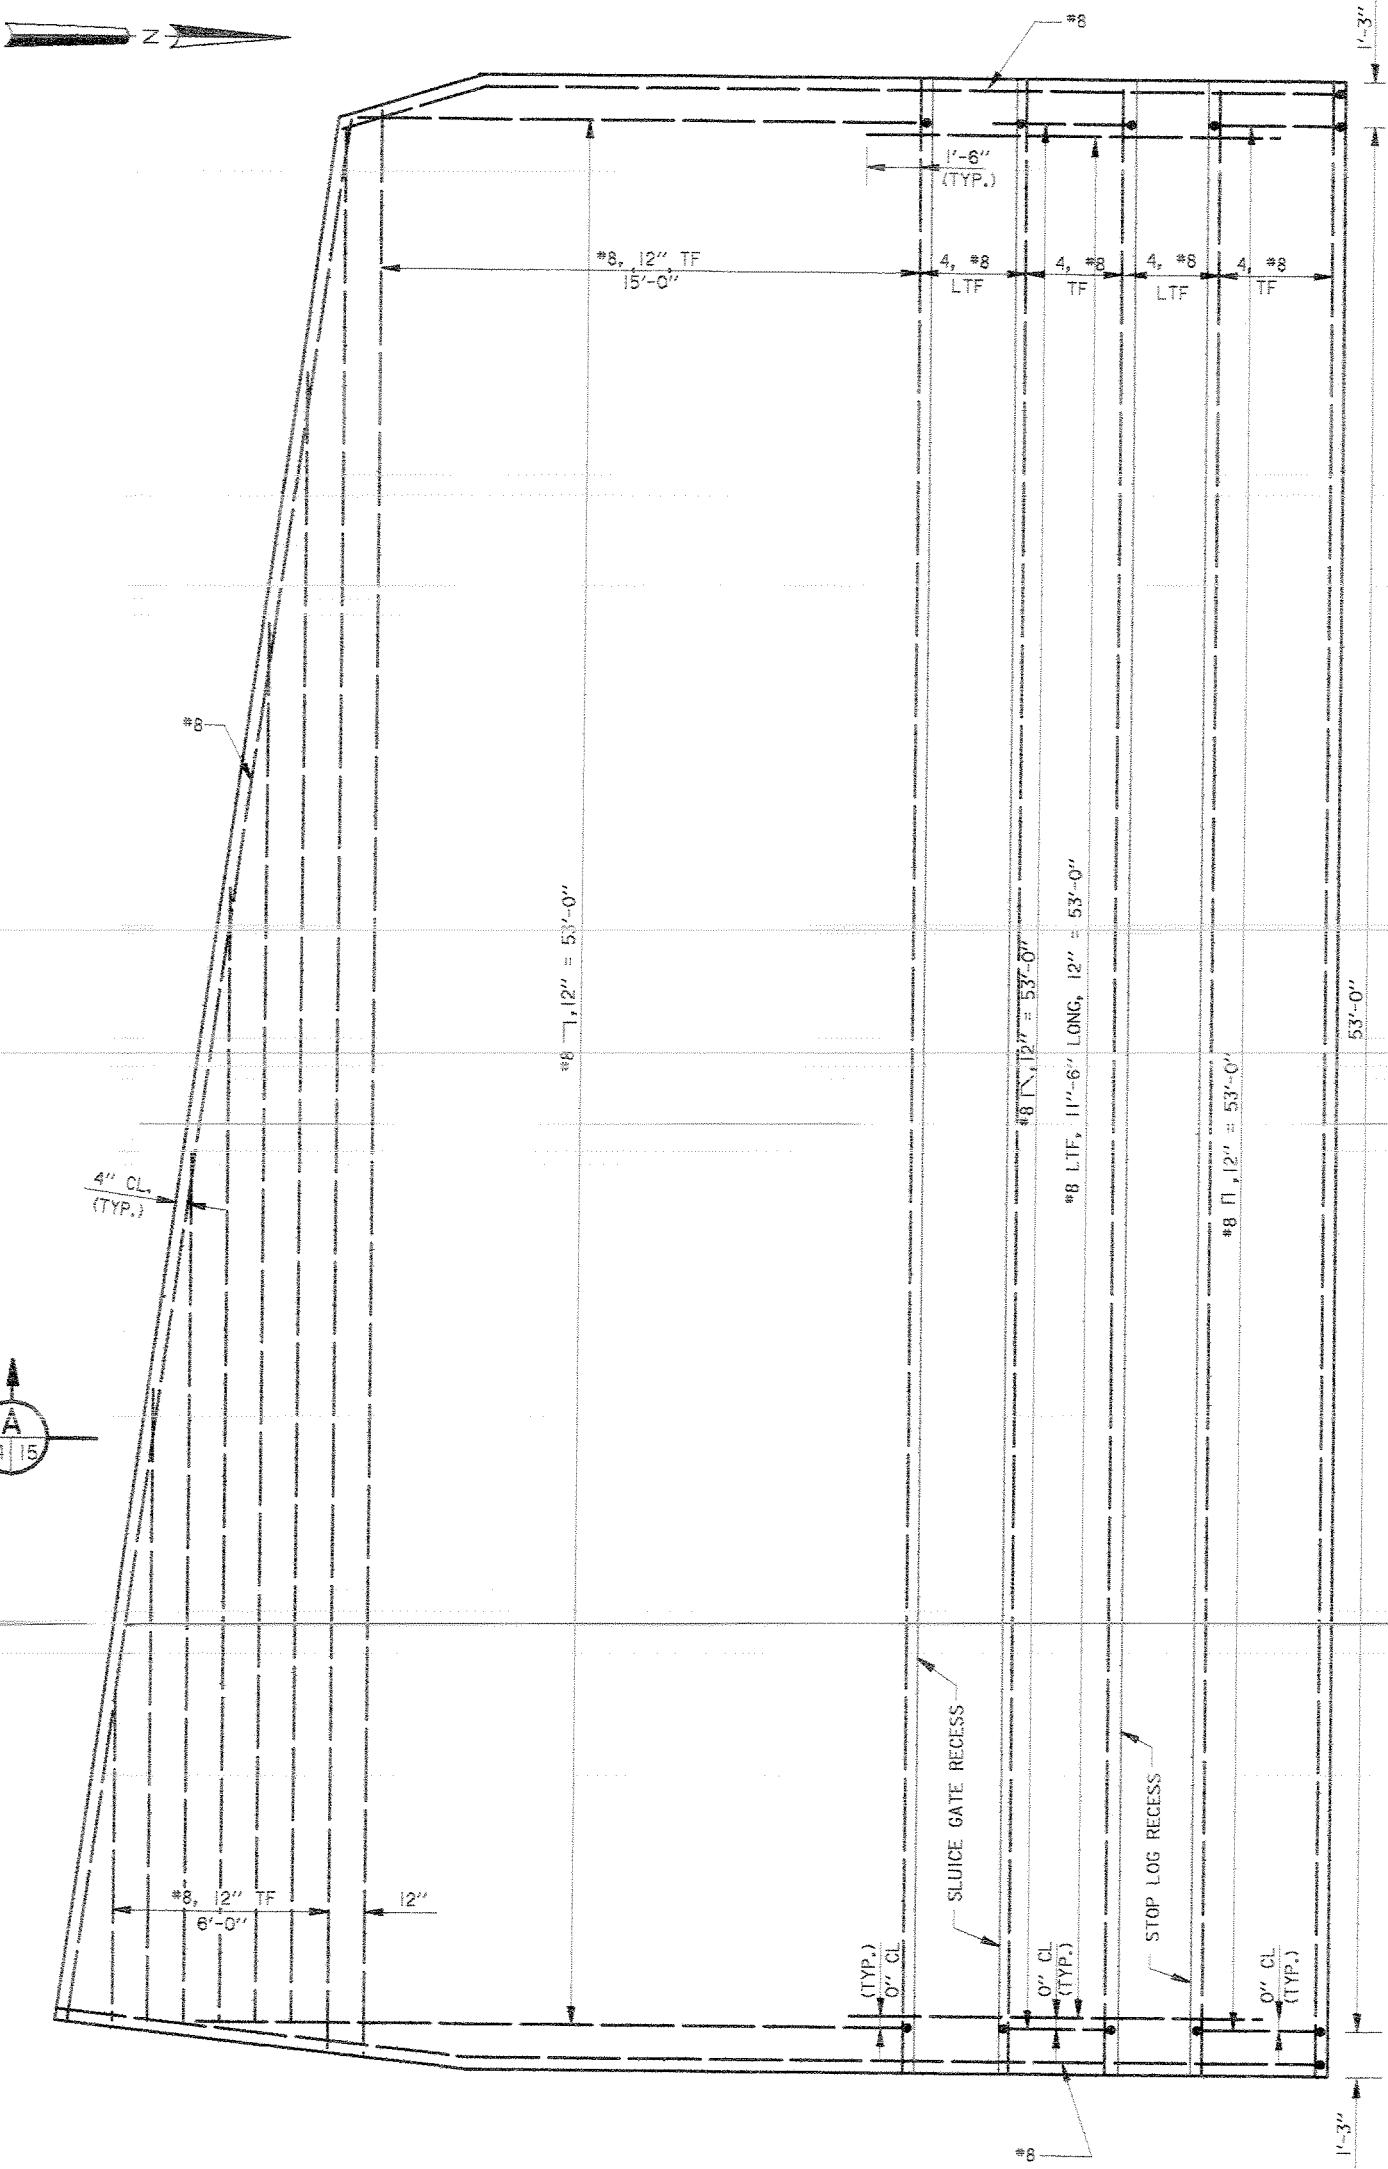


TOP FACE

SCALE: $\frac{3}{8}'' = 1'-0''$



Safety is a Part of Your Contract

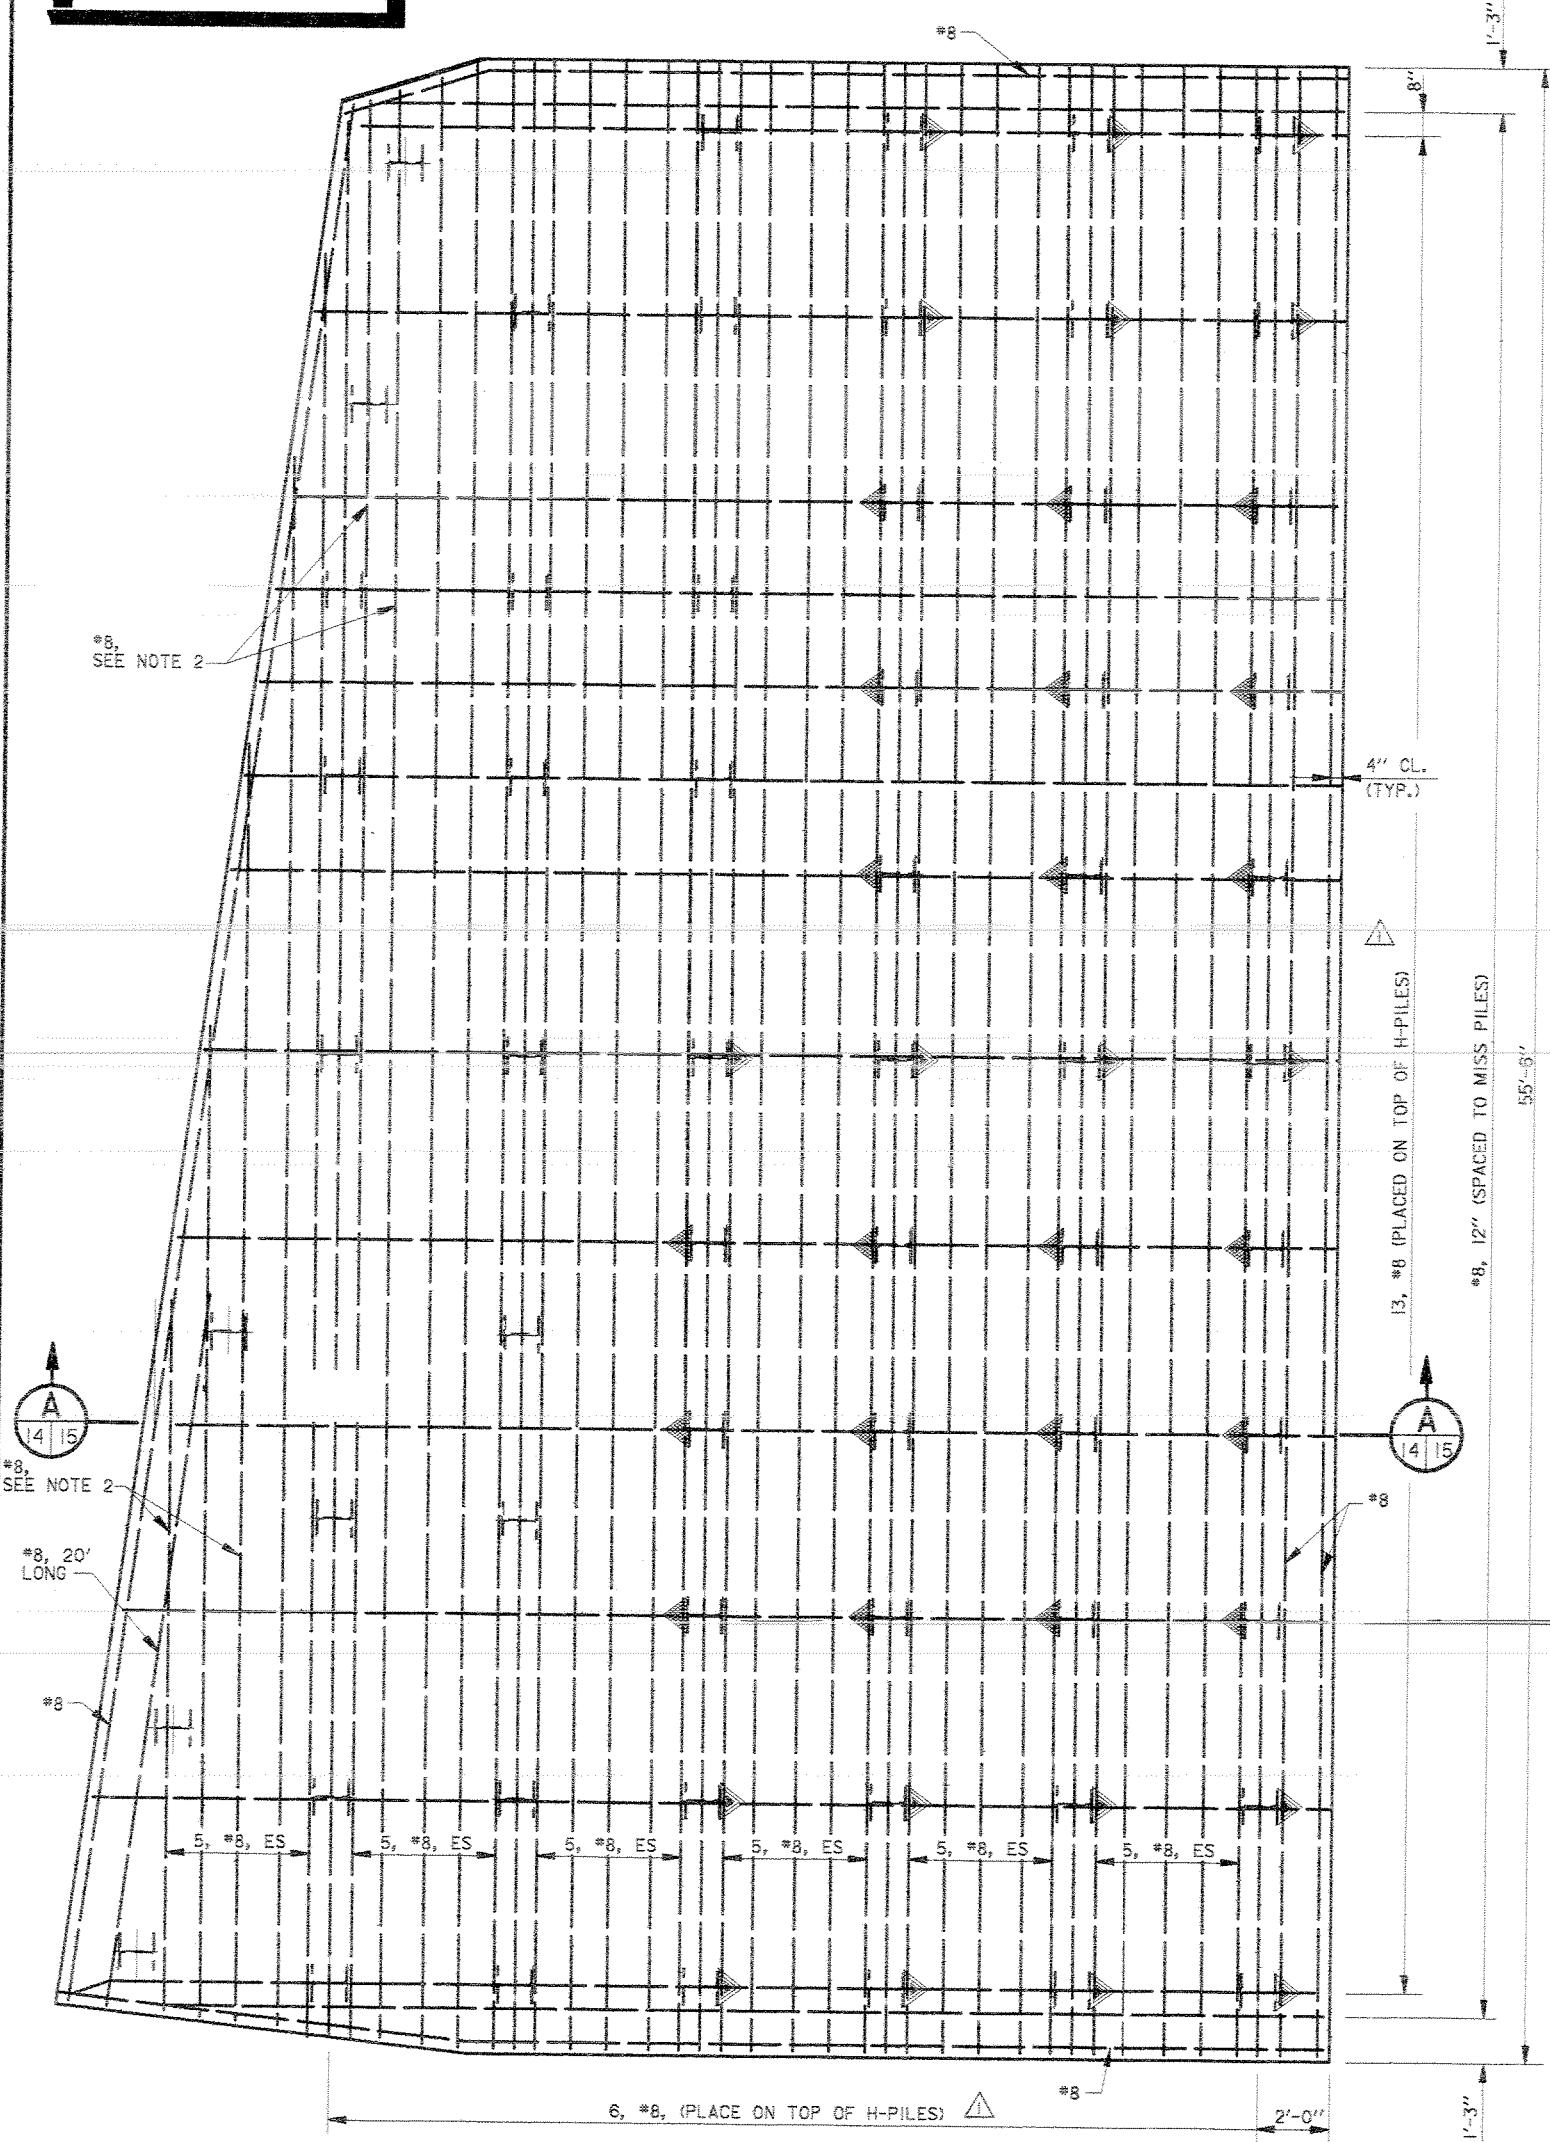


BOTTOM FACE

PLAN REINFORCEMENT

NOTES :

1. FOR FILE LAYOUT SEE DWG.13
2. *8, CONTINUOUS THROUGH H-PILE
WEB, BURN 2" & MAX HOLE IN
WEB TO PASS REINFORCEMENT

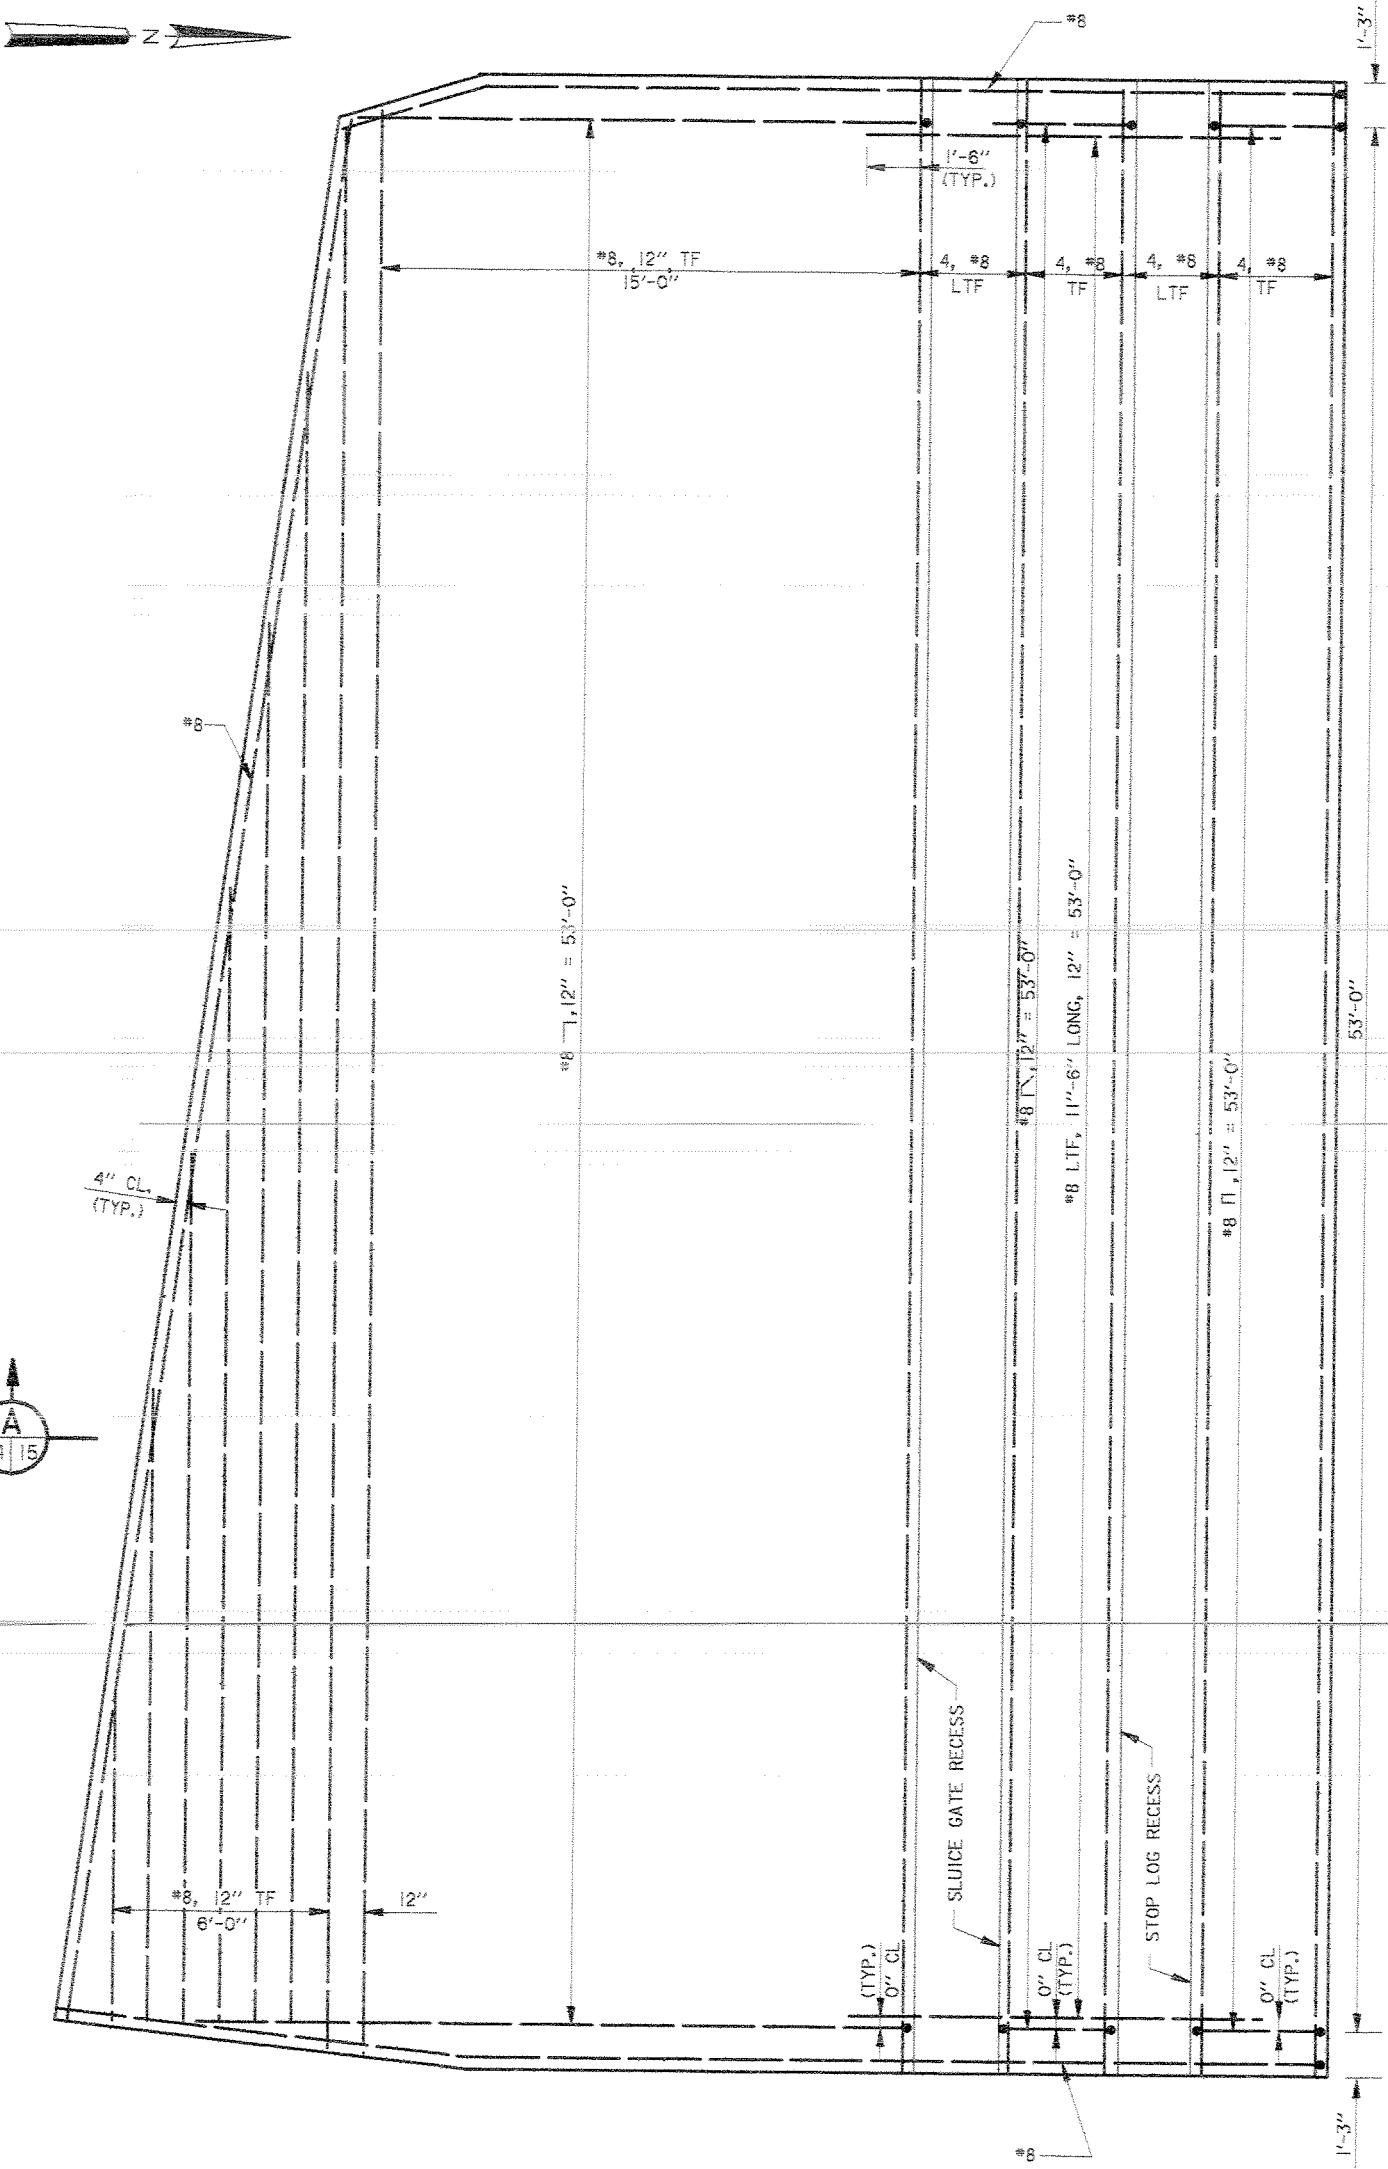


TOP FACE

SCALE: $\frac{3}{8}'' = 1'-0''$



SCALE: $\frac{3}{8}'' = 1'-0''$			
12"	0	2'	4'
6'		8'	10'
	ADDED BARS TO TOP OF FILES	DEC 98	CAL
SYMBOL	DESCRIPTION	DATE	APPROVED
REVISIONS			
U.S. ARMY ENGINEER DISTRICT, NEW ORLEANS CORPS OF ENGINEERS NEW ORLEANS, LOUISIANA			
LAKE PONTCHARTRAIN, LA. AND VICINITY HIGH LEVEL PLAN NEW ORLEANS LAKEFRONT LEVEE WEST OF I.H.N.C. NEW ORLEANS MARINA PHASE V - SLUICE GATES ORLEANS PARISH, LOUISIANA			
BASE SLAB REINFORCEMENT			
DESIGNED BY: C. LABORDE	DATE: NOV. 1997	PLOT SCALE: 32	PLOT DATE: DEC. 18, 1998
DRAWN BY: L. MAGEE	CAD FILE: 44778001.DGN FILE NO.: H-4-44778		
CHECKED BY: C. LABORDE			
SUBMITTED BY: CHARLES A. LABORDE, P.E. DESIGN ENGINEER	SOLICITATION NO. DACW29-98-B-0001	DWG. 14	OF 46


Safety is a Part
of Your Contract

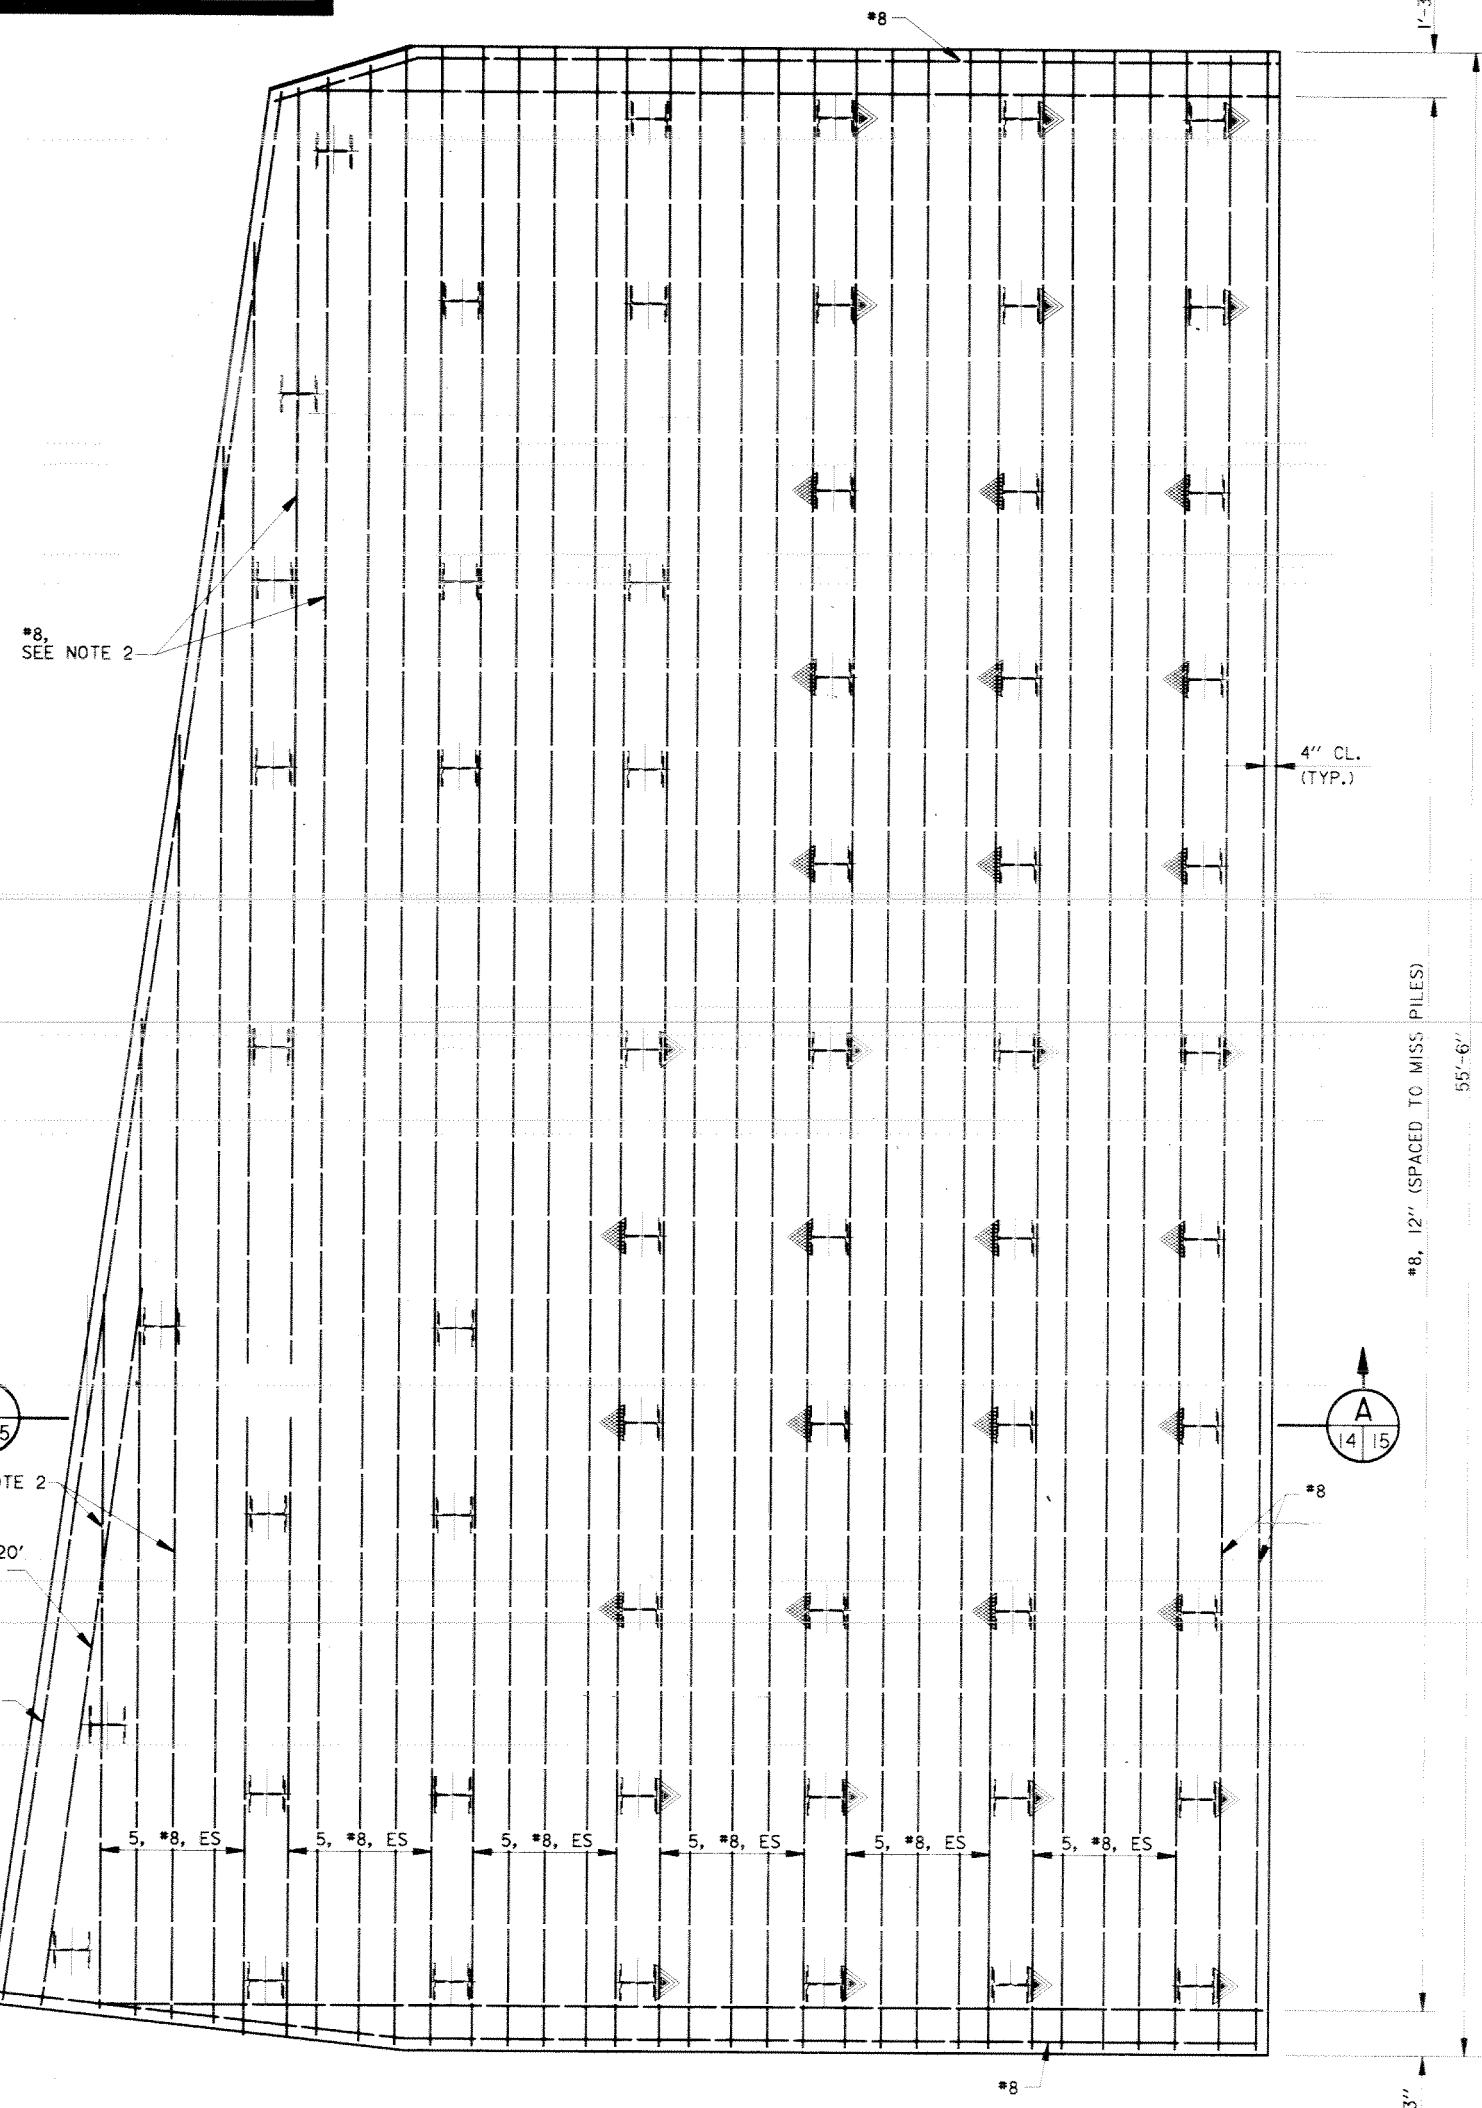

- NOTES :
1. FOR PILE LAYOUT SEE DWG.13
 2. *8, CONTINUOUS THROUGH H-PILE WEB. BURN 2" # MAX HOLE IN WEB TO PASS REINFORCEMENT

BOTTOM FACE


PLAN REINFORCEMENT

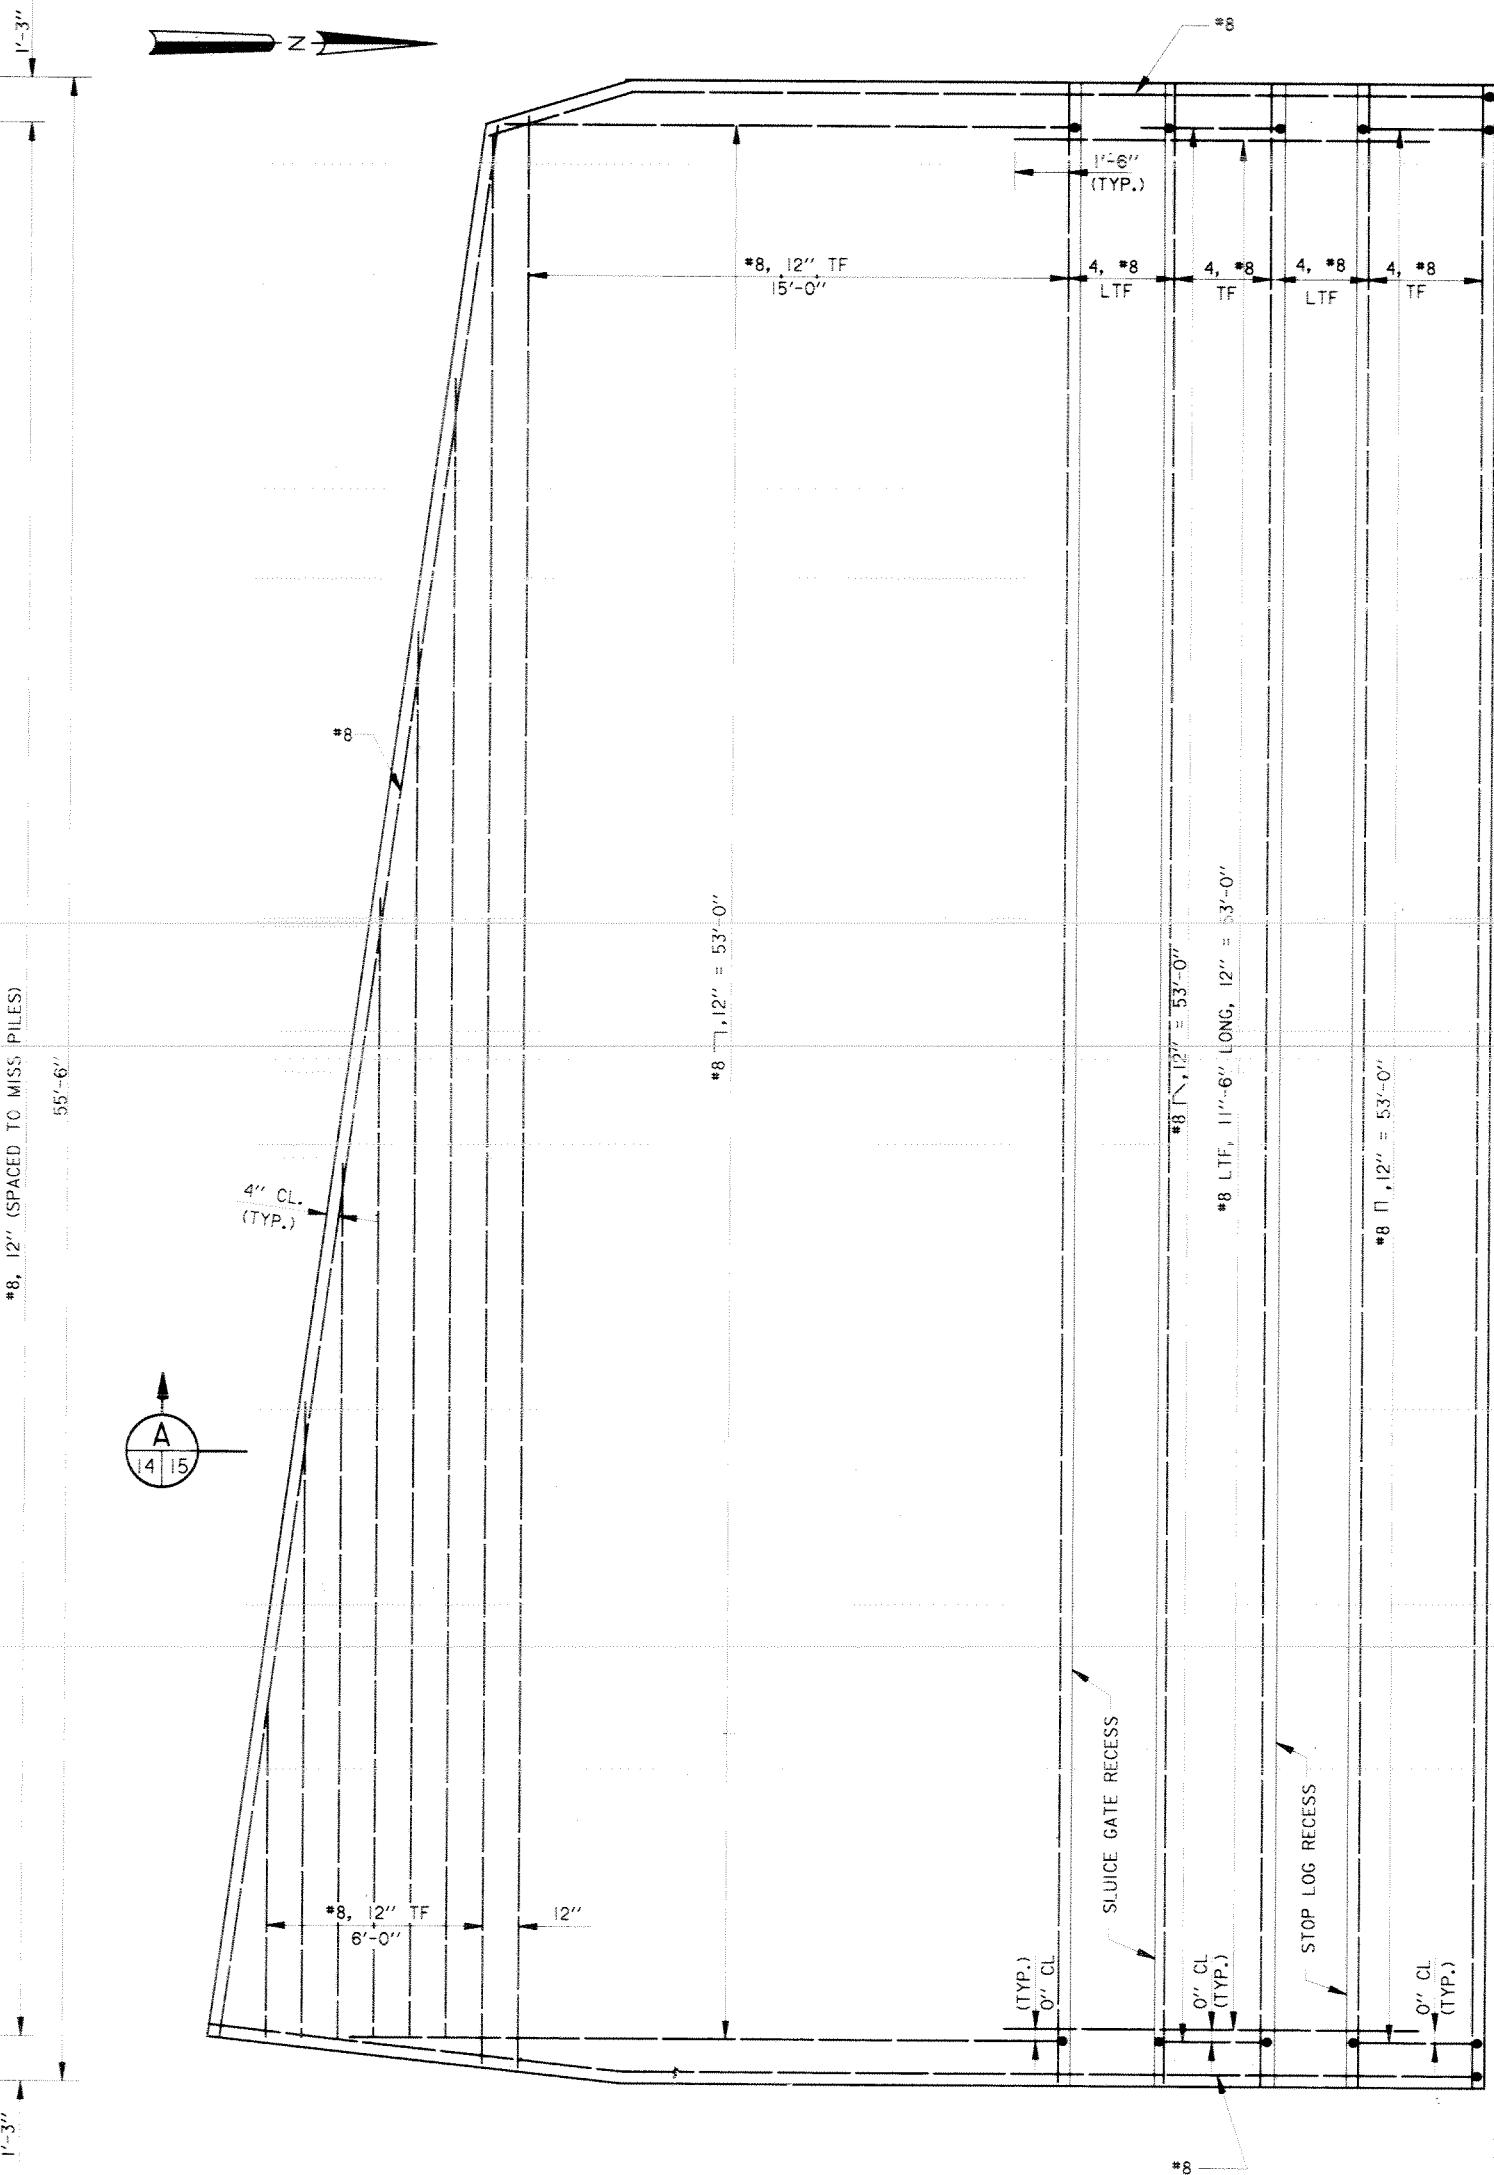

TOP FACE





PLAN REINFORCEMENT

SCALE: $\frac{3}{8}'' = 1'-0''$

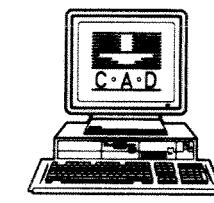


SYMBOL	DESCRIPTION	DATE	APPROVED
	U.S. ARMY ENGINEER DISTRICT, NEW ORLEANS CORPS OF ENGINEERS NEW ORLEANS, LOUISIANA		
LAKE PONTCHARTRAIN, LA. AND VICINITY HIGH LEVEL PLAN NEW ORLEANS LAKEFRONT LEVEE WEST OF I.H.N.C.			
ORLEANS MARINA PHASE V - SLUICE GATES ORLEANS PARISH, LOUISIANA			
BASE SLAB REINFORCEMENT			
DESIGNED BY: C. LABORDE DRAWN BY: L. MAGEE CHECKED BY: C. LABORDE SUBMITTED BY: CHARLES A. LABORDE, P.E. SOLICITATION NO. DACW29-98-B-0001 DESIGN ENGINEER		PLOT SCALE: NOV. 10, 1997 32 FILE NO. H-4-44778	PLOT DATE: NOV. 10, 1997 FILE NO. H-4-44778

Safety is a Part
of Your Contract

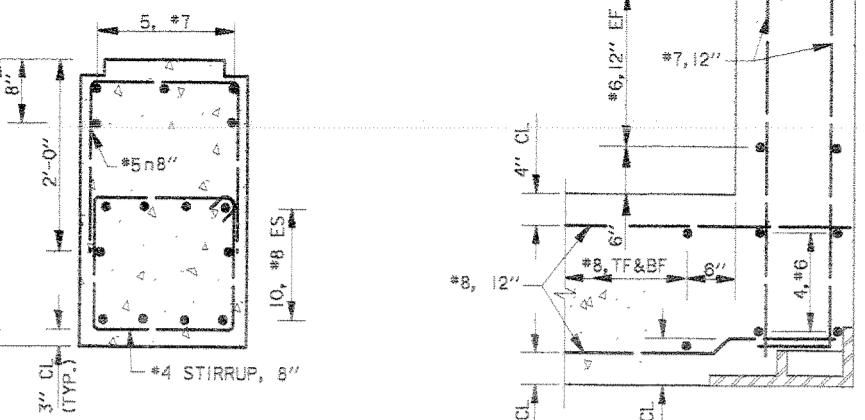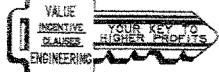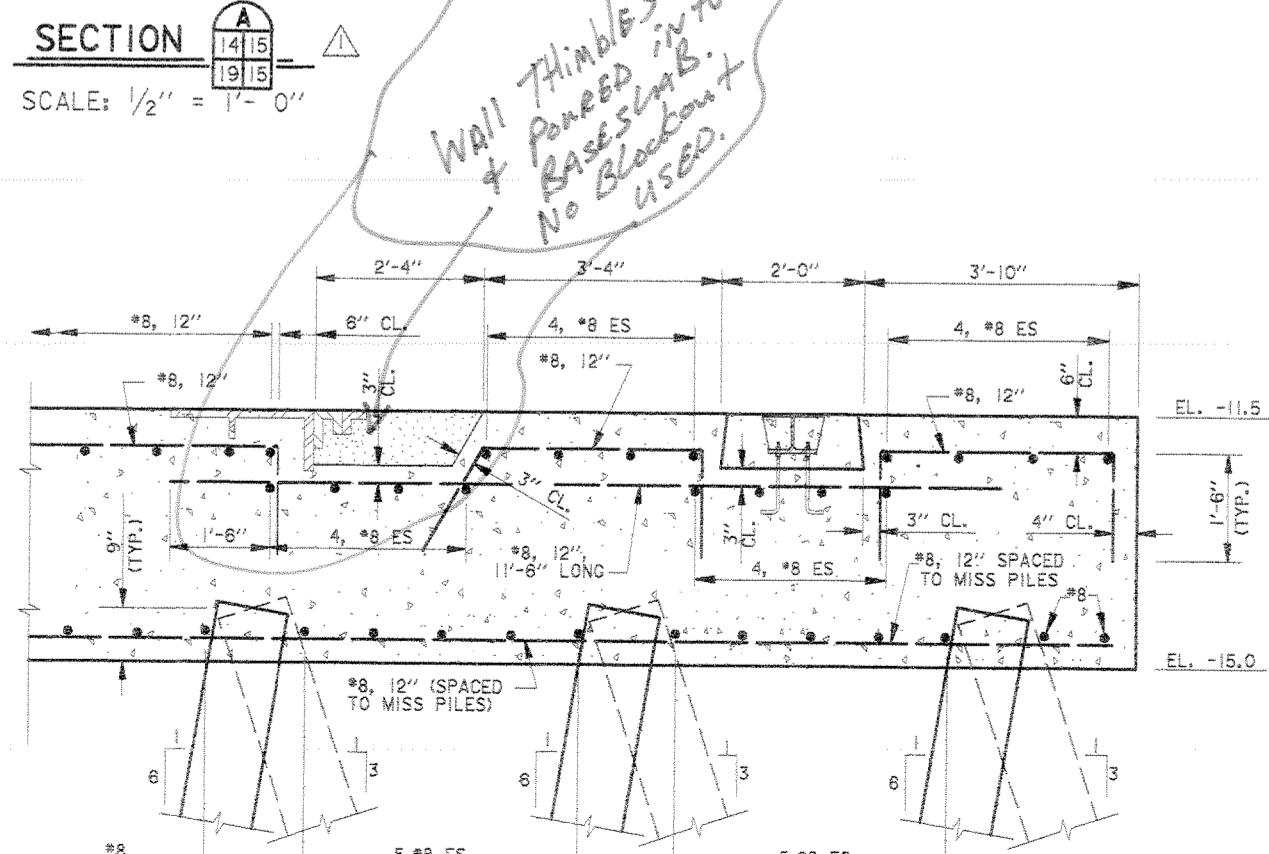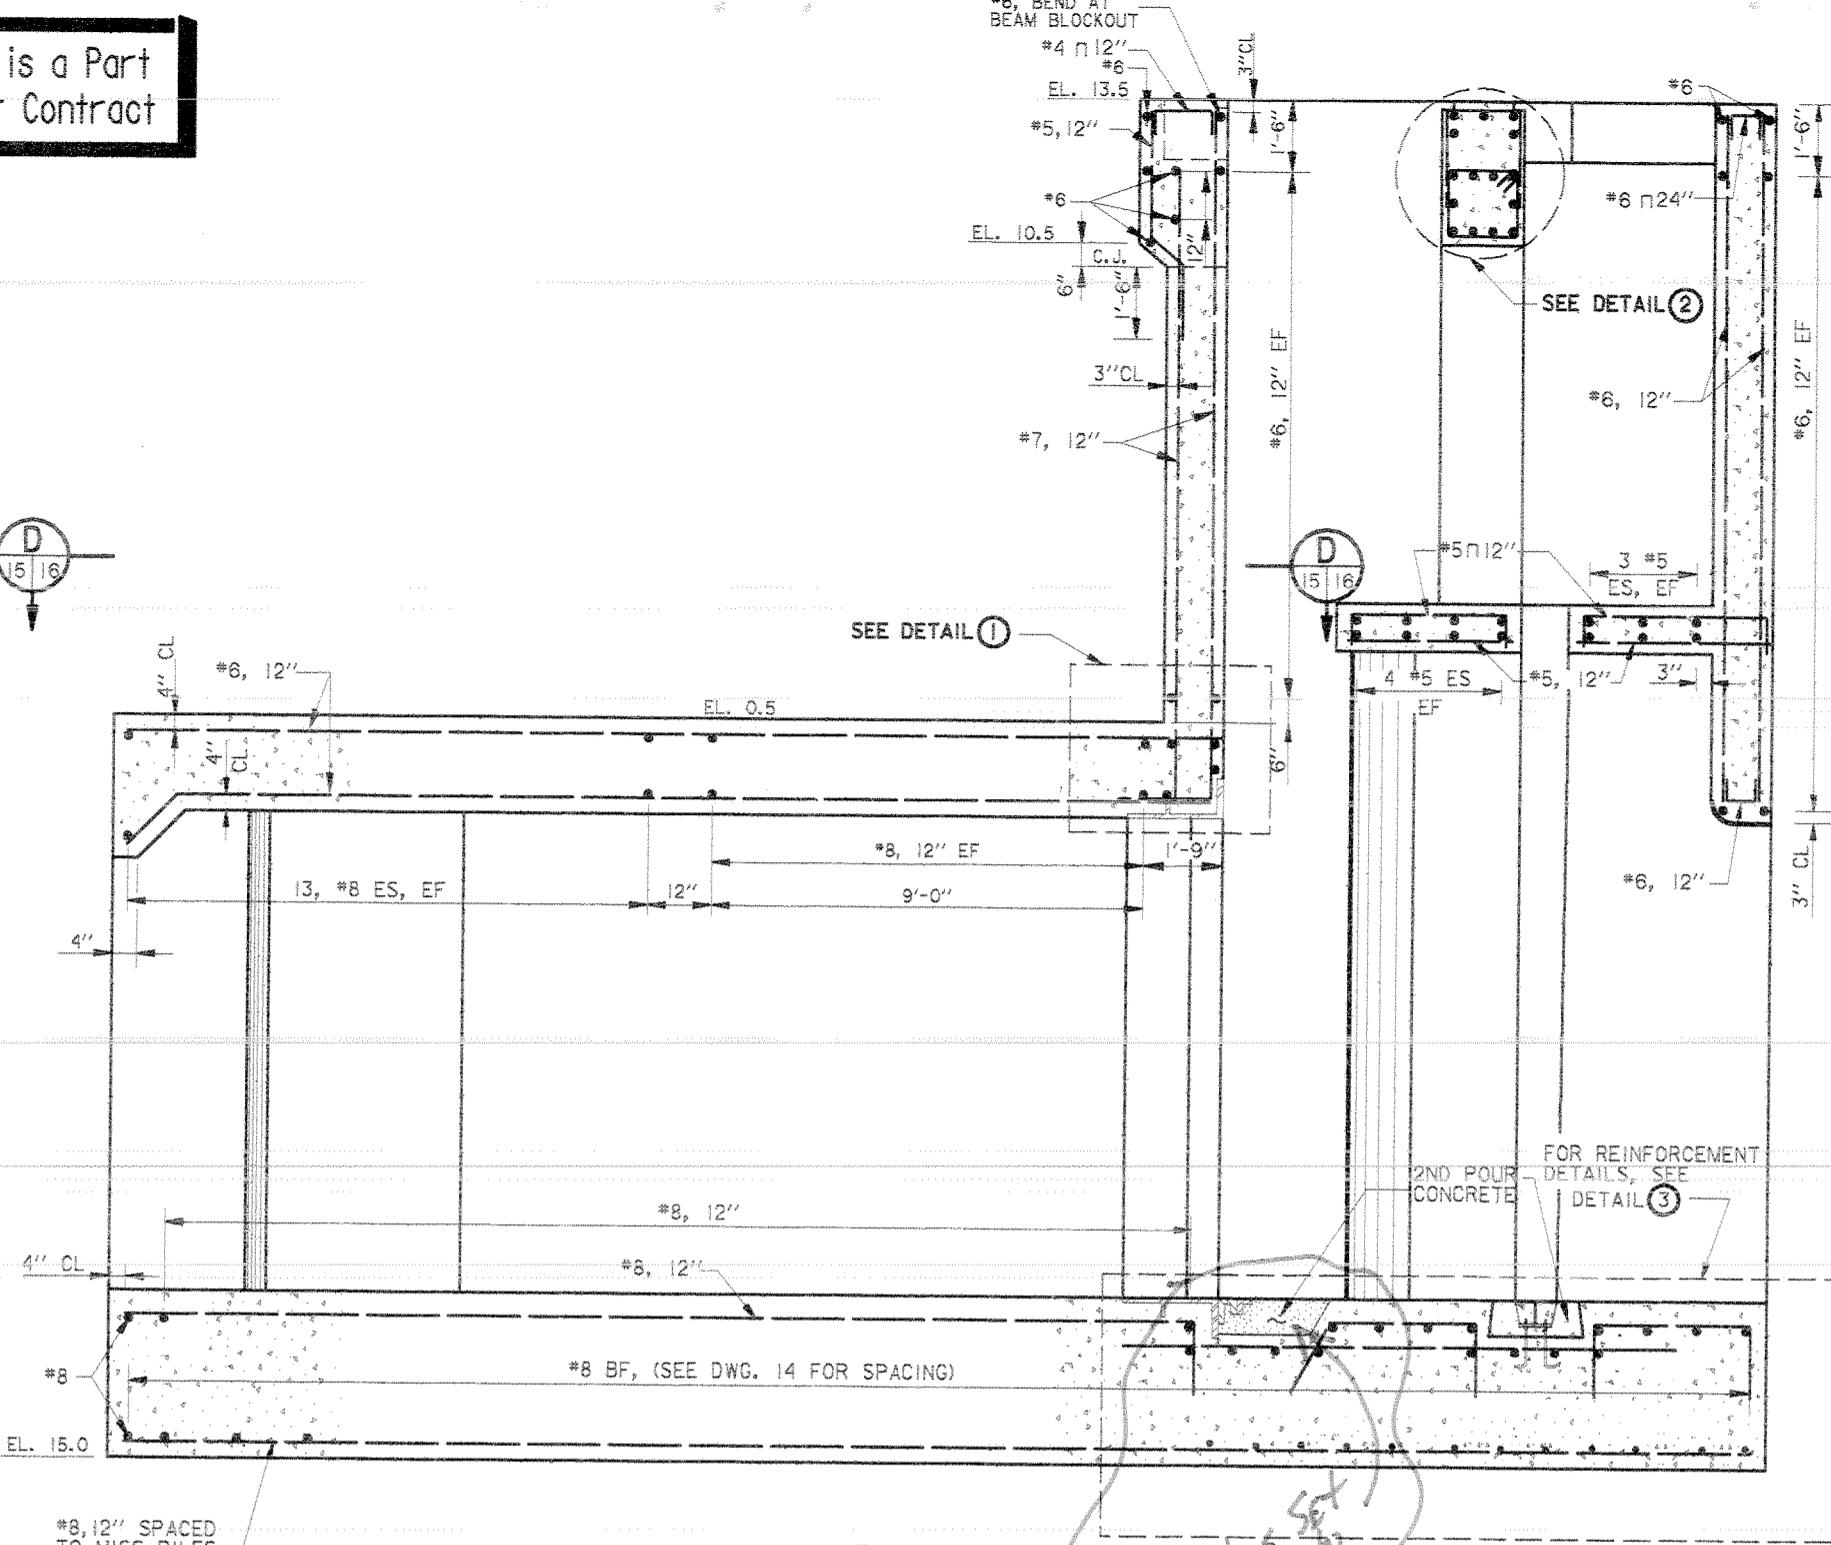

DETAIL 2
SCALE: $\frac{1}{2}'' = 1'-0''$

DETAIL 1
SCALE: $\frac{1}{2}'' = 1'-0''$

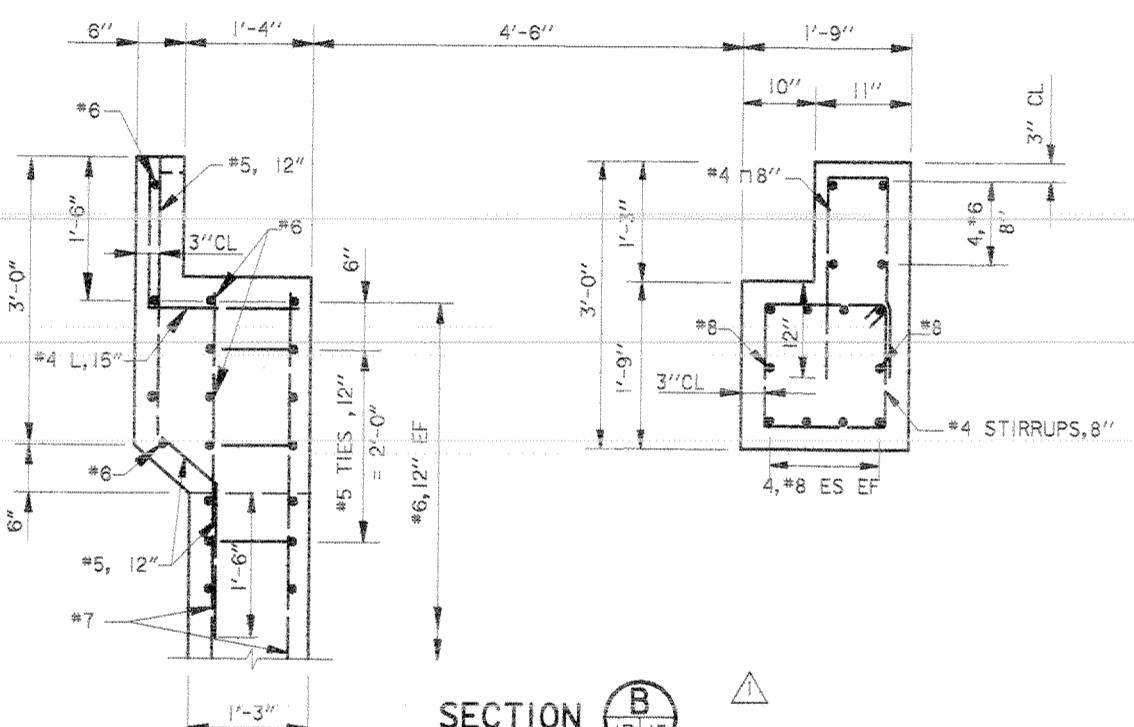

SECTION B
SCALE: $\frac{1}{2}'' = 1'-0''$

SECTION B
SCALE: $\frac{3}{4}'' = 1'-0''$

SECTION B
SCALE: $\frac{1}{2}'' = 1'-0''$

SECTION B
SCALE: $\frac{1}{2}'' = 1'-0''$

MODIFIED WALL GEOMETRY AND
REINFORCEMENT IN CONJUNCTION WITH CHANGES TO HOIST BEAM.
2/1/99 CAL


SYMBOL DESCRIPTION DATE APPROVED

REVISONS


U.S. ARMY ENGINEER DISTRICT, NEW ORLEANS
CORPS OF ENGINEERS
NEW ORLEANS, LOUISIANA
LAKE PONTCHARTRAIN, LA. AND VICINITY
HIGH LEVEL PLAN
NEW ORLEANS LAKEFRONT LEVEE
WEST OF I.H.N.C.
ORLEANS MARINA PHASE V - SLUICE GATES
ORLEANS PARISH, LOUISIANA

REINFORCEMENT SECTIONS (SHT 1 OF 6)


DESIGNED BY:	C. LABORDE	DATE:	PLOT SCALE:	PLOT DATE:
DRAWN BY:	J.C.M.	NOV. 1997	16	FEB. 1, 1998
CHECKED BY:	C. LABORDE			
SUBMITTED BY:	CHARLES A. LABORDE, P.E.			
DESIGN ENGINEER				
	SOLICITATION NO.			
	H-4-44778			
	FILE NO.			
	DACW29-98-B-0001			
	DWG. 15 OF 46			

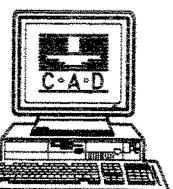


Safety is a Part of Your Contract

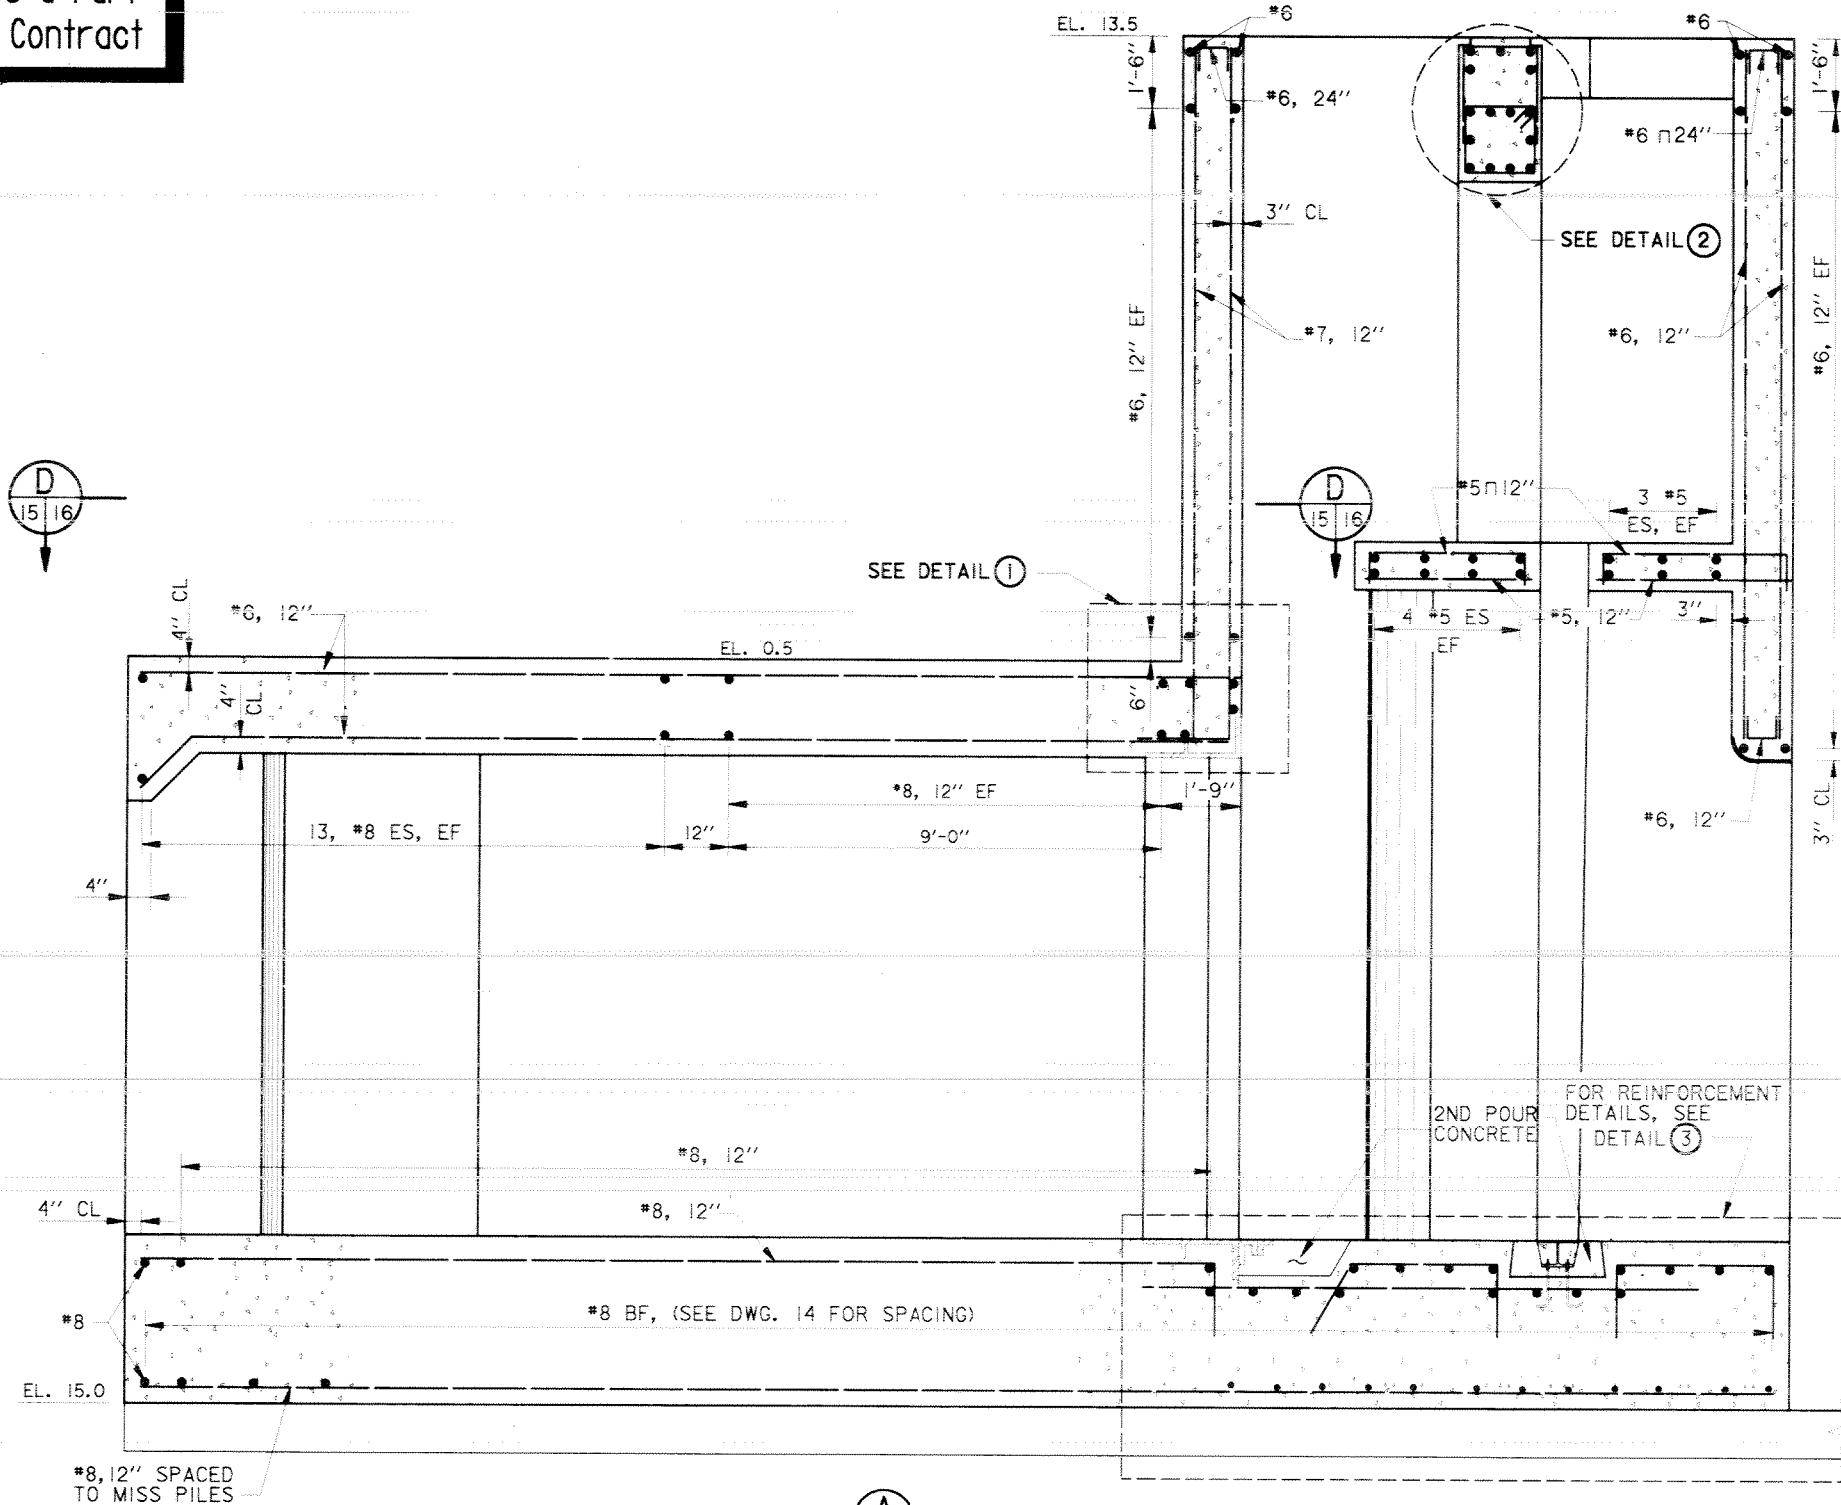


SECTION 

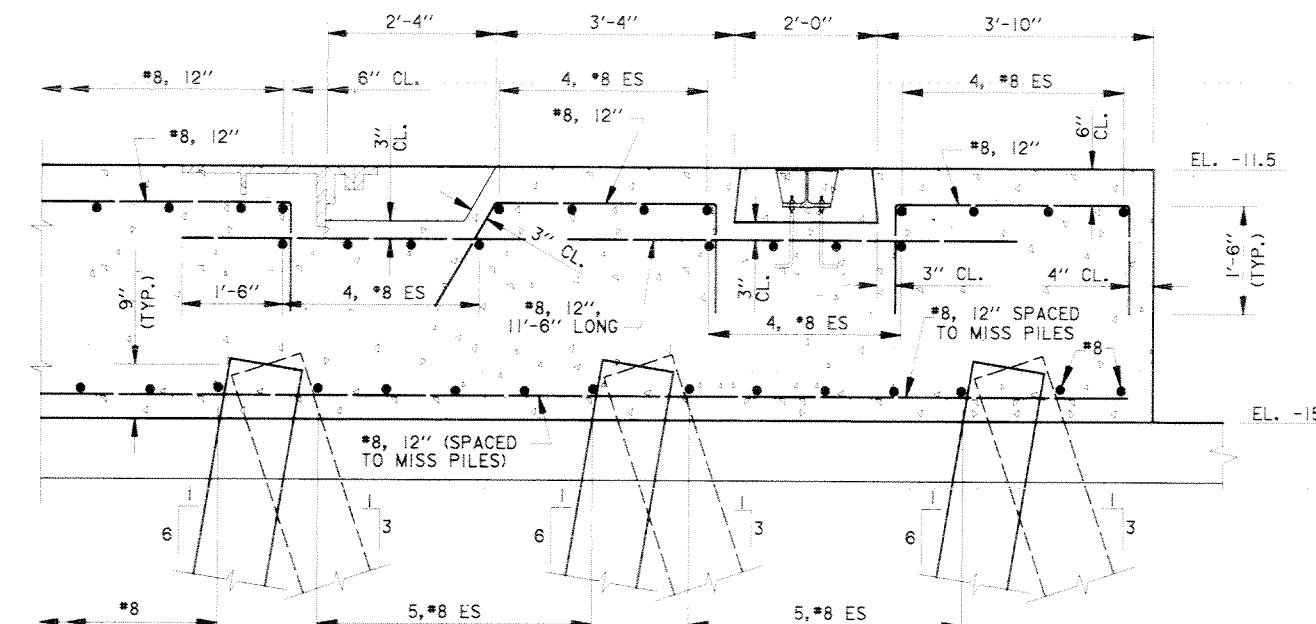


DETAIL (3)

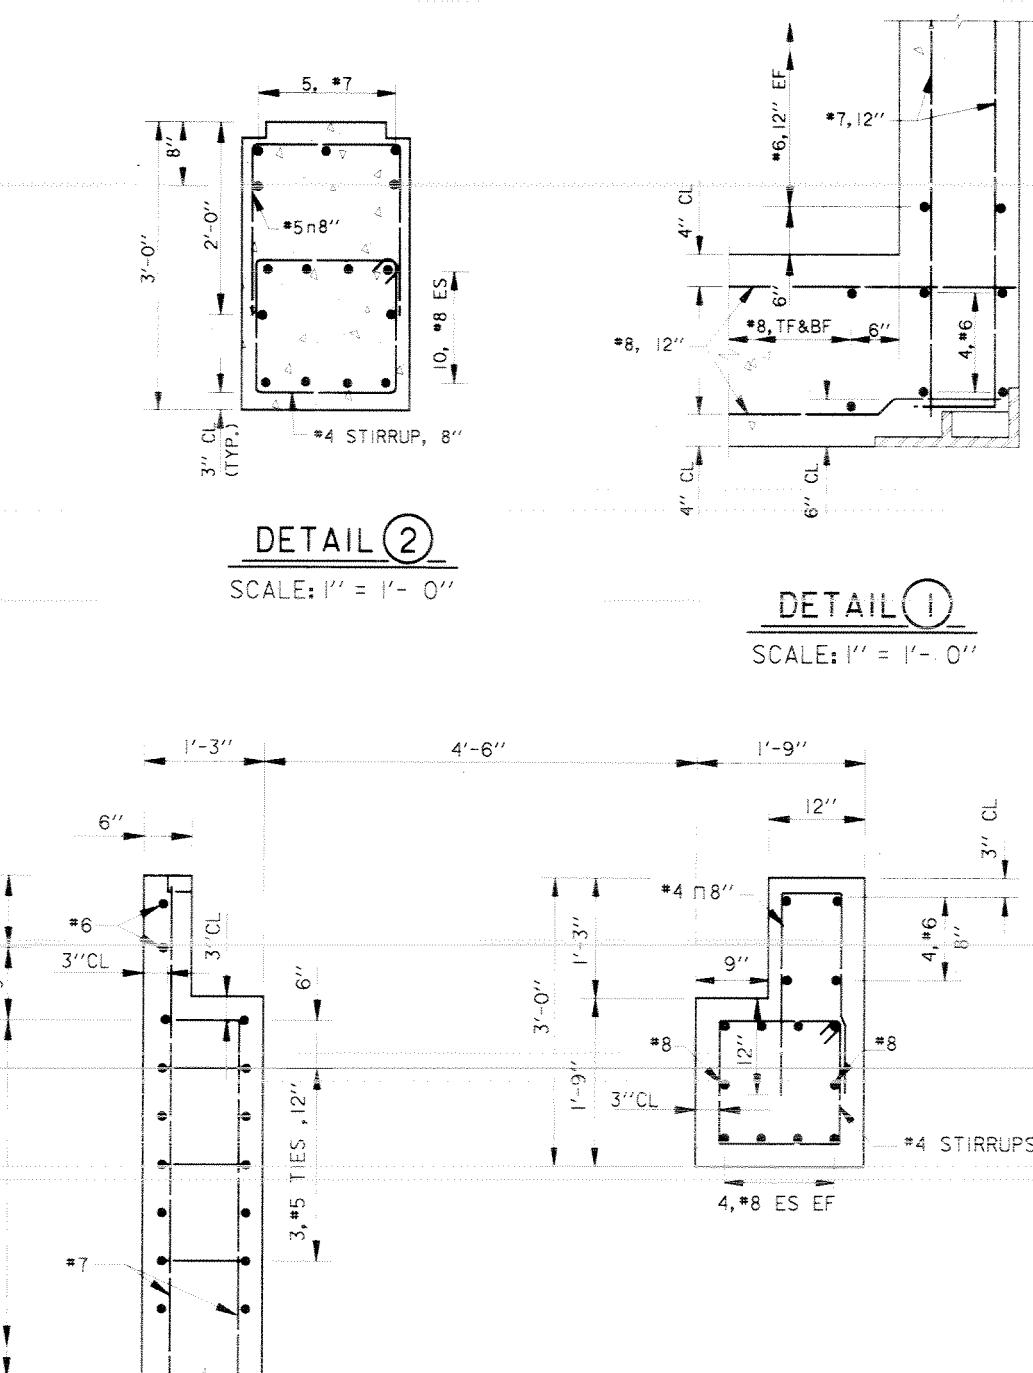

SECTION B
17 15

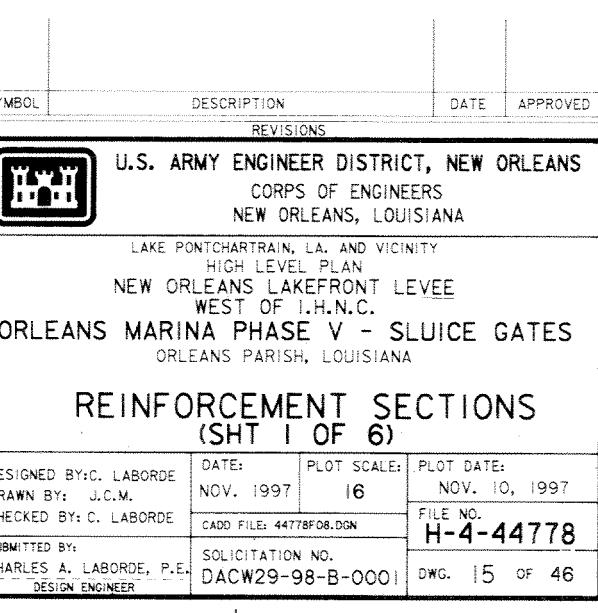


Safety is a Part of Your Contract

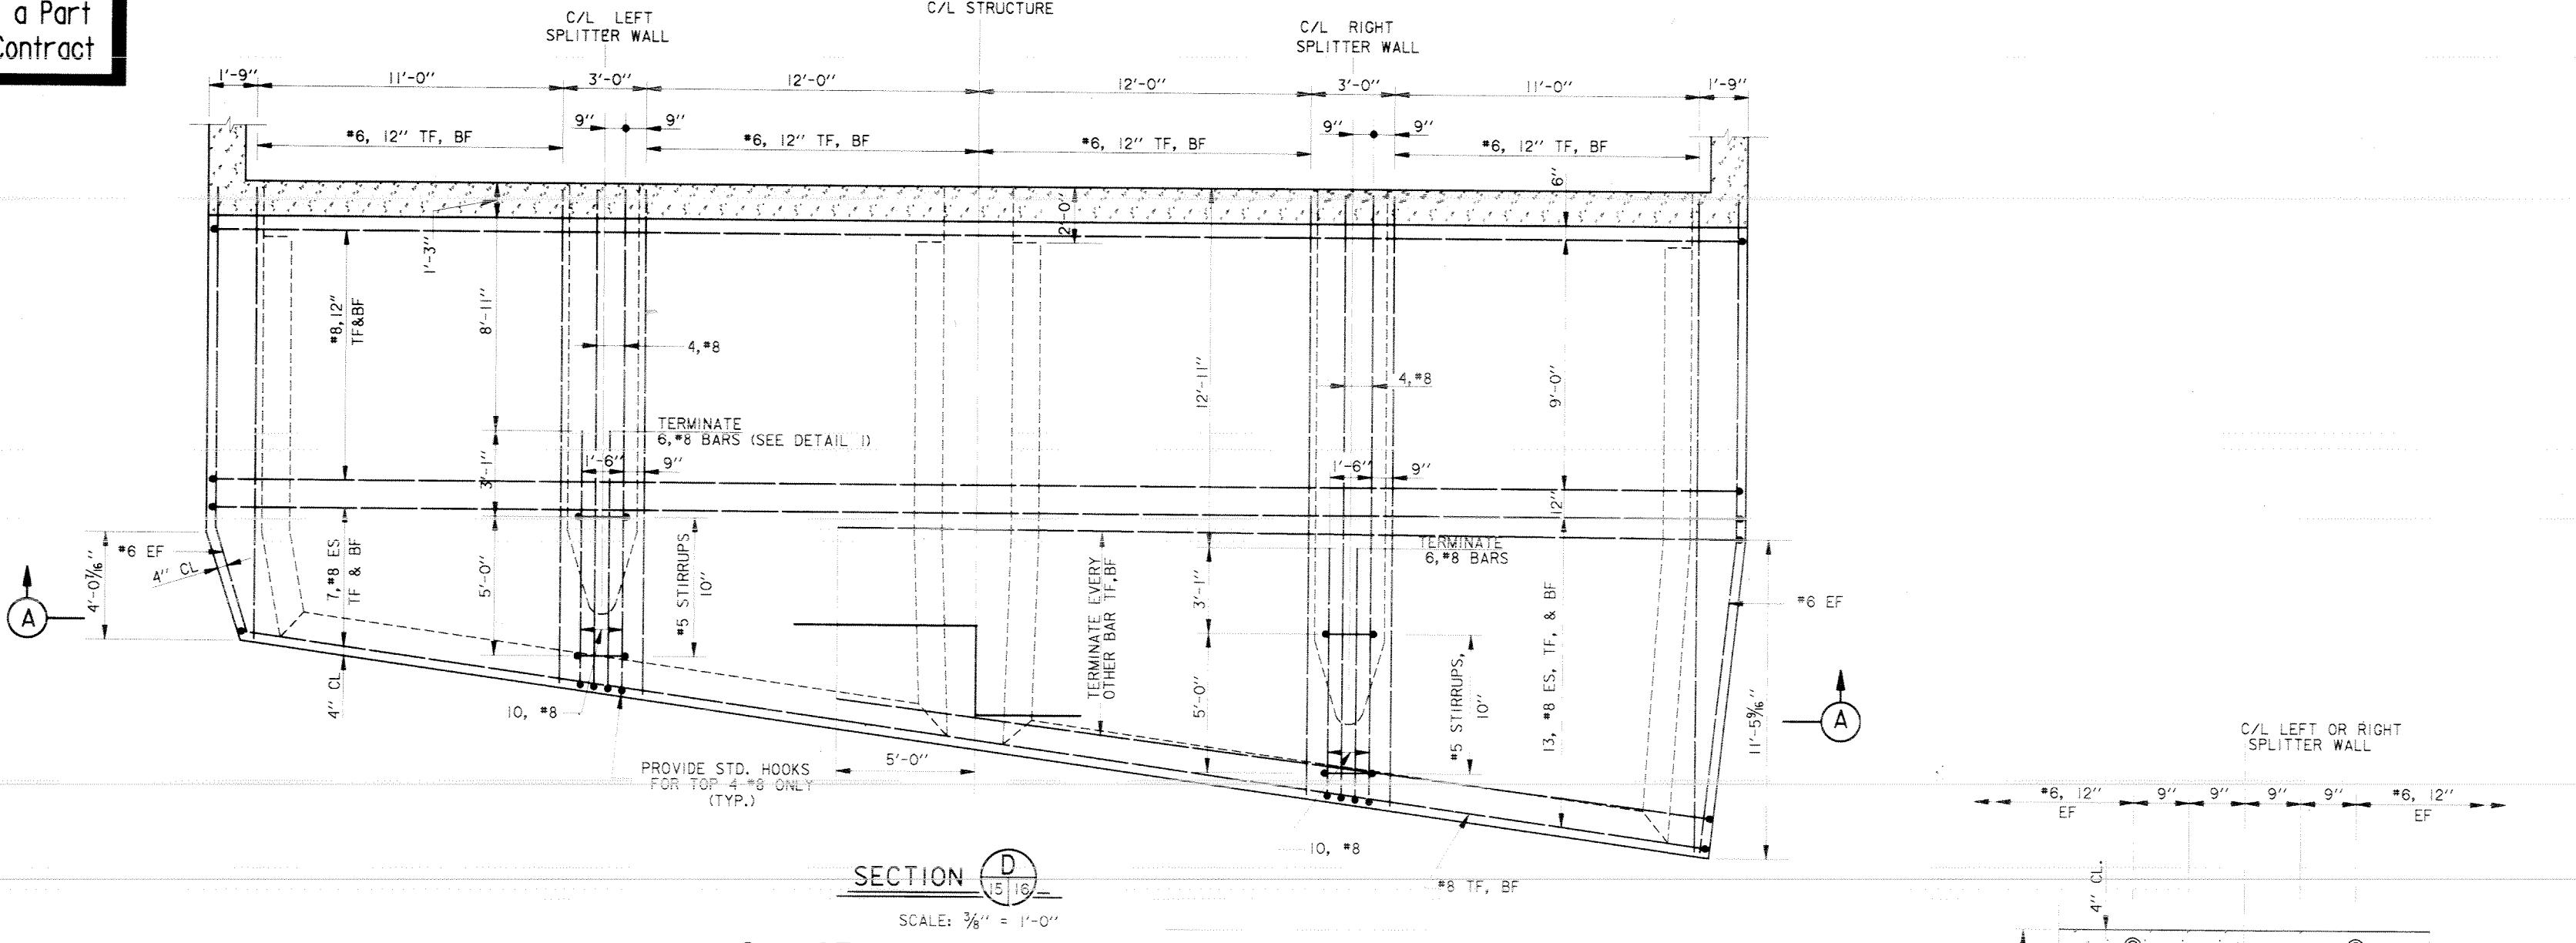


SLUICE GATE STRUCTURE

SCALE: $\frac{3}{8}'' =$

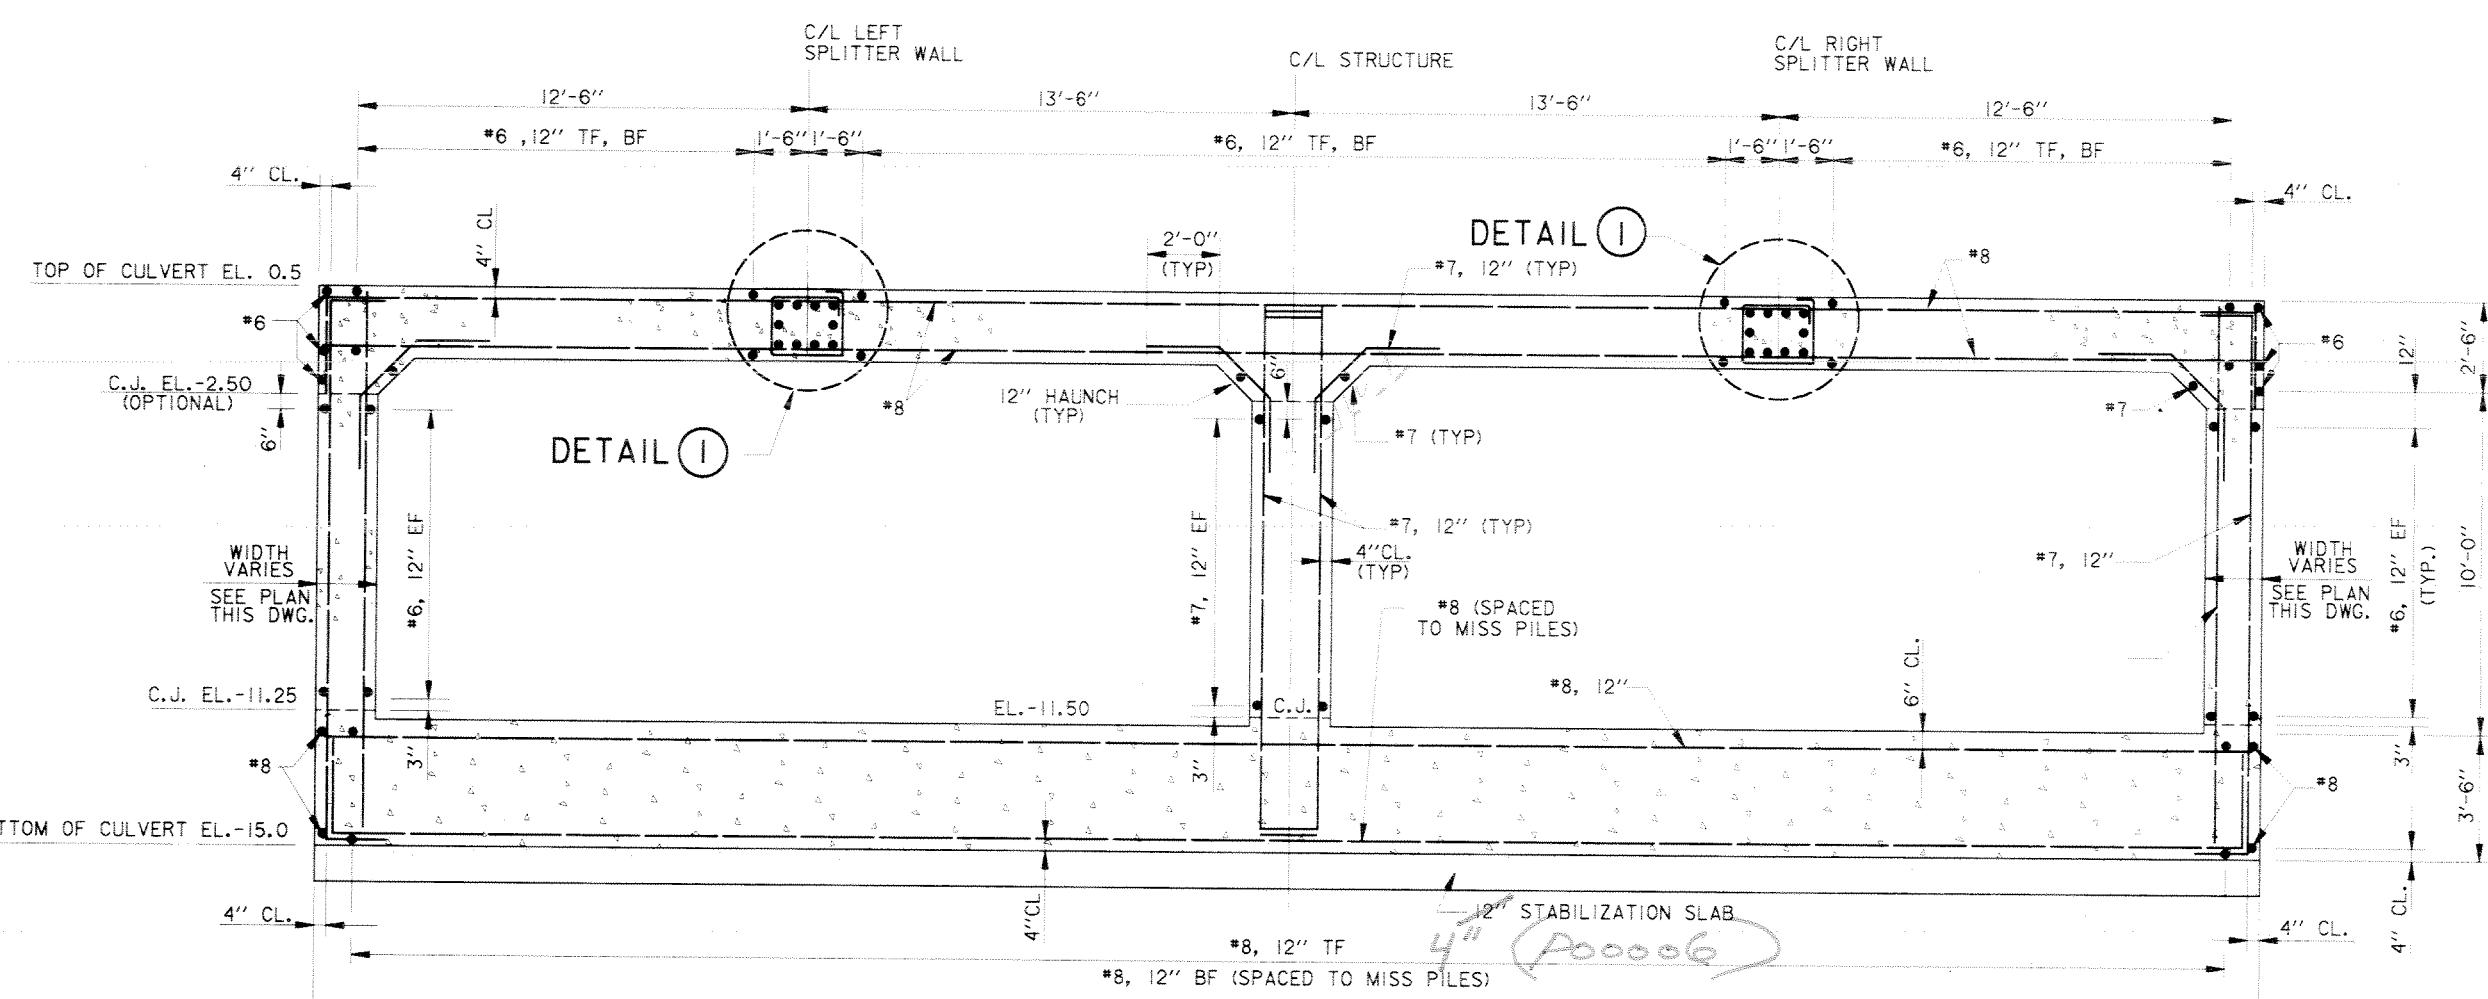

SECTION A



SCALE: $\frac{3}{8}'' = 1'-0''$

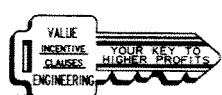

A computer monitor is shown from a slightly elevated angle. The screen displays a graphic of a house with a chimney and the letters 'C-A-D' in a stylized font below it. The monitor sits on top of a dark-colored computer tower. In front of the monitor, a portion of a keyboard is visible.


DESIGNED BY: P. SCHAEFER	DATE:	PLOT SCALE:	PLOT DATE:
DRAWN BY: JCM	NOV. 1997	32	NOV. 10, 1997
CHECKED BY: C. LABORDE	CADD FILE: 4477BF04.DCN		
SUBMITTED BY:	SOLICITATION NO.		FILE NO.
CHARLES A. LABORDE, P.E. DESIGN ENGINEER	DACPW29-98-B-0001		H-4-44778
	DWG.	16	OF 46

Safety is a Part
of Your Contract.

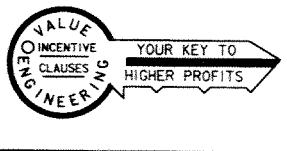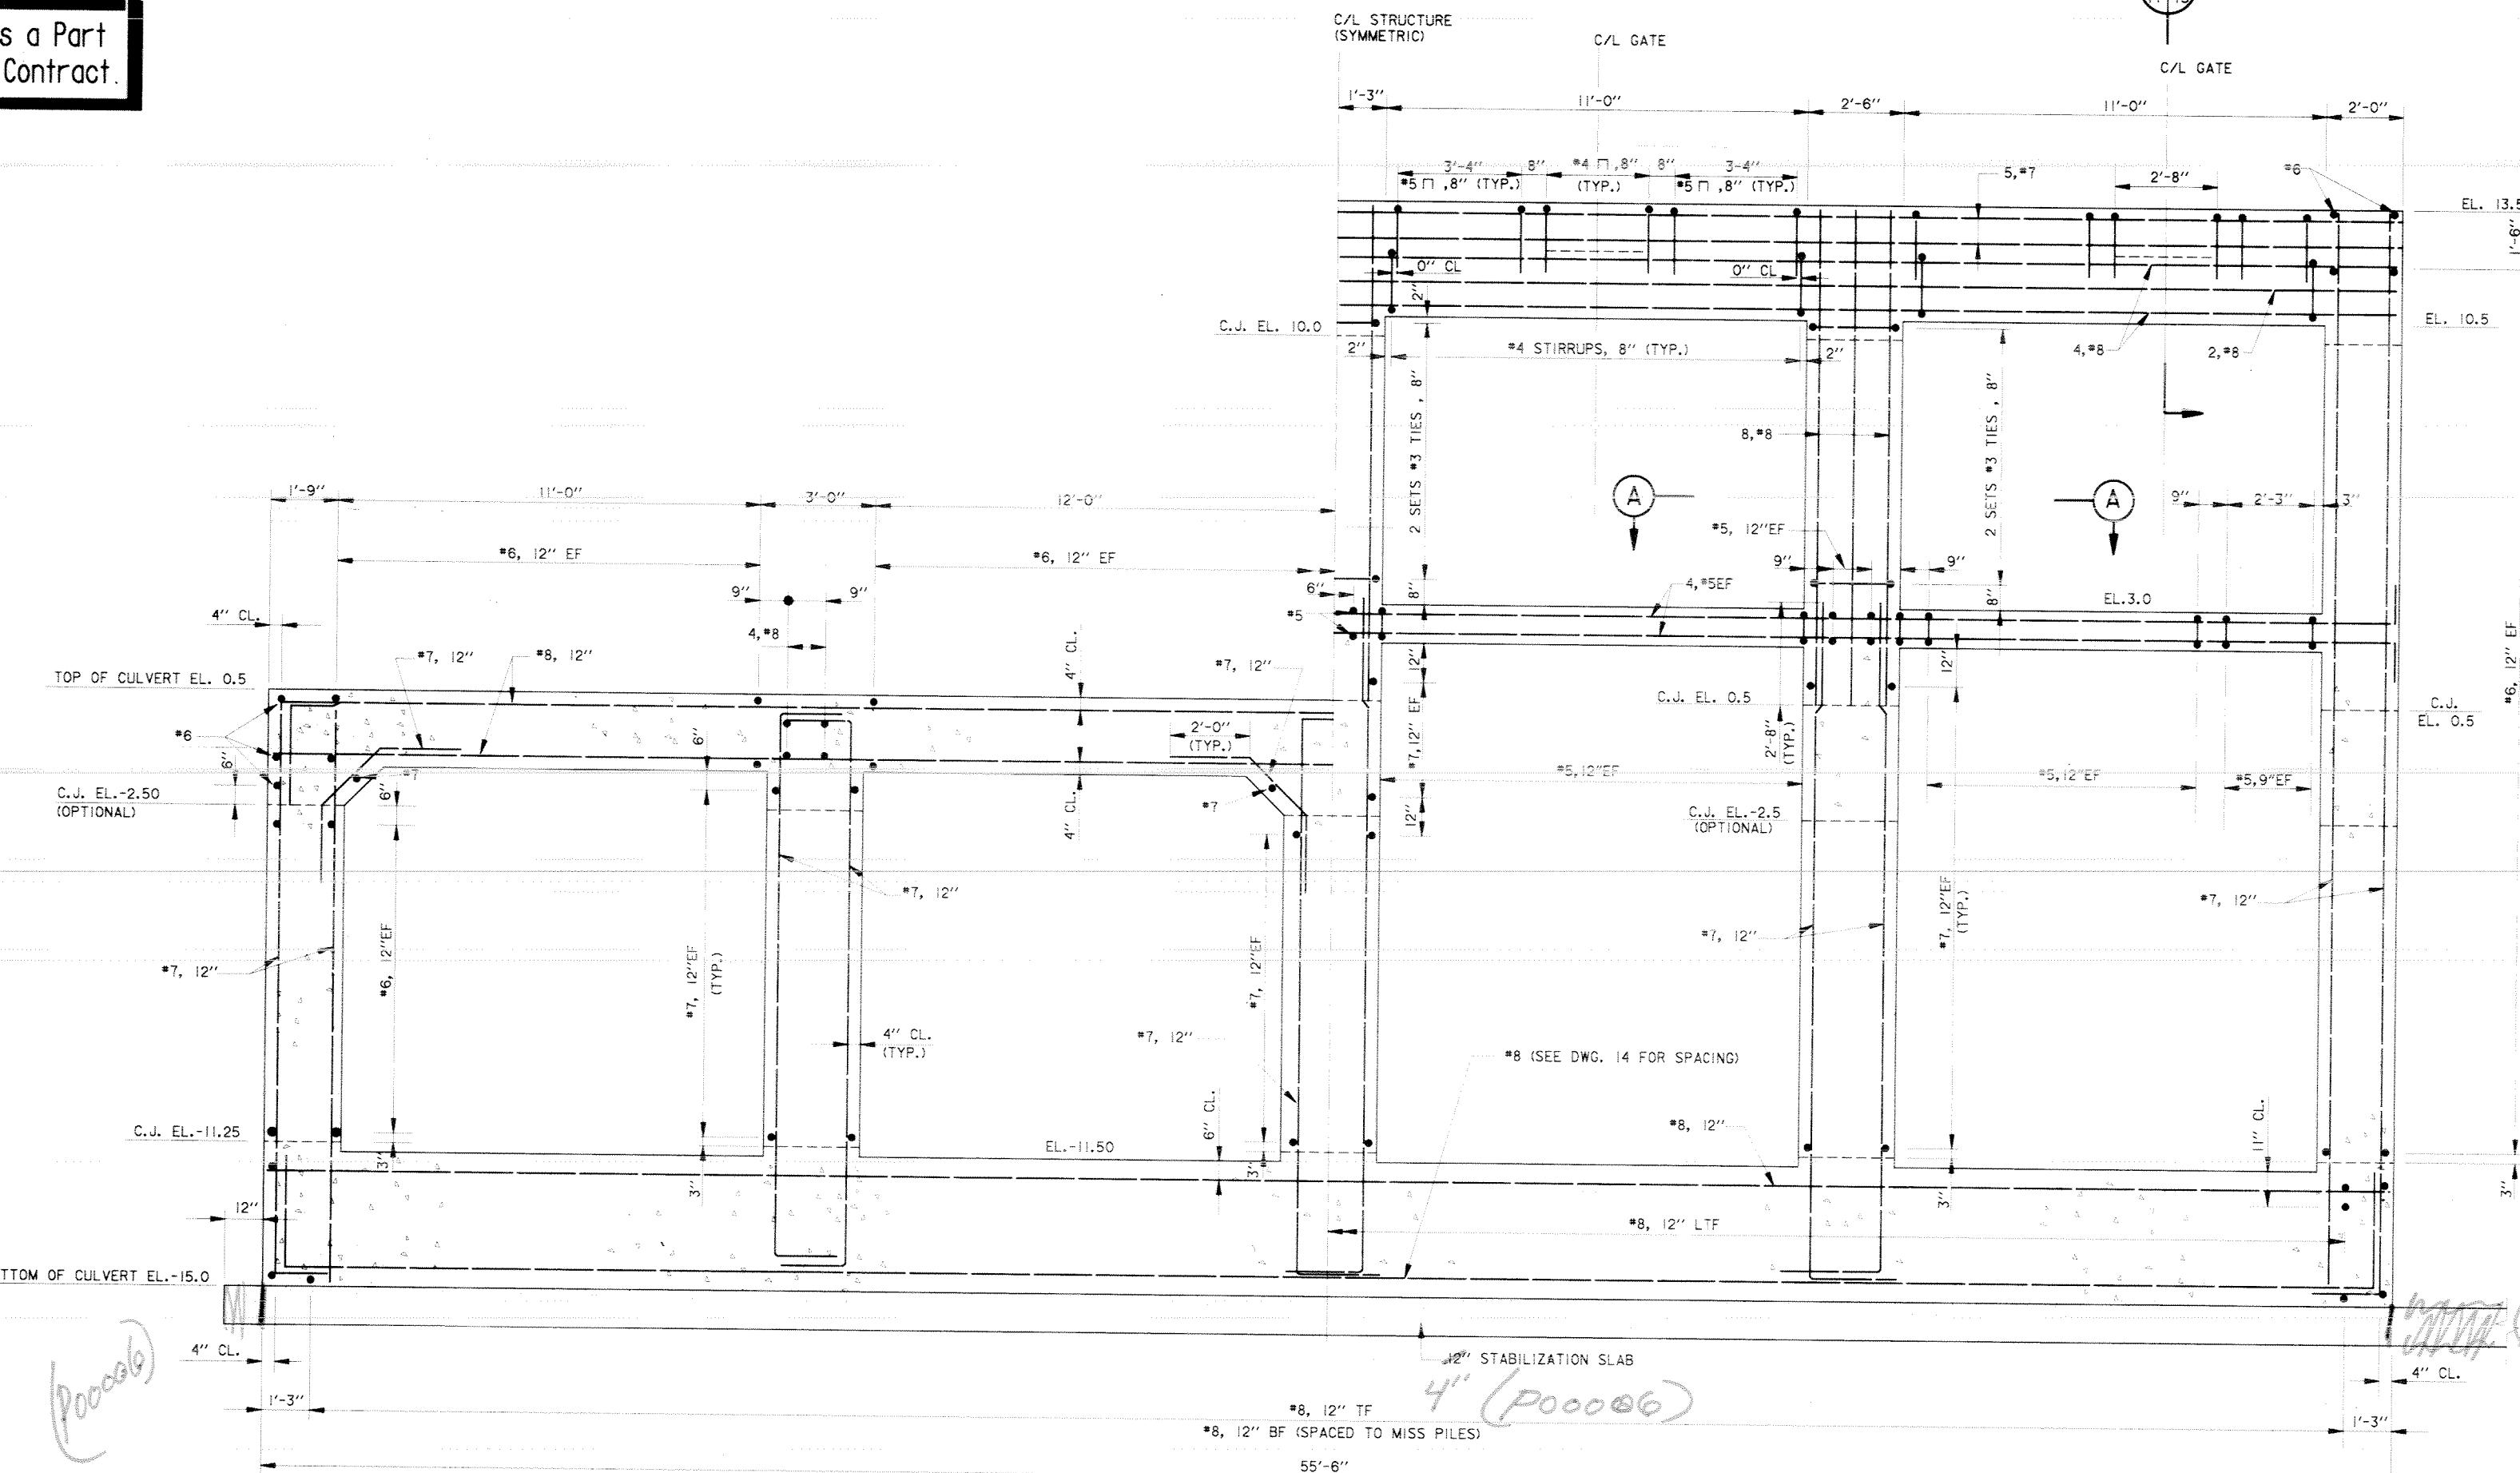

SECTION A


SCALE: $1\frac{1}{2}'' = 1'-0''$

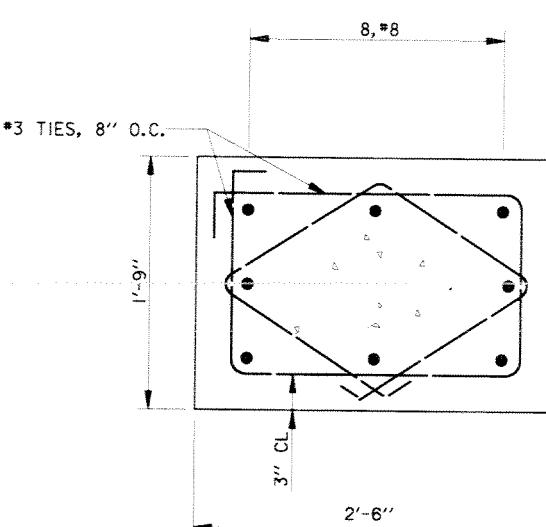

SECTION E
9 17


SCALE: $\frac{1}{2}'' = 1' = 0''$

SCALE: $\frac{1}{3}'' = 1' - 0''$

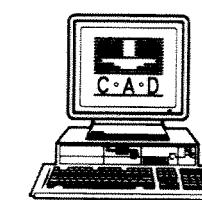


SYMBOL	DESCRIPTION	DATE	APPROVED
	REVISIONS		
U.S. ARMY ENGINEER DISTRICT, NEW ORLEANS CORPS OF ENGINEERS NEW ORLEANS, LOUISIANA			
LAKE PONTCHARTRAIN, LA. AND VICINITY HIGH LEVEL PLAN NEW ORLEANS LAKEFRONT LEVEE WEST OF I.H.N.C. ORLEANS MARINA PHASE V - SLUICE GATES ORLEANS PARISH, LOUISIANA			
REINFORCEMENT SECTIONS (SHEET 3 OF 6)			
DESIGNED BY: C.LABORDE	DATE:	PLOT SCALE:	PLOT DATE:
DRAWN BY: J.DARBY	NOV. 1997	24	NOV. 10, 1997
CHECKED BY: C. LABORDE		CADD FILE: 447TBEO1.DGN	FILE NO.
SUBMITTED BY: CHARLES A. LABORDE, P.E. DESIGN ENGINEER	SOLICITATION NO. DACW29-98-B-0001		H-4-44778
		DWG. 17	OF 46


Safety is a Part
of Your Contract

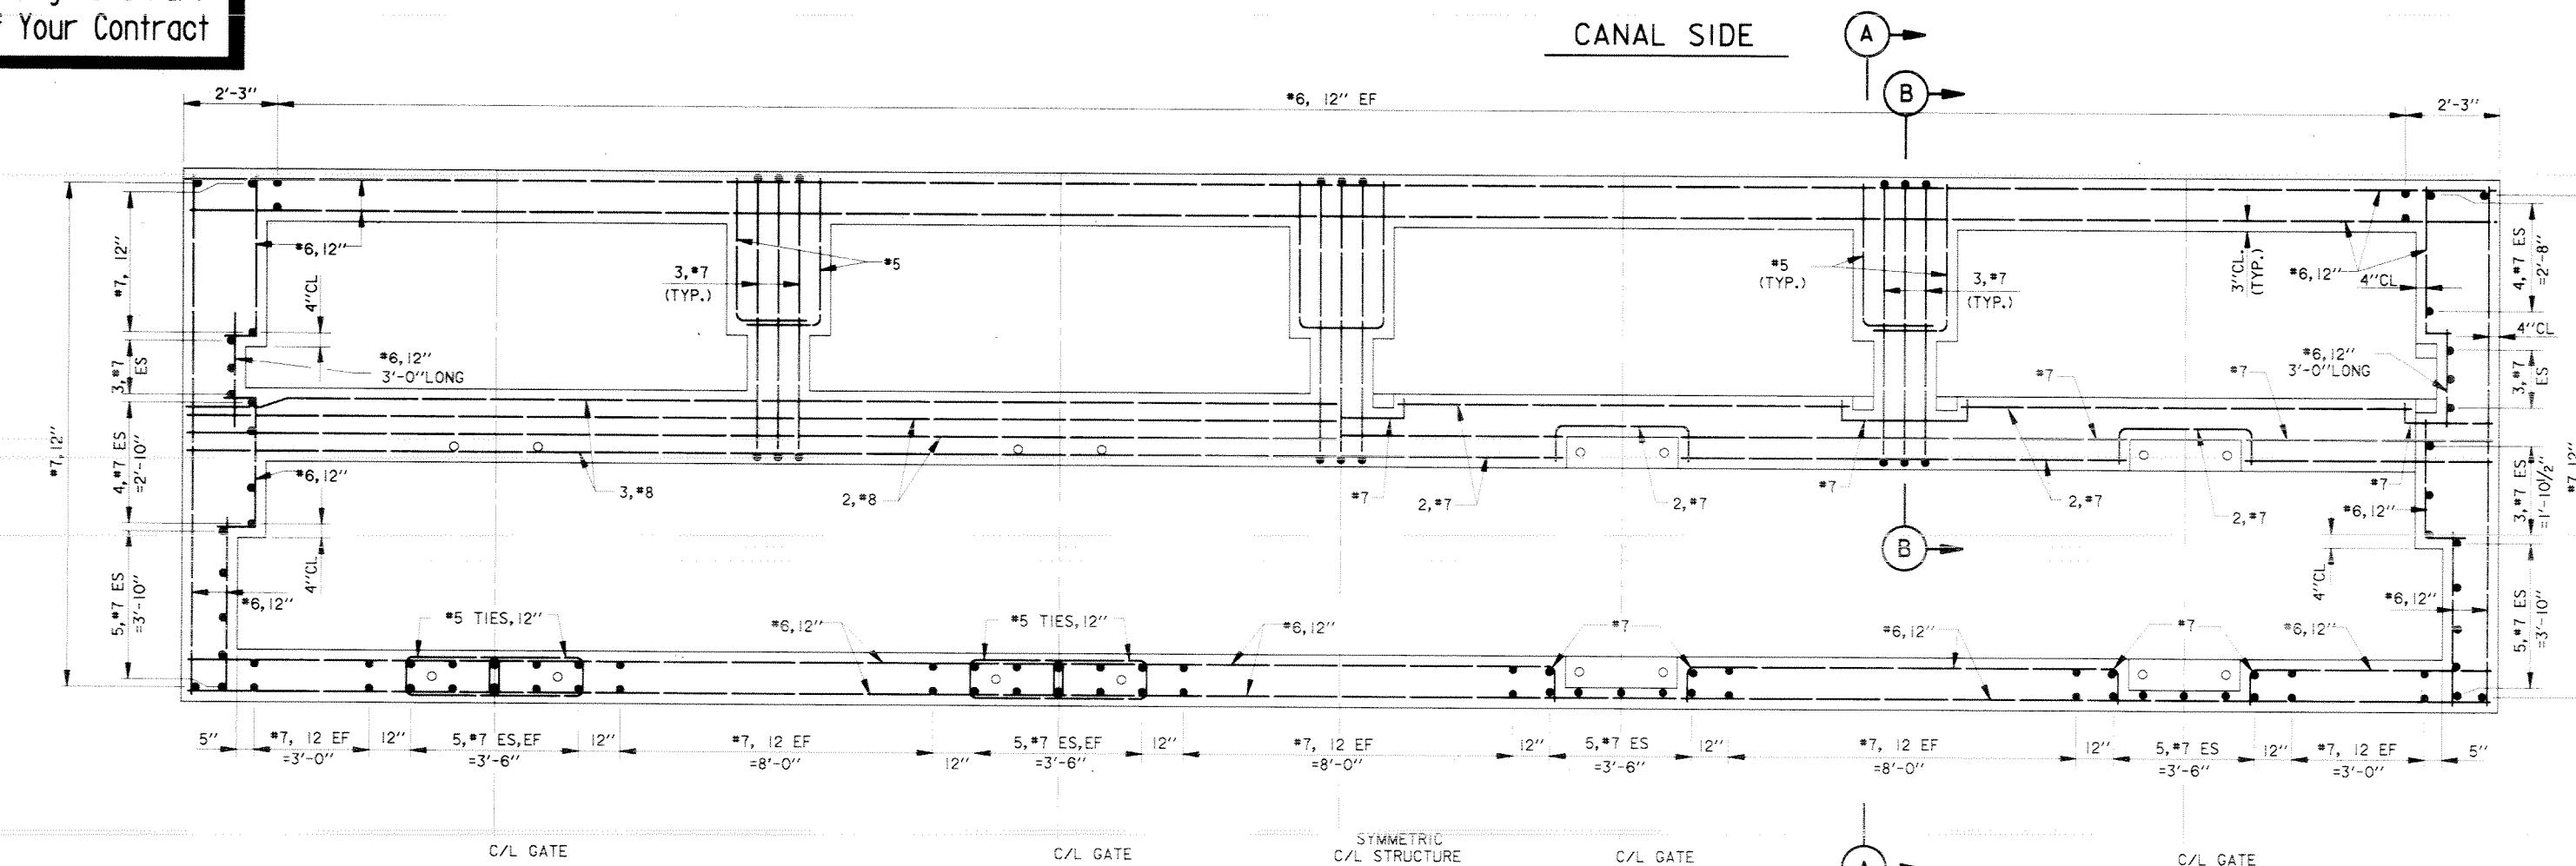

HALF PLAN
EL. 12.5

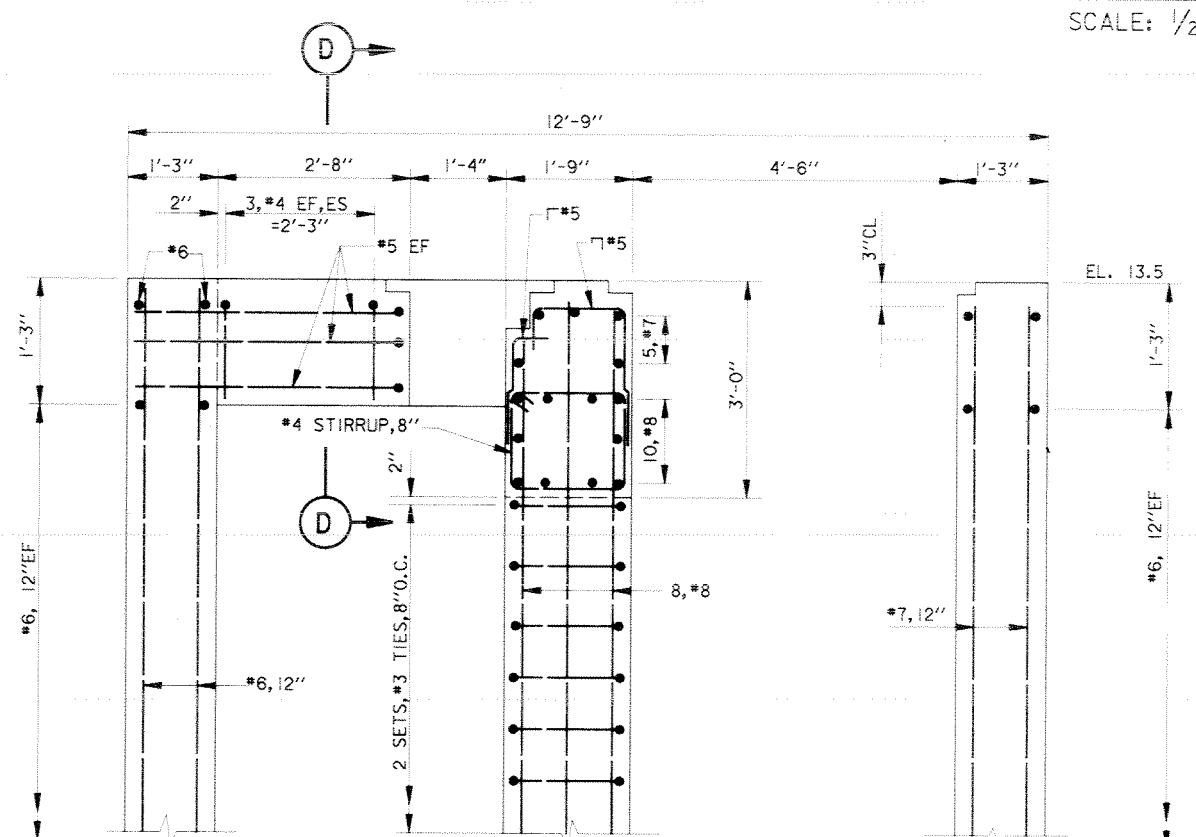


SECTION (A)
SCALE: $\frac{3}{4}'' = 1'-0''$

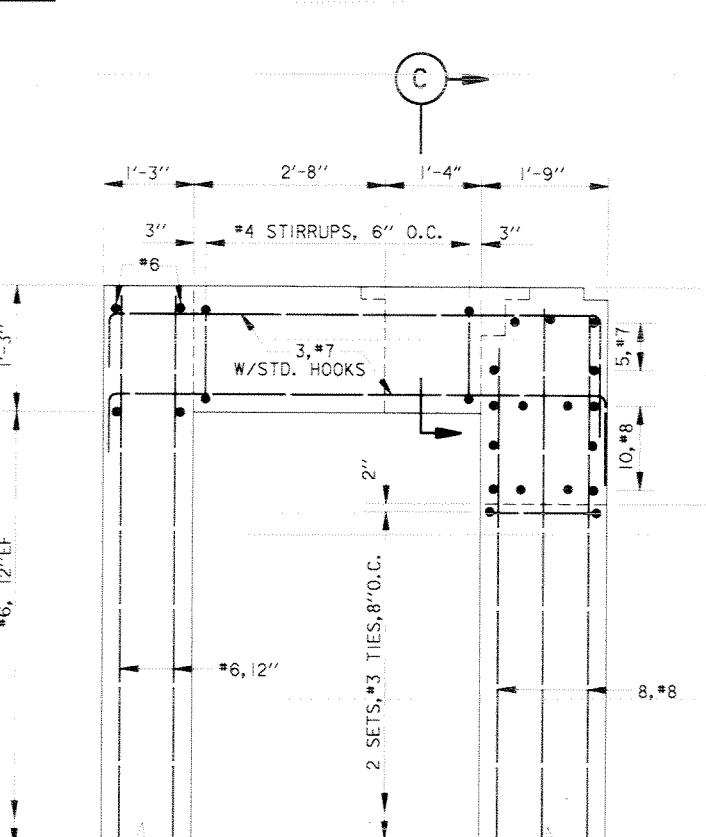


SECTION (B)
SCALE: $\frac{3}{4}'' = 1'-0''$

HALF PLAN
EL. 13.5

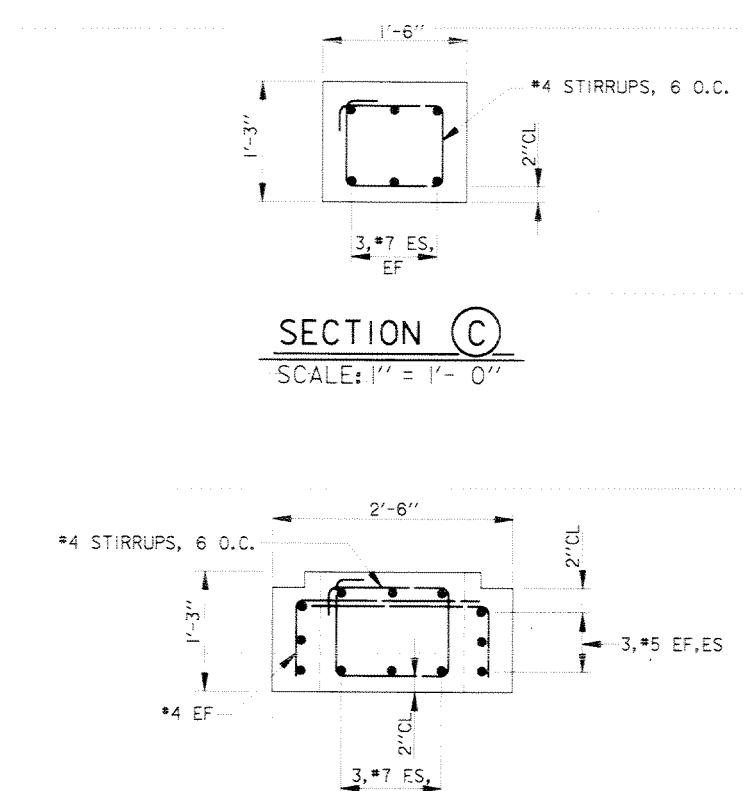

SECTION (D)
SCALE: $\frac{1}{2}'' = 1'-0''$

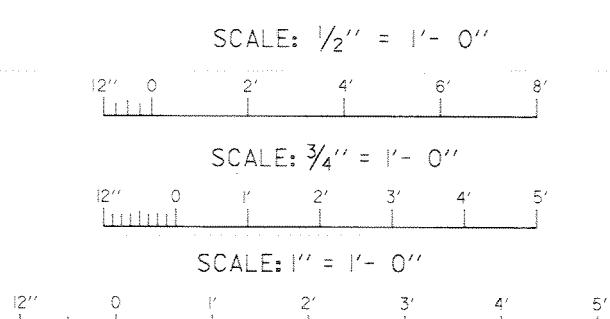

SYMBOL	DESCRIPTION	DATE	APPROVED
	U.S. ARMY ENGINEER DISTRICT, NEW ORLEANS CORPS OF ENGINEERS NEW ORLEANS, LOUISIANA		


LAKE PONTCHARTRAIN LA. AND VICINITY
HIGH LEVEL PLAN
NEW ORLEANS LAKEFRONT LEVEE
WEST OF I.H.N.C.

ORLEANS MARINA PHASE V - SLUICE GATES
ORLEANS PARISH, LOUISIANA



REINFORCEMENT SECTIONS
(SHEET 4 OF 6)

DESIGNED BY: C.LABORDE	DATE: NOV. 97	PLOT SCALE: 24	PLOT DATE: NOV. 10, 1997
DRAWN BY: J.DARBY			
CHECKED BY: C. LABORDE			
SUBMITTED BY: CHARLES A. LABORDE, P.E. DESIGN ENGINEER			


CADD FILE: 4477BE06.DGN
SOLICITATION NO.: DACW29-98-B-0001
DWG. 18 OF 46

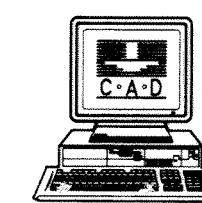



Safety is a Part
of Your Contract

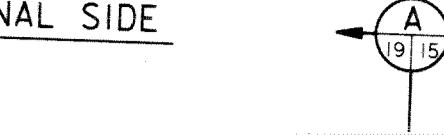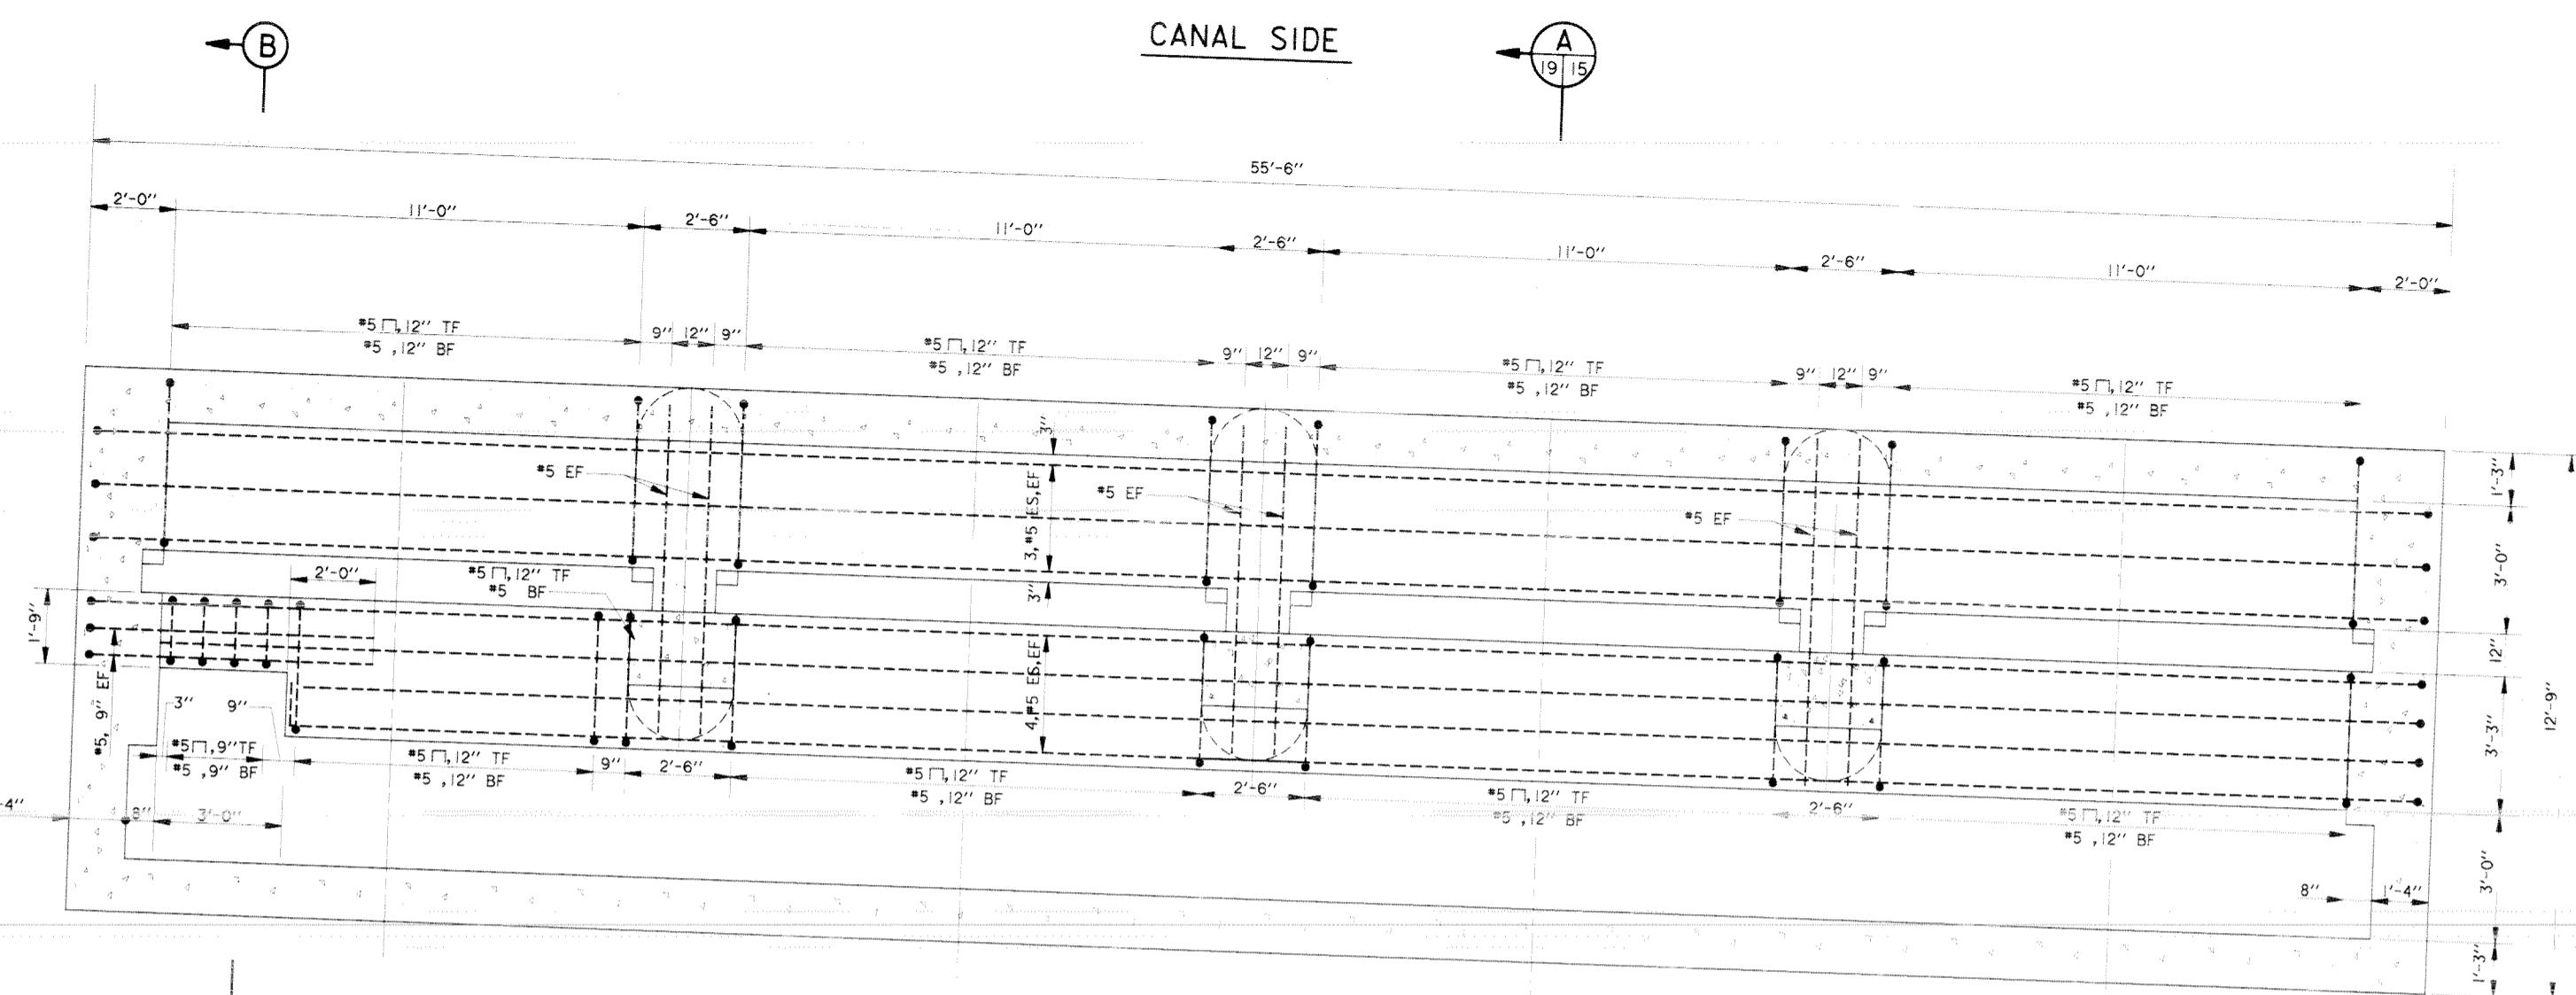

SLUICE GATE STRUCTURE
PLAN AT EL. 3.0

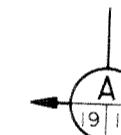


LAND SIDE

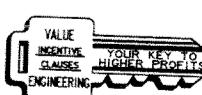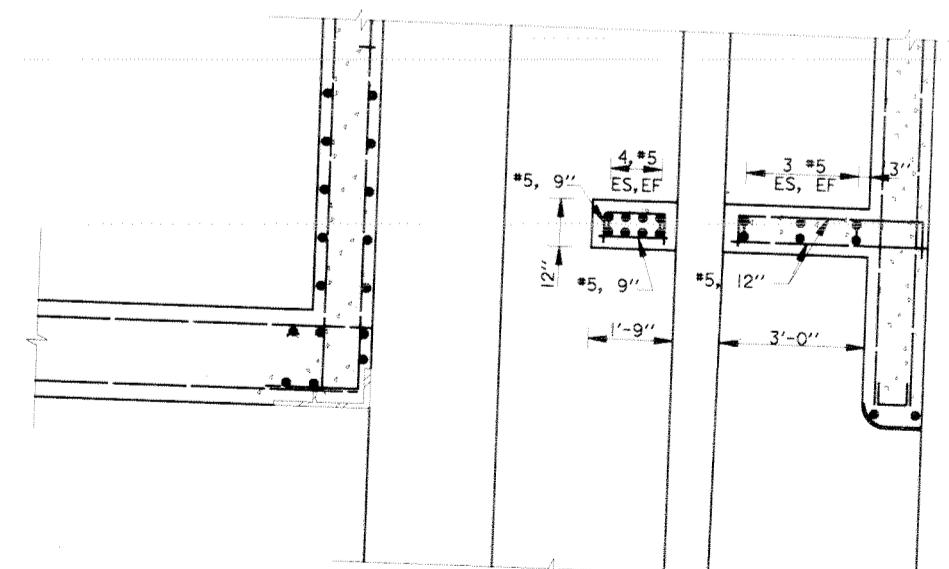

SECTION B

SCALE: $\frac{1}{2}'' = 1'-0''$

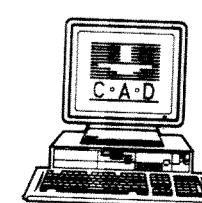


SCALE: $\frac{1}{2}'' = 1'-0''$


12' 0" 2' 4' 6' 8'

SYMBOL	DESCRIPTION	DATE	APPROVED
	U.S. ARMY ENGINEER DISTRICT, NEW ORLEANS CORPS OF ENGINEERS NEW ORLEANS, LOUISIANA		
LAKE PONTCHARTRAIN, LA. AND VICINITY HIGH LEVEL PLAN NEW ORLEANS LAKEFRONT LEVEE WEST OF I.R.N.C.			
ORLEANS MARINA PHASE V - SLUICE GATES ORLEANS PARISH, LOUISIANA			
REINFORCEMENT SECTIONS (SHEET 5 OF 6)			
DRAWN BY: C. LABORDE		DATE: NOV. 10, 1997	PLOT SCALE: 24
CHECKED BY: C. LABORDE		PLOT DATE: NOV. 10, 1997	
SUBMITTED BY: CHARLES A. LABORDE, P.E. DESIGN ENGINEER		FILE NO. H-4-44778	
		CADD FILE: 44778C14.DGN	
		SOLICITATION NO. DACW29-98-B-0001	
		19 OF 46	



Safety is a Part
of Your Contract

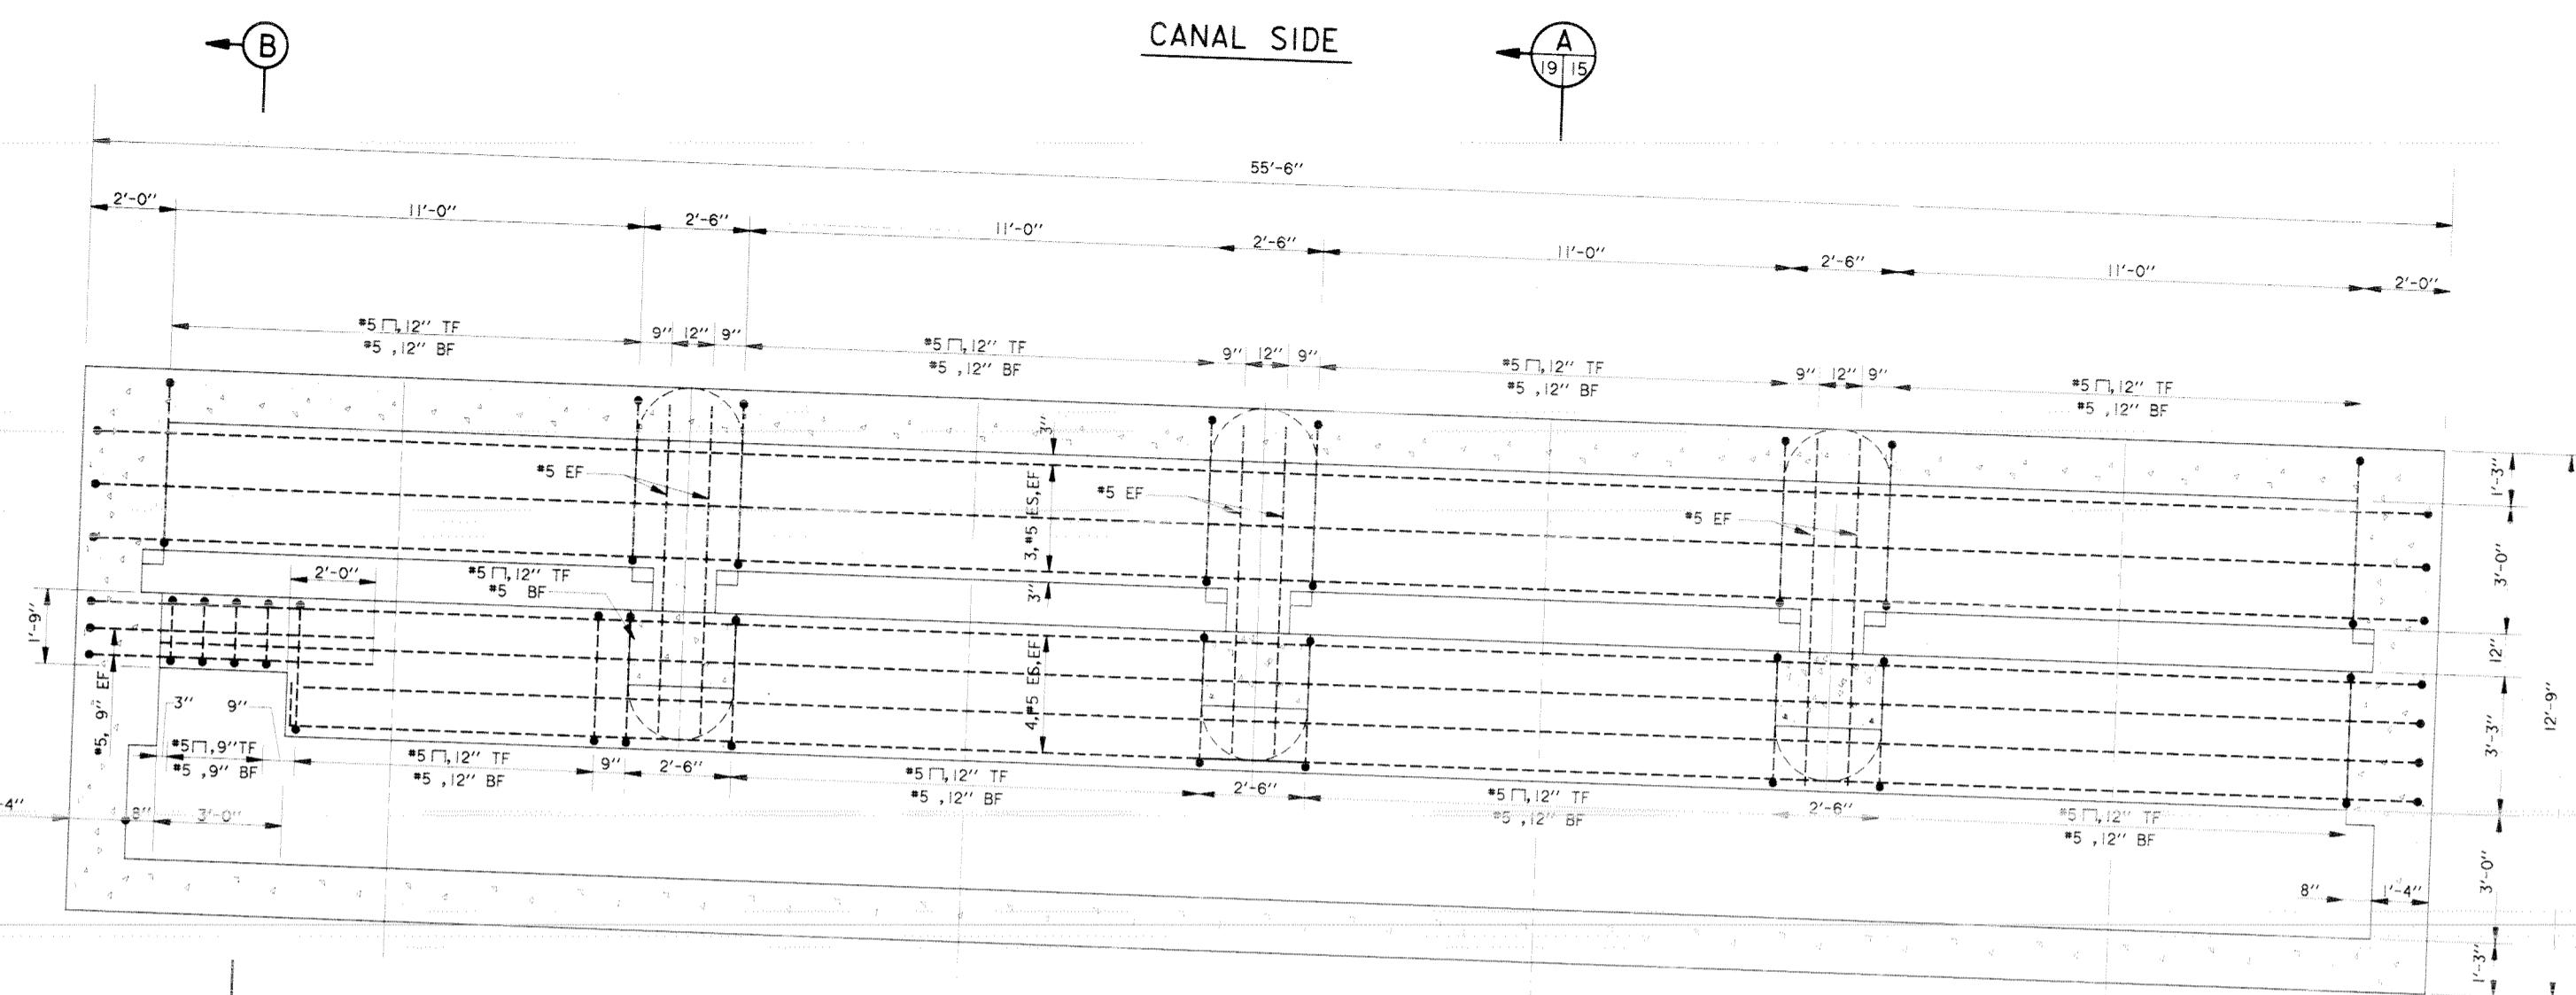

SLUICE GATE STRUCTURE
PLAN AT EL. 3.0

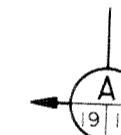


LAND SIDE

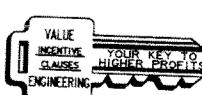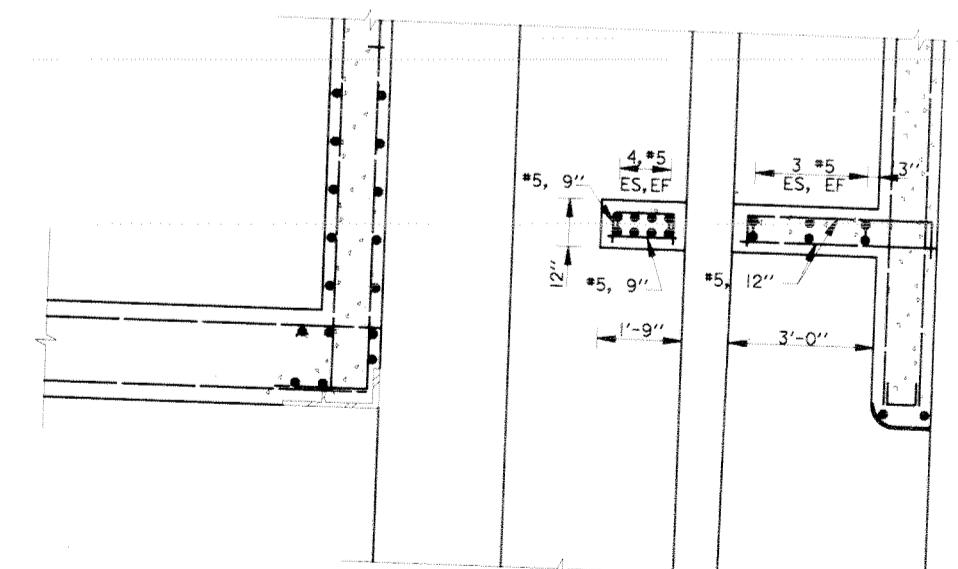

SECTION B

SCALE: $\frac{1}{2}'' = 1'-0''$

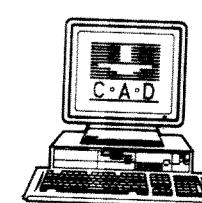


SCALE: $\frac{1}{2}'' = 1'-0''$


12' 0" 2' 4' 6' 8'

SYMBOL	DESCRIPTION	DATE	APPROVED
	U.S. ARMY ENGINEER DISTRICT, NEW ORLEANS CORPS OF ENGINEERS NEW ORLEANS, LOUISIANA		
LAKE PONTCHARTRAIN, LA. AND VICINITY HIGH LEVEL PLAN NEW ORLEANS LAKEFRONT LEVEE WEST OF I.R.N.C.			
ORLEANS MARINA PHASE V - SLUICE GATES ORLEANS PARISH, LOUISIANA			
REINFORCEMENT SECTIONS (SHEET 5 OF 6)			
DESIGNED BY: C.LABORDE	DATE: NOV. 10, 1997	PLOT SCALE: 24	PLOT DATE: NOV. 10, 1997
DRAWN BY: C.BRANTSTETTER	CHECKED BY: C. LABORDE	CADD FILE: 44778C14.DCN	FILE NO. H-4-44778
SUBMITTED BY: CHARLES A. LABORDE, P.E. DESIGN ENGINEER	SOLICITATION NO. DACW29-98-B-0001		


Safety is a Part
of Your Contract

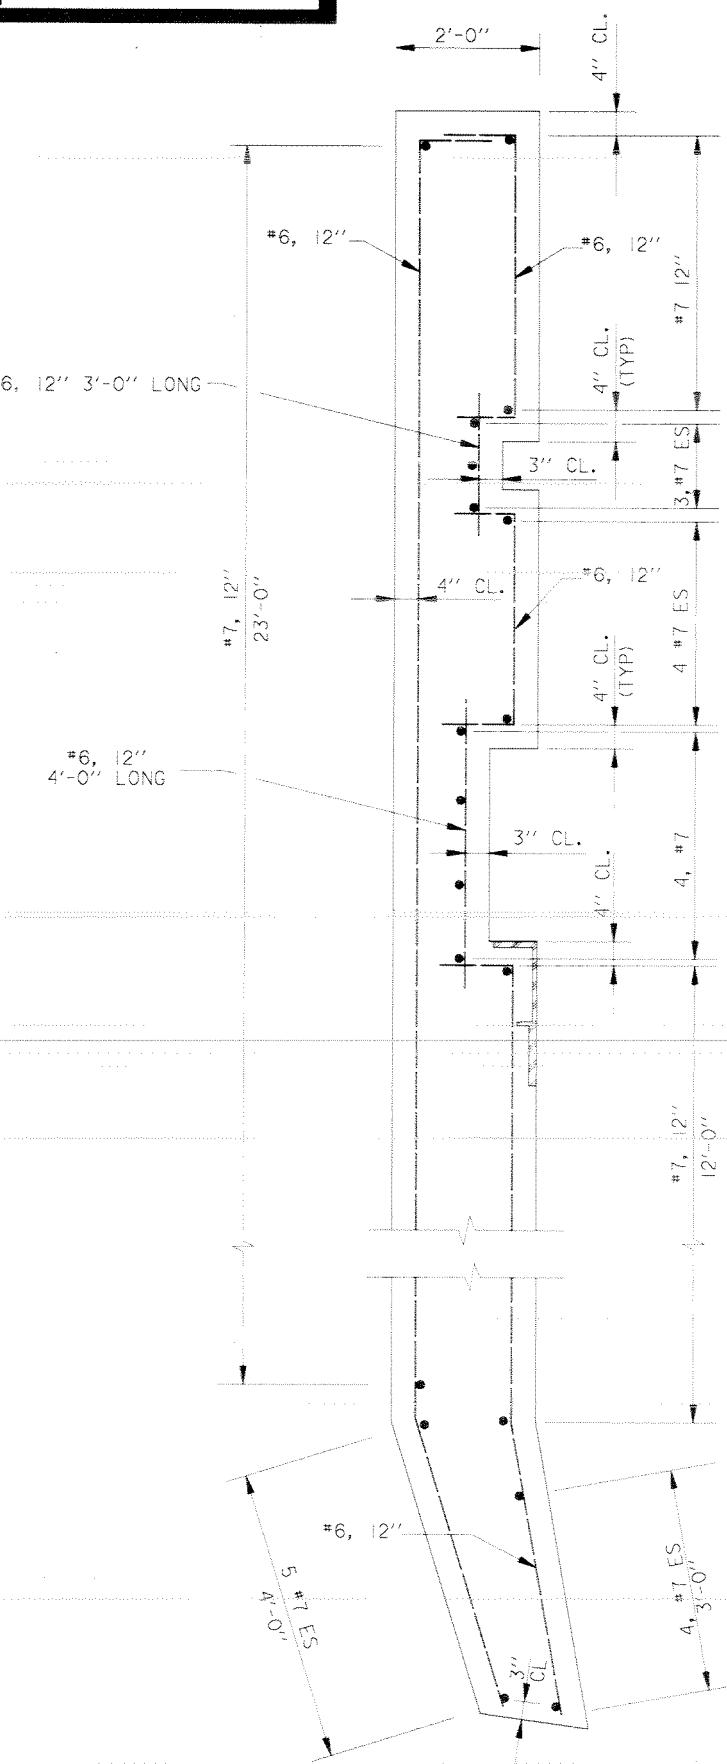


DETAIL 1
SCALE: $\frac{3}{4}'' = 1'-0''$

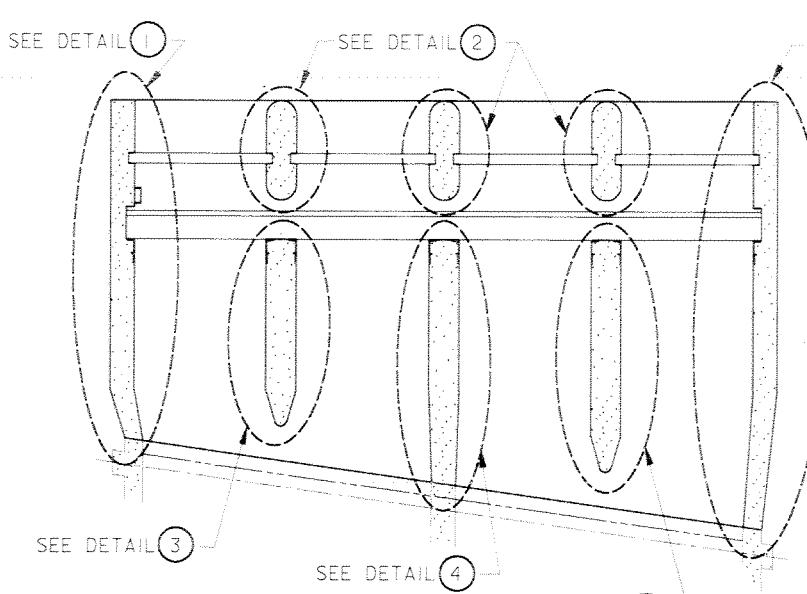


KEY PLAN
SCALE: $\frac{1}{8}'' = 1'-0''$

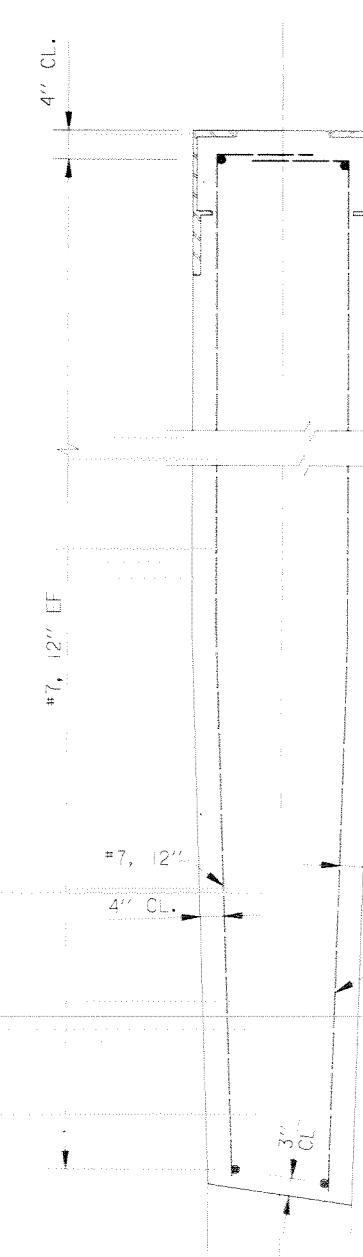


DETAIL 2
SCALE: $\frac{3}{4}'' = 1'-0''$

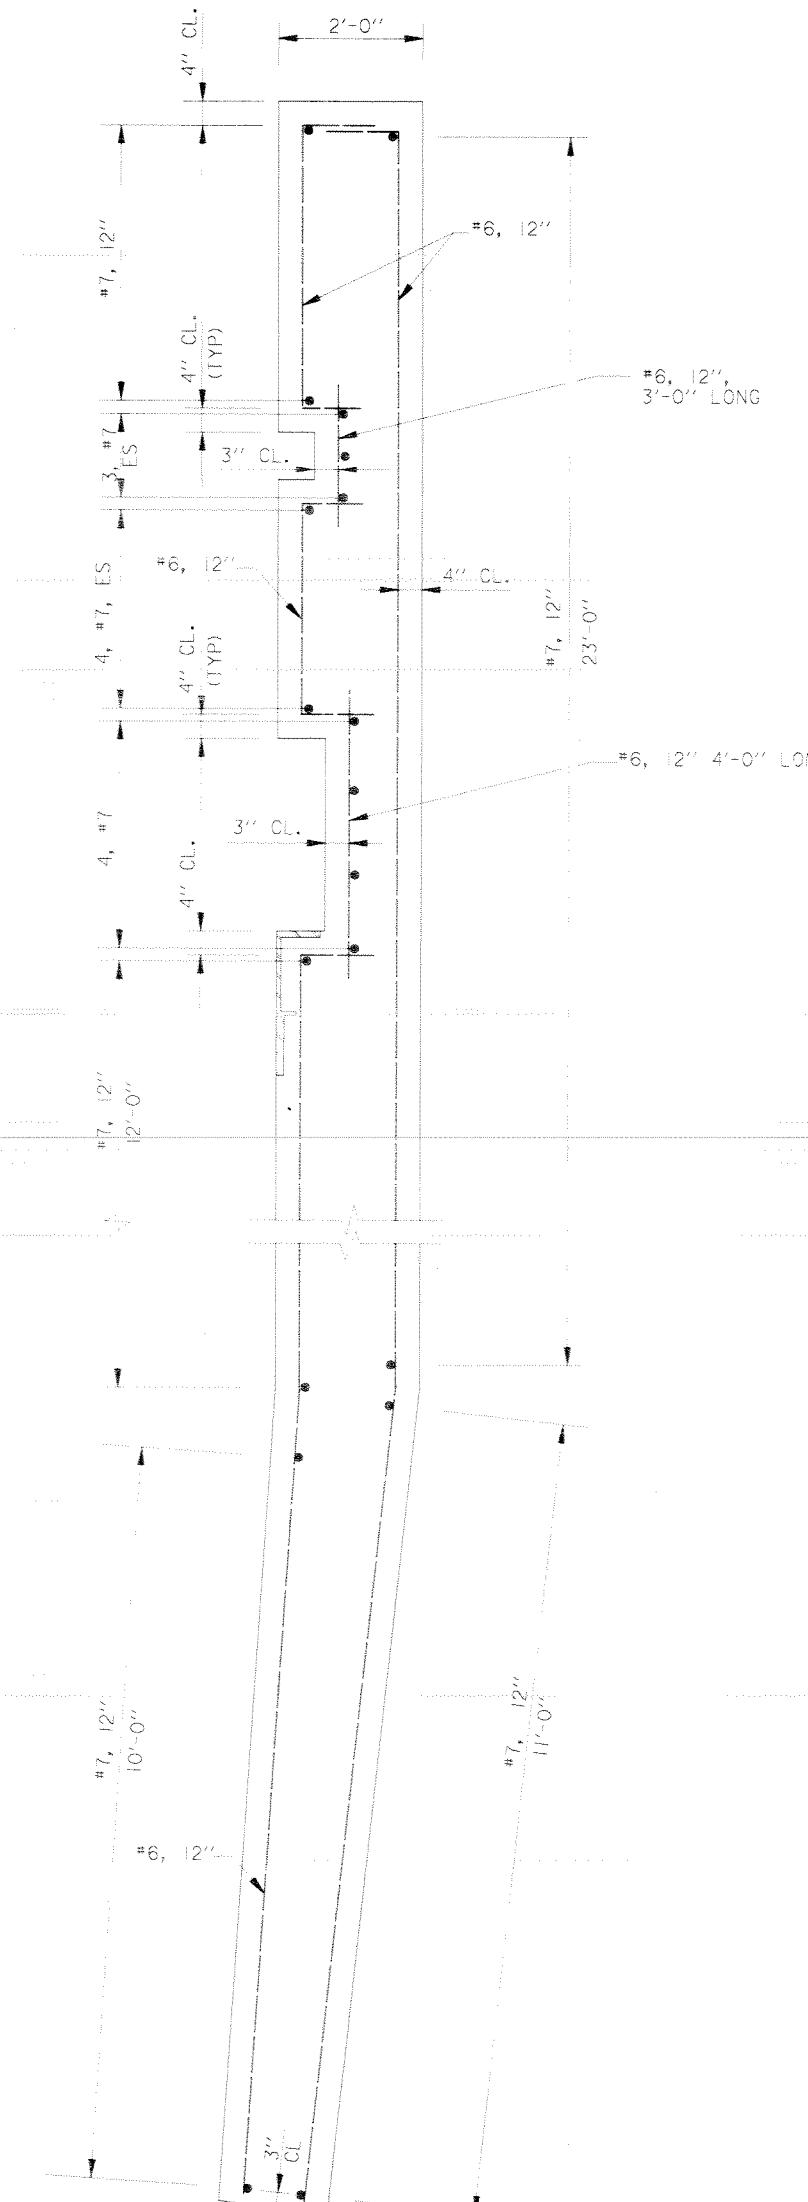


DETAIL 3
SCALE: $\frac{3}{4}'' = 1'-0''$

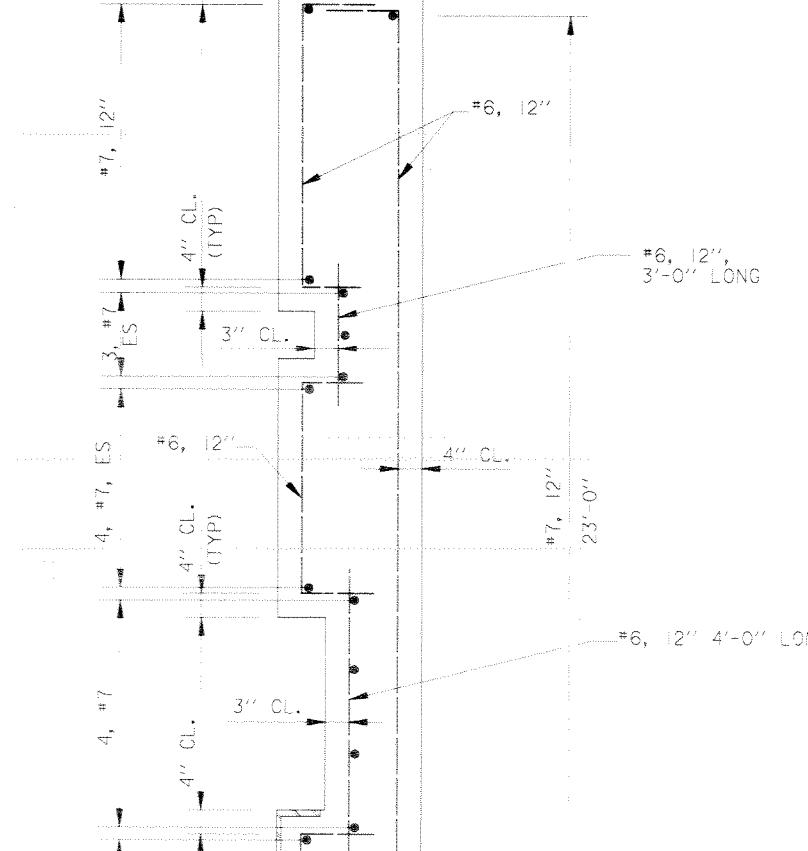


DETAIL 4
SCALE: $\frac{3}{4}'' = 1'-0''$

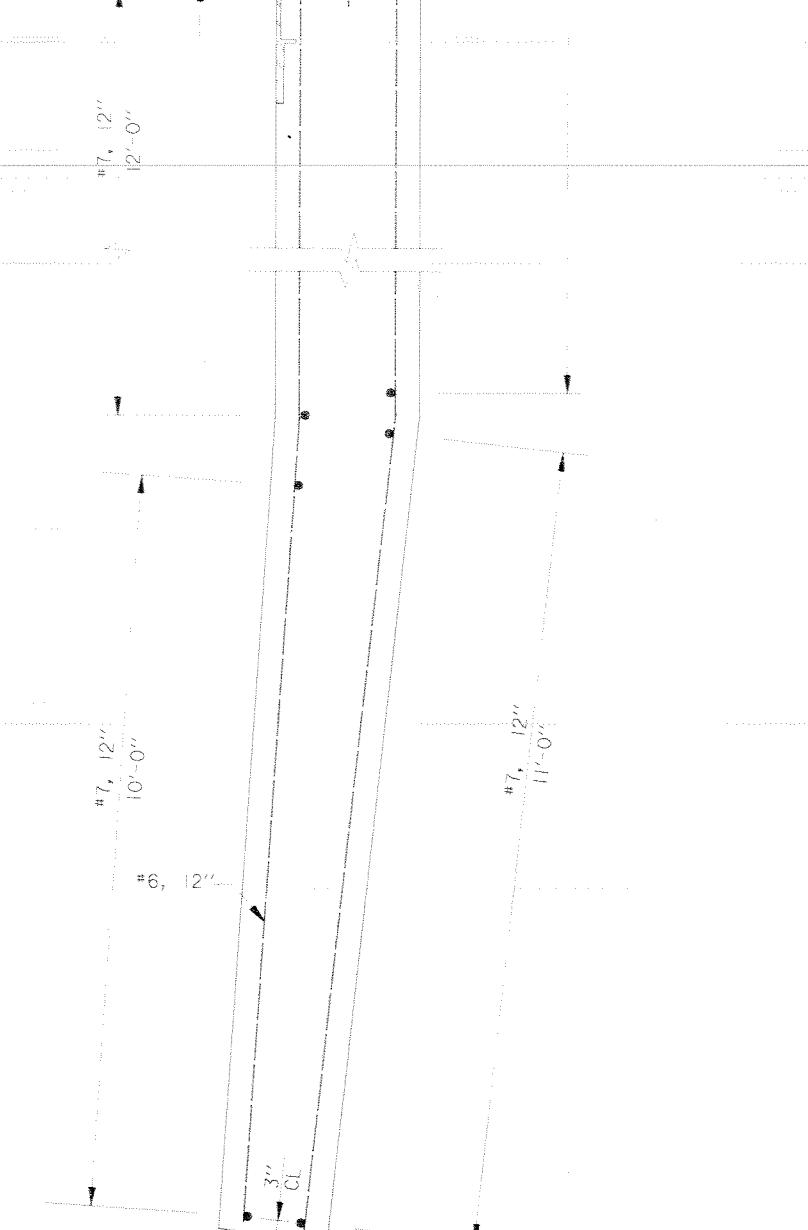


DETAIL 5
SCALE: $\frac{3}{4}'' = 1'-0''$

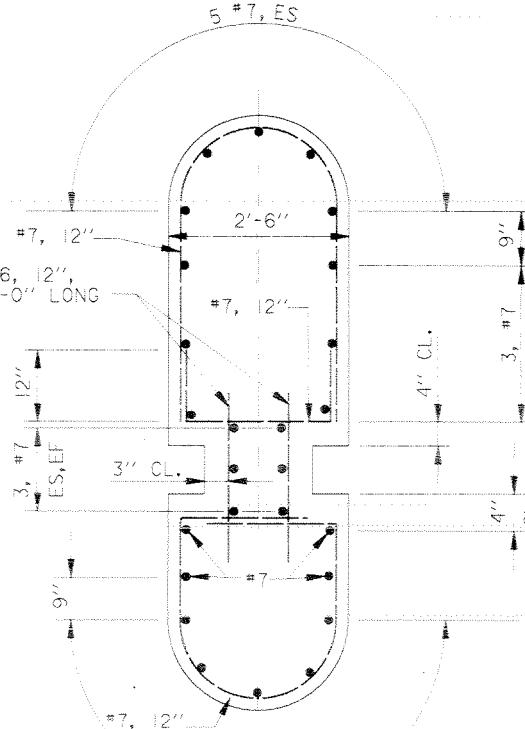




DETAIL 6
SCALE: $\frac{3}{4}'' = 1'-0''$

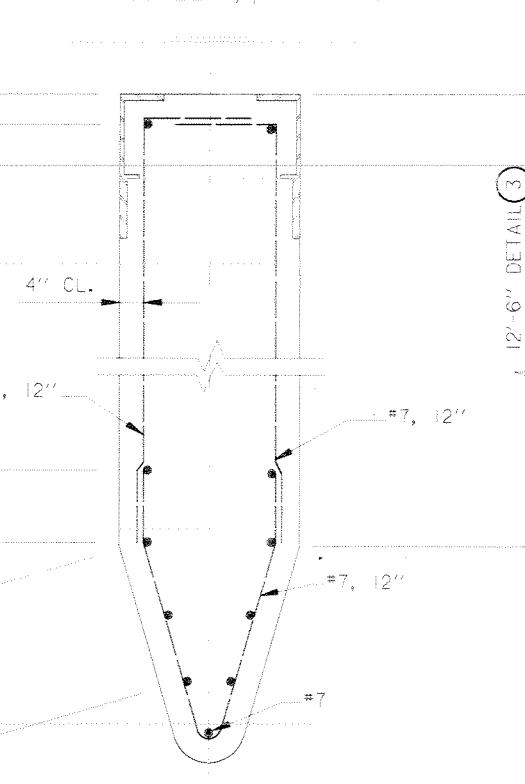


DETAIL 7
SCALE: $\frac{3}{4}'' = 1'-0''$

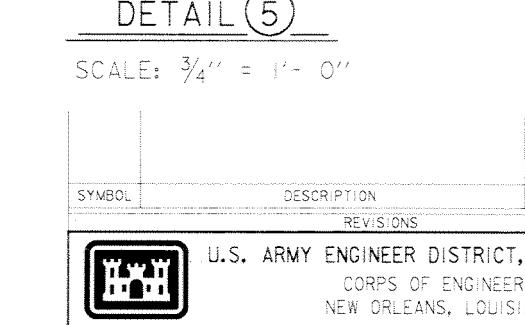


DETAIL 8
SCALE: $\frac{3}{4}'' = 1'-0''$

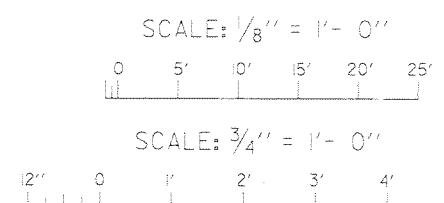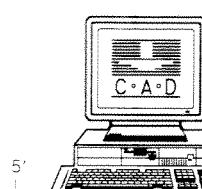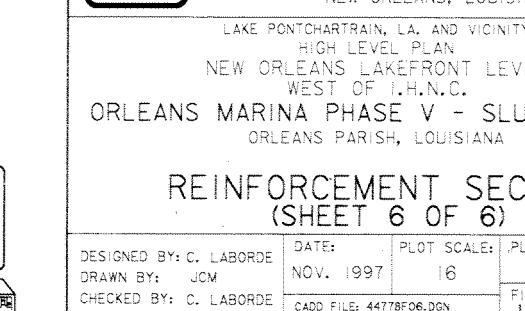

Safety is a Part of Your Contract

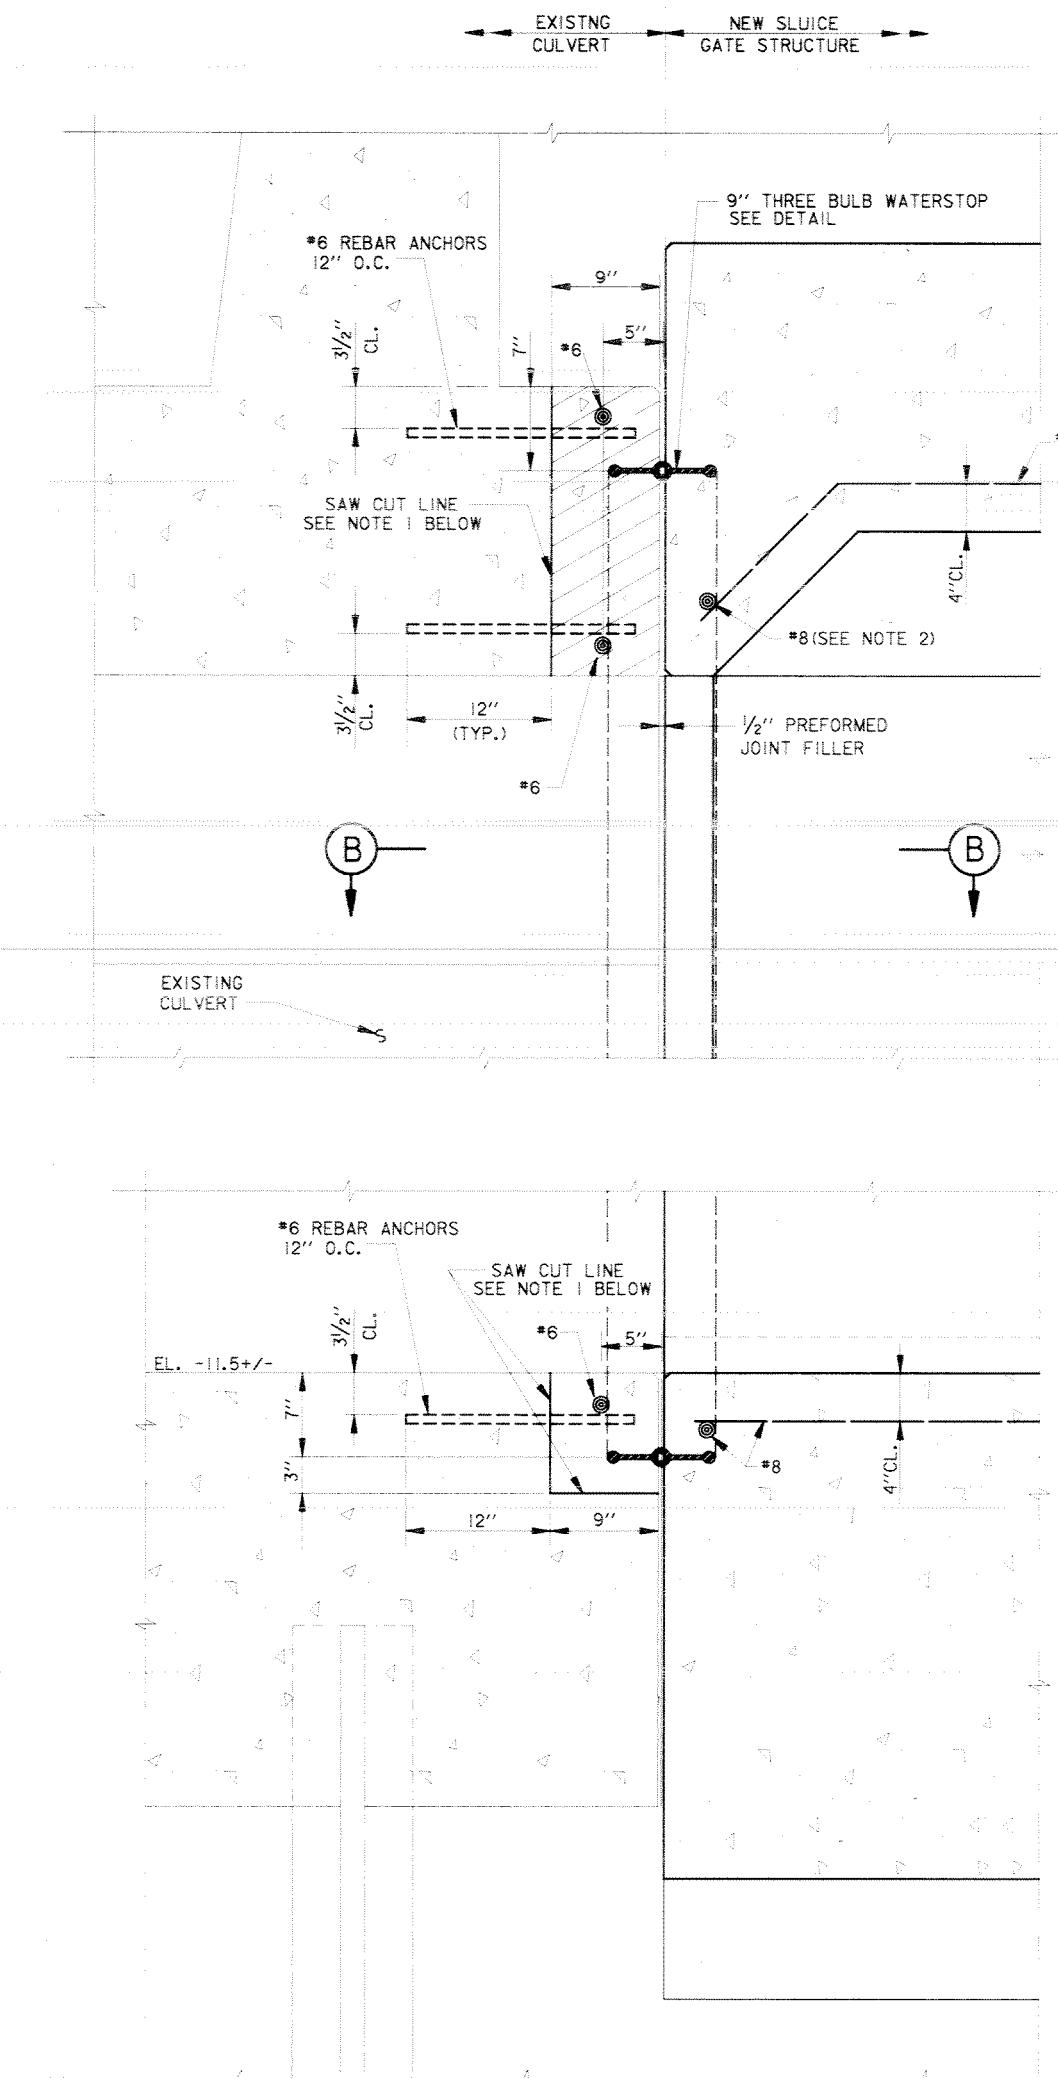

SECTION A

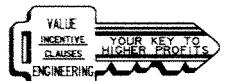

WEST EXTERIOR CULVERT WALL AS SHOWN

EAST EXTERIOR CULVERT WALL
OPPOSITE HAND AND SIMILAR

SCALE: $\frac{1}{2}'' = 1'-0''$

NOTES:


1. SAW-CUT 25% TO 30% OF THICKNESS OF EXISTING WALL OR THRU EXISTING REINFORCING, EACH FACE, THEN SHEAR REMAINING PORTION OF EXISTING CONCRETE TO BE REMOVED.

2. FIELD BEND REINFORCING TO CLEAR
THREE BULB WATERSTOPS

SECTION B

SECTION B


SCALE: $1\frac{1}{2}'' = 1'-0''$

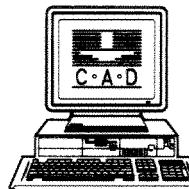

A technical drawing showing a curved metal strip. The strip has a central circular hole with a diameter of $1\frac{1}{2}''$. On either side of this hole are two semi-circular notches, each with a radius of $\frac{1}{4}''$. The total width of the strip is $1\frac{1}{4}''$. A dimension of $\frac{3}{8}''$ is shown from the center of the hole to the outer edge of the strip. Another dimension of $\frac{3}{4}''$ is shown from the center of the hole to the inner edge of the strip.




THREE BULB WATERSTOP DETAIL


SCALE: 12" = 1'-0"

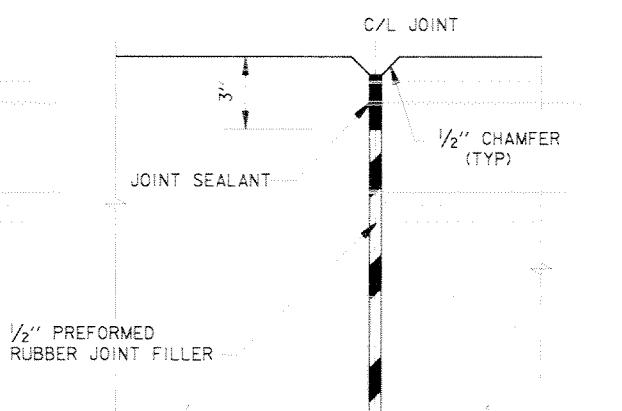

TYPICAL JOINT SEALANT DETAIL

SCALE: 3" = 100'

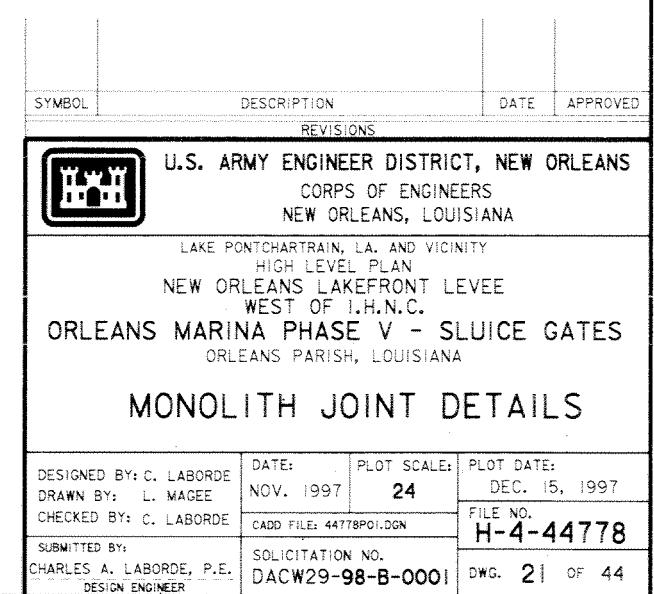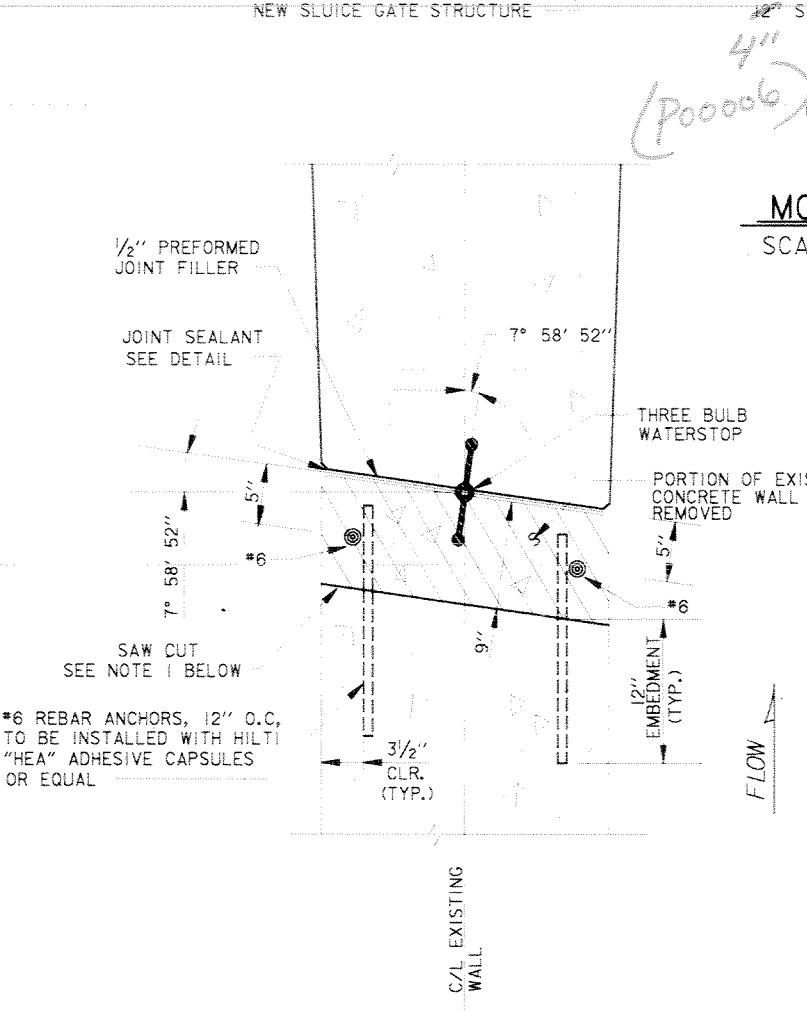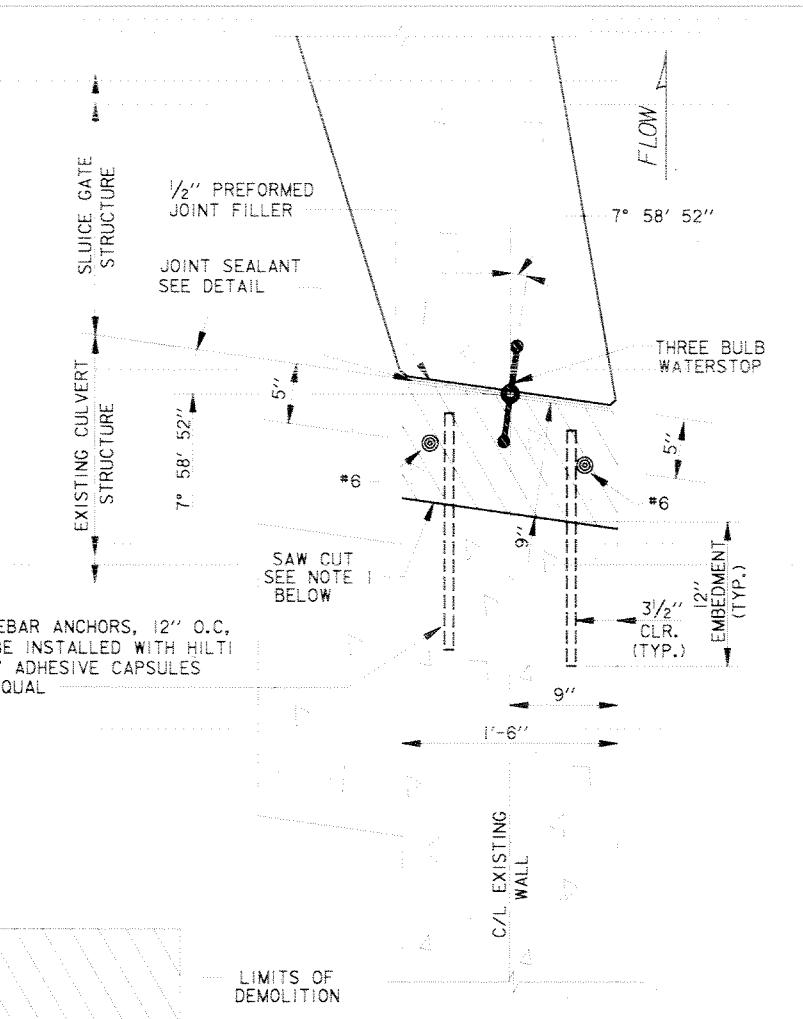

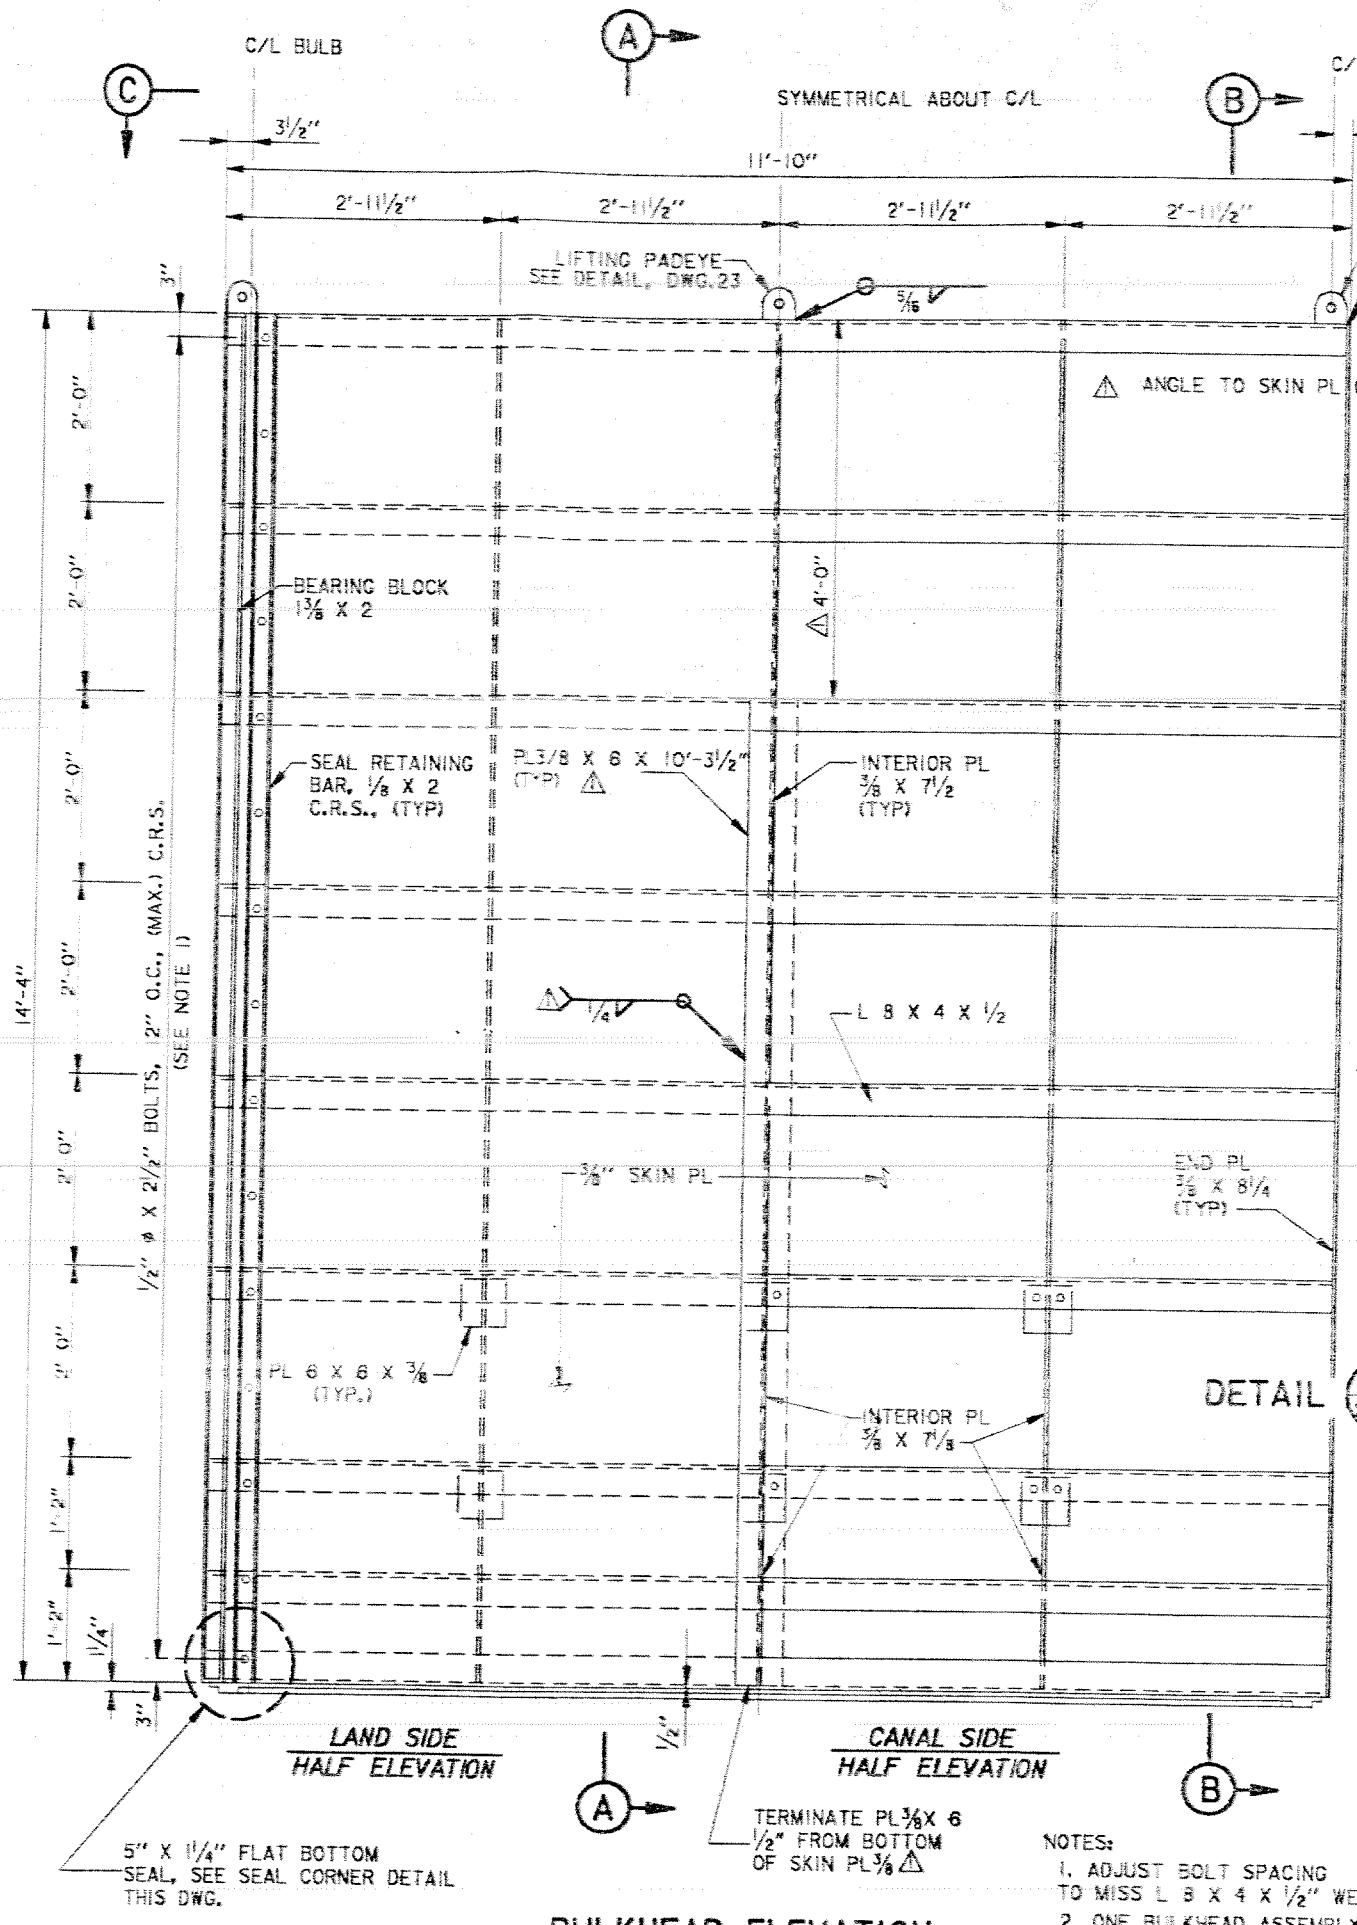

3 X 1/4 FLAT BOTTOM
SEAL, SEE SEAL CORNER DETAIL.
THIS DWG.

BULKHEAD ELEVATION

SCALE: 1" = 1'-0"

LAND SIDE


NOTES:
1. ADJUST BOLT SPACING
TO MISS L 8 X 4 X $\frac{1}{2}$ " WEBS
2. ONE BULKHEAD ASSEMBLY
SHOWN, 4 EACH REQUIRED

SECTION A

SCALE: 1" = 1'-0"

SECTION B

SCALE: 1" = 1'-0"

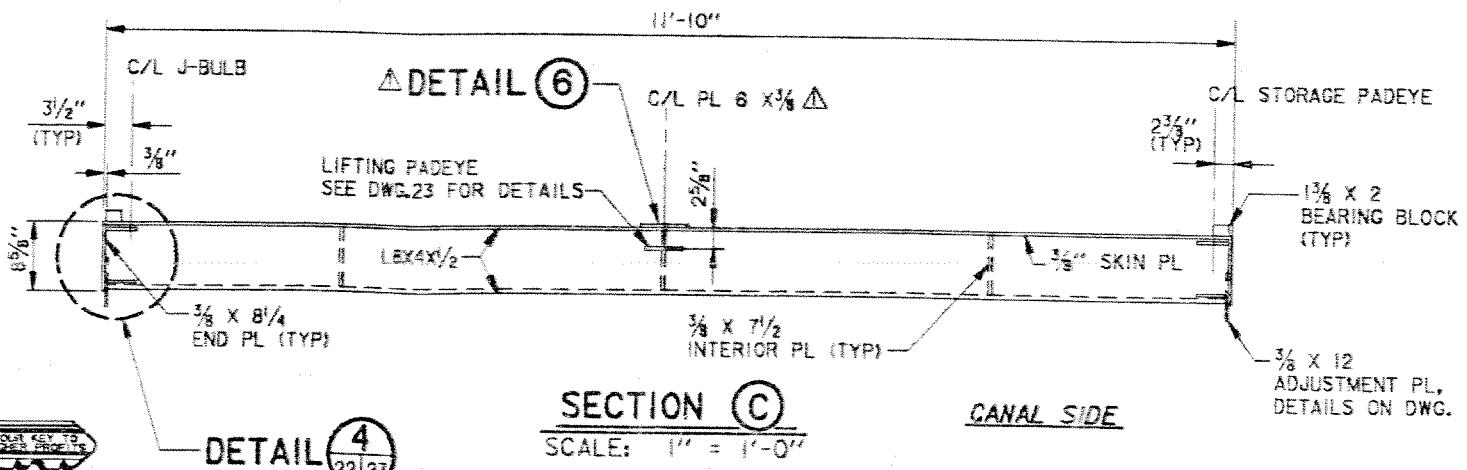


SECTION C

SCALE: 1" = 1'-0"

CANAL SIDE


SEAL ANGLE AND PLATE DETAIL

SCALE: 1 1/2" = 1' - 0"

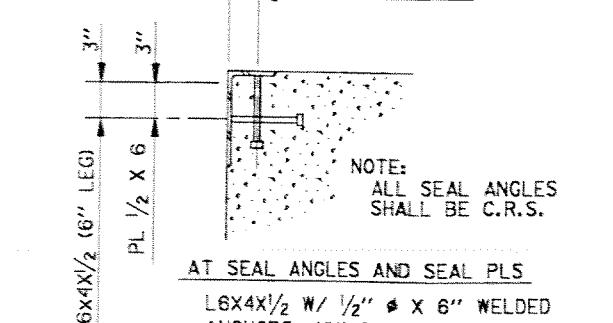

BOTTOM VIEW
SEAL CORNER DETAIL

SCALE: 3'' = 1' - 0"

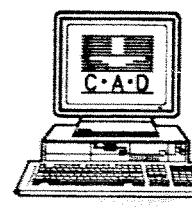

DESIGNED BY: G.LABORDE	DATE: NOV.97	PLOT SCALE: 12	PLOT DATE: FEB. 2, 2000
DRAWN BY: J.DARBY			FILE NO.
CHECKED BY: G.LABORDE	CADD FILE: 44778E05.DGN		H-4-44778
SUBMITTED BY: CHARLES A. LABORDE P.E. <small>DETNT ENGRNG CO.</small>	SOLICITATION NO. DACW29-98-B-0001		DWG. 22 OF 46

REVISIONS

U.S. ARMY ENGINEER DISTRICT, NEW ORLEANS

CORPS OF ENGINEERS

NEW ORLEANS, LOUISIANA

LAKE PONTCHARTRAIN, LA. AND VICINITY

HIGH LEVEL PLAN

NEW ORLEANS LAKEFRONT LEVEE


WEST OF I.H.N.C.

ORLEANS MARINA PHASE V - SLUICE GATES












ORLEANS PARISH, LOUISIANA

ALUMINUM BULKHEADS

DESIGNED BY: C LABORDE	DATE: NOV. 97	PLOT SCALE: 12	PLOT DATE: FEB. 2, 2000
DRAWN BY: J LABORDE	FILE NO. H-4-44778		
CHECKED BY: C LABORDE			
SUBMITTED BY: CHARLES A. LABORDE, P.E. DETAN ENGINEERS	SOLICITATION NO. DACPW29-98-B-0001	DWG. 22	OF 46


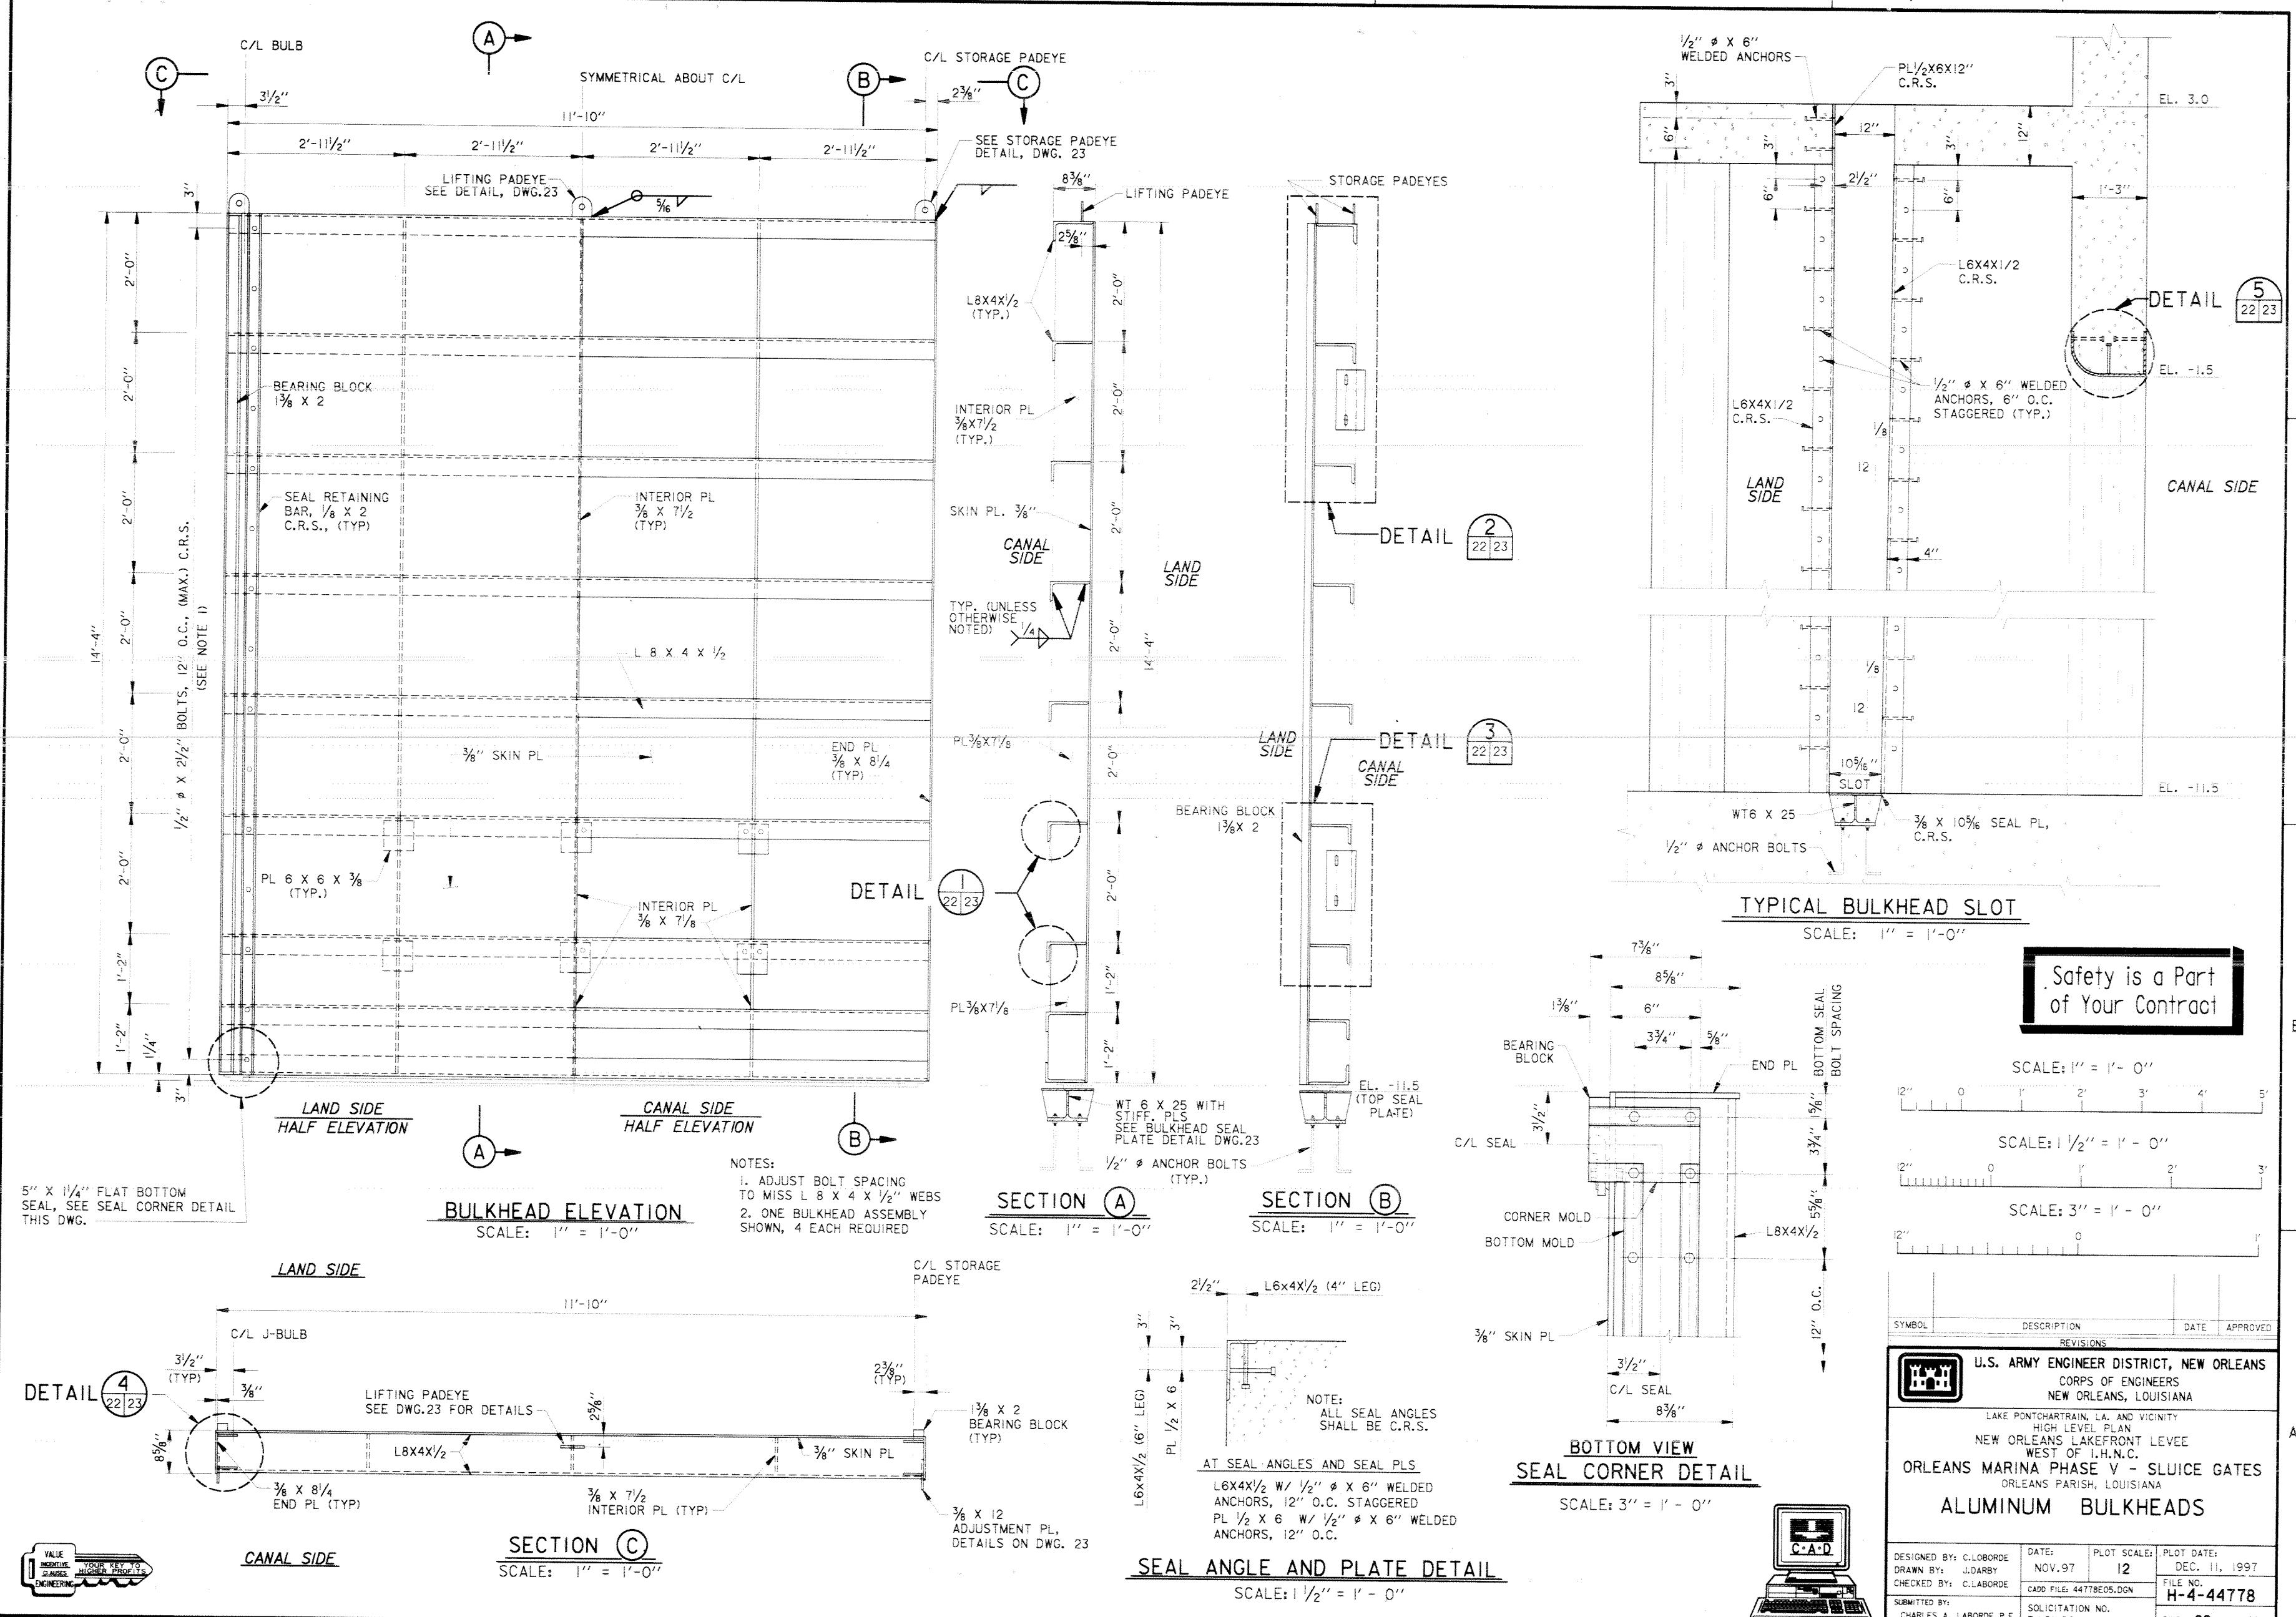


Safety is a Part
of Your Contract

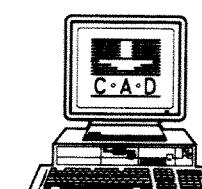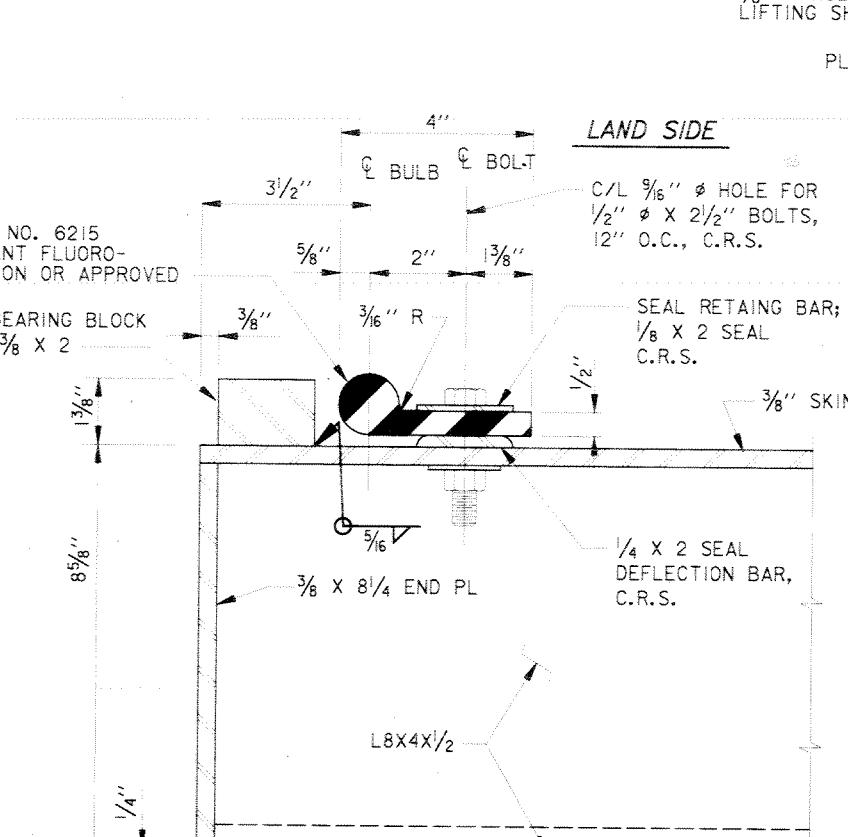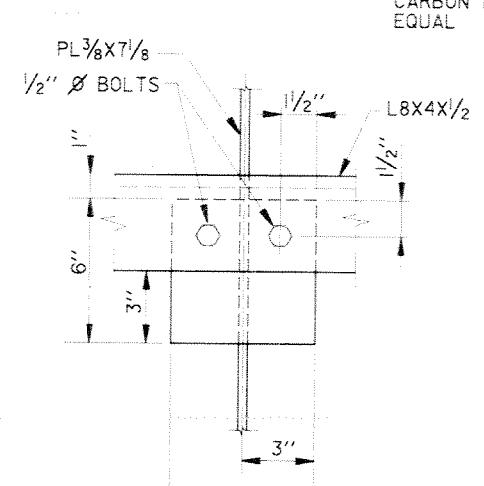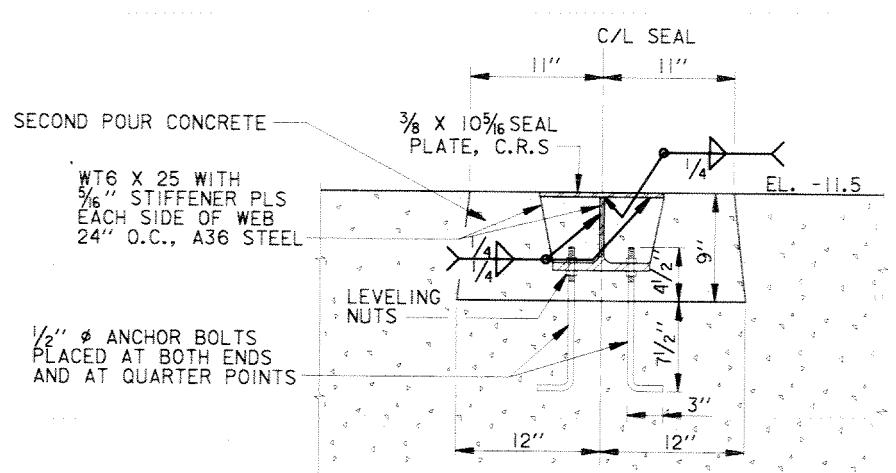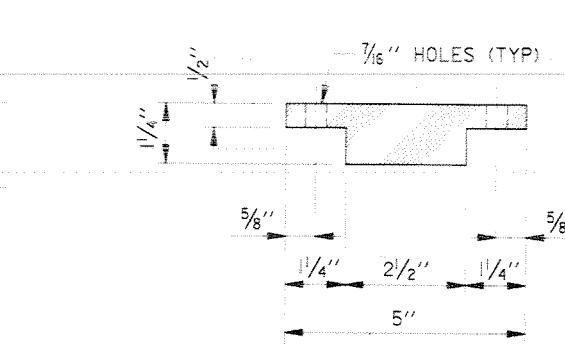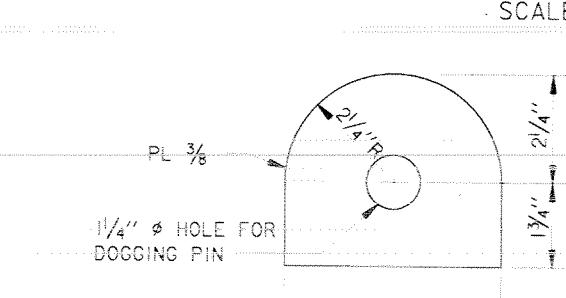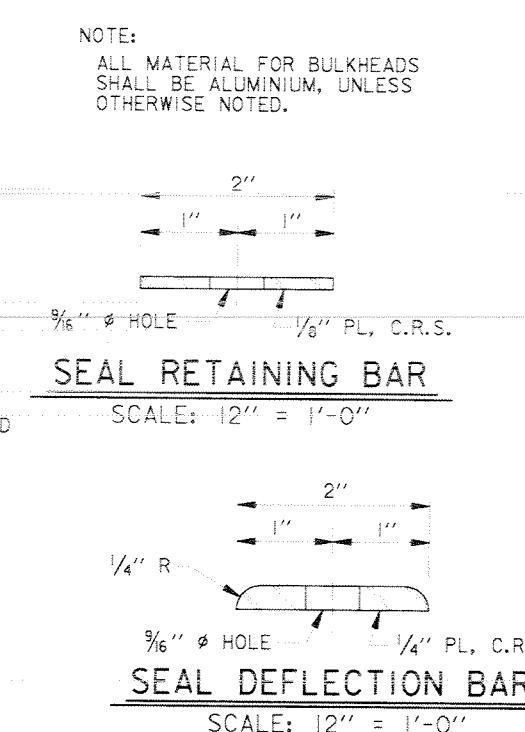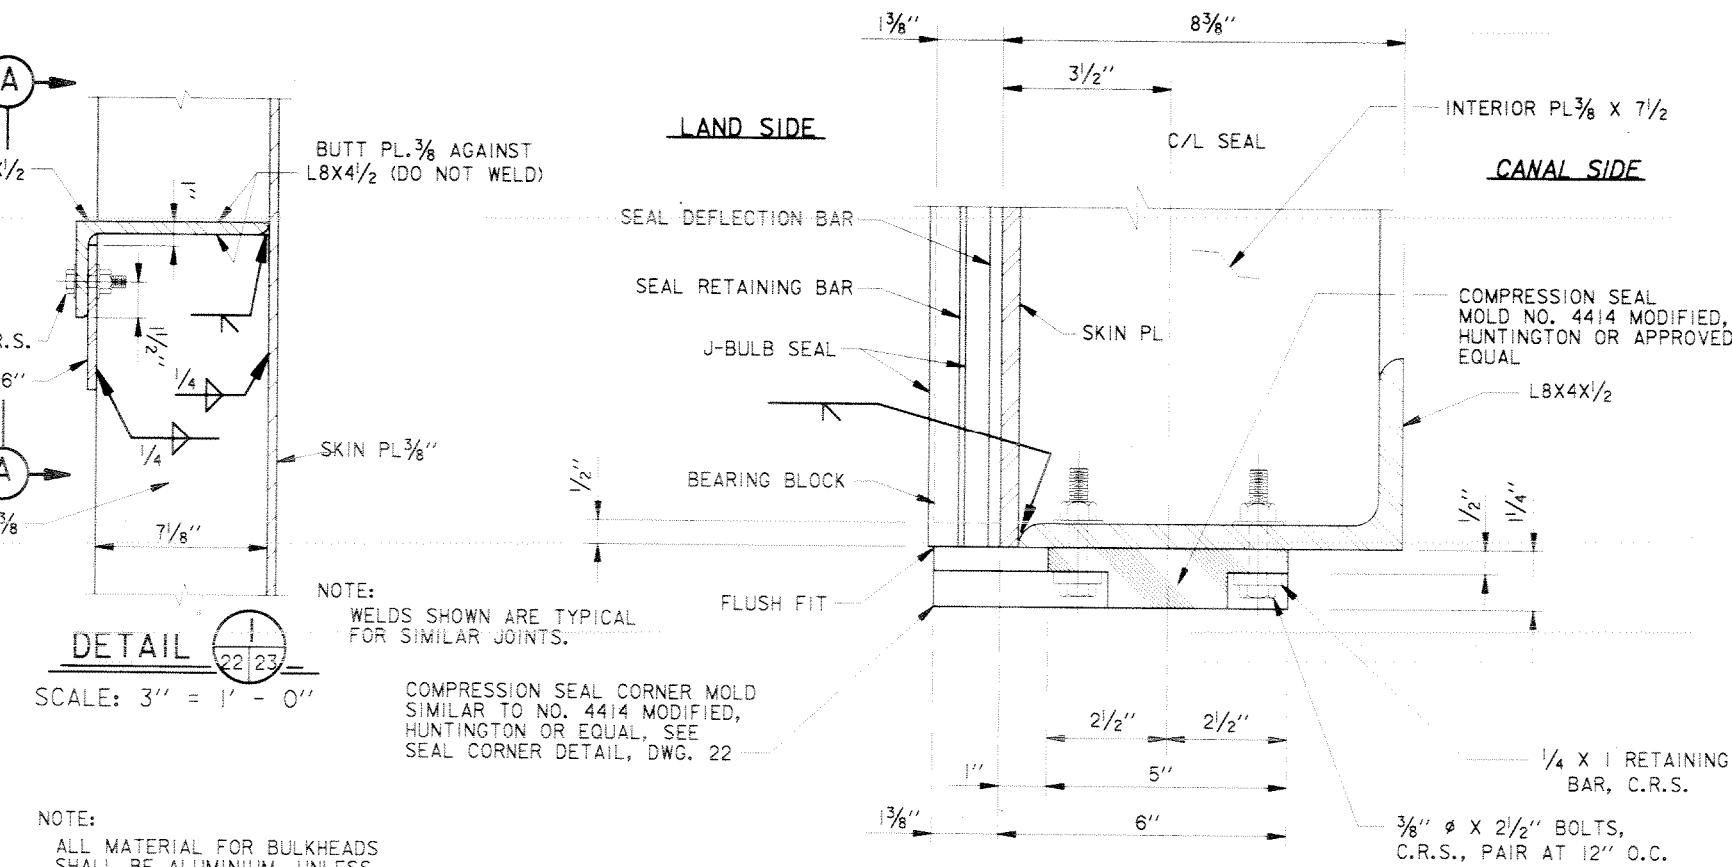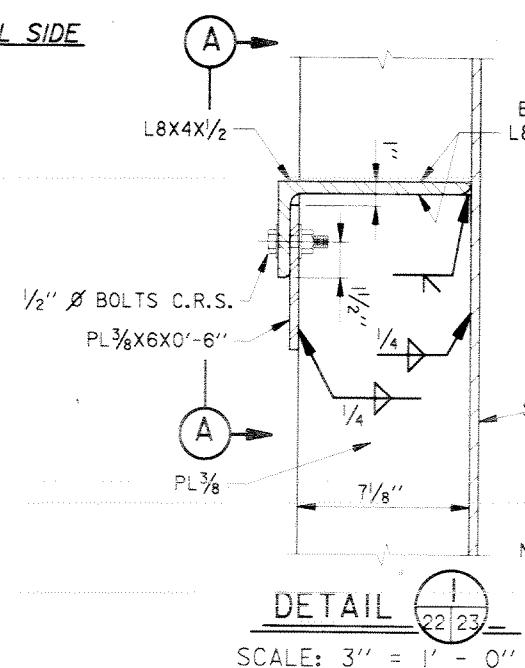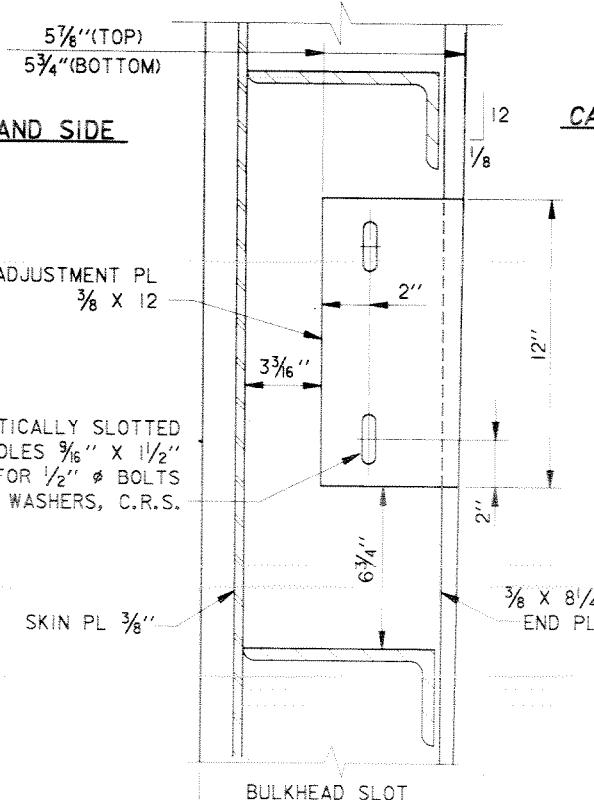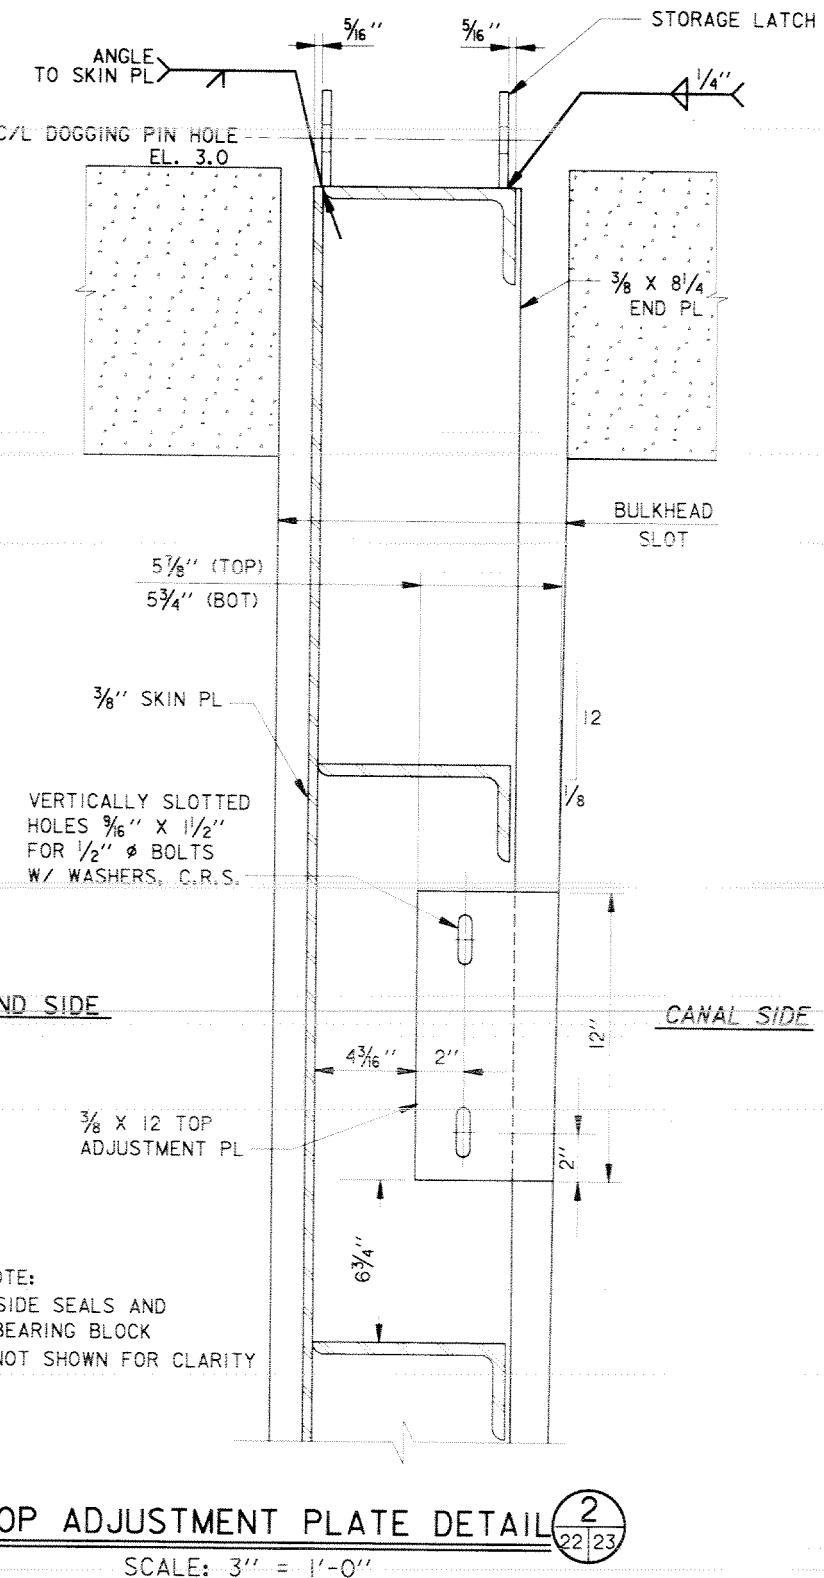


SYMBOL	DESCRIPTION	DATE	APPROVED
REVISIONS			
	U.S. ARMY ENGINEER DISTRICT, NEW ORLEANS CORPS OF ENGINEERS NEW ORLEANS, LOUISIANA		
	LAKE PONTCHARTRAIN, LA. AND VICINITY HIGH LEVEL PLAN NEW ORLEANS LAKEFRONT LEVEE WEST OF I.H.N.C.		
	ORLEANS MARINA PHASE V - SLUICE GATES ORLEANS PARISH, LOUISIANA		
	ALUMINUM BULKHEAD DETAILS		
DESIGNED BY: CLABORDE	DATE: NOV. 97	PLOT SCALE: 4	PLOT DATE: DEC. 15, 1997
DRAWN BY: J.DARBY			FILE NO. H-4-44778
CHECKED BY: CLABORDE			CADD FILE: 44778ED4.DCN
SUBMITTED BY: CHARLES A. LABORDE P.E.			SOLICITATION NO. DACW29-98-B-0001
DESIGN ENGINEER			DWG. 23 OF 46

Safety is a Part
of Your Contract

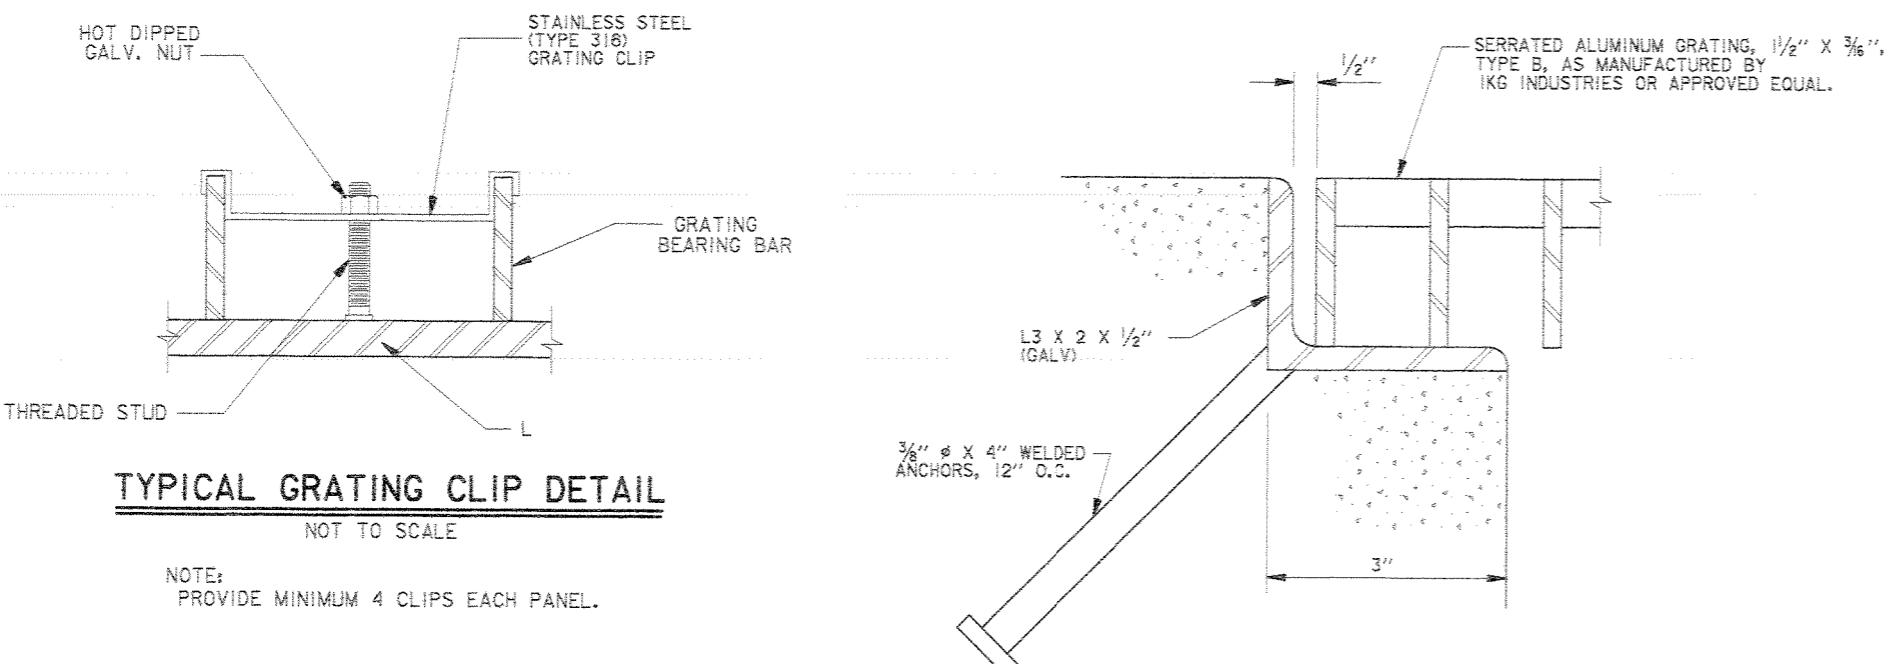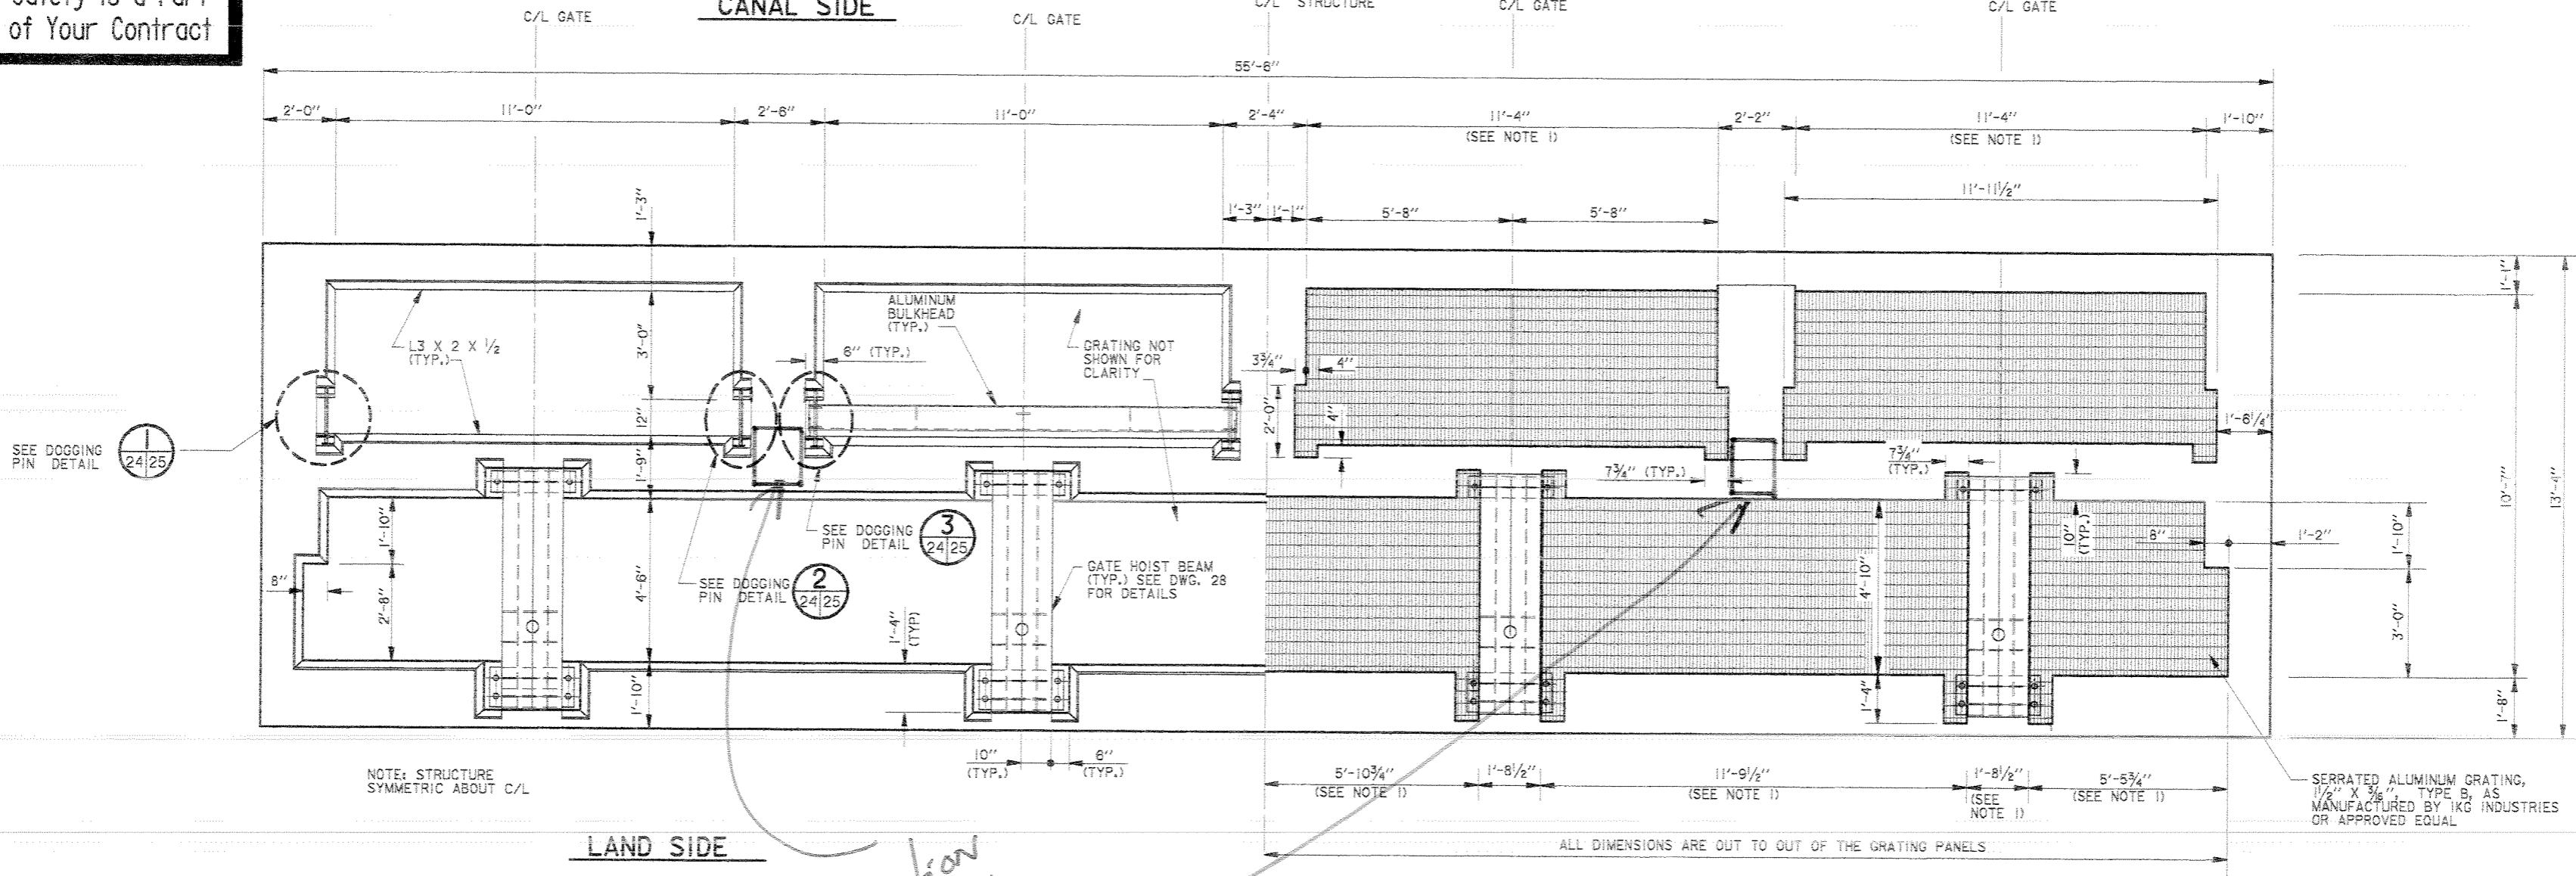

TYPICAL SUPPORT ANGLE ANCHORAGE

N.T.S.

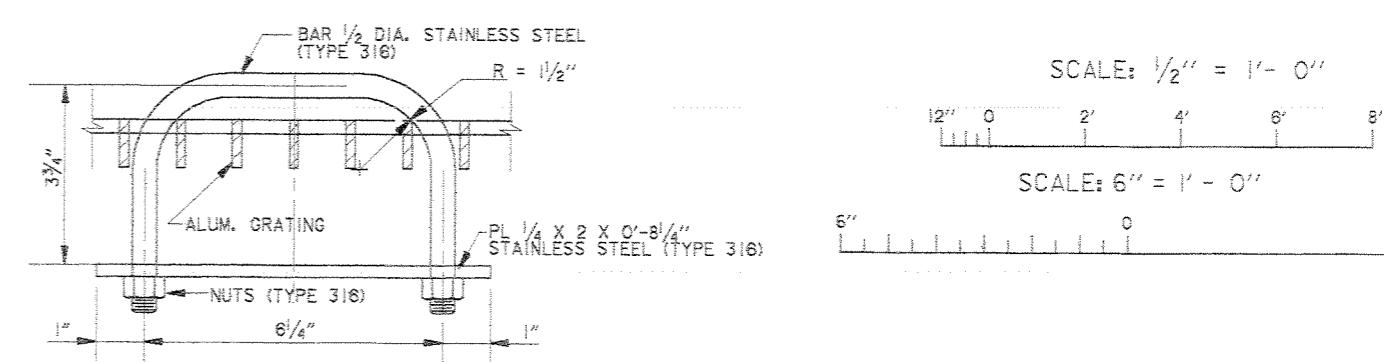

NOTE: PROVIDE 2 LIFTING HANDLES FOR EACH GRATING PANEL. LOCATION OF THE LIFTING HANDLES SHALL BE APPROVED BY THE CONTRACTING OFFICER

SYMBOL	REVISED GRATING TO MATCH CHANGES	2/1/99	CAL
	DESCRIPTION	DATE	APPROVED

U.S. ARMY ENGINEER DISTRICT, NEW ORLEANS
CORPS OF ENGINEERS
NEW ORLEANS, LOUISIANA

LAKE PONTCHARTRAIN, LA. AND VICINITY
HIGH LEVEL PLAN
NEW ORLEANS LAKEFRONT LEVEE
WEST OF I.H.N.C.

ORLEANS MARINA PHASE V - SLUICE GATES
ORLEANS PARISH, LOUISIANA


GRATING PLAN AND DETAILS

DESIGNED BY: C. LABORDE	DATE:	PLOT SCALE:	PLOT DATE:
DRAWN BY: C. BRANSTETTER	NOV. 1997	24	FEB. 1, 1999
CHECKED BY: C. LABORDE			
CADD FILE: 44778UD.DDN			FILE NO. H-4-44778
SUBMITTED BY: CHARLES A. LABORDE, P.E.	SOLICITATION NO.		
DESIGN ENGINEER	DACW29-98-B-0001		DWG. 24 OF 46



Safety is a Part of Your Contract

CANAL SIDE

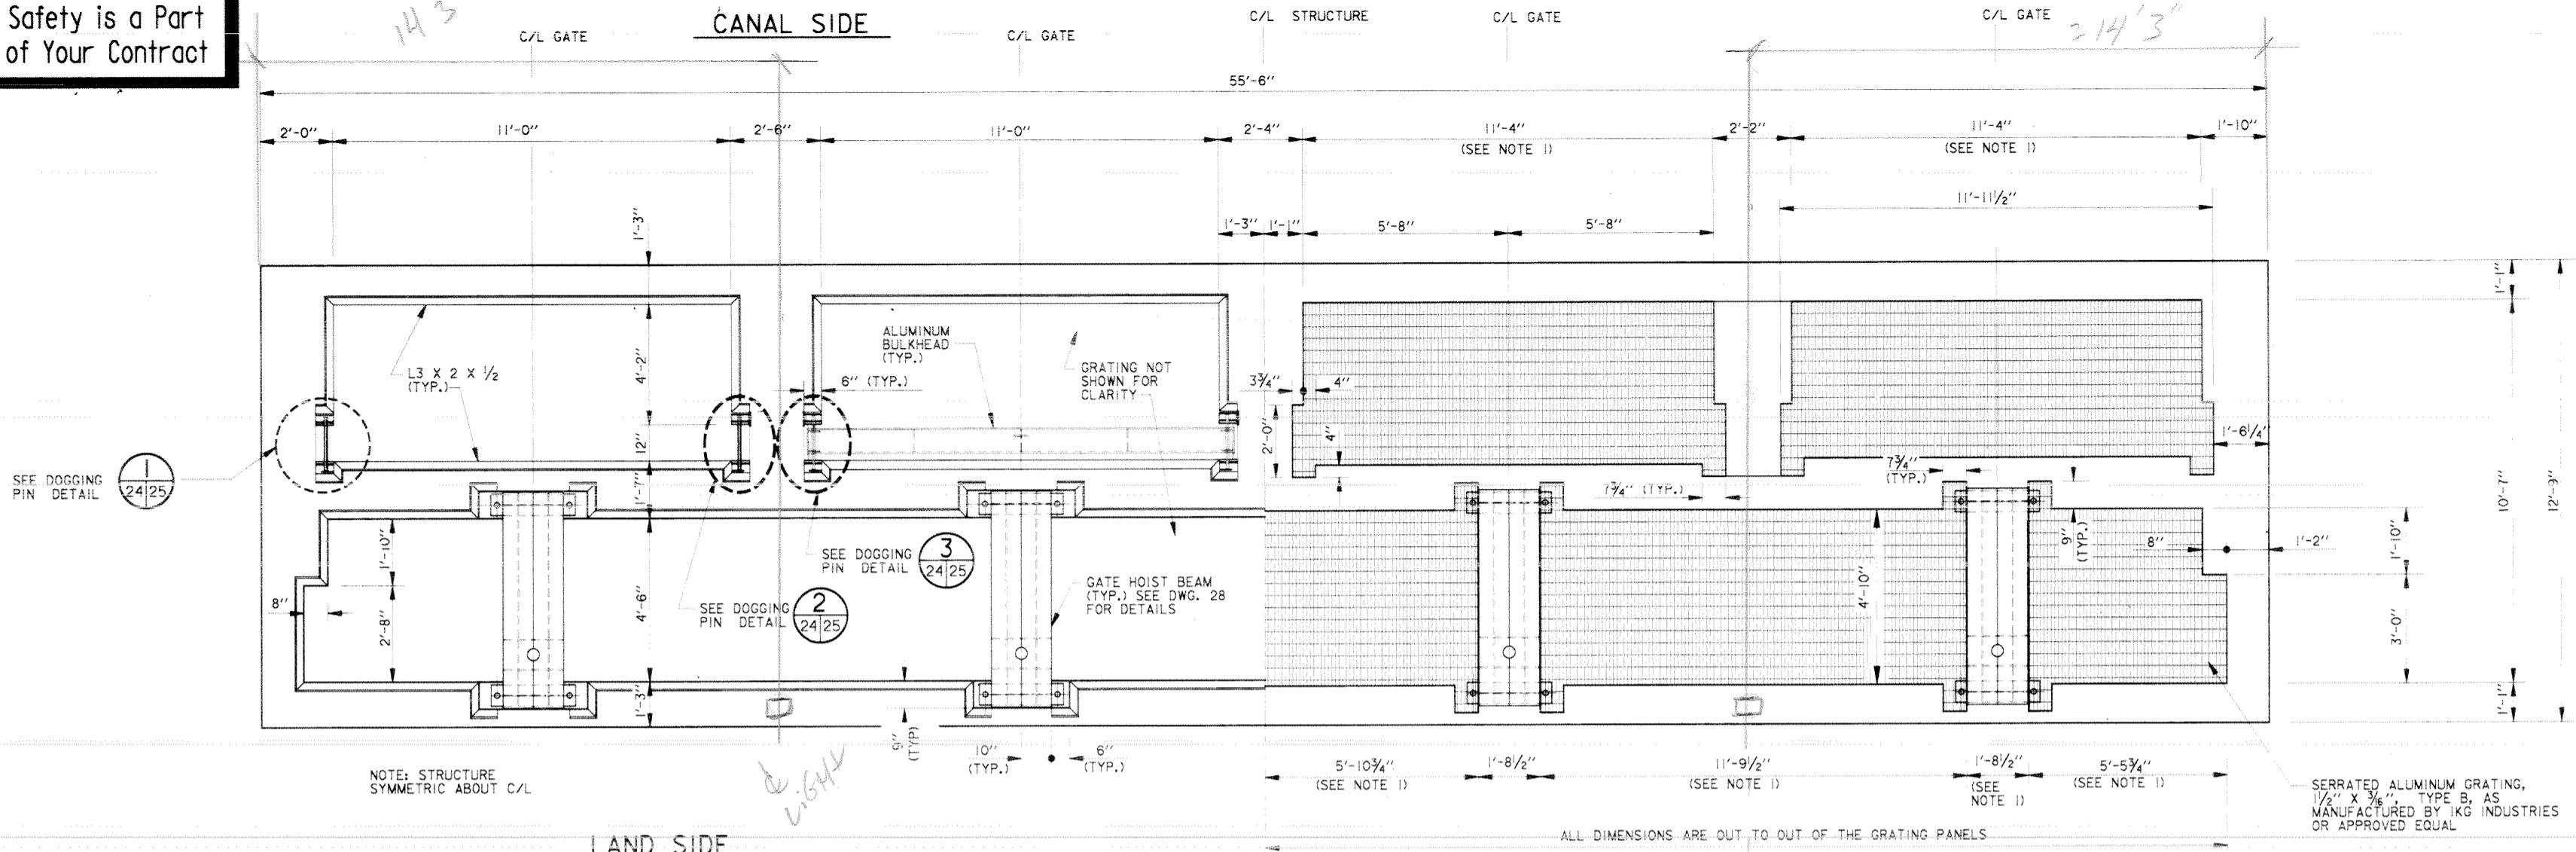


LAND SIDE

GRATING PLAN

SCALE: $\frac{1}{3}'' = 1' - 0''$

- NOTES:


 1. PROVIDE SUFFICIENT NUMBER OF ALUMINUM GRATING PANELS WITHIN EACH OPENING SO THAT THE WEIGHT OF EACH PANEL IS LESS THAN OR EQUAL TO 65 LBS.
 2. AFTER FABRICATION, THE GRATING SUPPORT ASSEMBLY SHALL BE HOT DIP GALVANIZED PRIOR TO INSTALLATION.

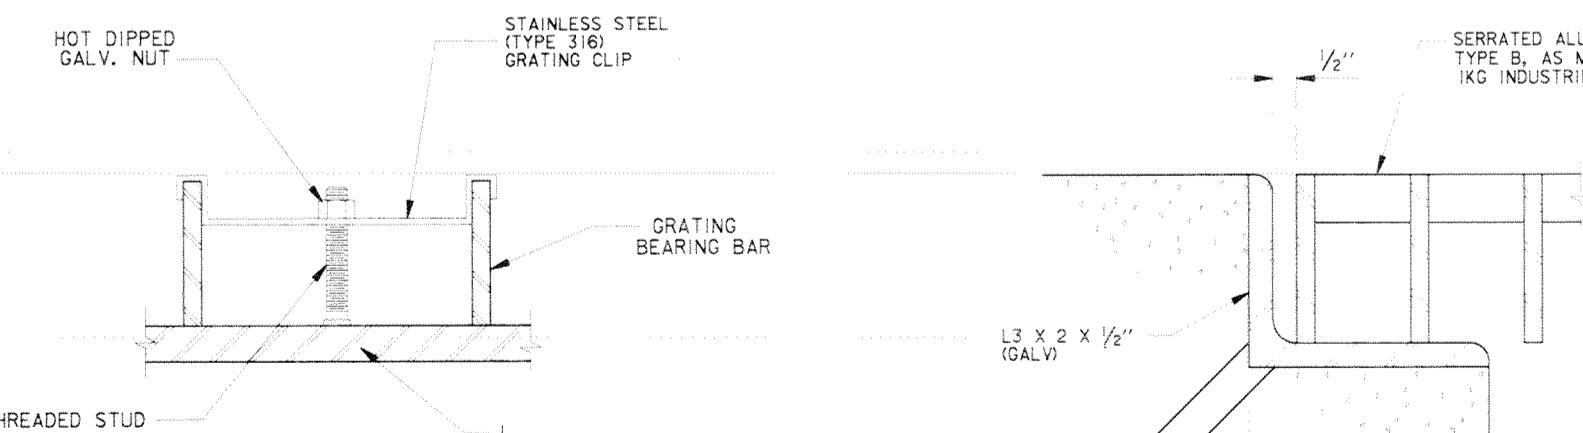

TYPICAL GRATING CLIP DETAIL


NOT TO SCALE

NOTE:
PROVIDE MINIMUM 4 CLIPS EACH PANEL.

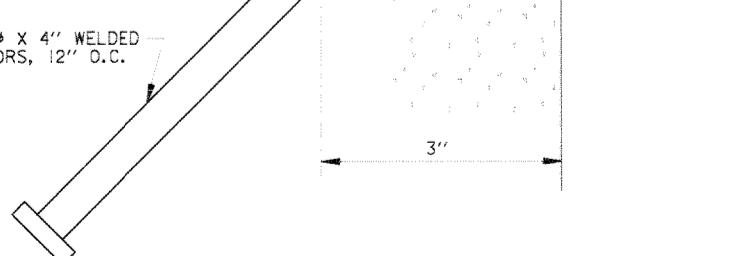

TYPICAL SUPPORT ANGLE ANCHORAGE

N.T.S

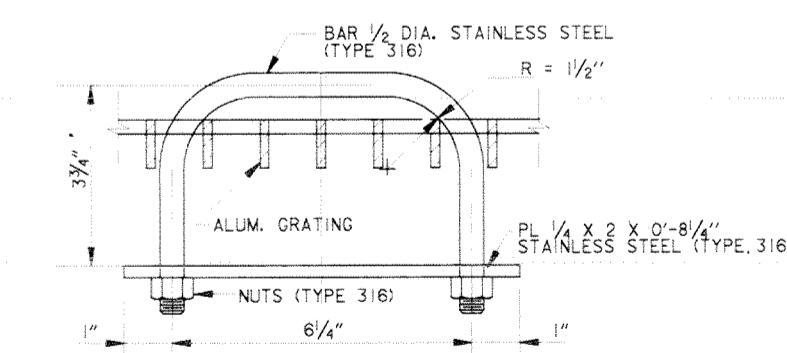

LIFTING HANDLE DETAIL




SCALE: 6'' = 1' = 0"

NOTE: PROVIDE 2 LIFTING HANDLES FOR EACH GRATING PANEL. LOCATION OF THE LIFTING HANDLES SHALL BE APPROVED BY THE CONTRACTING OFFICER



SYMBOL	DESCRIPTION	DATE	APPROVED
	REVISIONS		
	<p style="text-align: center;">U.S. ARMY ENGINEER DISTRICT, NEW ORLEANS</p> <p style="text-align: center;">CORPS OF ENGINEERS</p> <p style="text-align: center;">NEW ORLEANS, LOUISIANA</p>		
	<p style="text-align: center;">LAKE PONTCHARTRAIN, LA. AND VICINITY</p> <p style="text-align: center;">HIGH LEVEL PLAN</p> <p style="text-align: center;">NEW ORLEANS LAKEFRONT LEVEE</p> <p style="text-align: center;">WEST OF I.H.N.C.</p> <p style="text-align: center;">ORLEANS MARINA PHASE V - SLUICE GATES</p> <p style="text-align: center;">ORLEANS PARISH, LOUISIANA</p>		
	<h1>GRATING PLAN AND DETAILS</h1>		
DESIGNED BY: C. LABORDE DRAWN BY: C. BRANSTETTER CHECKED BY: C. LABORDE	DATE: NOV. 1997 CADD FILE# 44778U01.DGN	PLOT SCALE: 24	PLOT DATE: NOV. 10, 1997 FILE NO. H-4-44778
SUBMITTED BY: CHARLES A. LABORDE, P.E.	SOLICITATION NO. DACW29-98-B-0001		
	DWG. 24 OF 46		


Safety is a Part of Your Contract

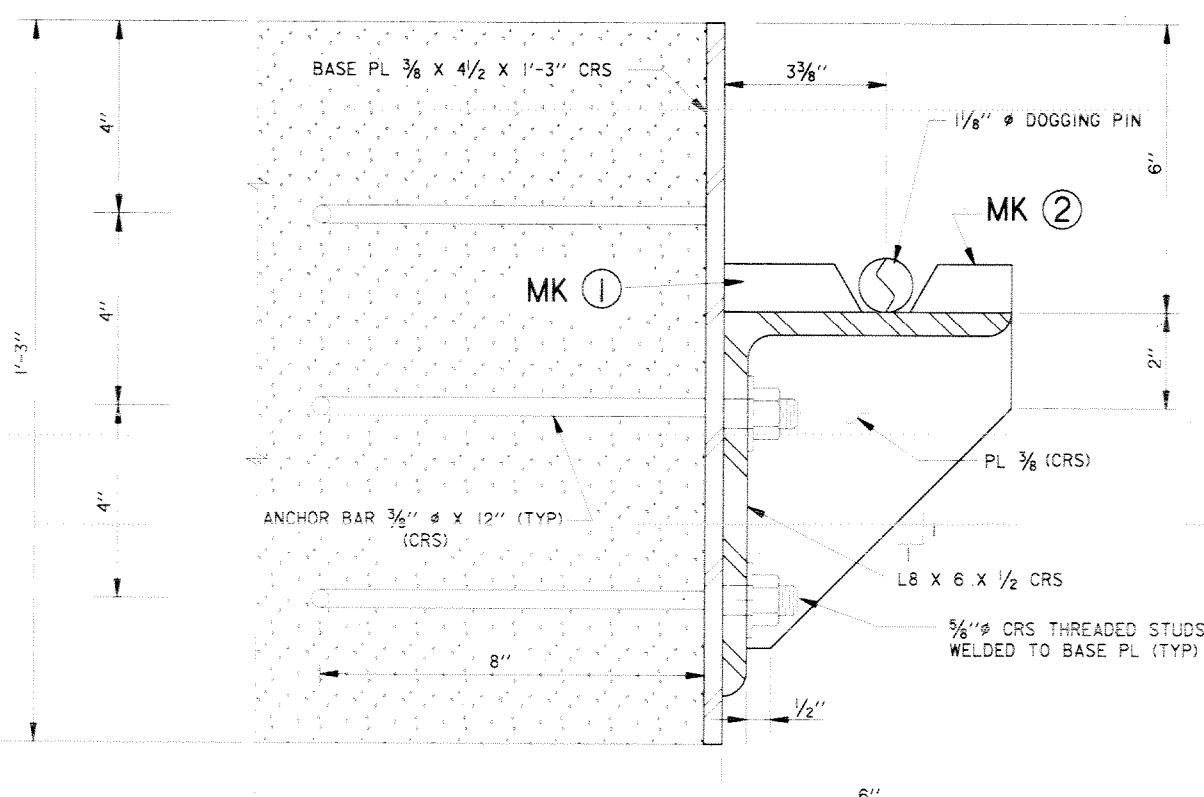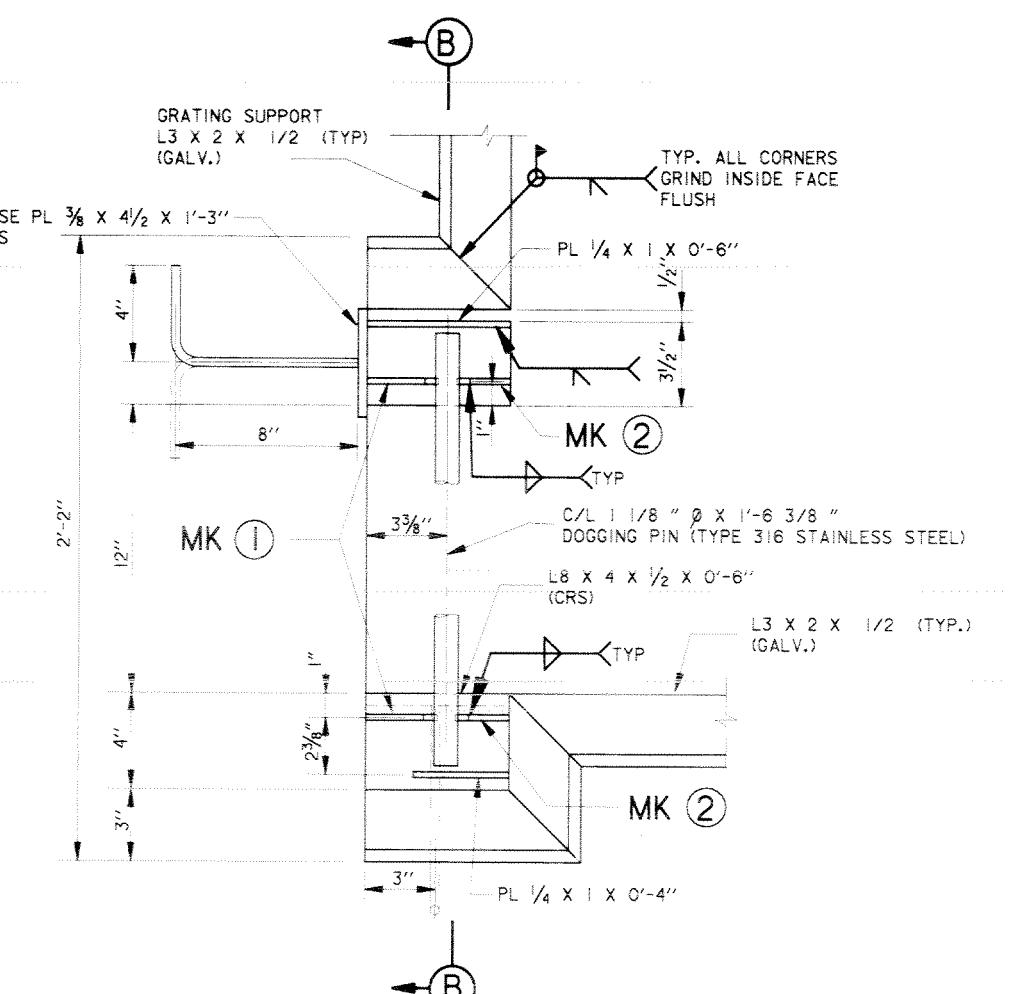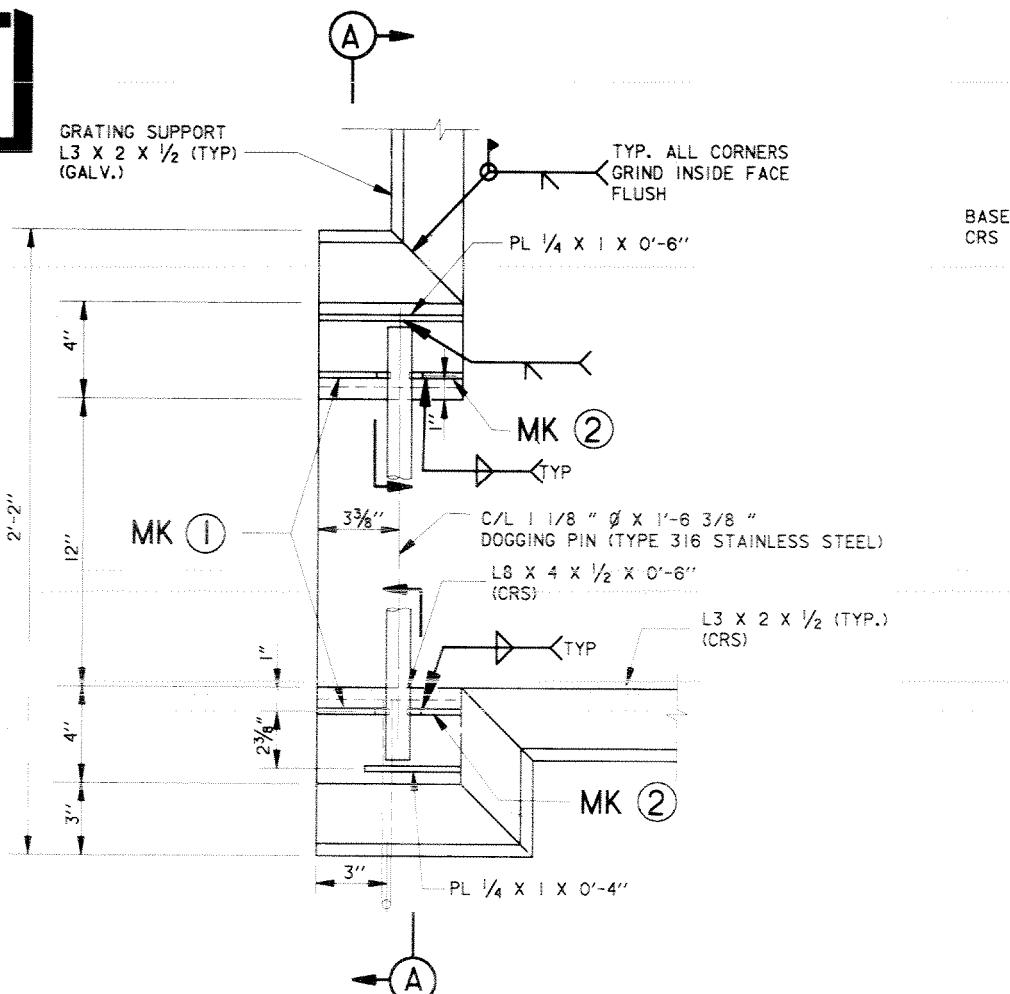

DOGGIN PIN SUPPORT

DETAIL 24-25 SHOWN

SCALE: 3 " = 1' - 0"

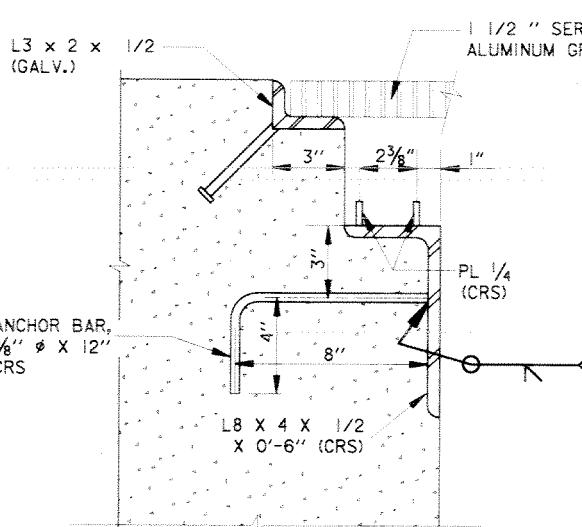


DOGGIN PIN SUPPORT

DETAIL 24-25 SHOWN

DETAIL  SIMILAR
(OPPOSITE HAND)

SCALE: 3 " = 1' = 0"

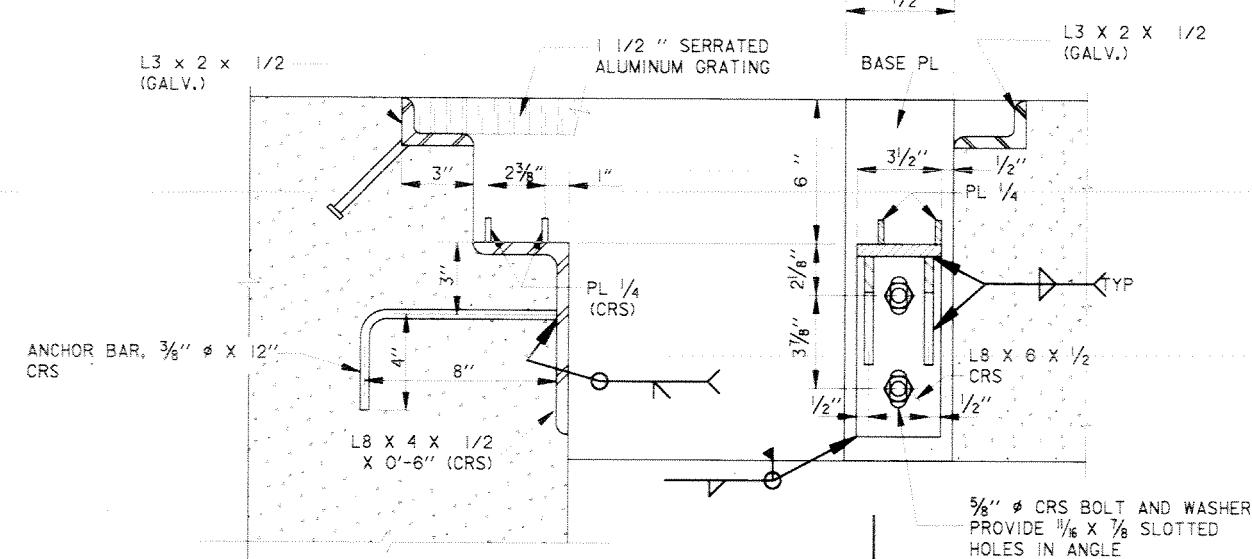


SECTION B

G PIN AND BULKHEAD
DOWN FOR CLARITY

SECTION A

SCALE: 3'' = 1' - 0''

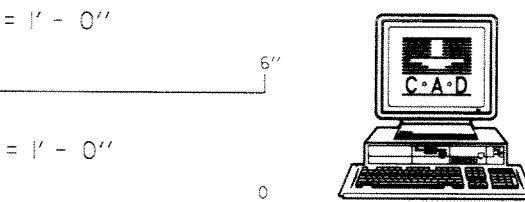

REVISIONS

U.S. ARMY ENGINEER DISTRICT, NEW ORLEANS

CORPS OF ENGINEERS

NEW ORLEANS, LOUISIANA


LAKE PONTCHARTRAIN, LA. AND VICINITY
HIGH LEVEL PLAN
NEW ORLEANS LAKEFRONT LEVEE
WEST OF I.H.N.C.

ORLEANS MARINA PHASE V - SLUICE GATES
ORLEANS PARISH, LOUISIANA

DOGGING PIN SUPPORT

DESIGNED BY: C. LABORDE	DATE:	PLOT SCALE:	PLOT DATE:
DRAWN BY: V. COUVILLION	NOV. 97	2	NOV. 10, 1997
CHECKED BY: C. LABORDE			
SUBMITTED BY: CHARLES A. LABORDE, P.E. DESIGN ENGINEER	CADD FILE: 4477BN04.DGN SOLICITATION NO. DACW29-B-98-0001		FILE NO. H-4-44778
			DWG. 25 OF 46

Safety is a Part of Your Contract

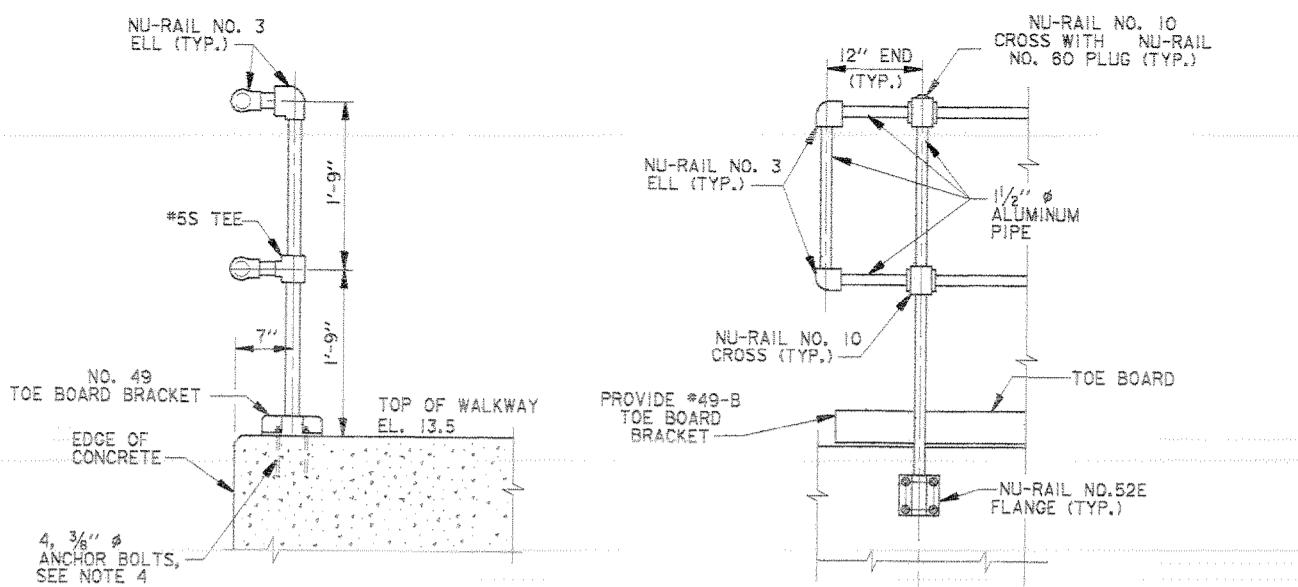


SECTION D

SCALE: 1 " = 1' - 0"




SCALE: 1'' = 1' - 0''

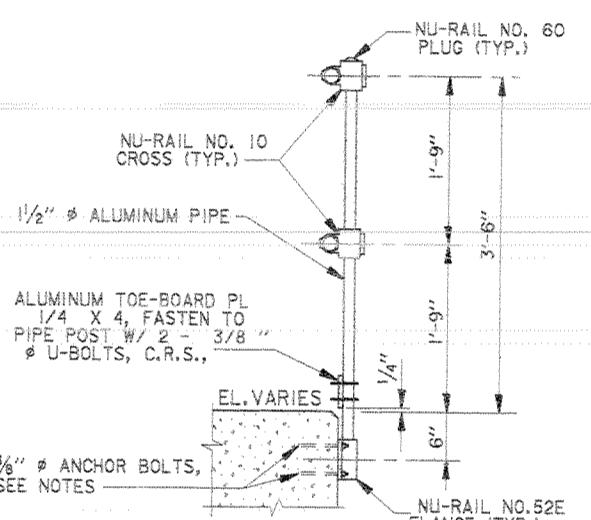


SECTION B

SCALE: 1" = 1'-0"

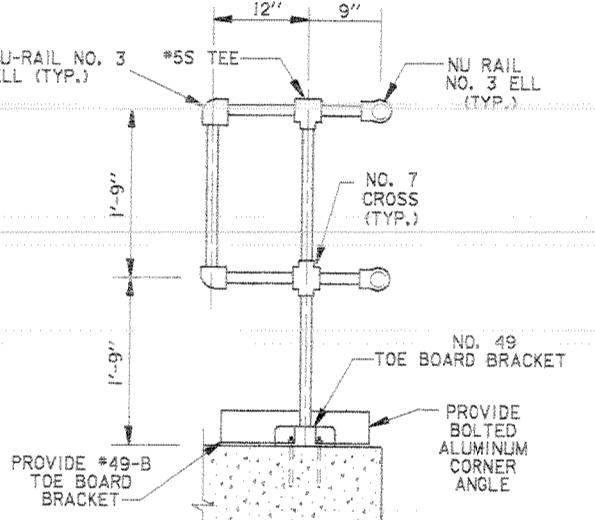

SECTION E

SCALE: 1" = 1' - 0"

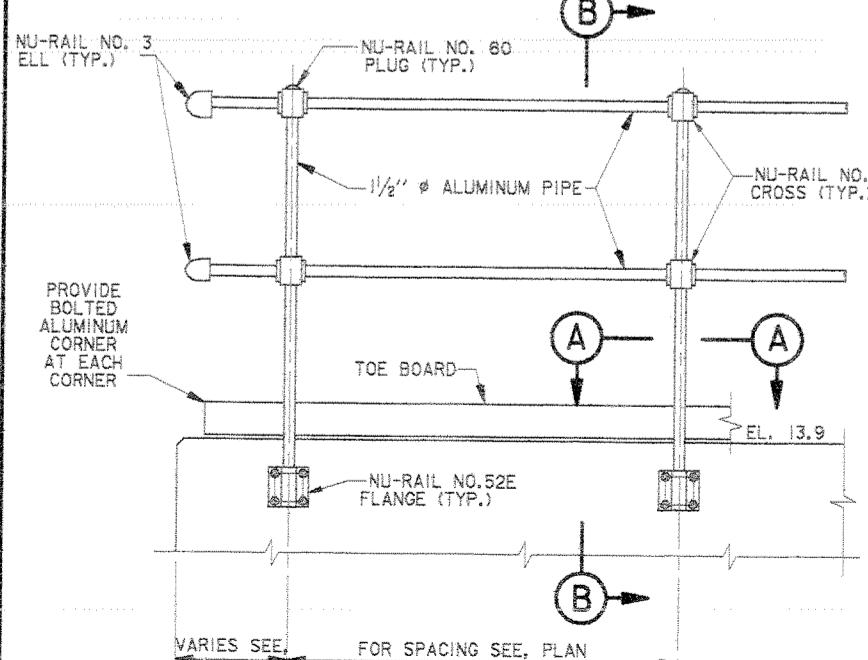


TYPICAL GUARDRAIL ELEVATION

SCALE: 1'' = 1'-0"


- GUARDRAIL NOTES

 1. ALL GUARDRAIL FITTINGS SHALL BE ALUMINUM NU-RAIL SLIP-ON OFFSET FITTINGS AS MANUFACTURED BY THE HOLLANDER MFG. CO., CINCINNATI, OHIO OR APPROVED EQUAL.
 2. ALL GUARDRAIL PIPE SHALL BE $1\frac{1}{2}$ " ϕ ALUMINUM PIPE, SCHEDULE 40 FOR RAILS AND SCHEDULE 80 FOR POSTS. ALUMINUM SHALL BE ALLOY 6063-T6.
 3. WHERE ALUMINUM IS EXPOSED TO CONCRETE, USE 2 COATS OF BITUMINOUS PAINT OR A NEOPRENE GASKET.
 4. ANCHOR BOLTS SHALL BE HILTI, KWIK BOLT II, C.R.S., $3/8$ " ϕ WITH 5" MINIMUM EMBEDMENT, AS MFD. BY HILTI, TULSA, OKLAHOMA OR APPROVED EQUAL. PROVIDE C.R.S. LOCK WASHERS AND NUTS WITH ANCHOR BOLTS.
 5. ALL BOLTS USED TO FASTEN GUARDRAIL TO STEEL STRINGERS TOE-BOARDS TO TOE-BOARD BRACKETS, CONNECTING ANGLES & TOE BOARDS TO GUARDRAIL POST SHALL BE $3/8$ " ϕ BOLTS W/ LOCK WASHERS AND NUTS C.R.S.

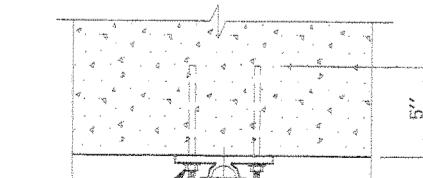


ANCHOR SC
TES


SECTION A

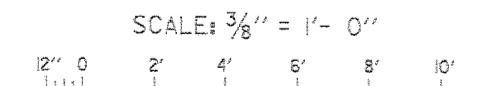


SCALE: $\frac{1}{2}'' = 1'-0''$

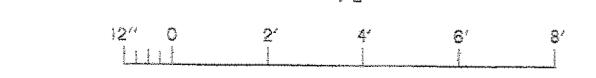

SCALE: 1" = 1'- 0"

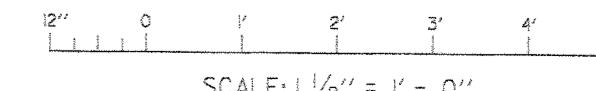

SCALE: $1 \frac{1}{2}'' = 1' - 0''$

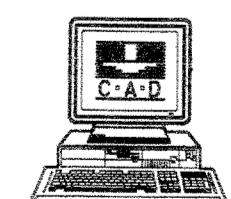

	REVISED GUARDRAIL PLAN TO MATCH CHANGES TO HOIST BEAM	2/1/99	CAL
--	--	--------	-----


SYMBOL	DESCRIPTION	DATE	APPR
	REVISIONS		
	U. S. ARMY ENGINEER DISTRICT, NEW ORLEANS CORPS OF ENGINEERS U. S. ARMY CORPS OF ENGINEERS		

WEST OF I.H.N.C.
ORLEANS MARINA PHASE V - SLUICE GATES
ORLEANS PARISH, LOUISIANA


GUARDRAILS AND DETAILS

DESIGNED BY: C.LABORDE	DATE:	PLOT SCALE:	PLOT DATE:
DRAWN BY: J.DARBY	NOV. 1997	24	FEB. 1, 1999
CHECKED BY: C.LABORDE	CADD FILE: 44778C06.DGN		FILE NO.
SUBMITTED BY: CHARLES A. LABORDE, P.E. DESIGN ENGINEER	SOLICITATION NO. ACW29-98-B-0001		H-4-44778
			DWG. 26 OF 46


Safety is a Part
of Your Contract

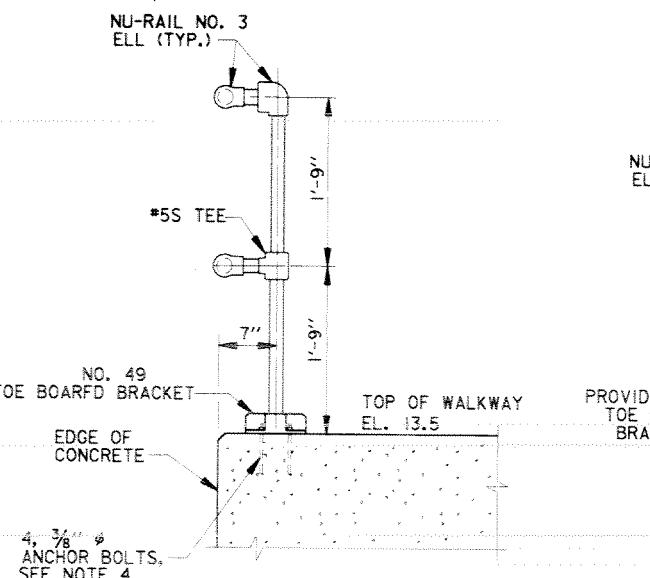


SECTION D
SCALE: 1" = 1' - 0"

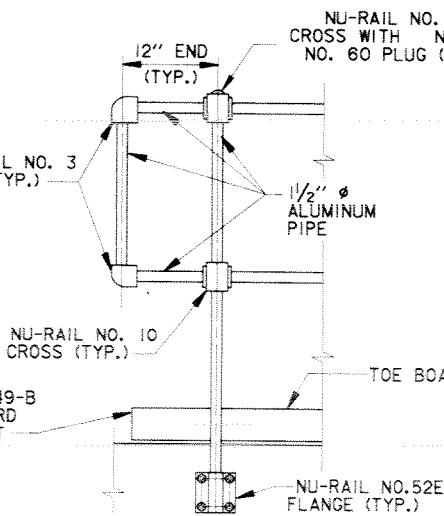

SECTION C
SCALE: 1" = 1' - 0"

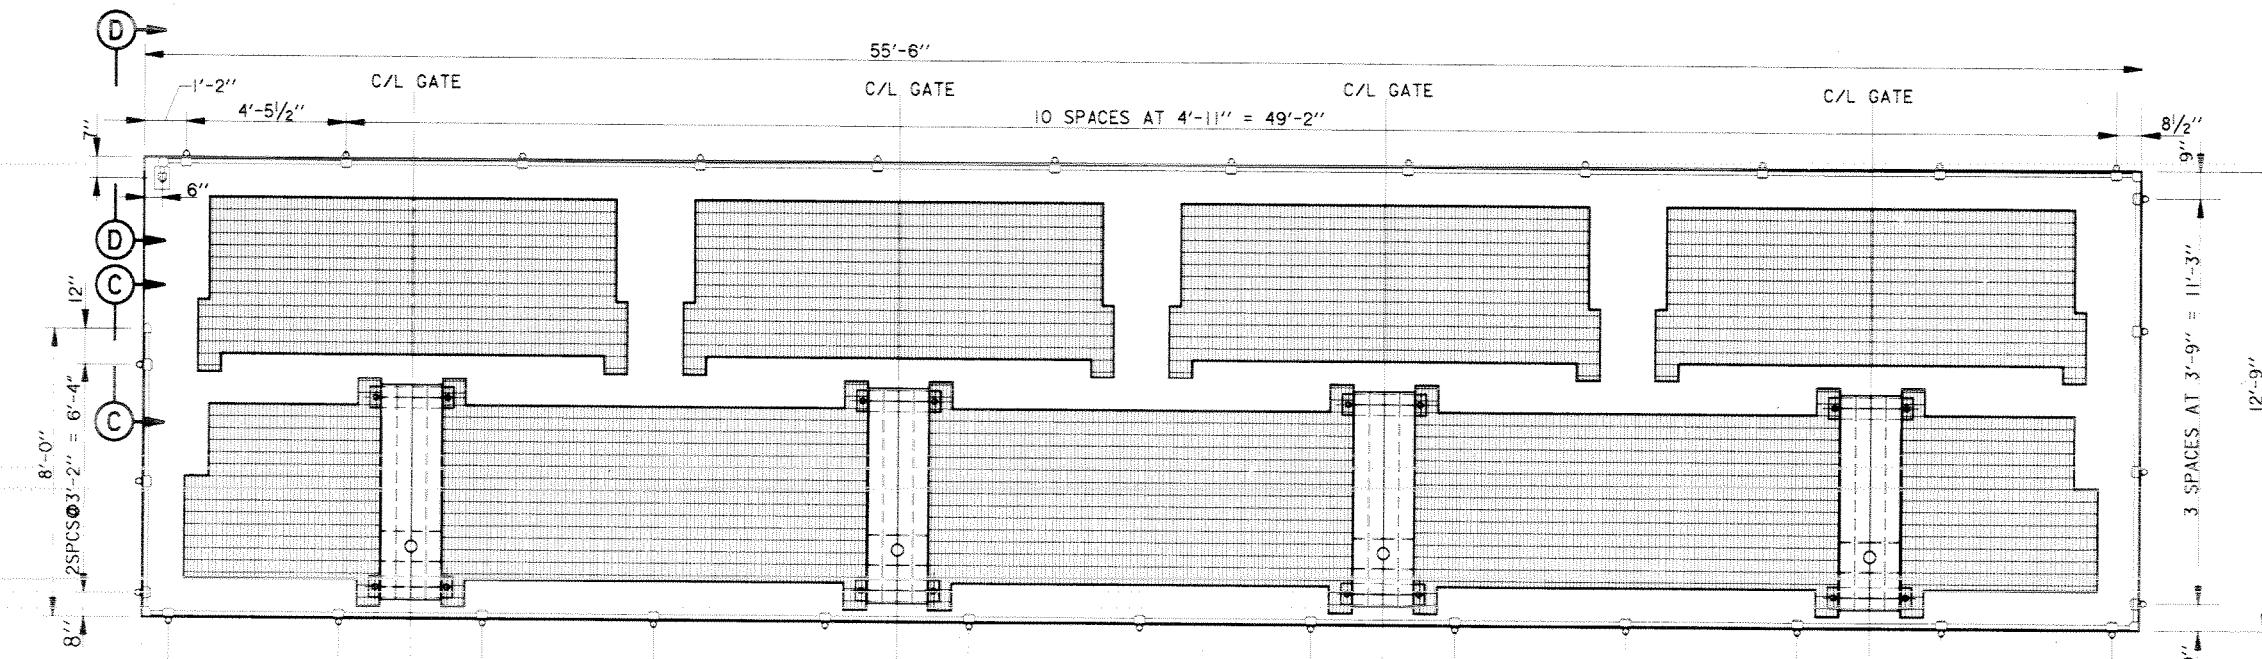


PLAN AT EL. 17.0
SCALE: 3/8" = 1' - 0"

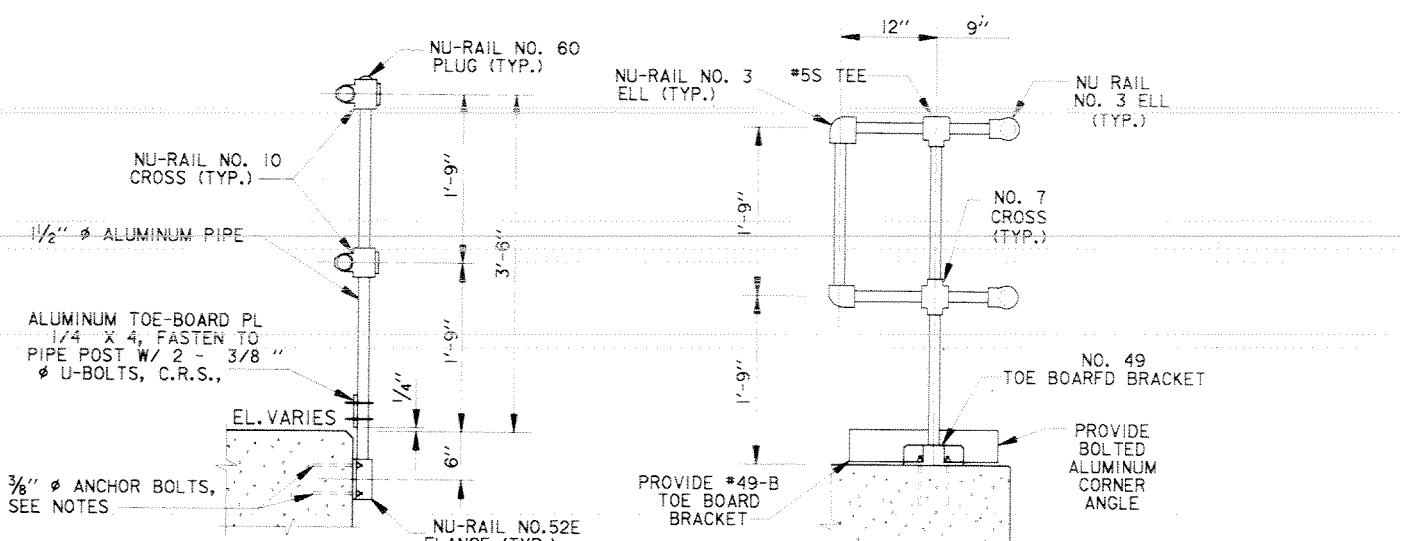

SECTION B
SCALE: 1" = 1' - 0"


SECTION E
SCALE: 1" = 1' - 0"

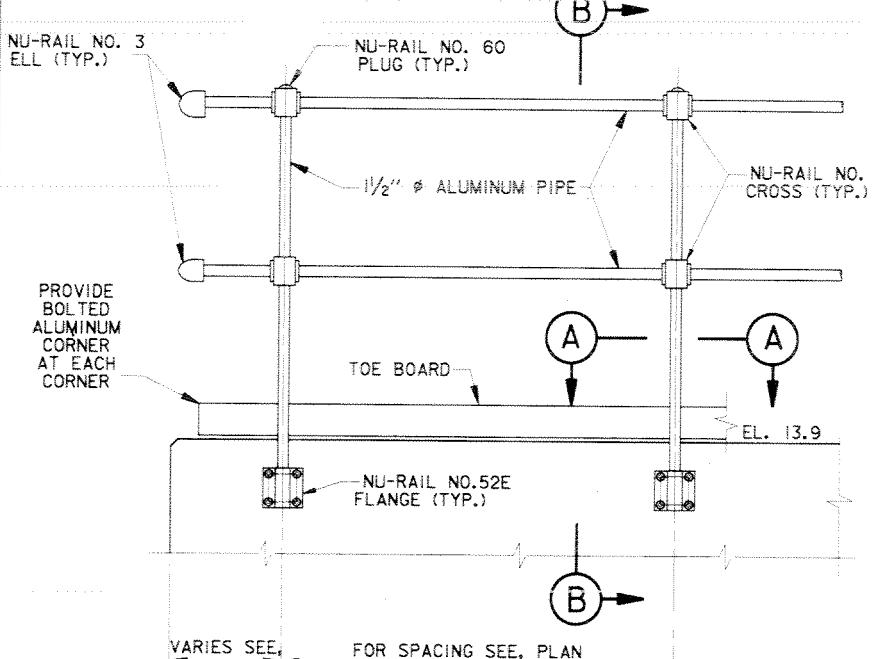


TYPICAL GUARDRAIL ELEVATION
SCALE: 1" = 1' - 0"




- GUARDRAIL NOTES**
- ALL GUARDRAIL FITTINGS SHALL BE ALUMINUM NU-RAIL SLIP-ON OFFSET FITTINGS AS MANUFACTURED BY THE HOLLANDER MFG. CO., CINCINNATI, OHIO OR APPROVED EQUAL.
 - ALL GUARDRAIL PIPE SHALL BE 1 1/2" # ALUMINUM PIPE, SCHEDULE 40 FOR RAILS AND SCHEDULE 80 FOR POSTS. ALUMINUM SHALL BE ALLOY 6061-T6.
 - WHERE ALUMINUM IS EXPOSED TO CONCRETE, USE 2 COATS OF BITUMINOUS PAINT OR A NEOPRENE GASKET.
 - ANCHOR BOLTS SHALL BE HILTI, KWIK BOLT II, C.R.S., 3/8" # WITH 5" MINIMUM EMBEDMENT, AS MFD. BY HILTI, TULSA, OKLAHOMA OR APPROVED EQUAL. PROVIDE C.R.S. LOCK WASHERS AND NUTS WITH ANCHOR BOLTS.
 - ALL BOLTS USED TO FASTEN GUARDRAIL TO STEEL STRINGERS, TOE BOARDS TO TOE-BOARD BRACKETS, CONNECTING ANGLES AND TOE BOARDS TO GUARDRAIL POST SHALL BE 3/8" # BOLTS W/ LOCK WASHERS AND NUTS, C.R.S..

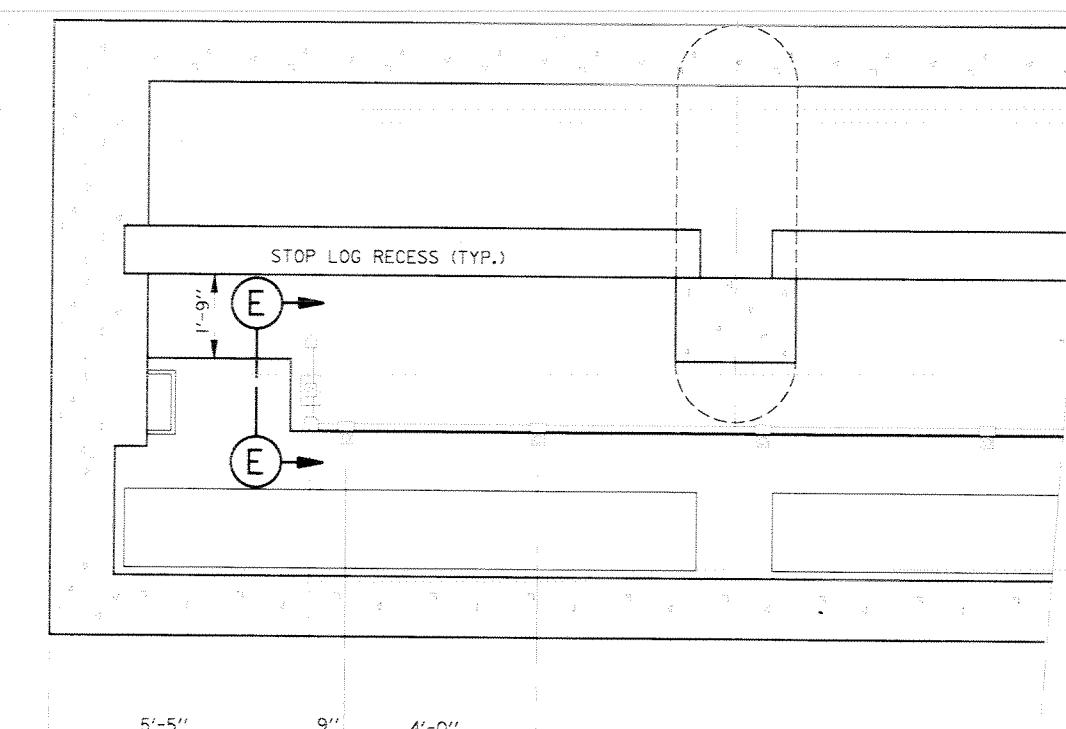


PLAN AT EL. 7.0
SCALE: 1/2" = 1' - 0"

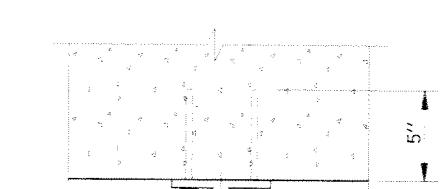


SCALE: 3/8" = 1' - 0"

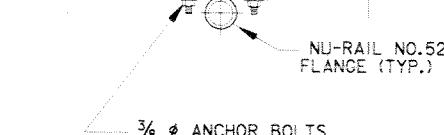

SCALE: 1/2" = 1' - 0"

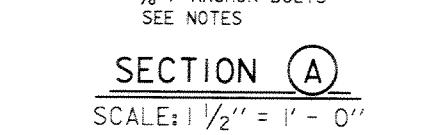


SCALE: 1 1/2" = 1' - 0"

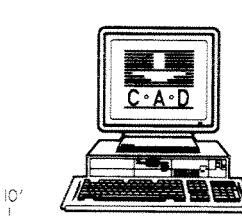


SYMBOL	DESCRIPTION	DATE	APPROVED
	U.S. ARMY ENGINEER DISTRICT, NEW ORLEANS CORPS OF ENGINEERS NEW ORLEANS, LOUISIANA		
LAKE PONTCHARTRAIN, LA. AND VICINITY HIGH LEVEL PLAN NEW ORLEANS LAKEFRONT LEVEE WEST OF I.H.N.C.			
ORLEANS MARINA PHASE V - SLUICE GATES ORLEANS PARISH, LOUISIANA			
	GUARDRAILS AND DETAILS		
DESIGNED BY: C.LABORDE DRAWN BY: J.DARBY CHECKED BY: C.LABORDE SUBMITTED BY: CHARLES A. LABORDE, P.E. SOLICITATION NO.: DACW29-98-B-0001	PLOT SCALE: 24 FILE NO.: H-4-44778	PLOT DATE: NOV. 10, 1997	DWG. 26 OF 46

Safety is a Part
of Your Contract

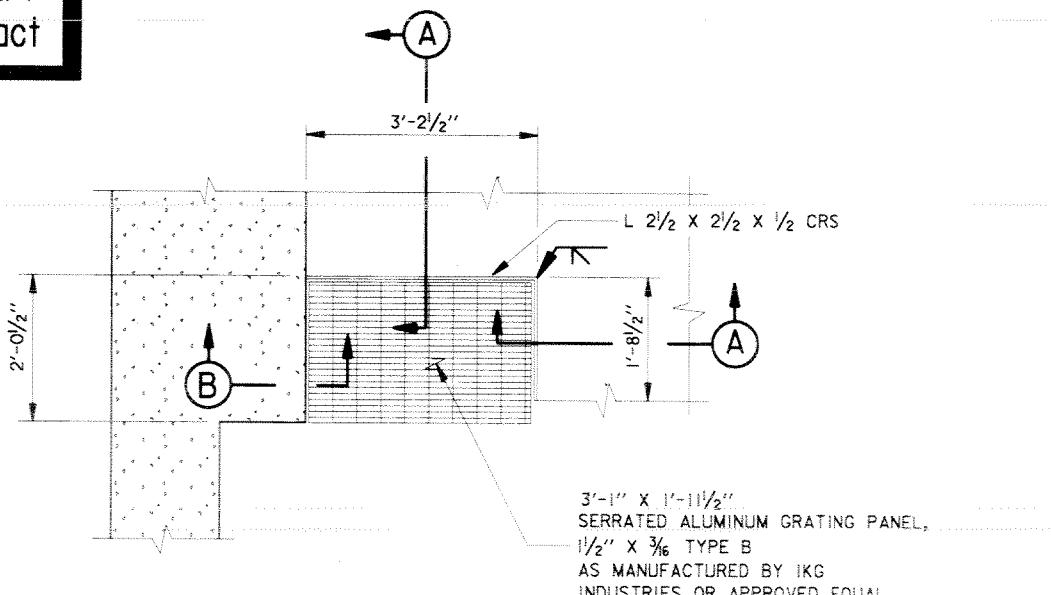


GRATING LANDING DETAIL

SCALE: 3/4" = 1'- 0"

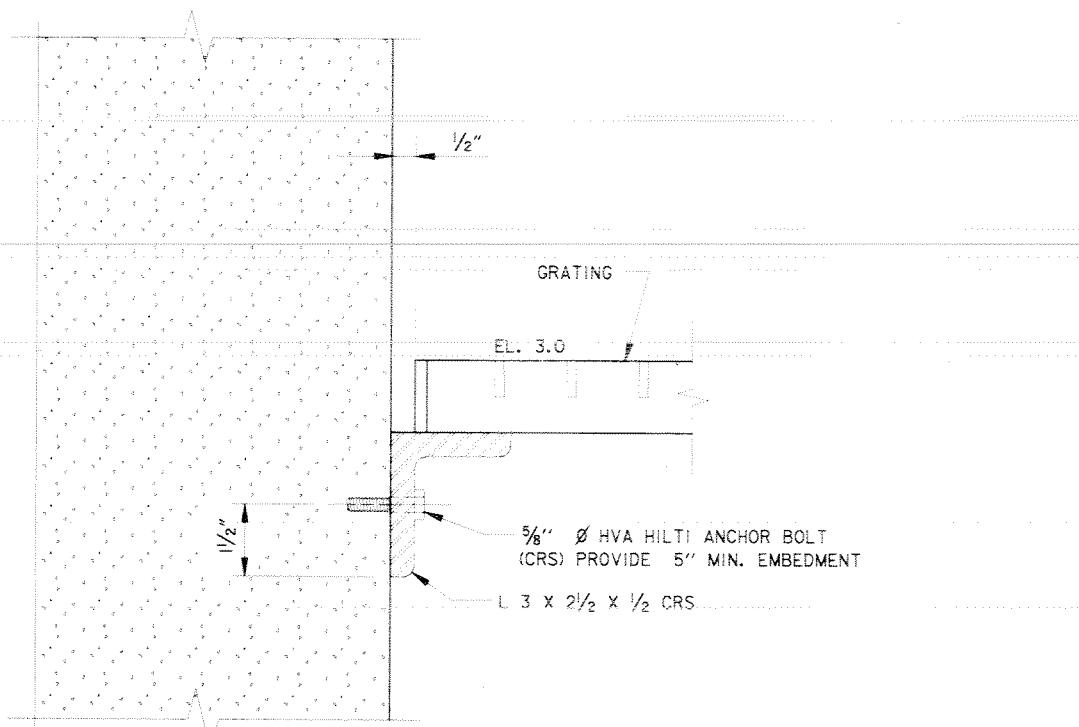


SECTION B

SCALE: 6" = 1'- 0"

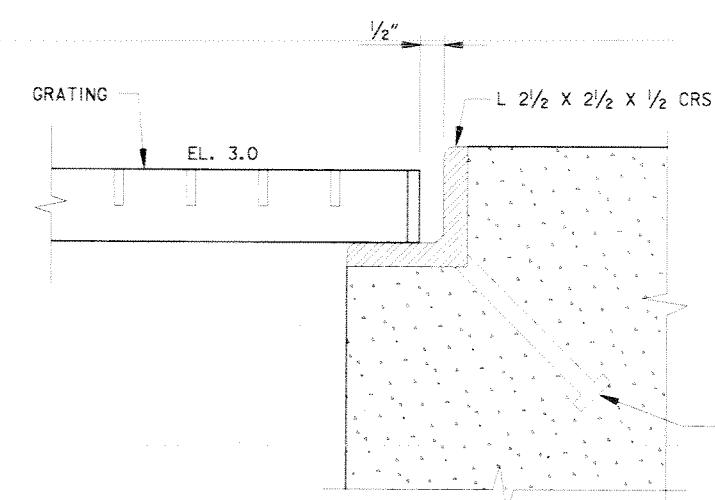


SECTION A


SCALE: 6" = 1'- 0"

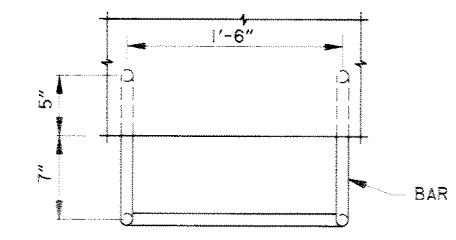

PLAN
SCALE: 1/2" = 1'- 0"

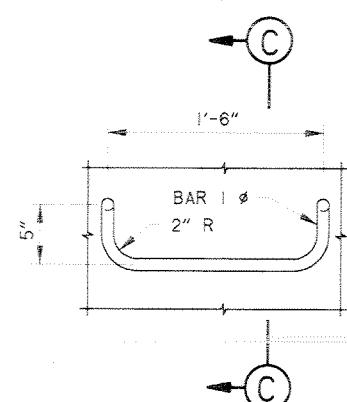


ELEVATION
SCALE: 1/2" = 1'- 0"

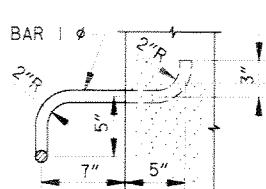


SECTION C
SCALE: 1/2" = 1'- 0"





ACCESS LADDER DETAILS

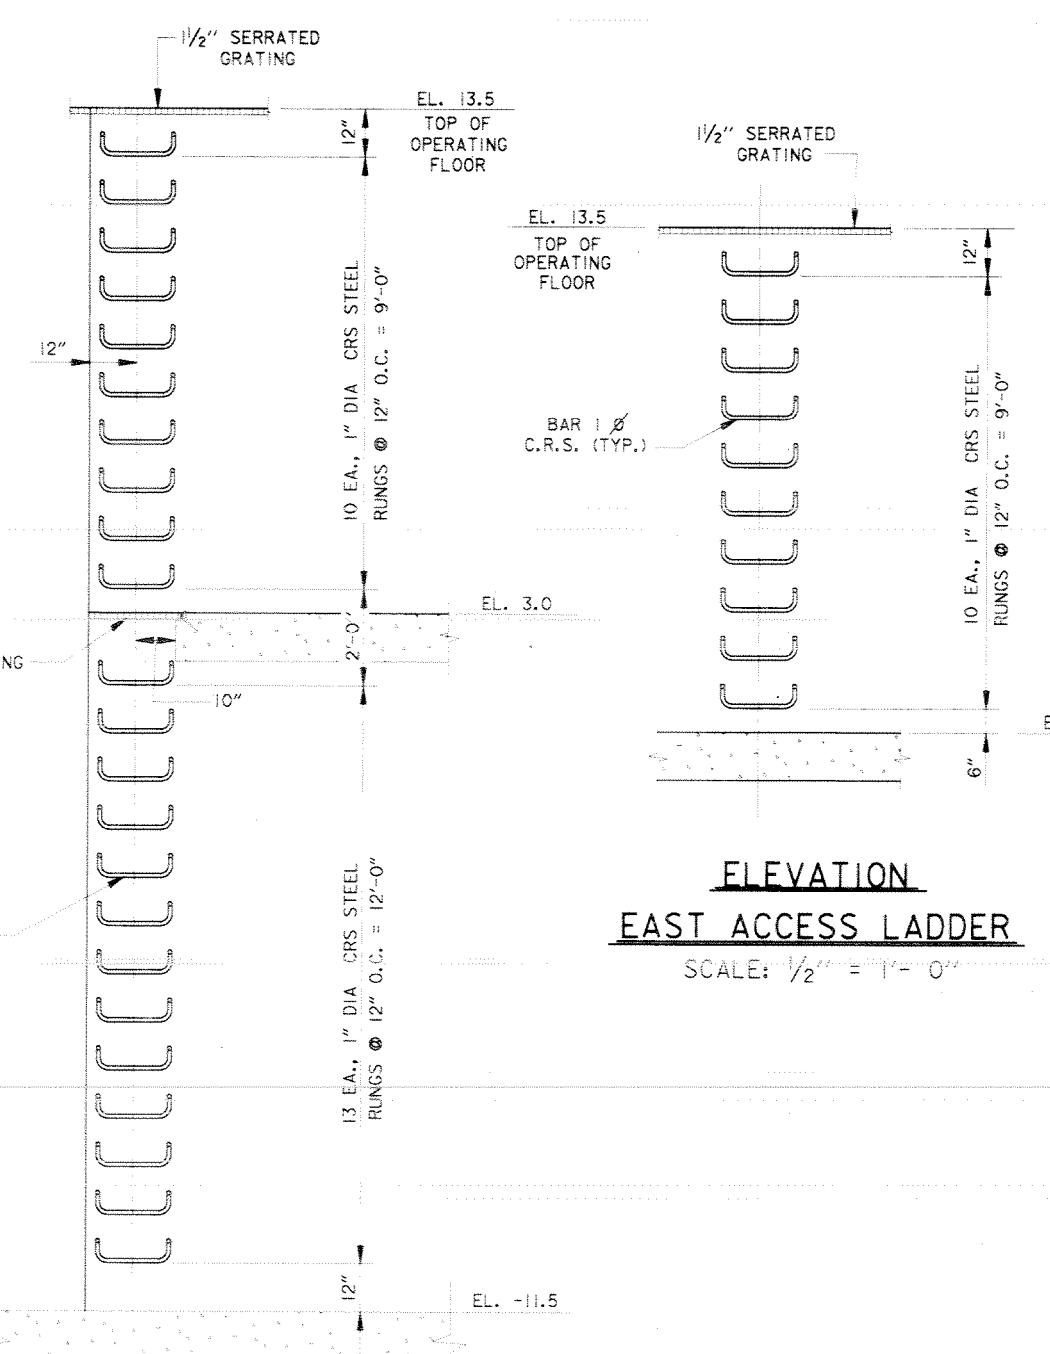

ELEVATION
EAST ACCESS LADDER
SCALE: 1/2" = 1'- 0"

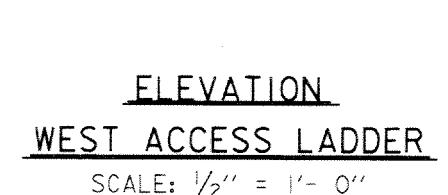

ELEVATION
WEST ACCESS LADDER
SCALE: 1/2" = 1'- 0"

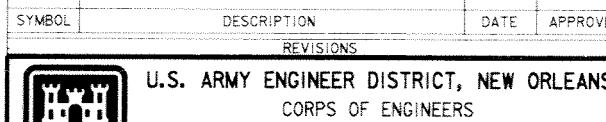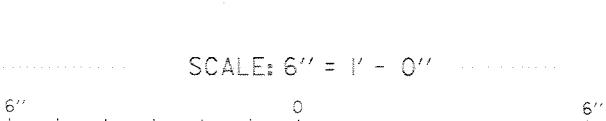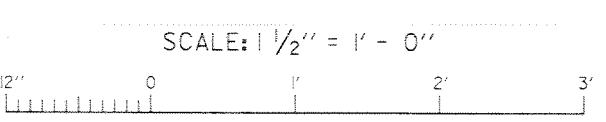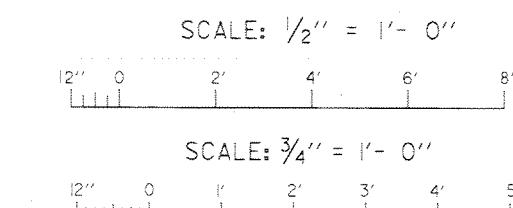

LAKE PONTCHARTRAIN, LA., AND VICINITY
HIGH LEVEL PLAN


NEW ORLEANS LAKEFRONT LEVEE

WEST OF I.H.N.C.

NEW MARINA PHASE V - SLUICE GATES


ORLEANS PARISH, LOUISIANA

LADDERS AND DETAILS

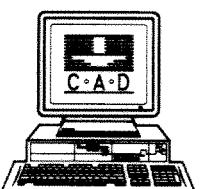


DESIGNED BY: C.LABORDE	DATE: NOV. 1997	PLOT SCALE: 24	PLOT DATE: NOV. 10, 1997
DRAWN BY: J.DARBY	CHECKED BY: C.LABORDE		FILE NO. H-4-44778
CADD FILE: 44778E25.DGN			
SUBMITTED BY: CHARLES A. LABORDE P.E.	SOLICITATION NO. DACW29-98-B-0001		DWG. 27 OF 46

Safety is a Part of Your Contract

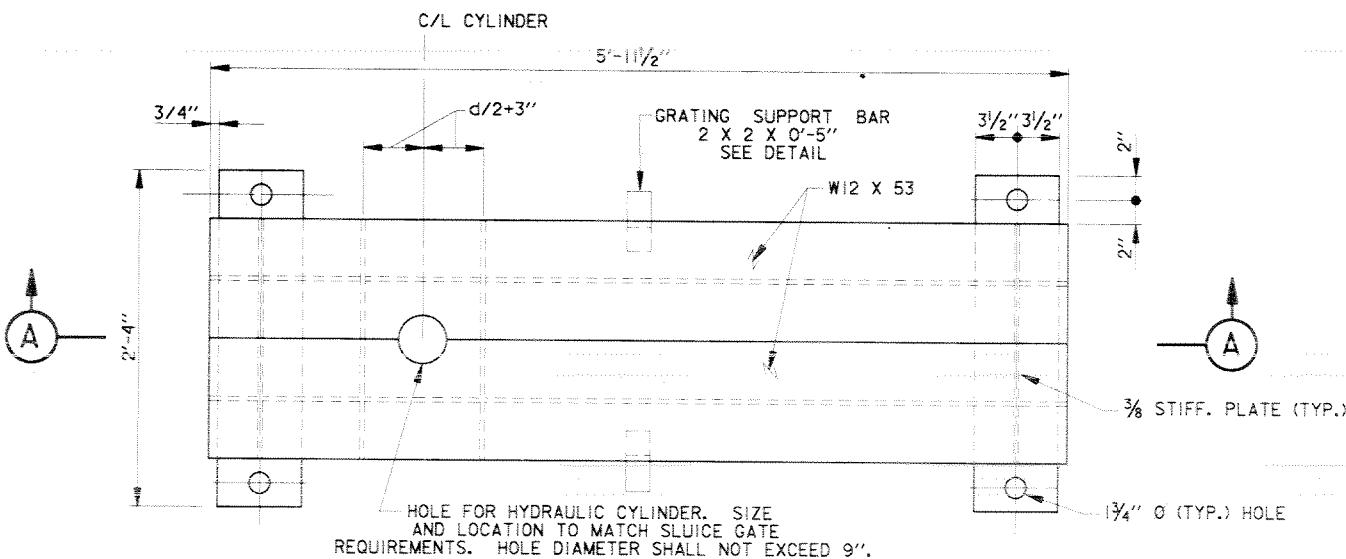


PLAN

SCALE: 1 1/2" = 1' - 0"

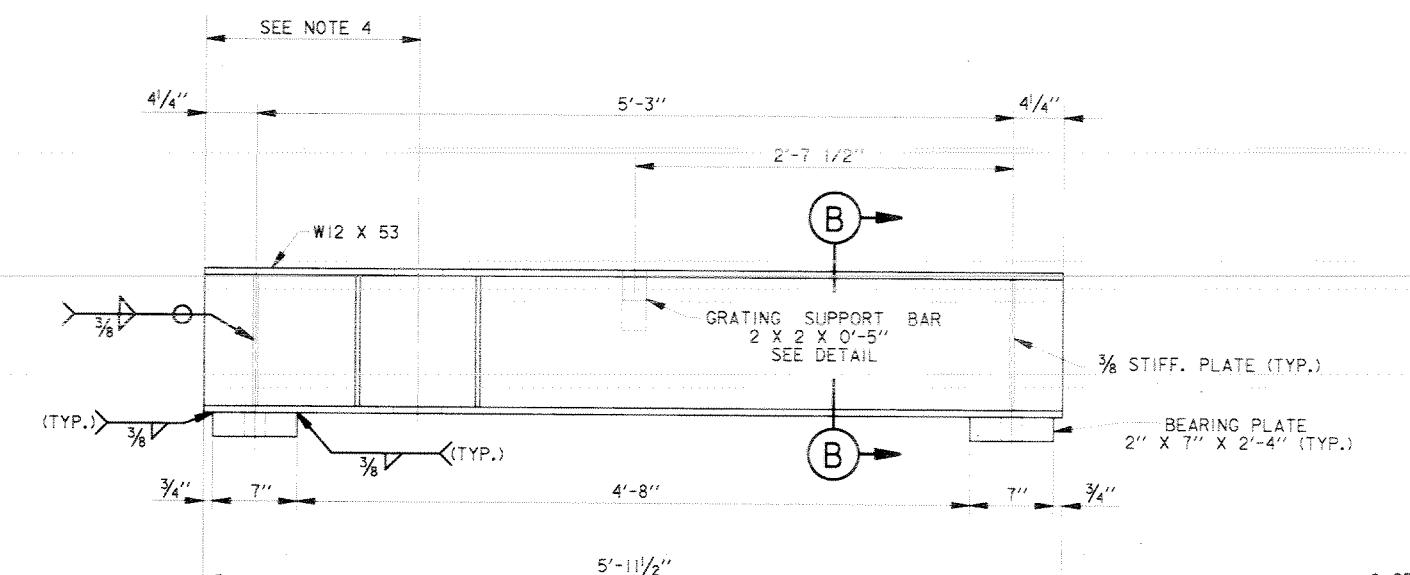

SECTION A

SCALE: 1 1/2" = 1' = 0"

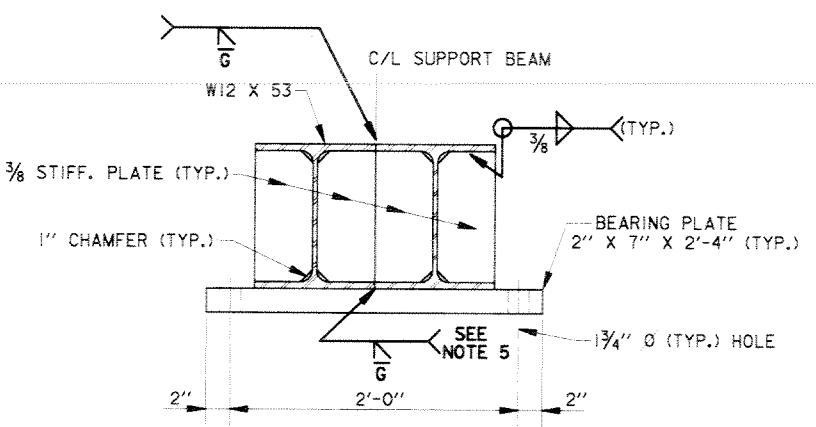

SECTION B


SCALE: $1 \frac{1}{3}'' = 1' = 0''$

HOIST BEAM NOTES:

1. 4 EACH GATE HOIST ASSEMBLIES REQUIRED.
ONE GATE HOIST ASSEMBLY *Show*
 2. SUPPORT BEAM ASSEMBLY
TO BE HOT DIPPED GALVANIZED
AFTER FABRICATION BUT PRIOR
TO INSTALLATION OF FLOORSTAND.
 3. AFTER INSTALLATION, TOP FLANGES
OF SUPPORT BEAM TO BE COATED
WITH 3M 1420 SCOTCH CLAD NON-
SLIP COATING OR APPROVED EQUAL.
 4. DISTANCE TO Q CYLINDER TO BE
DETERMINED BY SLUICE GATE
MANUFACTURER, DISTANCE SHALL
NOT EXCEED 1'-10"
 5. GRIND ONLY UNDER BEARING PLATES


Diseño brusco

Amber
0003

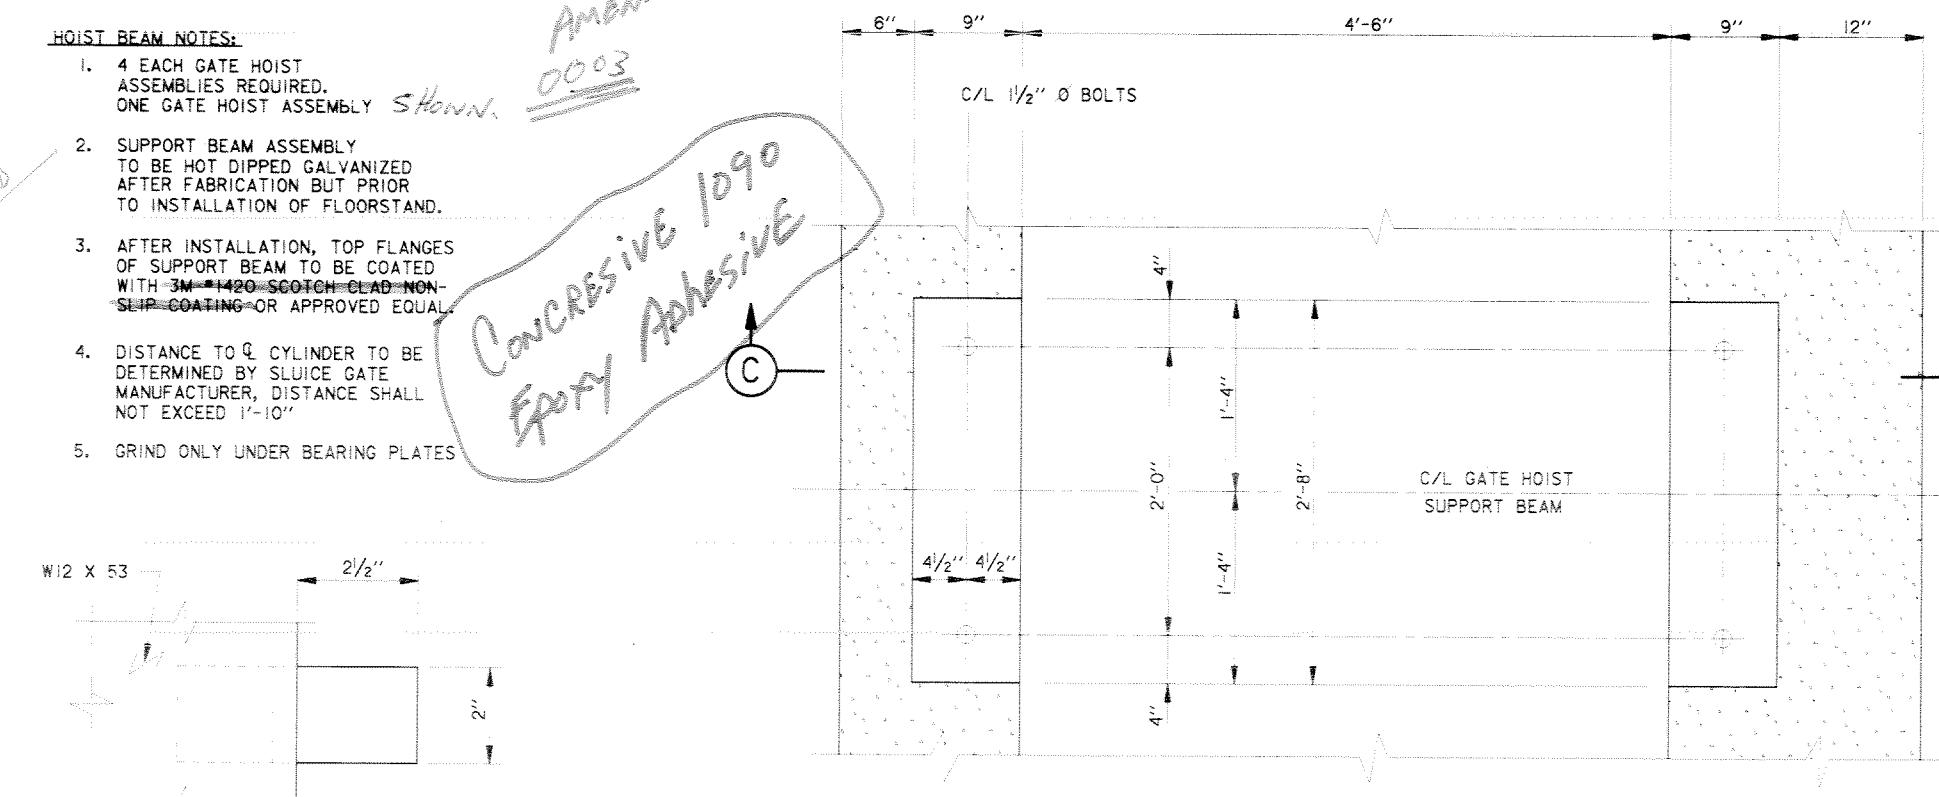


TYPICAL ANCHOR BOLT

SCALE: $1 \frac{1}{2}'' = 1' - 0''$

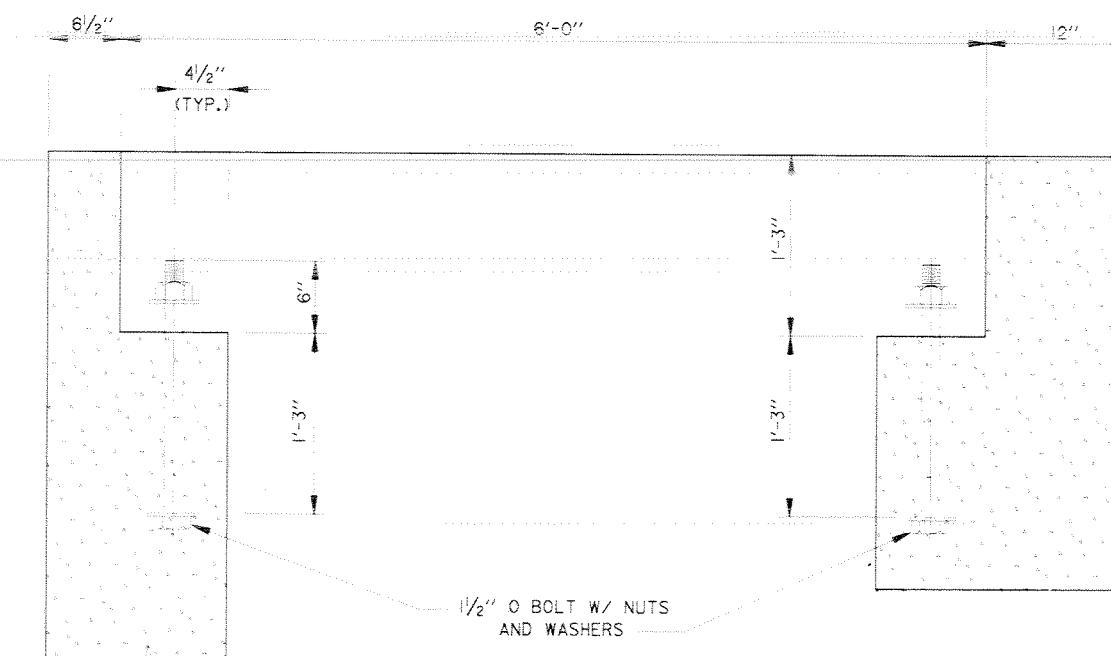


SECTION C

SECTION C

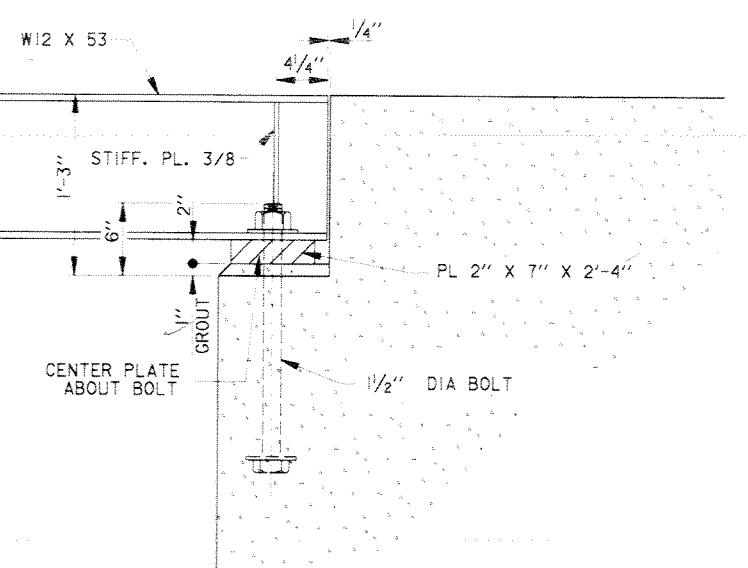

TYPICAL ANCHOR BOLT CONNECTION DETAILS

SCALE: 1 1/2" = 1' - 0"

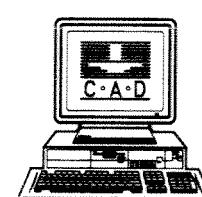

SYMBOL	DESCRIPTION	DATE	APPROVED
	<p style="text-align: center;">REVISIONS</p> <p style="text-align: center;">U.S. ARMY ENGINEER DISTRICT, NEW ORLEANS</p> <p style="text-align: center;">CORPS OF ENGINEERS</p> <p style="text-align: center;">NEW ORLEANS, LOUISIANA</p> <p style="text-align: center;">LAKE PONTCHARTRAIN, LA. AND VICINITY HIGH LEVEL PLAN NEW ORLEANS LAKEFRONT LEVEE WEST OF I.H.N.C. ORLEANS MARINA PHASE V - SLUICE GATES ORLEANS PARISH, LOUISIANA</p> <p style="text-align: center;">GATE HOIST SUPPORT BEAM</p>		
DESIGNED BY: C.LABORDE	DATE:	PLOT SCALE:	PLOT DATE:
DRAWN BY: J.DARBY	NOV. 1997	8	NOV. 10, 1997
CHECKED BY: C.LABORDE	CADD FILE: 44778EO2.DGN		
SUBMITTED BY: CHARLES A. LABORDE, P.E. DESIGN ENGINEER	FILE NO. H-4-44778		
	SOLICITATION NO. DACW29-98-B-0001		
	DWG. 28 OF 46		

CEMVN-SS

15 May 2000

MEMORANDUM FOR CEMVN-ED-TF attn: Mr. Charles Laborde

SUBJECT: Lake Pontchartrain, Louisiana and Vicinity, Hurricane Protection, Orleans Marina Phase V - Sluice Gates; Contract No. DACW29-98-C-0050.

1. A Safety & Occupational Health Specialist inspected the subject stair wells, adjacent sluice gate and dock railing and provide the findings and recommendations or actions below to correct the deficiencies.

a. Finding: Loose ledgers (stringers) on both sides of Public accessible stair not secured properly. 29 CFR 1910.23(e)(3)(iv),

Action: Couplings be installed with non-swivel type bottom couplings. Additional couplings at joints to prevent movement.

b. Finding: Toe boards missing on platform. 29 CFR 1910.23@(1)

Action: Install toe boards.

c. Finding: Dock side railing mid rail and bottom rail needed.

Recommend: Additional mid rail and bottom rail be added for safety due to physical hazards of lower level cluttered dock area.

d. Finding: Midrail and bottom rail on platform needed.

Recommend: Additional mid rail and bottom rail be added for safety due to physical hazards if a person were to fall through rail.

e. Finding: Cotter pins not pig eared in lateral braces of stairs present a puncture hazard.

Recommend: Cotter pins in lateral braces of stairs be pig eared to reduce puncture hazard

f. Finding: Lateral braces can easily be moved

Recommend: Should be tack welded or wired to secure.

g. Finding: Locking device of sluice gate presents an extreme projection hazard at normal height and leg chin level.

Recommend: Shortening of bolt shank and locking in place to prevent theft.

h. Finding: Large nuts of sluice gate bottom hinge missing or loose.


Recommend: Installing and torque nuts as required.

2. POC is Mike Rosales, Safety & Occupational Health Specialist, ext. 1995.

GARY L. HAWKINS
Acting Chief of Safety,
Security & Occupational
Health


DISTRIBUTION:
CEMVN-ED-TF
CEMVN-CD-QM

Safety is a Part
of Your Contract

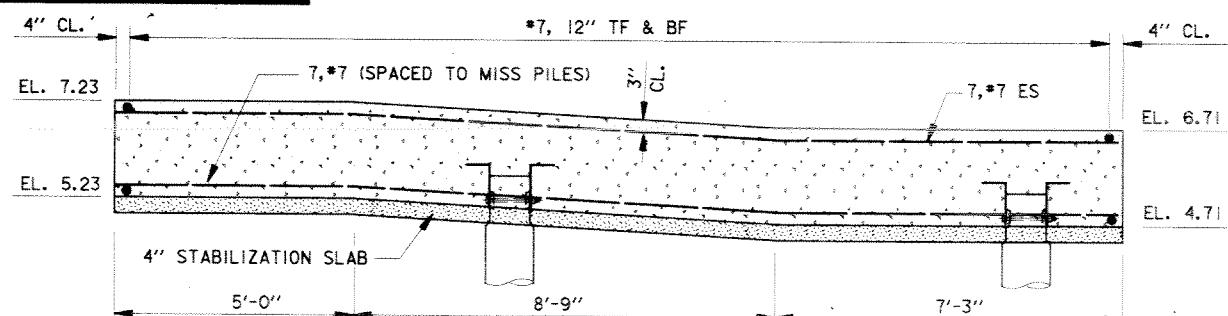


SECTION A

SCALE: $\frac{1}{2}'' = 1'-0'$

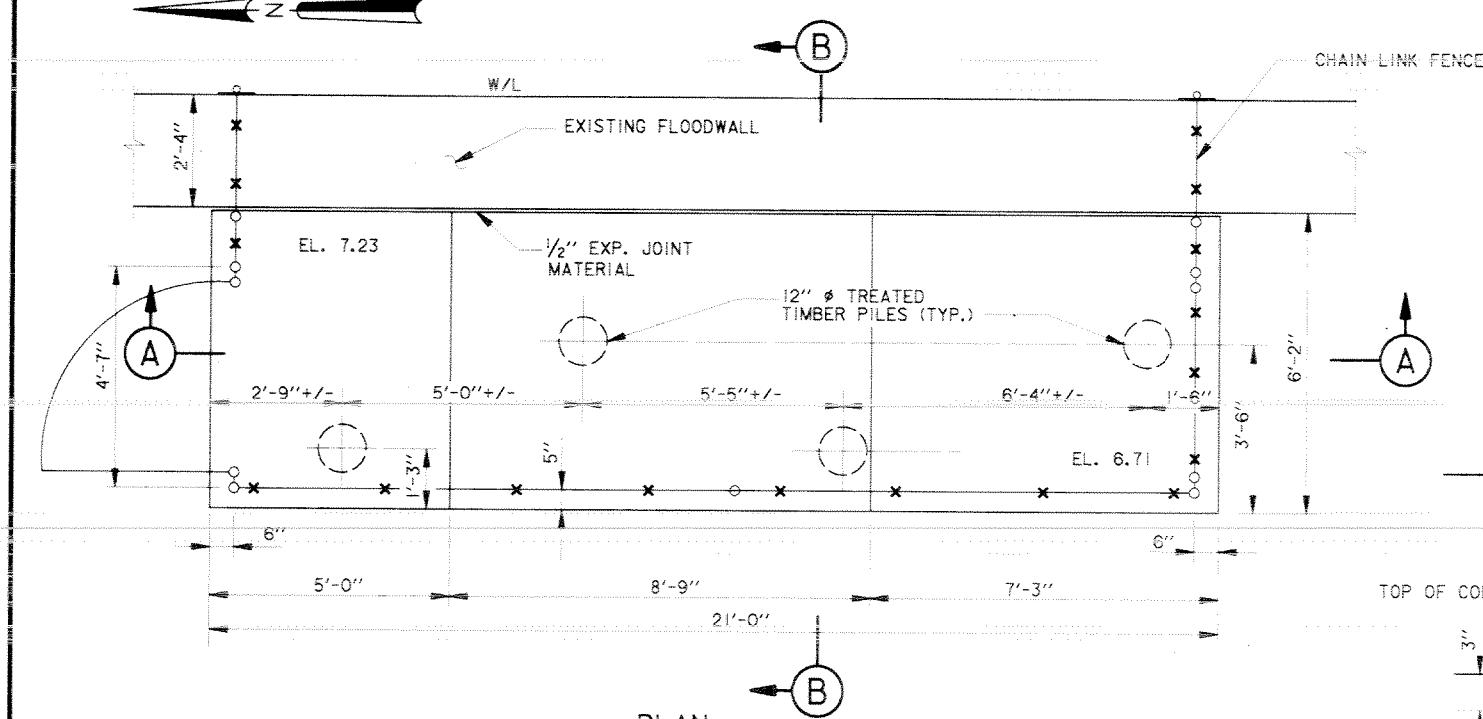



ACCESS STAIRWAY SLAB

SCALE: $\frac{1}{2}'' = 1'-0''$

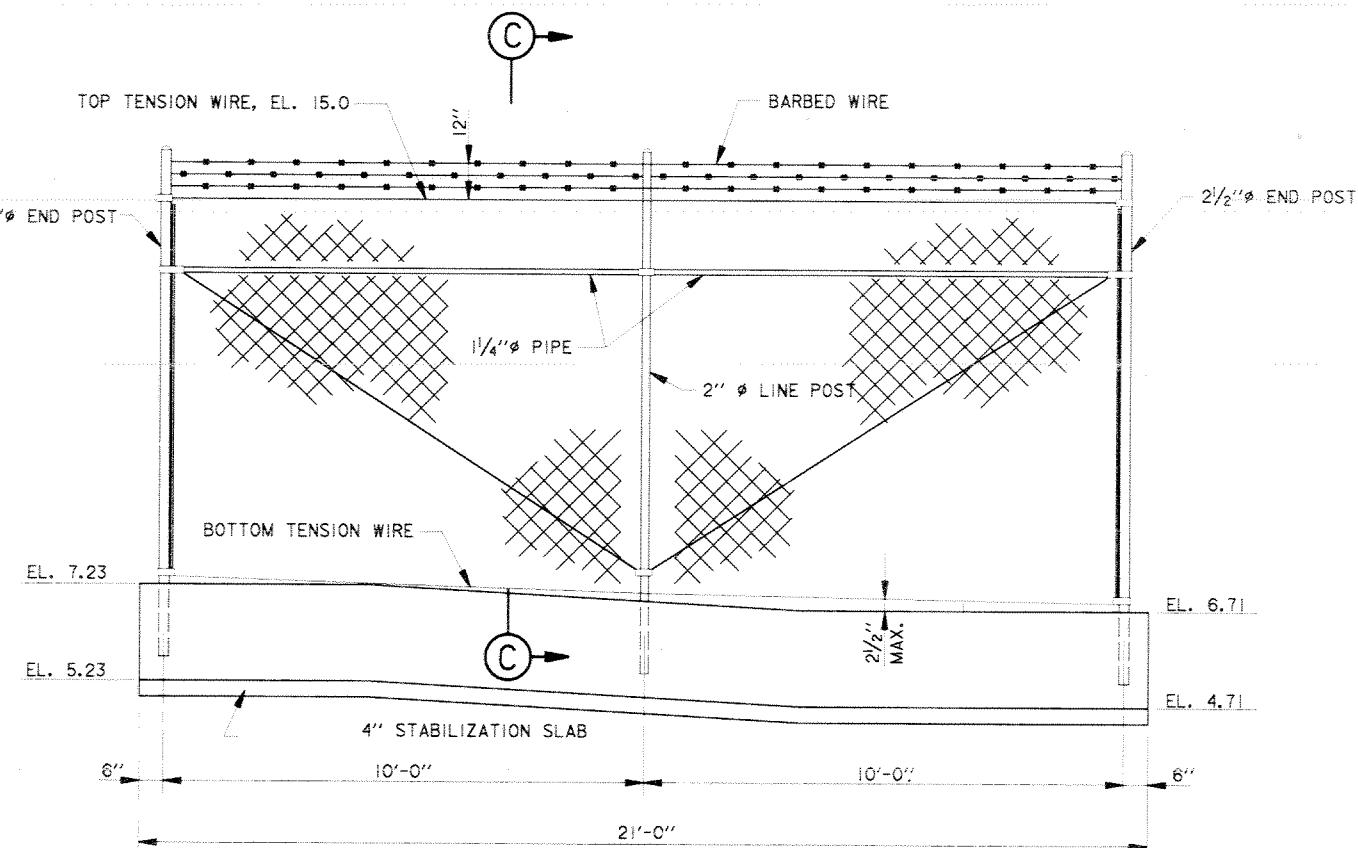


WEST ELEVATION

SCALE: $\frac{1}{2}'' = 1'-0''$

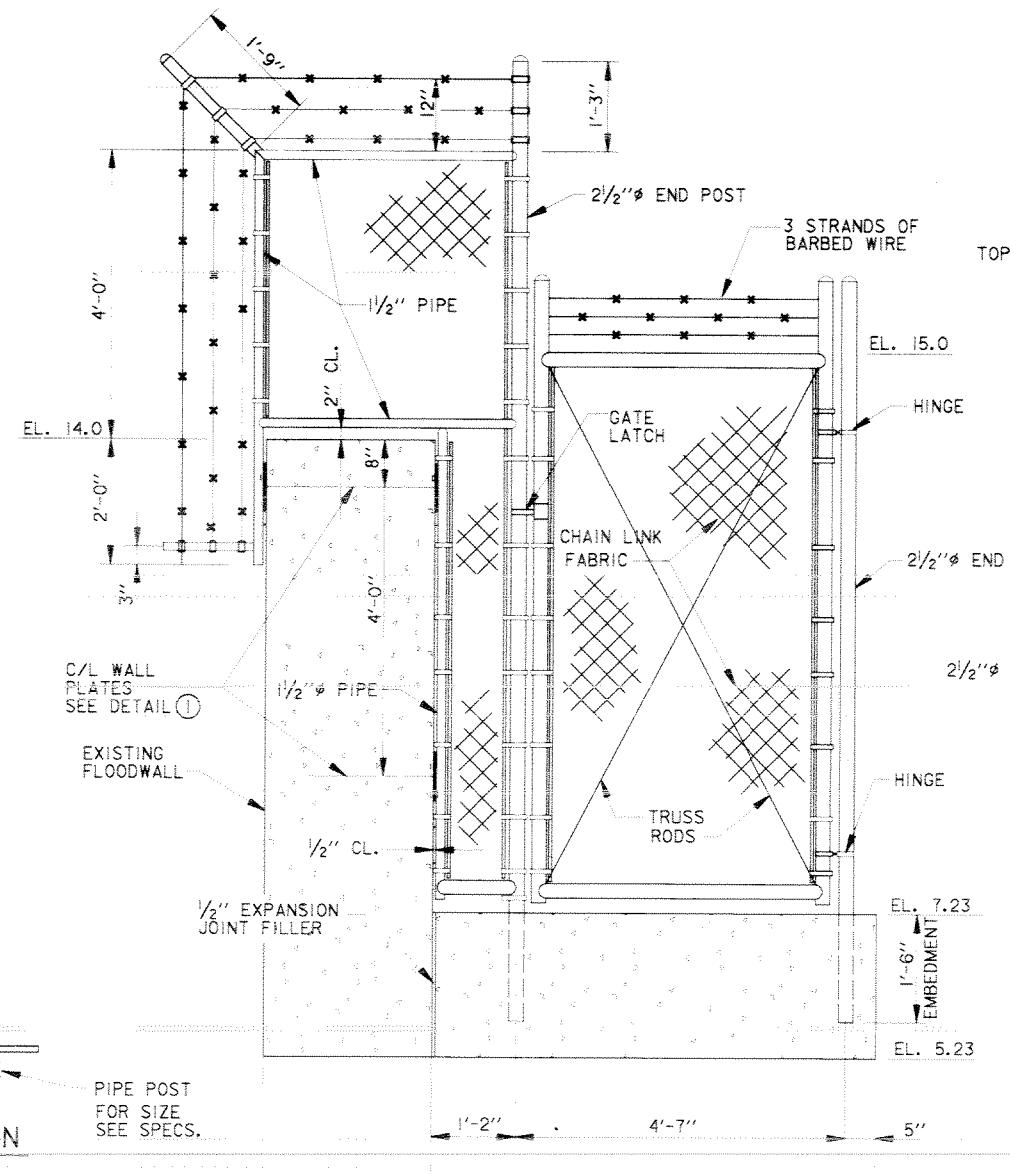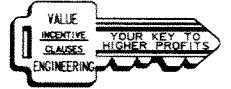


NORTH ELEVATION

SCALE: $\frac{3}{4}'' = 1'-0''$

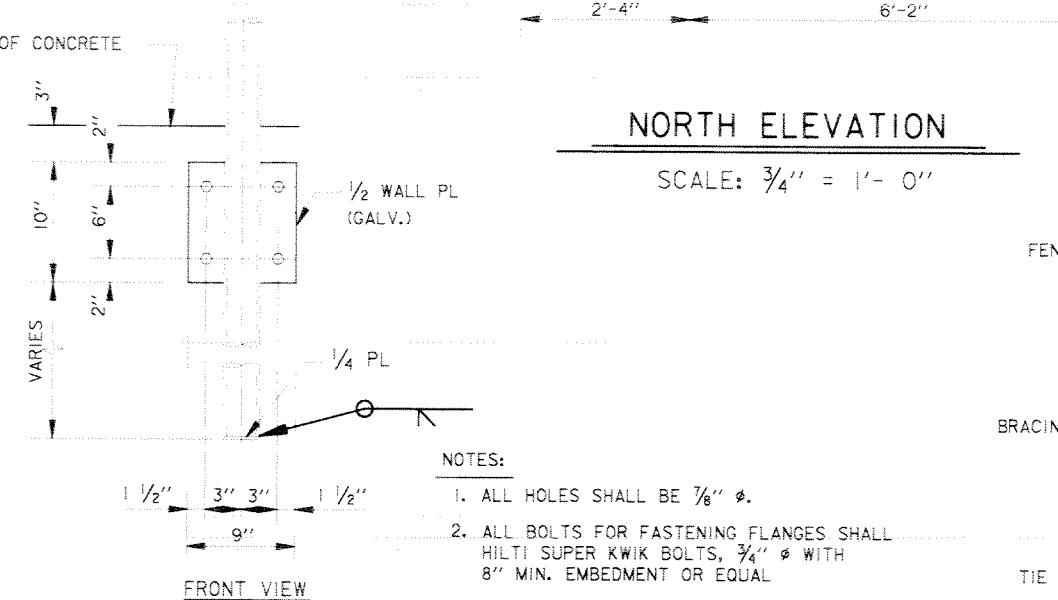


WALL PLATE DETAIL (1)

SCALE: $1 \frac{1}{2}'' = 1' - 0$

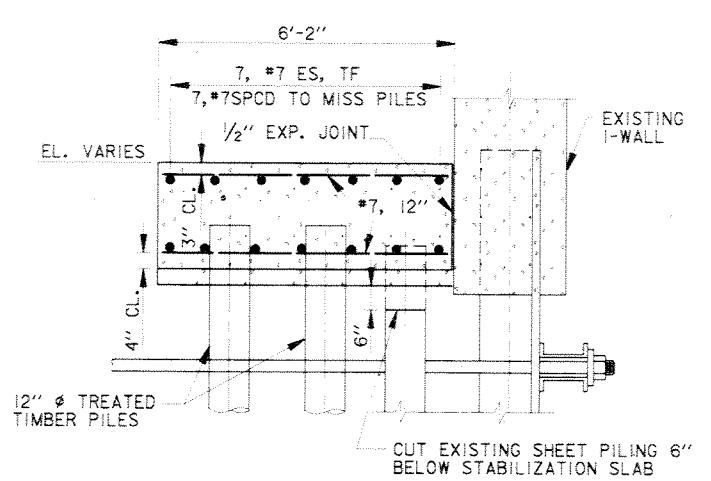

SECTION B

SCALE: $\frac{1}{2}'' = 1'-0''$

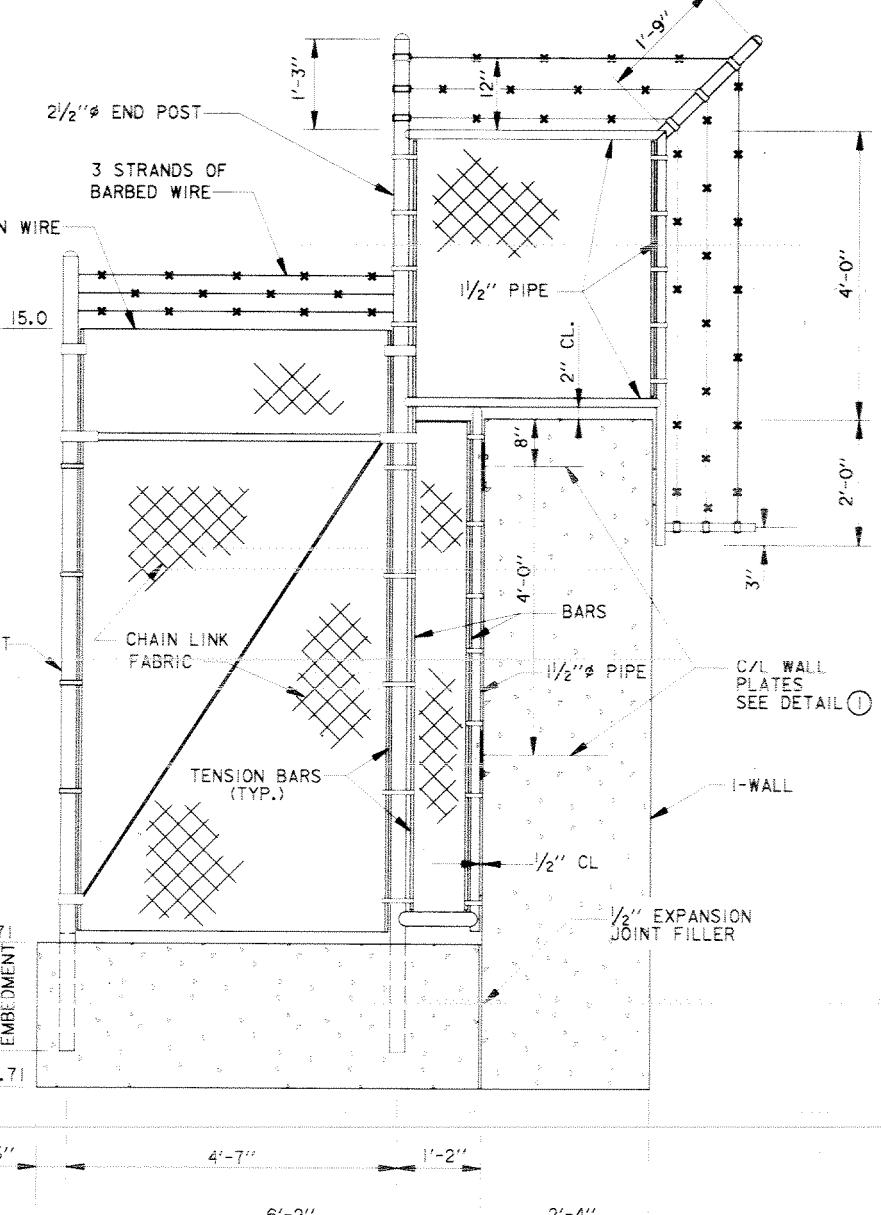


SOUTH ELEVATION

SCALE: $\frac{3}{4}'' = 1'-0'$



SCALE-3/U = V - 0/U

0' 1' 2' 3' 4'

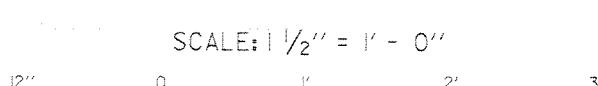


SCALE: $\frac{1}{2}'' = 1' - 0''$

— 0 —

SYMBOL	DESCRIPTION	DATE	APPROVED
	REVISIONS		
	U.S. ARMY ENGINEER DISTRICT, NEW ORLEANS CORPS OF ENGINEERS NEW ORLEANS, LOUISIANA		
LAKE PONTCHARTRAIN, LA. AND VICINITY HIGH LEVEL PLAN NEW ORLEANS LAKEFRONT LEVEE WEST OF I.H.N.C. ORLEANS MARINA PHASE V - SLUICE GATES ORLEANS PARISH, LOUISIANA ACCESS STAIRWAY - PLAN & ELEVATIONS (SHT. 2 OF 2)			
DESIGNED BY: C. LABORDE	DATE:	PLOT SCALE:	PLOT DATE:
DRAWN BY: L. MAGEE	NOV. 1997	24	NOV. 10, 1997
CHECKED BY: C. LABORDE	CADD FILE: 44778P04.DGN		FILE NO.
SUBMITTED BY: CHARLES A. LABORDE, P.E. DESIGN ENGINEER	SOLICITATION NO. DACW29-98-B-0001		DWG. 30 OF 46

Safety is a Part
of Your Contract

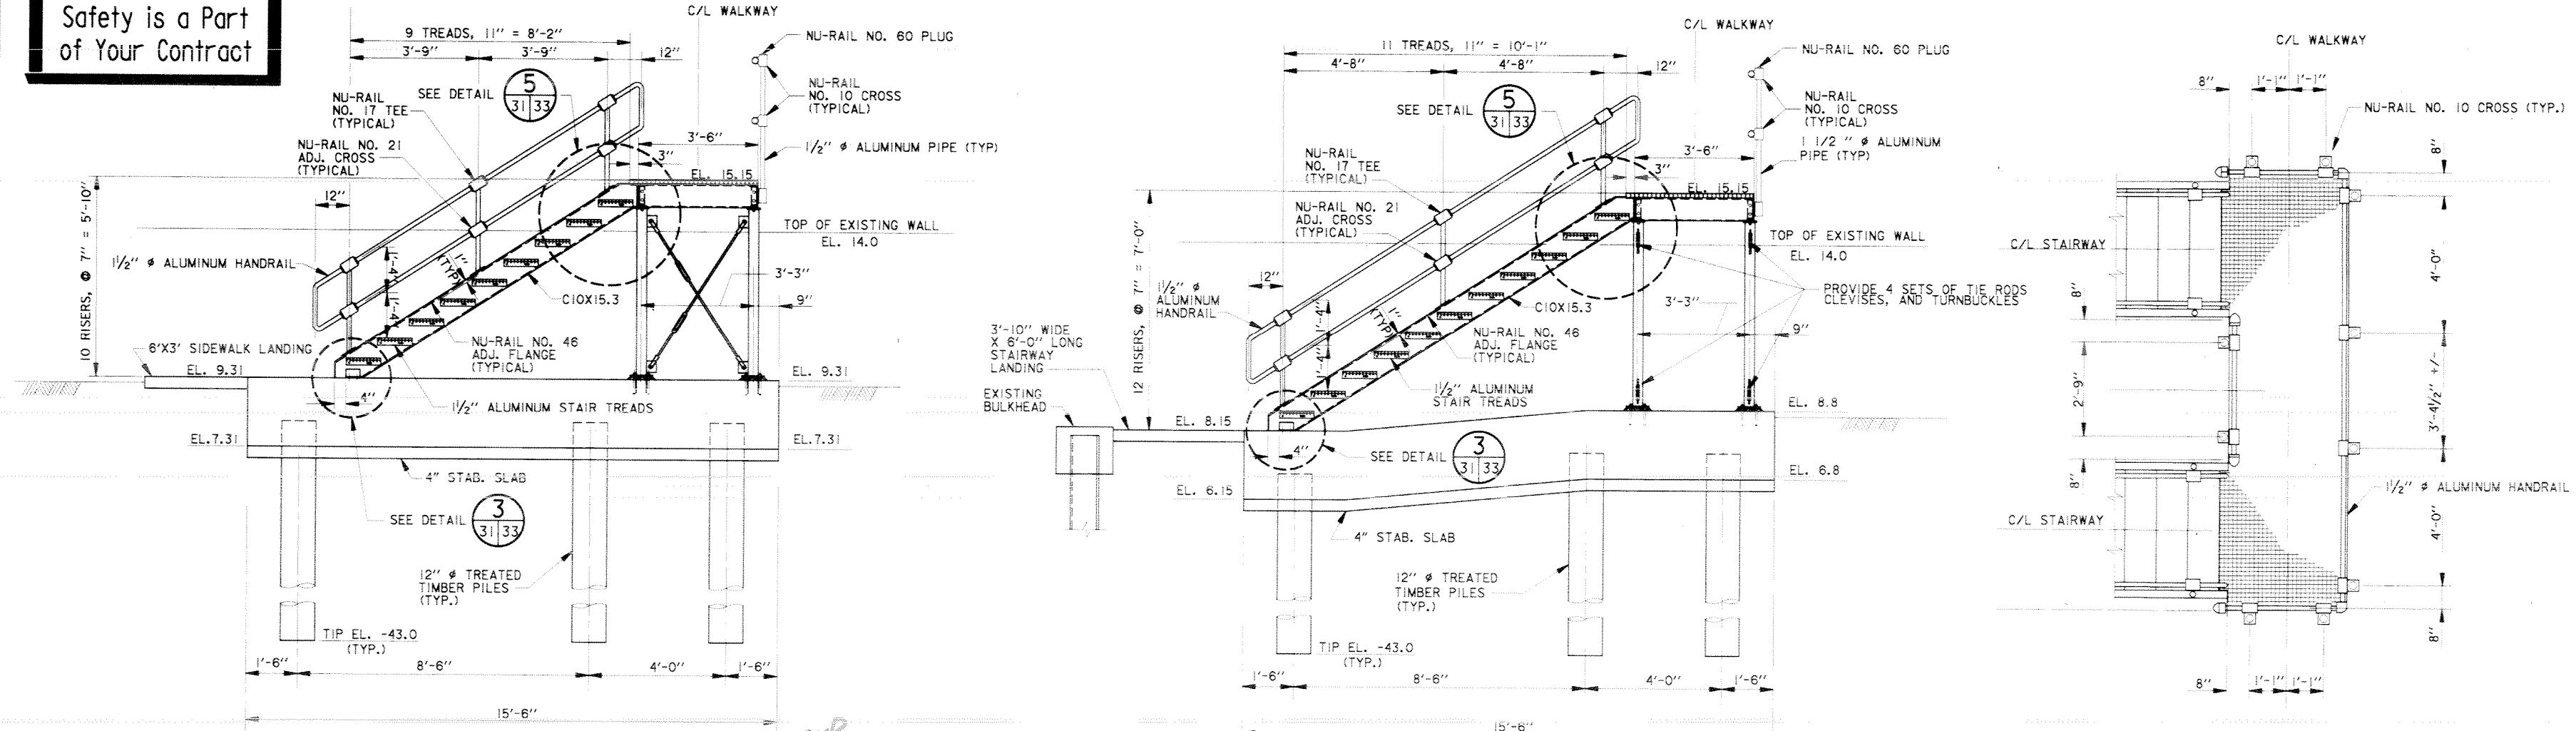


SECTION C

SCALE: $\frac{1}{2}'' = 1'-0''$

*ABANDONED ENTERTY
UNDERGROUND ELECTRIC
SERVICE, REMOVE AS
REQUIRED*

BELL SOUTH
UNDERGROUND
TELEPHONE
CONDUIT
(DO NOT DISTURB)

PROTECTED SIDE

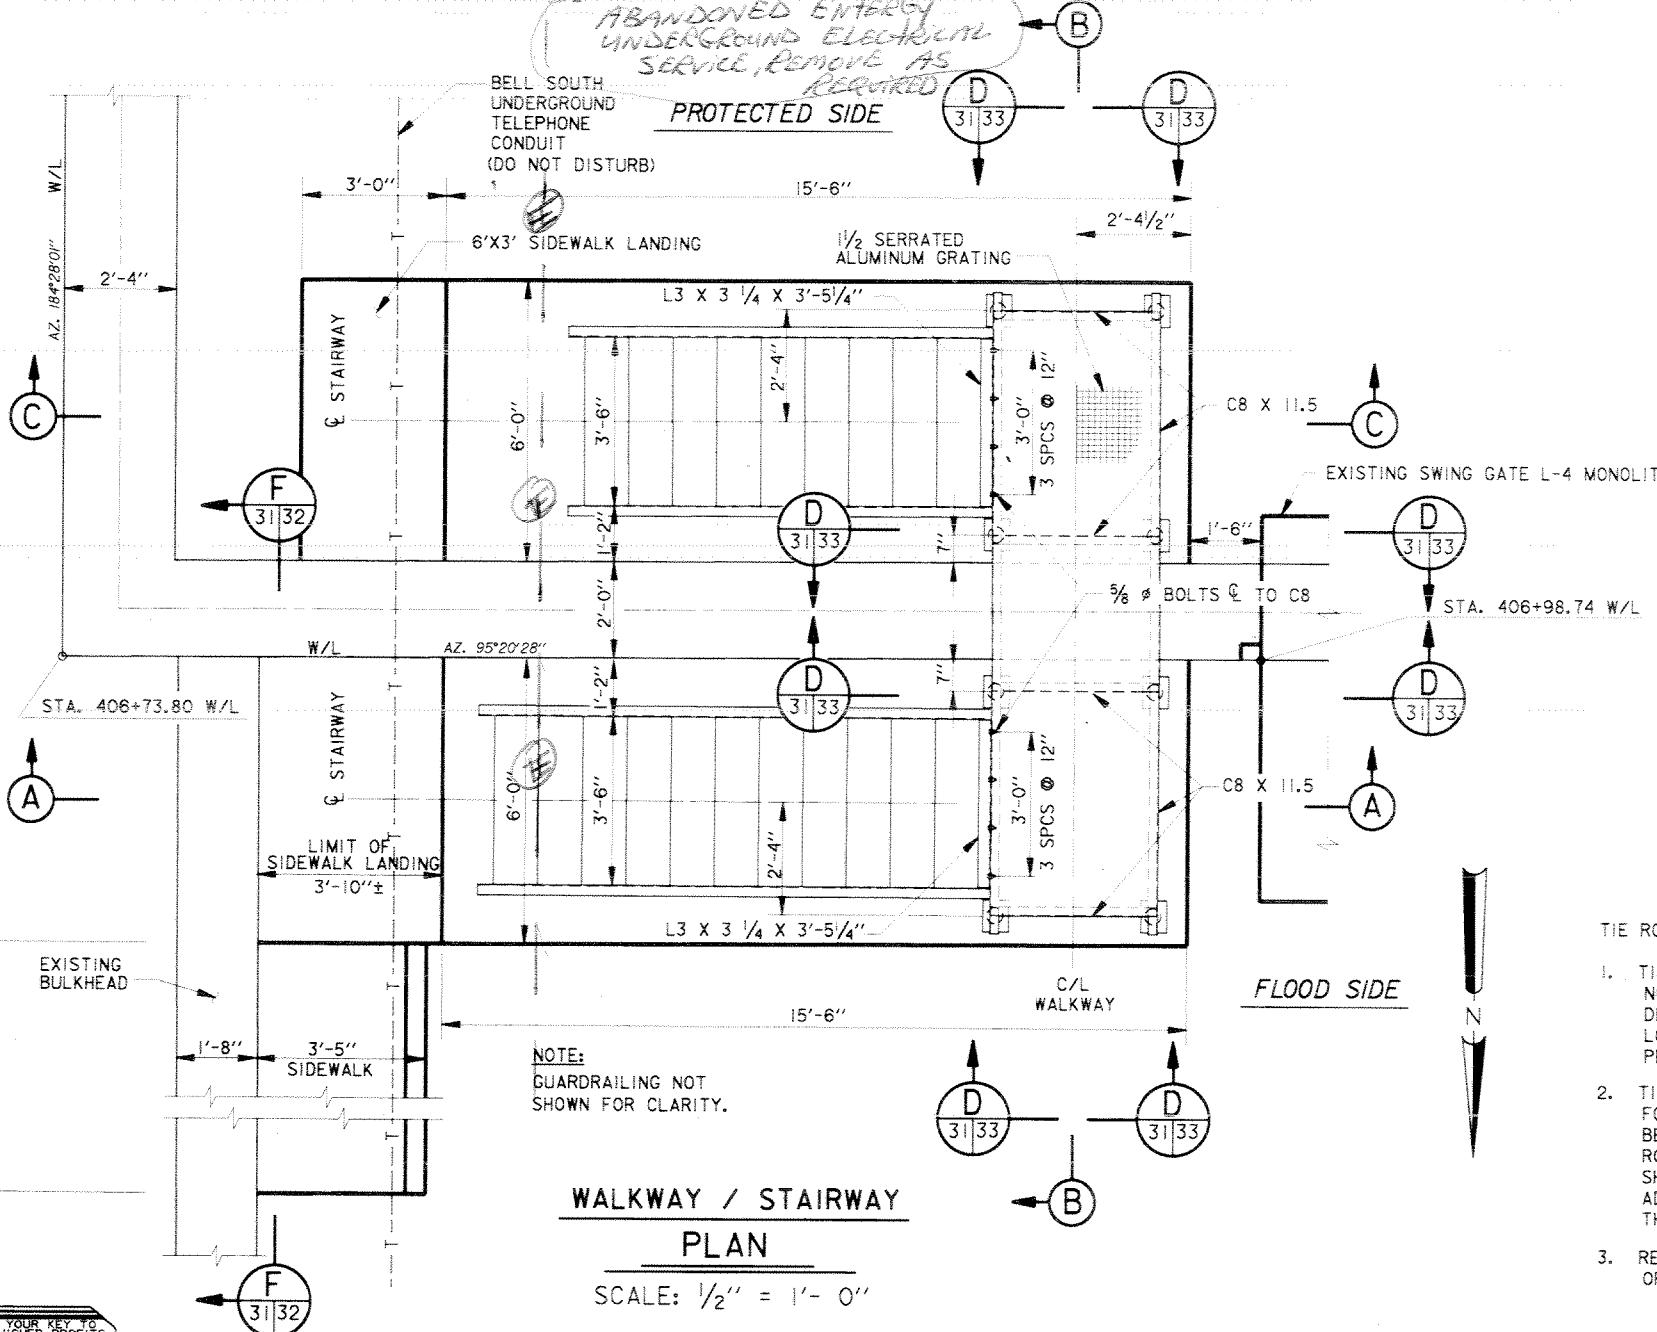

WALKWAY / STAIRWAY PLAN

SCALE: $\frac{1}{2}'' = 1'-0''$

Value
Incentive
Claims
Engineering
Your Key To
Higher Profits

SECTION A

SCALE: $\frac{1}{2}'' = 1'-0''$

FLOOD SIDE

SEE DETAIL
3133

C/L STAIRWAY

EL. 15.15

EL. 14.0

EL. 9.31

EL. 8.8

EL. 6.8

EL. 6.15

EL. 7.31

EL. 8.8

EL. 9.31

EL. 14.0

EL. 15.15

EL. 14.0

EL. 9.31

EL. 8.8

EL. 6.8

EL. 6.15

EL. 7.31

EL. 8.8

EL. 9.31

EL. 14.0

EL. 15.15

EL. 14.0

EL. 9.31

EL. 8.8

EL. 9.31

EL. 14.0

EL. 15.15

EL. 14.0

EL. 9.31

EL. 8.8

EL. 9.31


EL. 14.0

EL. 15.15



Safety is a Part
of Your Contract

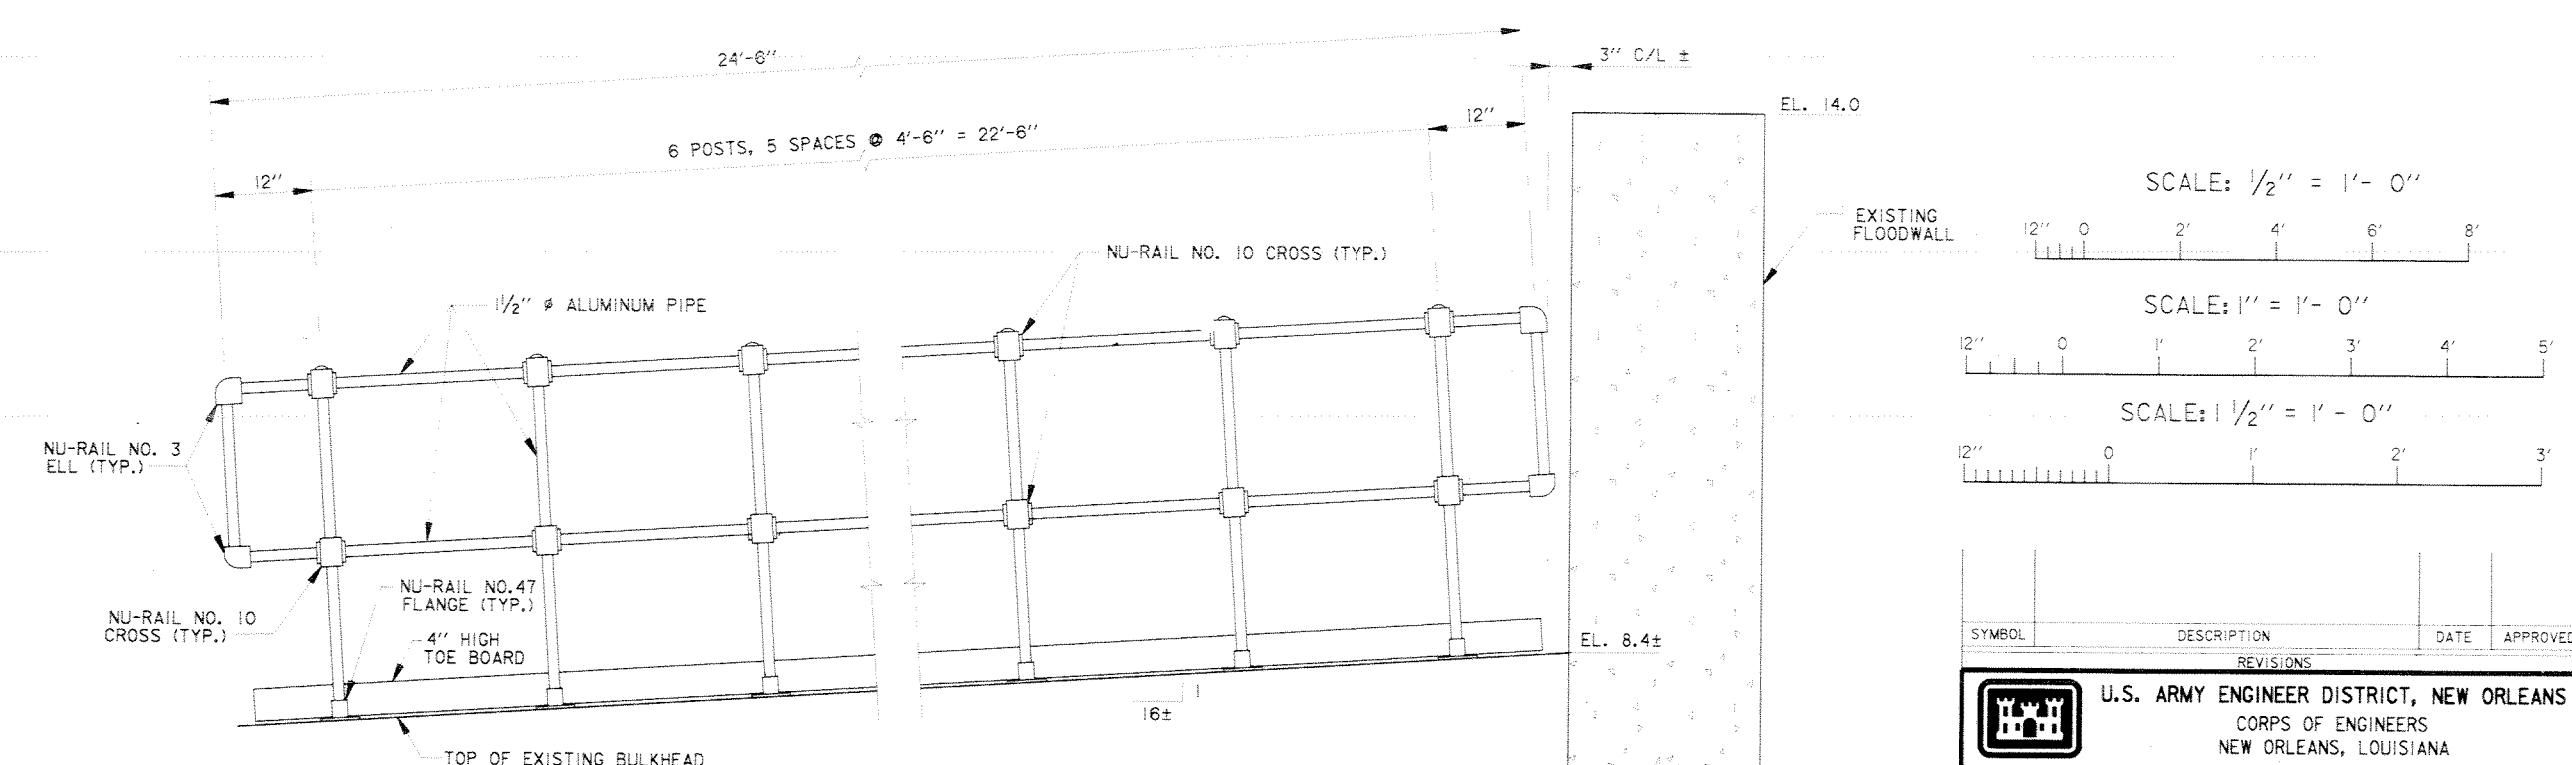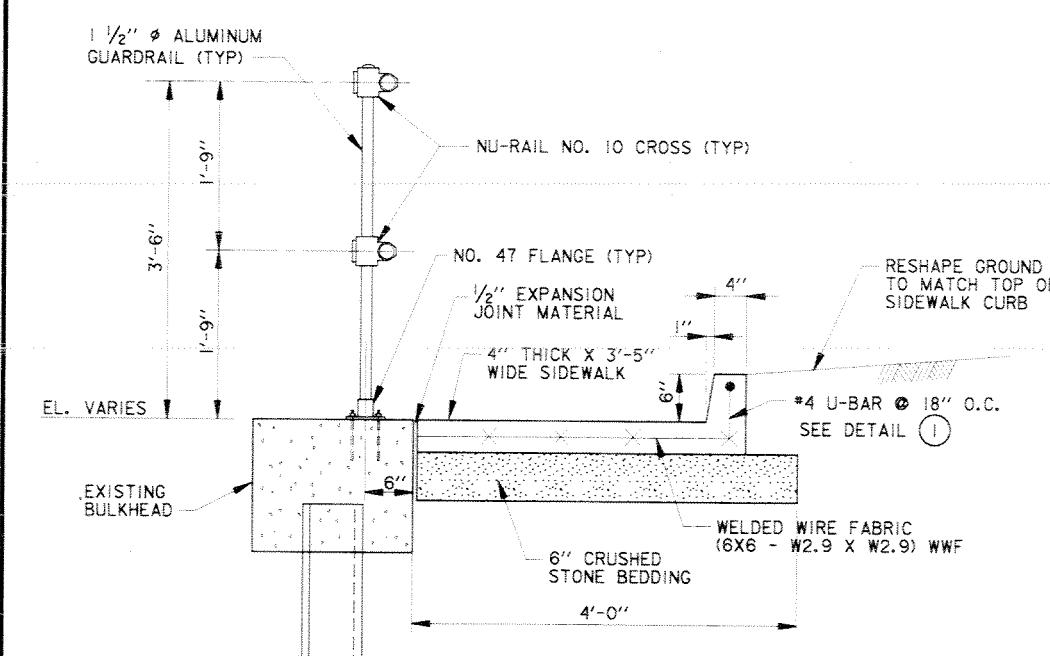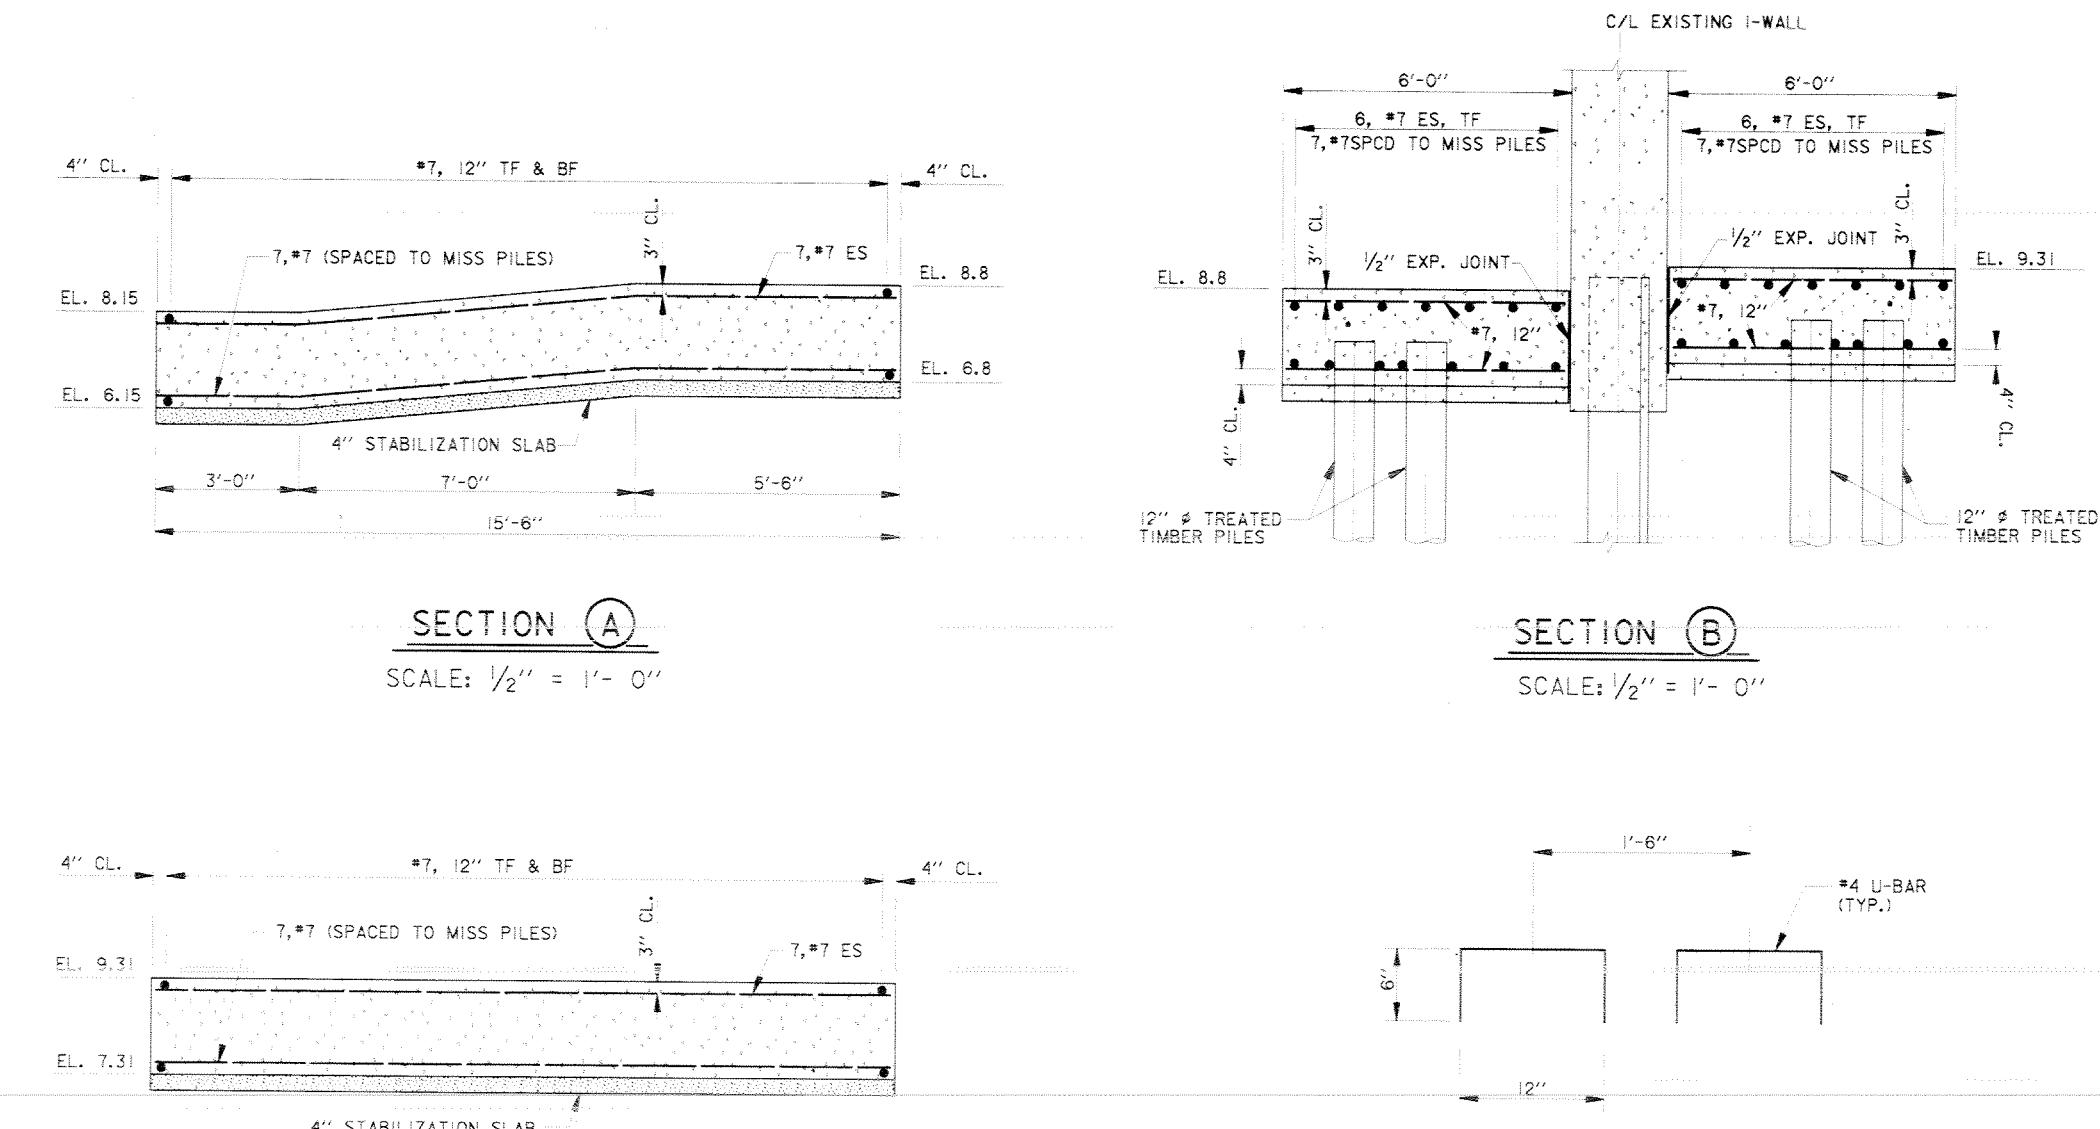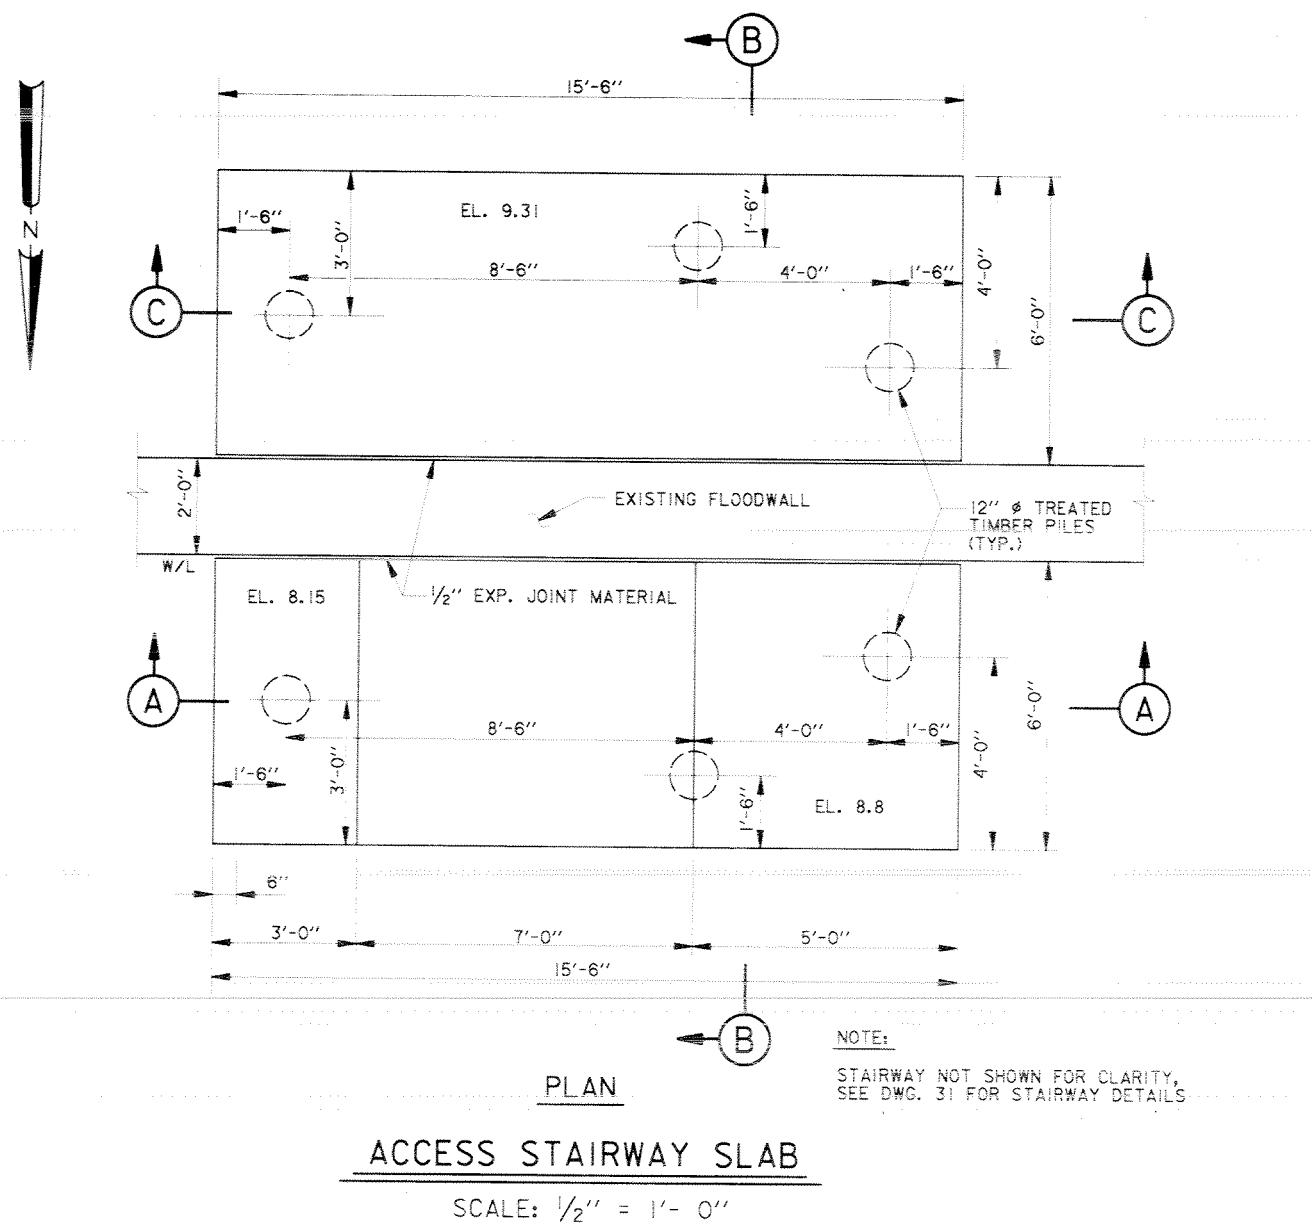

U.S. ARMY ENGINEER DISTRICT, NEW ORLEANS	
CORPS OF ENGINEERS	
NEW ORLEANS, LOUISIANA	
LAKE PONTCHARTRAIN, LA. AND VICINITY	
HIGH LEVEL PLAN	
NEW ORLEANS LAKEFRONT LEVEE	
WEST OF I.H.N.C.	
ORLEANS MARINA PHASE V - SLUICE GATES	
ORLEANS PARISH, LOUISIANA	
ACCESS STAIRWAY VICINITY OF GATE L-4	
PLAN & ELEVATIONS	
(SHT. 2 OF 2)	
DESIGNED BY: C. LABORDE	DATE: NOV. 1997
DRAWN BY: V. COUVILLION	PLOT SCALE: 24
CHECKED BY: C. LABORDE	PLOT DATE: NOV. 12, 1997
SUBMITTED BY:	FILE NO. H-4-44778
CHARLES A. LABORDE, P.E.	SOLICITATION NO. DACW29-98-B-0001
DESIGN ENGINEER	DWG. 32 OF 46

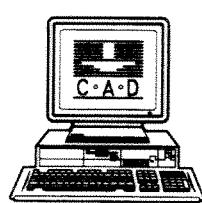


Safety is a Part
of Your Contract

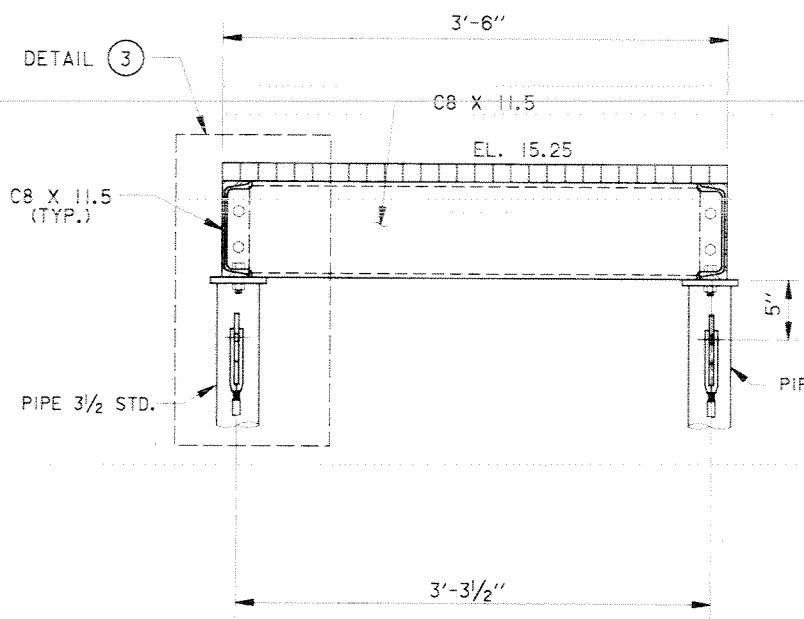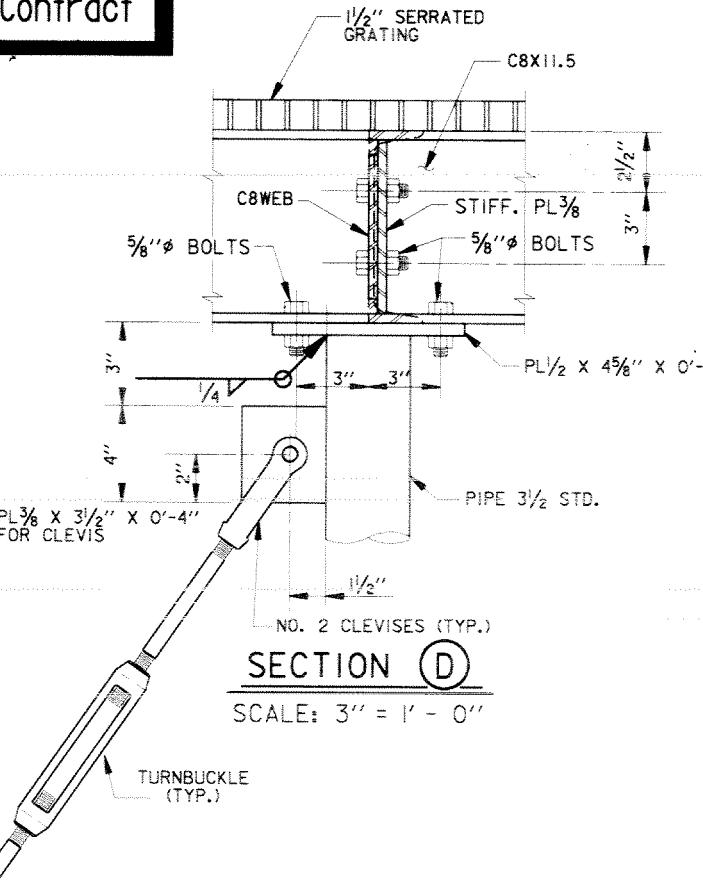



SECTION D
29 33
31 33

SCALE: 1 1/2" = 1' - 0"

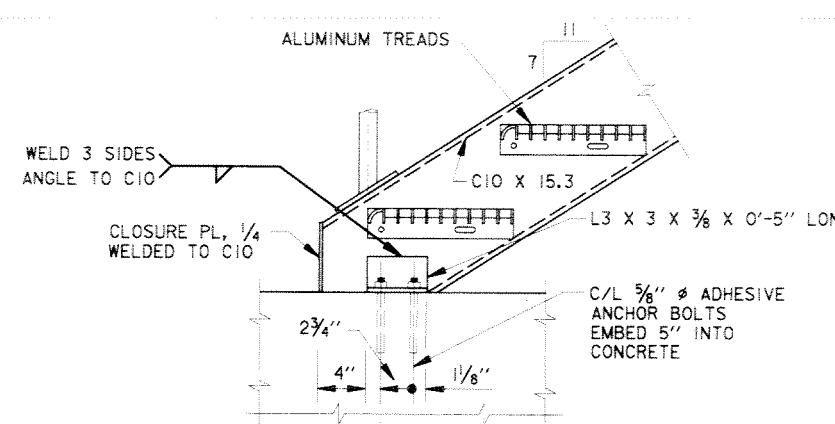


BOTTOM STAIR CONNECTION

SCALE: 1/2" = 1' - 0"

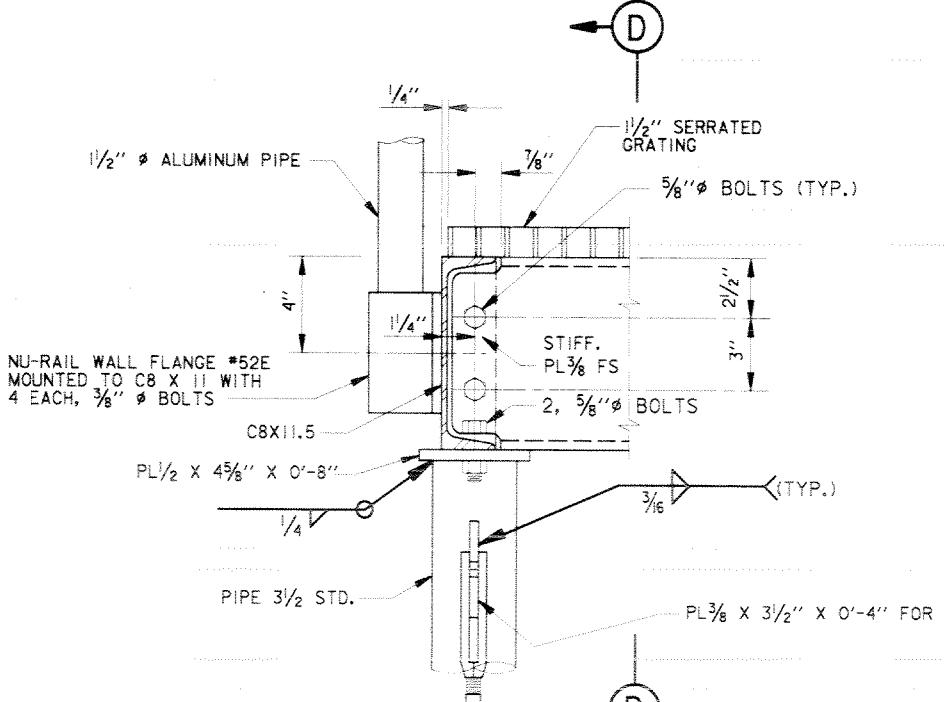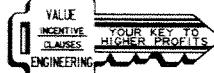


DETAIL 3
SCALE: 3" = 1' - 0"

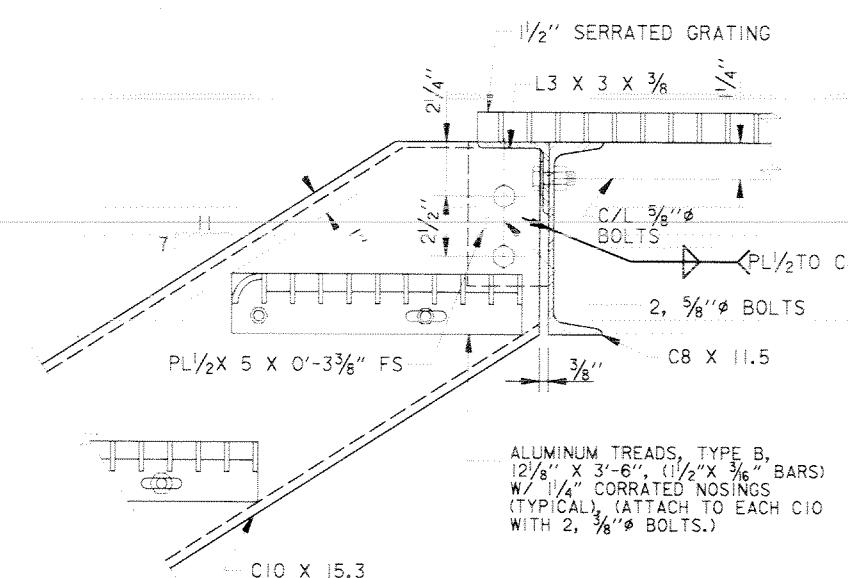

DETAIL 5
29 33
31 33


TOP STAIR CONNECTION

SCALE: 3" = 1' - 0"

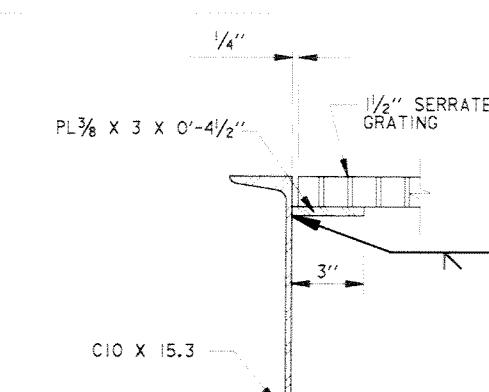


SECTION A

SCALE: 3" = 1' - 0"

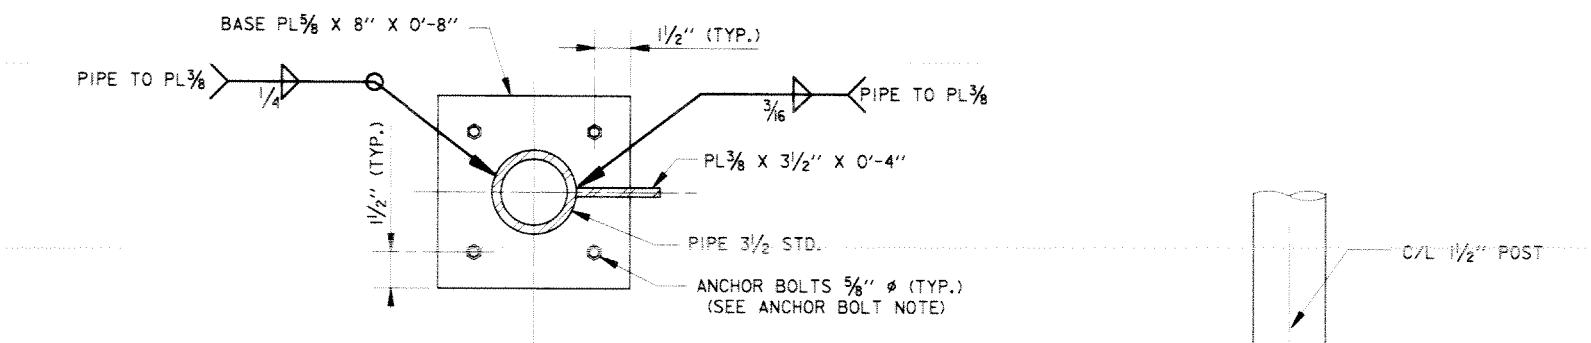


SECTION C
SCALE: 3" = 1' - 0"

ANCHOR BOLT NOTE: ANCHOR BOLTS SHALL BE 5/8" X 5 HILTI "HVA" WITH SUPER "HAS" ROD OR EQUAL.

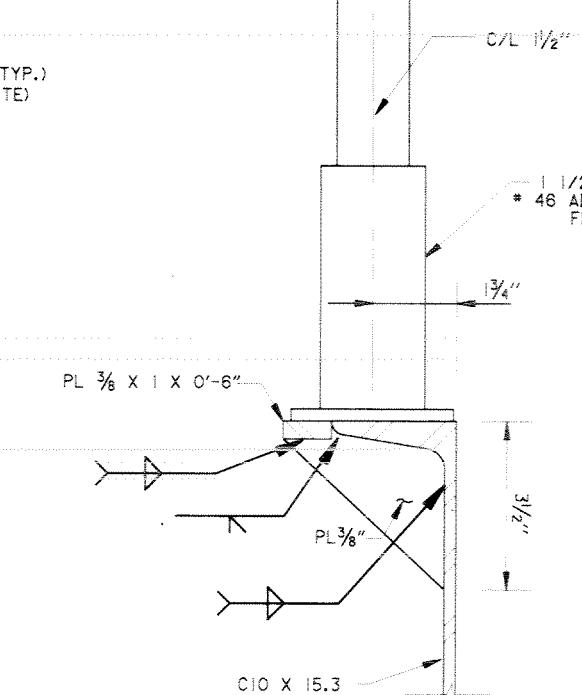

SECTION B
SCALE: 6" = 1' - 0"

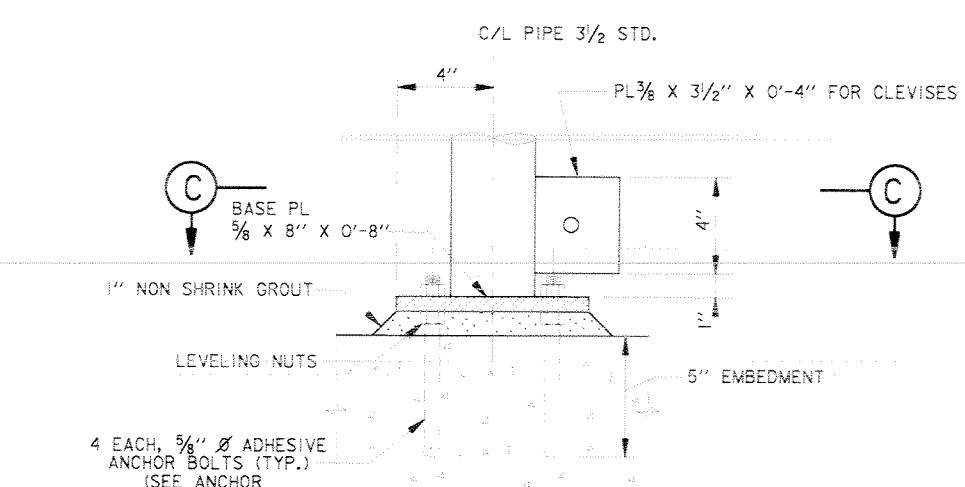


DETAIL 1
29 33
31 33

SCALE: 3" = 1' - 0"

SCALE: 1 1/2" = 1' - 0"


SCALE: 3" = 1' - 0"

SCALE: 6" = 1' - 0"

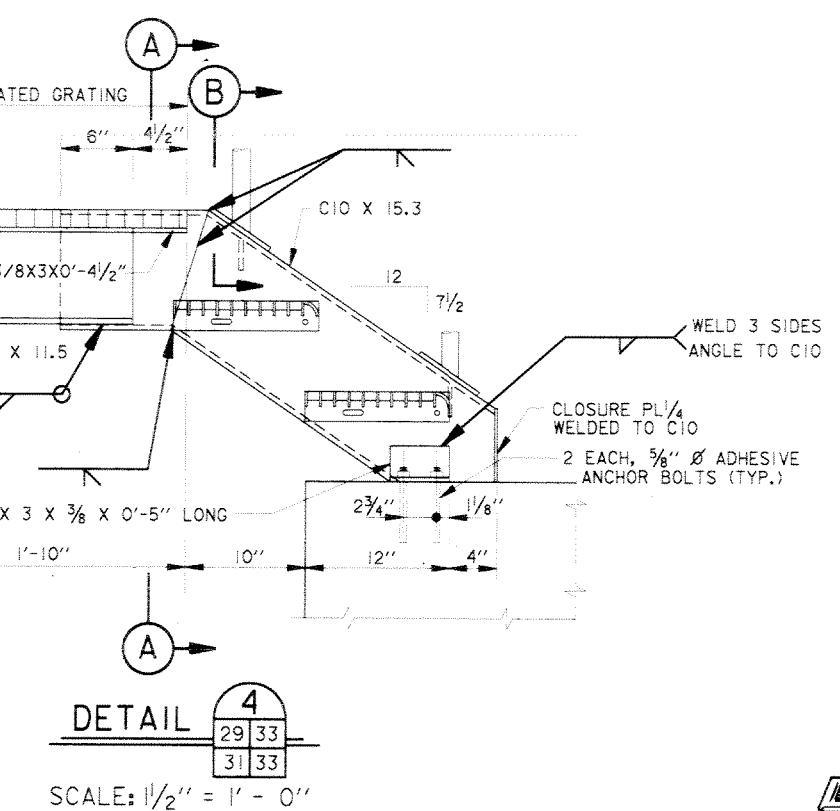

DETAIL 4
29 33
31 33

SCALE: 1/2" = 1' - 0"

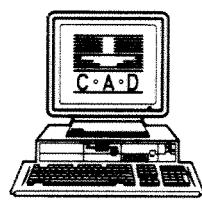





SYMBOL	DESCRIPTION	DATE	APPROVED
	U.S. ARMY ENGINEER DISTRICT, NEW ORLEANS CORPS OF ENGINEERS NEW ORLEANS, LOUISIANA LAKE PONTCHARTRAIN, LA. AND VICINITY HIGH LEVEL PLAN NEW ORLEANS LAKEFRONT LEVEE WEST OF I.H.N.C. ORLEANS MARINA PHASE V - SLUICE GATES ORLEANS PARISH, LOUISIANA	NOV. 97	

ACCESS STAIRWAY DETAILS


DESIGNED BY: C. LABORDE	PLOT SCALE:	8	PLOT DATE:
DRAWN BY: L. MAGEE	NOV. 97		FILE NO.
CHECKED BY: C. LABORDE			H-4-44778
SUBMITTED BY: CHARLES A. LABORDE, P.E., DESIGN ENGINEER			SOLICITATION NO.
			DACW29-98-B-0001
			DWG. 33 OF 46

5

1

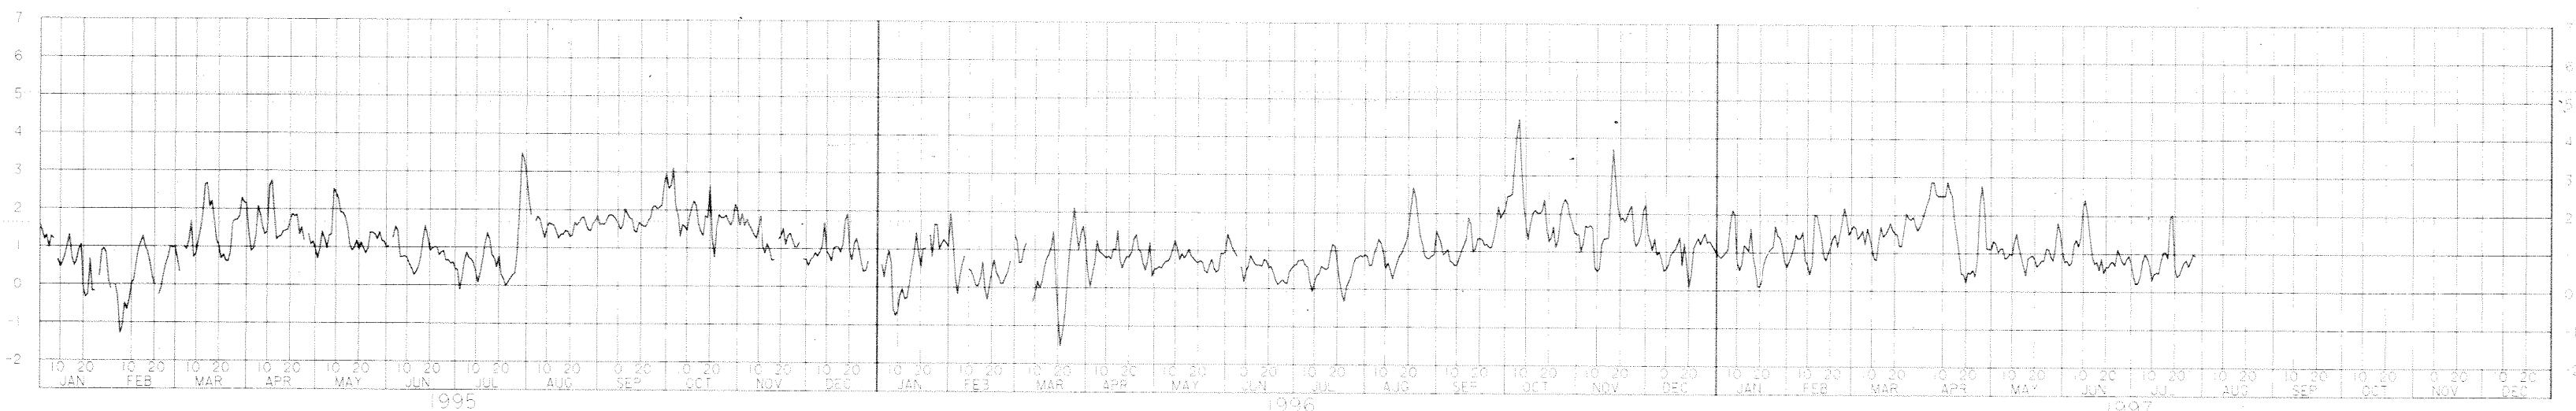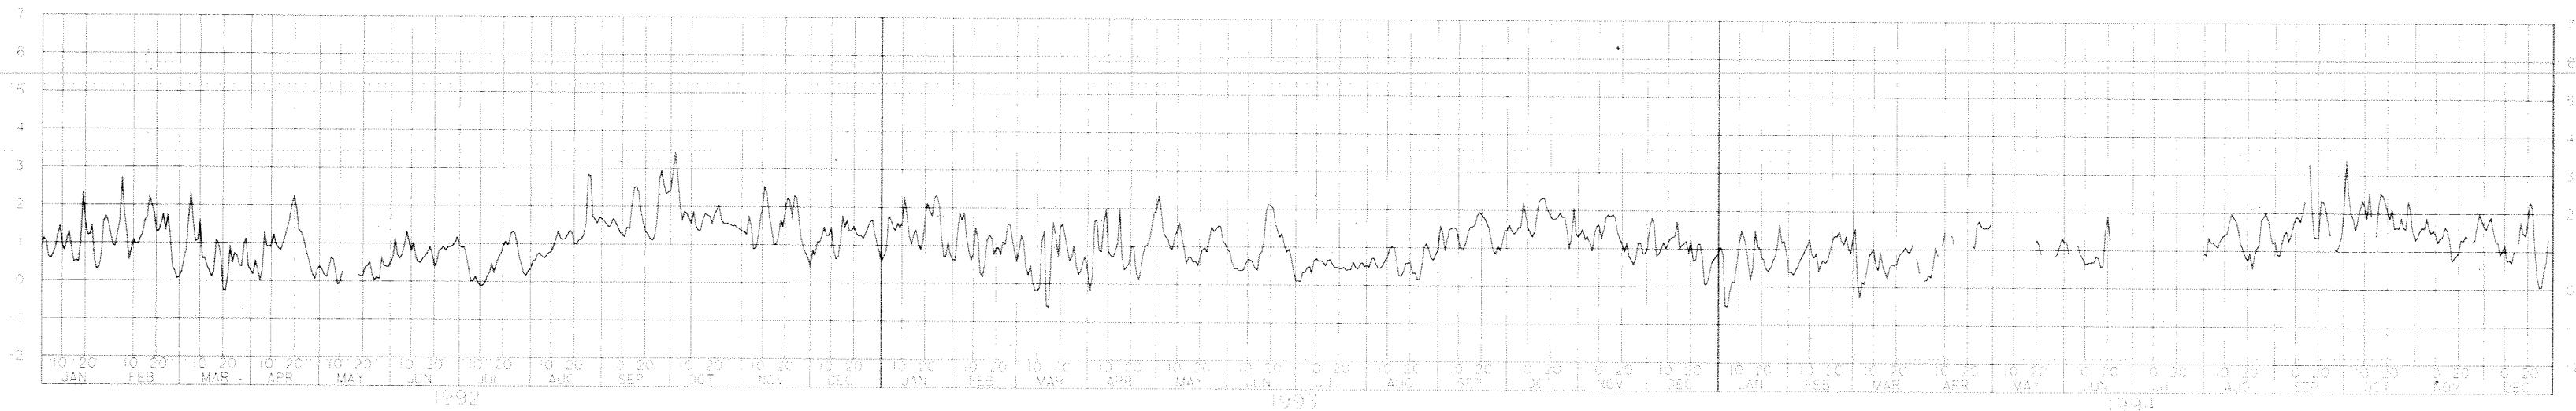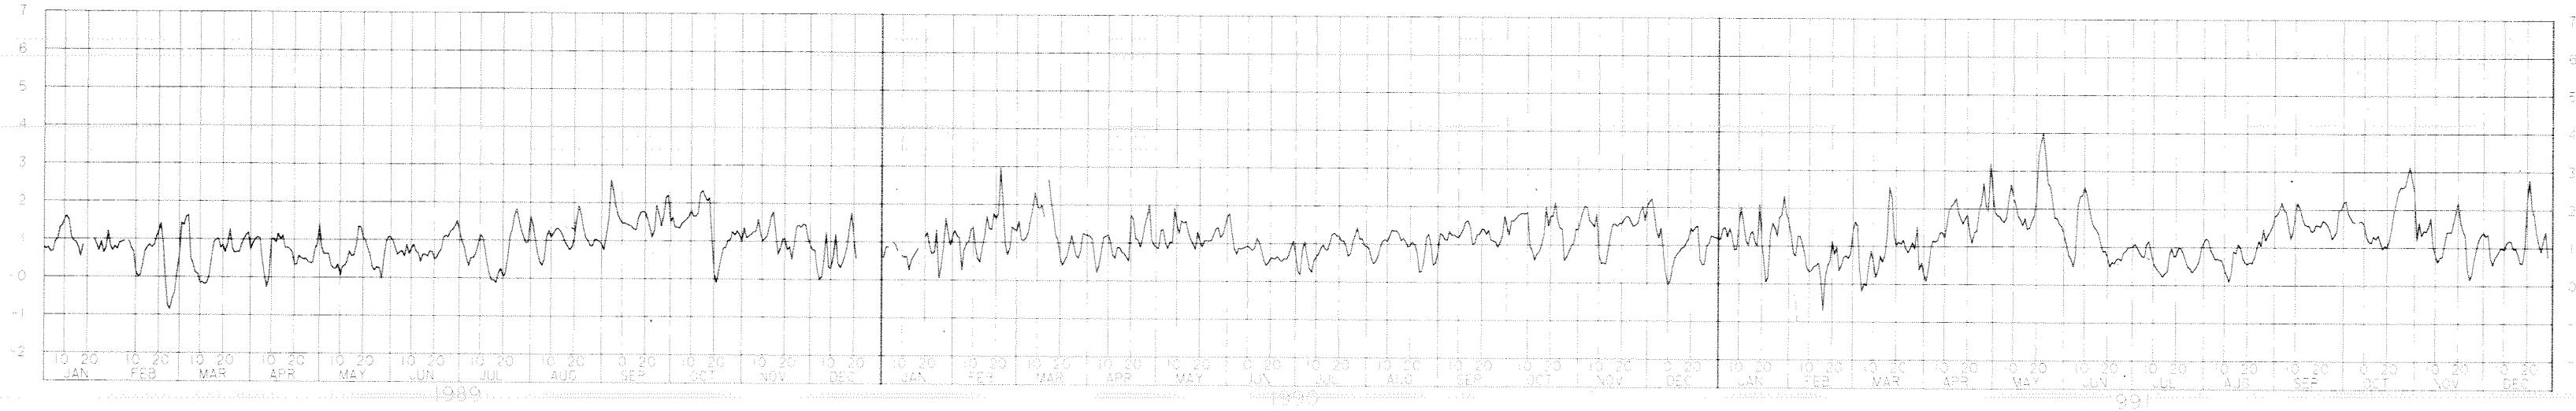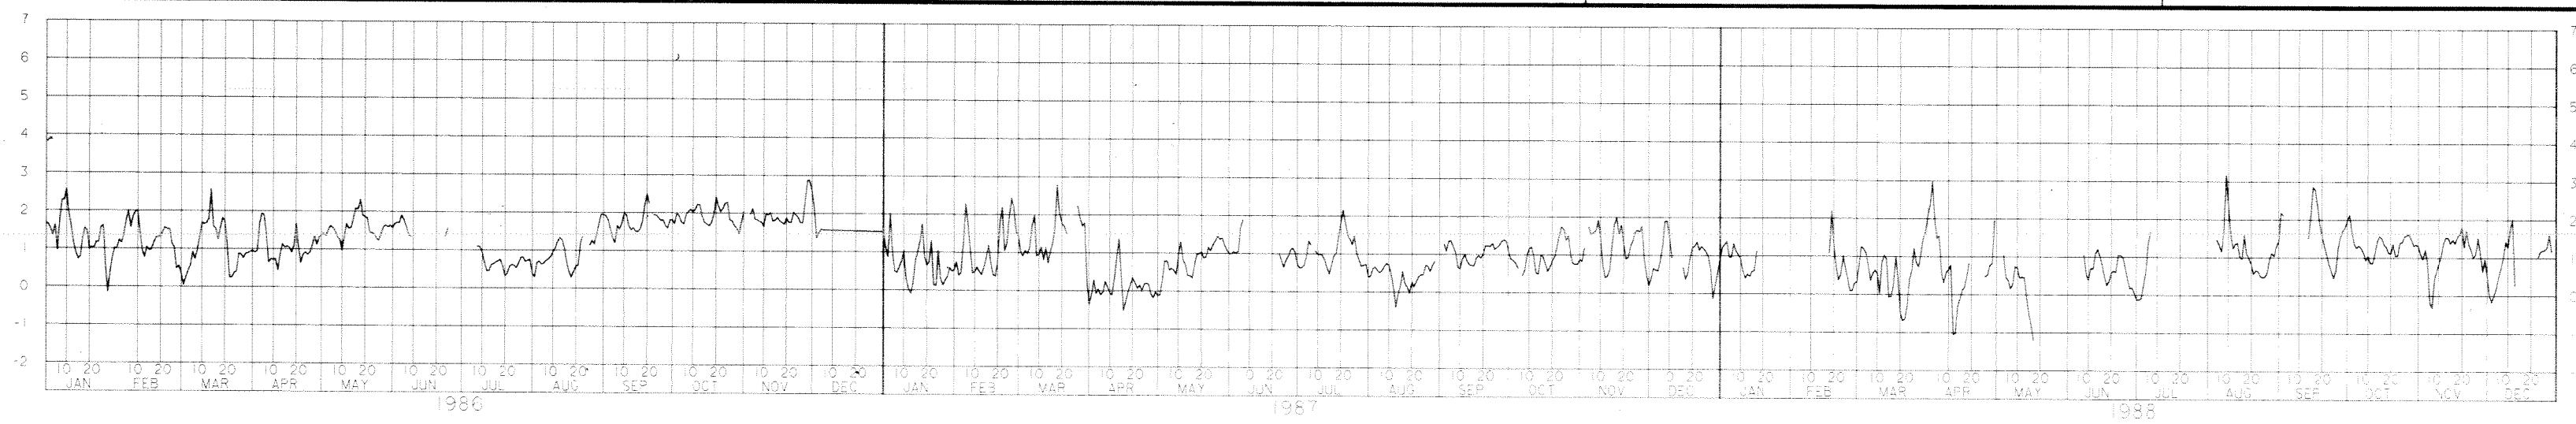


Safety is a Part of Your Contract

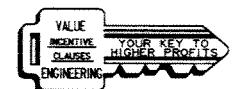

LOCATION.

LAT. 30-01-18, LONG. 90-06-57. ON WEST END
OF MUNICIPAL YACHT BUILDING IN WEST END
HARBOR. (STA.8562506)

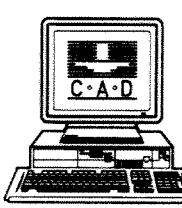

U.S. ARMY ENGINEER DISTRICT, NEW ORLEANS
CORPS OF ENGINEERS
NEW ORLEANS, LOUISIANA

LAKE PONTCHARTRAIN, LOUISIANA AND VICINITY
HIGH LEVEL PLAN
NEW ORLEANS LAKEFRONT LEVEE

**NEW ORLEANS LAKEFRONT LEVEE
WEST OF I.H.N.C.
ORLEANS MARINA PHASE V - SLUICE GATES
ORLEANS PARISH, LOUISIANA**

STAGE-HYDROGRAPH
LAKE PONTCHARTRAIN AT WEST END

DESIGNED BY: P.SCHAEFER	DATE:	PLOT SCALE:	PLOT DATE:
DRAWN BY: P.SCHAEFER	19 AUG 97	12	NOV. 12, 1997
CHECKED BY: C. LABORDE	FILE NO.		
SUBMITTED BY: J. L. BROWN	H-4-44778		
		SOLICITATION NO.	

UNIFIED SOIL CLASSIFICATION

MAJOR DIVISION	TYPE	LETTER SYMBOL	TYPICAL NAMES	
COARSE - GRAINED SOILS More than half of material is larger than No. 4 sieve size.	GRAVELS	GW GP GM GC SW SP SM SC	GRAVEL, Well Graded, gravel-sand mixtures, little or no fines GRAVEL, Poorly Graded, gravel-sand mixtures, little or no fines GRAVEL WITH FINES (Appreciable Amount of Fines) CLAYEY GRAVEL, gravel-sand-clay mixtures SANDS More than half of coarse fraction is larger than No. 4 sieve size. CLEAN SAND (Little or No Fines) SW SP SANDS WITH FINES (Appreciable Amount of Fines) SM SC CLAYEY SAND, sand-clay mixtures	
	FINE - GRAINED SOILS More than half the material is finer than No. 200 sieve size.	SILTS AND CLAYS (Liquid Limit < 50)	ML CL OL	SILT & very fine sand, silty or clayey fine sand or clayey silt with slight plasticity LEAN CLAY, Sandy Clay, Silty Clay, of low to medium plasticity ORGANIC SILTS, and organic silty clays of low plasticity
		SILTS AND CLAYS (Liquid Limit > 50)	MH CH OH	SILT, fine sandy or silty soil with high plasticity FAT CLAY, inorganic clay of high plasticity ORGANIC CLAYS of medium to high plasticity, organic silts
		HIGHLY ORGANIC SOILS	PT	PEAT, and other highly organic soil
		WOOD	Wd	WOOD
		SHELLS	SI	SHELLS
		NO SAMPLE	NS	No Sample Retrieved

NOTE: Soils possessing characteristics of two groups are designated by combinations of group symbols.

DESCRIPTIVE SYMBOLS

COLOR		CONSISTENCY FOR COHESIVE SOILS		MODIFICATIONS	
COLOR	SYMBOL	CONSISTENCY	COHESION IN LBS./SQ.FT. FROM UNCONFINED COMPRESSION TEST	MODIFICATION	SYMBOL
TAN	T			Traces	Tr
YELLOW	Y			Fine	F
RED	R			Medium	M
BLACK	BK			Coarse	C
GRAY	Gr			Concretions	cc
LIGHT GRAY	lGr			Rootlets	rt
DARK GRAY	dGr			Lignite fragments	lg
BROWN	Br			Shale fragments	sh
LIGHT BROWN	lBr			Sandstone fragments	sds
DARK BROWN	dBr			Shell fragments	sif
BROWNISH-GRAY	brGr			Organic matter	O
GRAYISH-BROWN	gyBr			Clay strata or lenses	CS
GREENISH-GRAY	gnGr			Silt strata or lenses	SIS
GRAYISH-GREEN	gyGn			Sand strata or lenses	SS
GREEN	Gn			Sandy	S
BLUE	Bl			Gravelly	G
BLUE-GREEN	Bgn			Boulders	B
WHITE	Wh			Slickensides	SL
MOTTLED	Mot			Wood	Wd
				Oxidized	Ox

PLASTICITY CHART

For classification of fine-grained soils in accordance with ASTM D 2487

NOTES:

FIGURES TO LEFT OF BORING UNDER COLUMN "W OR D₁₀"

Are natural water contents in percent dry weight

When underlined denotes D₁₀ size in mm*

FIGURES TO LEFT OF BORING UNDER COLUMNS "LL" AND "PL"

Are liquid and plastic limits, respectively

SYMBOLS TO LEFT OF BORING

▽ Ground-water surface and date observed

© Denotes location of consolidation test**

Ⓐ Denotes location of consolidated-drained direct shear test**

Ⓑ Denotes location of consolidated-undrained triaxial compression test**

Ⓒ Denotes location of unconsolidated-undrained triaxial compression test**

Ⓓ Denotes location of sample subjected to consolidation test and each of the above three types of shear test**

FW Denotes free water encountered in boring or sample

FIGURES TO RIGHT OF BORING

Are values of cohesion in lbs./sq.ft. from unconfined compression tests

In parenthesis are driving resistances in blows per foot determined with a standard split spoon sampler (1 3/8" I.D., 2" O.D.) and a 140 lb. driving hammer with a 30" drop

Where underlined with a solid line denotes laboratory permeability in centimeters per second of undisturbed sample

Where underlined with a dashed line denotes laboratory permeability in centimeters per second of sample remoulded to the estimated natural void ratio

*The D₁₀ size of a soil is the grain diameter in millimeters of which 10% of the soil is finer, and 90% coarser than D₁₀.

**Results of these tests are available for inspection in the U.S. Army Engineer District Office, if these symbols appear beside the boring logs on the drawings.

TYPICAL NOTES:

- While the borings are representative of subsurface conditions at their respective locations and for their respective vertical reaches, local variations characteristic of the subsurface materials of the region are anticipated and, if encountered, such variations will not be considered as differing materially within the purview of the contract clause entitled "Differing Site Conditions".
- Ground-water elevations shown on the boring logs represent ground-water surfaces encountered in such borings on the dates shown. Absence of water surface data on certain borings indicates that no ground-water data are available from the boring but does not necessarily mean that ground-water will not be encountered at the locations or within the vertical reaches of such borings.
- Consistency of cohesive soils shown on the boring logs is based on driller's log and visual examination and is approximate, except within those vertical reaches of the borings where shear strengths from unconfined compression tests are shown.
- Unless otherwise noted:
 - Undisturbed borings, indicated by the letter "U", are taken with a 5" I.D. Piston Type Sampler.
 - General type borings are taken with a 1 1/8" I.D. Tube Sampler and/or a 1 3/8" I.D. Split Spoon Sampler.

SYMBOL	DESCRIPTION	DATE	APPROVED

U.S. ARMY ENGINEER DISTRICT, NEW ORLEANS
CORPS OF ENGINEERS
NEW ORLEANS, LOUISIANA

LAKE PONTCHARTRAIN, LOUISIANA AND VICINITY

HIGH LEVEL PLAN

NEW ORLEANS LAKEFRONT LEVEE



WEST OF I.H.N.C.

ORLEANS MARINA PHASE V - SLUICE GATES




ORLEANS PARISH, LOUISIANA

SOIL BORING LEGEND

DESIGNED BY: SCHAEFER DRAWN BY: J.DARBY CHECKED BY: C.LABORDE SUBMITTED BY: CHARLES A. LABORDE, P.E. DESIGN ENGINEER	DATE: NOV 97 PLOT SCALE: 1:1000 FILE NO. H-4-44778 SOLICITATION NO. DACW29-98-B-0001 DWG. 35 OF 46
---	--

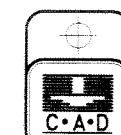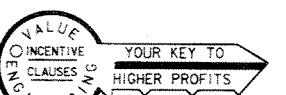

Safety is a Part
of Your Contract

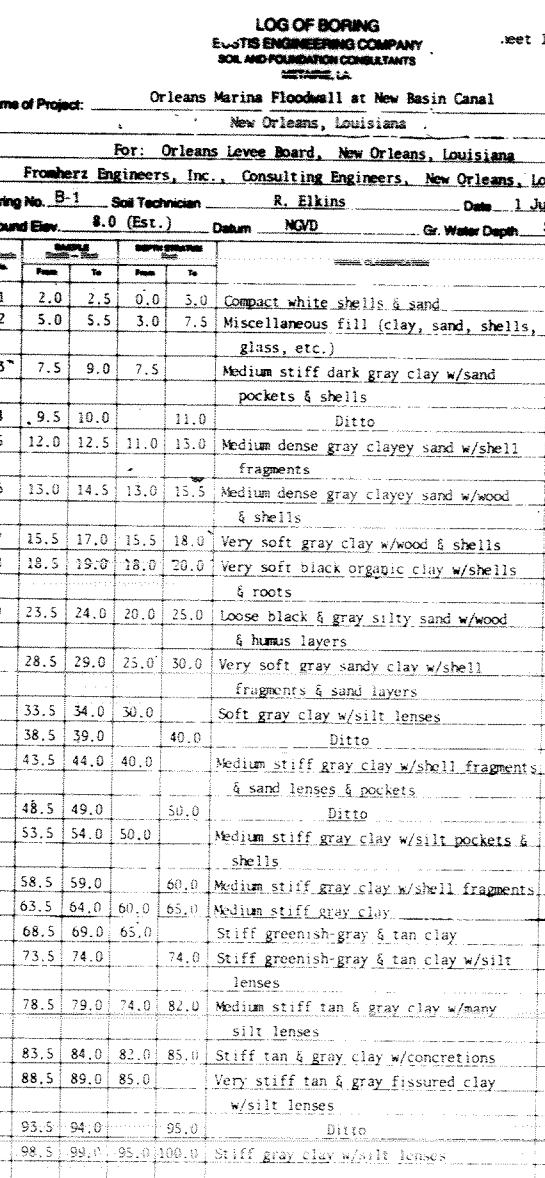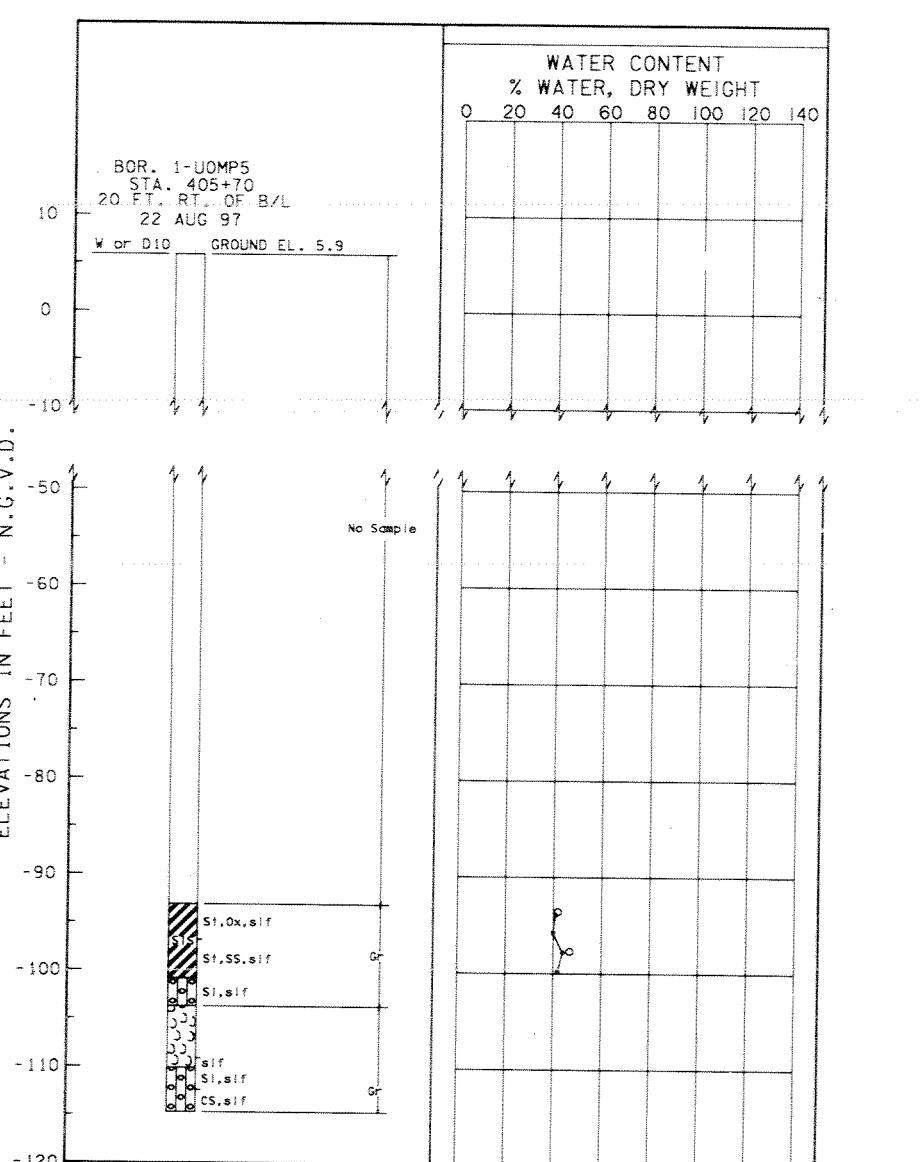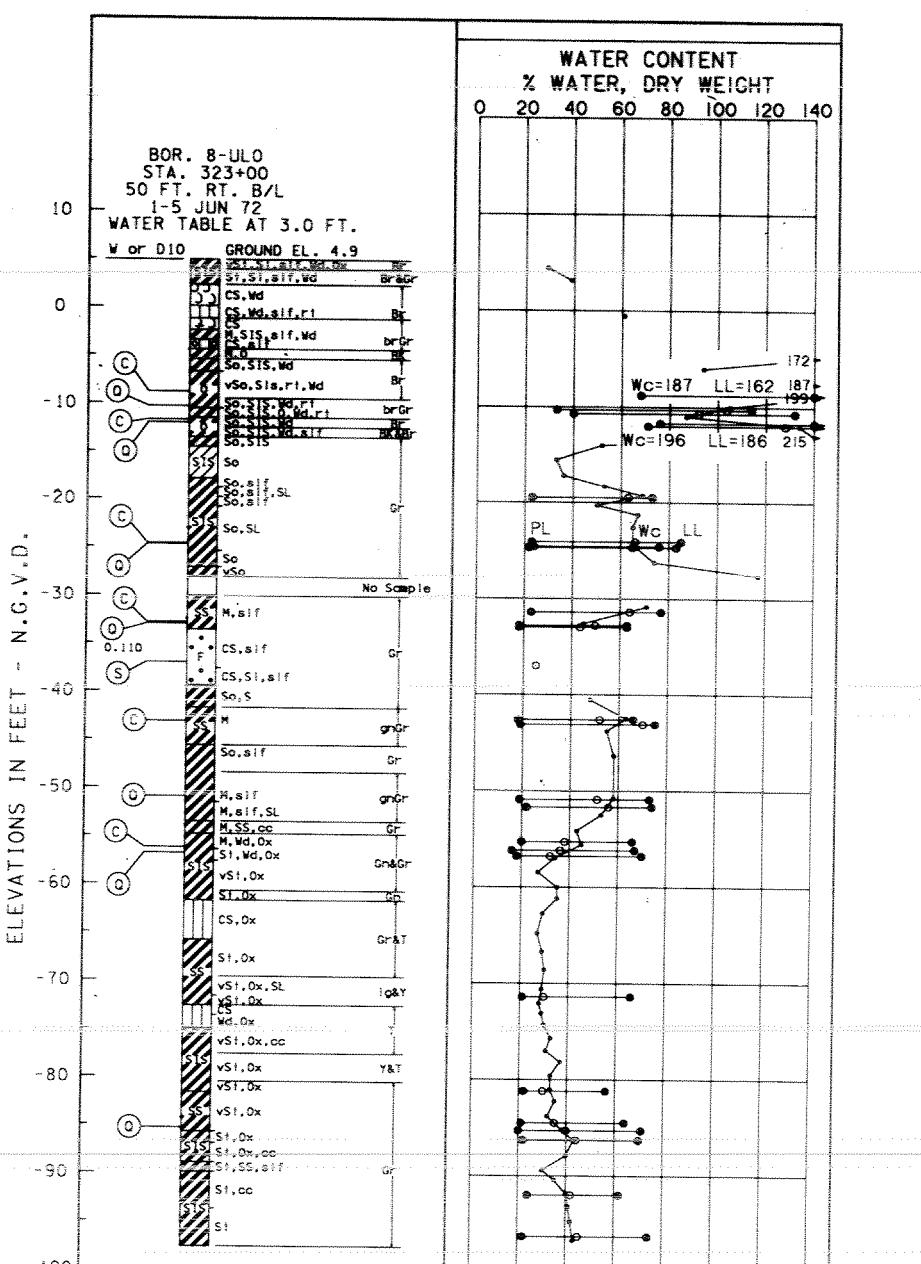

SUMMARY OF LABORATORY TEST RESULTS
WEST SIDE OF NEW BASIN CANAL

BORING B-1

Sample No.	Depth In Feet	Classification	Water Content Percent	Density PCF	Unconfined Compressive Strength PSF	Sample No.	Depth In Feet	Classification	Water Content Percent	Density PCF	Unconfined Compressive Strength PSF	
4	9.5	Medium stiff dark gray clay w/sand pockets & shells	31.9	88.4	116.8	1015*	3	8.0	Loose gray clayey sand w/shell fragments, roots & organic matter	42.3	-----	-----
5	12.0	Medium dense gray clayey sand w/shell fragments	32.1	88.4	116.8	1015*	4	11.0	Soft gray silty clay w/wood & organic matter	82.2	-----	-----
8	18.5	Very soft black organic clay w/shells & roots	142.7	32.3	78.5	450	5	14.0	Extremely soft brown organic material w/roots & silt pockets	153.2	29.2	74.0
9	23.5	Loose black & gray silty sand w/glass, etc.	62.4	57.4	93.2	635*	6	19.0	Very soft gray silty clay w/shell fragments	34.8	84.7	114.1
10	28.5	Very soft gray sandy clay	35.9	81.8	111.1	450	7	24.0	Very soft gray clay w/silt lenses	53.7	67.6	103.9
11	33.5	Soft gray clay w/silt lenses	61.7	62.8	101.5	925	8	29.0	Soft gray clay w/silt lenses	69.3	58.7	99.4
12	38.5	Ditto	62.1	62.6	101.5	1240	9	34.0	Soft gray clay w/shell fragments	74.5	-----	-----
13	43.5	Medium stiff clay w/sand pockets & shell fragments	42.9	76.4	109.2	1780*	10	39.0	Soft gray clay w/sand pockets	40.3	79.1	110.9
15	53.5	Medium stiff gray clay w/silt	51.3	69.0	104.4	1130	11	44.0	Medium stiff gray clay w/silt lenses	2255	-----	-----
16	58.5	Medium stiff gray clay w/shell	59.7	63.2	100.9	1215	12	59.0	Medium stiff gray clay with many shell fragments	3045	-----	-----
17	63.5	Medium stiff gray clay	54.3	67.9	104.8	1665	13	64.0	Medium stiff dark gray clay w/organic matter & decayed	105.2	42.2	86.5
18	68.5	Stiff greenish-gray & tan clay	27.8	95.4	121.8	2255	14	69.0	Very stiff greenish-gray & tan silty clay	21.9	103.8	126.5
19	73.5	Stiff greenish-gray & tan clay w/silt lenses	29.3	93.9	121.4	3045	15	74.0	Medium compact greenish-gray & tan clay w/silt lenses & clay layers & trace of fine sand	26.3	96.5	121.9
20	78.5	Medium stiff tan & gray clay	29.0	93.9	121.2	1780*	16	79.5	Very stiff tan & gray clay w/silt lenses	36.5	85.1	116.1
21	83.5	Stiff tan & gray clay with concretions	24.3	101.0	125.5	3765	17	84.0	Very stiff tan & gray clay	34.4	87.8	117.9
22	88.5	Very stiff tan & gray fissured clay w/silt lenses	35.4	86.2	116.7	4705	18	90.0	Very stiff gray clay w/silt lenses	42.3	79.5	113.2
23	93.5	Ditto	34.4	88.2	118.5	5790	19	94.0	Very stiff tan & gray clay	34.4	87.8	117.9
24	98.5	Stiff gray clay	39.9	82.1	114.9	5915	20	97.5	Very stiff tan & gray clay w/silt lenses	5400	-----	-----

*Unconsolidated Undrained Triaxial Compression Test - One Specimen;
Confined at the approximate overburden pressure.

*Unconsolidated Undrained Triaxial Compression Test - One Specimen;
Confined at the approximate overburden pressure.

NOTES:

1. STANDARD PENETRATION TEST
*NUMBER IN FIRST COLUMN INDICATES NUMBER OF BLOWS OF 140-LB HAMMER DROPPED 30 IN. REQUIRED TO SEAT 2-IN. O.D. SPLITSPON Sampler 6 IN. NUMBER IN SECOND COLUMN INDICATES NUMBER OF BLOWS OF 140-LB. HAMMER DROPPED 30 IN. REQUIRED TO DRIVE 2-IN. O.D. SPLITSPON Sampler 1 FT. AFTER SEATING 6 IN.
2. FOR SOIL BORINGS 8-UL0 AND 1-UOMP5 SEE LEGEND DRAWING
3. FOR EUSTIS ENGINEERING BORINGS FURTHER INFORMATION IS AVAILABLE IN EUSTIS ENGINEERING APPENDICES DATED 12 DECEMBER 1984 GEOTECHNICAL INVESTIGATION ORLEANS MARINA FLOODWALL AT NEW BASIN CANAL OLB PROJECT NO. 2041-0217 NEW ORLEANS, LOUISIANA.
4. WHILE THESE LOGS OF BORINGS ARE CONSIDERED TO BE REPRESENTATIVE OF SUBSURFACE CONDITIONS AT ITS RESPECTIVE LOCATION ON THE DATE SHOWN, IT IS NOT WARRANTED THAT IT IS REPRESENTATIVE OF SUBSURFACE CONDITIONS AT OTHER LOCATIONS AND TIMES.


LEGEND FOR BORINGS B-1 & B-2




PREDOMINANT TYPE SHOWN HEAVY.
MODIFYING TYPE SHOWN LIGHT.

SYMBOL	DESCRIPTION	DATE	APPROVED
REVISIONS			
	U.S. ARMY ENGINEER DISTRICT, NEW ORLEANS CORPS OF ENGINEERS NEW ORLEANS, LOUISIANA		
LAKE PONTCHARTRAIN, LA. AND VICINITY HIGH LEVEL PLAN			
NEW ORLEANS LAKEFRONT LEVEE WEST OF I.H.N.C. ORLEANS MARINA PHASE V - SLUICE GATES ORLEANS PARISH, LA.			
SOIL BORINGS			
DESIGNED BY: VOJKOVICH DRAWN BY: WOODS CHECKED BY: RICHARDSON SUBMITTED BY: LARRY W. TORRE, P.E. DESIGN ENGINEER	DATE: NOV.97 PLOT SCALE: 10 PLOT DATE: OCT.21, 1997 FILE NO. H-4-44778 CADD FILE: fmocnv.dgn SOLICITATION NO. DACW29-98-B-0001 DWG. 36 OF 46		

Safety is a Part
of Your Contract

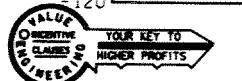


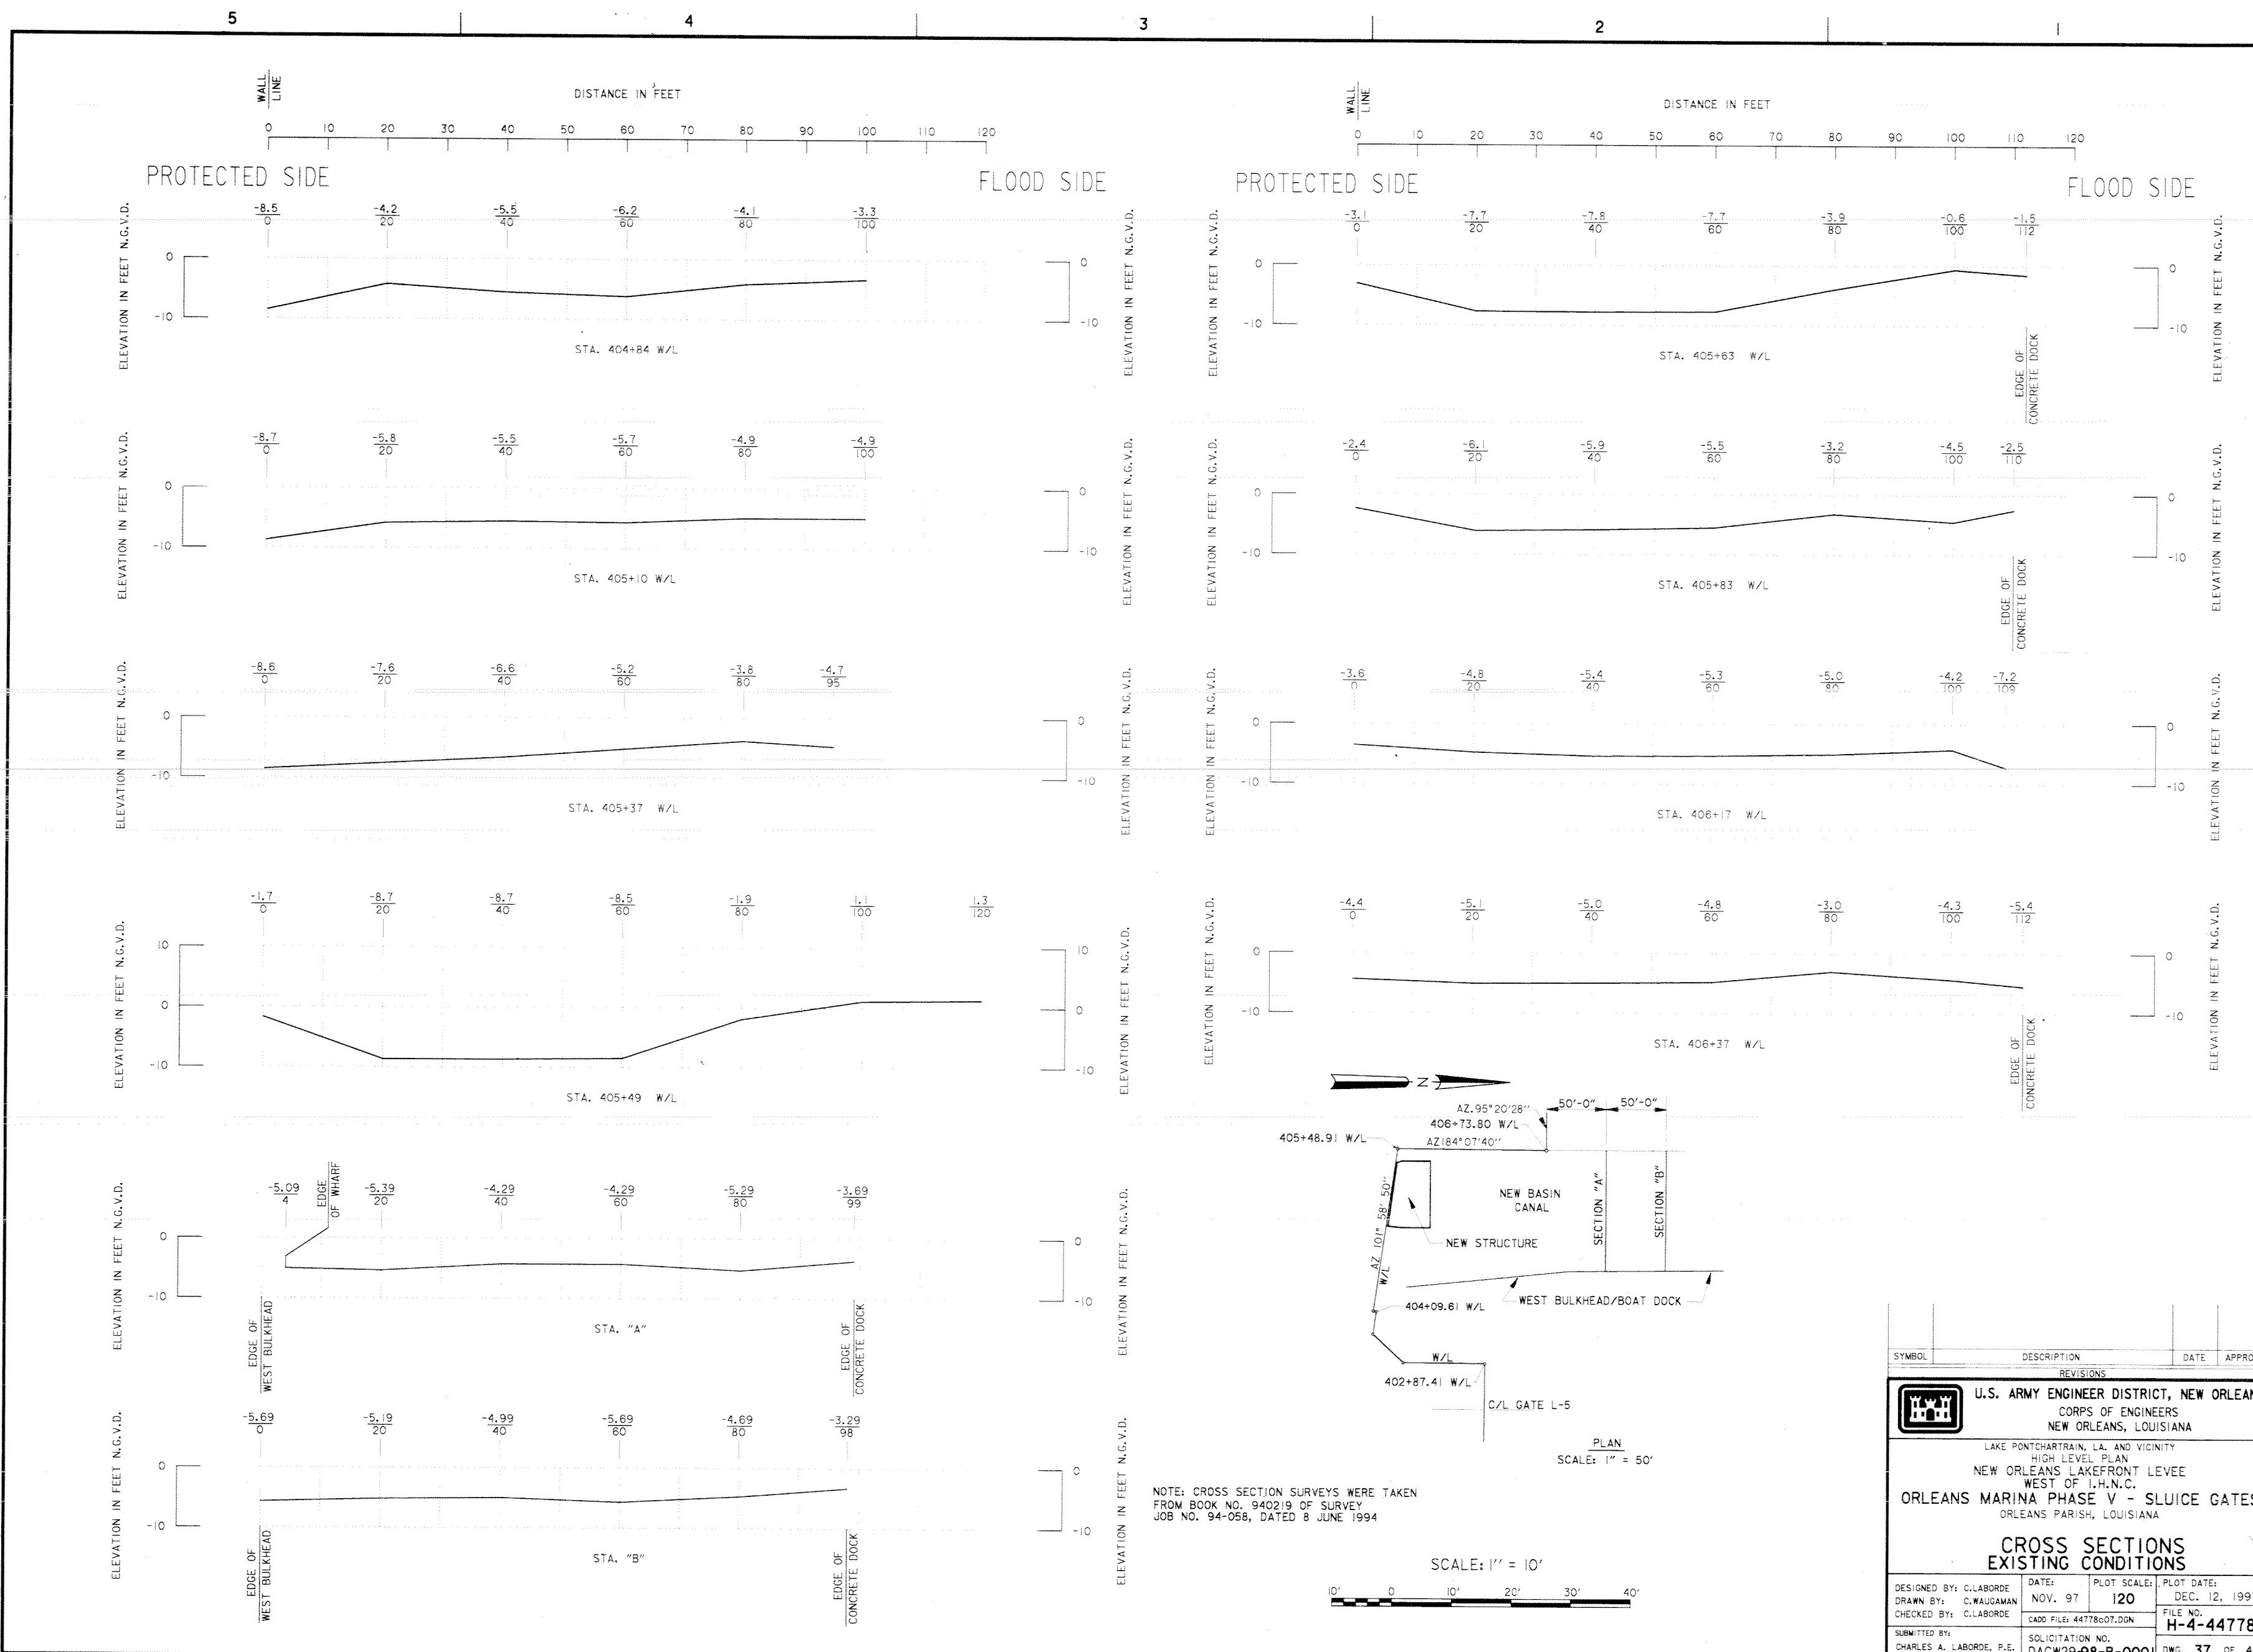



**Safety is a Part
of Your Contract**

Fixture Schedule

- F1 INCANDESCENT VAPORTITE, CAST ALUMINUM FIXTURE BODY, CLEAR TEMPERED GLASS GLOBE, CAST ALUMINUM GUARD, STANCHION MOUNT, UL WET LOCATION LISTED, 120 VOLT LAMP-150 WATT A-21. HUBBELL CAT #VS-150 OR APPROVED EQUAL.
- F2 HID FLOODLIGHT, 175 WATT, METAL HALIDE HIGH POWER FACTOR BALLAST, SLIPFITTER MOUNTING, MULTI TAP 120/208/240/277 VOLT BALLAST LAMP-175MH HUBBELL #PVL-0175H-118 WITH #PVL-PT TENON SLIPFITTER ATTACHEMENT

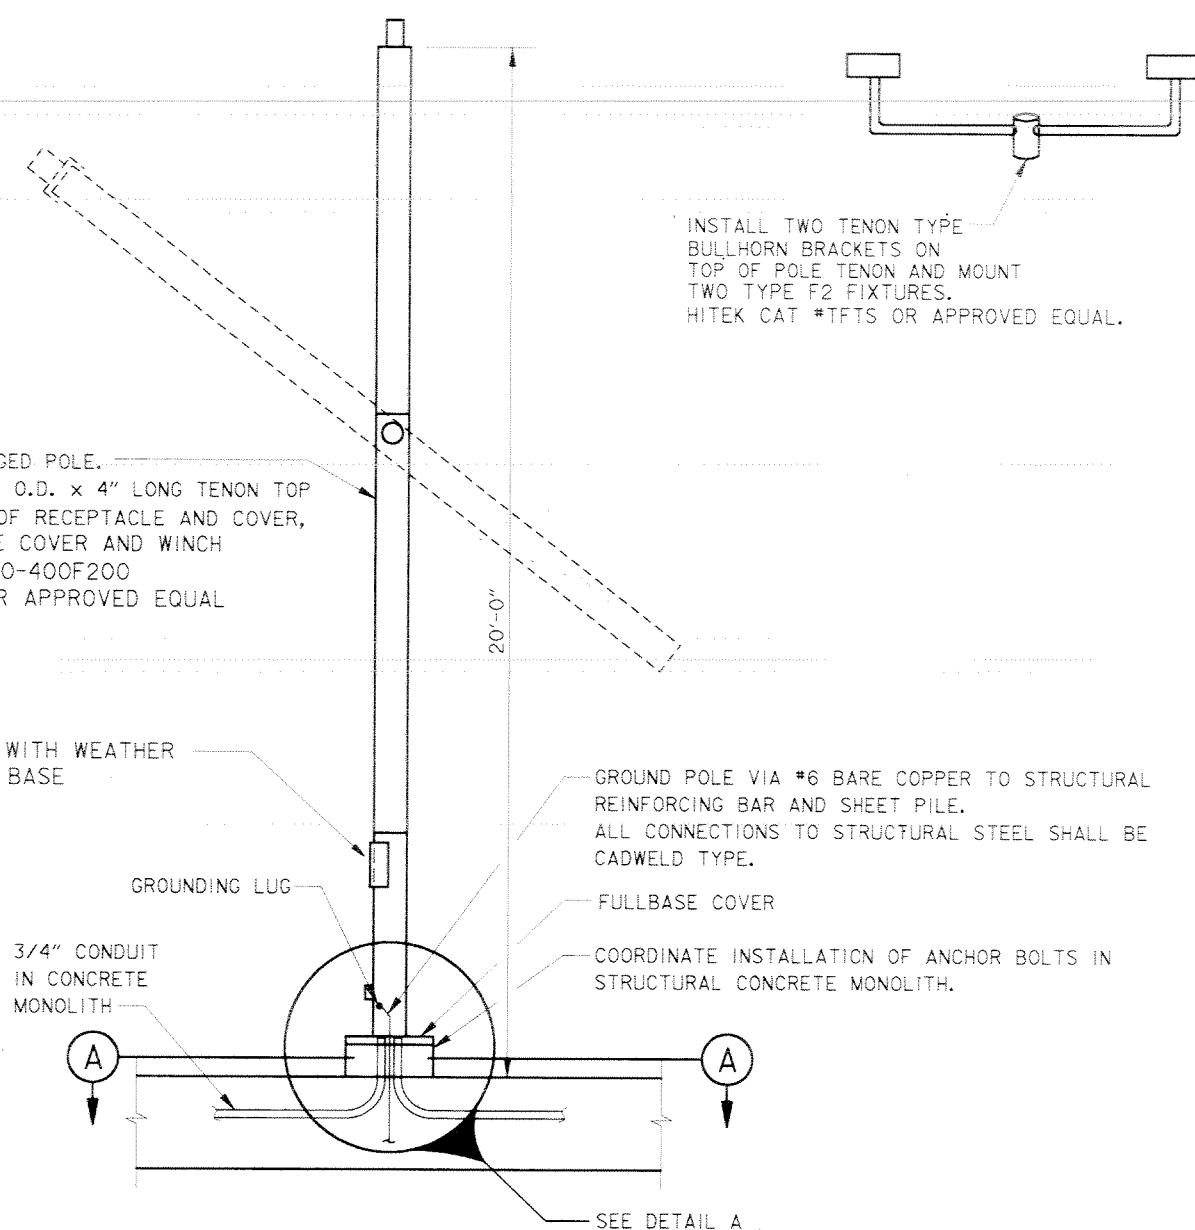

SYMBOL	DESCRIPTION	SYMBOL	DESCRIPTION
O	HID OR INCANDESCENT LIGHT FIXTURE. SEE FIXTURE SCHEDULE.	-	FUSE.
S	SINGLE-POLE TOGGLE SWITCH.	-	NORMALLY OPEN CONTACT.
Φ	DUPLEX OUTLET, 15 AMP, 125V., NEMA 5-15R.	-	NORMALLY CLOSED CONTACT.
Φ _{W.P.}	DUPLEX OUTLET WITH WEATHERPROOF COVER.	-	JUNCTION BOX.
Φ _{G.F.I.}	GROUND FAULT CIRCUIT INTERRUPTER DUPLEX OUTLET.	-	EXTEND EXISTING CONDUIT WITH NEW CONDUIT.
—	GROUND CONNECTION.	-	WIRING (IN CONDUIT) CONCEALED UNDER FLOOR SLAB OR UNDERGROUND.
—	BRANCH CIRCUIT PANELBOARD.	-	WIRING (IN CONDUIT) CONCEALED IN CEILING OR WALL.
—	DISTRIBUTION PANELBOARD.	-	WIRING (IN CONDUIT) RUN EXPOSED.
—	DISCONNECT SWITCH. FUSED UNLESS OTHERWISE NOTED.	-	EXISTING.
—	MAGNETIC MOTOR STARTER. (SUPPLIED UNDER DIVISION 15000)	-	EXISTING TO BE REMOVED.
—	COMBINATION STARTER/DISCONNECT SWITCH FUSED.	-	CIRCUIT TURNED UP.
—	TERMINAL CABINET	-	CIRCUIT TURNED DOWN.
—	HANDHOLE	-	OUTDOOR AERIAL CONDUCTORS.
—	PUSH BUTTON	A	AMP.
—	SELECTOR SWITCH	V	VOLT.
—	TORQUE SWITCH	W	WIRE.
—	PULLBOX OR TROUGH	P	POLE.
—	MOTOR, THREE PHASE. NUMERAL DENOTES HORSEPOWER.	C	CONDUIT ("RSC" INDICATES RIGID STEEL CONDUIT).
—	CIRCUIT BREAKER DEVICE	C/B	GROUND.
—	SWITCH DEVICE.	AFB	CIRCUIT BREAKER.
—		GFI	ABOVE FINISHED FLOOR.
—		NOTE REFERENCE	GROUND FAULT INTERRUPTER.
—			HOMERUN TO PANELBOARD WITH NOMENCLATURE (LETTERS), CIRCUIT NUMBERS (NUMBERS), NUMBER OF PHASE AND NEUTRAL CONDUCTORS WHEN MORE THAN TWO (HASH MARKS), OPPOSITE SLANT DENOTES GROUND, NUMBER OF CIRCUITS (NUMBER OF ARROWS).

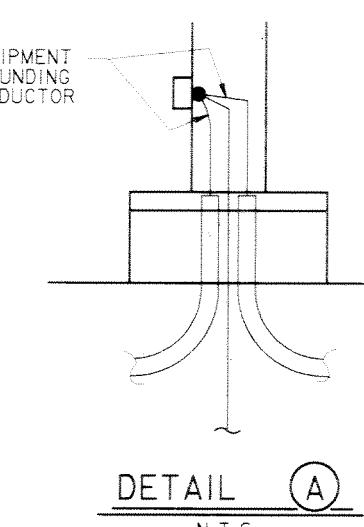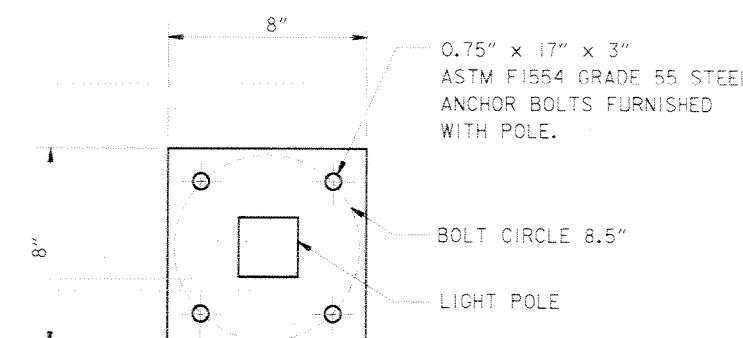


SYMBOL	DESCRIPTION	DATE	APPROVED
REVISIONS			
U.S. ARMY ENGINEER DISTRICT, NEW ORLEANS			
CORPS OF ENGINEERS NEW ORLEANS, LOUISIANA			
LAKE PONTCHARTRAIN, LA. AND VICINITY HIGH LEVEL PLAN NEW ORLEANS LAKEFRONT LEVEE WEST OF I.H.N.C.			
ORLEANS MARINA PHASE V - SLUICE GATES ORLEANS PARISH, LOUISIANA			
SLUICE GATE - ELECTRICAL LIGHT POLE DETAIL			
DESIGNED BY: B.P.C.	DATE: NOV. 1996	PLOT SCALE: 32	PLOT DATE: DEC. 17, 1997
DRAWN BY: C.G.H.	CHECKED BY: S.P.C.	FILE NO. H-4-44778	
CADD FILE: 44778E-1.DGN		SUBMITTED BY: DAN BRADLEY DESIGN ENGINEER	
SOLICITATION NO. DACW29-98-B-0001		DWG. 38 OF 46	

**Safety is a Part
of Your Contract**

CONCRETE PULL BOX NOTES:


- 1. CONCRETE SHALL BE 4000PSI IN 28 DAYS.
- 2. PRECAST STRUCTURE SHALL BE DESIGNED IN ACCORDANCE WITH ASTM C857 AND AASHTO WHERE APPLICABLE.
- 3. REINFORCING DESIGN SHALL MEET OR EXCEED AASHTO HS20-44 BRIDGE LOADING. PULLBOX DETAILS AND DESIGN SHALL BE SUBMITTED FOR APPROVAL.

GALVANIZED CAST-IRON TRAFFIC-RATED BOX WITH CHECKERED COVER SECURED WITH STAINLESS STEEL SCREWS. 24" LONG X 24" WIDE X 5 1/2" HIGH O. Z. MANUFACTURING COMPANY STYLE #Y58E-2424 (TRAFFIC) OR EQUAL COVER. COVER SHALL BE CUSTOM LETTERED TO READ "S&WB POWER", EMBED IN CONCRETE PULLBOX AS SHOWN.

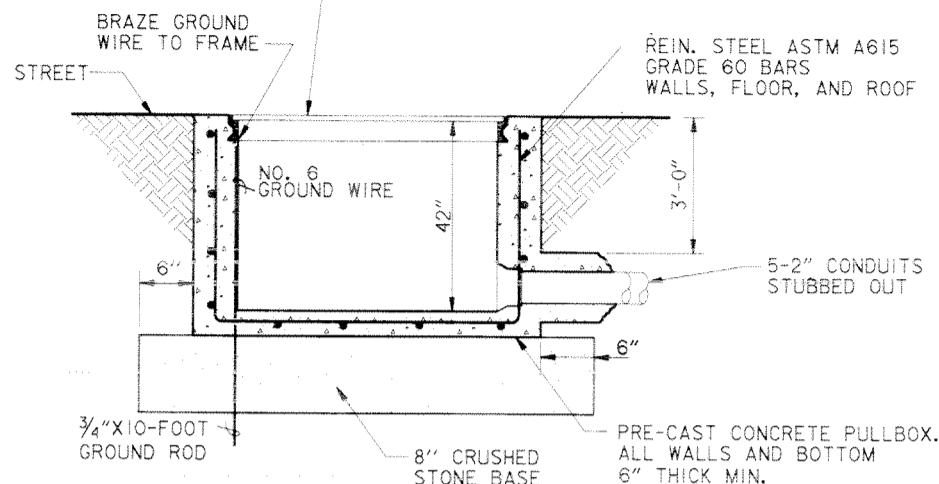

CONCRETE PULLBOX

TRAFFIC RATED
NOT TO SCALE

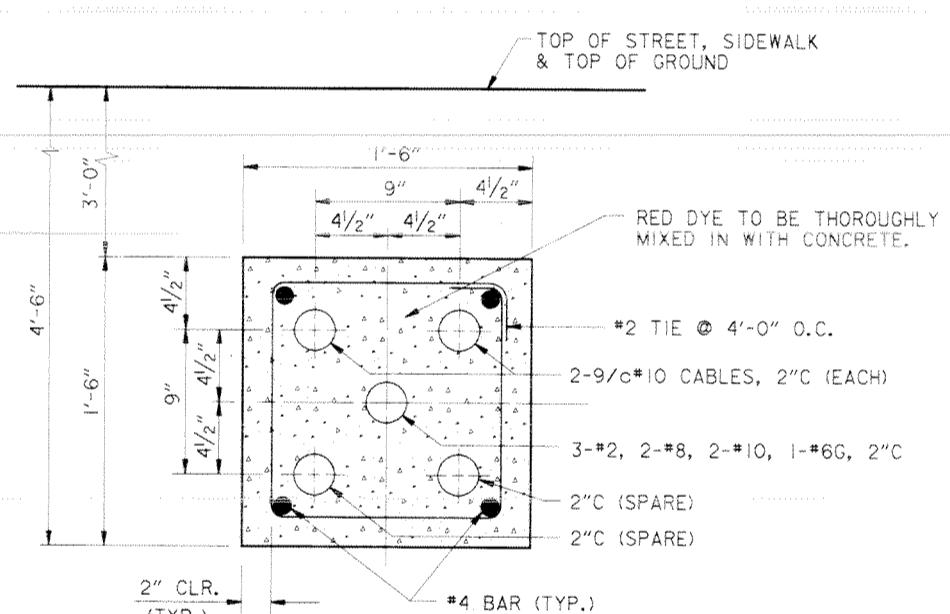

SECTION D

UNDERGROUND DUCT BANK

NOT TO SCALE

GENERAL NOTES:

- ★ 1. AT "AREA OF CONFLICT", EXISTING UTILITIES ARE KNOWN TO EXIST. THEIR EXACT LOCATION, SIZE AND DEPTHS MUST BE DETERMINED IN THE FIELD BY THE CONTRACTOR. IT IS THE RESPONSIBILITY OF THE CONTRACTOR TO LOCATE AND AVOID THESE LINES. THE CONTRACTOR SHALL BE LIABLE FOR ANY DAMAGES CAUSED BY FAILURE TO COMPLY WITH THESE INSTRUCTIONS. THE CONTRACTOR SHALL INSTALL UNDERGROUND ELECTRICAL DUCT TO AVOID CONFLICTS WITH WATER AND DRAIN LINES AT NO ADDITIONAL COST TO THE GOVERNMENT.
- 2. FOR STREET WORK PERMITTING, CONTRACTOR IS TO CONTACT THE NEW ORLEANS DEPARTMENT OF PUBLIC WORKS 72 HOURS BEFORE STARTING CONSTRUCTION. THE CONTRACTOR SHALL NOTIFY THE SEWERAGE AND WATER BOARD (P.O.C. MR. GARY SARRAT (504) 865-0452) 72 HOURS PRIOR TO STARTING CONSTRUCTION.
- 3. THE P.O.C. FOR "RUSSEL'S MARINA GRILL" IS: MR. PAUL PETROU 8555 PONTCHARTRAIN BLVD. NEW ORLEANS, LA. 70124 504-282-9980
- 4. SEE SPECIFICATIONS FOR TRAFFIC CONTROL REQUIREMENTS DURING CONSTRUCTION OF UNDERGROUND DUCT BANK ACROSS LAKE MARINA AVE. AND ALONG PONTCHARTRAIN BLVD.
- 5. FOR MISCELLANEOUS DETAILS, SEE DWG. 44.



- 1. CONCRETE SHALL BE 4000PSI IN 28 DAYS.
- 2. PRECAST STRUCTURE SHALL BE DESIGNED IN ACCORDANCE WITH ASTM C857 AND AASHTO WHERE APPLICABLE.
- 3. REINFORCING DESIGN SHALL MEET OR EXCEED AASHTO HS20-44 BRIDGE LOADING. PULLBOX DETAILS AND DESIGN SHALL BE SUBMITTED FOR APPROVAL.

NEW 24"x24"x6"
NEMA 4 PULLBOX
ATTACHED TO I-WALL
5'-0" FROM END OF WALL

NEW TYPE "A" CONCRETE
HANDICAP RAMP, FOR
DETAILS, SEE DWG. 44.

LAKE MARINA AVE

TWO TELEPHONE LINES EXIST IN THIS AREA.
A 2" LINE BURIED APPROXIMATELY 2' BELOW
THE SURFACE AND A 4" LINE APPROXIMATELY
4' DEEP (ONE BELOW THE OTHER).

NEW TYPE "B" CONCRETE
HANDICAP RAMP, FOR
DETAILS, SEE DWG. 44.

TRAFFIC RATED PULL-BOX (SEE DETAIL).
EXACT LOCATION DEPENDENT UPON
LOCATION OF EXISTING TELEPHONE
AND GAS LINES. LOCATION TO BE
DETERMINED BY FIELD ENGINEER.

**"WINDJAMMER"
RESTAURANT/
BREAKWATER
BISTRO**

2' C DIMENSION DETERMINED AT CONSTRUCTION
JOINT OF PARKING LOT AND EXISTING STREET.
(CURBING IS NOT WELL DEFINED AT MAJORITY
OF OTHER LOCATIONS ALONG PROJECT.)

REPLACE ANY EXISTING CONCRETE
IN STREET REMOVED DURING
CONSTRUCTION WITH ASPHALT.

**"WEST END CAFE"
RESTAURANT**

TRAFFIC RATED
PULL-BOX
(SEE DETAIL)

**"MIDNIGHT STAR CAFE"
RESTAURANT**

LEGEND:
★ = AREA OF CONFLICT

**NEW BASIN
CANAL**

EXISTING
FLOODWALL
(I-WALL)

TEMPORARY
COFFERDAM

SLUICE
GATES

STA. 18+08

98.30

101'58"50.01"

102'0"15.1"

33.78

46'46"39.42"

8' SIDEWALK

12'9"19.31"

485.28

98'59"79.98"

BASELINE

LAKESHORE DR.

SCALE: 1"=20'

POINTS OF CONTACT

ENERGY

GAS:
MR. WAYNE BURLETT
(504) 595-3584

UNDERGROUND ELECTRICAL:
MR. DAVE COOK
(504) 595-5889

BELL SOUTH

TELEPHONE LINES:
MS. TREMEDA HARRIS
(504) 253-7318

**SEWERAGE & WATER BOARD
OF NEW ORLEANS**

WATER, SEWERAGE & DRAINAGE:
MR. LARRY MCKEE
(504) 865-2264

ELECTRICAL:

MR. GARY SARRAT
(504) 865-0450

**CITY OF NEW ORLEANS,
DEPARTMENT OF STREETS**

MR. WILLIAM SEWELL
MR. ELMER DARWIN
(504) 565-6844

NETWORKS

CITY STREET LIGHTS:
MR. EDWARD ARNOLD
(504) 565-6260

NOTE:

1. THE LOCATION OF THE UTILITIES CALLED OUT
ON THIS DRAWING ARE BASED ON TWO SOURCES:
- SEWERAGE AND WATER BOARD MAPS AND
- AS-BUILT DRAWINGS OF THE PUMPING STATION.
- VISUAL OBSERVATION UPON SITE INSPECTIONS.


2. THE S&WB SERVITUDE IS BASED ON THE SEWERAGE
AND WATER BOARD DWG. NO. D-3630 (DATE 4-17-61).
THE LEGAL DESCRIPTION OF THIS SERVITUDE WAS ALSO
USED.

EXISTING GRATES TO BE REMOVED
DURING CONSTRUCTION AND
REPLACED UPON COMPLETION.
COST TO BE INCLUDED IN
DEMOLITION COSTS.

FOR DETAILS OF
AREA, SEE DWG. 44

SCALE: 1" = 20'

20' 0 20' 40' 60' 80'

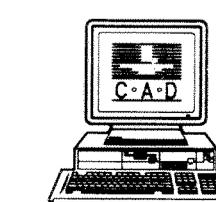

SYMBOL	REVISED PULL BOX AND DUCT BANK DETAILS; CHANGED DUCT BANK LOCATION, AMEND #0003	1/23/98	CAL
DESCRIPTION	REVISIONS	DATE	APPROVED

U.S. ARMY ENGINEER DISTRICT, NEW ORLEANS
CORPS OF ENGINEERS
NEW ORLEANS, LOUISIANA

LAKE PONTCHARTRAIN, LA. AND VICINITY
HIGH LEVEL PLAN


NEW ORLEANS LAKEFRONT LEVEE
WEST OF I.H.N.C.

ORLEANS MARINA PHASE V - SLUICE GATES


ORLEANS PARISH, LOUISIANA

**SLUICE GATE - ELECTRICAL
SITE PLAN**

DESIGNED BY: C.G.H.	DRAWN BY: C.G.H.	PLOT SCALE: 20	PLOT DATE: MAR. 6, 1998
DRAWN BY: C.G.H.	CHECKED BY: S.P.C.		
CADD FILE: 44778E-2.DGN			FILE NO. H-4-44778
SUBMITTED BY: DAN BRADLEY DESIGN ENGINEER	SOLICITATION NO.: DACW29-98-B-0001		DWG. 39 OF 46

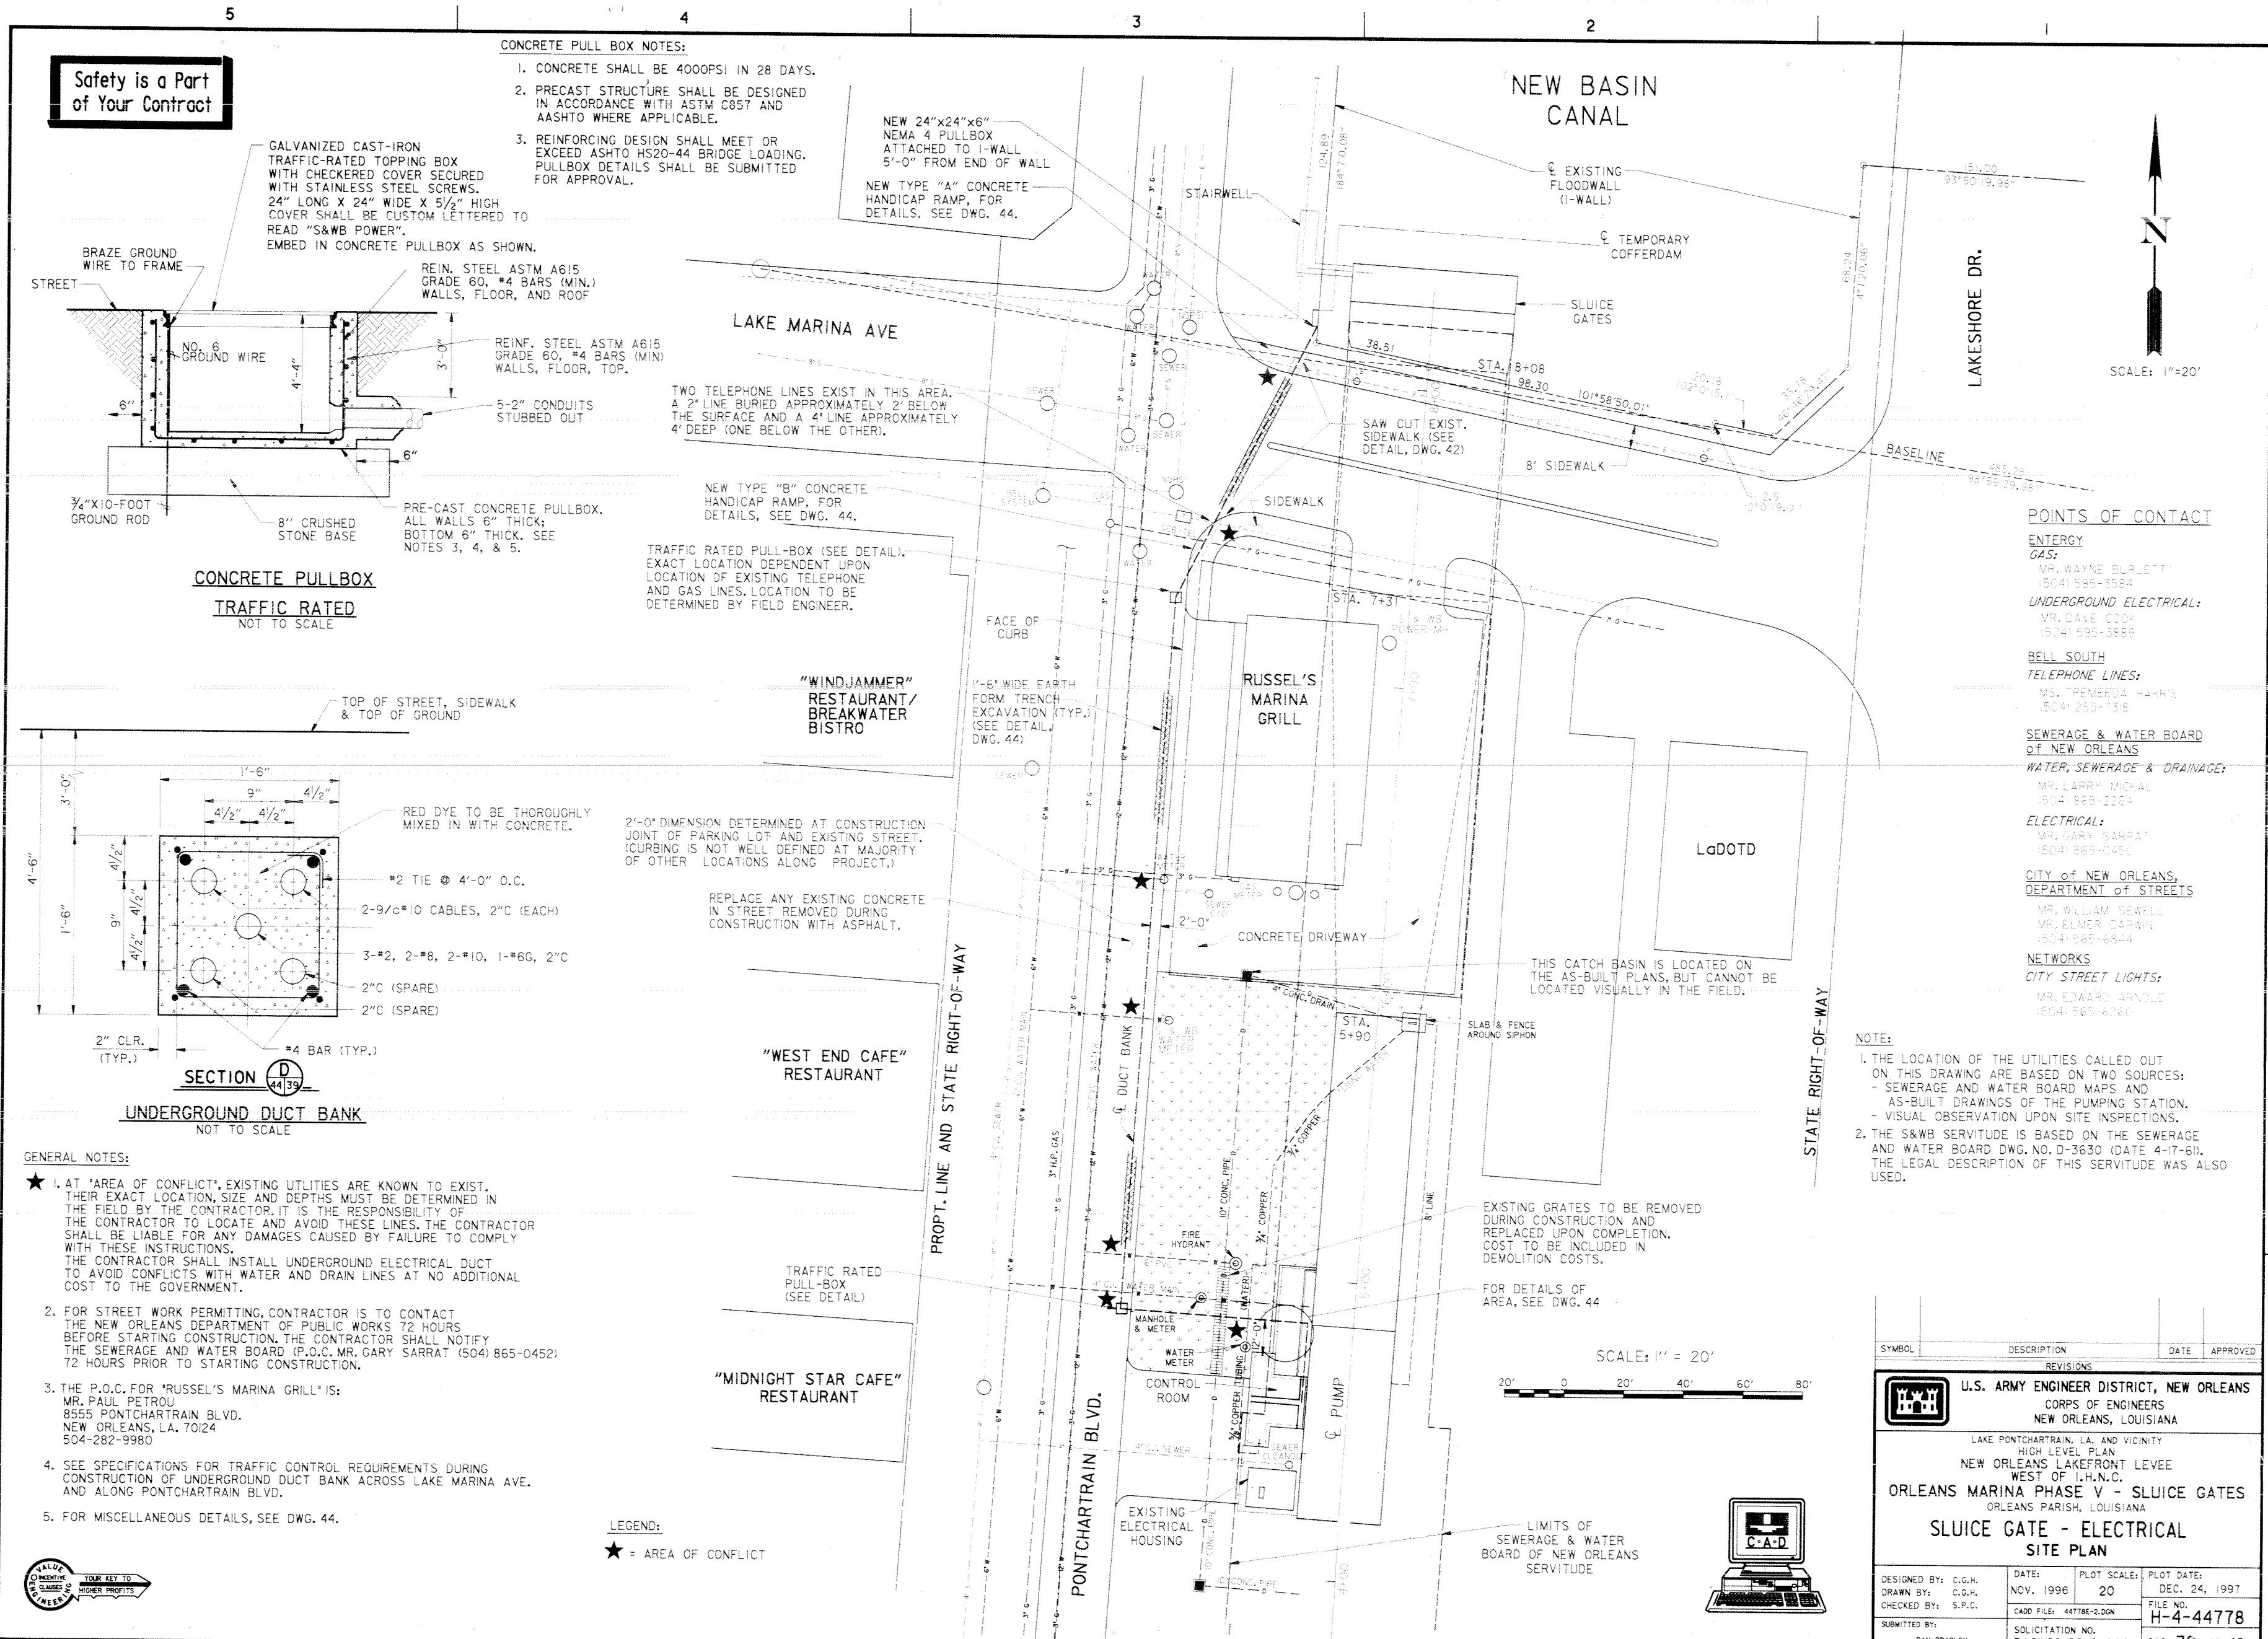

Safety is a Part
of Your Contract

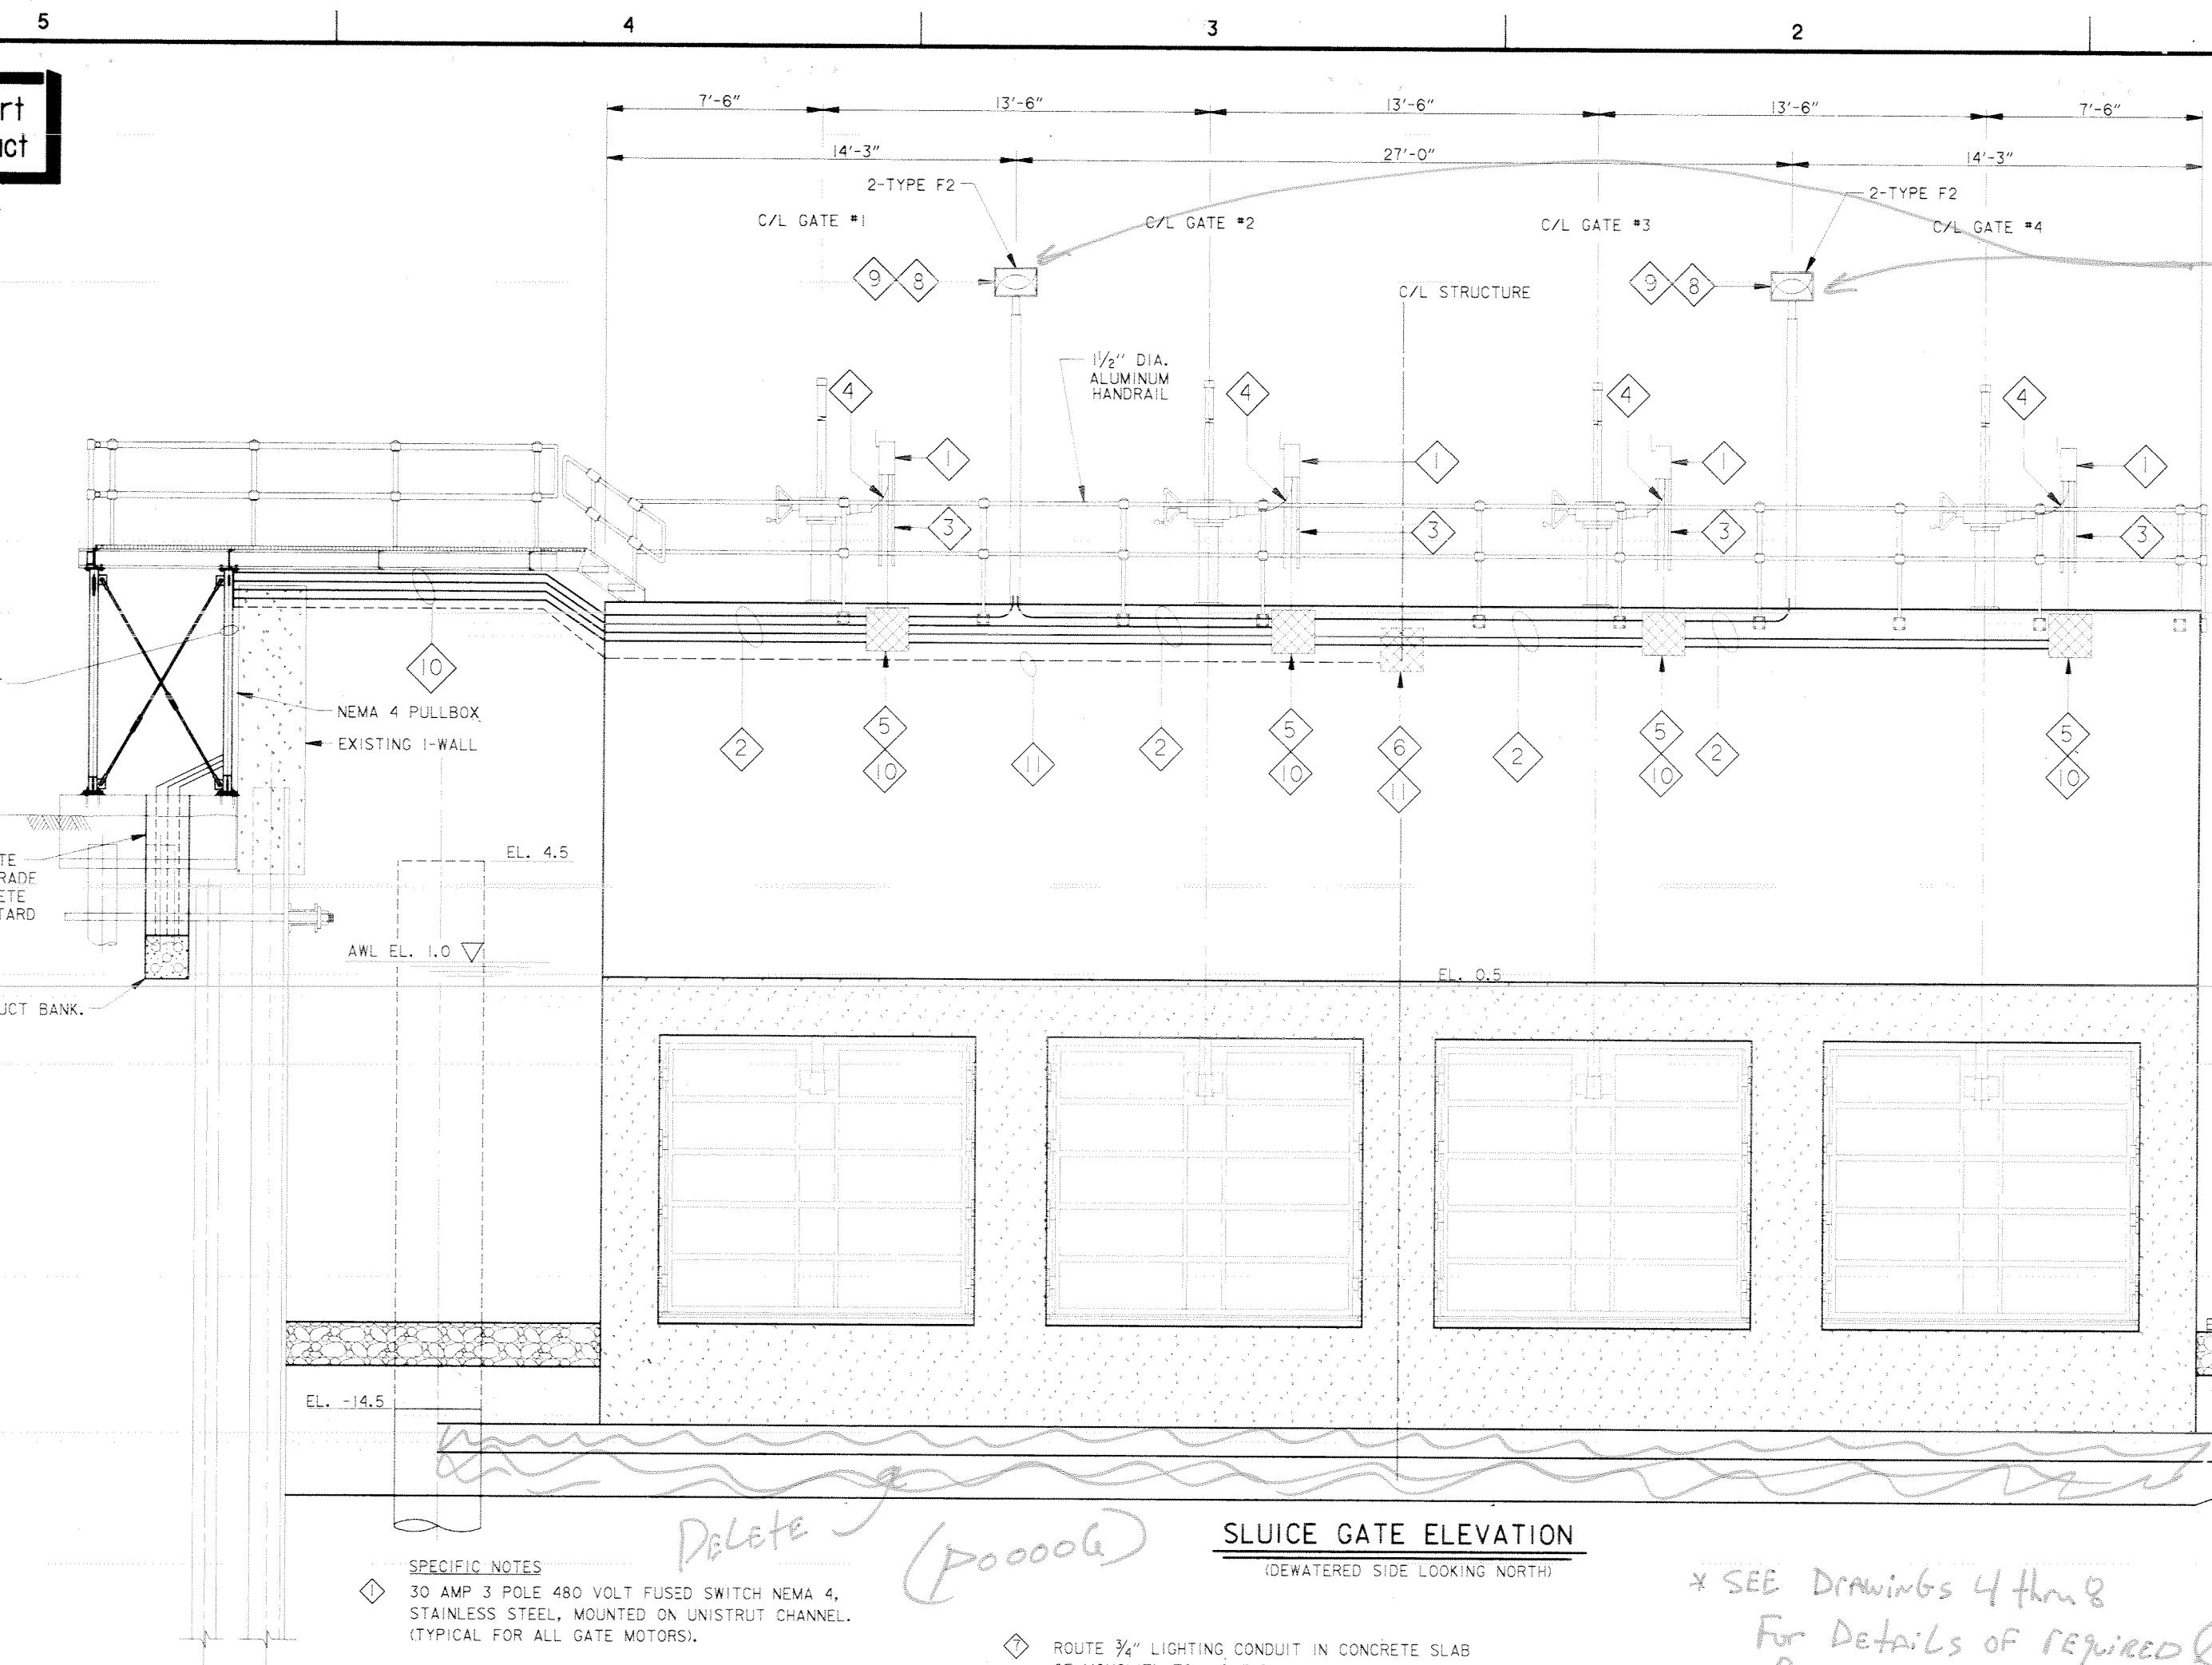


- SPECIFIC NOTES**
- ① 30 AMP 3 POLE 480 VOLT FUSED SWITCH NEMA 4, STAINLESS STEEL, MOUNTED ON UNISTRUT CHANNEL. (TYPICAL FOR ALL GATE MOTORS).
 - ② ROUTE POWER, LIGHTING, AND CONTROL CONDUITS EXPOSED ALONG PROTECTED (SOUTH) SIDE OF MONOLITH. ATTACH ALUMINUM UNISTRUT TO MONOLITH ISOLATED BY $\frac{1}{8}$ " NEOPRENE RUBBER AND STRAP CONDUITS TO ALUMINUM UNISTRUT.
 - ③ ALUMINUM UNISTRUT CHANNEL WELDED TO REAR OF HANDRAIL BAR.
 - ④ USE LIQUIDTIGHT FLEXIBLE CONDUIT BETWEEN FUSED SWITCH AND GATE CONTROLLER. ROUTE THROUGH WALL AND UNDER GRATING UP TO MOTOR.
 - ⑤ NEMA 4 FABRICATED ALUMINUM 24" X 24" X 6" PULLBOX WITH SCREW REMOVABLE AND GASKETED COVER MOUNTED TO CONCRETE ON SOUTH WALL WITH $\frac{1}{8}$ " NEOPRENE RUBBER GASKETS BETWEEN PULLBOX AND CONCRETE.
 - ⑥ NEMA 4 FABRICATED ALUMINUM 24" X 24" X 6" PULLBOX WITH SCREW REMOVABLE AND GASKETED COVER MOUNTED TO CONCRETE ON NORTH WALL WITH $\frac{1}{8}$ " NEOPRENE RUBBER GASKETS BETWEEN PULLBOX AND CONCRETE.

SLUICE GATE ELEVATION
(DEWATERED SIDE LOOKING NORTH)

- ⑦ ROUTE $\frac{3}{4}$ " LIGHTING CONDUIT IN CONCRETE SLAB OF MONOLITH TO LIGHT POLE. SEE LIGHT POLE DETAIL DWG. 38.
- ⑧ NOTE, ONE FIXTURE SHALL BE AIMED SOUTH AND ONE FIXTURE AIMED NORTH. ADJUST AT NIGHT FOR BEST LIGHTING. SEE DWG. 34 FOR FIXTURE SCHEDULE. *AMEND 003*
- ⑨ THESE LIGHT FIXTURES SHALL BE FED BY NEW 20 AMP, 2 POLE, C/B IN PANEL LP. SEE DWG. 42.
- ⑩ MOUNT ALUMINUM UNISTRUT TO SOUTH WALL ISOLATED FROM CONCRETE WITH $\frac{1}{8}$ " NEOPRENE RUBBER, USE TO SUPPORT CONDUITS AND PULLBOXES.
- ⑪ 2" SPARE CONDUIT RUN ALONG NORTH WALL FROM PULLBOX UNDER STAIRWELL TO A 24" X 24" X 6" PULLBOX MOUNTED TO NORTH WALL. MOUNT AS HIGH AS PRACTICAL ON WALL.

* SEE Drawings 4 thru 8
For Details of required (Pooooo6)
BEDDING + RIPRAP.

SCALE: $\frac{3}{8}$ " = 1'- 0"
12' 0" 2' 4' 6' 8' 10'

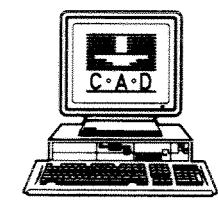


SYMBOL	DESCRIPTION	DATE	APPROVED	REVISIONS
	U.S. ARMY ENGINEER DISTRICT, NEW ORLEANS CORPS OF ENGINEERS NEW ORLEANS, LOUISIANA			

LAKE PONTCHARTRAIN, LA. AND VICINITY
HIGH LEVEL PLAN
NEW ORLEANS LAKEFRONT LEVEE
WEST OF I.H.N.C.
ORLEANS MARINA PHASE V - SLUICE GATES
ORLEANS PARISH, LOUISIANA

SLUICE GATE - ELECTRICAL SECTIONAL ELEVATION

DESIGNED BY: B.P.C.	DATE: NOV. 1996	PLOT SCALE: 32	PLOT DATE: DEC. 17, 1997
DRAWN BY: C.G.H.	CHECKED BY: S.P.C.	FILE NO. H-4-44778	
CADD FILE: 44778-3.DGN		SUBMITTED BY: DAN BRADLEY	
SOLICITATION NO. DACW29-98-B-0001		DWG. 40 OF 48	

Safety is a Part
of Your Contract

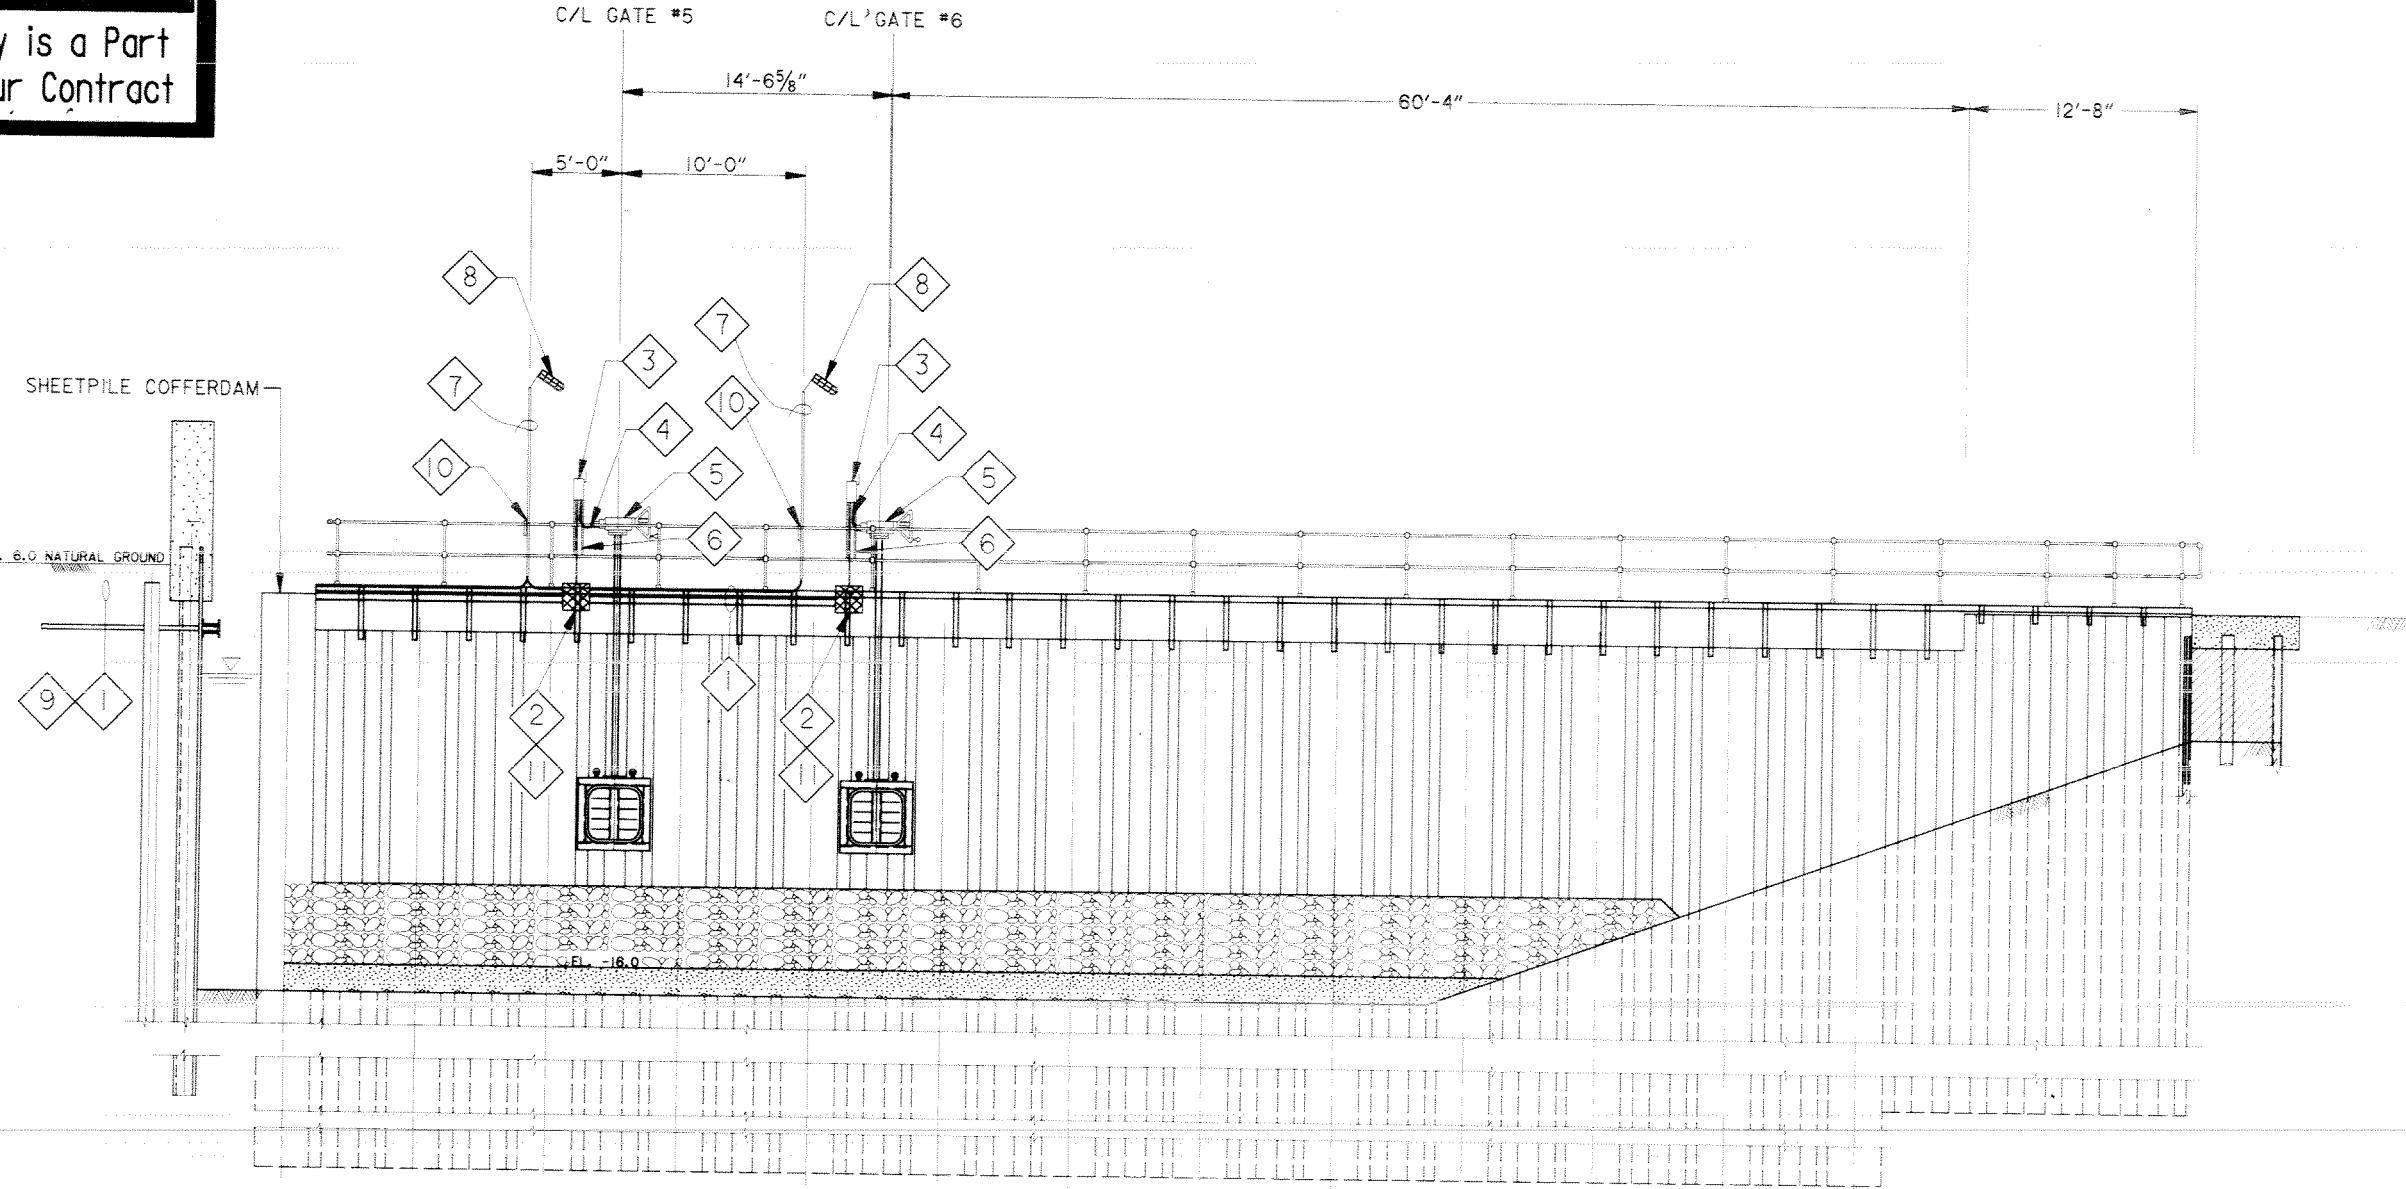

SPECIFIC NOTES

- ① ROUTE ONE 2" CONDUIT FOR POWER FOR GATE MOTORS, ONE 2" CONDUIT FOR GATE CONTROL AND ONE 3/4" CONDUIT FOR LIGHTING AND RECEPTACLES EXPOSED ALONG PROTECTED SIDE OF COFFERDAM TO UNDERGROUND DUCT BANK.
- ② 18"x18"x6" NEMA 4 JUNCTION BOX USED TO TAP POWER FEEDER CONDUCTORS.
- ③ 30 AMP 3 POLE 480 VOLT NEMA 4, FUSED SWITCH MOUNTED TO UNISTRUT SUPPORTS FOR GATE MOTOR.
- ④ USE FLEXIBLE LIQUIDTIGHT CONDUIT BETWEEN FUSED SWITCH AND GATE MOTOR CONTROLLER. ROUTE CLEAR OF HANDWHEEL.
- ⑤ BUTTERFLY GATE MOTOR CONTROLLER.
- ⑥ ALUMINUM UNISTRUT CHANNEL WELDED TO REAR OF HANDRAIL BAR.
- ⑦ 1/4" CONDUIT ATTACHED TO UPPER AND LOWER HANDRAIL USED TO SUPPORT 1/4" STANCHION MOUNT LIGHT FIXTURE.
- ⑧ LIGHT FIXTURE TYPE FI, SEE FIXTURE SCHEDULE, DWG. 36
- ⑨ WELD UNISTRUT SUPPORT TO TOP OF SHEET PILING TO SUPPORT CONDUITS.
- ⑩ GFI WEATHER PROOF DUPLEX OUTLET IN CAST ALUMINUM WEATHER PROOF BOX INSTALLED ON 1/4" STANCHION (18" A.F.F.)
- ⑪ WELD UNISTRUT TO BOTTOM OF WALKWAY AND WALKWAY SUPPORTS. USE TO SUPPORT CONDUITS AND PULLBOXES. CONDUITS AND PULLBOXES SHALL BE LOCATED SO AS NOT TO INTERFERE WITH THE OPERATION OF THE FLAP GATES, SEE DWG. 6.


GENERAL NOTES:

- ALL DEVICES SPECIFIED IN SPECIFIC NOTES NO. ① THROUGH ⑪ INCLUDING PULL BOXES, WIRING, LIGHTING, DISCONNECTS AND CONDUITS ARE FOR USE ON TEMPORARY COFFERDAM ONLY AND SHALL NOT BE USED IN PERMANENT SLUICE GATE STRUCTURE.
- SEE DWGS 4 THRU 6 FOR DETAILS OF THE COFFERDAM SHEETING, WALKWAY, FLAP GATES, AND WEIR.

PROTECTED SIDE

TYPICAL COFFERDAM ELEVATION

SCALE: 3/16" = 1'- 0"

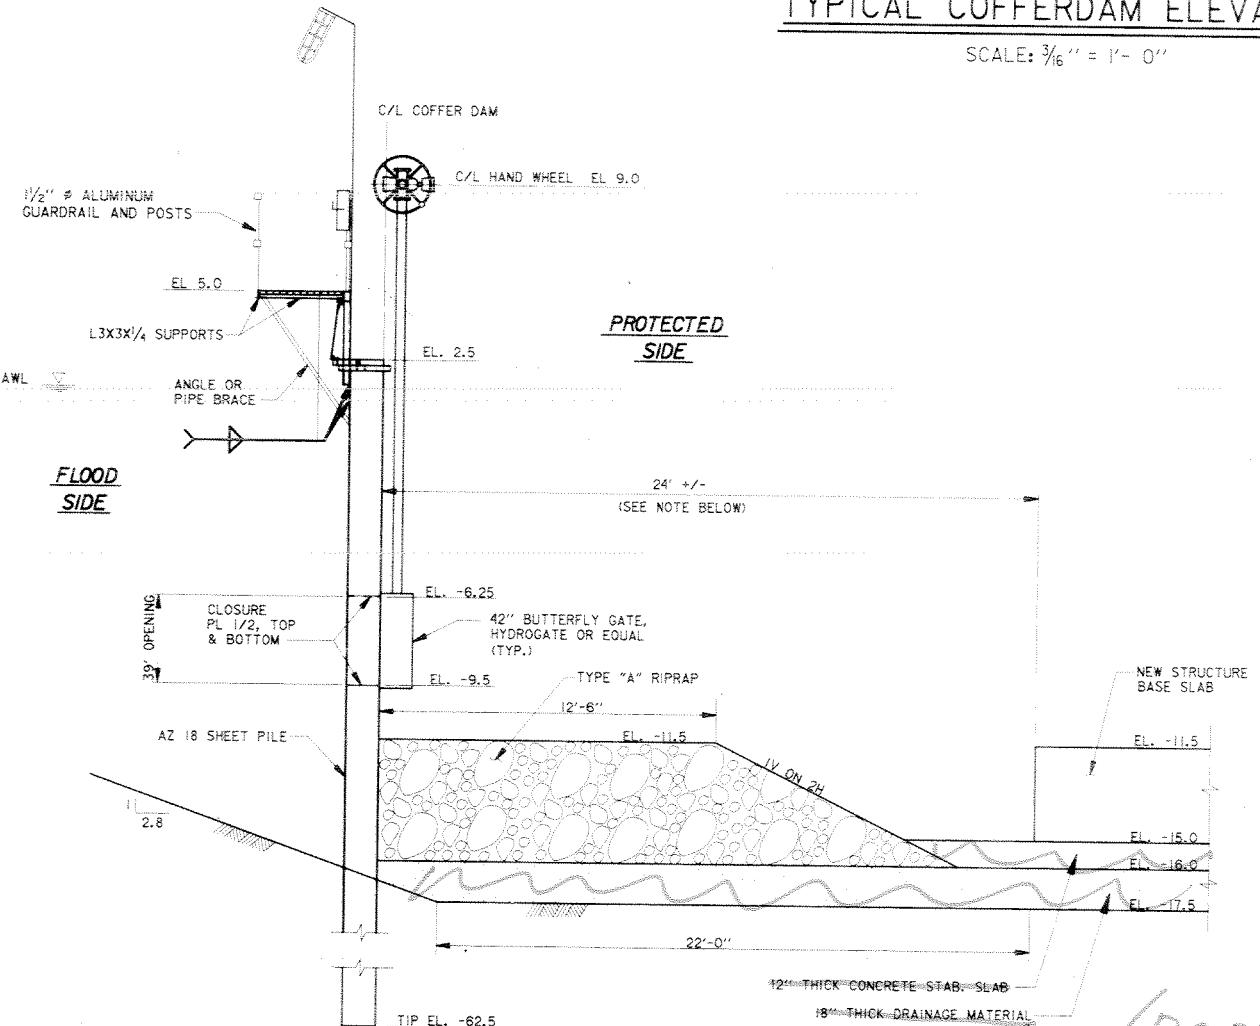

* SEE Drawing 4-B For
the REQUIRED BEDDING
+ Riprap.
(P00006)

SCALE: 3/16" = 1'- 0"

SCALE: 1/4" = 1'- 0"

12' 0" 5' 10' 15' 20'

12' 0" 5' 10' 15' 20'

SCALE: 1/4" = 1'- 0"

12' 0" 5' 10' 15' 20'

12' 0" 5' 10' 15' 20'


12' 0" 5' 10' 15' 20'

12' 0" 5' 10' 15' 20'

12' 0" 5' 10' 15' 20'

12' 0" 5' 10' 15' 20'

12' 0" 5

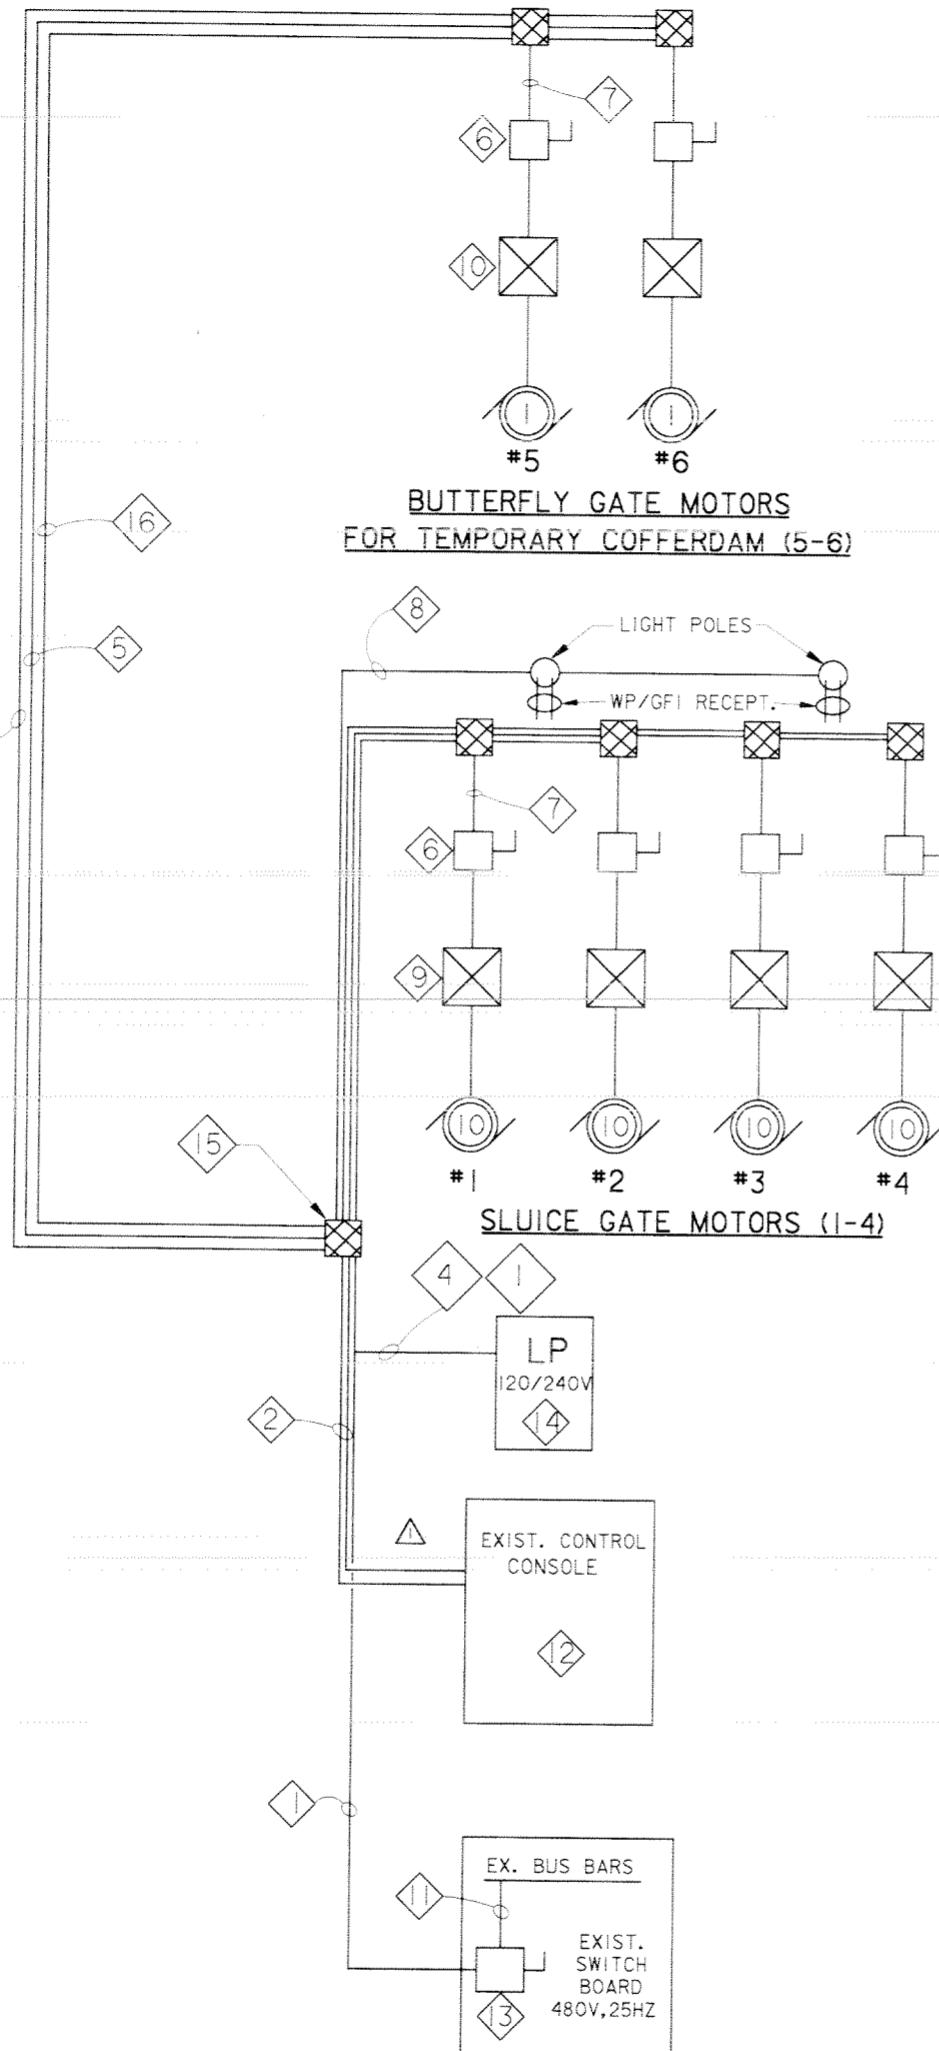


ELECTRICAL ONE LINE DIAGRAM



ROUTING OF CONDUIT FROM
SWITCHBOARD TO CABLE TROUGH

FOR PLAN LAYOUT, SEE DWG. 44
SCALE: N.T.S.

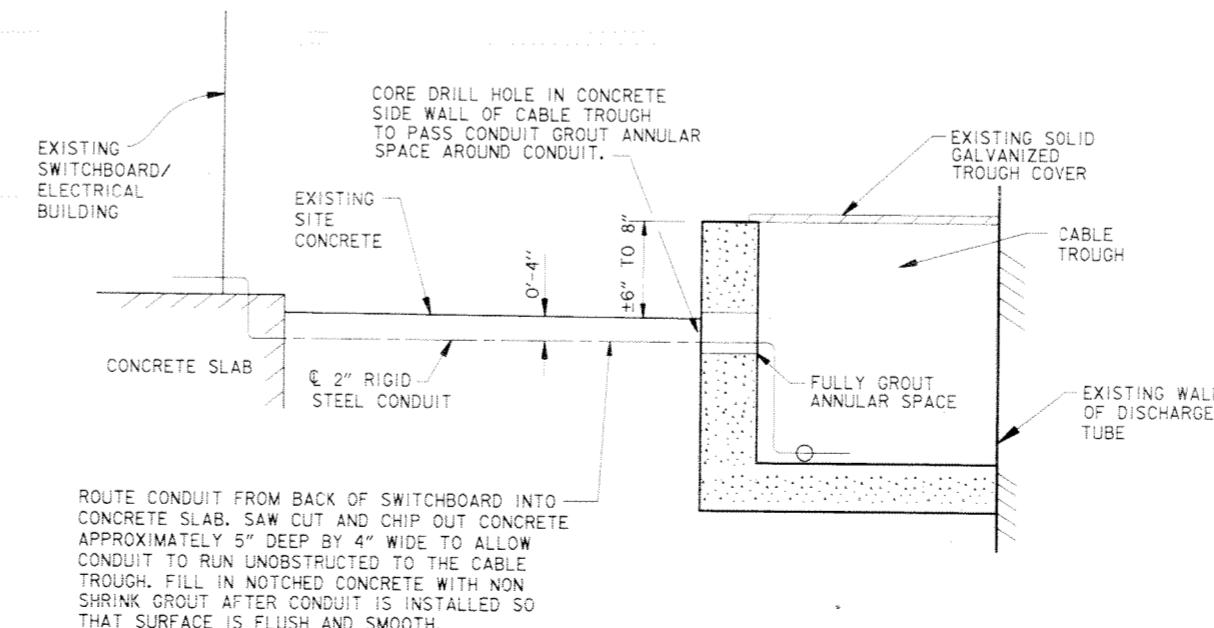

ROUTING OF CONDUIT FROM
SWITCHBOARD TO CABLE TROUGH

FOR PLAN LAYOUT, SEE DWG. 44
SCALE: N.T.S.




SPECIFIC NOTES:

- 1. FROM NEW 100 AMP FUSIBLE SWITCH IN SWITCHBOARD ROUTE 3 #2, 1 #6GD IN 2" CONDUIT. FROM PANEL LP, RUN LIGHTING AND RECEPTACLE WIRING OUT TO TROUGH IN 1" CONDUIT. USE 1" TEE IN TROUGH TO RUN LIGHTING & RECEPT. CIRCUITS IN 2" GATE POWER CONDUIT TO PULLBOX. SEE NOTE 15.. SEE DWG. #41 FOR CONDUIT ROUTING.
- 2. FROM CONTROL CONSOLE #3 IN CONTROL HOUSE, ROUTE FOUR 9/C #10 TYPE TC CONTROL CABLES (HOUSTON WIRE AND CABLE NO. D040100900 OR APPROVED EQUAL) IN CABLE TROUGH. TRANSITION TO TWO 2" CONDUITS EACH CONTAINING TWO CONTROL CABLES IN DUCT BANK. ROUTE ONE CONTROL CABLE TO EACH GATE CONTROLLER.
- 3. 3 #2, 1 #6GD IN 2" CONDUIT OUT TO BUTTERFLY GATE MOTORS.
- 4. ROUTE FROM NEW 20 AMP, 2 POLE, C/B IN 120/240V, EXIST. PANEL "LP" 2 #10, OUT TO LIGHTING POLES ON MONOLITH. ROUTE FROM 20 AMP, 1 POLE C/B IN PANEL LP 2 #8 (1 HOT AND 1 NEUTRAL) OUT TO MONOLITH AND COFFERDAM RECEPTACLES AND LIGHTS IN SAME 2" C WITH GATE MOTOR POWER. THE LIGHTS SHALL BE CONTROLLED THRU THE NEW CIRCUIT BREAKER. EXISTING PANEL IS A SQUARE D PANEL WITH 20 CIRCUITS AND NO SPARE BREAKERS. CREATE THREE NEW CIRCUITS (ONE FOR 20A, 1 POLE RECEPTACLE CIRCUIT AND TWO FOR 20A, 2 POLE LIGHTING CIRCUIT) BY REPLACING THREE EXISTING 20A, 1 POLE CIRCUIT BREAKERS WITH THREE NEW DUAL TANDEM 20A-20A (SQUARE D TYPE QOT) RE-CONNECT SIX EXISTING 20A CIRCUITS TO THREE NEW TANDEM BREAKERS TO CREATE THREE SPARE SPACES. REVISE PANEL DIRECTORY.
- 5. 3 #10, 1 #10GD IN 3/4" CONDUIT OUT TO LIGHTS AND RECEPTACLES AT COFFERDAM.
- 6. 60 AMP 3 POLE 480 VOLT NEMA 4 STAINLESS STEEL FUSED SWITCH (TYPICAL OF SLUICE AND BUTTERFLY GATES).
- 7. 3 #8, 1 #12GD FOR GATE POWER AND 9/C #14 TYPE TC CONTROL CABLE IN 1" RIGID ALUMINUM CONDUIT. TYPICAL FOR SLUICE GATES (I-4) AND BUTTERFLY GATES (5&6) MOTORS. FINAL CONNECTION TO MOTORS SHALL BE LIQUIDTIGHT CONDUIT.
- 8. CONDUIT FOR LIGHTS & RECEPTACLES SHALL BE ROUTED IN CONCRETE SLAB OF MONOLITH TO LIGHT POLES. 2 #8, 2 #10, 1 #10G, 1 #C.
- 9. SLUICE GATE MOTOR CONTROLLER (TYPICAL FOR SLUICE GATES I-4), (SEE SPECIFICATIONS).
- 10. BUTTERFLY GATE MOTOR CONTROLLER (TYPICAL FOR BUTTERFLY GATES 5 & 6). (SEE SPECIFICATIONS).
- 11. 3#2, 1#6 GND.

DELETE ALL REFERENCE
to the local [REMOVED]
(P00007)
(A00002)

SYMBOL	REVISED NOTES AND ADDED CONDUIT DETAIL, AMEND #0003	DESCRIPTION	DATE	APPROVED
REVISIONS				
U.S. ARMY ENGINEER DISTRICT, NEW ORLEANS CORPS OF ENGINEERS NEW ORLEANS, LOUISIANA				
LAKE PONTCHARTRAIN, LA. AND VICINITY HIGH LEVEL PLAN NEW ORLEANS LAKEFRONT LEVEE WEST OF I.H.N.C. ORLEANS MARINA PHASE V - SLUICE GATES ORLEANS PARISH, LOUISIANA				
SLUICE GATE - ELECTRICAL ONE LINE DIAGRAM				
DESIGNED BY:	B.P.C.	DATE:	MAR. 6, 1998	PLOT SCALE: 32
DRAWN BY:	C.G.H.	PLOT DATE:	NOV. 1996	FILE NO. H-4-44778
CHECKED BY:	B.P.C.	CADD FILE:	44778E-5.DDN	
SUBMITTED BY:	DAN BRADLEY DESIGN ENGINEER	SOLICITATION NO.	DACW29-98-B-0001	
DWG. 42 OF 46				


Safety is a Part of Your Contract

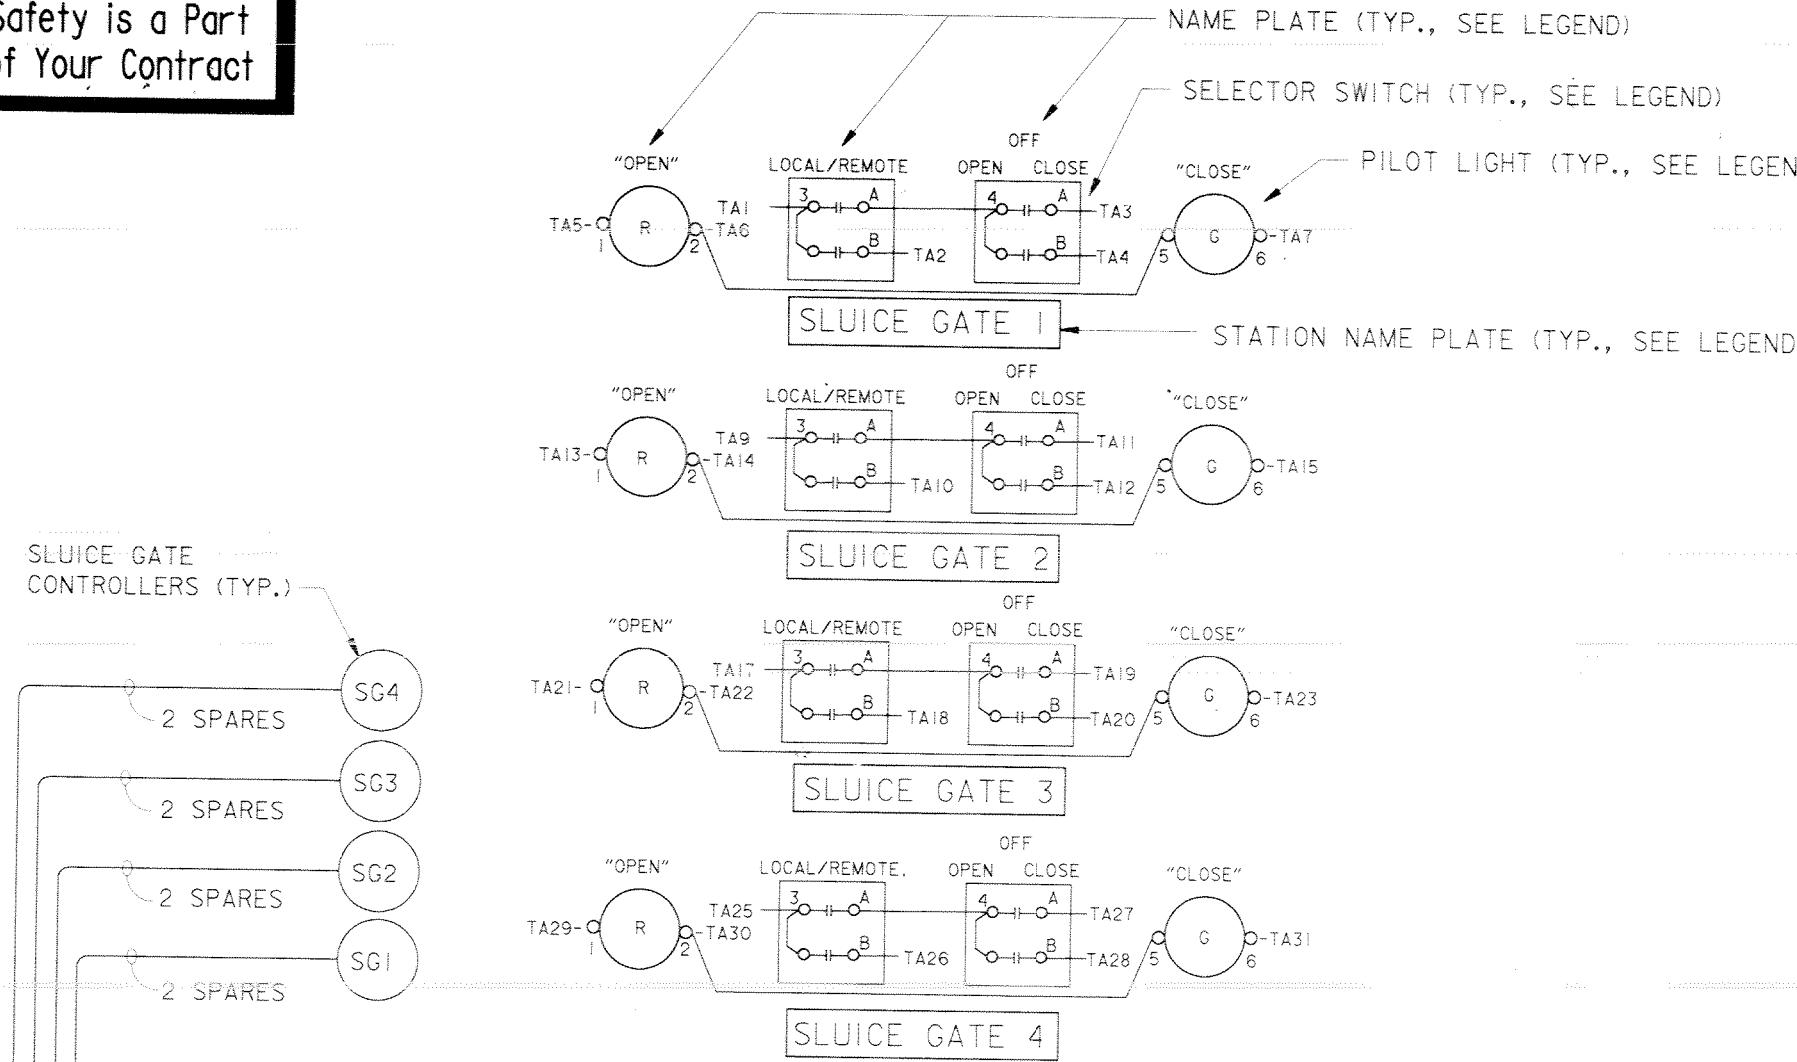


CONSOLE GATE CONTROL WIRING DIAGRAM

RD2	1	CLI	A
RD7	2	LI	A
BLU3	3	OPN	A
BLKI	4	CLS	A
OR4	5	OPL	A
YEL5	6	COM	A
BRN6	7	CPL	A
	8		
RD2	9	CLI	A2
RD7	10	LI	A2
BLU3	11	OPN	A2
BLKI	12	CLS	A2
OR4	13	OPL	A2
YEL5	14	COM	A2
BRN6	15	CPL	A2
	16		
RD2	17	CLI	A3
RD7	18	LI	A3
BLU3	19	OPN	A3
BLKI	20	CLS	A3
OR4	21	OPL	A3
YEL5	22	COM	A3
BRN6	23	CPL	A3
	24		
RD2	25	CLI	A4
RD7	26	LI	A4
BLU3	27	OPN	A4
BLKI	28	CLS	A4
OR4	29	OPL	A4
YEL5	30	COM	A4
BRN6	31	CPL	A4
	32		
	33		
	34		
	35		
	36		

TERMINAL STRIP CONNECTIONS

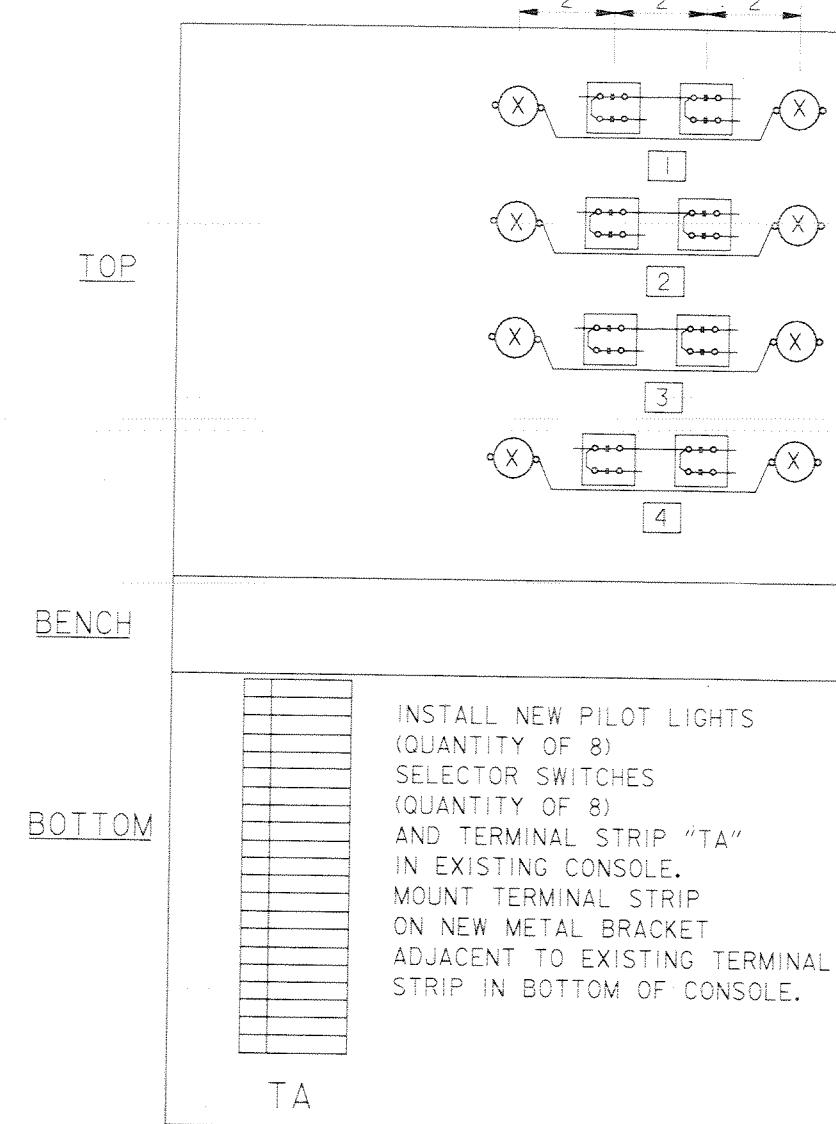

RIGHT SECTION (NO. 3) OF
EXISTING CONTROL CONSOLE

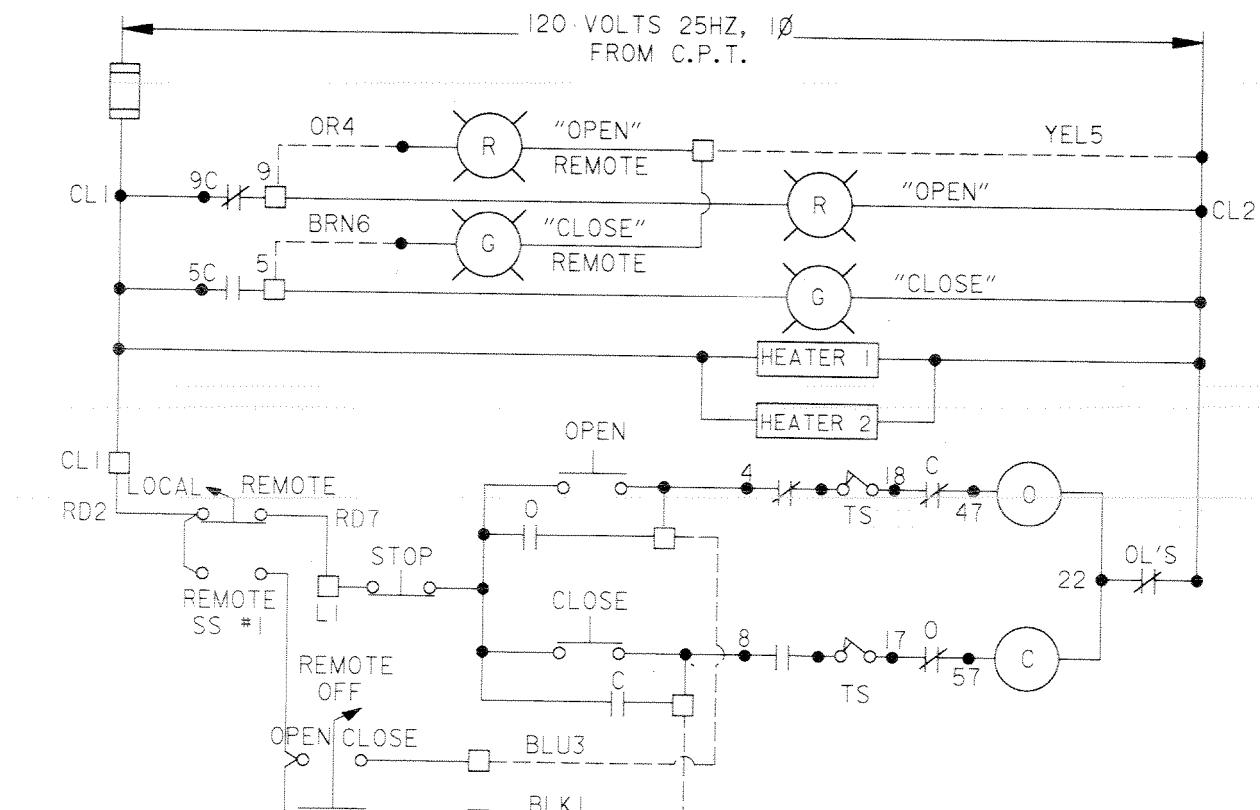

TYPICAL GATE CONTROL SCHEMATIC

.....LEGEND.....


- PILOT INDICATING LIGHT - GENERAL ELECTRIC TYPE ET-16 WITH 1900 OHM RESISTOR AND ALLEN BRADLEY #800T-N515. TYPE "A" NAMEPLATE OR APPROVED EQUAL WITH BLACKENED CHARACTERS - ENGRAVED TO READ "OPEN" OR "CLOSED" AS REQUIRED. "X" INDICATES RED OR GREEN AS REQUIRED.

TYPICAL SELECTOR SWITCH/PILOT LIGHT STATION NAMEPLATE. ENGRAVED PHENOLIC. 1" X 3" WITH BEVELED EDGES AND INSCRIPTION AS SHOWN IN CONSOLE GATE CONTROL WIRING DIAGRAM.


SELECTOR SWITCHES AS FOLLOW:

 1. ALLEN BRADLEY #800T-HSA, 2 POSITION WITH 800T-X638 NAMEPLATE OR APPROVED EQUAL FOR "LOCAL/REMOTE" CONTROL.
 2. ALLEN BRADLEY #800T-J2A, 3 POSITION WITH 800T-X533 NAMEPLATE OR APPROVED EQUAL FOR "OPEN - OFF - CLOSE" CONTROL.

Delete All References
to the local (Remote)
suites (Root)

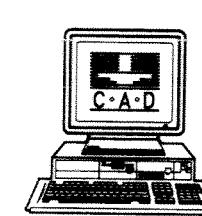

SYMBOL	DESCRIPTION	DATE	APPROVED
			REVISIONS
	<p style="text-align: center;">U.S. ARMY ENGINEER DISTRICT, NEW ORLEANS</p> <p style="text-align: center;">CORPS OF ENGINEERS</p> <p style="text-align: center;">NEW ORLEANS, LOUISIANA</p>		
<p style="text-align: center;">LAKE PONTCHARTRAIN, LA. AND VICINITY</p> <p style="text-align: center;">HIGH LEVEL PLAN</p> <p style="text-align: center;">NEW ORLEANS LAKEFRONT LEVEE</p> <p style="text-align: center;">WEST OF I.H.N.C.</p> <p style="text-align: center;">ORLEANS MARINA PHASE V - SLUICE GATES</p> <p style="text-align: center;">ORLEANS PARISH, LOUISIANA</p>			
<p style="text-align: center;">SLUICE GATE - ELECTRICAL</p> <p style="text-align: center;">MISCELLANEOUS</p>			
DESIGNED BY: B.P.C.	DATE:	PLOT SCALE:	PLOT DATE:
DRAWN BY: C.G.H.	NOV. 1996	32	DEC. 17, 1997
CHECKED BY: B.P.C.	CADD FILE: 44778E-6.DGN		FILE NO.
SUBMITTED BY:	SOLICITATION NO.		H-4-44778
DAN BRADLEY DESIGN ENGINEER	DAGW29-98-B-0001		DWG. 43 OF 46

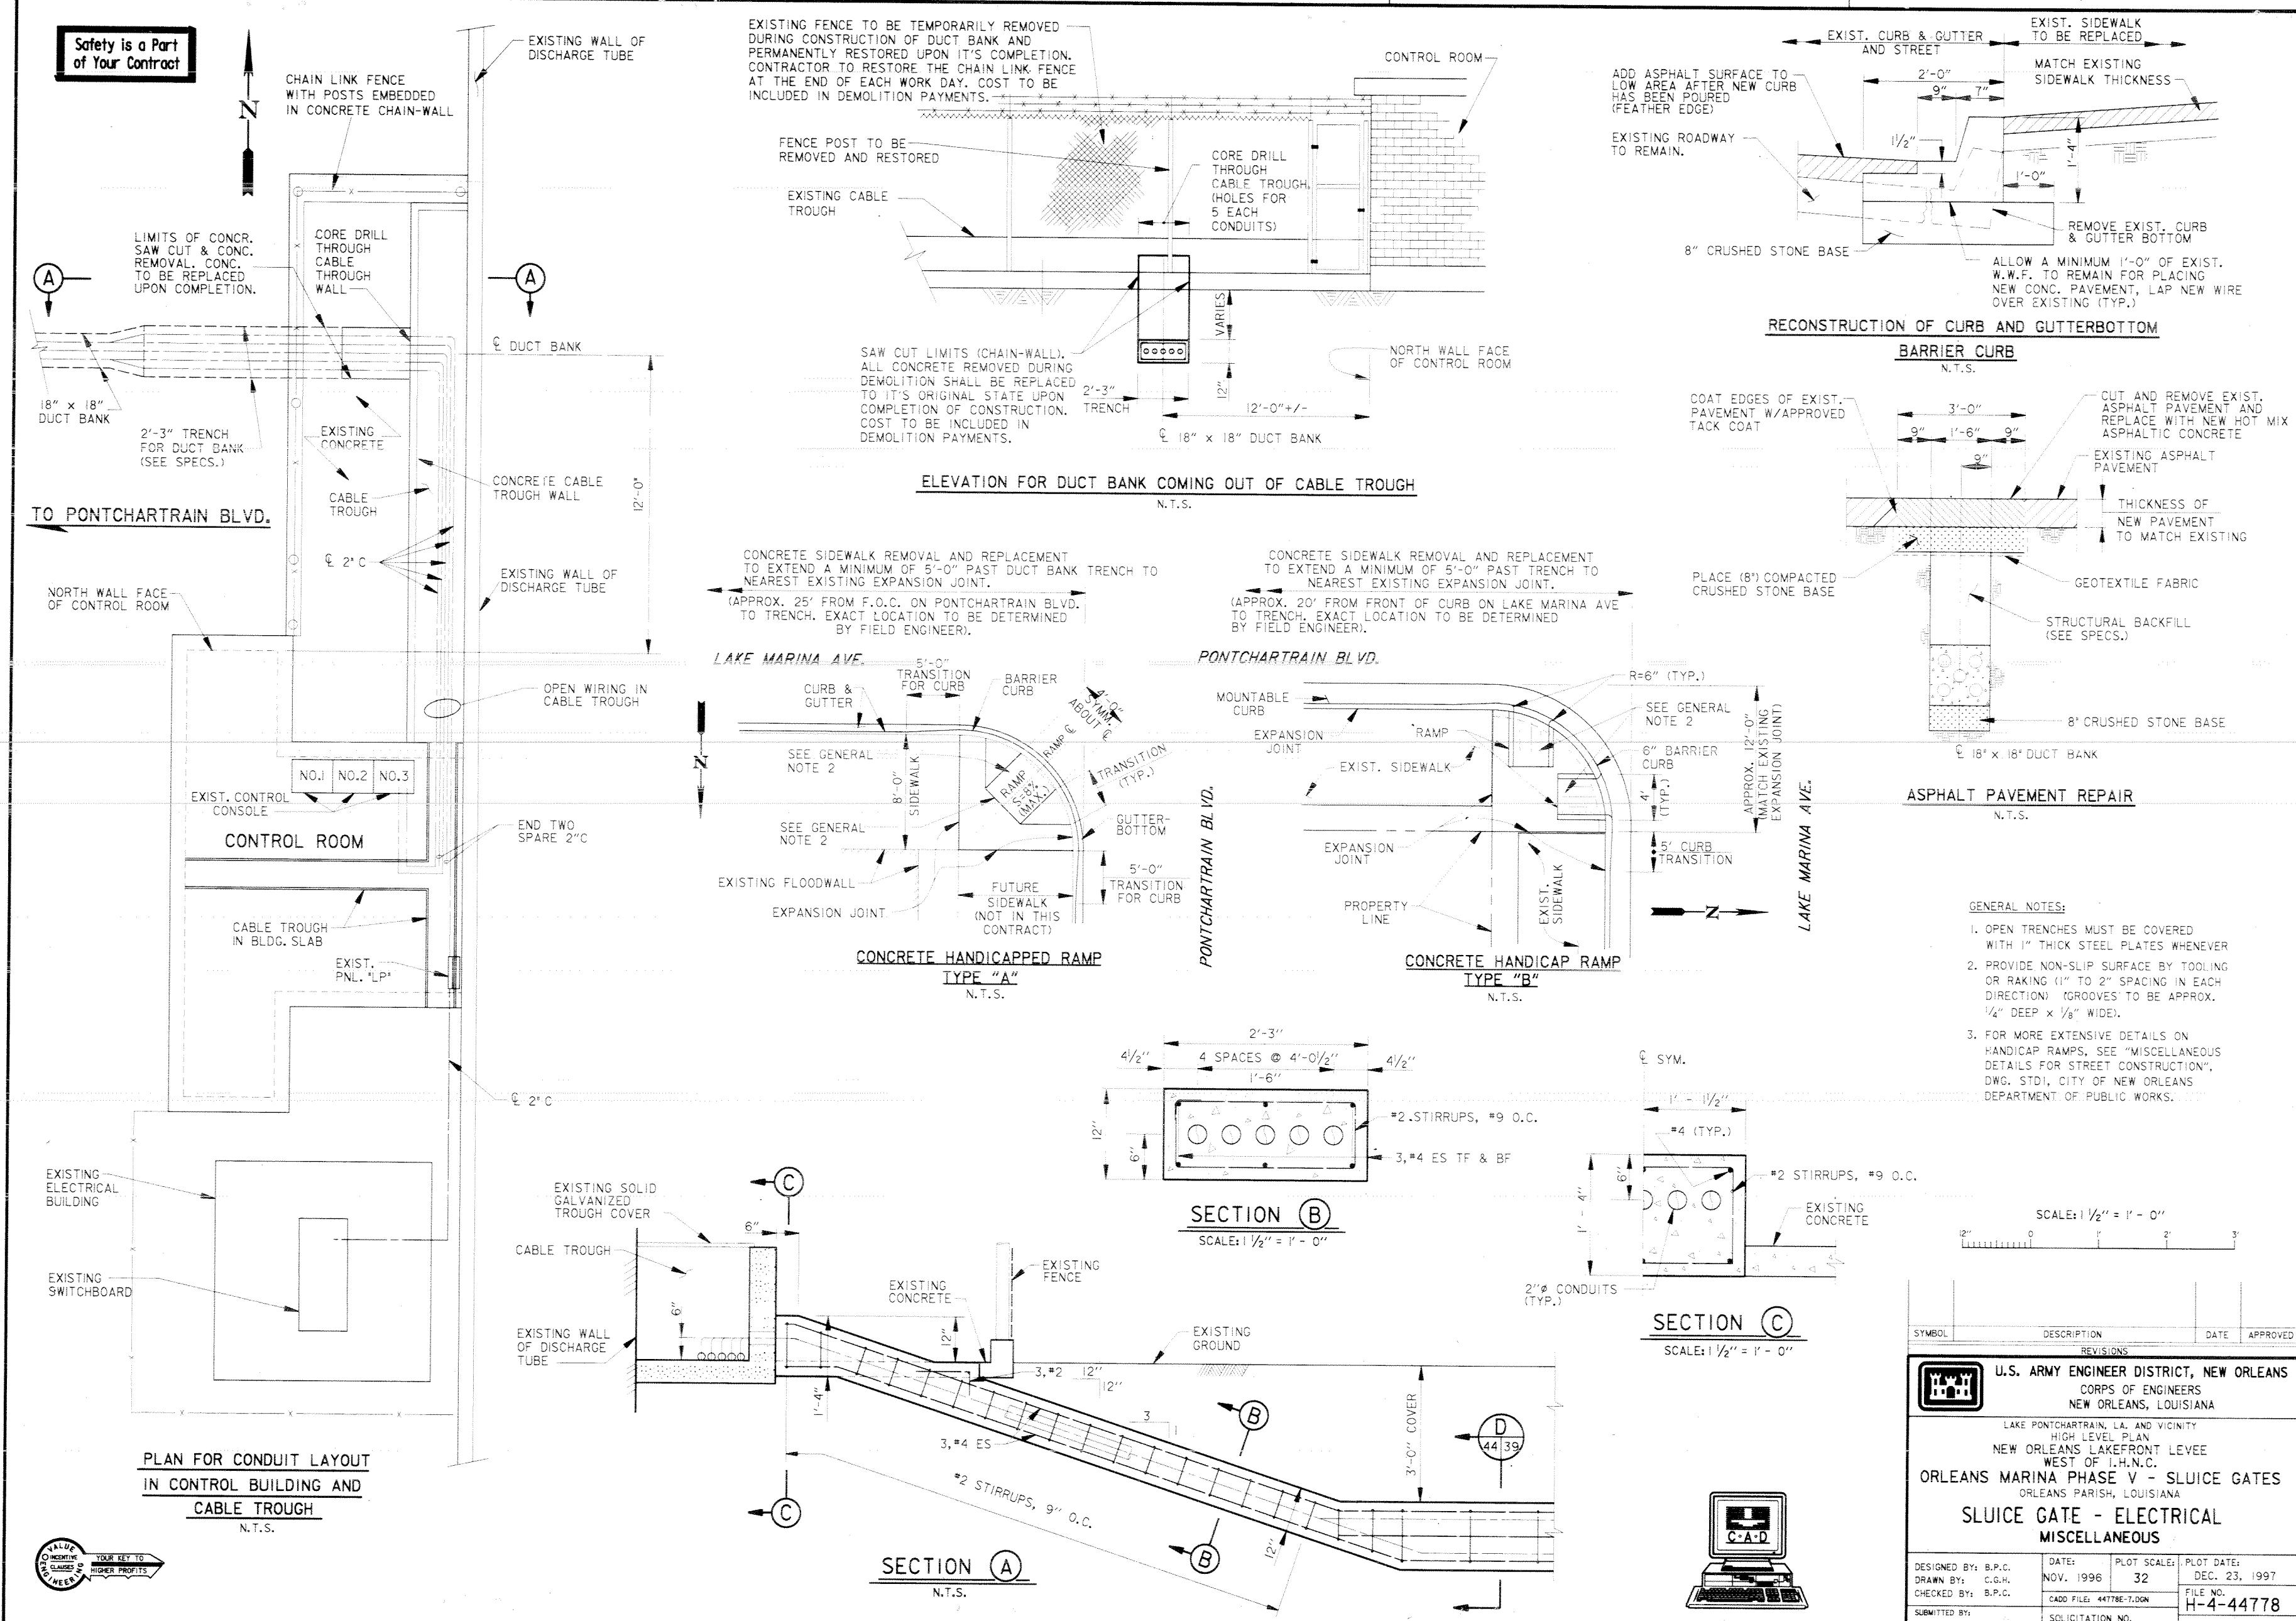


Safety is a Part
of Your Contract

5

4


3

2


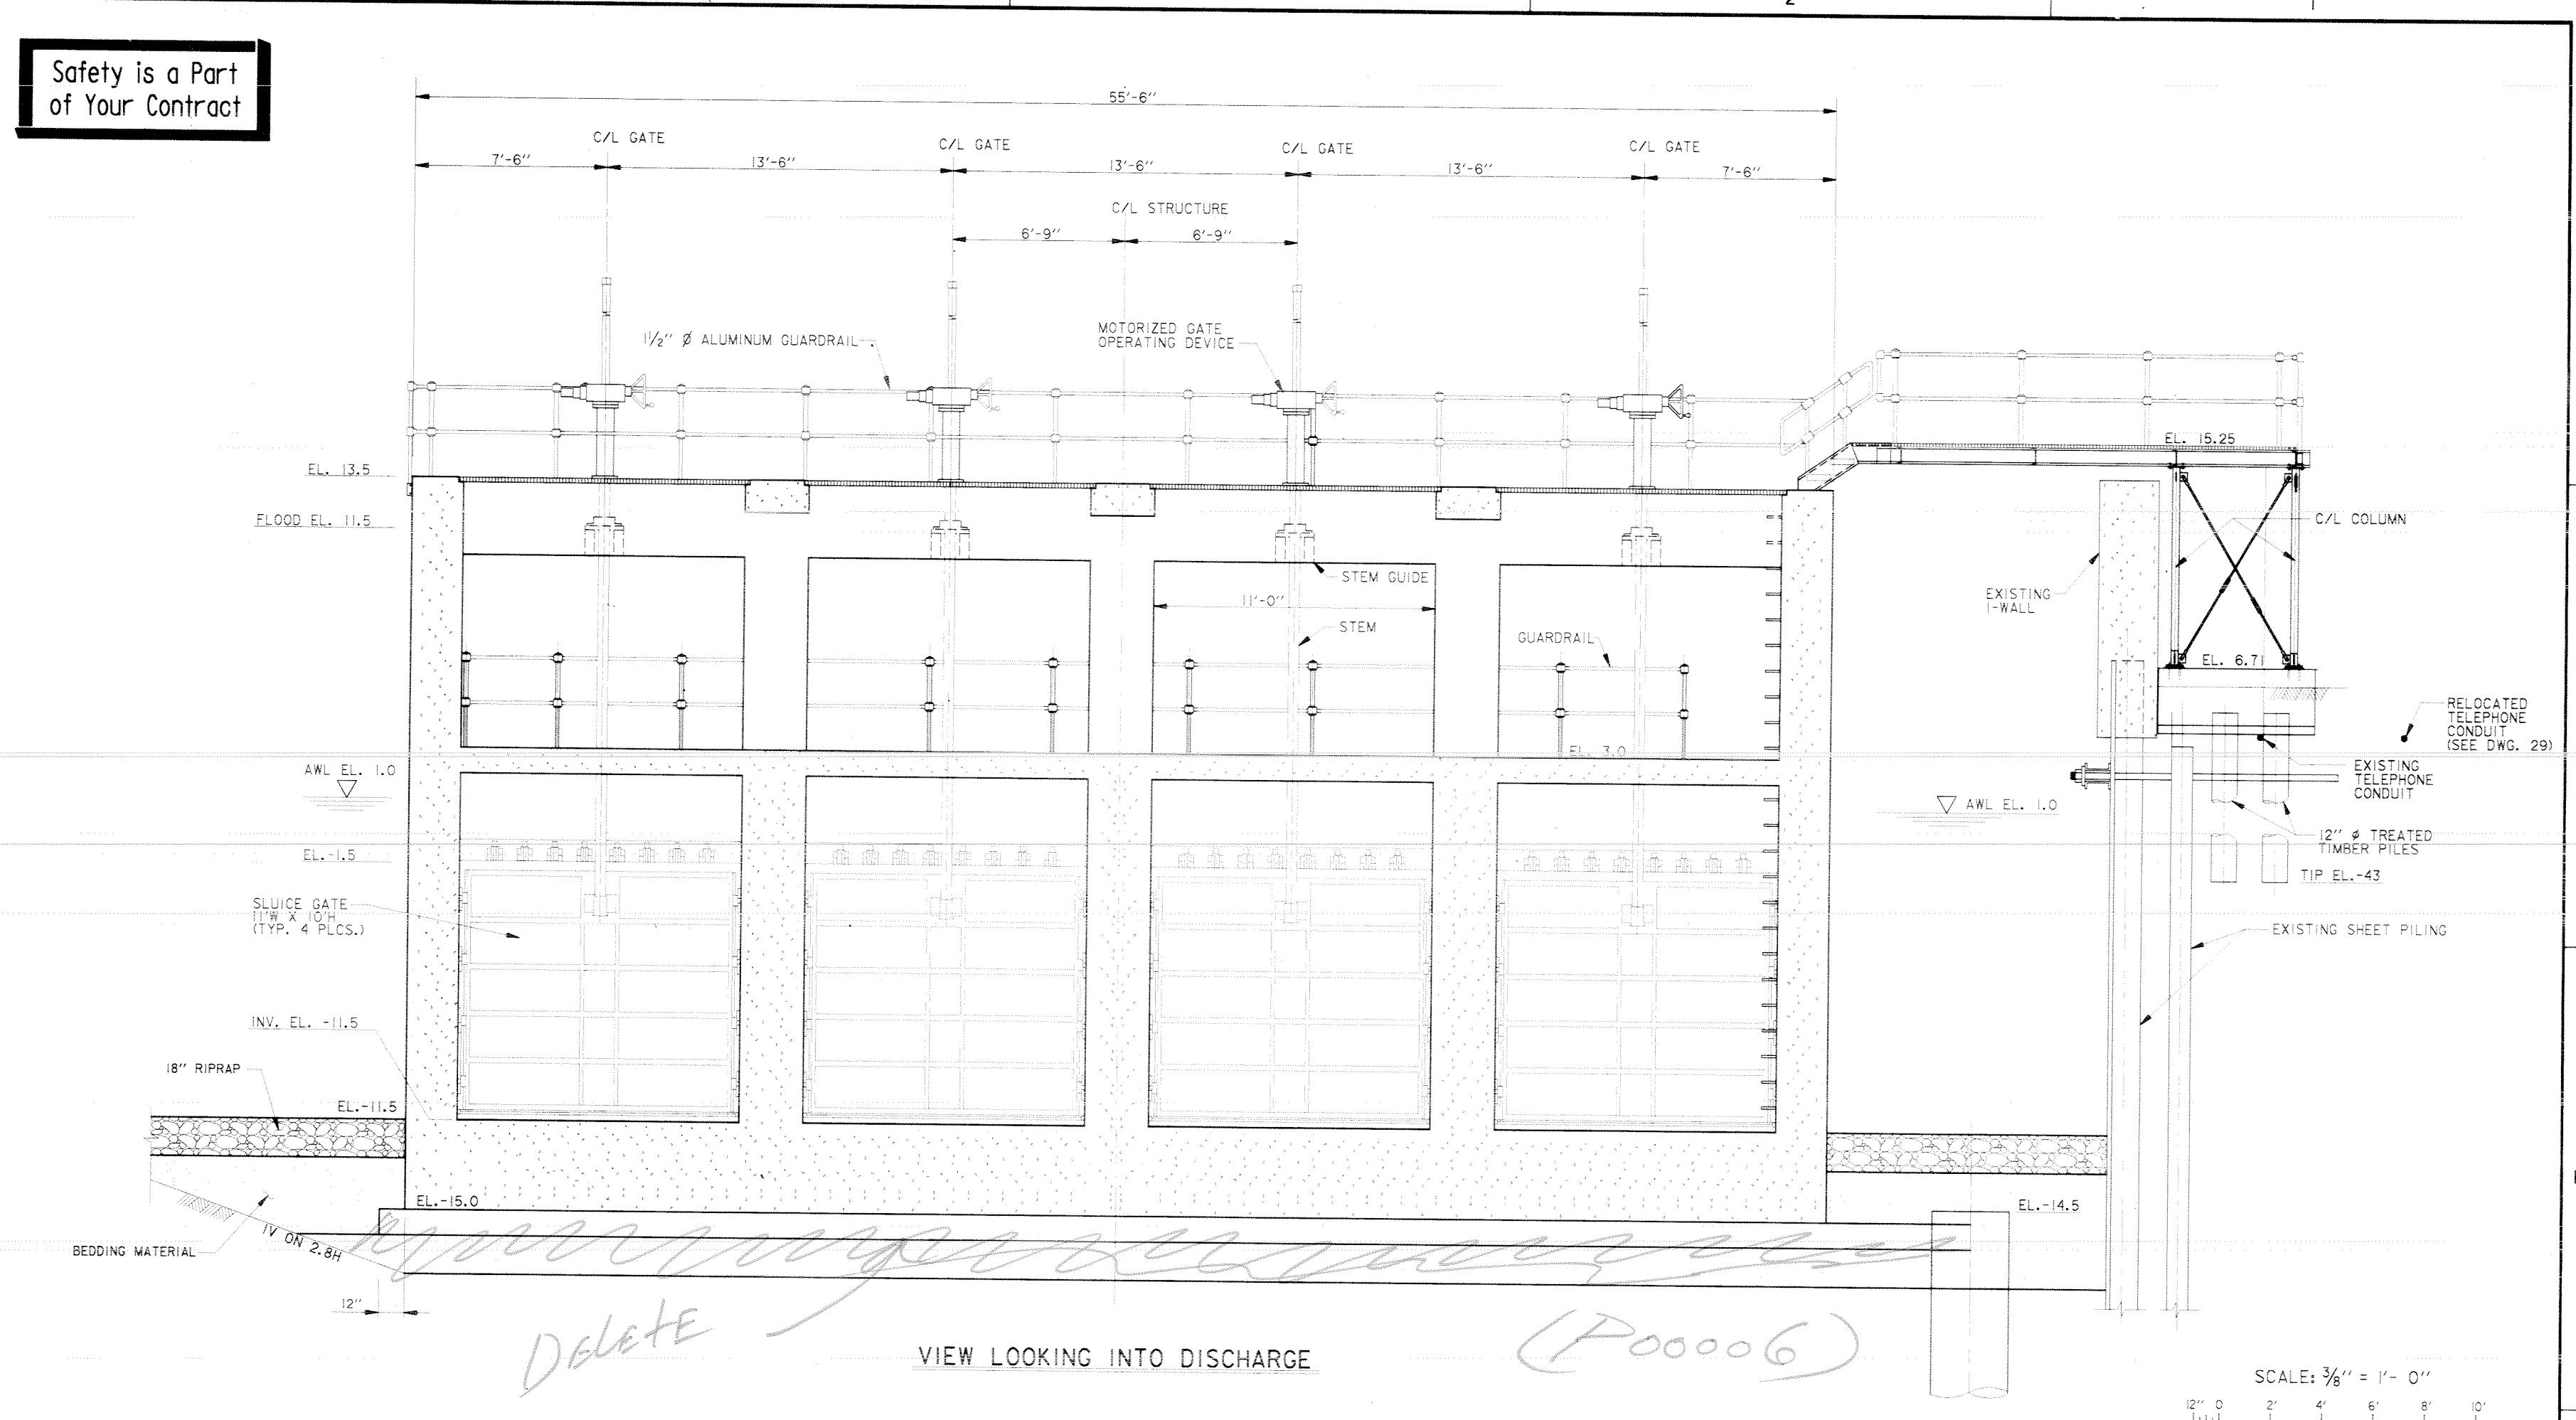


GATE	QTY.	OPERATOR	MOTOR	STEM RPM	STEM FACTOR	START TORQUE (FT.-LBS.)	RUN TORQUE (FT.-LBS.)	STALL TORQUE (FT.-LBS.)	STALL THRUST (LBS.)	FULL LOAD AMPS	LOCKED ROTOR AMPS
11'W X 10'H	4	LIMITORQUE LI20-420 (OR APPROVED EQUAL)	10 HP 460V,SPH,25 Hz	24	.034	1600	800	5200	152,900	27	96

SYMBOL	DESCRIPTION	DATE	APPROVED
REVISIONS			
U.S. ARMY ENGINEER DISTRICT, NEW ORLEANS			
CORPS OF ENGINEERS			
NEW ORLEANS, LOUISIANA			
LAKE PONTCHARTRAIN, LA., AND VICINITY			
HIGH LEVEL PLAN			
NEW ORLEANS LAKEFRONT LEVEE			
WEST OF I.H.N.C.			
ORLEANS MARINA PHASE V - SLUICE GATES			
ORLEANS PARISH, LOUISIANA			
SLUICE GATES OPERATOR DETAILS			
DESIGNED BY: M. SANCHEZ	PLOT SCALE:	DATE: X	PLOT DATE: 32
DRAWN BY: G. WEIDENBACHER	CHECKED BY: M. SANCHEZ	FILE NO. H-4-44778	DEC. 17, 1997
SUBMITTED BY: MIKE SANCHEZ, P.E.		SOLICITATION NO. DACW29-98-B-0001	FILE NO. H-4-44778
DESIGN ENGINEER		DWG. 45 OF 46	DWG. 45 OF 46

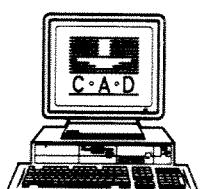

Safety is a Part
of Your Contract

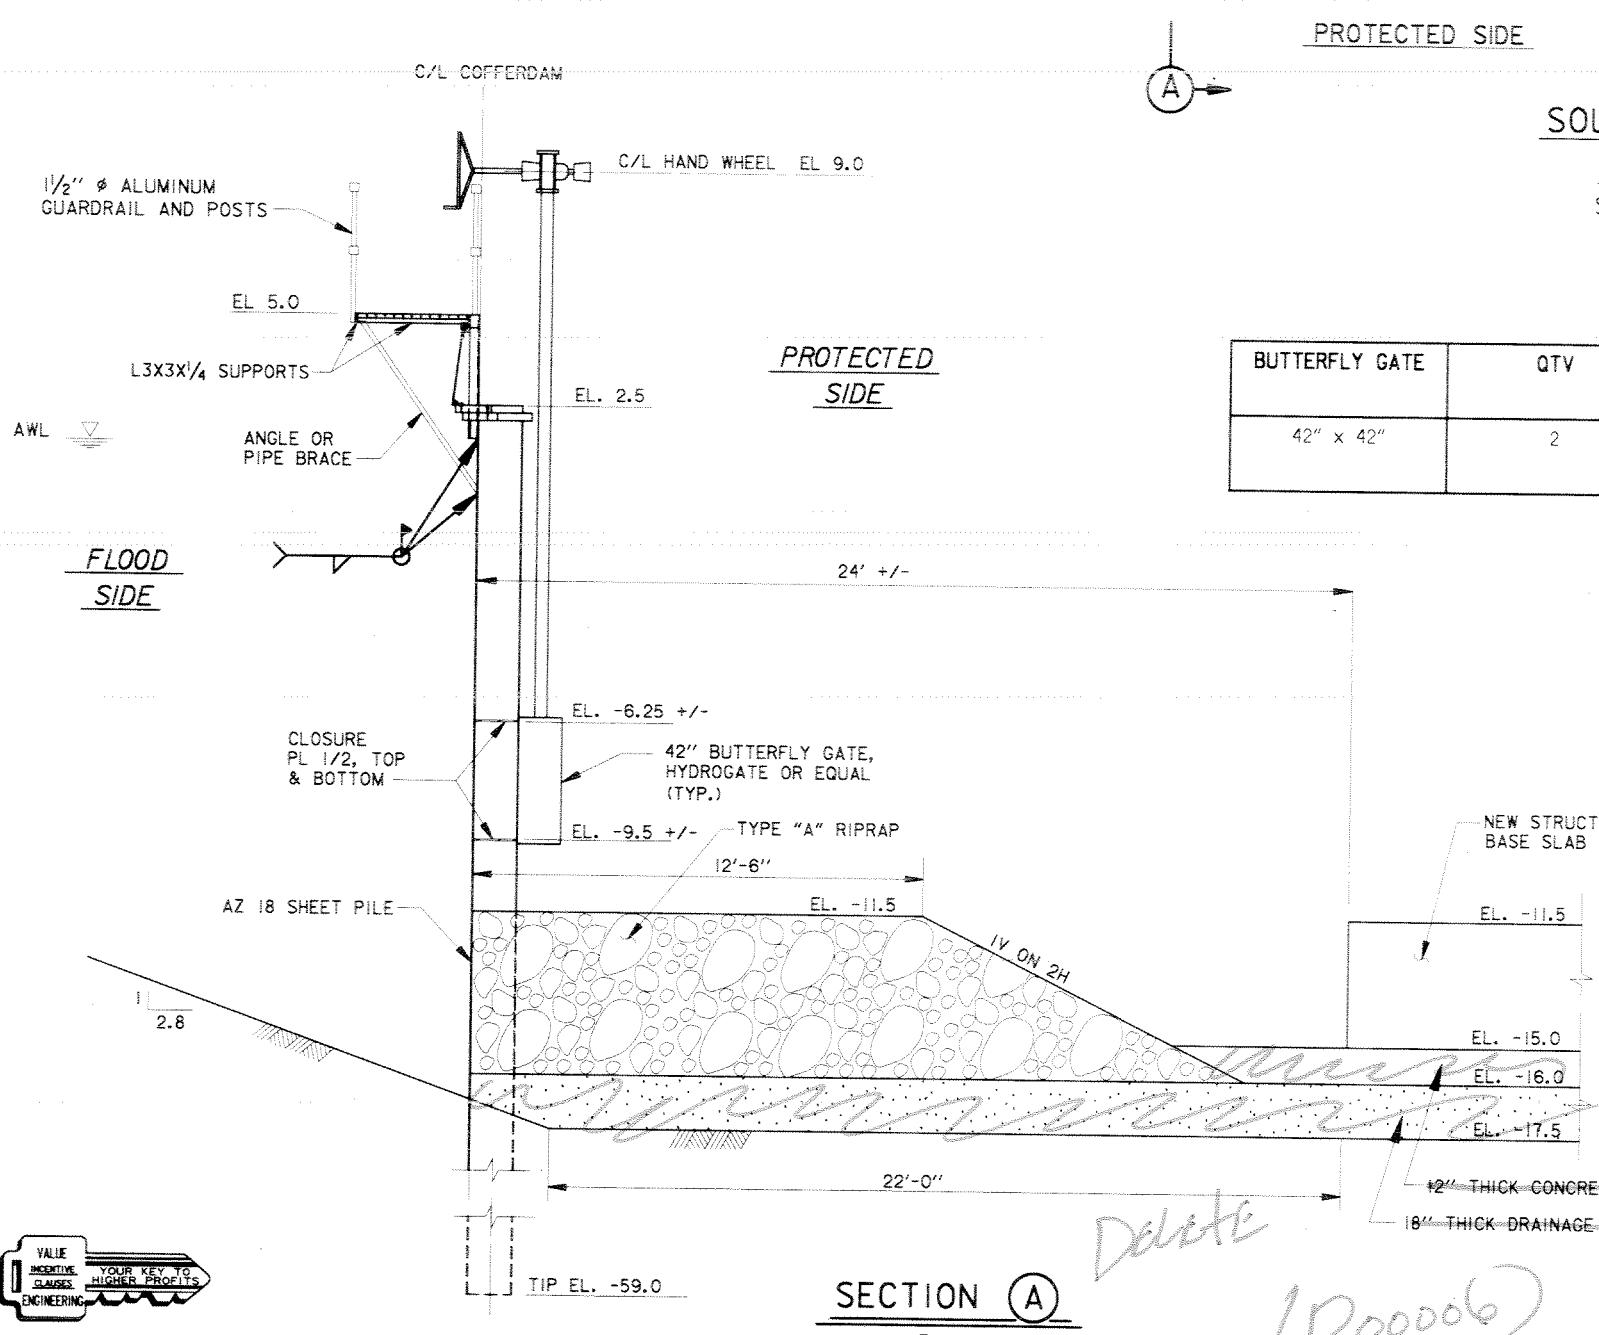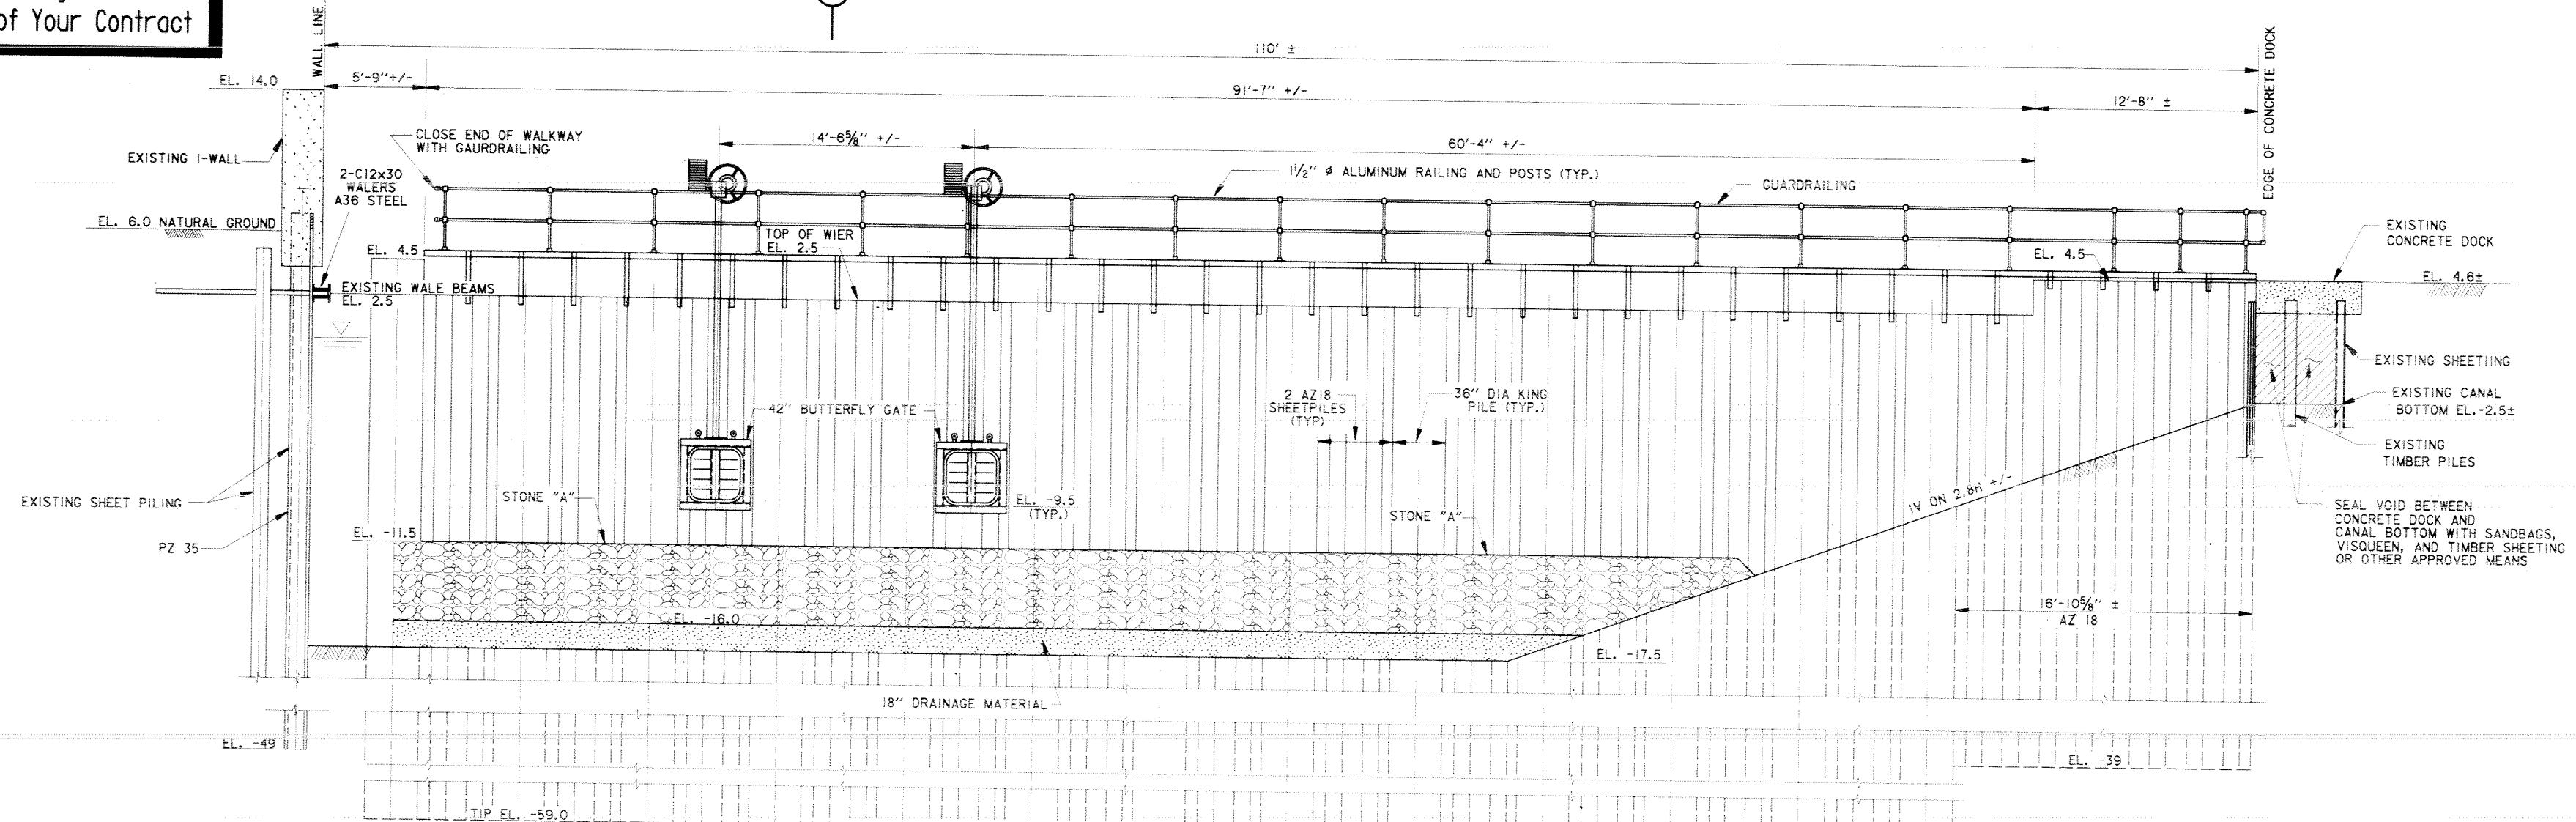

Renard 60Hz Operator

**SOUTH ELEVATION
COFFERDAM**

SCALE: $\frac{1}{4}$ " = 1'- 0"

BUTTERFLY GATE	QTY	OPERATOR	MOTOR	OPERATING TIME	START TORQUE (FT-LBS)	RUN TORQUE (FT-LBS)	STALL TORQUE (FT-LBS)	FULL LOAD AMPS	LOCKED ROTOR AMPS
42" x 42"	2	LIMITORQUE L-120-10/WTRA-72 4.64:1 SGA OR EQUAL	0.43 HP, 460 V, 3 PH 25 HZ	90 SEC	6,336	1,131	12,446	2.5	16

* SEE DRAWING 4-8 FOR
DETAILS OF THE
REQUIRED BEDDING
AND RIPRAP.
(P00006)


SCALE: $\frac{3}{8}$ " = 1'- 0"
12' 0" 2' 4' 6' 8' 10'

SCALE: $\frac{1}{4}$ " = 1'- 0"
12' 0" 5' 10' 15' 20'



SYMBOL	DESCRIPTION	DATE	APPROVED
REVISIONS			
	U.S. ARMY ENGINEER DISTRICT, NEW ORLEANS CORPS OF ENGINEERS NEW ORLEANS, LOUISIANA		
LAKE PONTCHARTRAIN, LA. AND VICINITY HIGH LEVEL PLAN NEW ORLEANS LAKEFRONT LEVEE WEST OF I.H.N.C.			
ORLEANS MARINA PHASE V - SLUICE GATES ORLEANS PARISH, LOUISIANA			
COFFERDAM BUTTERFLY GATES OPERATOR DETAILS			
DESIGNED BY: M. SANCHEZ DRAWN BY: B. DAUENHAUSER CHECKED BY: M. SANCHEZ SUBMITTED BY: MIKE SANCHEZ, P.E. DESIGN ENGINEER	DATE: DEC 97 PLOT SCALE: 48 FILE NO. H-4-44778	PLOT DATE: DEC. 17, 1997	FILE NO. H-4-44778
SOLICITATION NO. DACW29-98-B-0001 DWG. 46 OF 46			

SAFETY IS A PART
OF YOUR CONTRACT

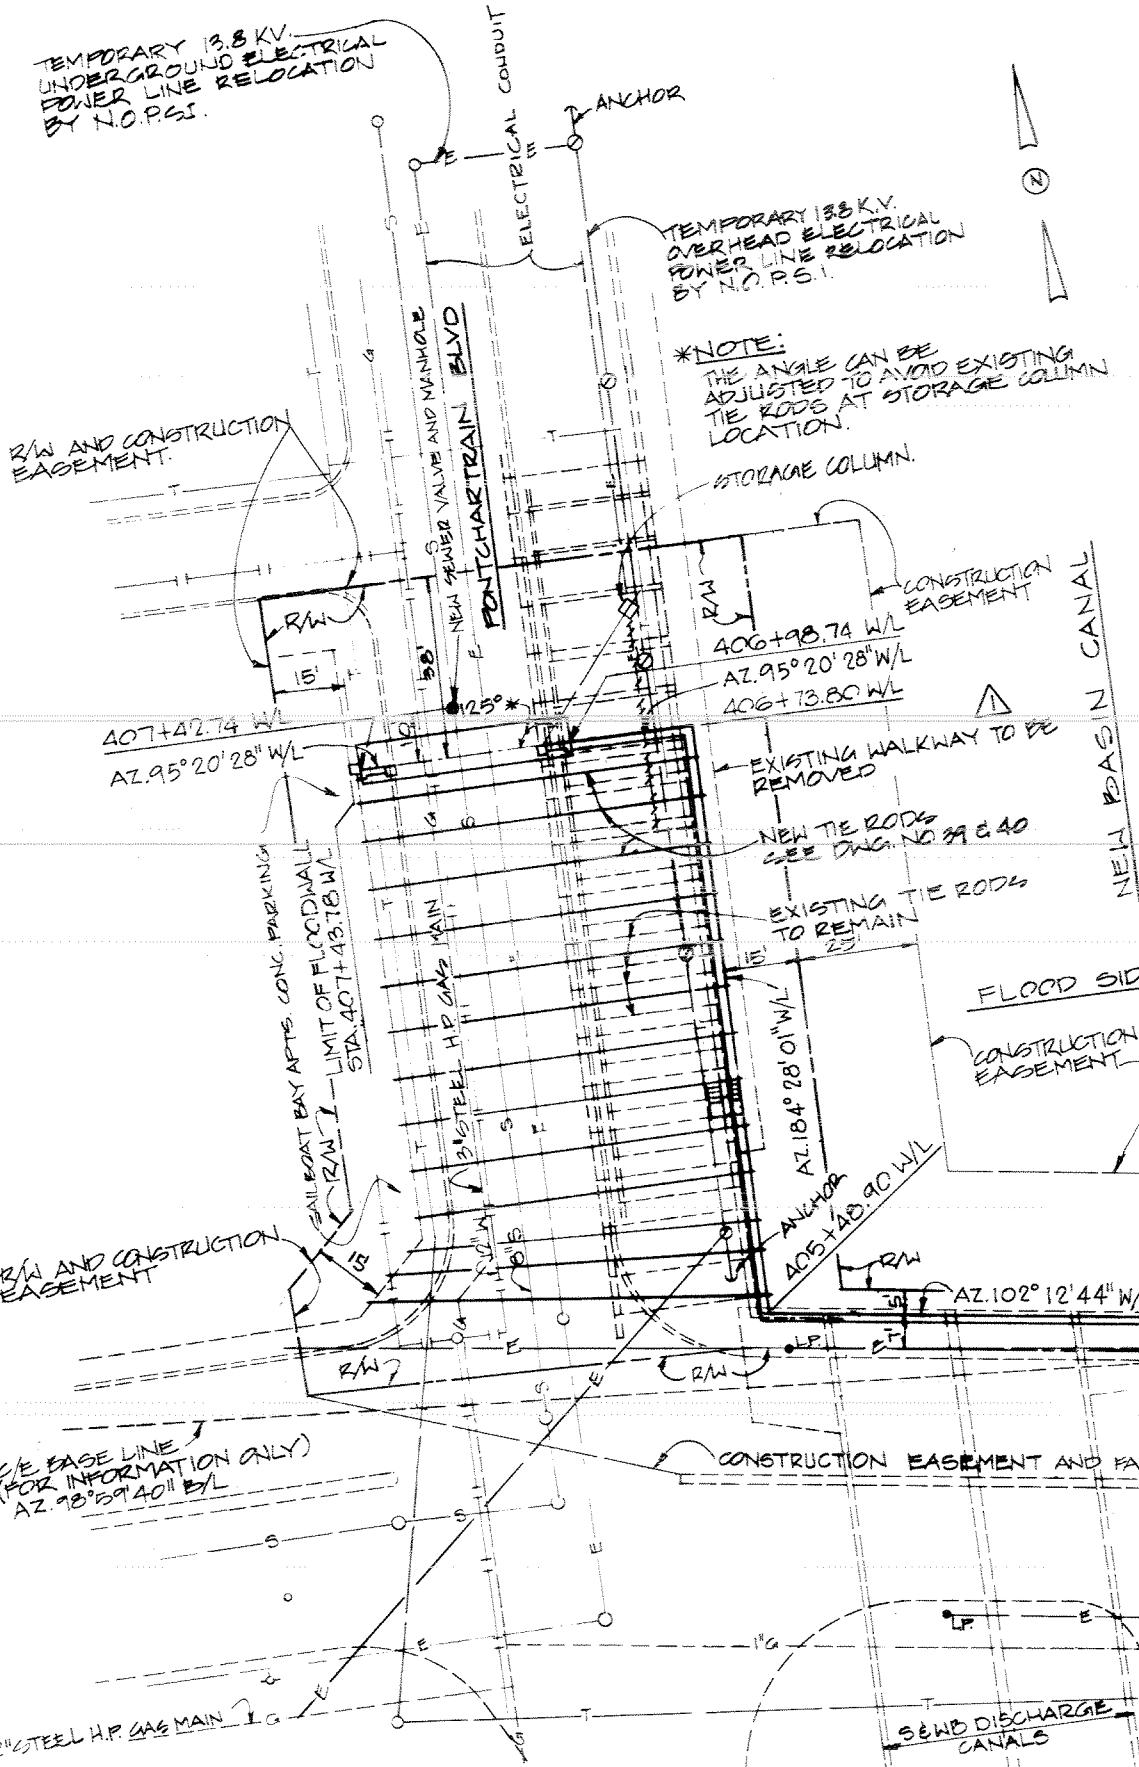

PLAN OF FLOODWALL

SCALE 1"=20'



LEGEND:	
5.32	EXISTING GRADE
7.25	FINISHED GRADE
B.C.	BACK OF CURB
W/L.	WALL LINE
B/L	BASE LINE
L.P.	LIGHT POLE (O.L.B OWNED, to be removed by owner)
T	TELEPHONE CABLE
G	GAS LINE
W	WATER LINE
S	SEWER LINE
E	ELECTRICAL CONDUIT
O	MANHOLE (EXISTING)
●	NEW SEWER VALVE & MH.
■	NEW ELECTRICAL JUNCTION BOX BY N.O.P.S.I
□	TEMPORARY POWER POLE BY N.O.P.S.I
RW	RIGHT OF WAY
—	7/8"X7/8" CONCRETE POSTS
—	ELECTRIC SIGN (TO BE REMOVED BY OWNER'S.)
—	AREA OF FERTILIZING & SEED

THIS PLAN ACCOMPANIES
MODIFICATION P00013
TO CONTRACT NUMBER
DACP29-88-C-0091

- NOTES
1. FOR PROFILES, SEE DWGS. 4 AND 5.
 2. FOR GENERAL NOTES, SEE DWG. 1.
 3. FOR PAVING PLAN SEE DWG. 28.
 4. FOR WALL FINISH DETAILS, SEE DWGS. 51 AND 55.
 5. FOR NEW TREES TYPE AND PLANTING LOCATION, SEE DWG. 28.

3	7 APR 89	REVISED LEVEE SHAPING BETWEEN STA. 400+00 W/L AND STA. 400+56 W/L; MOD. #13	MSD
4	12 JAN 89	REVISED LIMIT OF SHEET PILING; MOD. 9	MSD
5-17-88		REVISED W/L ALIGNMENT; MOD. #2	MSD
5-18-88		Moved RI STA. 303+51.39 B/L and P.T. STA. 313+00 B/L FROM LEVEE CROWN LINE TO BASELINE; MOD. #2	MSD
2-22-88		REVISED EXISTING WALKWAY NOTE AND NOTE NO. 4 & ADDED B/L STATIONS; AMEND. #3	MSD

REVISION	DATE	DESCRIPTION	BY
		FROMMERZ ENGINEERS INC. U.S.ARMY ENGINEER DISTRICT, NEW ORLEANS NEW ORLEANS, LA. CORPS OF ENGINEERS ARCHITECT - ENGINEER NEW ORLEANS, LOUISIANA	

LAKE PONTCHARTRAIN, LA. AND VICINITY
HIGH LEVEL PLAN


NEW ORLEANS LAKEFRONT LEVEE WEST OF I.H.N.C.
ORLEANS MARINA FLOODWALL EXTENSION
ORLEANS PARISH, LOUISIANA

PLAN OF FLOODWALL


DESIGNED	DRAWN	CHECKED	DATE	SCALE	FILE NO.
N.F.H.	S.P.	N.F.H.	DEC., 1987	AS SHOWN	H-4-30204
SUBMITTED	Signed	Signed	SPEC NO.	Dwg. 03	REFERENCE DRAWING

DACW29-88-B-0024

03 or 57

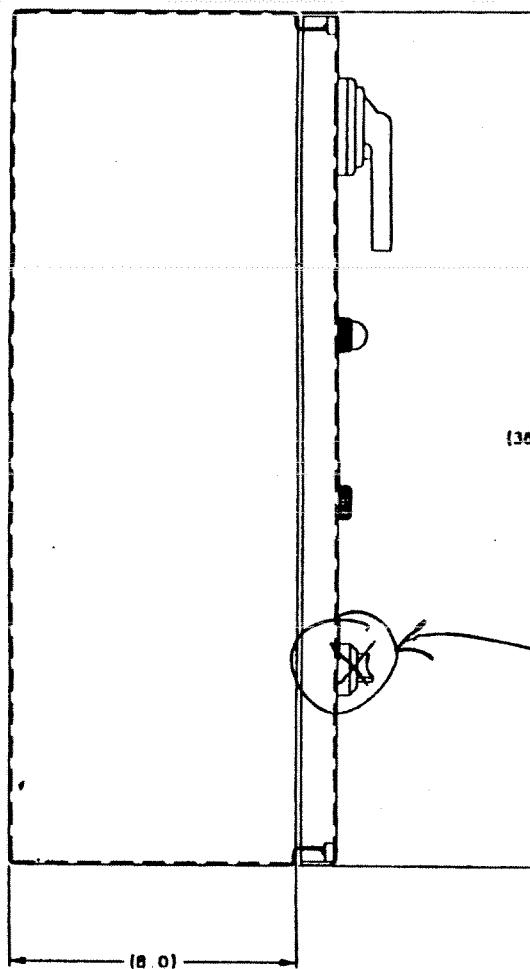

HOFFMAN CONTROL BOX
36x24x8 (CSD36248)

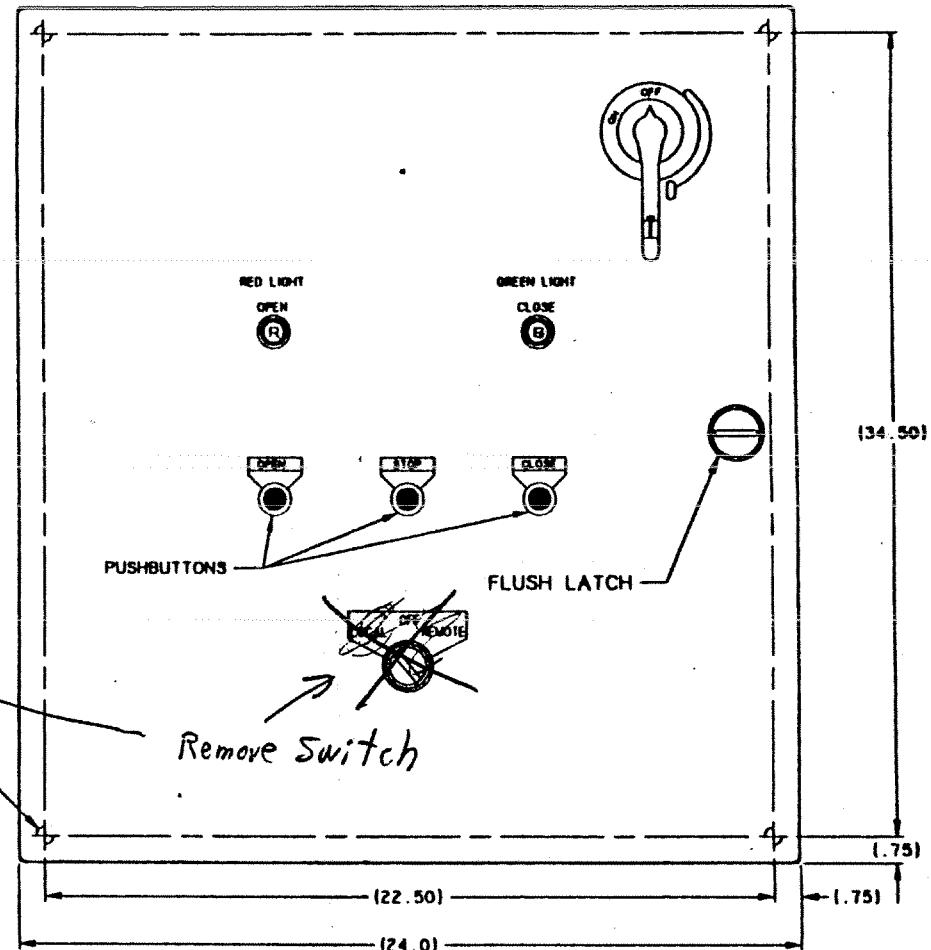


			DRAWN BY	DATE	LIMITORQUE CORPORATION	
			JCD	10/23/98		
			CHECKED BY	DATE	TITLE	
			JD		CONTROL ENCLOSURE	
NO.	DESCRIPTION	DATE	APPROVED BY	DATE	1ST ORDER NO.	DRAWING NO.
			KEH	10/23/98	274712	02-487-0293-2
	REVISION				REV	1 OF 1

L-781 REV-A 4/26/93

MOD 1

MARCH 26, 1998

100000

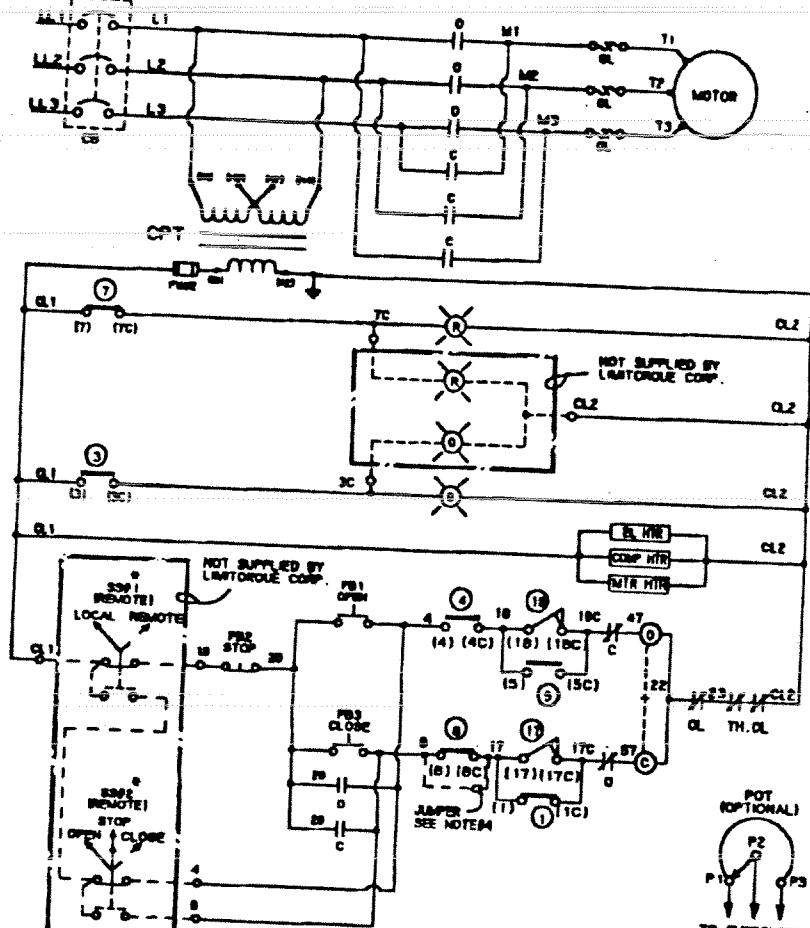

VALVE SHOWN IN FULL OPEN POSITION		
ROTOR	LIMIT SWITCH CONTACT DEVELOPMENT	
	FULLY OPEN	FULLY CLOSED
OPEN	A	B
	BY-PASS CIR.	SPARE
CLOSE	IND LIGHT	OPEN LIMIT
	BY-PASS CIR.	SPARE
WT. 1	IND LIGHT	CLOSE LIMIT
	SPARE	SPARE
WT. 2	SPARE	SPARE
	SPARE	SPARE


- (v) CLOSING TORQUE SWITCH INTERRUPTS CONTROL CIRCUIT IF MECHANICAL OVERLOAD OCCURS DURING CLOSING CYCLE
- (ii) OPENING TORQUE SWITCH INTERRUPTS CONTROL CIRCUIT IF MECHANICAL OVERLOAD OCCURS DURING OPENING CYCLE

NOTES

1. OPEN CONTACT
2. CLOSE CONTACT
3. MOTORS INT. 1 & INT. 2 CAN BE SET AT VALVE POSITION IN FULL OPEN, FULL CLOSED OR ANY POINT IN BETWEEN AS INDICATED BY POINTS A AND B.
4. ADD JUMPER ON LS90 BETWEEN TERMINALS (18) & (18C) FOR TORQUE SEATING VALVES

LEGEND

- (v) OPEN CONTACT
- (c) CLOSE CONTACT
- (o) OPENING DOOR
- (c) CLOSING DOOR
- (+) MECHANICAL INTERLOCK
- (R) RED INDICATING LIGHT
- (G) GREEN INDICATING LIGHT
- (S) SELECTOR SWITCH
- (P1) OPEN PUSHBUTTON
- (P2) STOP PUSHBUTTON
- (P3) CLOSE PUSHBUTTON
- (MTR HTR) MOTOR HEATER
- (OL) ELECTRICAL COMPARTMENT HEATER
- (OL) THERMAL OVERLOAD CONTACTS
- POT-SLIDEWIRE TRANSMITTER (OPTIONAL, SEE CERTIFICATION SHEET IF SUPPLIED)
- CB-CIRCUIT BREAKER
- DL-OVERLOAD RELAY

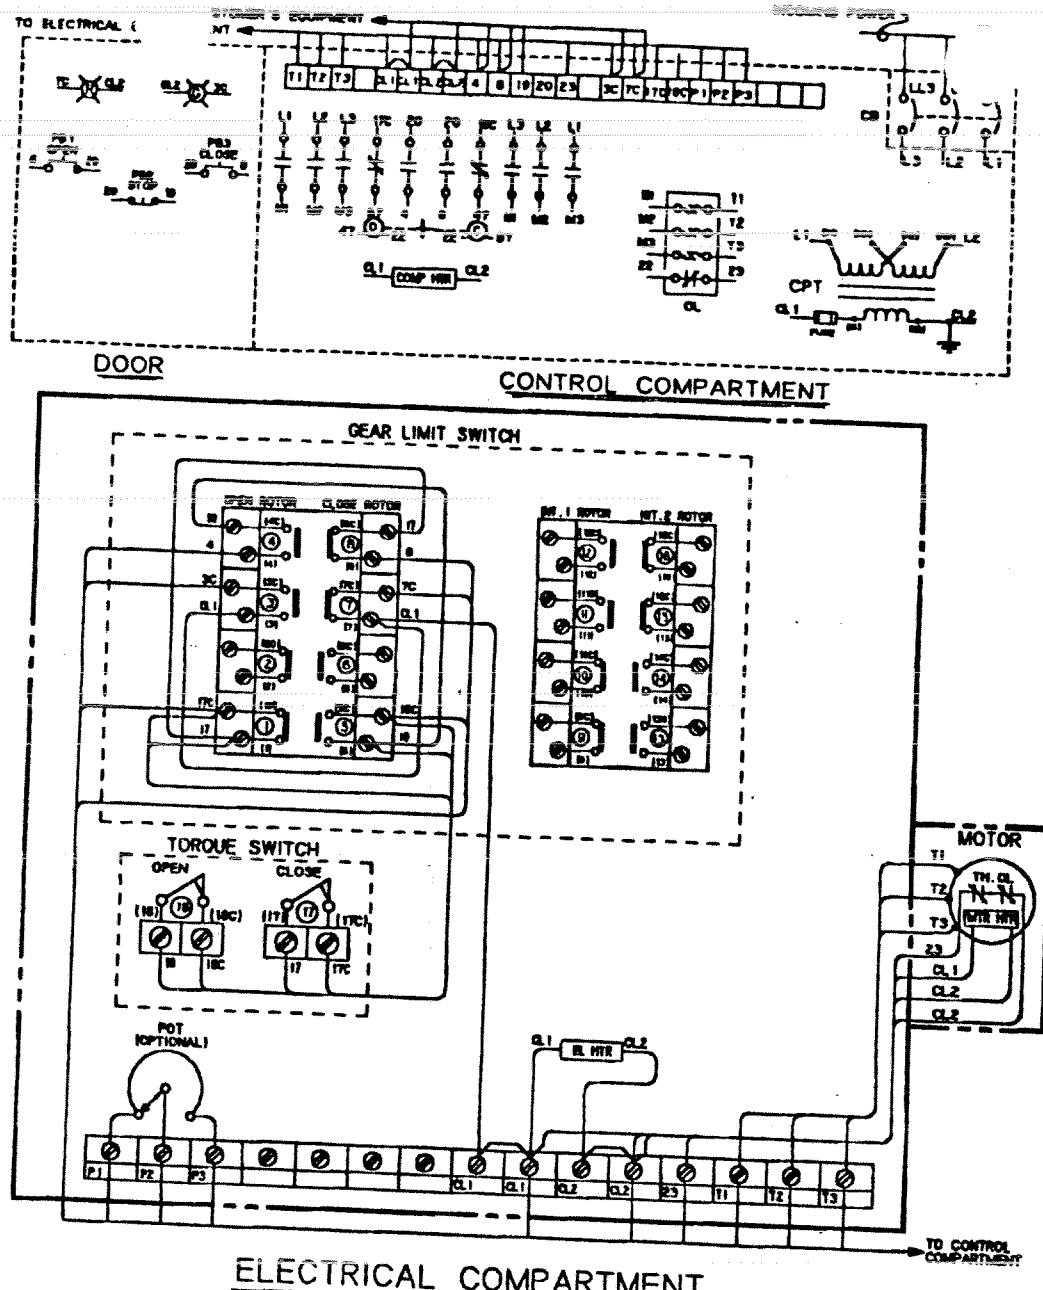

ELECTRICAL COMPARTMENT



NO.	DESCRIPTION	DATE	REV.	REVISION	DATE	APPROVED	DATE	NO. OF SHEETS	ISSUED TO	REVIS.	REVIS.
		MAR 15 1989	101		MAR 15 1989			1	LIMITORQUE CORPORATION		

LIMITORQUE CORPORATION
WIRING DIAGRAM

MOD 2

March 26, 1989

C-231701 0004-00010

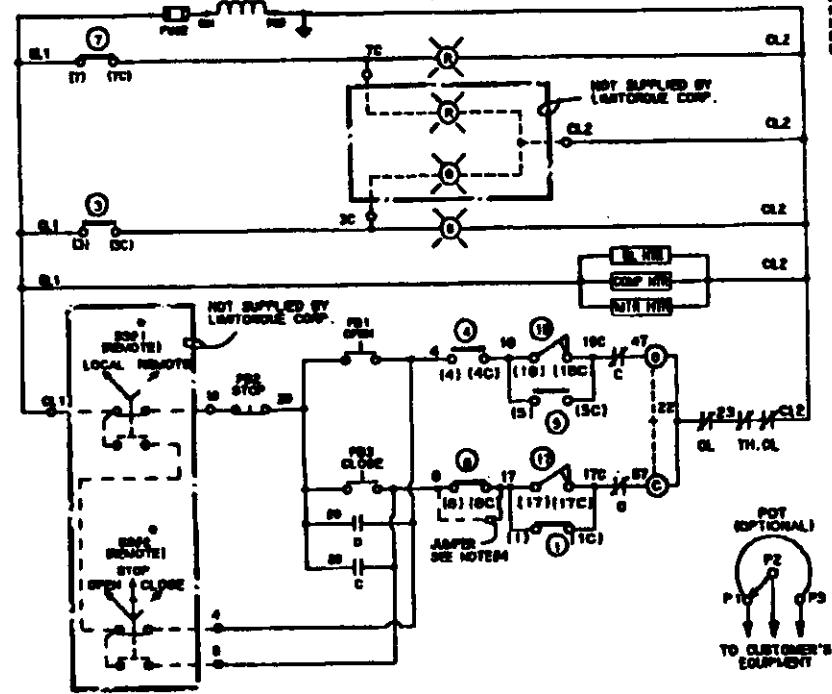
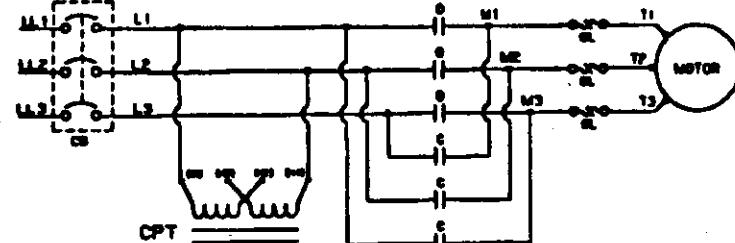
**NOTES**

1. OPEN CONTACT
2. CLOSING CLOSE CONTACT
3. MOTORS M1, 1 & M2, 2 CAN BE SET AT VALVE POSITION FULL OPEN, FULL CLOSED OR ANY POSITION IN BETWEEN AS INDICATED BY POINT A AND B.
4. ADD JUMPER ON LINE BETWEEN TERMINALS (B) & (B1) FOR TORQUE SEATING VALVES

LEGEND

- O OPEN CONTACT
- C-CLOSE CONTACT
- (O) OPENING COIL
- (C) CLOSING COIL
- MECHANICAL INTERLOCK
- (R) RED INDICATING LIGHT
- (G) GREEN INDICATING LIGHT
- (P) POSITION SWITCH
- (F) OPEN PUSHBUTTON
- (S) STOP PUSHBUTTON
- (C) CLOSE PUSHBUTTON
- MTR-MOTOR HEATER
- EL-MTR-ELECTRICAL COMPARTMENT HEATER
- TH-OL-THERMAL OVERLOAD CONTACTS
- POT-SLIDEWIRE TRANSMITTER (OPTIONAL, SEE CERTIFICATION SHEET IF SUPPLIED)
- CB-CIRCUIT BREAKER
- OL-OVERLOAD RELAY

- (1) CLOSING TORQUE SWITCH INTERRUPTS CONTROL CIRCUIT IF MECHANICAL OVERLOAD OCCURS DURING CLOSING CYCLE
- (2) OPENING TORQUE SWITCH INTERRUPTS CONTROL CIRCUIT IF MECHANICAL OVERLOAD OCCURS DURING OPENING CYCLE

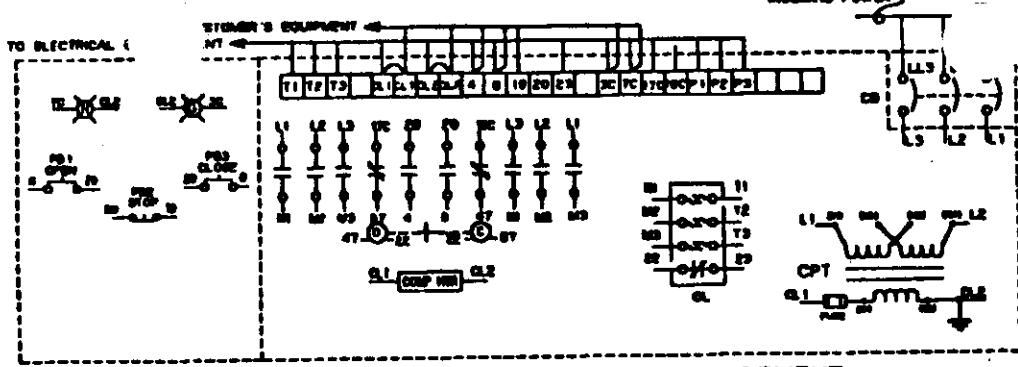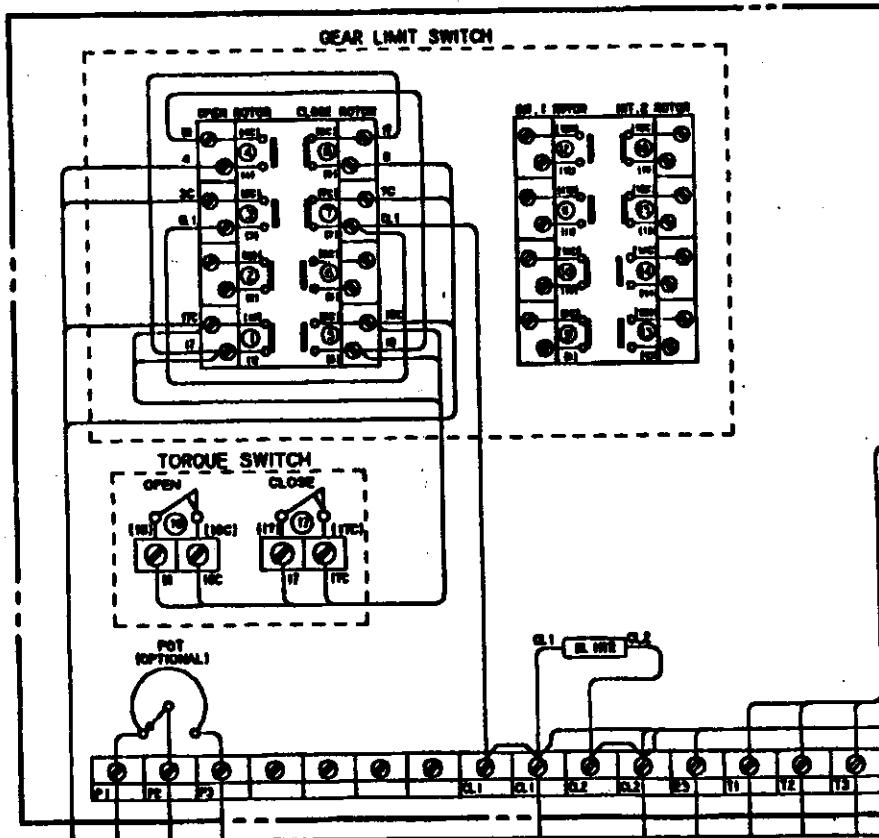**DOOR CONTROL COMPARTMENT****ELECTRICAL COMPARTMENT**

		REV	DATE	LIMITORQUE CORPORATION
NO.	DESCRIPTION	REV	DATE	WIRING DIAGRAM
10	10	10	3/16/99	16-477-3746-3

MOD 2

March 26, 1999