


L A K E B O R G N E



29° 55'

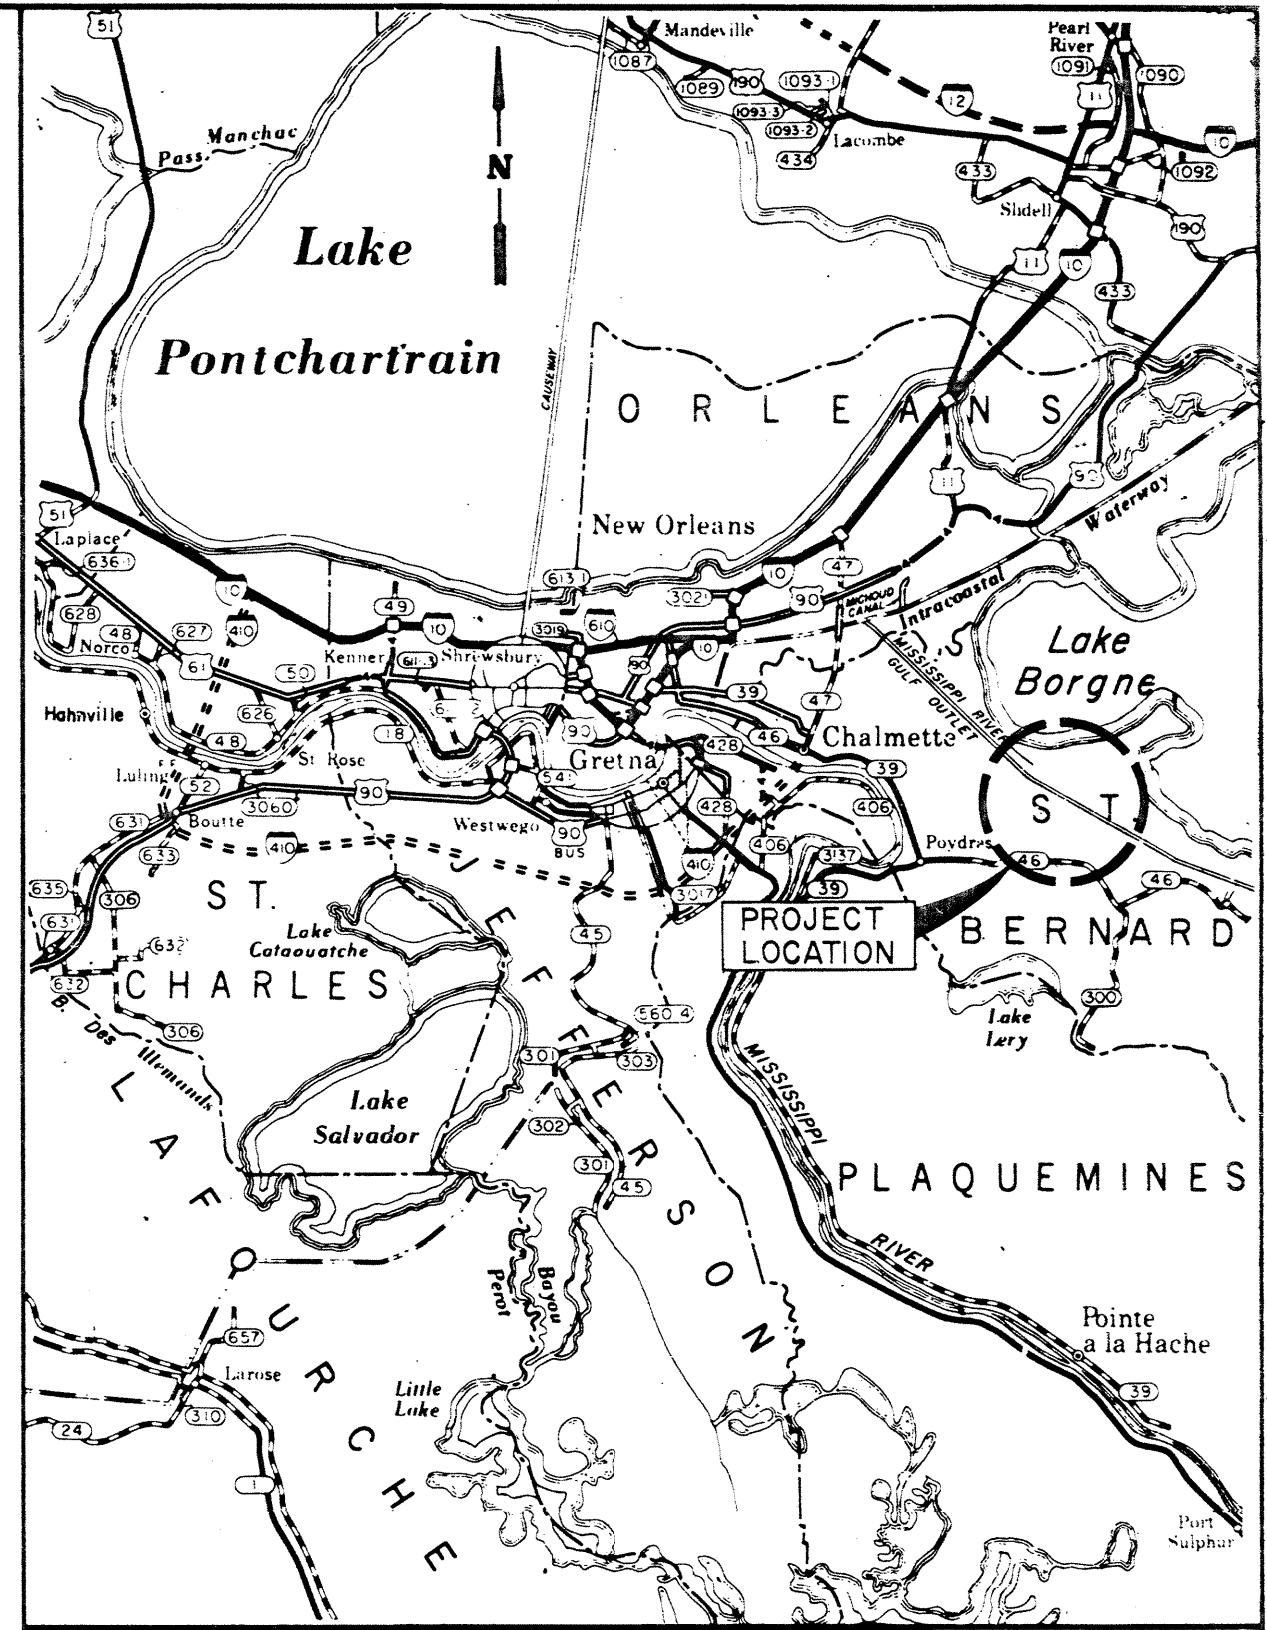

VICINITY MAP

SCALE IN MILES  
0 1 2 3 4 5

| DWG. | DESCRIPTION                                     |
|------|-------------------------------------------------|
| 1    | LOCATION MAP, VICINITY MAP, & INDEX TO DRAWINGS |
| 2    | PLAN AND PROFILE - STA 708+68 TO STA 781+00     |
| 3    | PLAN AND PROFILE - STA 781+00 TO STA 847+83.62  |
| 4    | PLAN AND PROFILE - STA 847+83.62 TO STA 945+87  |
| 5    | DESIGN SECTIONS                                 |
| 6    | ENDS OF PROJECT DETAILS                         |
| 7    | HYDROGRAPHS                                     |
| 8    | SOIL BORINGS                                    |
| 9    | SOIL BORING LEGEND                              |

**NOTE:**  
DRAWINGS IN THIS FOLIO  
HAVE BEEN REDUCED ONE  
HALF THE ORIGINAL SCALE


AS BUILT  
CONTRACT 8300195

| B. M.         | ELEVATION      | LOCATION AND DESCRIPTION                                                                                                                                                                                                                                                                                                                                                                                                                            |
|---------------|----------------|-----------------------------------------------------------------------------------------------------------------------------------------------------------------------------------------------------------------------------------------------------------------------------------------------------------------------------------------------------------------------------------------------------------------------------------------------------|
| P.B.M. 780+00 | 7.692' M.S.L.  | MARK IS TOP OF BRASS CAP SET ON A BRASS ROD DRIVEN 90 FEET INTO THE GROUND ENCASED IN CONCRETE ON SOUTH BANK OF MISSISSIPPI RIVER-GULF OUTLET; APPROXIMATELY 173 FEET LANDSIDE OF STATION 780+00 MISSISSIPPI RIVER-GULF OUTLET BASELINE. CAP IS STAMPED P.B.M. 780+00-173 1977.                                                                                                                                                                     |
| P.B.M. TED    | 7.881' M.S.L.  | GALVANIZED PIPE, 1 1/2 INCHES IN DIAMETER, WAS SET IN BORE HOLE AT A DEPTH OF 95 FEET. THE 1/2-INCH DIAMETER PIPE WAS THEN DRIVEN AN ADDITIONAL 10.5 FEET INTO STRATA. P.B.M. IS ON THE EAST SIDE OF BAYOU DUPRE, SOUTH SIDE OF THE STRUCTURE, 105 FEET FROM BAYOU DUPRE AND 282 FEET FROM THE WALL OF THE STRUCTURE. THE 1 1/2 INCH PIPE IS PROTECTED BY 3-INCH DIAMETER GALVANIZED PIPE WITH CAP AND THREE 1 1/2-INCH GUARD POSTS PAINTED YELLOW. |
| P.B.M. 945+00 | 10.334' M.S.L. | MARK IS TOP OF BRASS CAP SET ON A BRASS ROD DRIVEN 95 FEET INTO THE GROUND ENCASED IN CONCRETE ON SOUTH BANK OF MISSISSIPPI RIVER-GULF OUTLET; APPROXIMATELY 176 FEET LANDSIDE OF STATION 940+00 MISSISSIPPI RIVER-GULF OUTLET BASELINE. CAP IS STAMPED P.B.M. 940+00-176 1977.                                                                                                                                                                     |

LAKE LERY  
LOCATION MAP  
SCALE IN MILES

LAKE PONTCHARTRAIN, LOUISIANA AND CHALMETTE AREA PLAN, CHALMETTE HURRICANE PROTECTION LEVEE SECOND ENLARGEMENT

VICINITY EXTENSION LEVEE

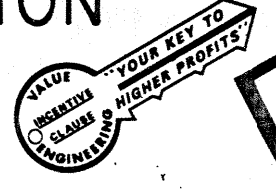

Safety is a Part of Your Contract

| REVISION | DATE | DESCRIPTION | BY |
|----------|------|-------------|----|
|          |      |             |    |


U. S. ARMY ENGINEER DISTRICT, NEW ORLEANS  
CORPS OF ENGINEERS  
NEW ORLEANS, LA.

LAKE PONTCHARTRAIN, LOUISIANA AND VICINITY CHALMETTE AREA PLAN, CHALMETTE EXTENSION HURRICANE PROTECTION LEVEE SECOND ENLARGEMENT  
BL STA. 708+68 TO BL STA. 945+87  
ST. BERNARD PARISH, LA.


LOCATION MAP, VICINITY MAP AND INDEX TO DRAWINGS

|          |        |         |           |          |           |
|----------|--------|---------|-----------|----------|-----------|
| DESIGNED | DRAWN  | CHECKED | DATE      | SCALE    | FILE NO.  |
| R.W.W.   | L.A.H. | R.P.L.  | MAR. 1968 | AS SHOWN | H-8-29520 |


DATE SUBMITTED: MAR. 1968  
SPEC. NO. DACW29-83-B-0053  
DWS 1 OF 9

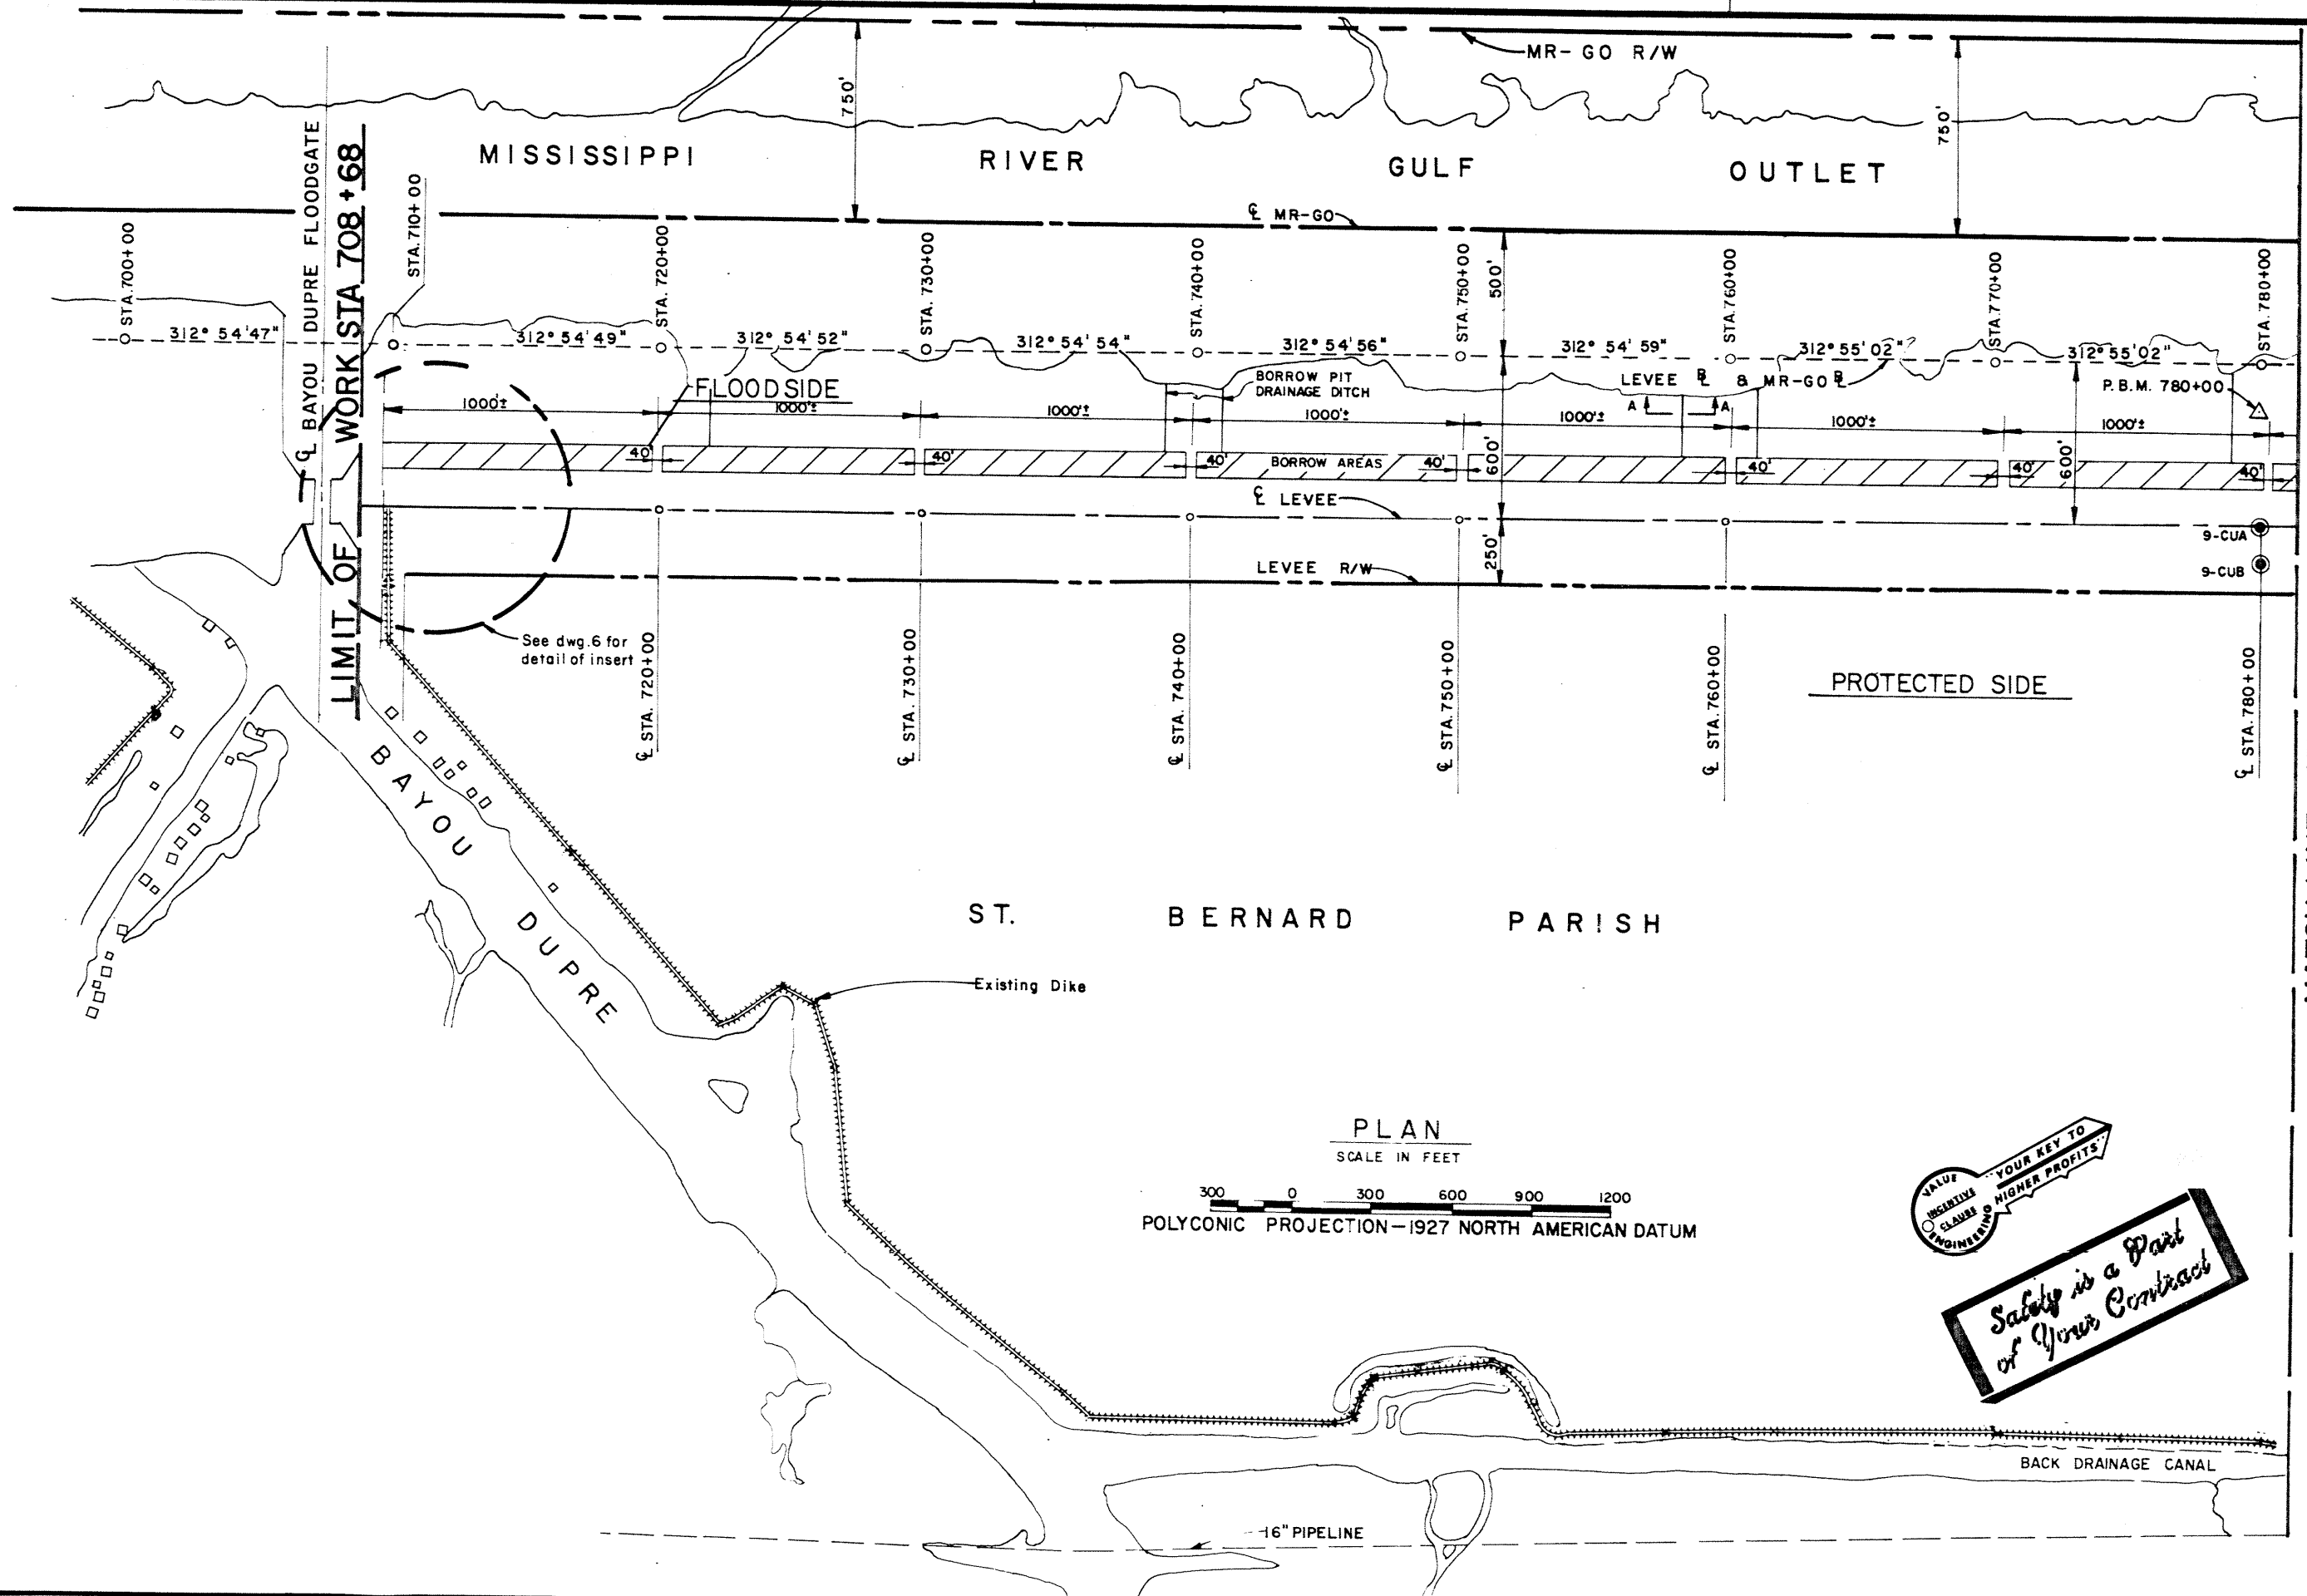

PLAN  
SCALE IN FEET  
POLYCONIC PROJECTION-1927 NORTH AMERICAN DATUM

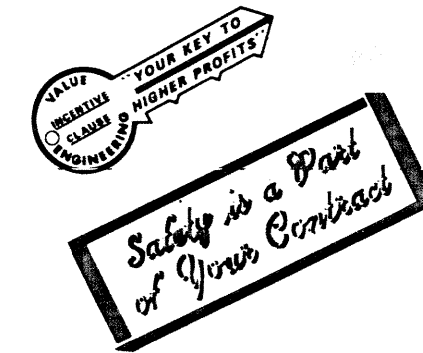

MATCH LINE STA. 781+00 DWG. 3

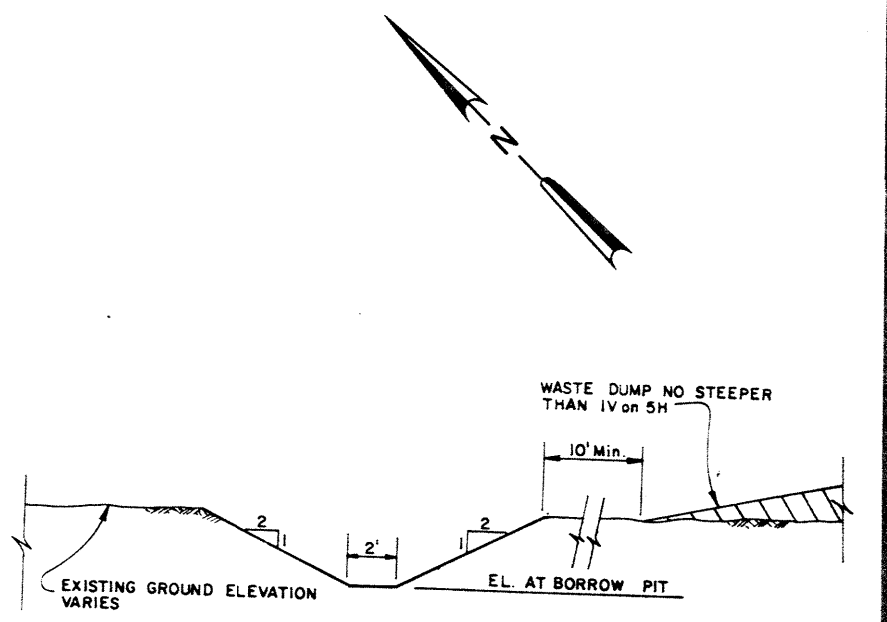


- NOTES:
1. SLOPE DITCH 0.2% FROM BORROW PIT TO MR-GO.
  2. EXCAVATED MATERIAL MAY BE PILED ON EITHER OR BOTH SIDES OF THE DITCH.
  3. THIS SECTION APPLICABLE FOR ENTIRE JOB.

SECTION A-A  
DRAINAGE DITCH


- GENERAL NOTES:
1. ALL ELEVATIONS SHOWN ARE REFERENCED TO NATIONAL GEODETIC VERTICAL DATUM (N.G.V.D.).
  2. AZIMUTHS SHOWN ARE MEASURED IN A CLOCKWISE DIRECTION FROM THE SOUTH.
  3. SEE DWG 1 FOR "BENCH MARK" DESCRIPTION.
  4. THE 40-FOOT ACCESS STRIPS THAT TRAVERSE THE BORROW AREA ARE TO BE FIELD LOCATED BY THE CONTRACTING OFFICER (CO).
  5. DITCHES FROM THE BORROW AREA TO THE MR-GO ARE TO BE FIELD LOCATED BY THE CO.
  6. BORROW EXCAVATION SHALL START AT THE BACK SIDE OF THE BORROW AREA AND SHALL BE EXCAVATED IN SUCH A MANNER THAT NO AREA OF BORROW WILL BE BYPASSED OR ISOLATED. AFTER CONSTRUCTION IS COMPLETE, THE REMAINING BORROW WILL BE LEFT IN A UNIFORM ALLURMENT THAT WILL BE EASILY ACCESSIBLE FOR FUTURE WORK. THE CONTRACTOR'S PLAN AND SEQUENCE OF BORROW EXCAVATION SHALL BE SUBMITTED TO THE CO FOR APPROVAL PRIOR TO ANY EXCAVATION.
  7. FOR LIMITS OF AVAILABLE BORROW SEE DRAWING 5.
  8. SETTLEMENT PLATE DETAILS ARE ON DRAWING 5.
  9. LEVEE C/L STATIONING IS THE SAME AS THE MR-GO R/L STATIONING EXCEPT FOR THE CURVE SECTION SHOWN ON DRAWING 3.
  10. DRAWING DIMENSIONS ARE AS SHOWN.

LEGEND  
UNDISTURBED BORING (circle with dot)  
SETTLEMENT PLATE (X)

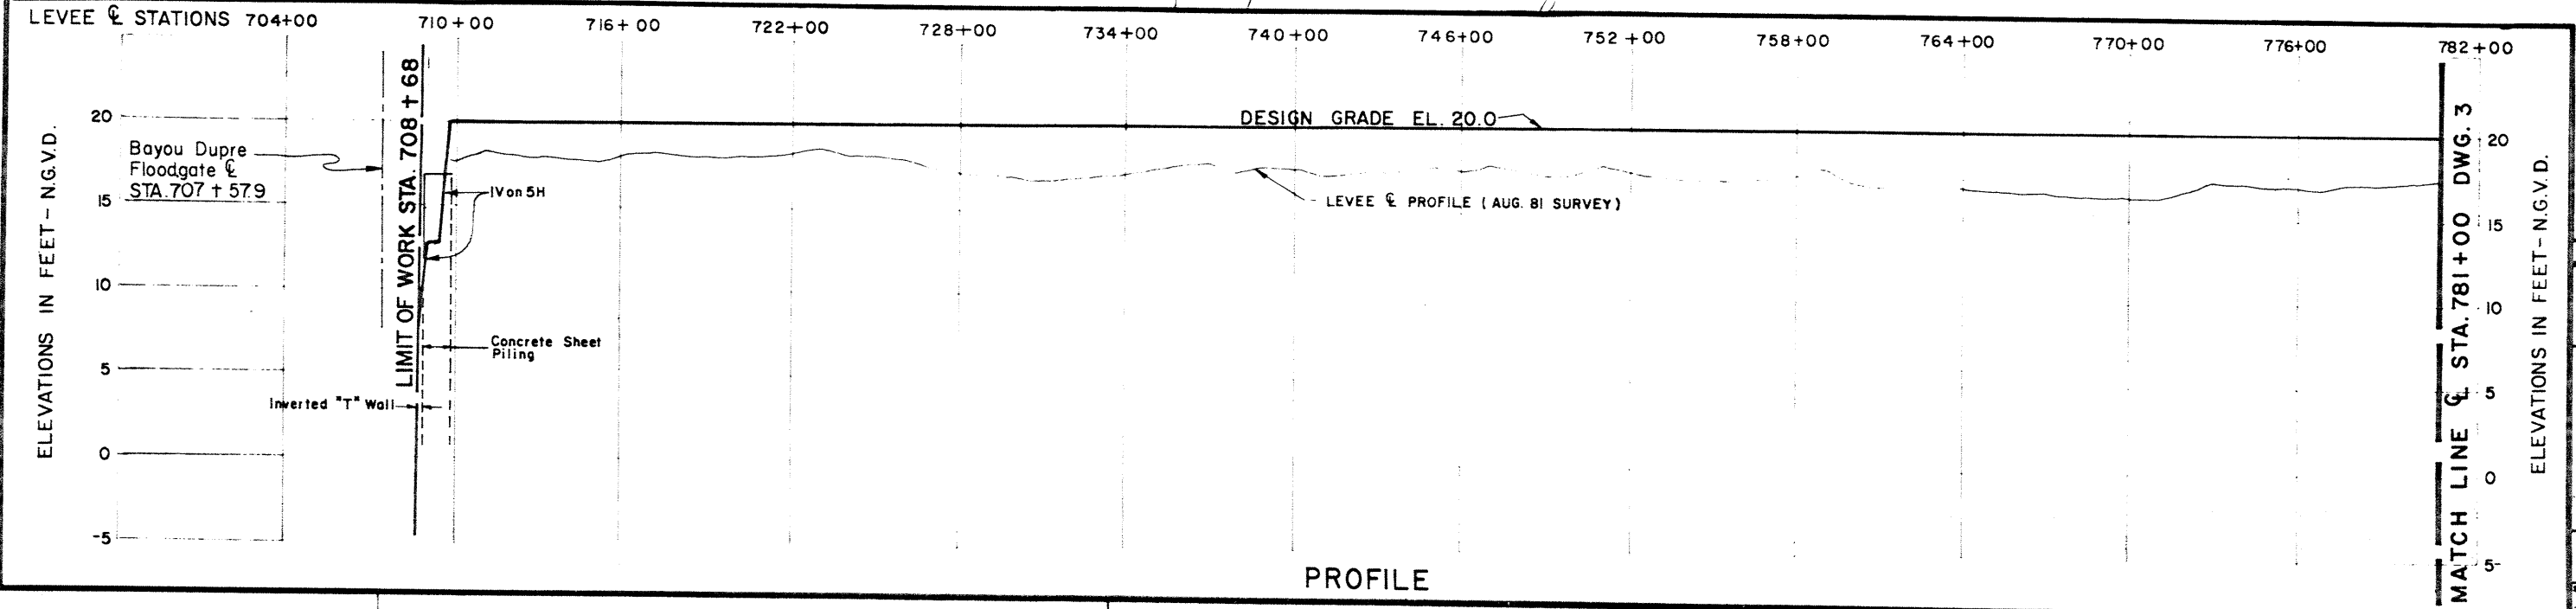



PROFILE

| REVISION                                                                                                                                                                                            | DATE             | DESCRIPTION           | BY                 |
|-----------------------------------------------------------------------------------------------------------------------------------------------------------------------------------------------------|------------------|-----------------------|--------------------|
| U. S. ARMY ENGINEER DISTRICT, NEW ORLEANS<br>CORPS OF ENGINEERS<br>NEW ORLEANS, LA.                                                                                                                 |                  |                       |                    |
| LAKE PONTCHARTRAIN, LOUISIANA AND VICINITY<br>CHALMETTE AREA PLAN, CHALMETTE EXTENSION<br>HURRICANE PROTECTION LEVEE<br>SECOND ENLARGEMENT<br>STA. 708+68 TO STA. 945+87<br>ST. BERNARD PARISH, LA. |                  |                       |                    |
| <b>PLAN AND PROFILE</b><br><b>STA. 708+68 TO STA. 781+00</b>                                                                                                                                        |                  |                       |                    |
| DESIGNED:<br>R.W.W.                                                                                                                                                                                 | DRAWN:<br>V.L.W. | CHECKED:<br>R.P.L.    | DATE:<br>MAR. 1983 |
| SCALE:<br>AS SHOWN                                                                                                                                                                                  |                  | FILE NO.<br>H-8-29520 |                    |
| SUBMITTED:<br>DACW29-83-B-0053                                                                                                                                                                      |                  | DWG. 2 OF 9           |                    |

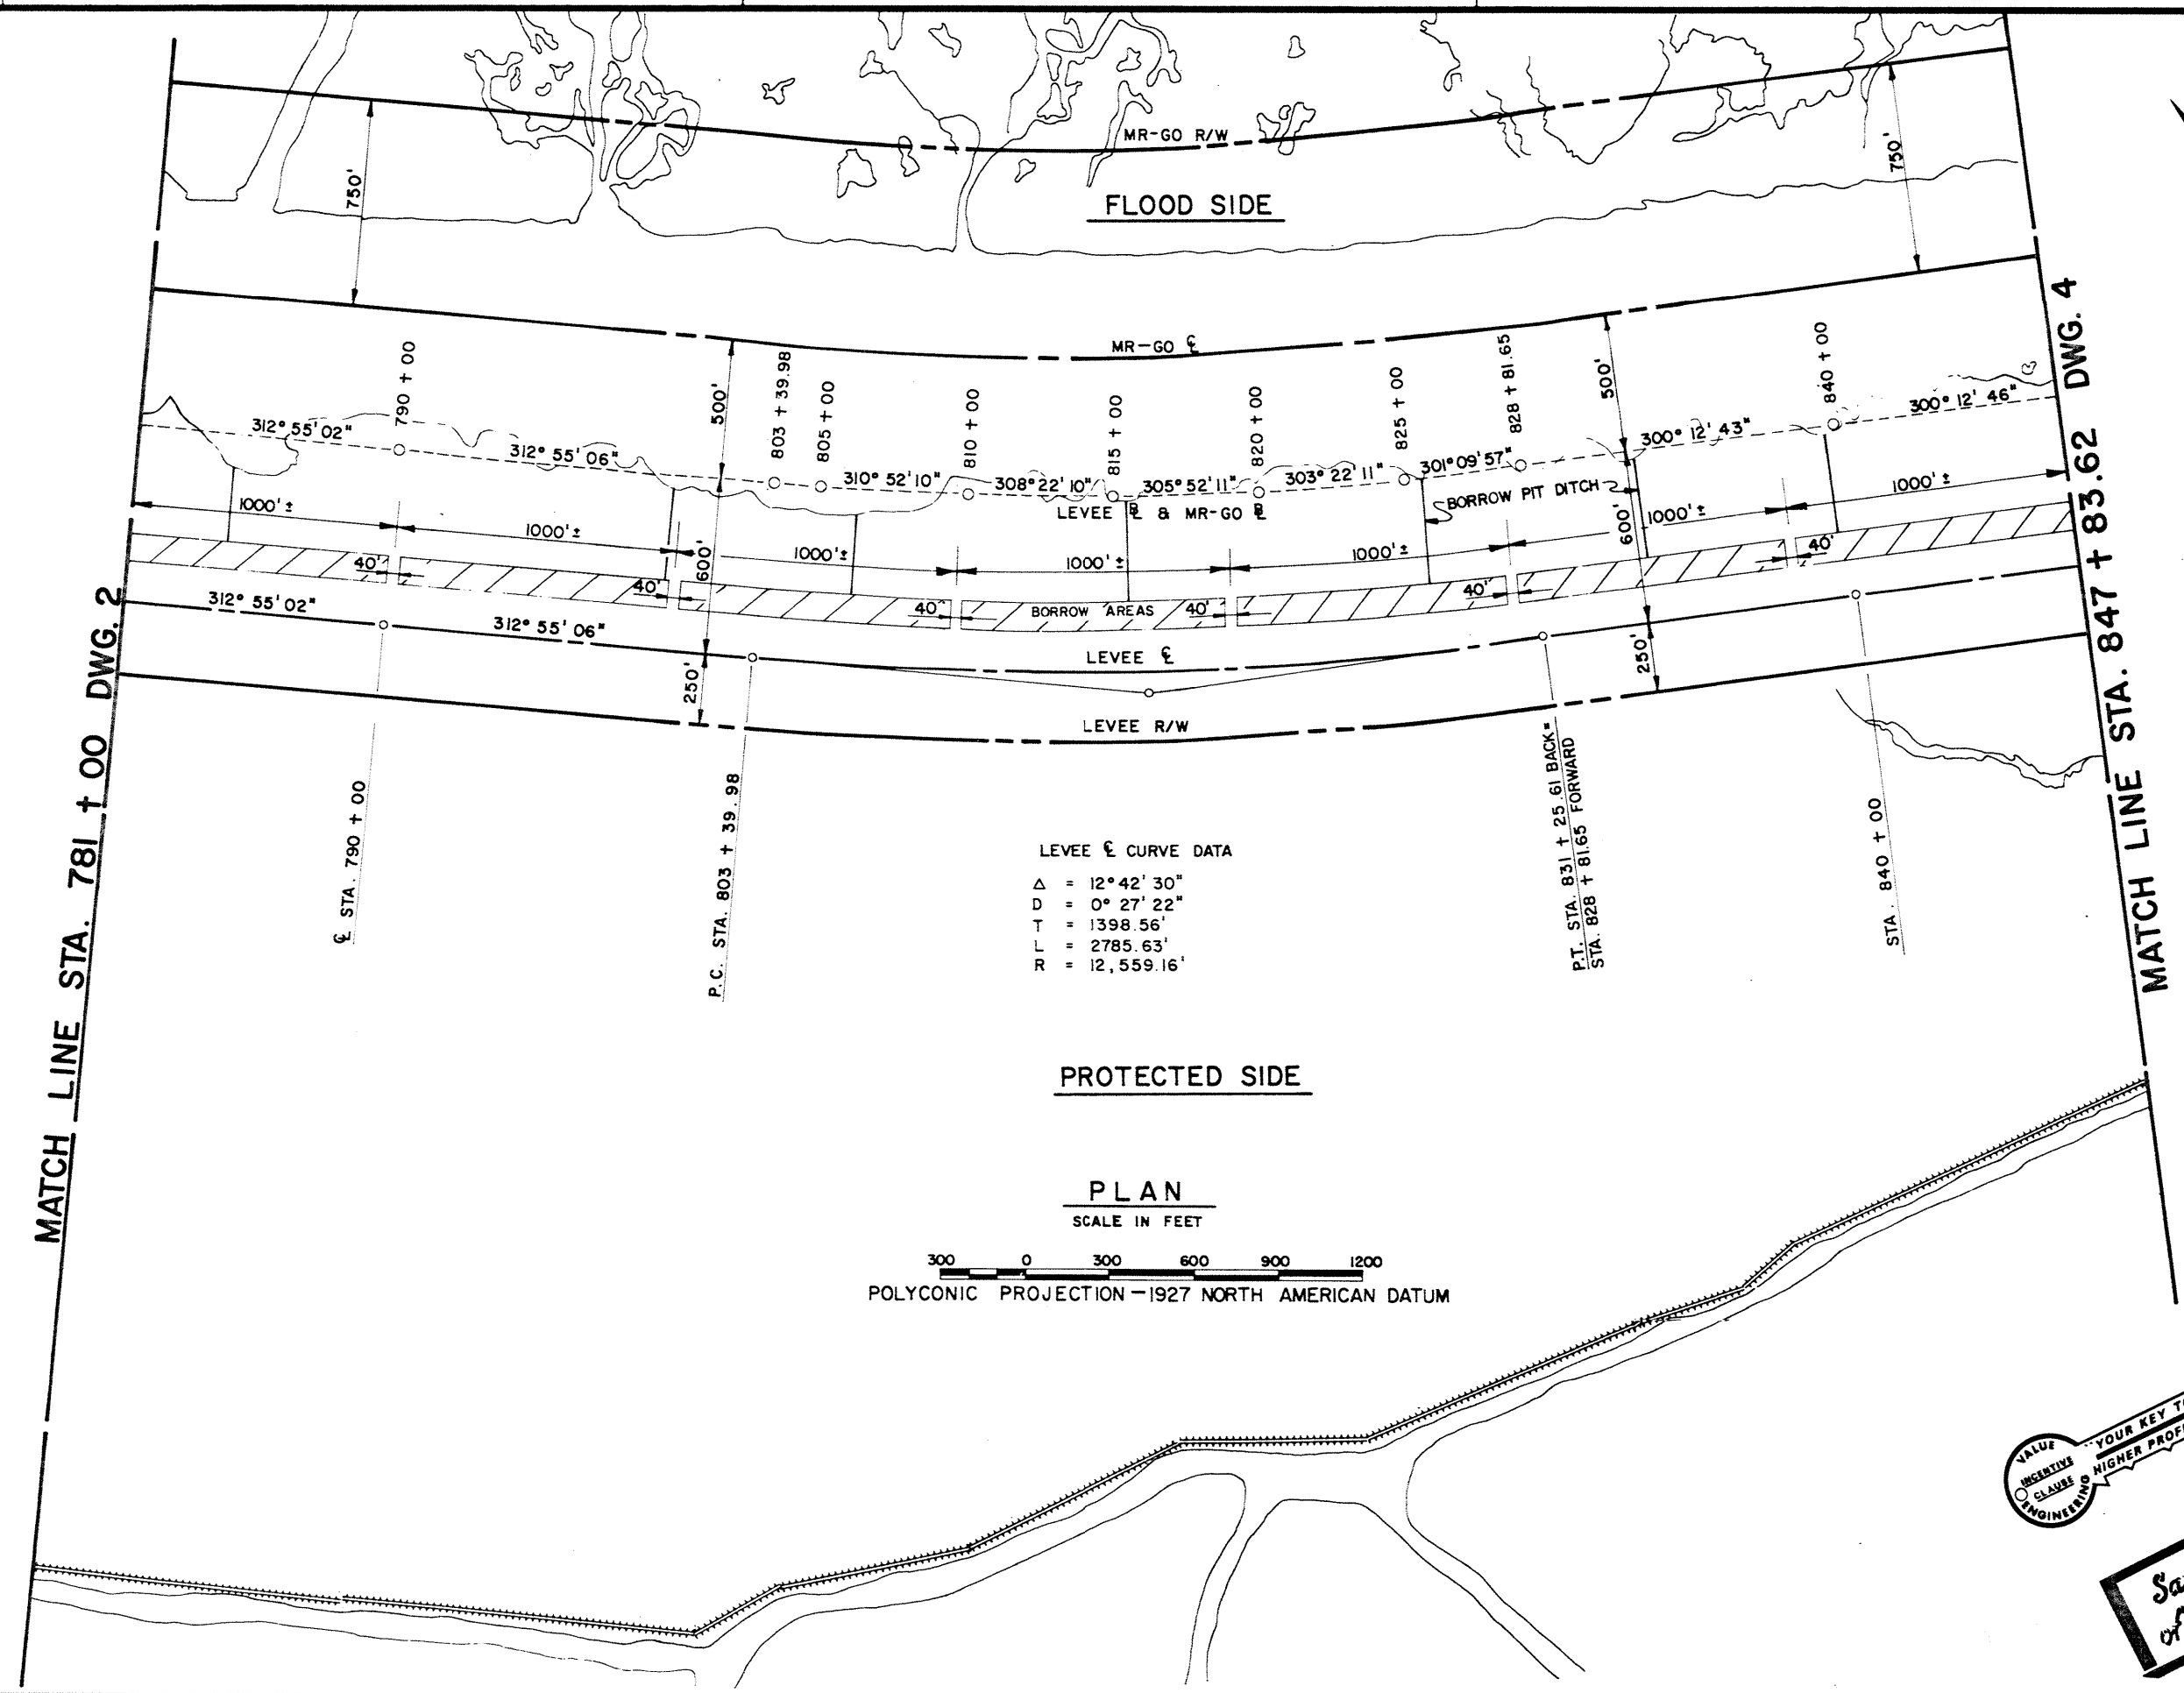

**PLAN**  
SCALE IN FEET  
300 0 300 600 900 1200  
POLYCONIC PROJECTION - 1927 NORTH AMERICAN DATUM

- NOTES:
1. FOR GENERAL NOTES & LEGEND SEE DWG. 2.
  2. FOR BORROW PIT DRAINAGE DETAILS SEE DWG. 2.
  3. MR GO B/L STATIONING AND LEVEE C/L STATIONING ARE THE SAME EXCEPT THRU THE CURVE SECTION AS SHOWN.

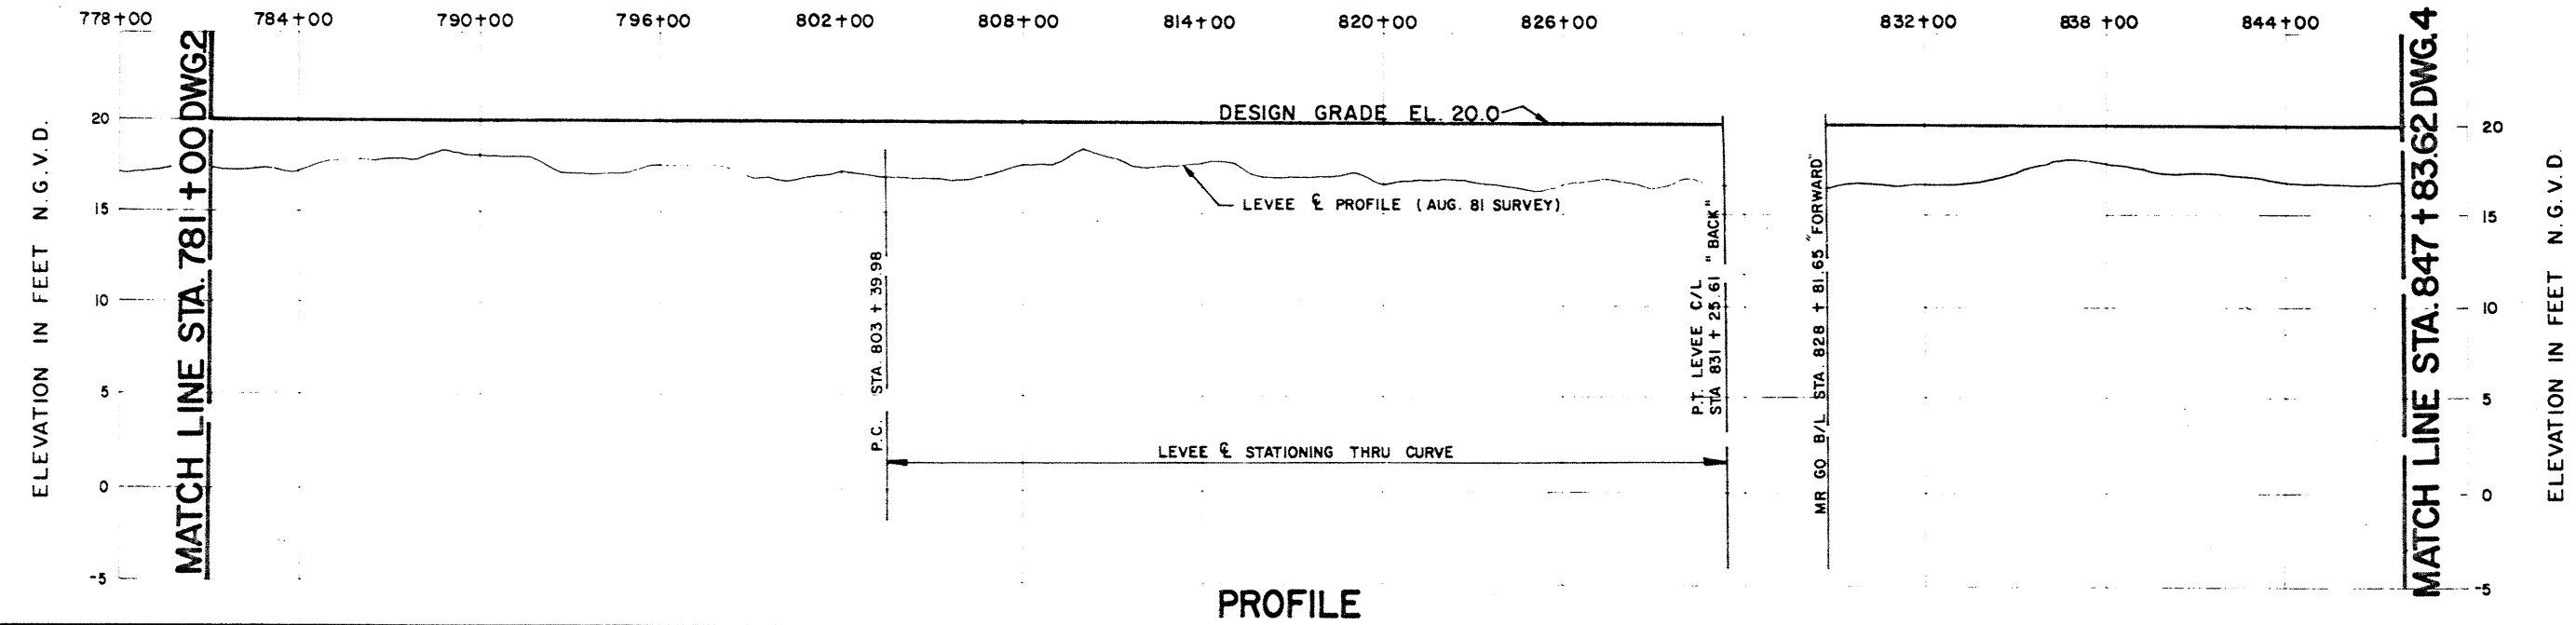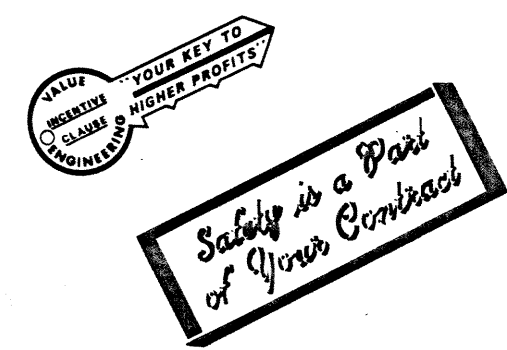


**PROFILE**


| REVISION                                                                                                                                                                                                | DATE               | DESCRIPTION                | BY              |
|---------------------------------------------------------------------------------------------------------------------------------------------------------------------------------------------------------|--------------------|----------------------------|-----------------|
| U. S. ARMY ENGINEER DISTRICT, NEW ORLEANS<br>CORPS OF ENGINEERS<br>NEW ORLEANS, LA.                                                                                                                     |                    |                            |                 |
| LAKE PONTCHARTRAIN, LOUISIANA AND VICINITY<br>CHALMETTE AREA PLAN, CHALMETTE EXTENSION<br>HURRICANE PROTECTION LEVEE<br>SECOND ENLARGEMENT<br>STA. 708 + 68 TO STA. 945 + 87<br>ST. BERNARD PARISH, LA. |                    |                            |                 |
| <b>PLAN AND PROFILE</b><br><b>STA. 781 + 00 TO STA. 847 + 83.62</b>                                                                                                                                     |                    |                            |                 |
| DESIGNED: R.W.W.                                                                                                                                                                                        | DRAWN: L.A.H.      | CHECKED: R.P.L.            | DATE: MAR. 1983 |
| SCALE: AS SHOWN                                                                                                                                                                                         | FILE NO: H-8-29520 | SPEC. NO. DACW29-83-B-0053 |                 |
| DWG. 3                                                                                                                                                                                                  |                    | OF 9                       |                 |




MATCH LINE STA. 847 + 83.62 DWG. 3

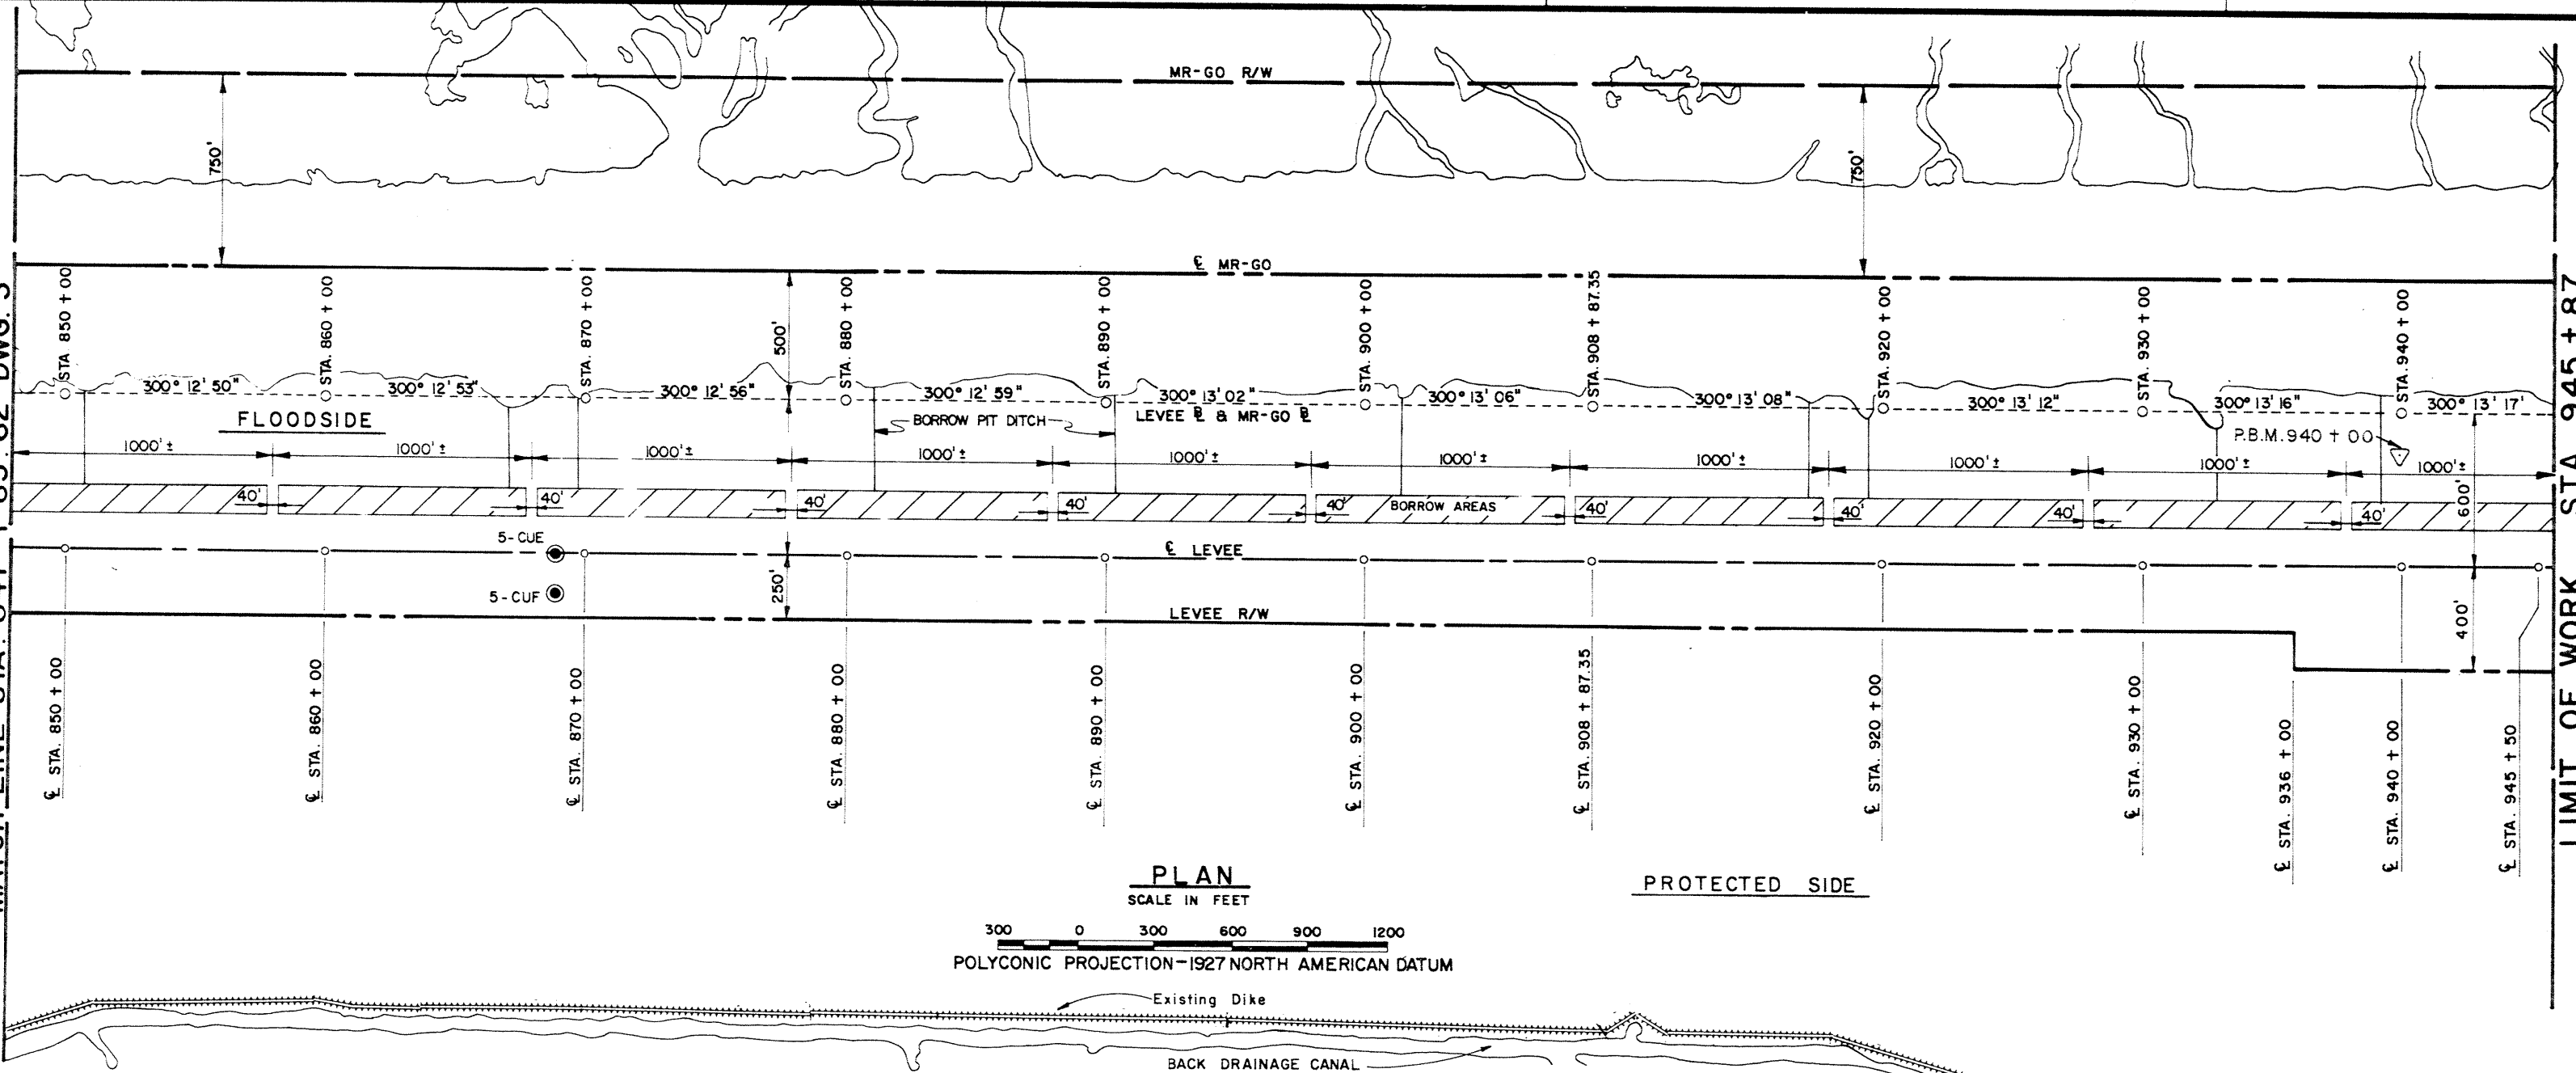

**PLAN**  
SCALE IN FEET  
POLYCONIC PROJECTION-1927 NORTH AMERICAN DATUM

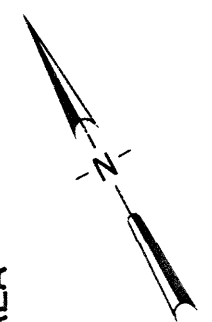

LIMIT OF WORK STA. 945 + 87  
SEE DWG. 6 FOR DETAILS THIS AREA

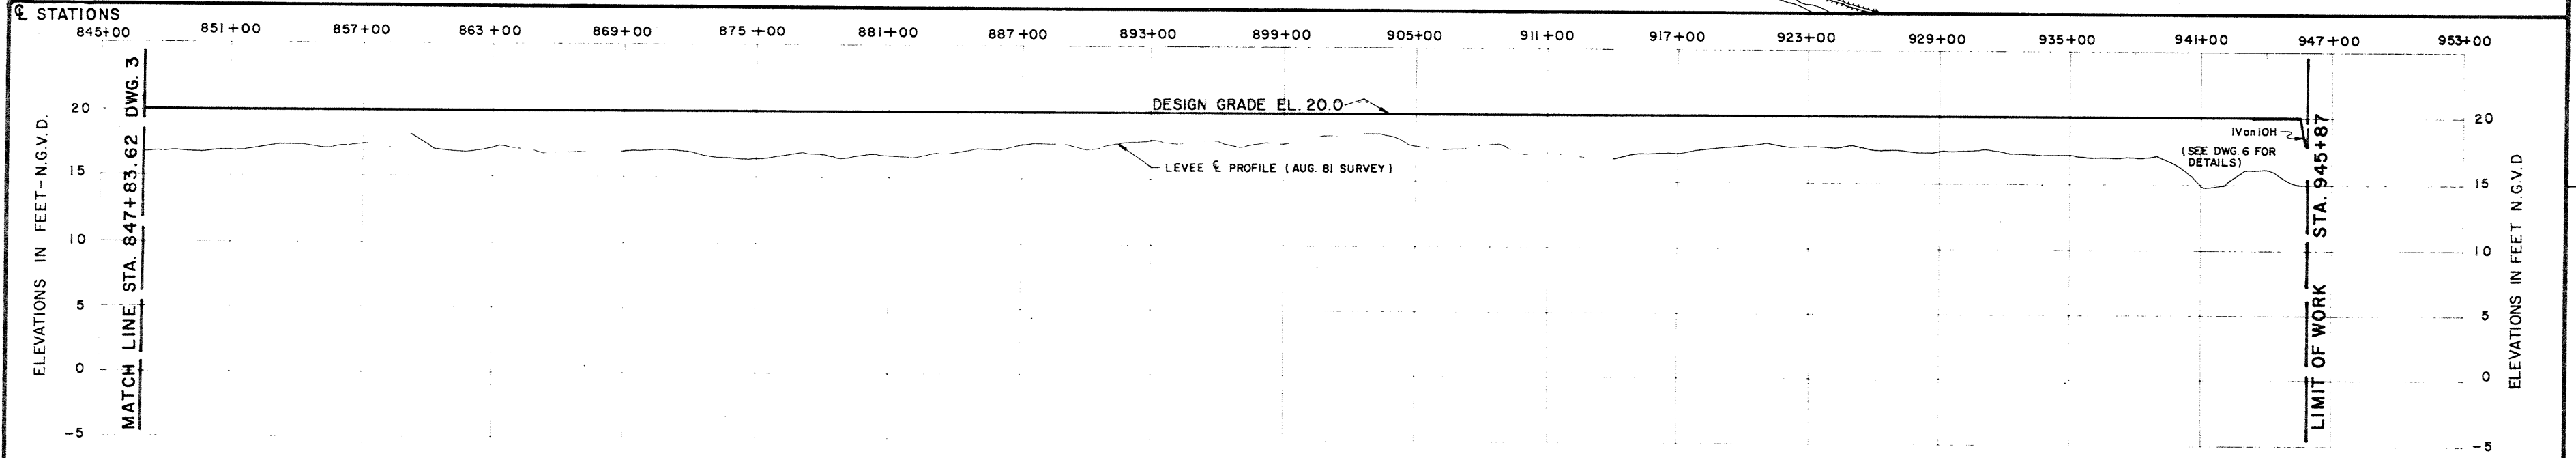


**PROFILE**

- NOTES:
1. FOR GENERAL NOTES & LEGEND SEE DWG. 2.
  2. DETAILS OF BORROW PIT DITCHES ARE ON DWG. 2.
  3. ALL DRAWING DIMENSIONS ARE AS SHOWN.
  4. THERE IS AN ONGOING LEVEE CONTRACT THAT STARTS AT STA. 945+72. THE CONTRACTOR ON THIS PROJECT SHALL SCHEDULE HIS WORK IN SUCH MANNER THAT A CONFLICT WILL NOT DEVELOP WITH THE ONGOING CONTRACTOR.



| REVISION                                                                                                                                                                                                | DATE             | DESCRIPTION | BY        |
|---------------------------------------------------------------------------------------------------------------------------------------------------------------------------------------------------------|------------------|-------------|-----------|
| U.S. ARMY ENGINEER DISTRICT, NEW ORLEANS<br>CORPS OF ENGINEERS<br>NEW ORLEANS, LA.                                                                                                                      |                  |             |           |
| LAKE PONTCHARTRAIN, LOUISIANA AND VICINITY<br>CHALMETTE AREA PLAN, CHALMETTE EXTENSION<br>HURRICANE PROTECTION LEVEE<br>SECOND ENLARGEMENT<br>STA. 708 + 68 TO STA. 945 + 87<br>ST. BERNARD PARISH, LA. |                  |             |           |
| <b>PLAN AND PROFILE</b><br><b>STA. 847 + 83.62 TO STA. 945 + 87</b>                                                                                                                                     |                  |             |           |
| DESIGNED:                                                                                                                                                                                               | DRAWN:           | CHECKED:    | DATE:     |
| R.W.W.                                                                                                                                                                                                  | L.A.H.           | R.P.L.      | MAR. 1983 |
| SUBMITTED:                                                                                                                                                                                              | SPEC. NO.        | SCALE:      | FILE NO.  |
|                                                                                                                                                                                                         | DACW29-83-B-0053 | AS SHOWN    | H-8-29520 |
|                                                                                                                                                                                                         |                  |             | 4 OF 9    |

SUTHERLAND CORP.

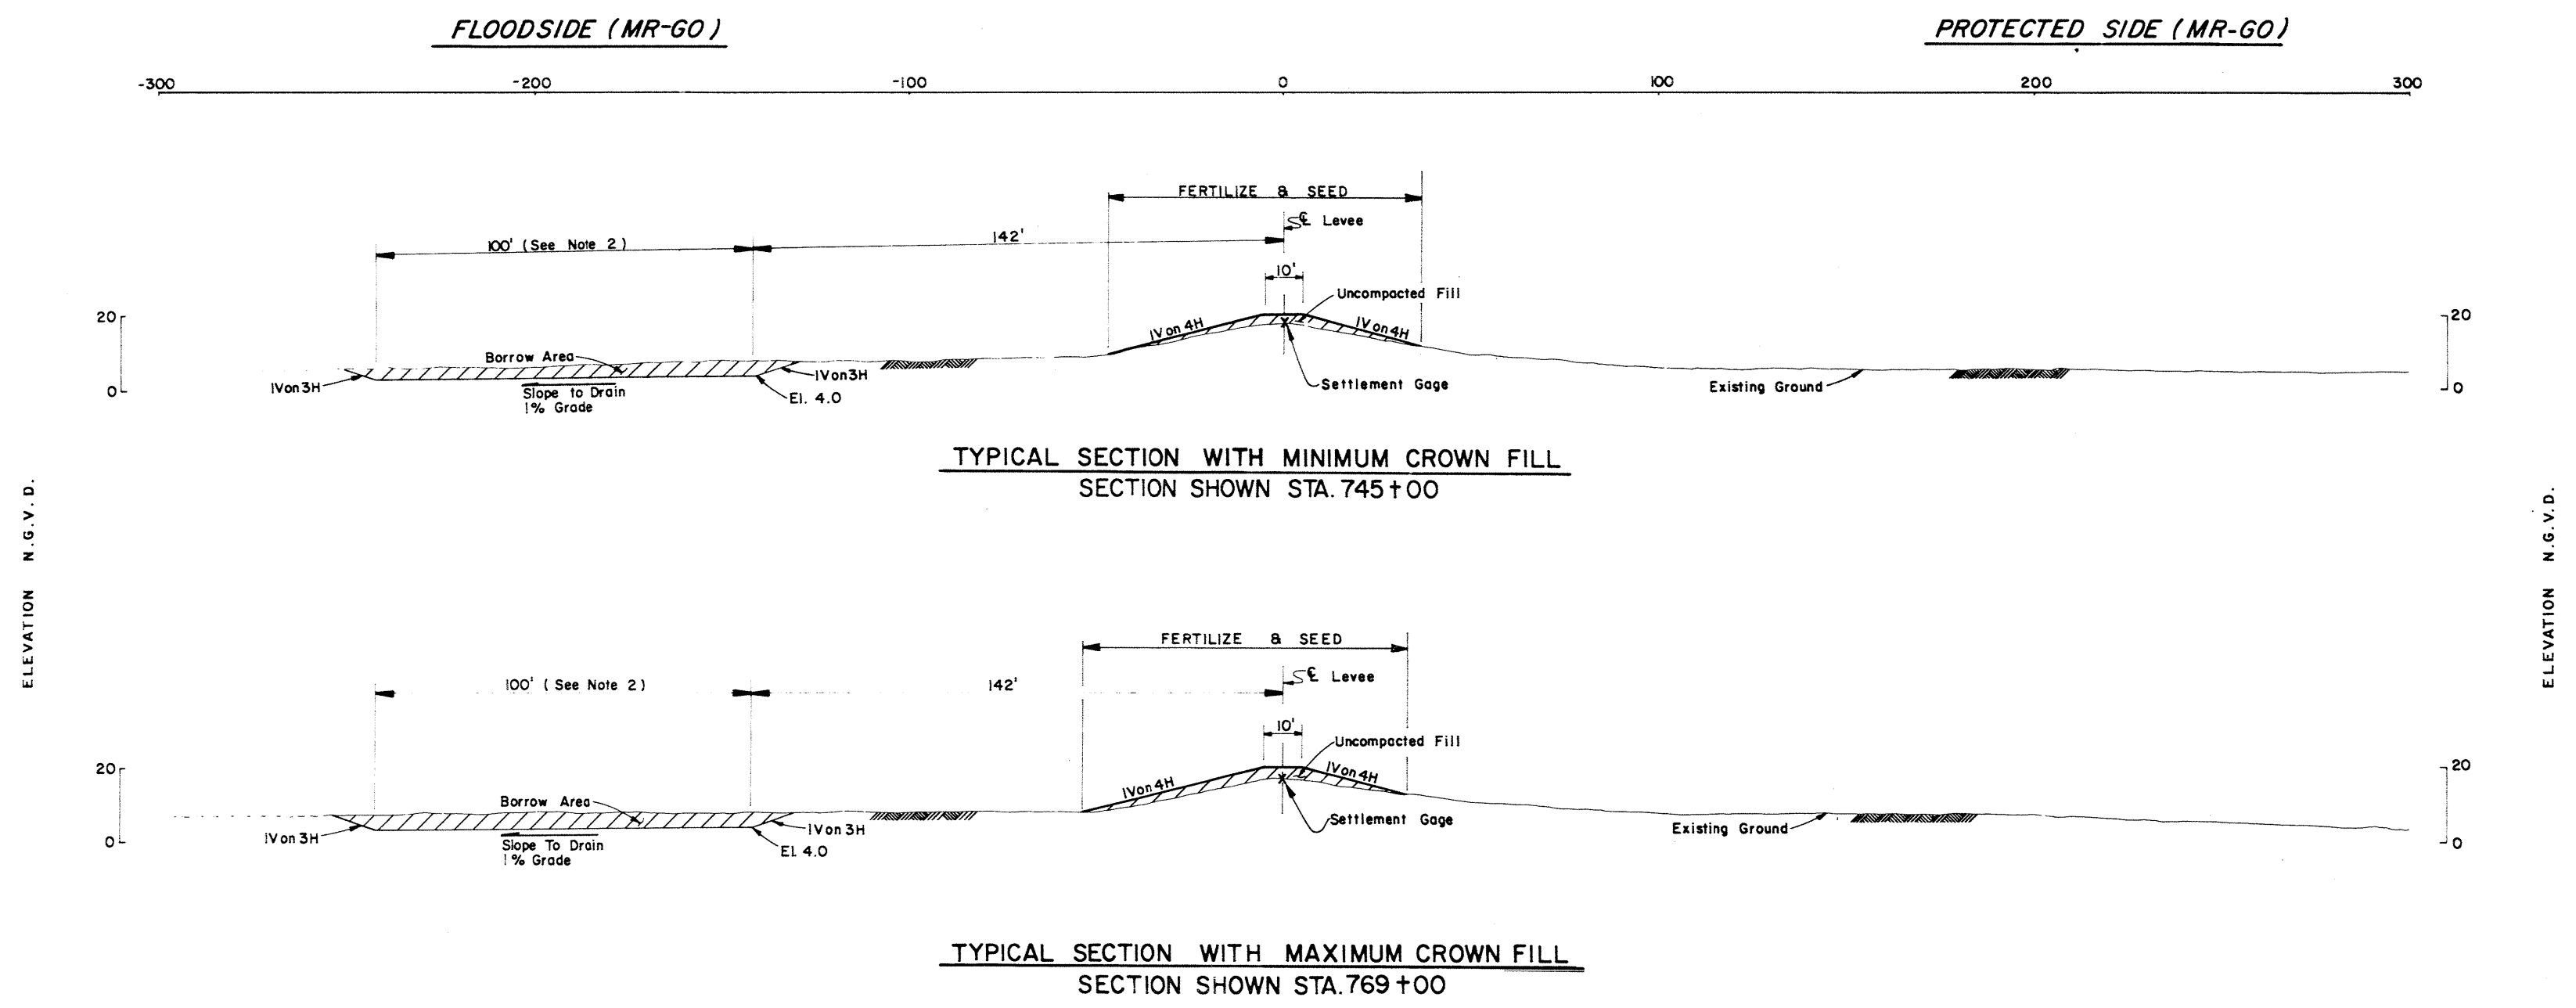


- NOTES:
1. For general notes and legend, see dwg. 2.
  2. It is anticipated that borrow within the limits shown will be adequate to provide adjacent borrow throughout the project. Should additional adjacent borrow be required due to unsuitable material or for any other unforeseen reasons, the floodside limit of the borrow area may be extended as required to obtain suitable borrow. Before the borrow limits are extended, for any reason, the Contractor shall submit an excavation plan to the C.O.R. for approval.
  3. Plan views of sections shown are on dwg. 2.
  4. All drawing dimensions are as shown.

**SETTLEMENT GAGE SPECIFICATIONS**

SHOULD THE CONTRACTOR DESIRE PAYMENT FOR PLACING ADDITIONAL FILL DUE TO FOUNDATION SETTLEMENT DURING CONSTRUCTION HE SHALL FURNISH AND INSTALL SETTLEMENT GAGES AT THE LOCATIONS SHOWN ON THE DESIGN SECTION IN CONFORMANCE WITH THE PROVISIONS OF SECTION 3 OF THE SPECIFICATIONS.


THE SETTLEMENT MEASUREMENT RANGE FOR EACH SETTLEMENT GAGE SHALL BE FOR A DISTANCE OF 250 FEET IN EACH DIRECTION FROM EACH SETTLEMENT GAGE MEASURED ALONG THE CENTERLINE OF THE LEVEE, EXCEPT WHERE SETTLEMENT GAGES ARE PLACED AT LESS THAN 500 FOOT INTERVALS, IN WHICH CASE, THE SETTLEMENT MEASUREMENT RANGE SHALL BE TO A POINT 1/2 THE DISTANCE BETWEEN SETTLEMENT GAGES.

1/8" STEELPLATE  
MINIMUM 2' x 2'

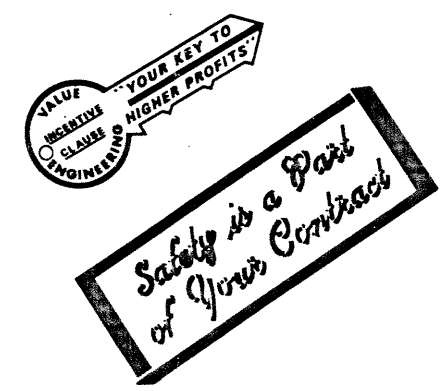


| REVISION                                                                                                                                                                                               | DATE             | DESCRIPTION                   | BY                 |
|--------------------------------------------------------------------------------------------------------------------------------------------------------------------------------------------------------|------------------|-------------------------------|--------------------|
| U.S. ARMY ENGINEER DISTRICT, NEW ORLEANS<br>CORPS OF ENGINEERS<br>NEW ORLEANS, LA.                                                                                                                     |                  |                               |                    |
| LAKE PONTCHARTRAIN, LOUISIANA AND VICINITY<br>CHALMETTE AREA PLAN, CHALMETTE EXTENSION<br>HURRICANE PROTECTION LEVEE<br>SECOND ENLARGEMENT<br>STA. 708 + 68 TO STA 945 + 87<br>ST. BERNARD PARISH, LA. |                  |                               |                    |
| <b>TYPICAL DESIGN SECTIONS</b>                                                                                                                                                                         |                  |                               |                    |
| DESIGNED:<br>R.W.W.                                                                                                                                                                                    | DRAWN:<br>L.A.H. | CHECKED:<br>R.P.L.            | DATE:<br>MAR. 1983 |
| SCALE:<br>AS SHOWN                                                                                                                                                                                     |                  | FILE NO.<br>H-8-29520         |                    |
| SUBMITTED:<br>[Signature]                                                                                                                                                                              |                  | SPEC. NO.<br>DACW29-83-B-0053 |                    |
|                                                                                                                                                                                                        |                  | DWS 5 OF 9                    |                    |

ELEVATION N.G.V.D.

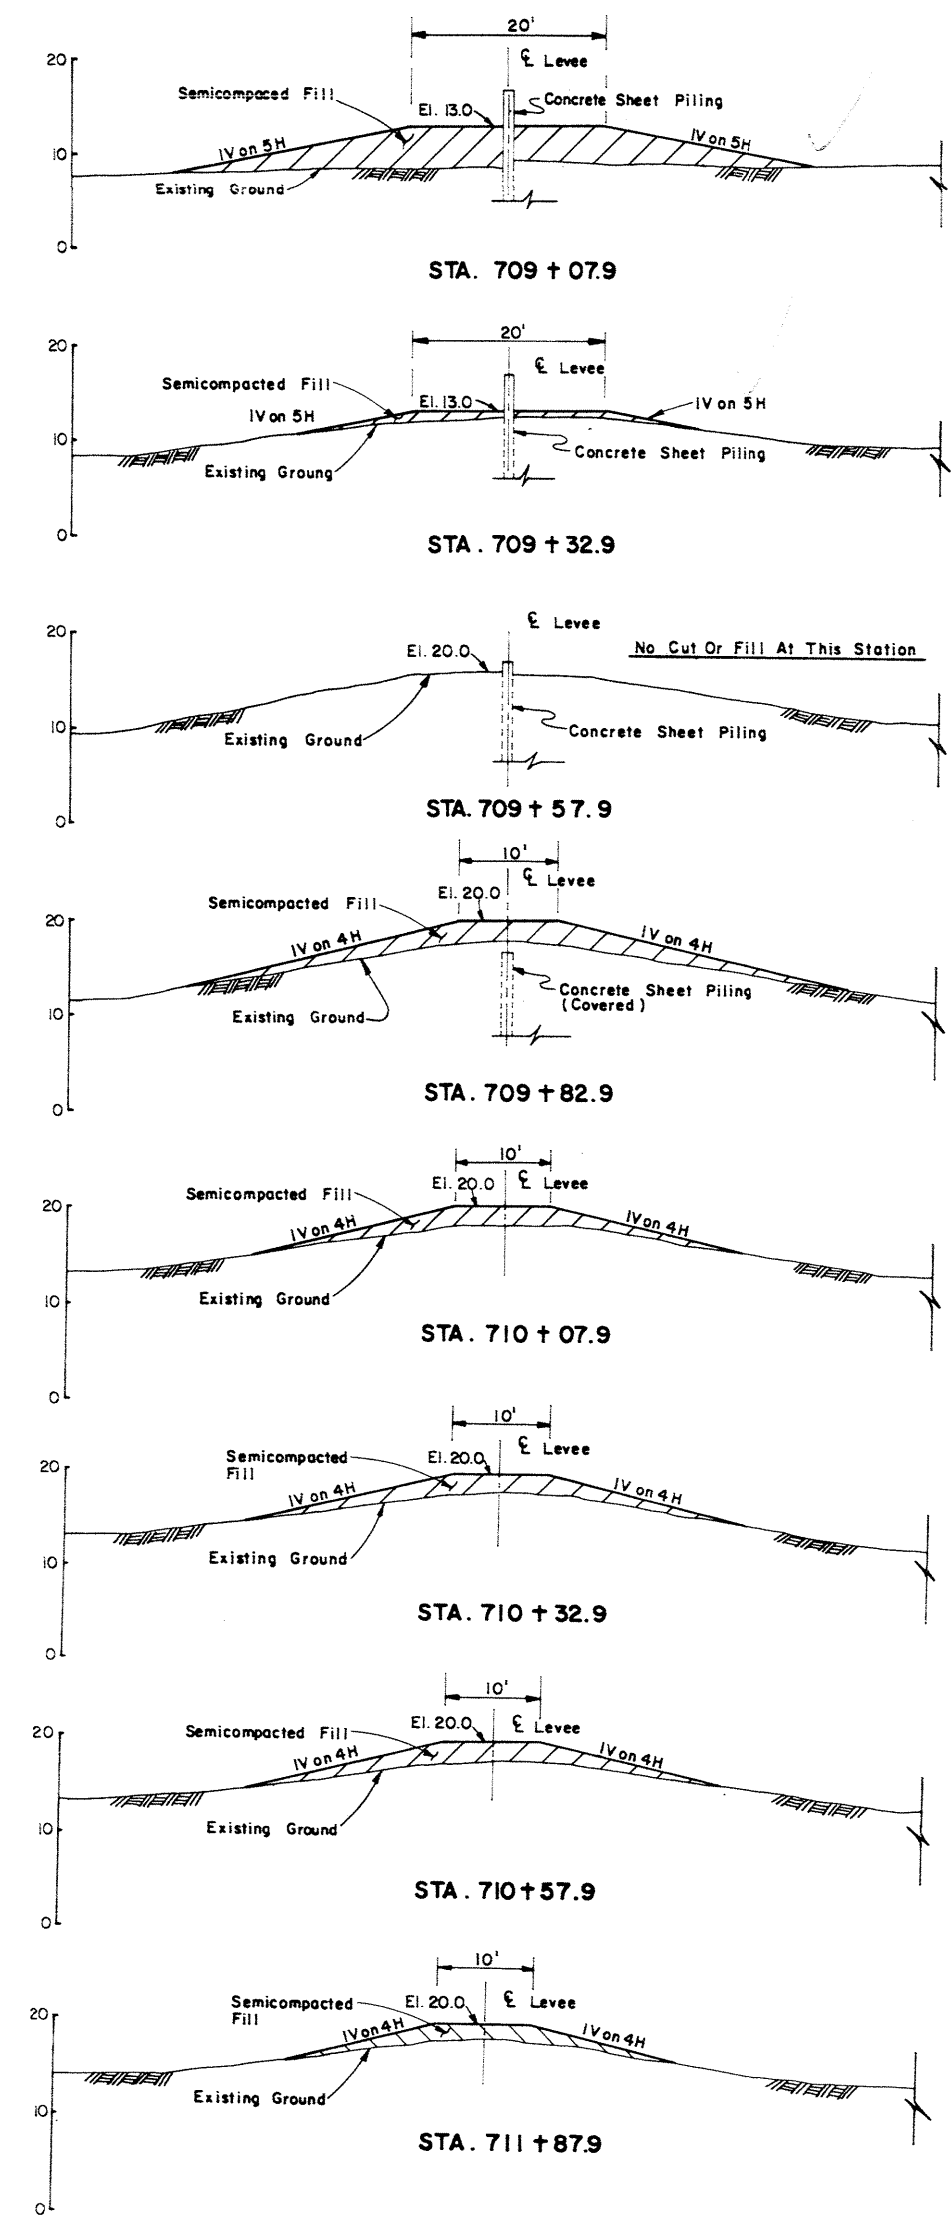


ABOVE LEVEE CROSS SECTIONS TAKEN AT STATIONS INDICATED  
SCALE 1" = 10'


E. BAYOU DUPRE STRUCTURE 707 + 57.9

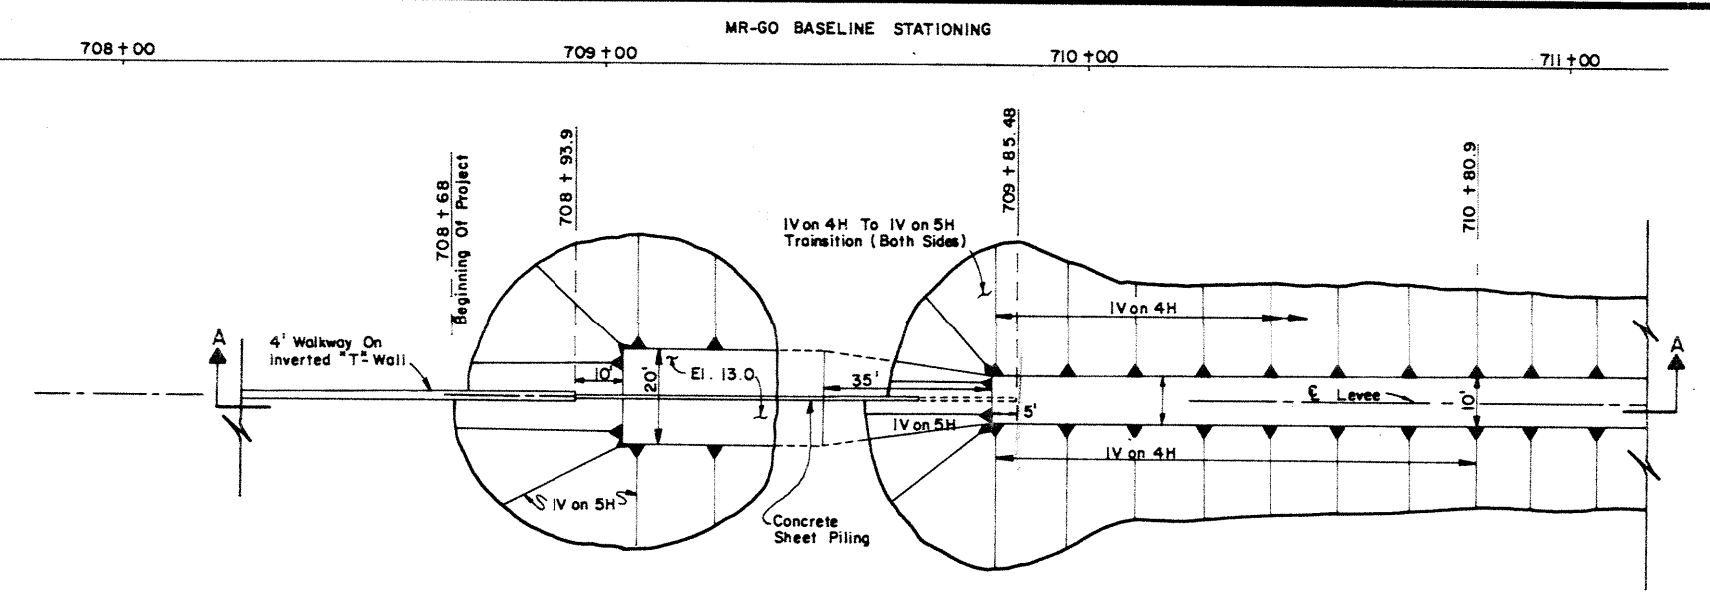

PLAN VIEW  
DETAIL OF HURRICANE PROTECTION LEVEE  
TIE-IN TO BAYOU DUPRE FLOOD CONTROL  
STRUCTURE  
SCALE 1" = 20'

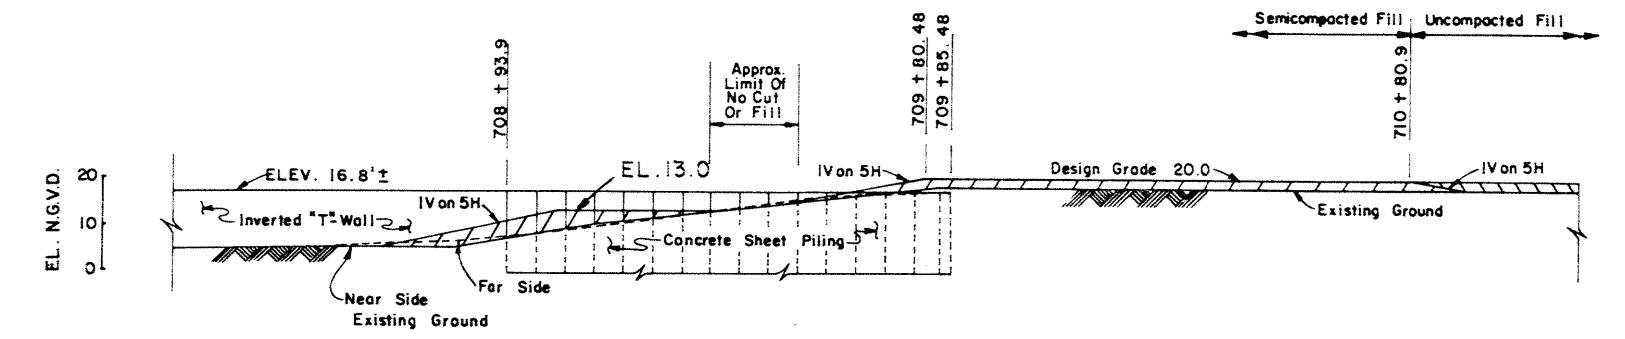

SECTION A-A  
SCALE 1" = 20'

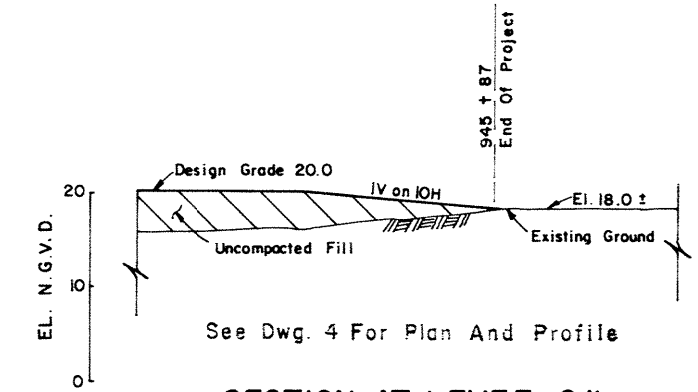

SECTION AT LEVEE C/L  
DETAIL OF LOWER END OF PROJECT





- NOTES:  
1. For General Notes and Legend, See Dwg. 2.  
2. Scale As Shown



| REVISION                                                                                                                                                                                                | DATE             | DESCRIPTION | BY         |
|---------------------------------------------------------------------------------------------------------------------------------------------------------------------------------------------------------|------------------|-------------|------------|
| U.S. ARMY ENGINEER DISTRICT, NEW ORLEANS<br>CORPS OF ENGINEERS<br>NEW ORLEANS, LA.                                                                                                                      |                  |             |            |
| LAKE PONTCHARTRAIN, LOUISIANA AND VICINITY<br>CHALMETTE AREA PLAN, CHALMETTE EXTENSION<br>HURRICANE PROTECTION LEVEE<br>SECOND ENLARGEMENT<br>STA. 708 + 68 TO STA. 945 + 87<br>ST. BERNARD PARISH, LA. |                  |             |            |
| ENDS OF PROJECT DETAILS                                                                                                                                                                                 |                  |             |            |
| DESIGNED:                                                                                                                                                                                               | DRAWN:           | CHECKED:    | DATE:      |
| R.W.W.                                                                                                                                                                                                  | L.A.H.           | R.P.L.      | MAR. 1983  |
| SUBMITTED:                                                                                                                                                                                              | SPEC. NO.        | SCALE:      | FILE NO.   |
|                                                                                                                                                                                                         | DACW29-83-B-0053 | AS SHOWN    | H-8-29520  |
|                                                                                                                                                                                                         |                  |             | DWG 6 OF 9 |


GAGE READINGS IN FEET

GAGE READINGS IN FEET

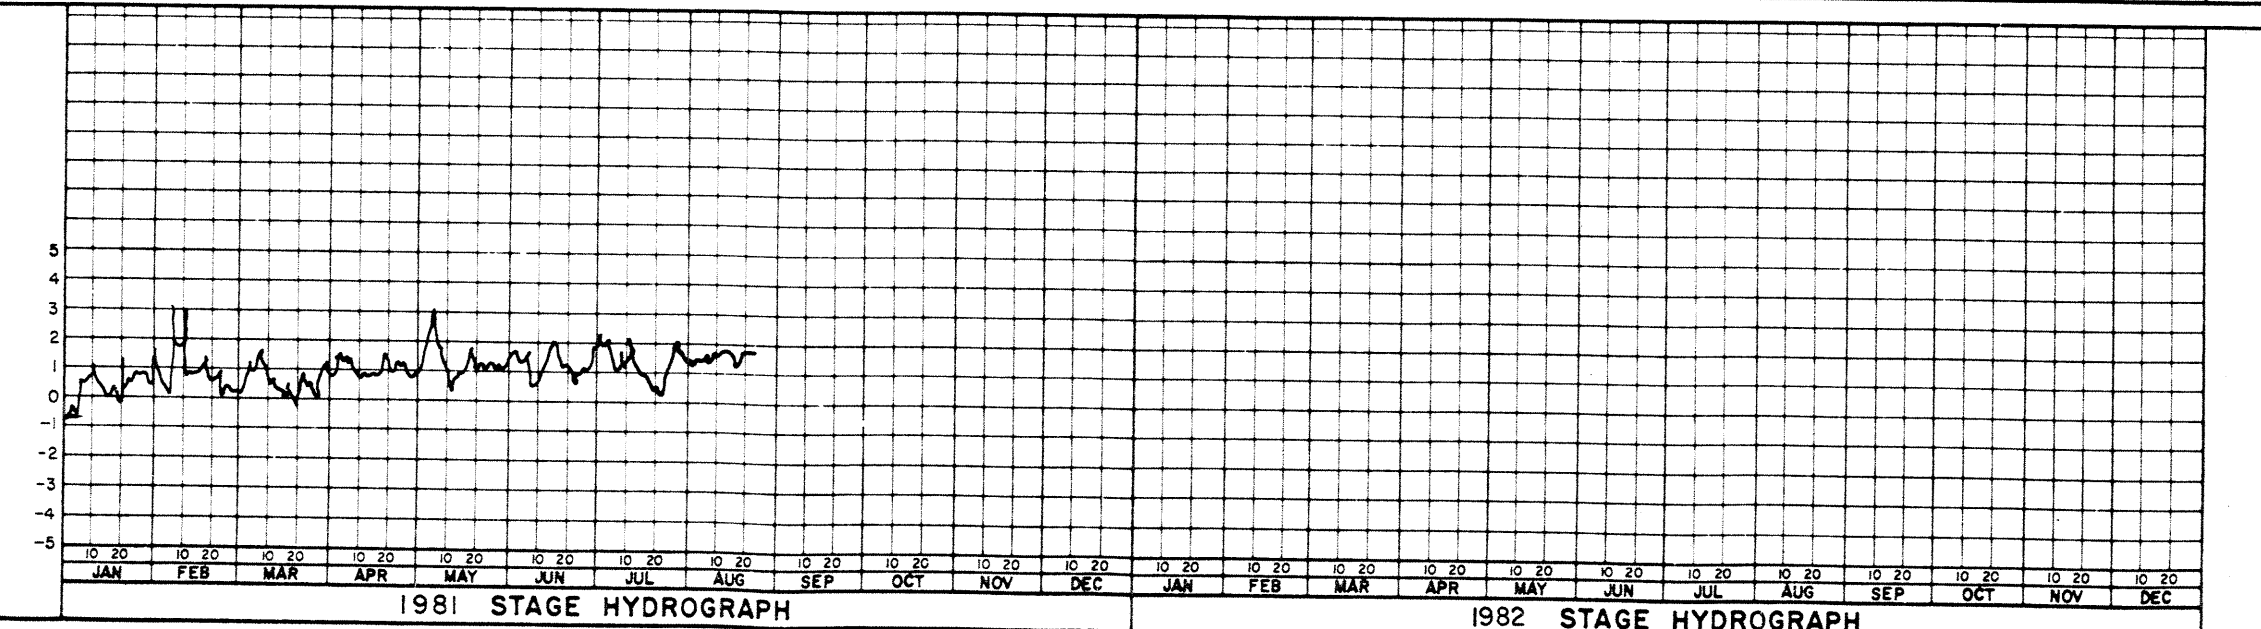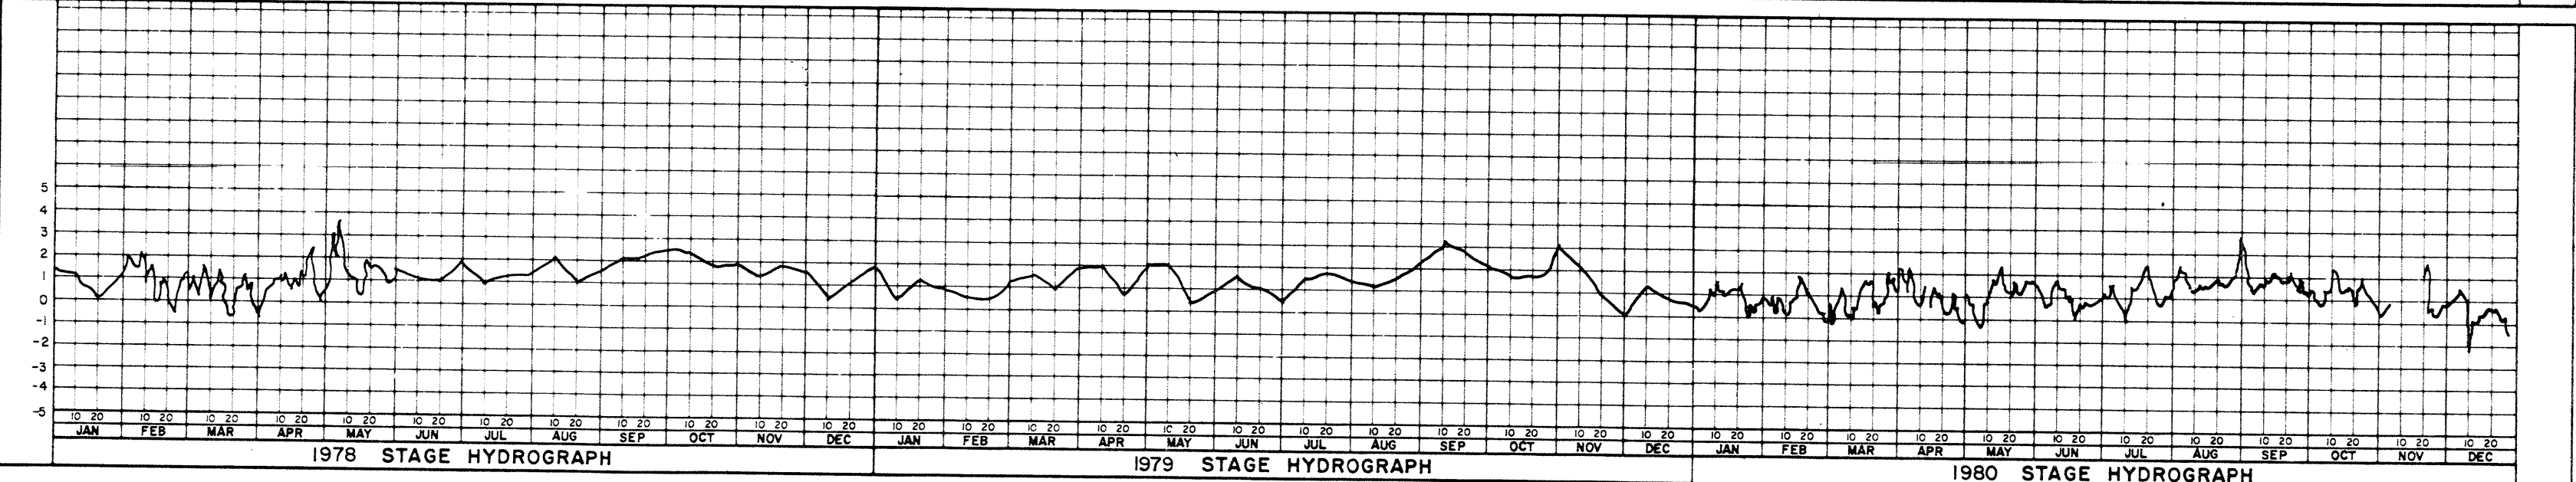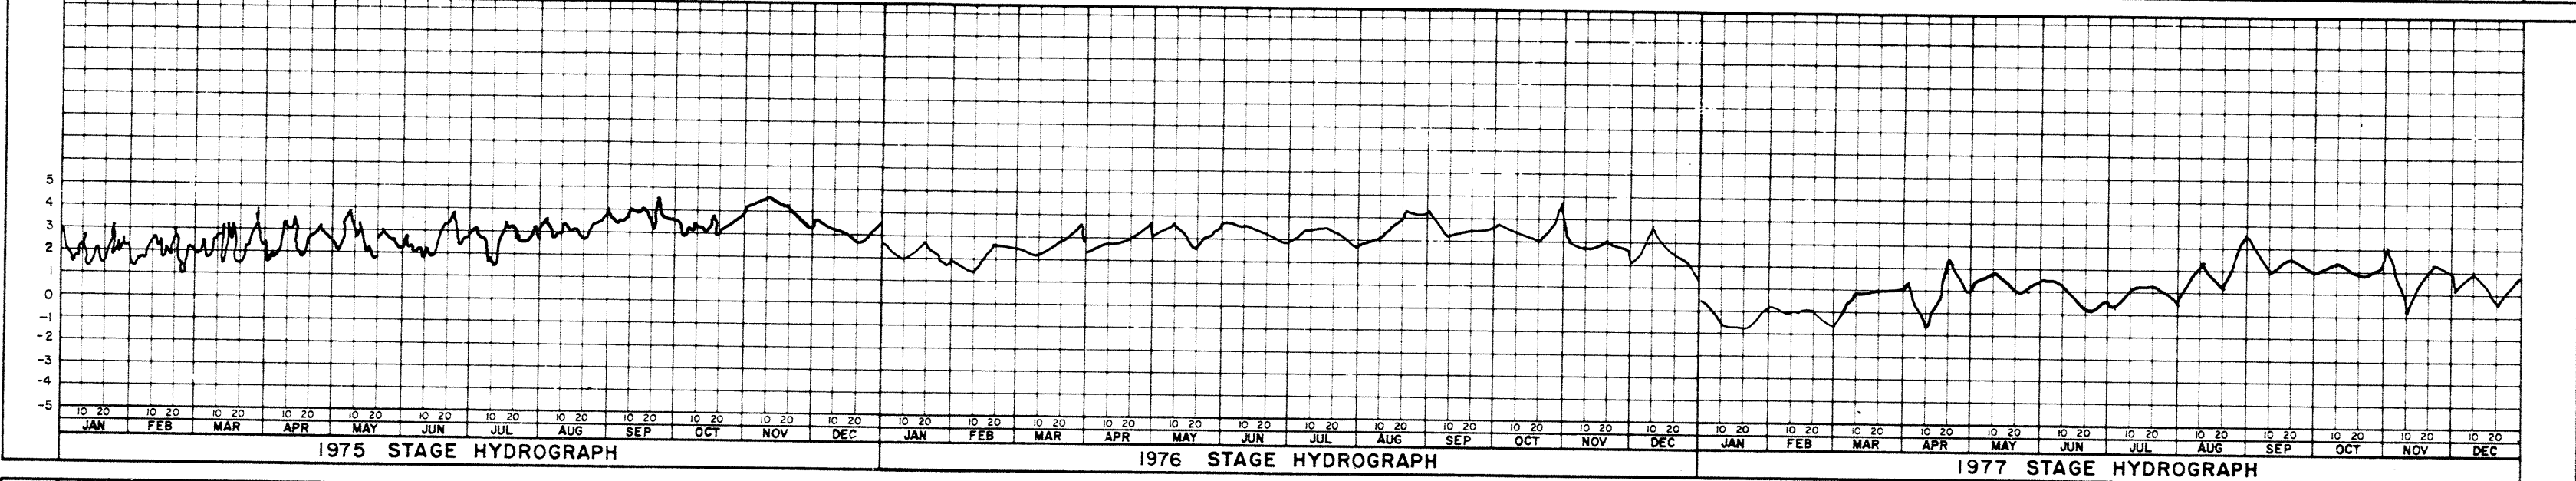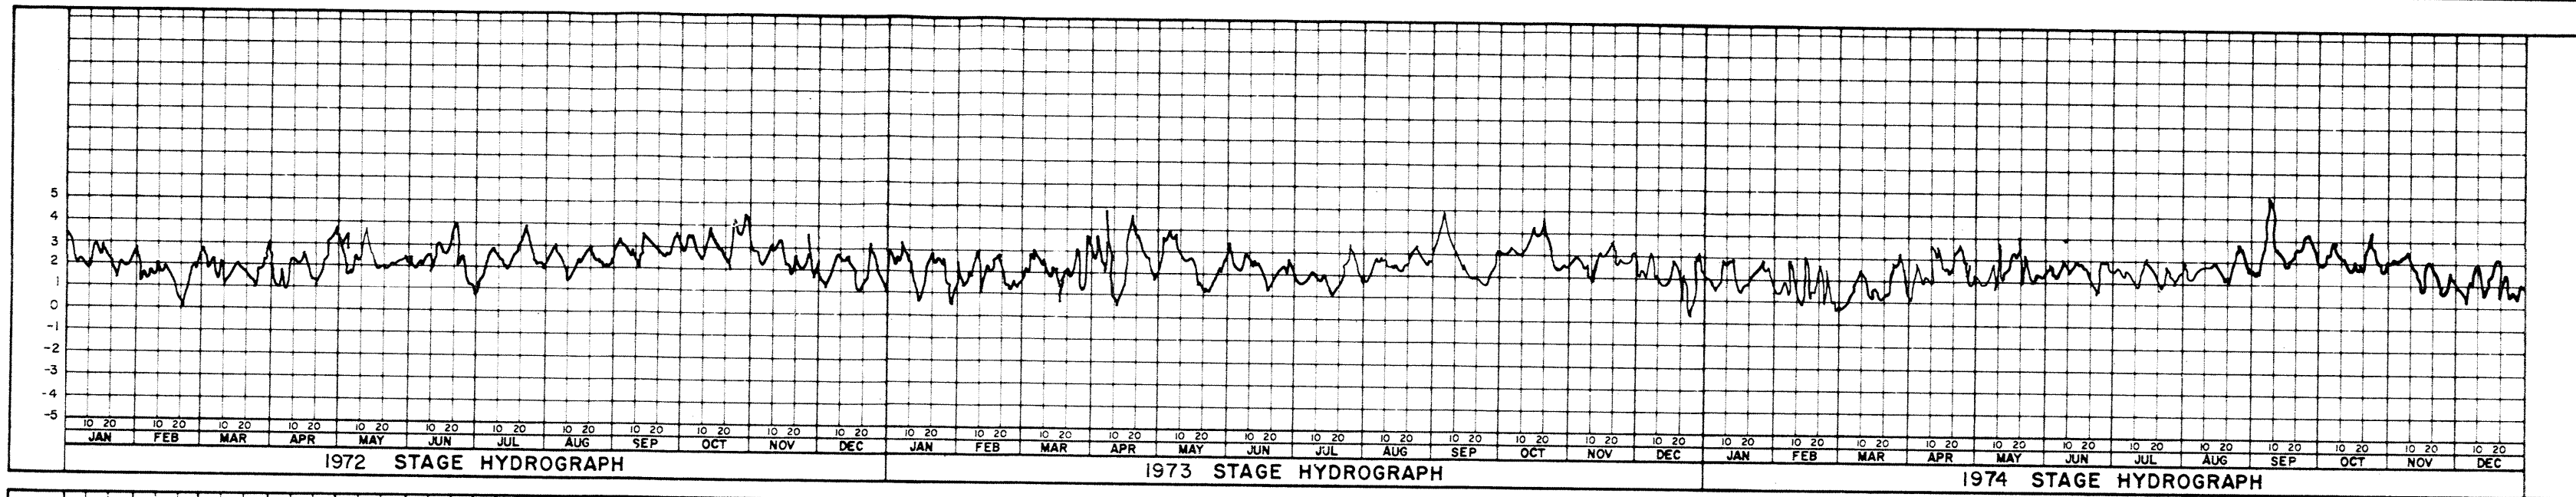

INTRACOASTAL WATERWAY NEAR PARIS ROAD BRIDGE, NEW ORLEANS, LA.  
 PRIOR TO 1 JAN. 77, GAGE ZERO IS M.L.G. AFTER 1 JAN. 77, GAGE ZERO  
 IS N.G.V.D.


*Safety is a Part  
of Your Contract*

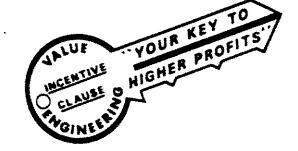


| REVISION                                                                                                                                                                                                | DATE   | DESCRIPTION | BY        |
|---------------------------------------------------------------------------------------------------------------------------------------------------------------------------------------------------------|--------|-------------|-----------|
| U. S. ARMY ENGINEER DISTRICT, NEW ORLEANS<br>CORPS OF ENGINEERS<br>NEW ORLEANS, LA.                                                                                                                     |        |             |           |
| LAKE PONTCHARTRAIN, LOUISIANA AND VICINITY<br>CHALMETTE AREA PLAN, CHALMETTE EXTENSION<br>HURRICANE PROTECTION LEVEE<br>SECOND ENLARGEMENT<br>STA. 708 + 68 TO STA. 945 + 87<br>ST. BERNARD PARISH, LA. |        |             |           |
| <b>STAGE HYDROGRAPHS</b>                                                                                                                                                                                |        |             |           |
| DESIGNED                                                                                                                                                                                                | DRAWN  | CHECKED     | DATE      |
| R.W.W.                                                                                                                                                                                                  | V.L.W. | R.P.L.      | MAR. 1983 |
| SCALE                                                                                                                                                                                                   |        | FILE NO.    |           |
| AS SHOWN                                                                                                                                                                                                |        | H-8-29520   |           |
| SUBMITTED                                                                                                                                                                                               |        | SPEC. NO.   |           |
| DACW29-83-B-0053                                                                                                                                                                                        |        | DWG 7 OF 9  |           |




BCR. 5-CUE  
 STA. 869+00  
 C/L LEVEE

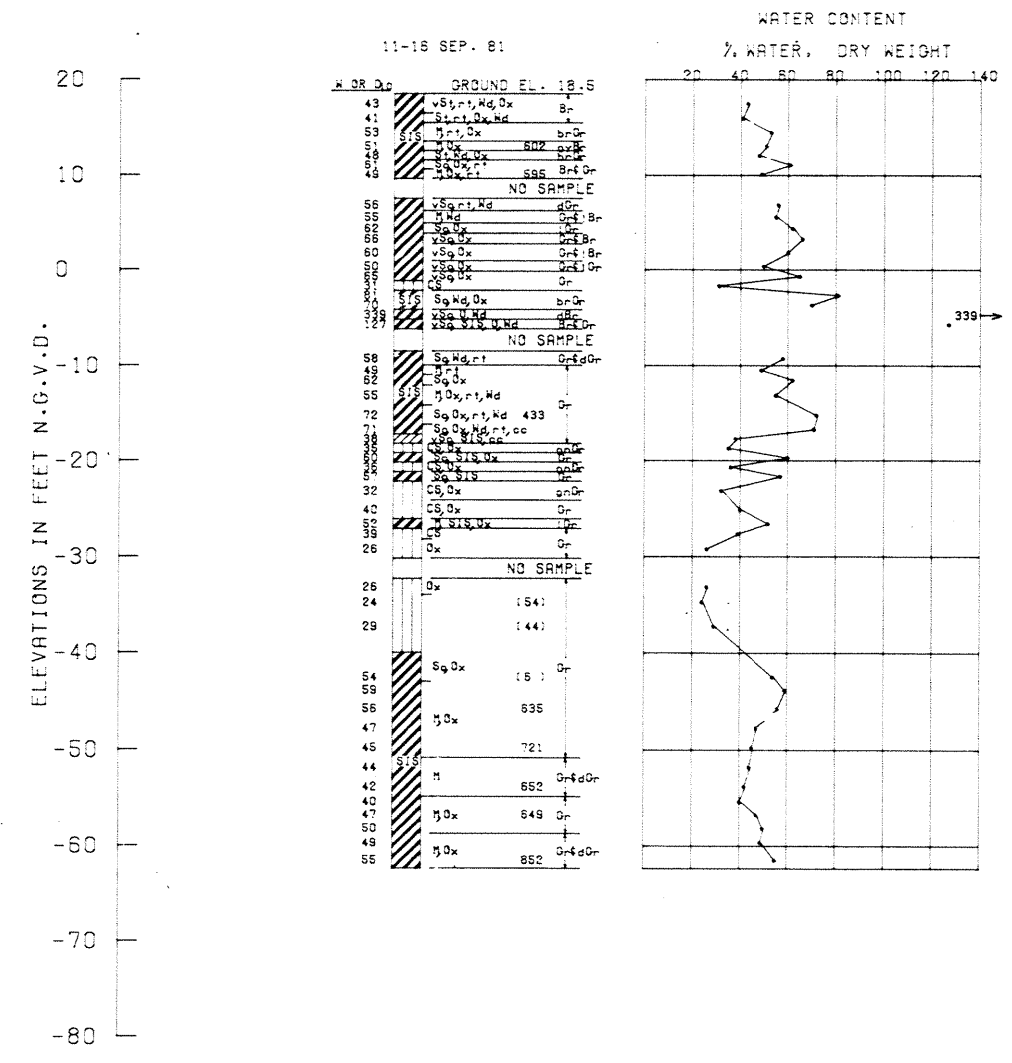


BCR. 5-CUF  
 STA. 869+00  
 150 FT. L.S. OF LEV. C/L

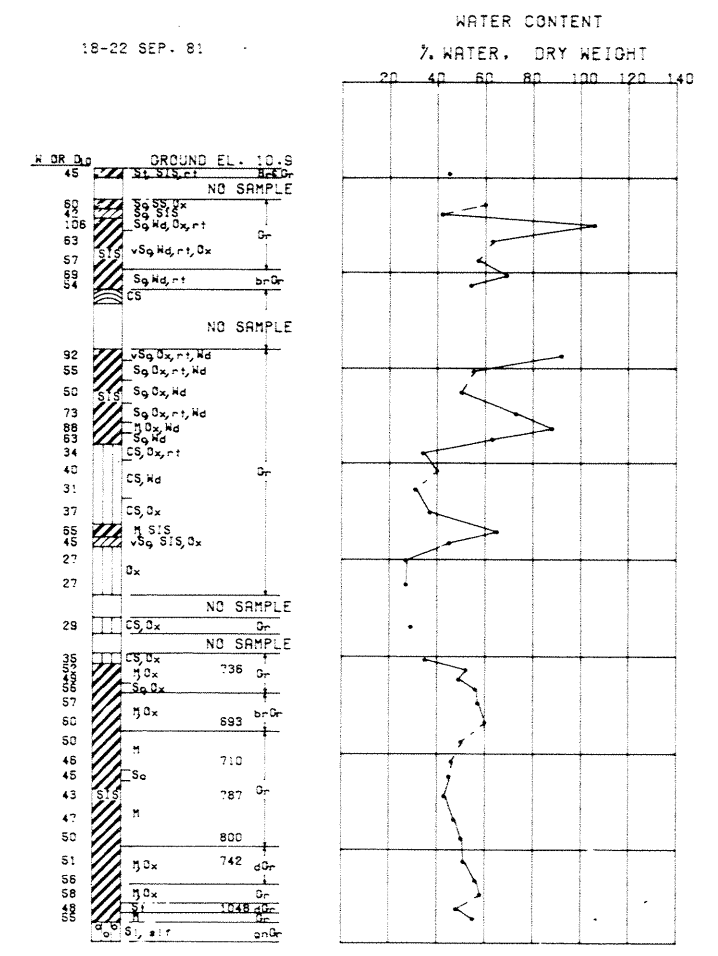


BCR. 9-CUA  
 STA. 780+00  
 ON C/L LEVEE

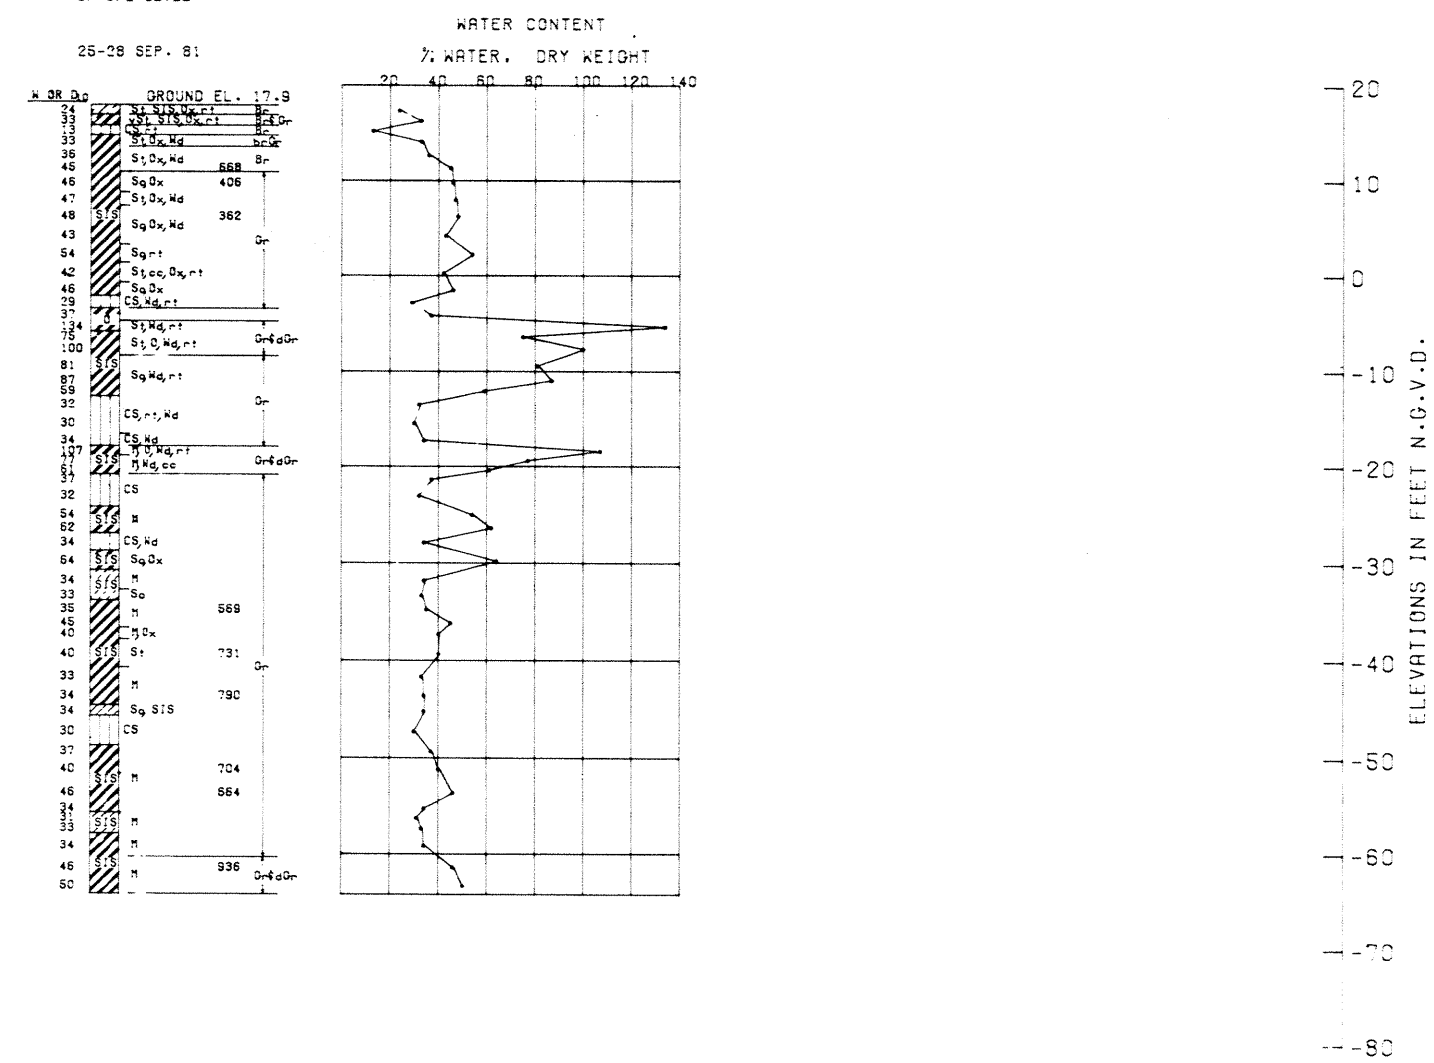

BCR. 9-CUB  
 STA. 780+00  
 150 FT. L.S. OF LEVEE C/L

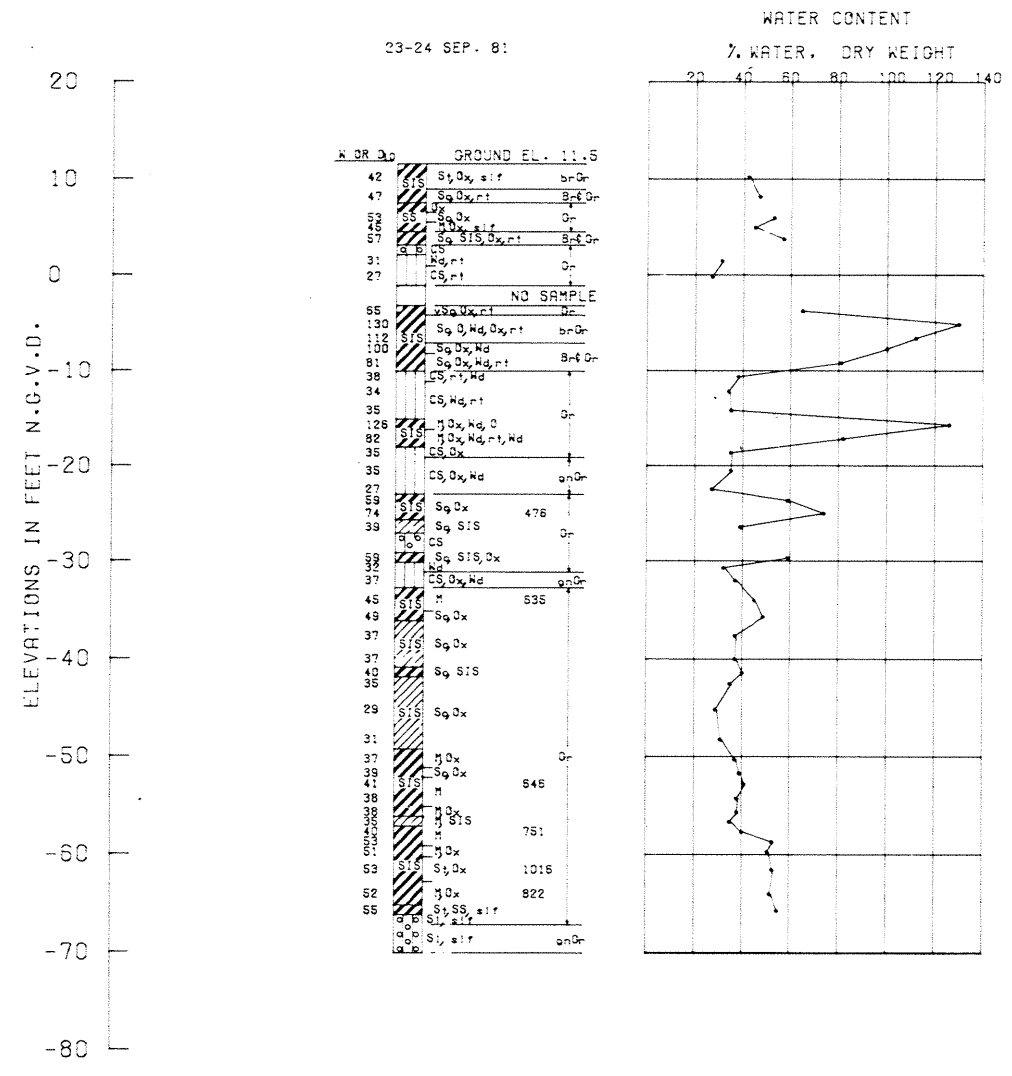

- NOTES:
1. FOR GENERAL NOTES AND LEGEND SEE DWG. 2
  2. FOR SOIL BORING LEGEND SEE DWG. 9
  3. UNDISTURBED SAMPLES WERE TAKEN WITH A 5 INCH DIAMETER STEEL TUBE PISTON TYPE SAMPLER.

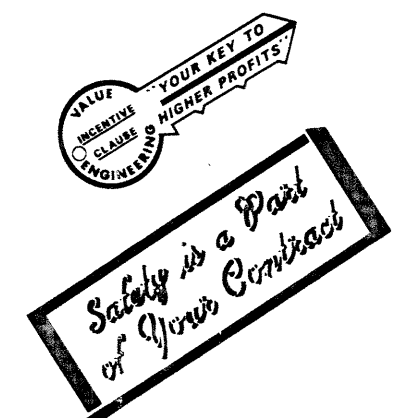

| REVISION                                                                                                                                                                                                                                                                                                                  | DATE             | DESCRIPTION | BY        |
|---------------------------------------------------------------------------------------------------------------------------------------------------------------------------------------------------------------------------------------------------------------------------------------------------------------------------|------------------|-------------|-----------|
| U. S. ARMY ENGINEER DISTRICT, NEW ORLEANS<br>CORPS OF ENGINEERS<br>NEW ORLEANS, LA.<br><br>LAKE PONTCHARTRAIN, LOUISIANA AND VICINITY<br>CHALMETTE AREA PLAN, CHALMETTE EXTENSION<br>HURRICANE PROTECTION LEVEE<br>SECOND ENLARGEMENT<br>STA. 708 + 68 TO STA. 945 + 87<br>ST. BERNARD PARISH, LA.<br><b>SOIL BORINGS</b> |                  |             |           |
| DESIGNED                                                                                                                                                                                                                                                                                                                  | DRAWN            | CHECKED     | DATE      |
| R. W. W.                                                                                                                                                                                                                                                                                                                  | E. M. M.         | R. P. L.    | MAR. 1983 |
| SCALE                                                                                                                                                                                                                                                                                                                     | FILE NO.         |             |           |
| AS SHOWN                                                                                                                                                                                                                                                                                                                  | H-8-29520        |             |           |
| SUBMITTED                                                                                                                                                                                                                                                                                                                 | SPEC. NO.        |             |           |
|                                                                                                                                                                                                                                                                                                                           | DACW29-83-B-0053 | DWS 8 OF 9  |           |



| UNIFIED SOIL CLASSIFICATION                                                           |                                                                                       |                                                  |                                                                                        |                                                                 |                                          |
|---------------------------------------------------------------------------------------|---------------------------------------------------------------------------------------|--------------------------------------------------|----------------------------------------------------------------------------------------|-----------------------------------------------------------------|------------------------------------------|
| MAJOR DIVISION                                                                        | TYPE                                                                                  | LETTER SYMBOL                                    | SYM BOL                                                                                | TYPICAL NAMES                                                   |                                          |
| COARSE-GRAINED SOILS<br>More than half of material is larger than No. 200 sieve size. | GRAVELS<br>More than half of coarse fraction is larger than No. 4 sieve size.         | CLEAN GRAVEL (Little or No Fines)                | GW                                                                                     | GRAVEL, Well Graded, gravel-sand mixtures, little or no fines   |                                          |
|                                                                                       |                                                                                       | GRAVEL WITH FINES (Approachable Amount of Fines) | GP                                                                                     | GRAVEL, Poorly Graded, gravel-sand mixtures, little or no fines |                                          |
|                                                                                       | SANDS<br>More than half of coarse fraction is smaller than No. 4 sieve size.          | CLEAN SAND (Little or No Fines)                  | SW                                                                                     | SAND, Well-Graded, gravelly sands                               |                                          |
|                                                                                       |                                                                                       | SANDS WITH FINES (Approachable Amount of Fines)  | SP                                                                                     | SAND, Poorly-Graded, gravelly sands                             |                                          |
|                                                                                       | FINE-GRAINED SOILS<br>More than half the material is smaller than No. 200 sieve size. | SILTS AND CLAYS (Liquid Limit < 50)              | GRAVEL WITH FINES (Approachable Amount of Fines)                                       | GM                                                              | SILTY GRAVEL, gravel-sand-silt mixtures  |
|                                                                                       |                                                                                       |                                                  | CLEAN SAND (Little or No Fines)                                                        | GC                                                              | CLAYEY GRAVEL, gravel-sand-clay mixtures |
|                                                                                       |                                                                                       |                                                  | SANDS WITH FINES (Approachable Amount of Fines)                                        | SM                                                              | SILTY SAND, sand-silt mixtures           |
|                                                                                       |                                                                                       |                                                  | SANDS WITH FINES (Approachable Amount of Fines)                                        | SC                                                              | CLAYEY SAND, sand-clay mixtures          |
|                                                                                       |                                                                                       | SILTS AND CLAYS (Liquid Limit > 50)              | SILT & very fine sand, silty or clayey fine sand or clayey silt with slight plasticity | ML                                                              |                                          |
|                                                                                       |                                                                                       |                                                  | LEAN CLAY, Sandy Clay, Silty Clay, of low to medium plasticity                         | CL                                                              |                                          |
| ORGANIC SILTS and organic silty clays of low plasticity                               |                                                                                       |                                                  | OL                                                                                     |                                                                 |                                          |
| SILT, fine sandy or silty soil with high plasticity                                   |                                                                                       |                                                  | MH                                                                                     |                                                                 |                                          |
| HIGHLY ORGANIC SOILS                                                                  | FAT CLAY, inorganic clay of high plasticity                                           | CH                                               |                                                                                        |                                                                 |                                          |
|                                                                                       | ORGANIC CLAYS of medium to high plasticity, organic silts                             | OH                                               |                                                                                        |                                                                 |                                          |
|                                                                                       | PEAT, and other highly organic soil                                                   | Pt                                               |                                                                                        |                                                                 |                                          |
|                                                                                       | WOOD                                                                                  | Wd                                               |                                                                                        |                                                                 |                                          |
| SHELLS                                                                                | SI                                                                                    |                                                  |                                                                                        |                                                                 |                                          |
| NO SAMPLE                                                                             |                                                                                       |                                                  |                                                                                        |                                                                 |                                          |

NOTE: Soils possessing characteristics of two groups are designated by combinations of group symbols

| DESCRIPTIVE SYMBOLS |        |                                |                                                           |        |                       |        |
|---------------------|--------|--------------------------------|-----------------------------------------------------------|--------|-----------------------|--------|
| COLOR               |        | CONSISTENCY FOR COHESIVE SOILS |                                                           |        | MODIFICATIONS         |        |
| COLOR               | SYMBOL | CONSISTENCY                    | COHESION IN LBS./SQ. FT. FROM UNCONFINED COMPRESSION TEST | SYMBOL | MODIFICATION          | SYMBOL |
| TAN                 | T      | VERY SOFT                      | < 250                                                     | vSo    | Traces                | Tr-    |
| YELLOW              | Y      | SOFT                           | 250 - 500                                                 | So     | Fine                  | F      |
| RED                 | R      | MEDIUM                         | 500 - 1000                                                | M      | Medium                | M      |
| BLACK               | BK     | STIFF                          | 1000 - 2000                                               | St     | Coarse                | C      |
| GRAY                | Gr     | VERY STIFF                     | 2000 - 4000                                               | vSt    | Concretions           | cc     |
| LIGHT GRAY          | lGr    | HARD                           | > 4000                                                    | H      | Rootlets              | rt     |
| DARK GRAY           | dGr    |                                |                                                           |        | Lignite fragments     | lg     |
| BROWN               | Br     |                                |                                                           |        | Shale fragments       | sh     |
| LIGHT BROWN         | lBr    |                                |                                                           |        | Sandstone fragments   | sds    |
| DARK BROWN          | dBr    |                                |                                                           |        | Shell fragments       | sif    |
| BROWNISH - GRAY     | br Gr  |                                |                                                           |        | Organic matter        | O      |
| GRAYISH - BROWN     | gy Br  |                                |                                                           |        | Clay strata or lenses | CS     |
| GREENISH - GRAY     | gn Gr  |                                |                                                           |        | Silt strata or lenses | SIS    |
| GRAYISH - GREEN     | gy Gn  |                                |                                                           |        | Sand strata or lenses | SS     |
| GREEN               | Gn     |                                |                                                           |        | Sandy                 | S      |
| BLUE                | Bl     |                                |                                                           |        | Gravelly              | G      |
| BLUE - GREEN        | Bl Gn  |                                |                                                           |        | Boulders              | B      |
| WHITE               | Wh     |                                |                                                           |        | Slickensides          | SL     |
| MOTTLED             | Mot    |                                |                                                           |        | Wood                  | Wd     |
|                     |        |                                |                                                           |        | Oxidized              | Ox     |

PLASTICITY CHART  
For classification of fine-grained soils

NOTES:

FIGURES TO LEFT OF BORING UNDER COLUMN "W OR D<sub>10</sub>"

Are natural water contents in percent dry weight  
When underlined denotes D<sub>10</sub> size in mm\*

FIGURES TO LEFT OF BORING UNDER COLUMNS "LL" AND "PL"

Are liquid and plastic limits, respectively

SYMBOLS TO LEFT OF BORING

—▽— Ground-water surface and date observed  
 (C) Denotes location of consolidation test\*\*  
 (S) Denotes location of consolidated-drained direct shear test\*\*  
 (R) Denotes location of consolidated-undrained triaxial compression test\*\*  
 (Q) Denotes location of unconsolidated-undrained triaxial compression test\*\*  
 (T) Denotes location of sample subjected to consolidation test and each of the above three types of shear tests\*\*  
 FW Denotes free water encountered in boring or sample

FIGURES TO RIGHT OF BORING

Are values of cohesion in lbs./sq. ft. from unconfined compression tests

In parenthesis are driving resistances in blows per foot determined with a standard split spoon sampler (1 3/8" I.D., 2" O.D.) and a 140 lb. driving hammer with a 30" drop

Where underlined with a solid line denotes laboratory permeability in centimeters per second of undisturbed sample

Where underlined with a dashed line denotes laboratory permeability in centimeters per second of sample remoulded to the estimated natural void ratio

\*The D<sub>10</sub> size of a soil is the grain diameter in millimeters of which 10% of the soil is finer, and 90% coarser than D<sub>10</sub>


\*\*Results of these tests are available for inspection in the U. S. Army Engineer District Office, if these symbols appear beside the boring logs on the drawings

TYPICAL NOTES:

While the borings are representative of subsurface conditions at their respective locations and for their respective vertical reaches, local variations characteristic of the subsurface materials of the region are anticipated and, if encountered, such variations will not be considered as differing materially within the purview of clause 4 of the contract.

Ground-water elevations shown on the boring logs represents ground-water surfaces encountered on the dates shown. Absence of water surface data on certain borings implies that no ground-water data is available, but does not necessarily mean that ground water will not be encountered at the locations or within the vertical reaches of these borings.

Consistency of cohesive soils shown on the boring logs is based on driller's log and visual examination and is approximate, except within those vertical reaches of the borings where shear strengths from unconfined compression tests are shown.

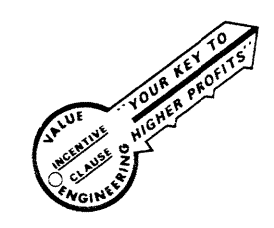

| REVISION                                                                                                                                                                                                | DATE               | DESCRIPTION                   | BY                 |
|---------------------------------------------------------------------------------------------------------------------------------------------------------------------------------------------------------|--------------------|-------------------------------|--------------------|
| U. S. ARMY ENGINEER DISTRICT, NEW ORLEANS<br>CORPS OF ENGINEERS<br>NEW ORLEANS, LA.                                                                                                                     |                    |                               |                    |
| LAKE PONTCHARTRAIN, LOUISIANA AND VICINITY<br>CHALMETTE AREA PLAN, CHALMETTE EXTENSION<br>HURRICANE PROTECTION LEVEE<br>SECOND ENLARGEMENT<br>STA. 708 + 68 TO STA. 945 + 87<br>ST. BERNARD PARISH, LA. |                    |                               |                    |
| <b>SOIL BORING LEGEND</b>                                                                                                                                                                               |                    |                               |                    |
| DESIGNED:<br>R. W. W.                                                                                                                                                                                   | DRAWN:<br>E. M. M. | CHECKED:<br>R. P. L.          | DATE:<br>MAR. 1983 |
| SCALE:<br>AS SHOWN                                                                                                                                                                                      |                    | FILE NO.<br>H-8-29520         |                    |
| SUBMITTED:<br><i>[Signature]</i>                                                                                                                                                                        |                    | SPEC. NO.<br>DACW29-83-3-0053 |                    |
|                                                                                                                                                                                                         |                    | DWS 9 OF 9                    |                    |