

SCALE 1/2" = 1'-0"

SECTION THRU DOCK & SEA WALL SHOWING WATER SERVICE INSTALLATION & HOSE RACK

REVISION 'B'  
AUG. 28, 1942

REVISION 'A'  
AUG. 13, 1942

REVISION 'C'  
SEPT. 18, 1942

NOTES:  
Valves in all cases to be located 4.0' from the Main unless otherwise specified.  
Control Elevations shown for Water Mains are top of pipe in all cases.  
Place all Water Services at Elevations to clear Sewer and Steam Lines.

UTILITIES CROSSINGS

- ① 4" Water Under 8" Sewer Top W.M.E.I. 6.4 or Less
- ② 4" Water Under Steam Lines Top W.M.E.I. 8.0 or Less
- ③
- ④

LEGEND

- V&B Valve and Box
- F.H. Fire Hydrant
- Utilities Crossings
- Future Water Lines


COURTHOUSE

BAY

REVISION	DATE	BRIEF	R.O. IN CHARGE	BY
'C'	SEP 18 1942	CHANGED LOCATION OF SERVICE TO TRACTOR STORAGE Bldg.	JWS	Raw
'B'	AUG 28 1942	REFERENCE TO DRAWING FOR DETAIL OF WATER BALANCING TANKS CHANGED (BY FORMER) JWS	JWS	Raw
'A'	AUG 13 1942	SERVICE LINE ADDED TO TRACTOR STORAGE BUILDING & DOCK HOSE RACK DETAILS JWS	JWS	Raw

DRAWN BY: JWS	CARR & J. E. GREINER CO.—ARCHITECT-ENGINEERS DURHAM, N. C.
CHECKED BY: JWS	MARINE BARRACKS—NEW RIVER, N. C. BUREAU OF YARDS AND DOCKS—U. S. NAVY
CHIEF DPM: FDK	
IN CHARGE: WCM	
DATE: MAY 4, 1942	
SCALE: 1" = 100'	
Y. & P. DRAWING NO. 162256	
APPROVED: [Signature]	RESIDENT OFFICER IN CHARGE
SHEET: 1	M.B. PROJ. NO. P-202-14
	R.S. DES. NO. 576



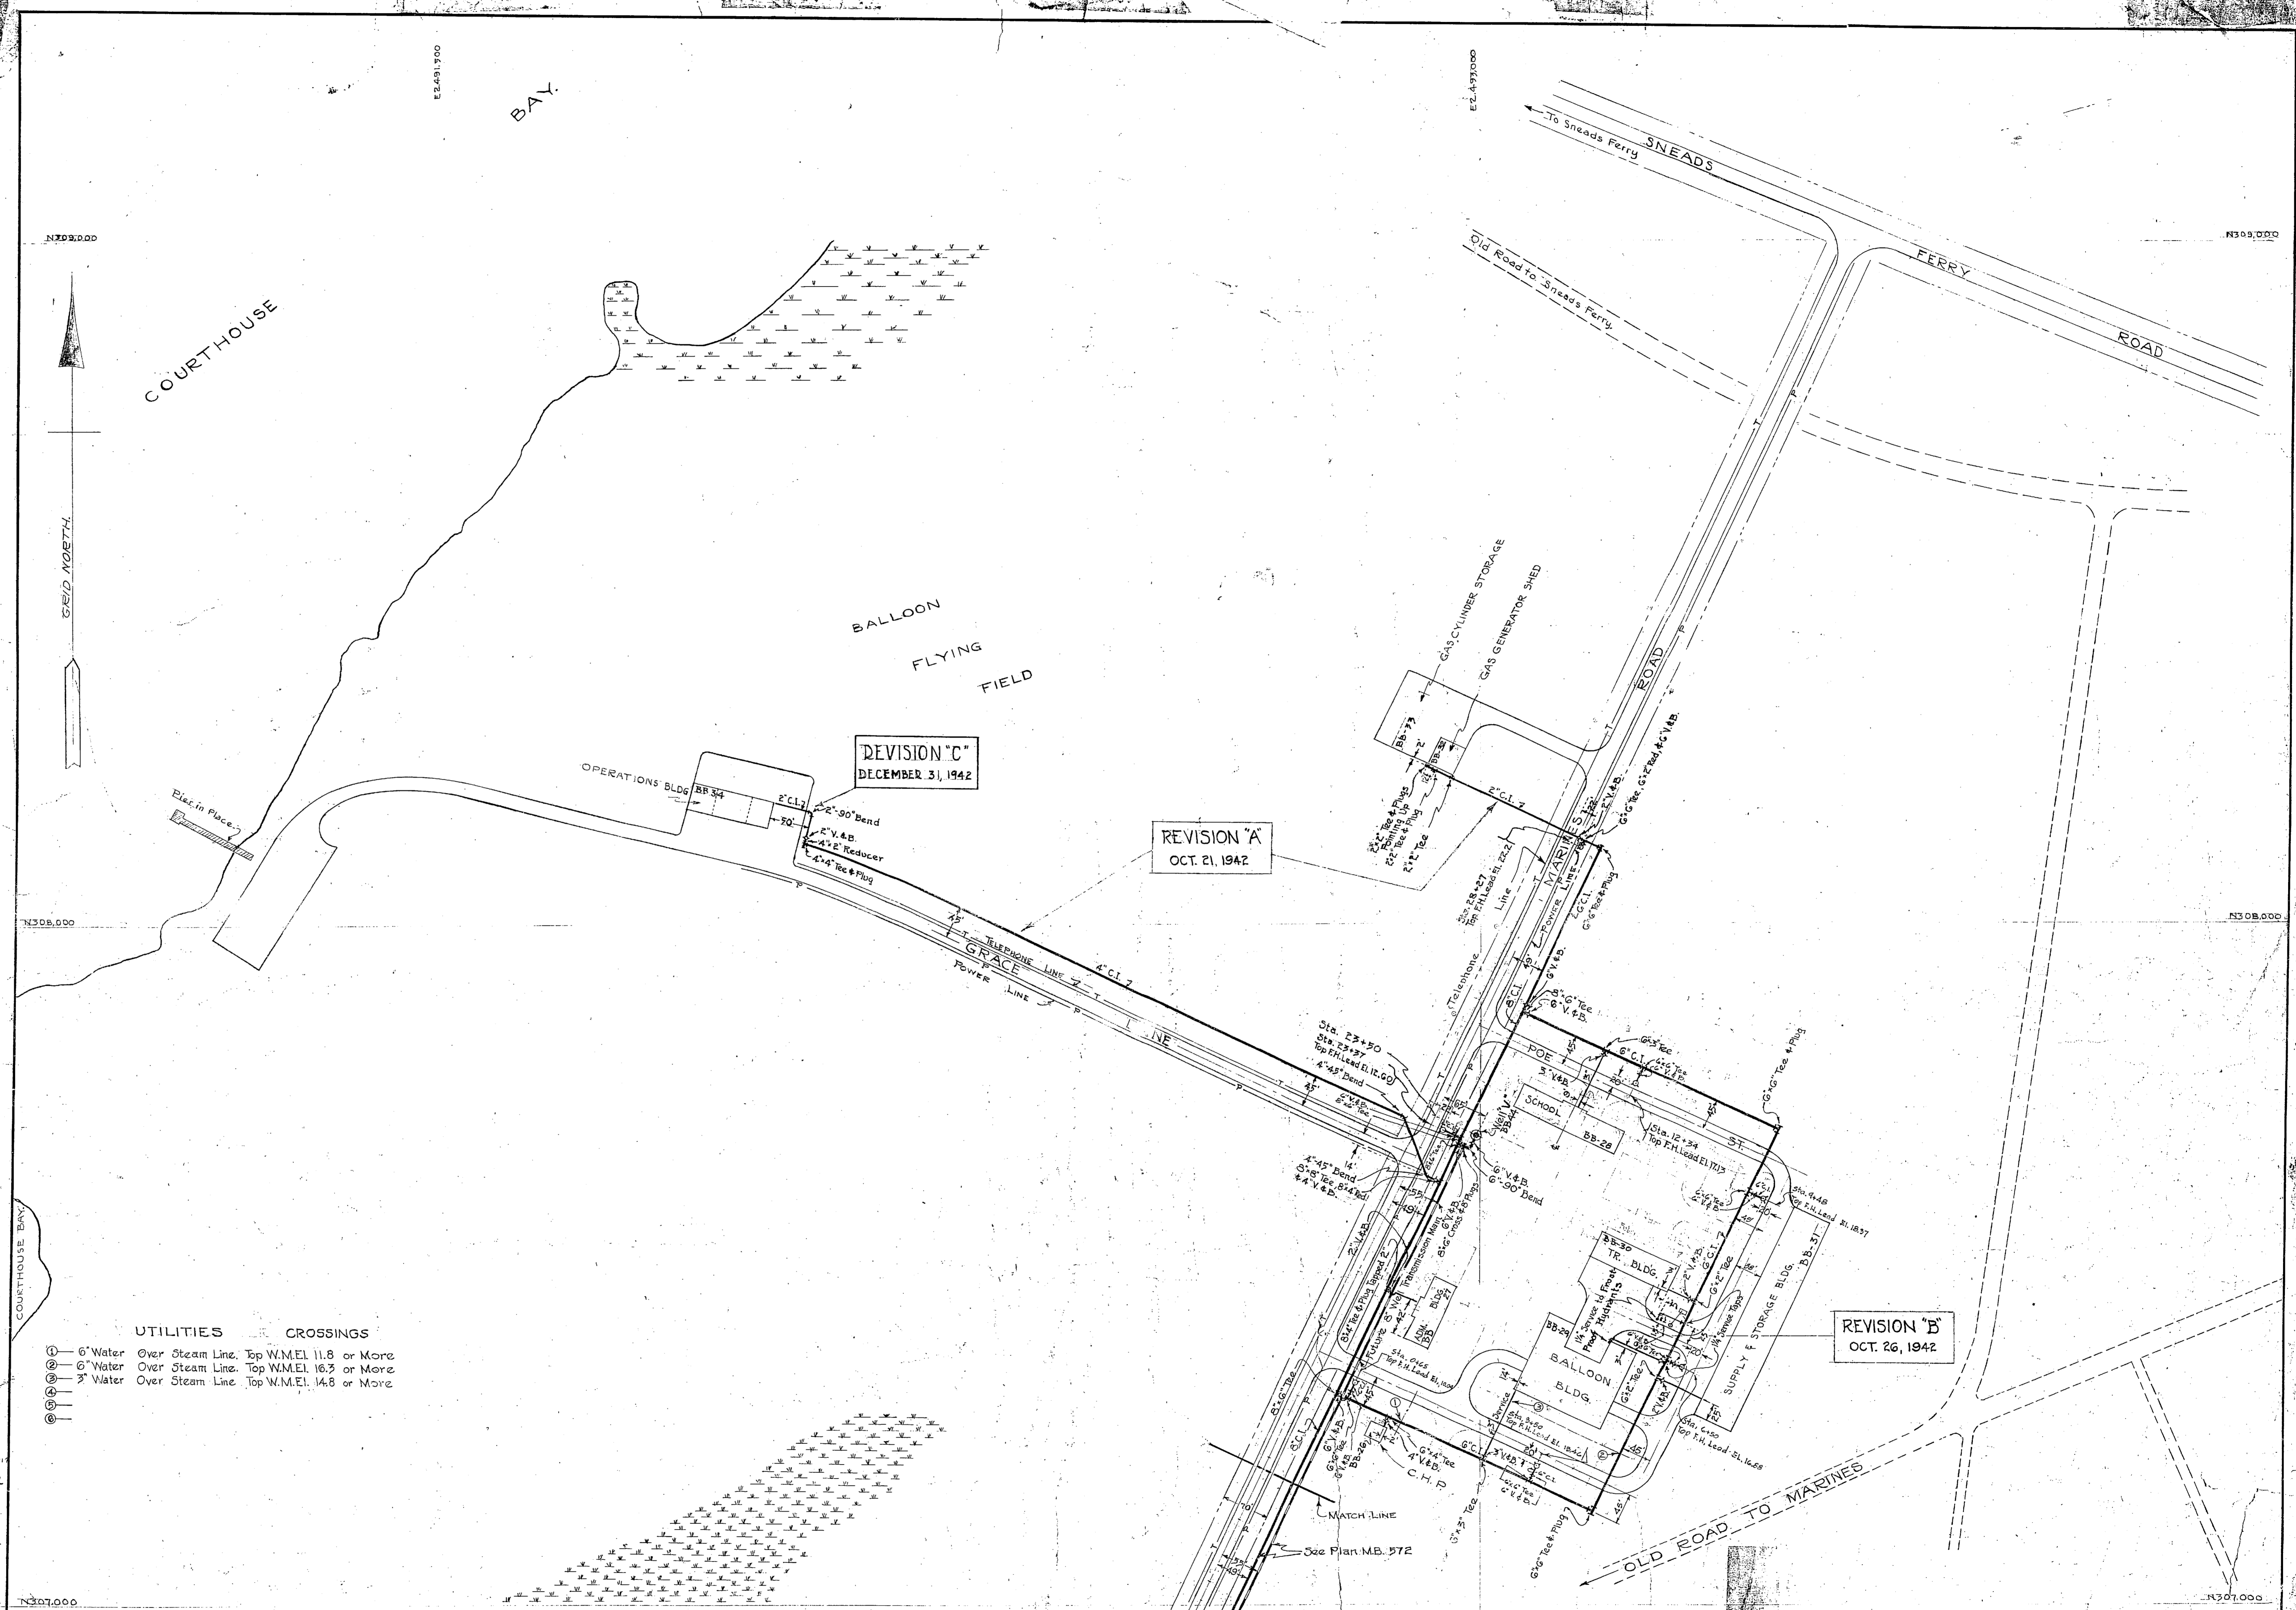

- UTILITIES CROSSINGS**
- ① 6" Water Over Steam Line, Top W.M.E.L. 11.8 or More
  - ② 6" Water Over Steam Line, Top W.M.E.L. 16.3 or More
  - ③ 3" Water Over Steam Line, Top W.M.E.L. 14.8 or More

- LEGEND**
- Y & B. Valve & Box
  - F.H. Fire Hydrant
  - Water & Power Crossing
  - Future Water Lines

**NOTES:**  
 Valves in all cases to be located 4.0' from the Main unless otherwise specified.  
 Control elevations shown for Water Mains are top of pipe in all cases.

REVISION "C"  
 DECEMBER 31, 1942

REVISION "A"  
 OCT. 21, 1942

REVISION "B"  
 OCT. 26, 1942

REVISION	DATE	BRIEF DESCRIPTION	BY	CHECKED BY
C	12-31-42	As-Built Revisions to Water Distribution System-Added Bldg Numbers	J.W.S.	P.S.
B	10-26-42	SERVICES ADDED FOR TWO HOSE CONNECTIONS	J.W.S.	P.S.
A	10-21-42	ADDED MAINS & SERVICES TO GAS GENERATOR SHED & OPERATIONS BLDG.	J.W.S.	P.S.

DRAWN BY: J.W.S.  
 TRACED BY: J.W.S.  
 CHECKED BY: F.D.K.  
 IN CHARGE: W.C.M.  
 DATE: May 5, 1942.  
 SCALE: 1"=100'  
 Y. & D. DRAWING NO. 162253

**CARR & J. E. GREINER CO.—ARCHITECT-ENGINEERS**  
 DURHAM, N. C. BALTIMORE, MD.  
**MARINE BARRACKS—NEW RIVER, N. C.**  
 BUREAU OF YARDS AND DOCKS—U. S. NAVY

**WATER DISTRIBUTION SYSTEM**  
**BALLOON BARRAGE BATTALION**  
**& AMPHIBIAN BASE**

APPROVED: *[Signature]*  
 ARCHITECT-ENGINEERS  
 SHEET 2 OF 2  
 M.B. PROJ. NO. D-202514  
 M.B. DWS. NO. 273

