


*** CHAIN LINK FENCE

○➔ PEDESTRIAN GATE

~~~~~ MICROWAVE IDS

⊗➔ VEHICLE GATE

11 12 13 14 15 16 17 18 19 20 21 22 23 24 25 26

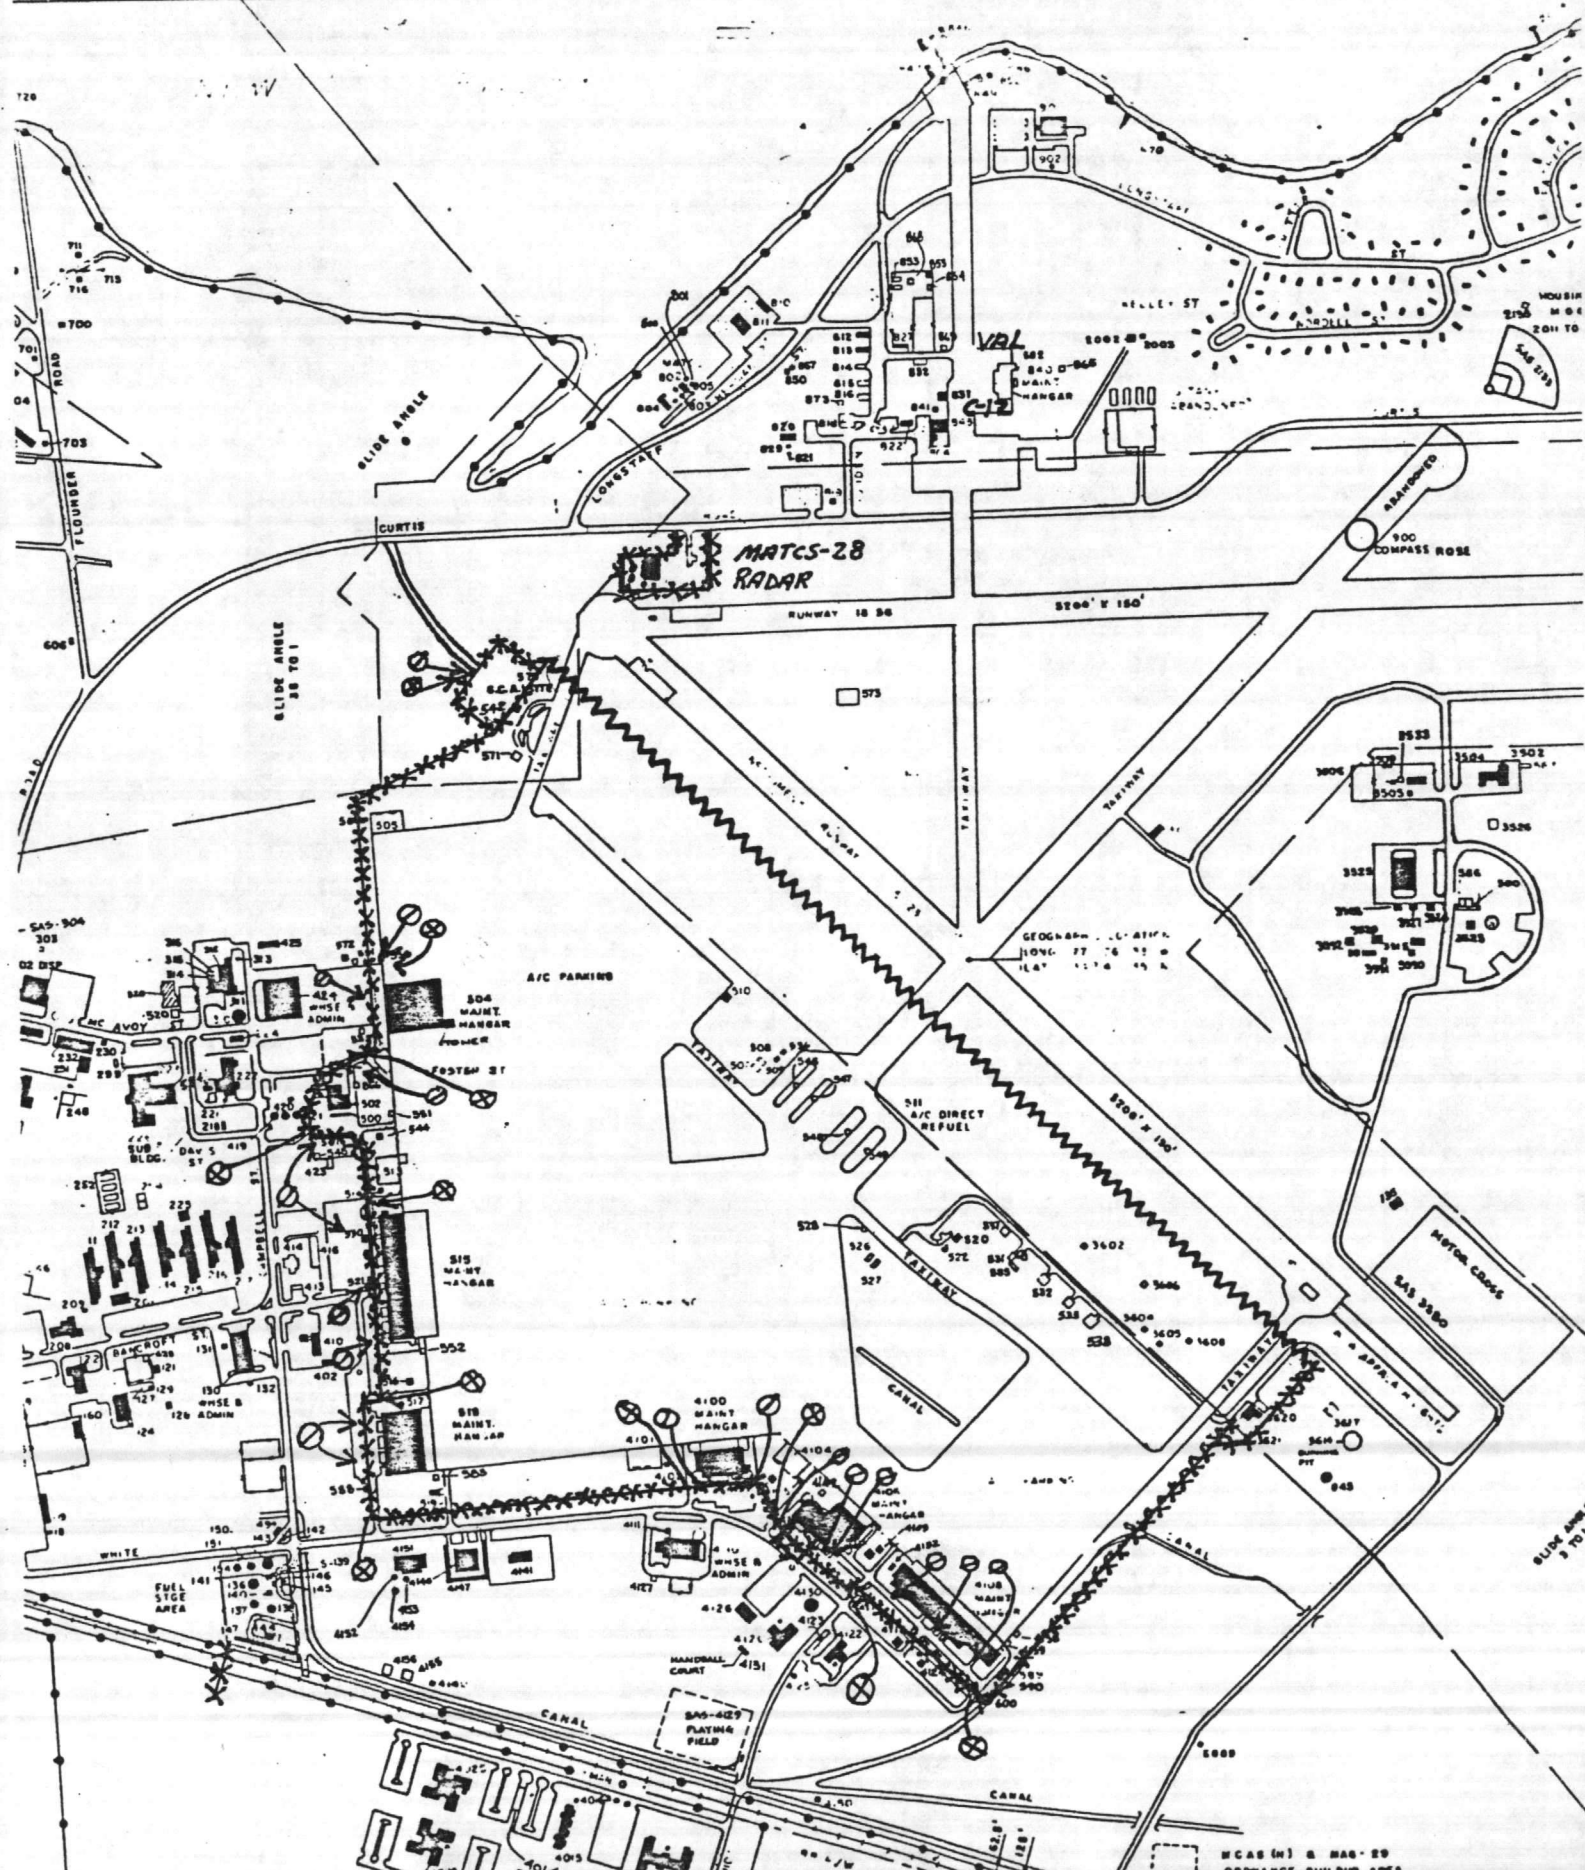

NCAS (N) & MAG-29 ORDNANCE BUILDUP AREA

