
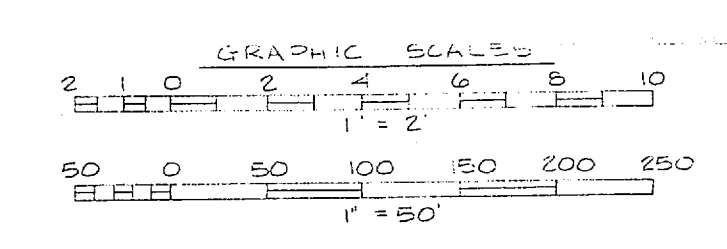


REVISIONS		
NO.	DESCRIPTION	DATE

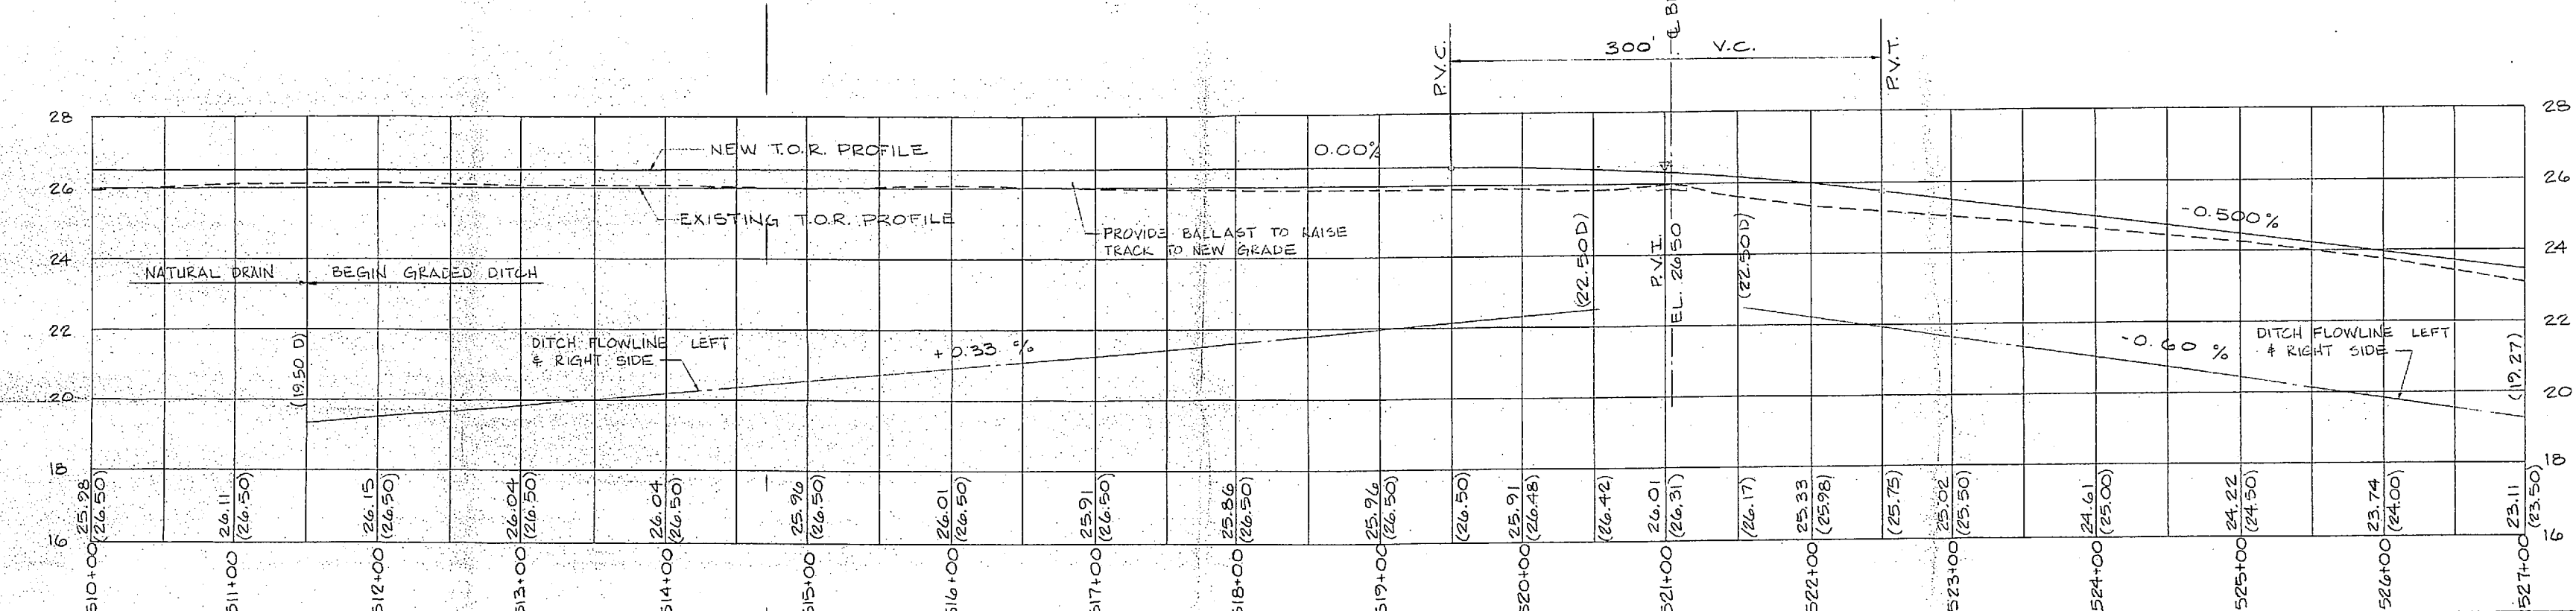

**RECORD DRAWING**  
**LETTER DATED** 17 AUG, 1987 **C-31**

DAVIS & FLOYD, INC.  
CONSULTING ENGINEERS  
GREENWOOD, SOUTH CAROLINA

DEPARTMENT OF THE NAVY  
NAVAL FACILITIES ENGINEERING COMMAND  
ATLANTIC DIVISION  
NAVAL STATION NORFOLK, VA

MARINE CORPS BASE CAMP LEJEUNE, NORTH CAROLINA  
**REPAIR RAILROAD SYSTEM**  
(SECOND INCREMENT)  
LEJEUNE R.R. STA. 510+00 TO 527+00

DATE: 8/17/87  
DRAWN BY: [Signature]  
CHECKED BY: [Signature]

ACTIVITY: SATISFACTORY TO [Signature]  
DATE: 8/17/87

SCALE AS NOTED SPEC. 03-83-3451

FRANK B. [Signature]

