




DOOR & JAMB SCHEDULE					
DOOR NO.	DOOR TYPE	SIZE	JAMB TYPE	LINTEL TYPE	REMARKS
103	A	3'-0" x 6'-8" x 1 3/4"	F	H	Wood door - 1/2" var. dr.
104	B	4'-0" x 8'-0" x 1 3/4"	D	G	Metal door - 1/2" var. dr.
105	A	2'-0" x 6'-8" x 1 3/4"	F	I	Wd. dr. - metal grille panel
102	C	2'-0" x 6'-8" x 1 3/4"	F	J	5 pl. wd. door
104	A	3'-0" x 6'-8" x 1 3/4"	F	H	Wood door
103	A	3'-0" x 6'-8" x 1 3/4"	F	I	" " "
104	C	3'-0" x 6'-8" x 1 3/4"	F	J	5 pl. wd. door

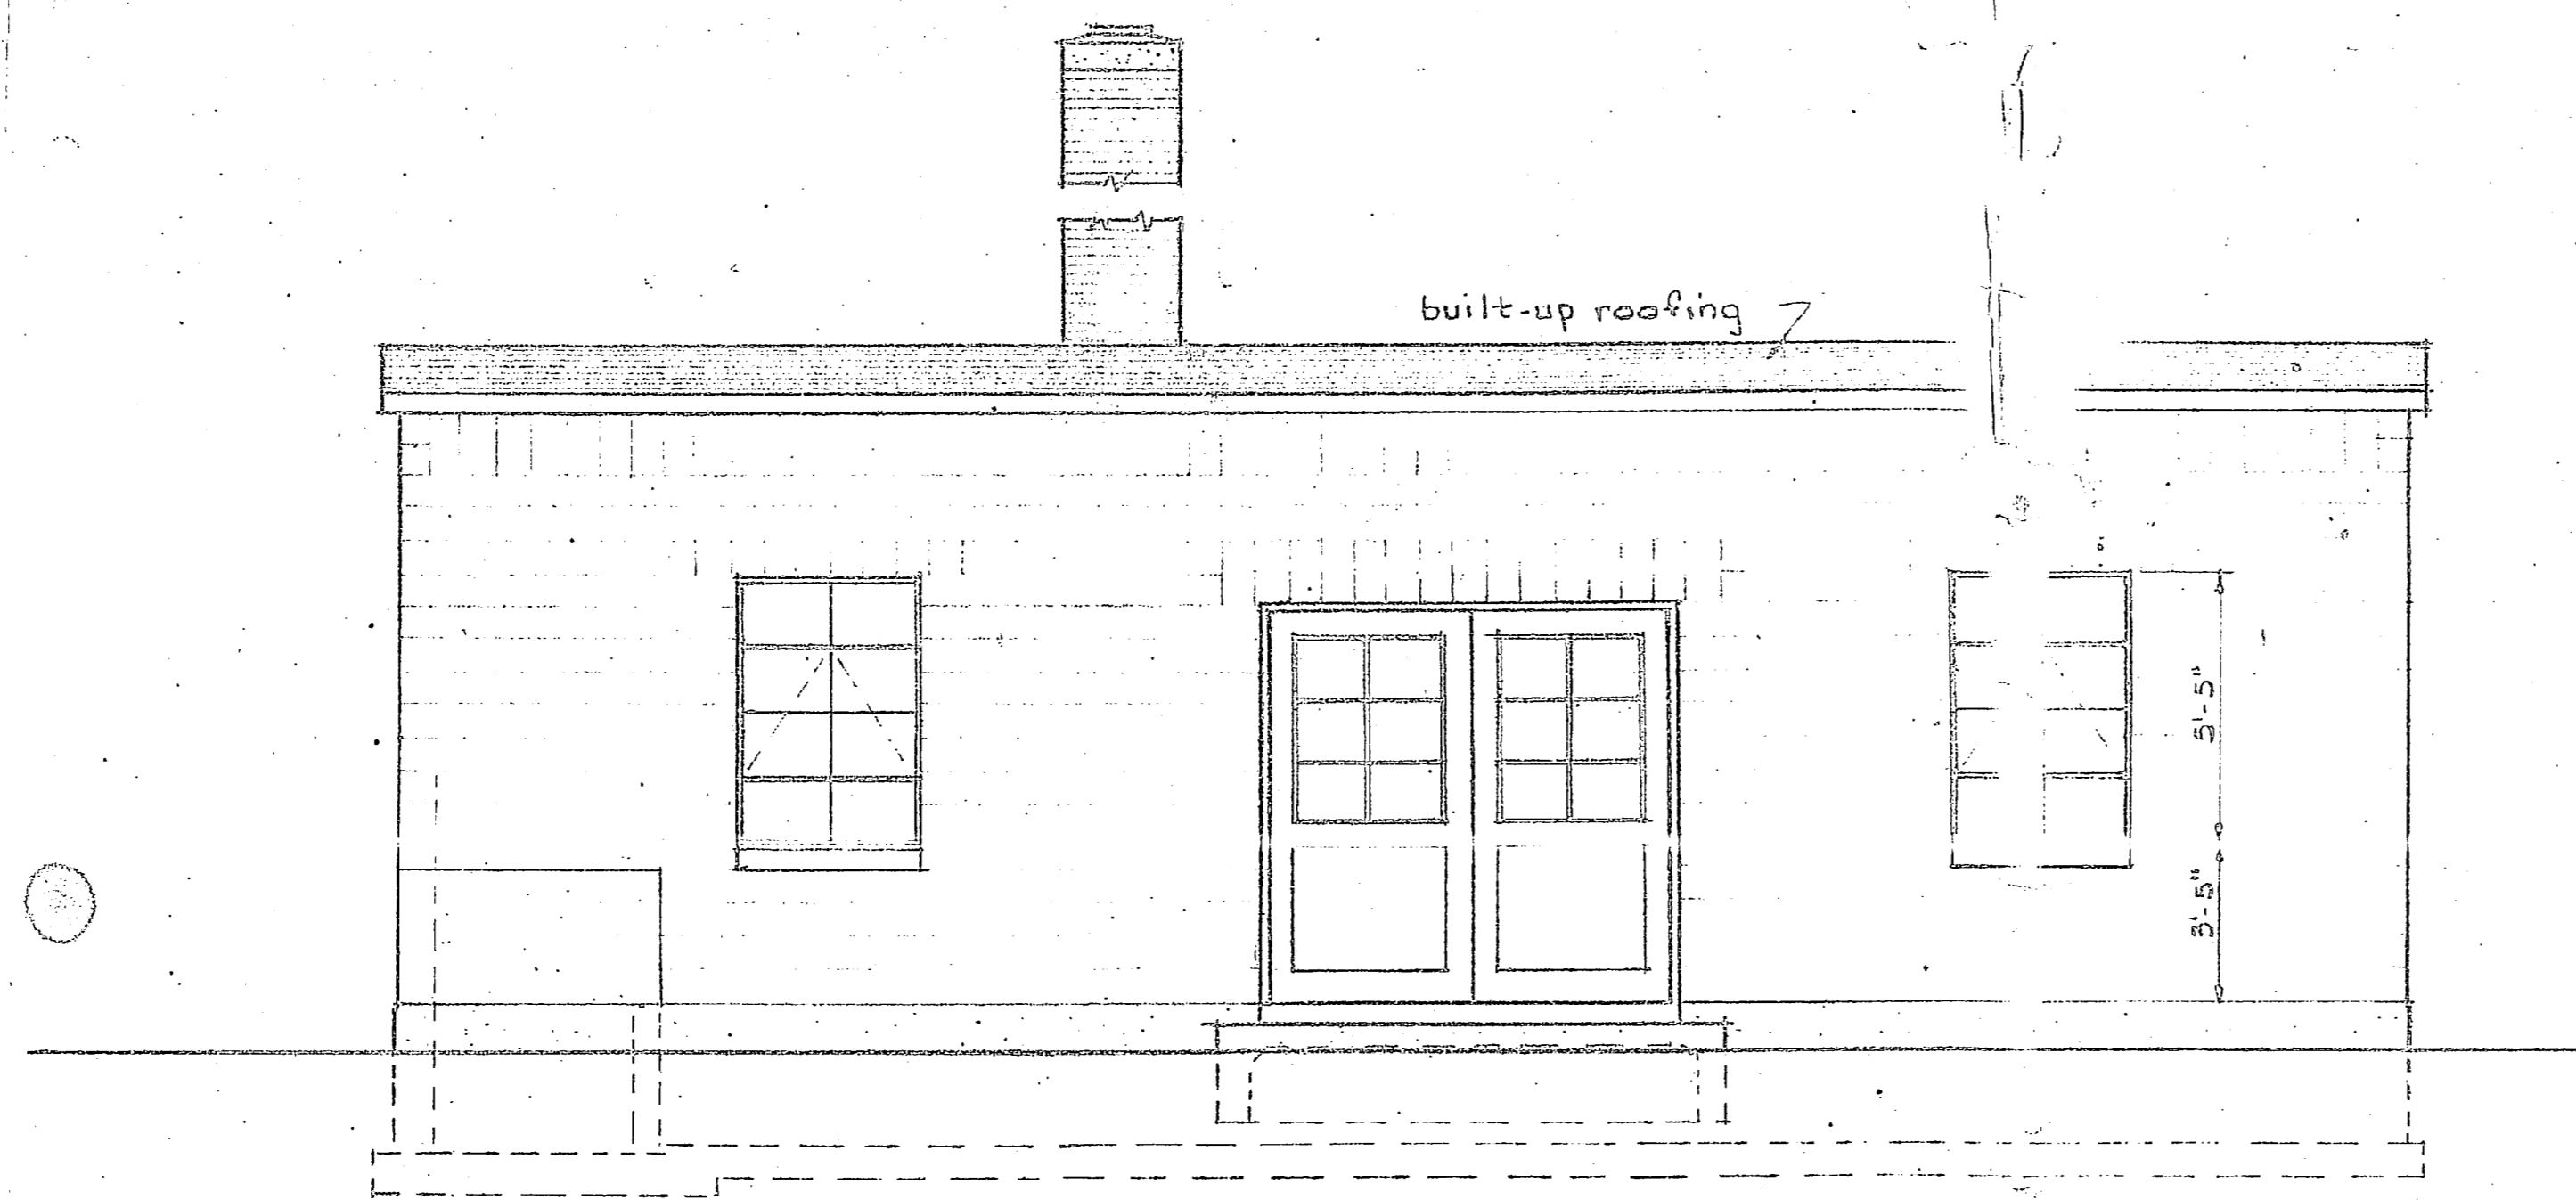


REAR ELEVATION
Scale 1/4"=1'-0"

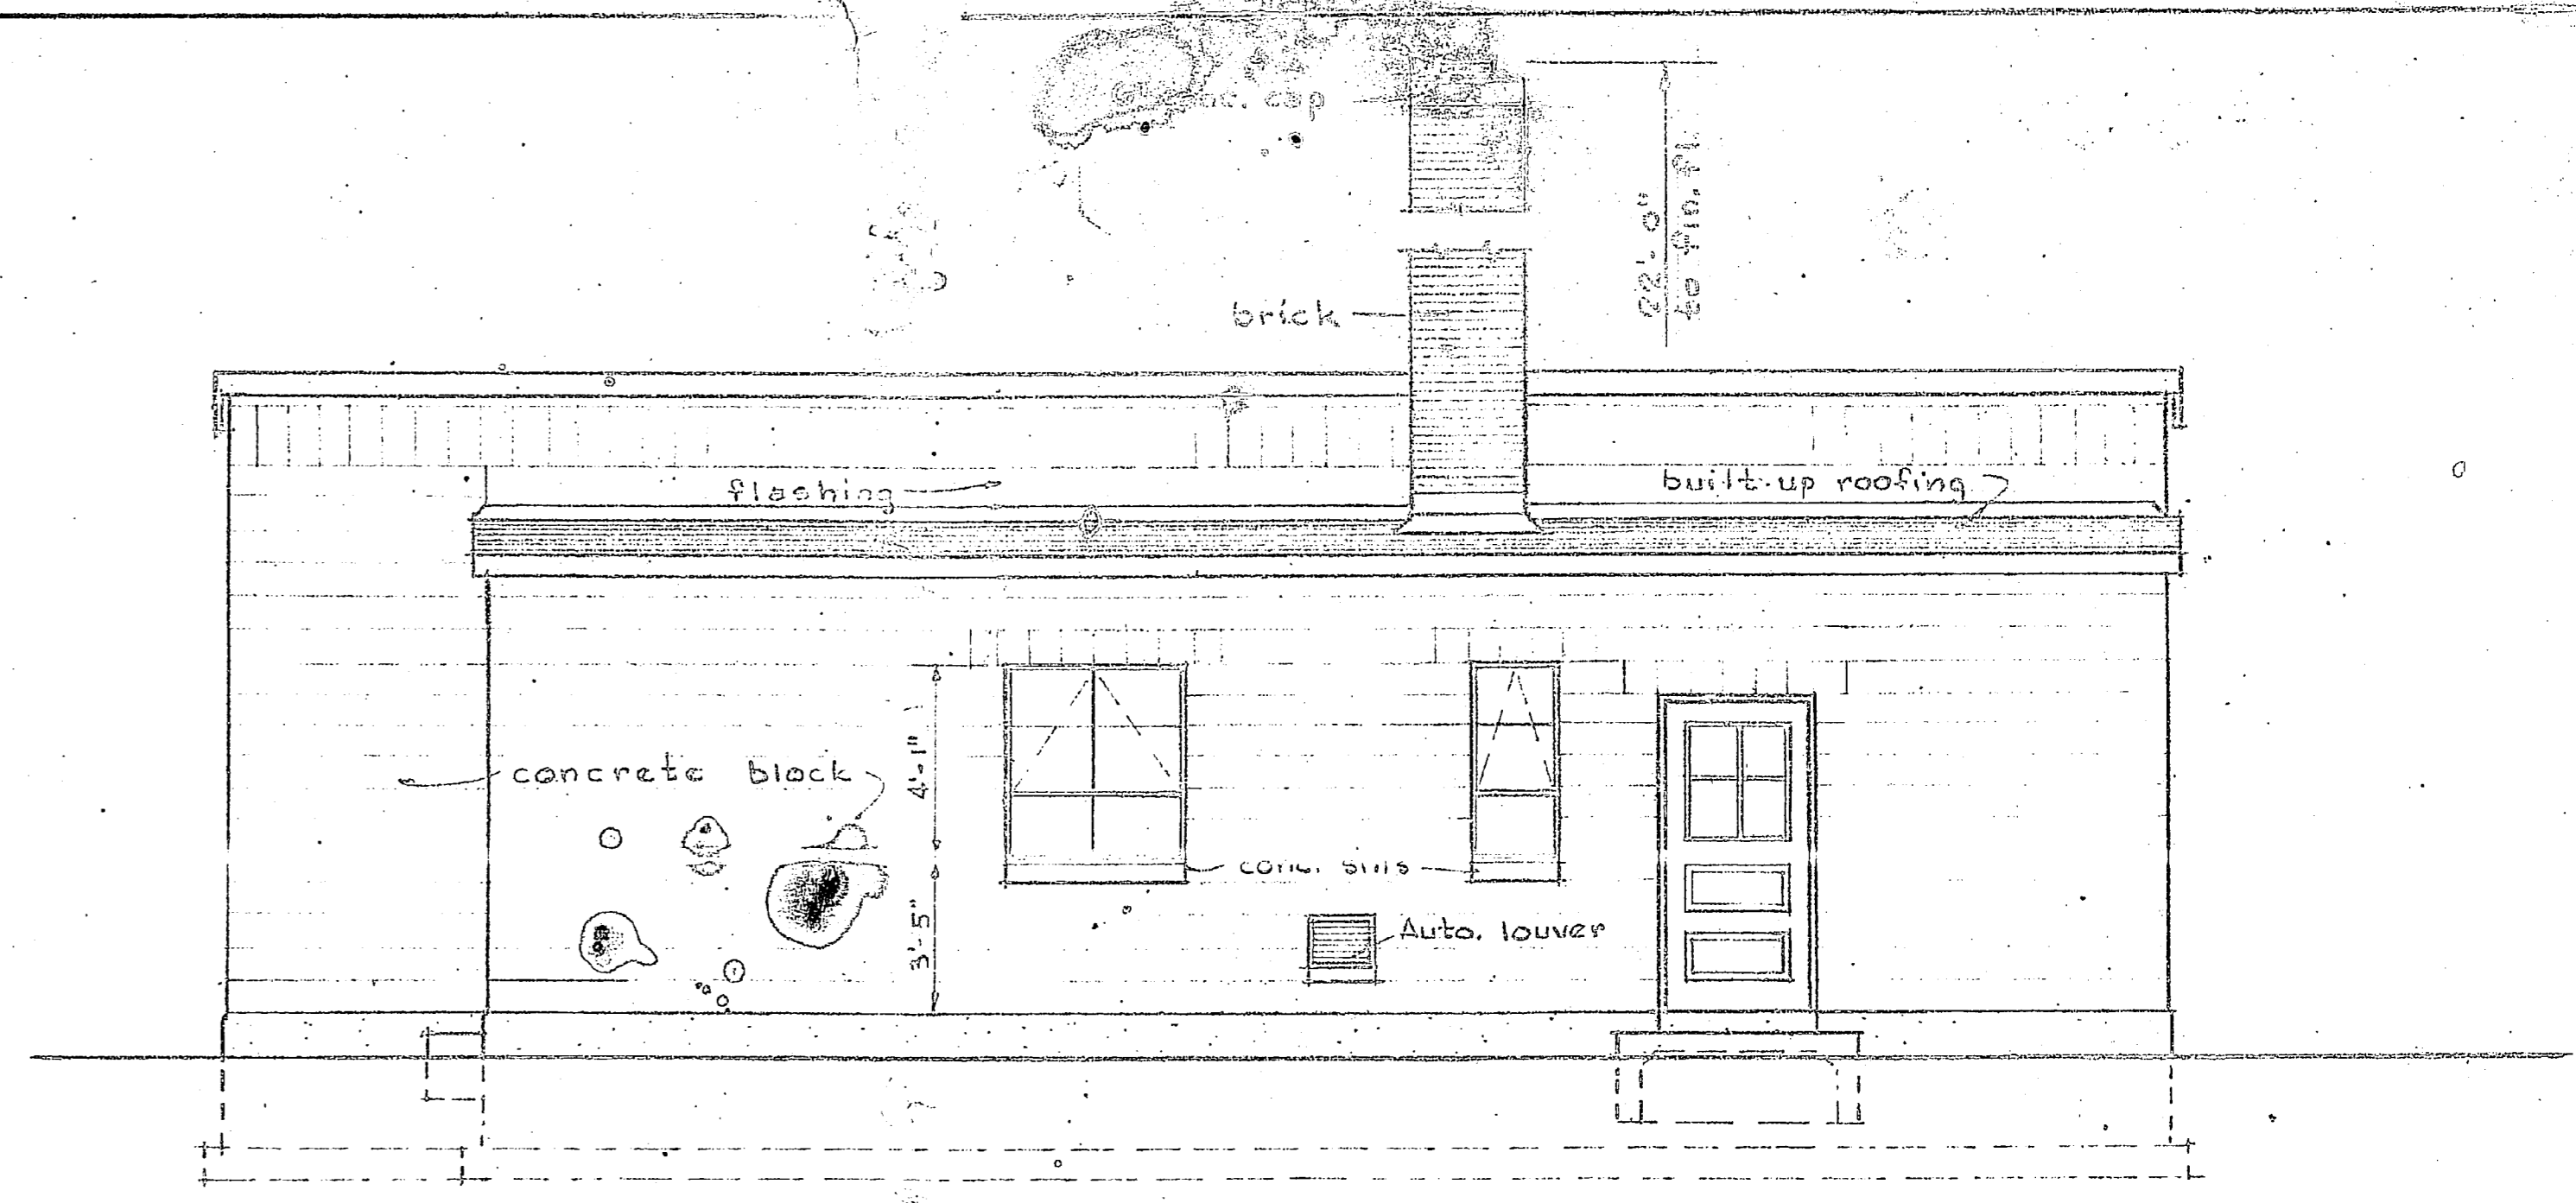


FRONT ELEVATION
Scale 1/4"=1'-0"

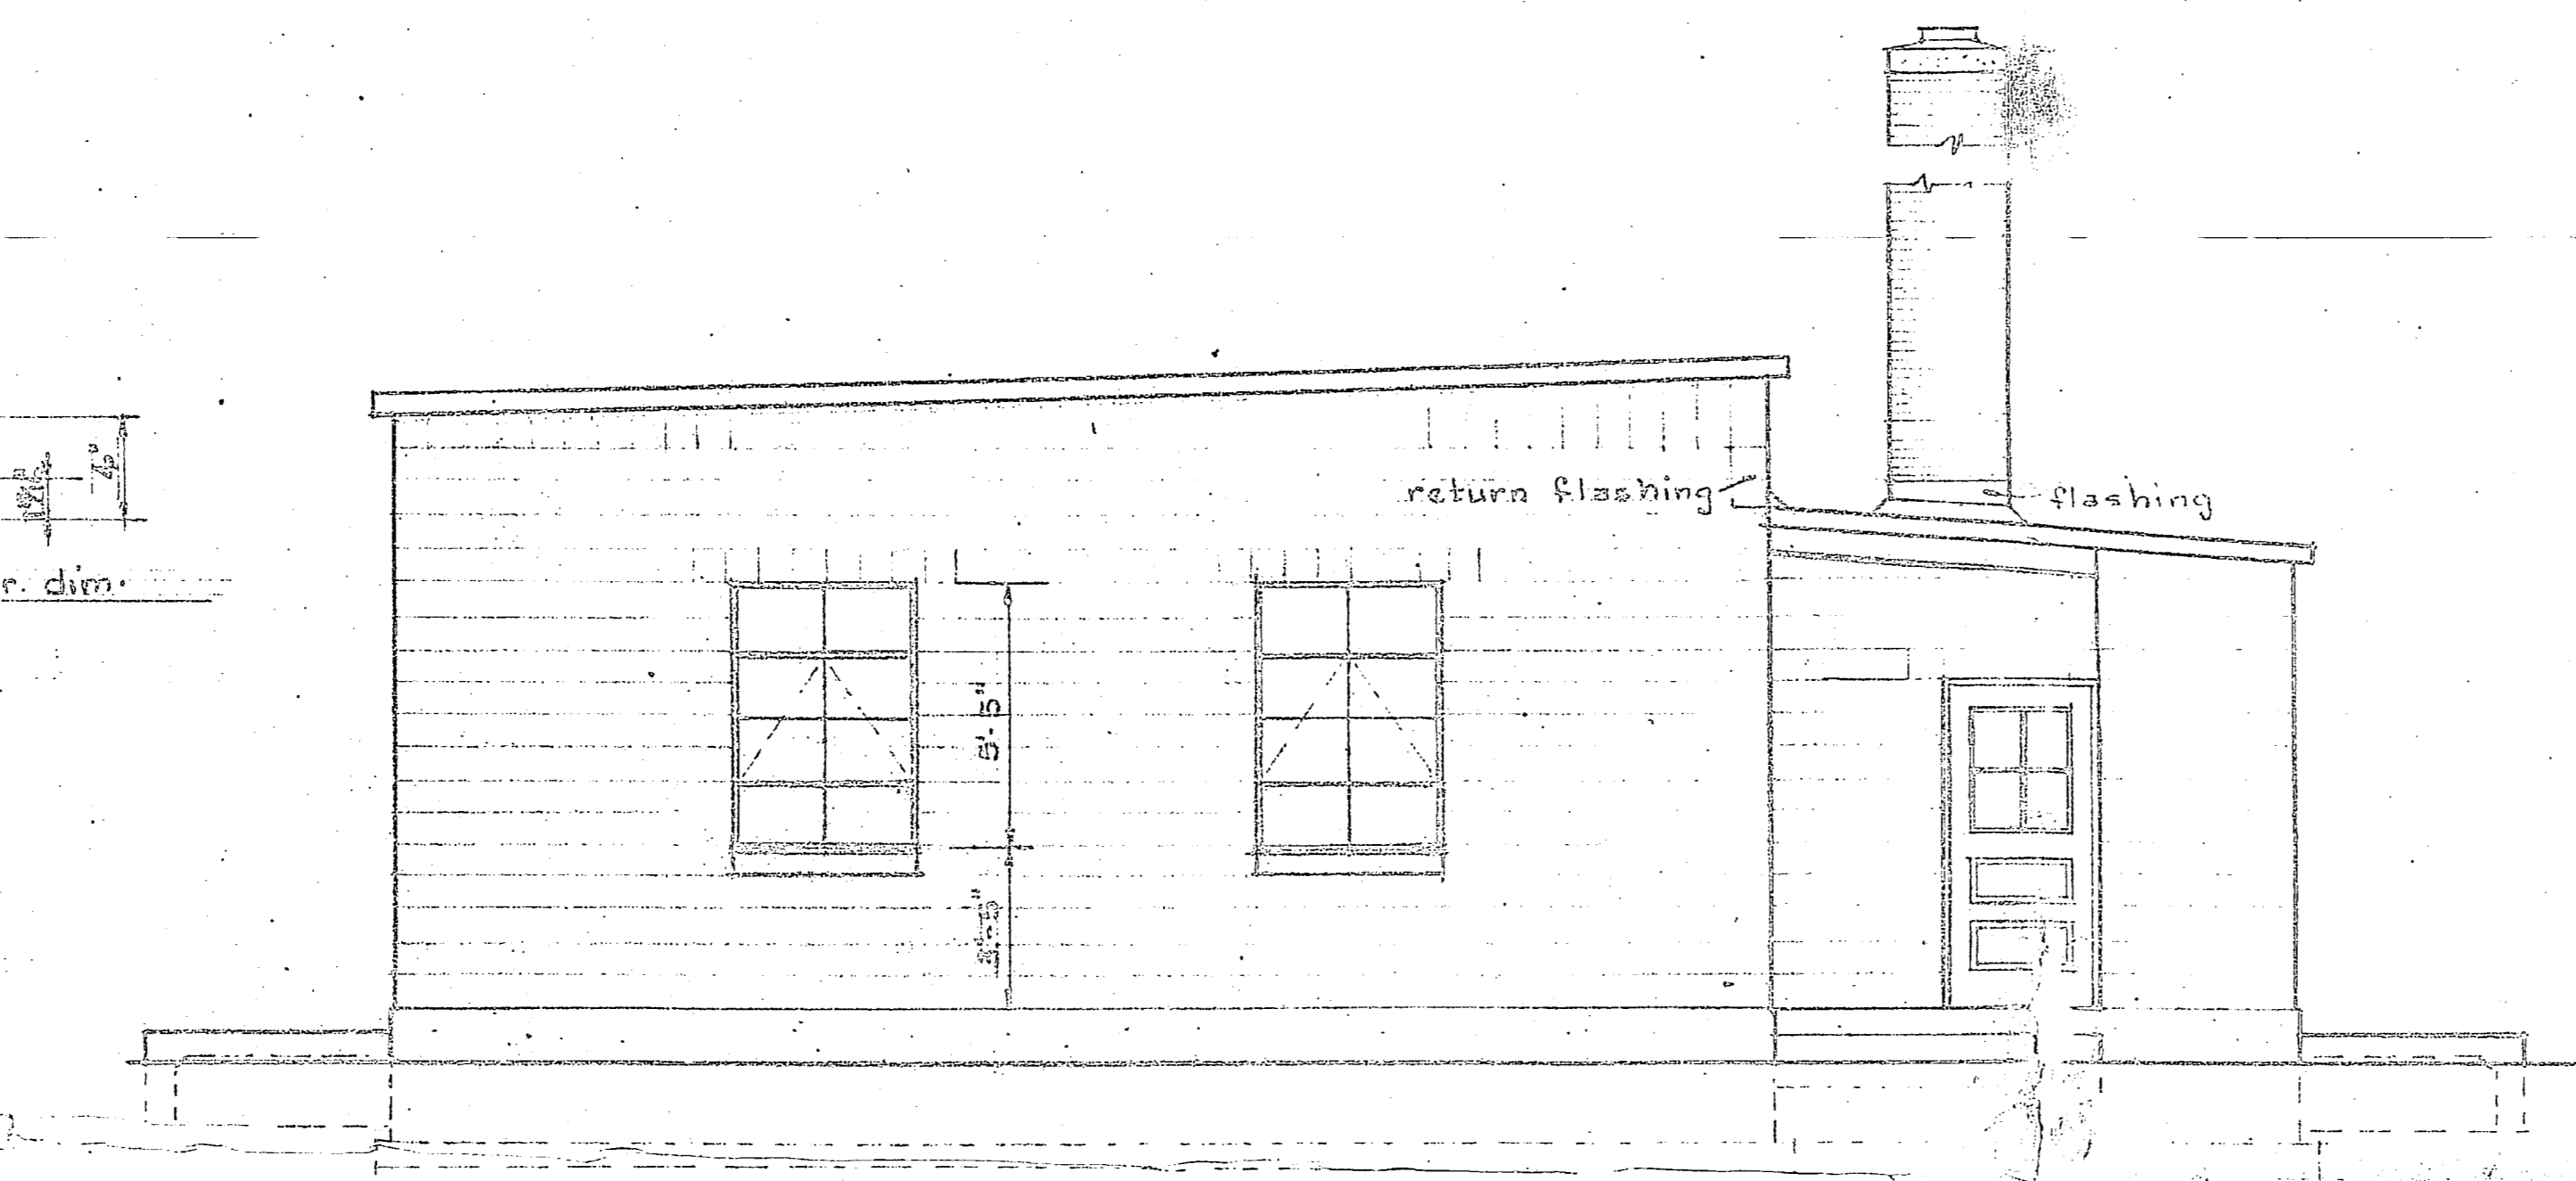


LEFT ELEVATION
Scale 1/4"=1'-0"

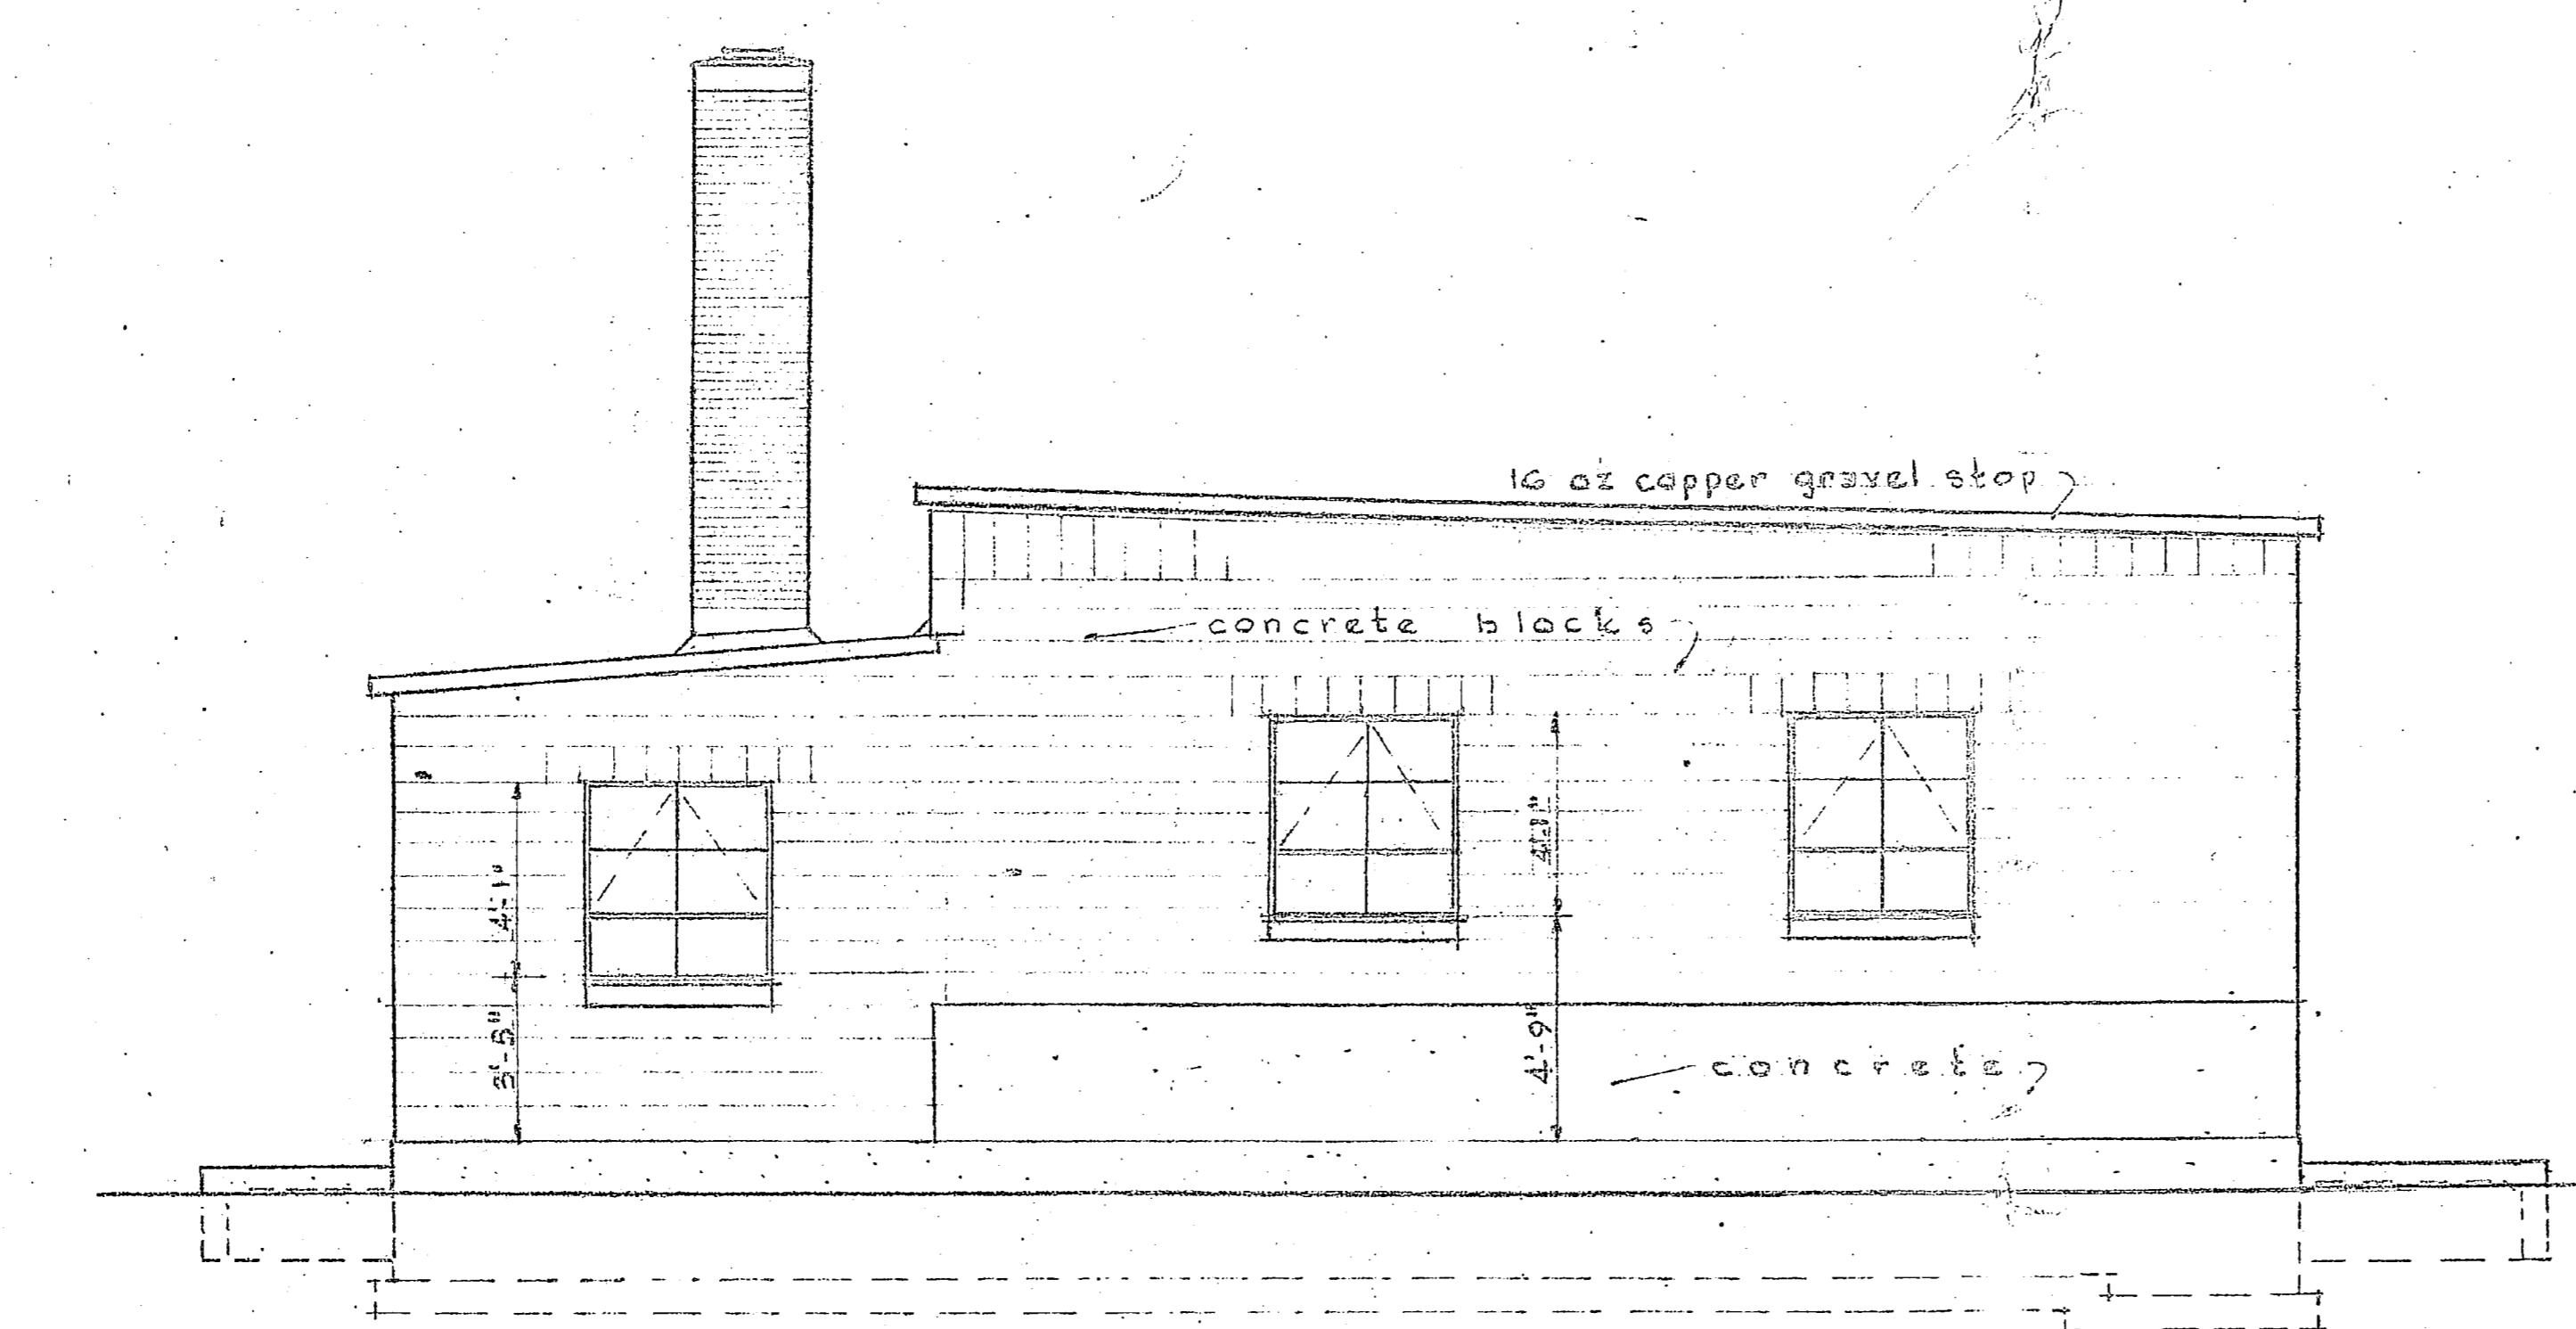


RIGHT ELEVATION
Scale 1/4"=1'-0"

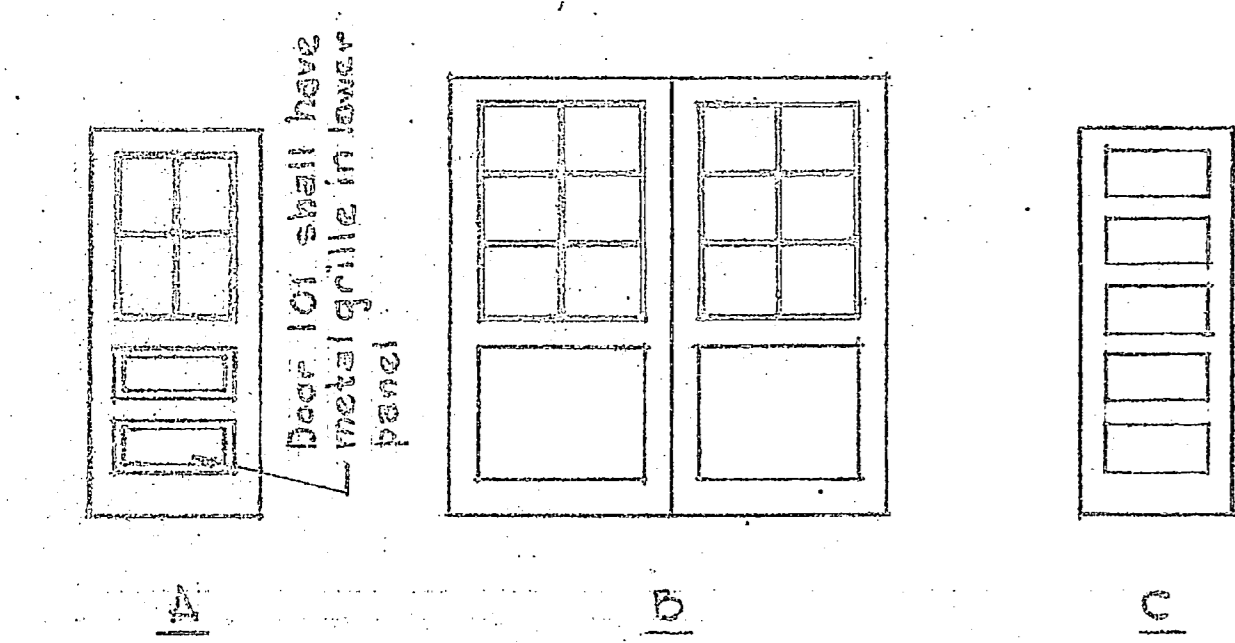


DOOR TYPES

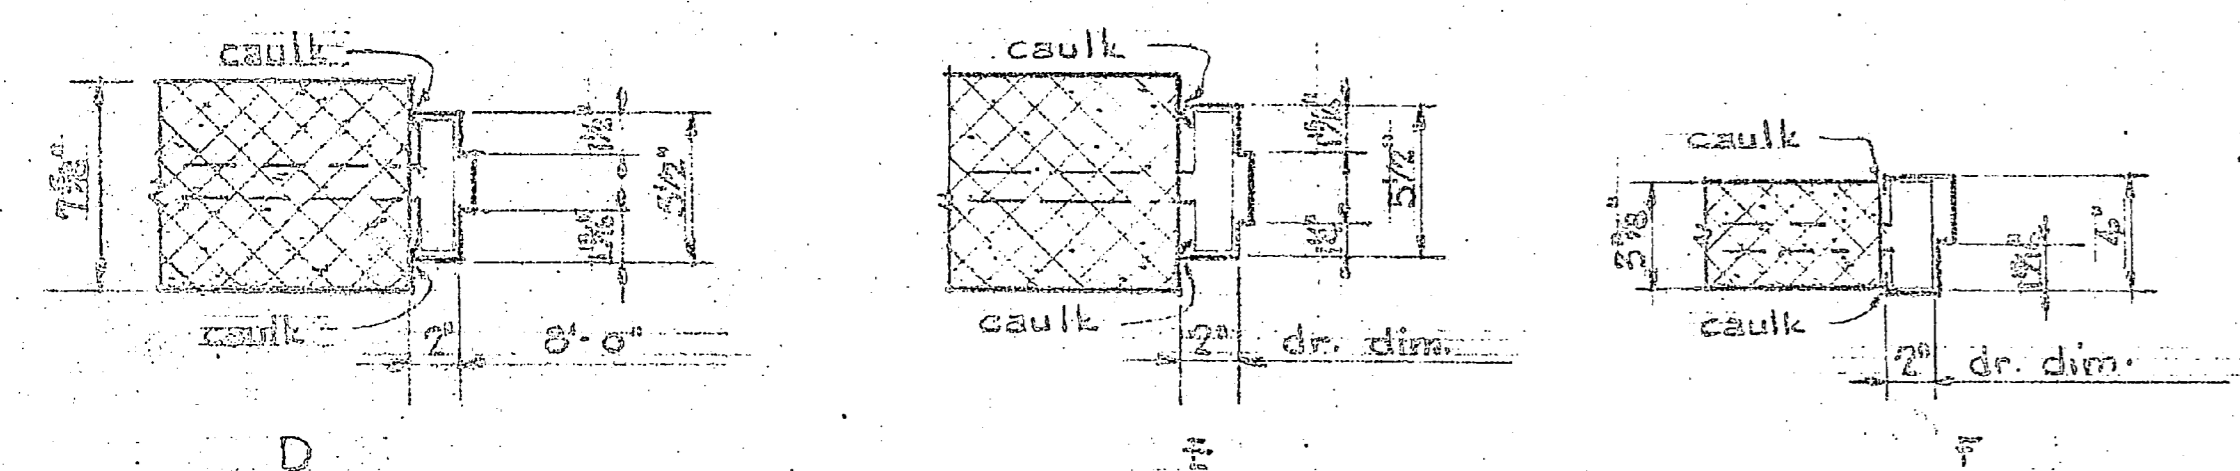


JAMB TYPES
Scale 1/2"=1'-0"

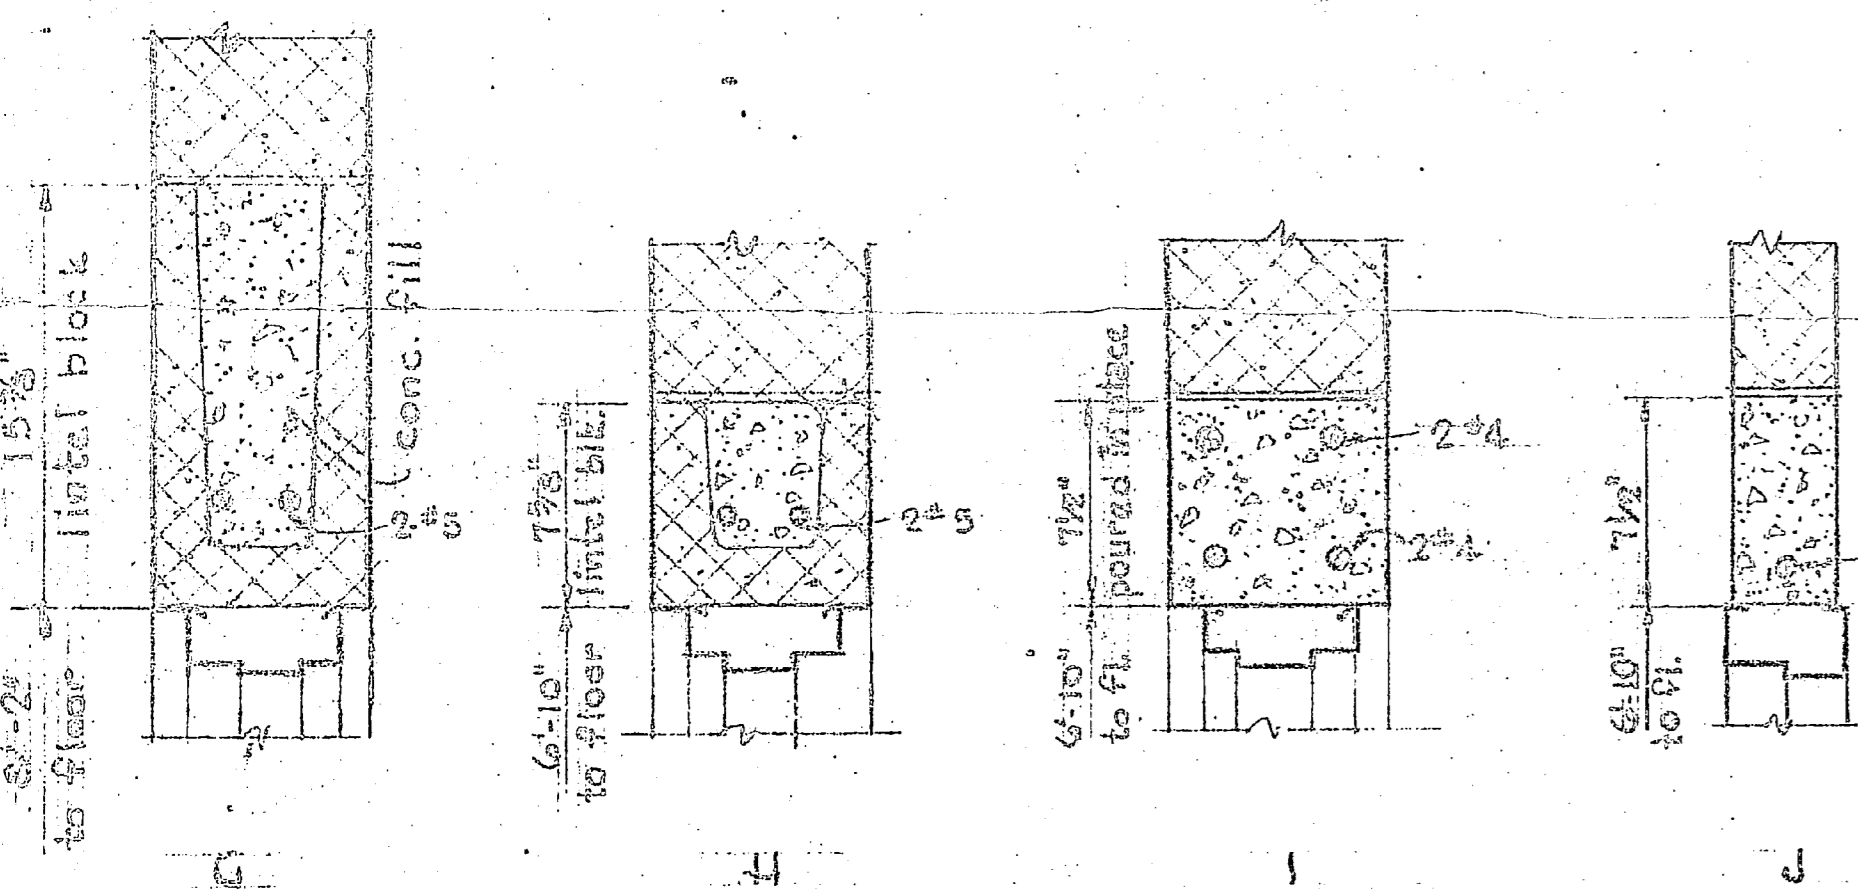

LINTEL DETAILS

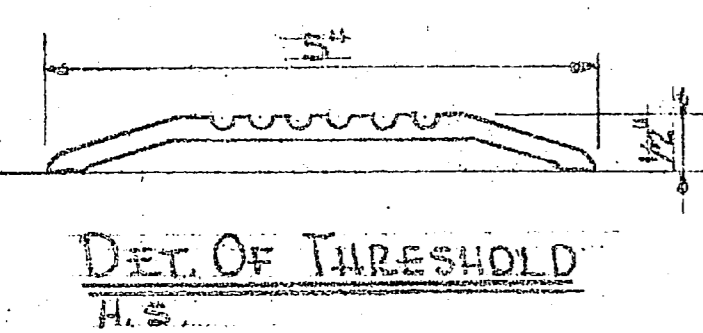


DET. OF THRESHOLD
H.S.

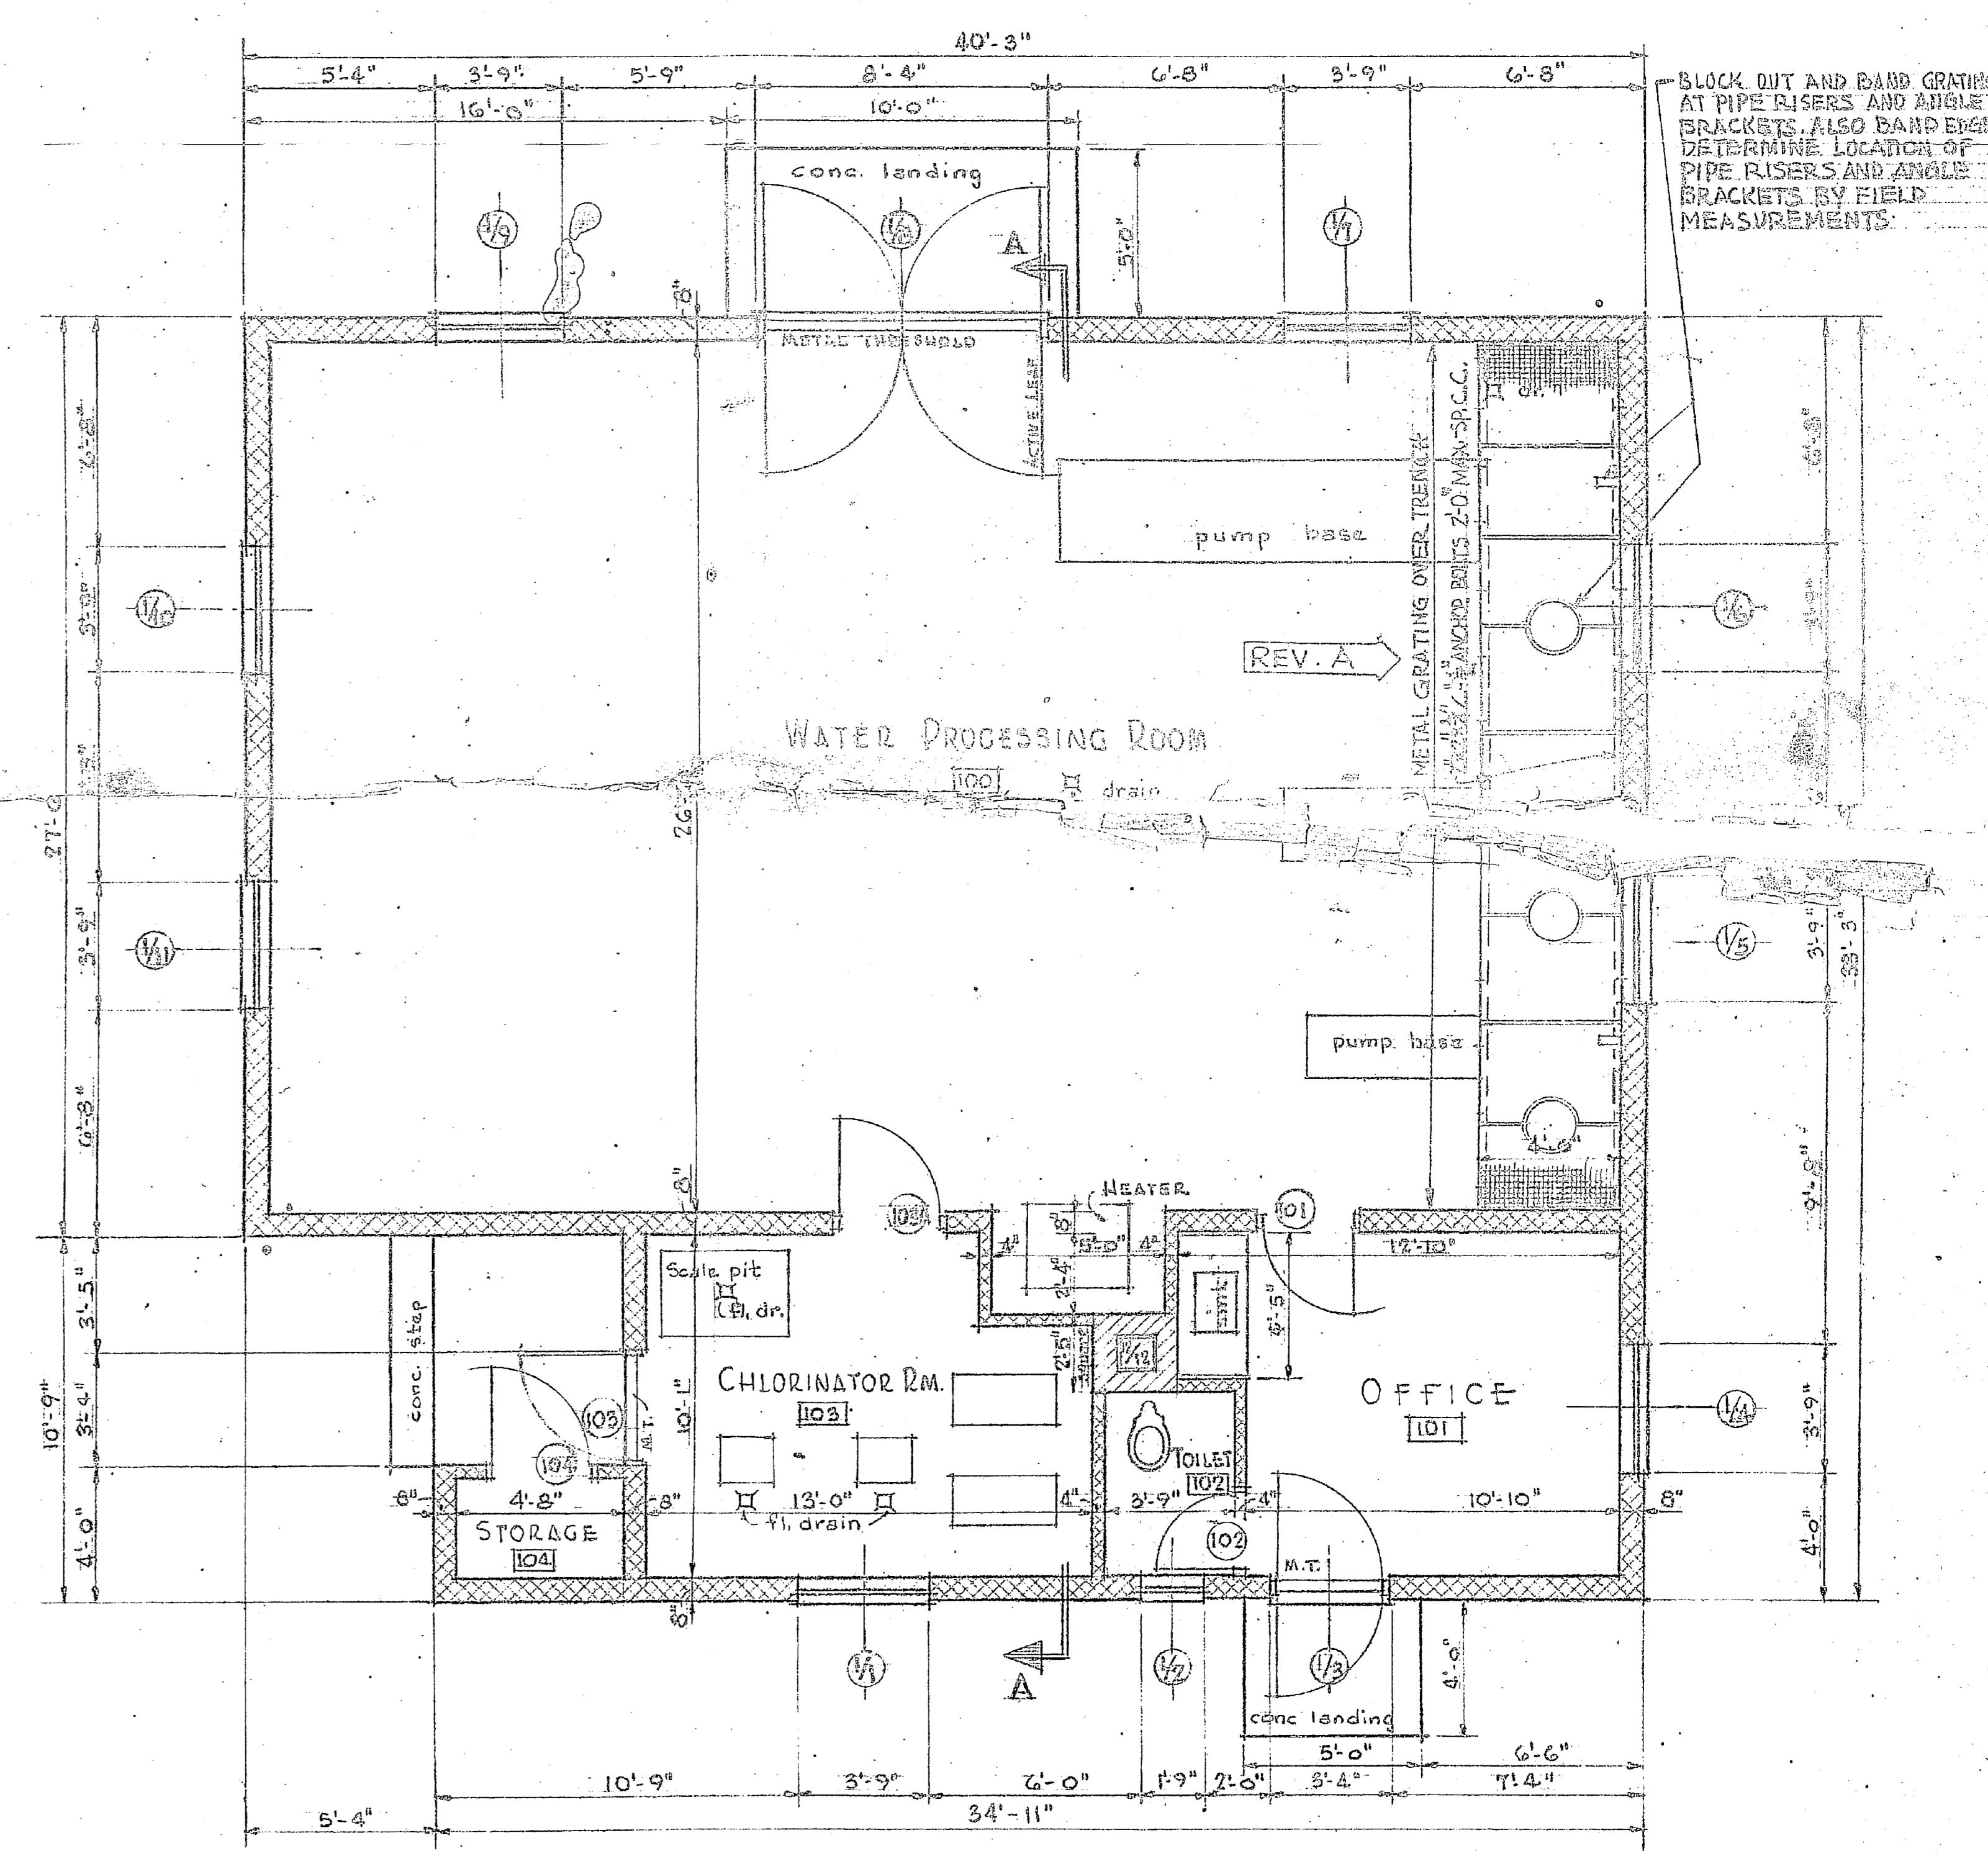

FLOOR PLAN
Scale 1/4"=1'-0"

GRAPHIC SCALES

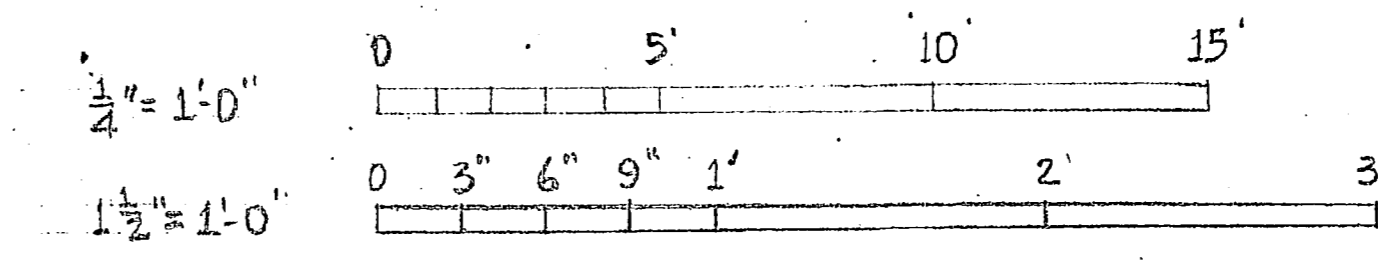

NOTE: DIMENSIONS AND ELEVATIONS
GIVEN THROUGHOUT DRAWING IN FIGURES
SHALL BE USED IN PREFERENCE TO SOME
MEASUREMENTS.

SATISFACTORY TO MARINE BASE, CAMP LEJEUNE
DATE 2 Feb 56
SIGNED *H. J. ...*
COMMANDING GENERAL

REVISION	DATE	APPD.	DESCRIPTION
A	1-23-57		ADDED METAL GRATING OVER PIPE TRENCH
P.W. DRAWING NO. 10534			MARINE CORPS BASE CAMP LEJEUNE, N. C.
DES. <i>W. B. ...</i> DRWN. <i>W. B. ...</i> TR. <i>W. B. ...</i>			WATER TREATMENT FACILITIES ON SLOW BEACH
CHK. <i>S. J. ...</i> SUPV. <i>S. J. ...</i> IN CHARGE <i>S. J. ...</i>			WATER PLANT FLOOR PLAN AND ELEVATIONS
APPROVED			DATE 2 Feb 56
SIGNED <i>[Signature]</i> PUBLIC WORKS OFFICER			
APPROVED FOR BUREAU OF YARDS & DOCKS			SCALE GRAPHIC SPEC 49928
SIGNED _____ DPWO FOR CHIEF OF BUREAU			SHEET 6 OF 17 No. 93544
DATE _____ THE QUARTERMASTER GENERAL OF THE MARINE CORPS			Y & D DRAWING NO. 646734

