





SEE SECONDARY SHEET NO. 7 ORIGINAL SHEET NO. 1

SEE SECONDARY SHEET NO. 9 ORIGINAL SHEET NO. 5

REVISION	DATE	APPR.	DESCRIPTION	BY
1	11-1-54		"AS-BUILT" REVISION, POLES A58 THRU A104 RENUMBERED	ILT
P.W. DRAWING NO.			MARINE CORPS BASE CAMP LEJEUNE, N.C.	
9744			ELECTRICAL POWER EXTENSIONS AND IMPROVEMENTS	
DES. <i>[Signature]</i>			POLE NUMBERING HOLCOMB BOULEVARD	
DRWN. <i>[Signature]</i>			APPROVED <i>[Signature]</i> DATE 11 Jan. 1952	
TR. <i>[Signature]</i>			PUBLIC WORKS OFFICER	
CHK. <i>[Signature]</i>			APPROVED FOR BUREAU OF YARDS & DOCKS	
IN CHARGE <i>[Signature]</i>			SCALE Graphic SPEC 42726	
SHEET 8 OF 34 NO. 82881			DPWO FOR CHIEF OF BUREAU	
DATE			Y & D DRAWING NO. 613844	

SATISFACTORY TO
THE QUARTERMASTER GENERAL OF
THE MARINE CORPS
DATE

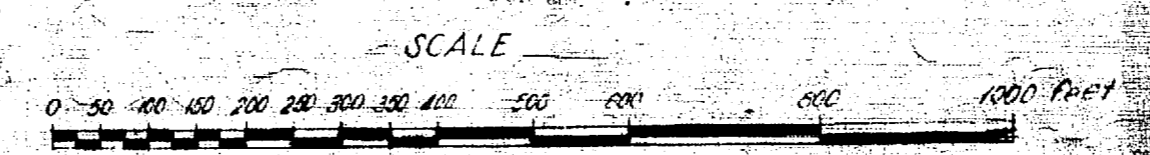

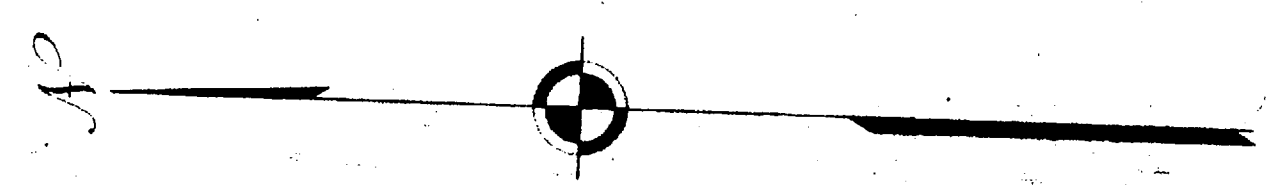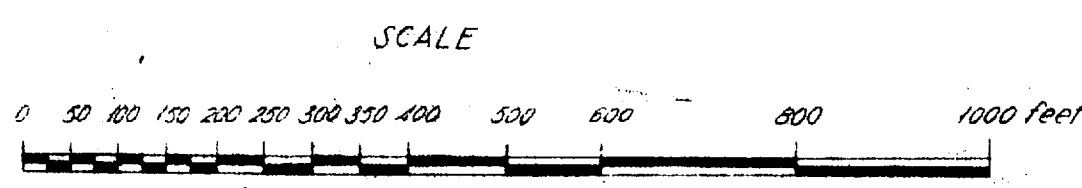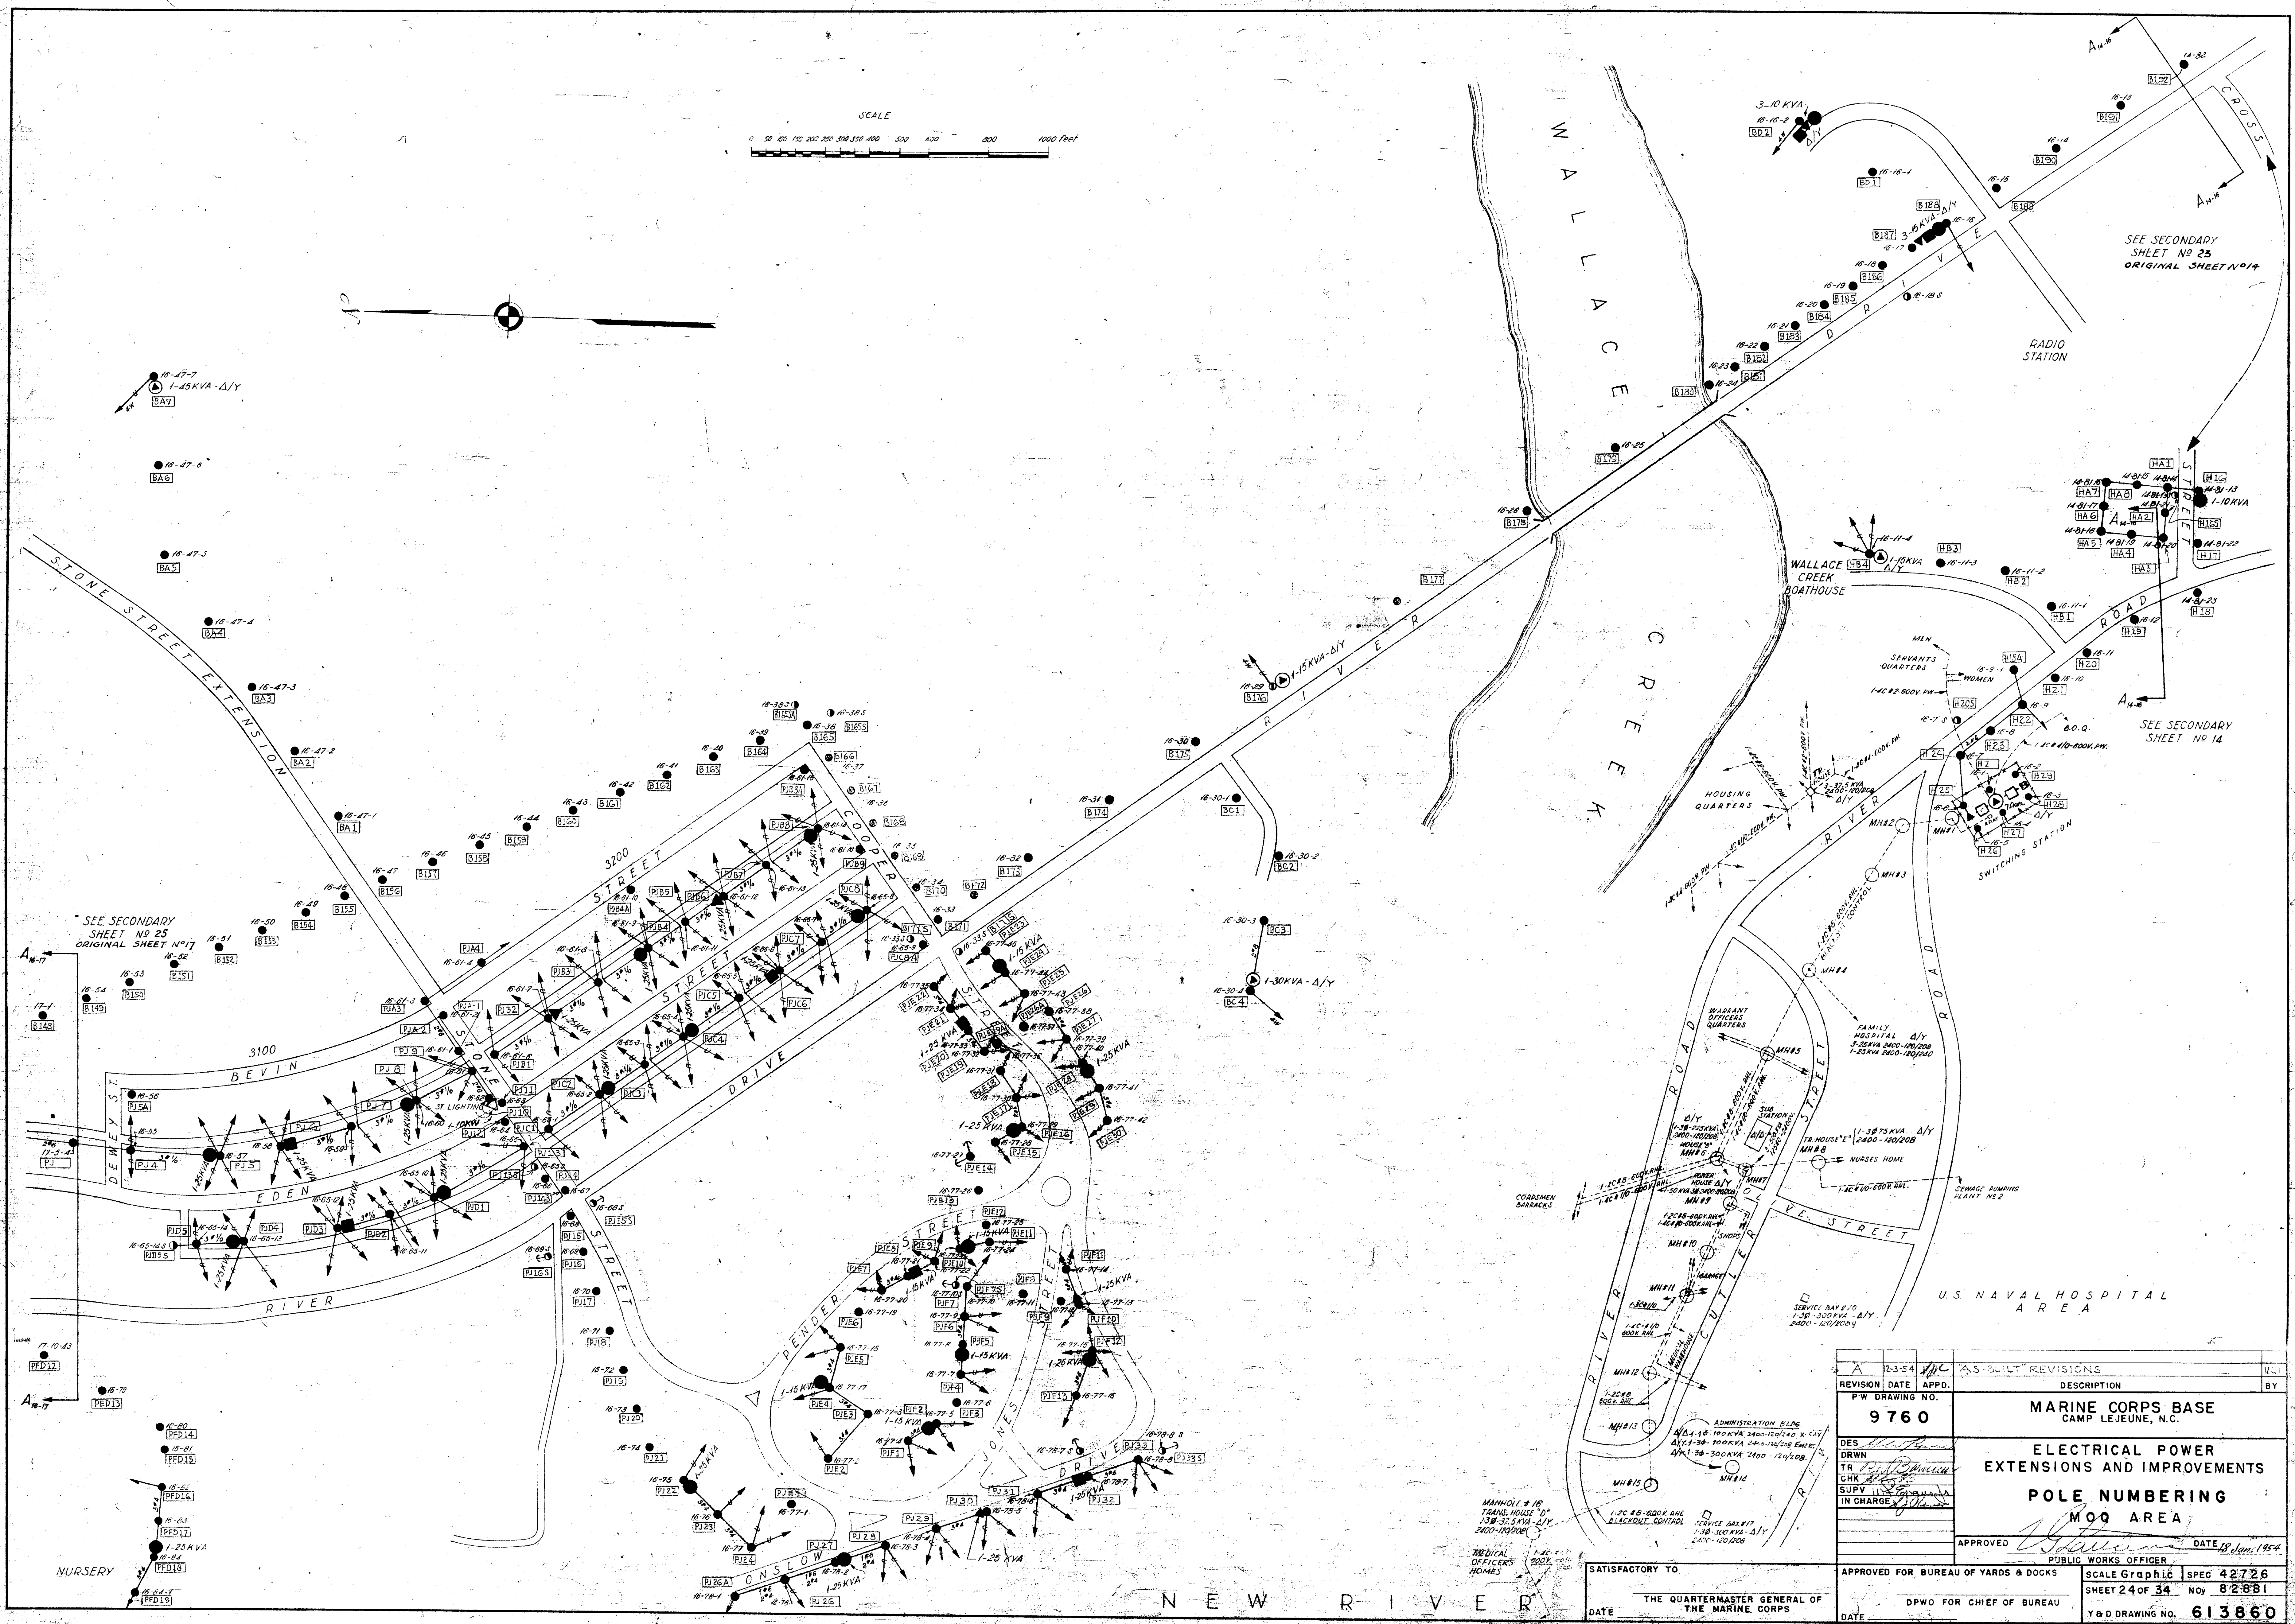

SEE SECONDARY SHEET NO 23 ORIGINAL SHEET NO 14

SEE SECONDARY SHEET NO 14

SEE SECONDARY SHEET NO 25 ORIGINAL SHEET NO 17

REVISION	DATE	APPD.	DESCRIPTION	BY
A	2-3-54	MJC	"AS-BUILT" REVISIONS	VLI
P.W. DRAWING NO. 9760				
MARINE CORPS BASE CAMP LEJEUNE, N.C.				
ELECTRICAL POWER EXTENSIONS AND IMPROVEMENTS POLE NUMBERING MOO AREA				
APPROVED <i>[Signature]</i> DATE 18 April 1954				
APPROVED FOR BUREAU OF YARDS & DOCKS				
PUBLIC WORKS OFFICER				
DATE 18 April 1954				
APPROVED FOR CHIEF OF BUREAU				
DATE				
SHEET 24 OF 34				
NO. 82881				
Y & D DRAWING NO. 613860				

SATISFACTORY TO
THE QUARTERMASTER GENERAL OF
THE MARINE CORPS
DATE

NEW R I V E R

