


90 KIDS
 Already have chert
 limit to F.D.

need Smoke Detectors

405
 27x15

28x27 = 756

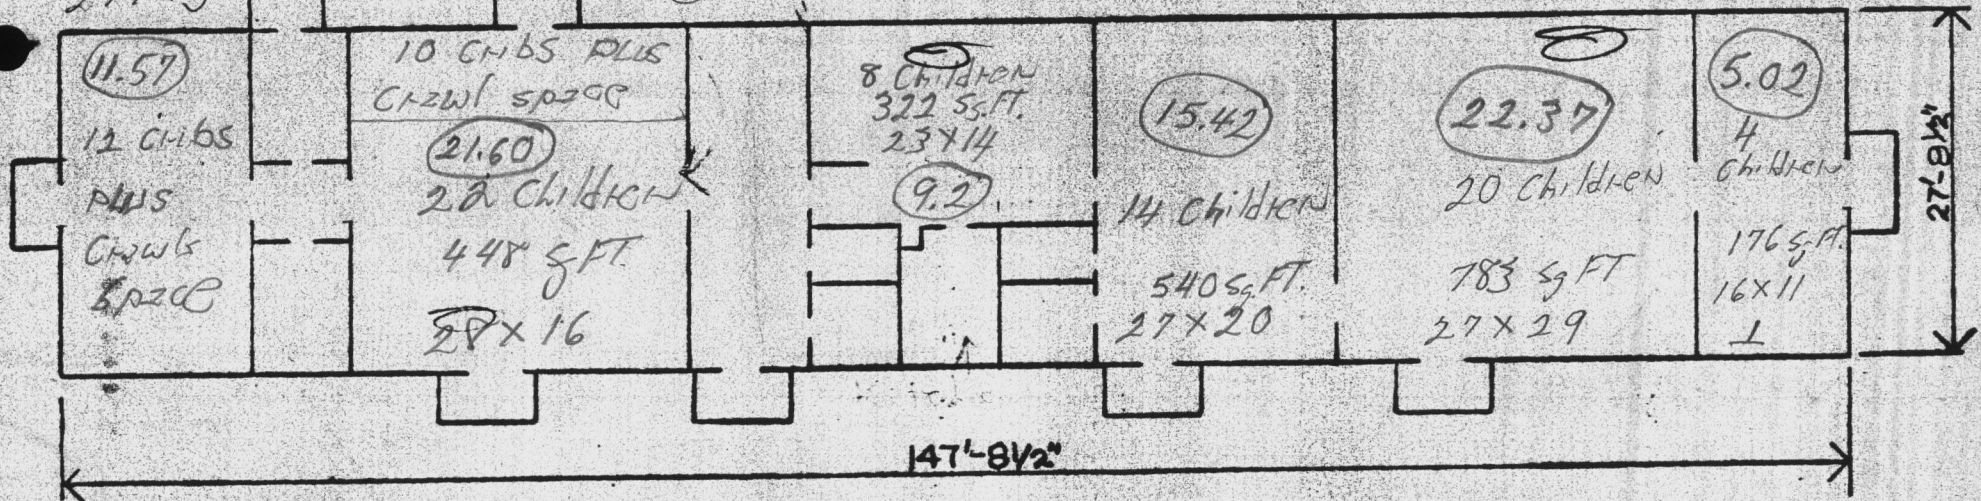

occ. limit 90 "also count"

FLOOR PLAN - BLDG. 2624
(CHILD CARE CENTER)

SF. = 4138

2982 = 85 children

1156 SF

EXHIBIT "A" TO
 LICENSE No. LIC-0-26

SKETCH No. 477

Handwritten notes on the left side of the page, including the number 100.

Handwritten notes in the upper middle section of the page.

Handwritten notes in the middle section of the page.

Handwritten notes in the lower middle section of the page.

Handwritten notes on the right side of the page, including a circled number 100.

Handwritten notes on the left side of the page, including the number 100.

Handwritten notes in the lower middle section of the page.

Handwritten notes in the middle section of the page.

Handwritten notes in the lower middle section of the page.

Handwritten notes on the right side of the page, including a circled number 100.


Centers Room

17 ft



Access

17 ft.




①

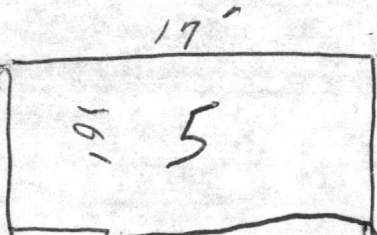


10 ft

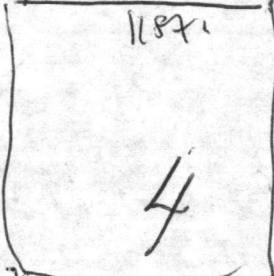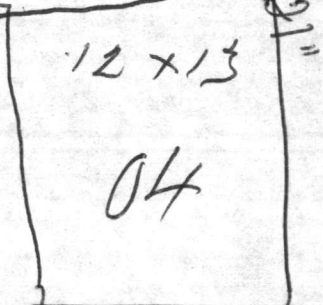

13 ft
centers

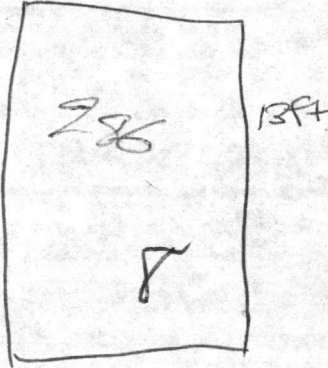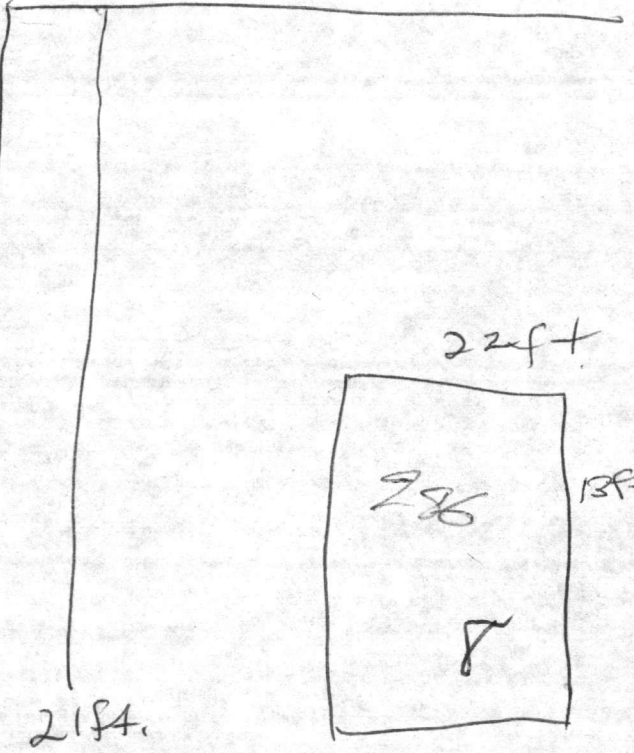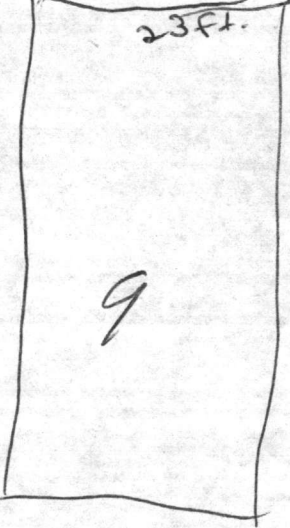


yellow
classroom

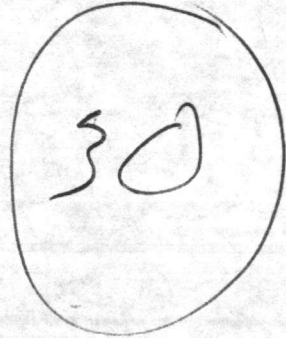


Faint handwritten text at the top of the page, possibly including a date or page number.

①

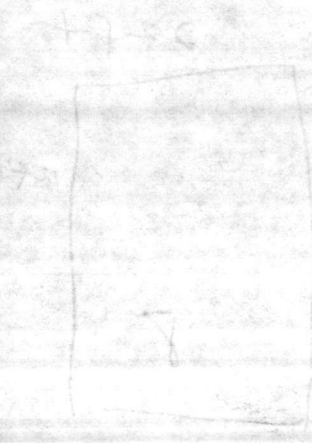

Handwritten text below the left diagram, possibly a label or description.

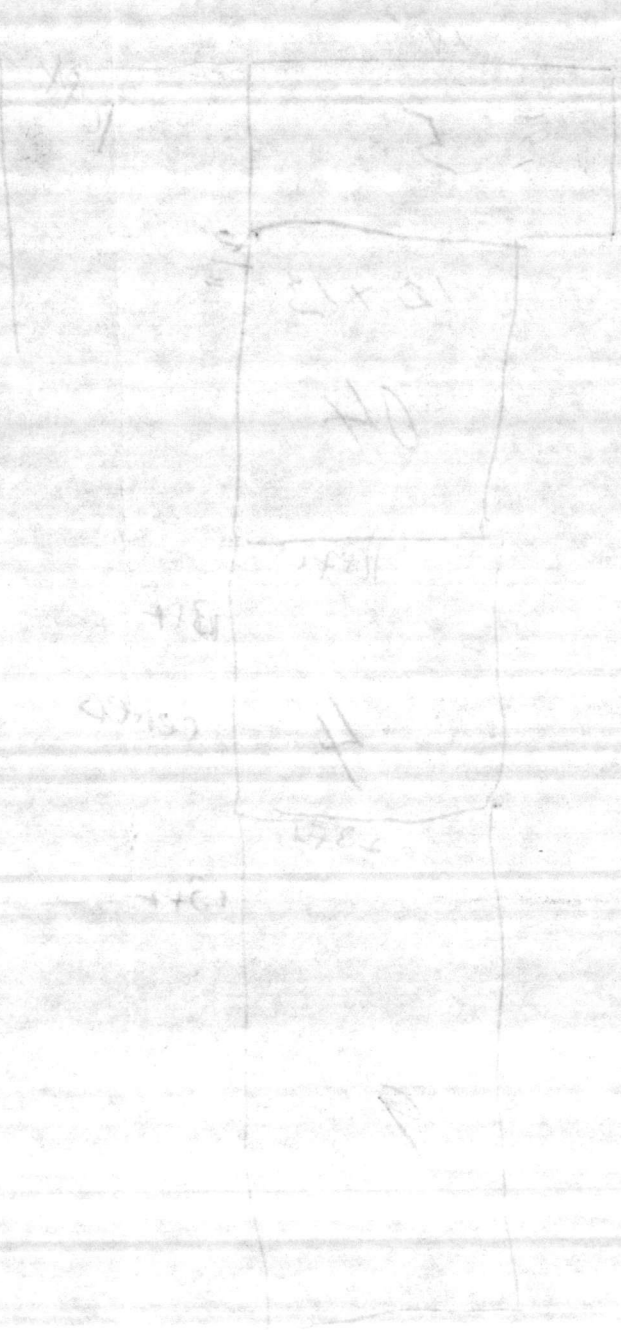

11x11

12x12

11x11

12x12

462 sq. FT.

13.20

12 children

21 x 22

3

40 sq. ft.

Kitchen

Rest room's

STORAGE

TT 2475

12 Children

463 sq. FT.

11 x 22

13 x 17

4

Storage RM

40 sq. ft.

13.22

22.28

20 children

780 sq. FT.

26 x 30

5

40 sq. ft.

30.11

26 children

1054 sq. FT.

31 x 34

2

40 sq. ft.

4885 = 140 children

30 x 20 = 600 sq. FT.

24 x 17 = 408 sq. FT.

28.70

31.88

28 children

1116 sq. FT.

31 x 36

1

40 sq. ft.

19 cribs to include crawl space.

OFFICE

" OLD COUNT 117 OCC. LOAD "

6

12-22

12-22

12-22

MIDWAY PK.

3128 sq. FT. = 89 children

72 OLD count.

