
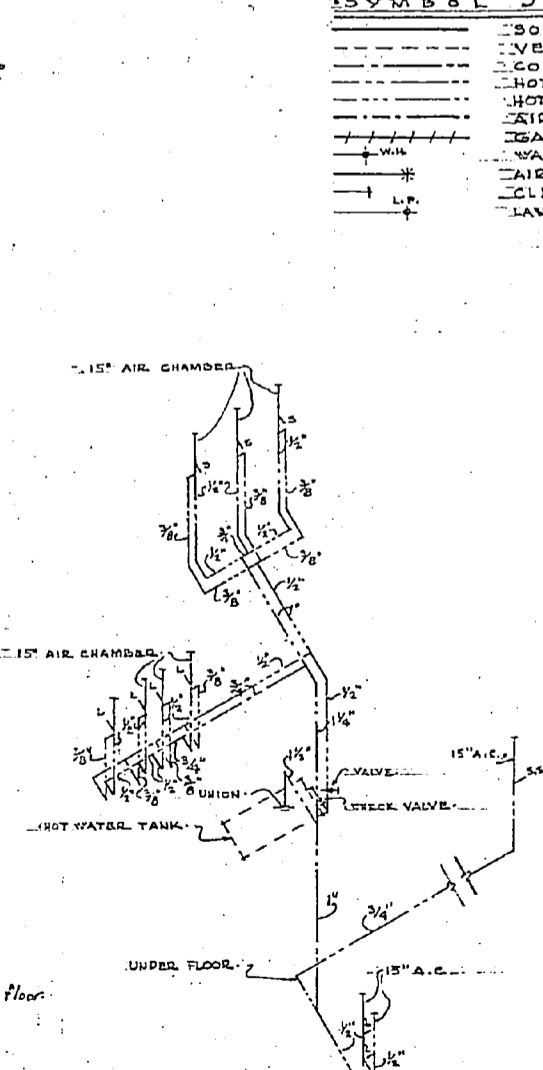
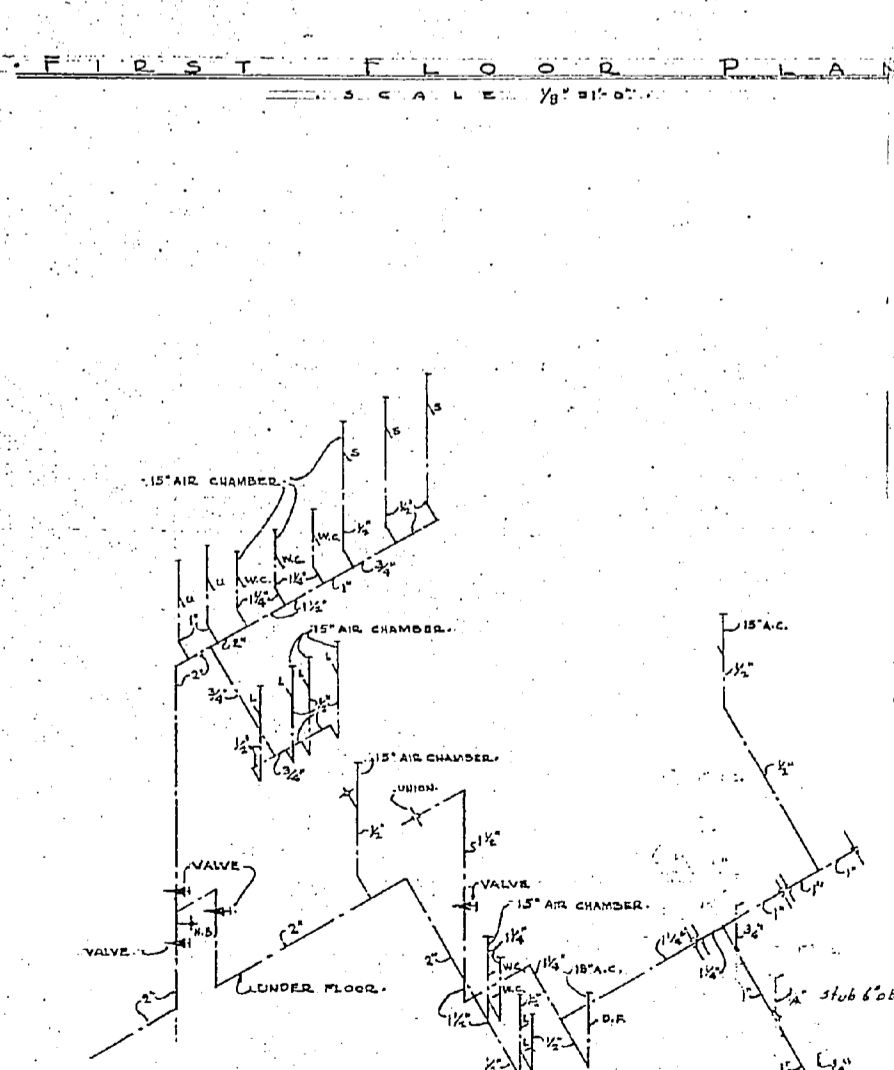


DETAILS OF GREASE & OIL TRAP

SCALE: 1/2" = 1'-0"

SYMBOL SCHEDULE

---	SOIL LINE - CAST IRON	W.C.	WATER CLOSET
---	VENT LINE	L.	LAVATORY
---	COLD WATER	S	SINK
---	HOT WATER	S.S.	SERVICE SINK
---	HOT WATER RECIRCULATING LINE	D.F.	DRINKING FOUNTAIN
---	RIG LINE	F.D.	FLOOR DRAIN
---	WASHER LINE	C.O.	CLEAN OUT
---	WALL HYDRANT	A.C.	AIR CHAMBER
---	FAUCET OUTLET	A.C.U.	AIR CONDITIONING UNIT
---	CLEAN OUT	T.	TANK
---	LAWN FAUCET		

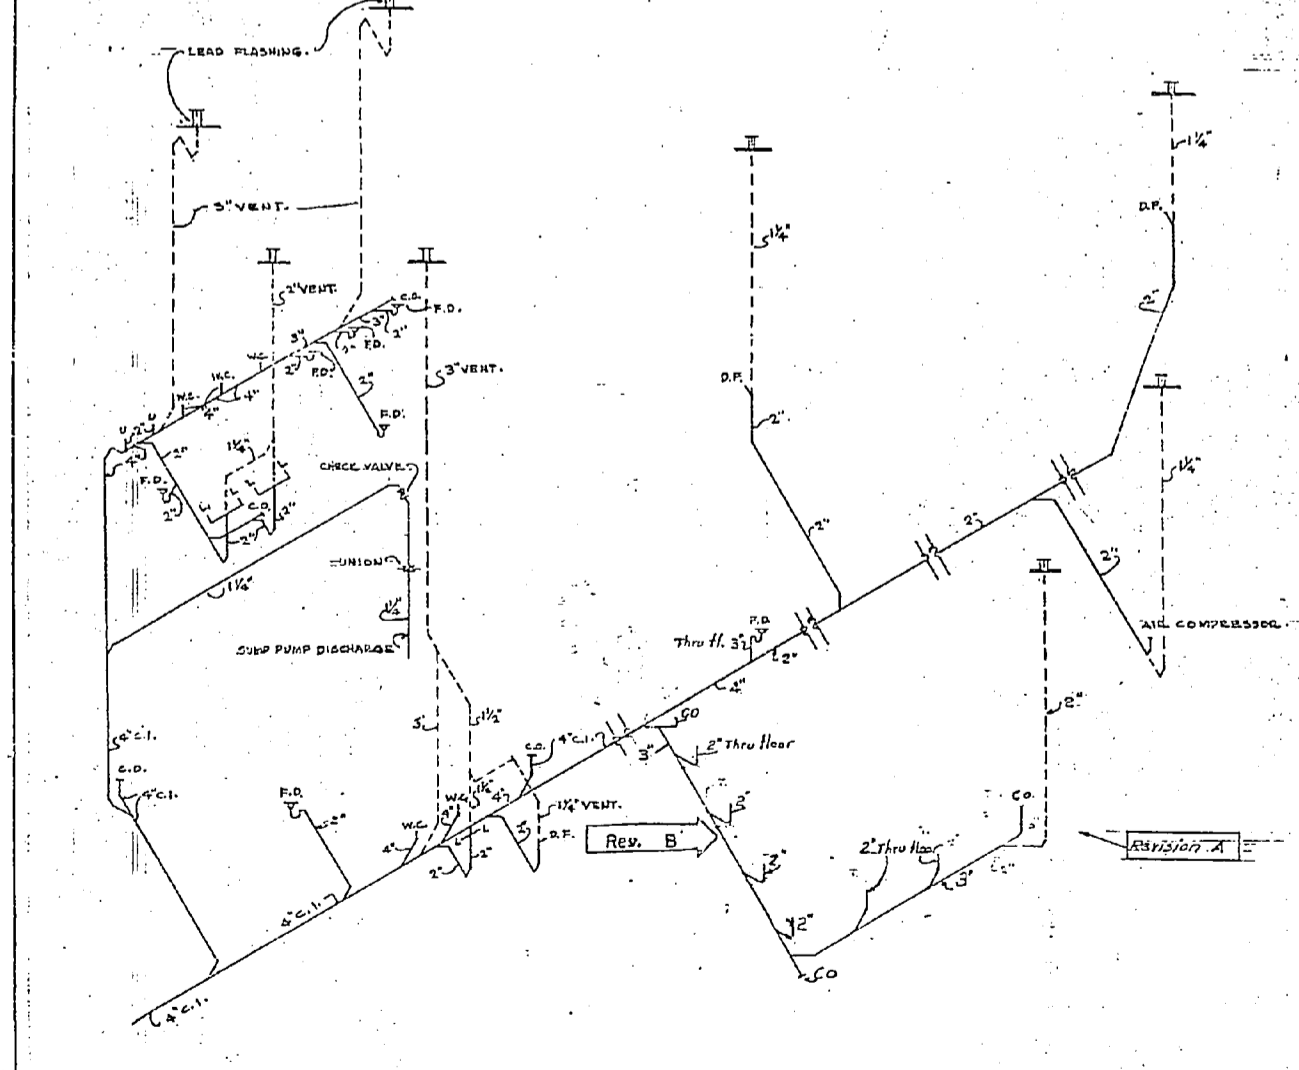

REV.	BY	DATE	BRIEF
C	G.McG.	5-5-49	Revised to "As Built" Status.
B	FAS	26 Feb 47	Changed piping in bluing room to fit relocated tanks.
A	A.H.N.	8-10-46	Size of pipe altered to suit plan.
APPROVED			
THE QUARTERMASTER GENERAL OF THE U.S. MARINE CORPS			
19			
DRAWN BY - H.W.M.		OLSEN AND DETRICK ENGINEER AND ARCHITECT RALEIGH, N. C.	
CHECKED BY - H.W.M.		EXPANSION OF INDUSTRIAL AREA ORDNANCE SHOP	
IN CHARGE - H.W.M.		PLUMBING	
SCALE - As Noted			
Y.S.D. DRAWING NO.			
387286			
P.W. DRAWING NO.		CAMP LEJEUNE, NORTH CAROLINA	
1413		Submitted	
SHEET 53 OF 58		PROJECT NUMBER 1429	
		SPECIFICATIONS NUMBER 1988	
		CONST. NO. 28	

