

VALUABLE

RETURN TO
PUBLIC WORKS
OFFICE
CAMP LEJEUNE
NEW RIVER, N. C.


SUBJECT Location on water
line Back Gate House
to midway Park
Profile

FIELD PARTY
Turlington IN CHARGE
Cooper INSTRUMENT
NOTES
Paggett TAPE READ
Everitt TAPE OR ROD
TAPE OR ROD
INSTRUMENT NO.
TAPE NO.

WEATHER
CLEAR SNOW
CLOUDY HOT
WINDY MODERATE
RAIN COLD
FAIR FOG

FILE No. 120-13
FLDR. No. _____
SHEET 1002
DATE 5/22/1940
Quad. No. 120-100

STATION	DIST.	ANGLE "	+	H. I.	VER. ANG. DIFF.	ELEVATION
BM 340			3.13	35.86		32.73
0+00						
+05						
+04.5					8.2	27.7
+05						
+30						
1					8.8	27.1
2						
3+22					11.0 11.0	24.9
+40						
+63						
4+00					11.0	24.9
+85					10.5	25.4

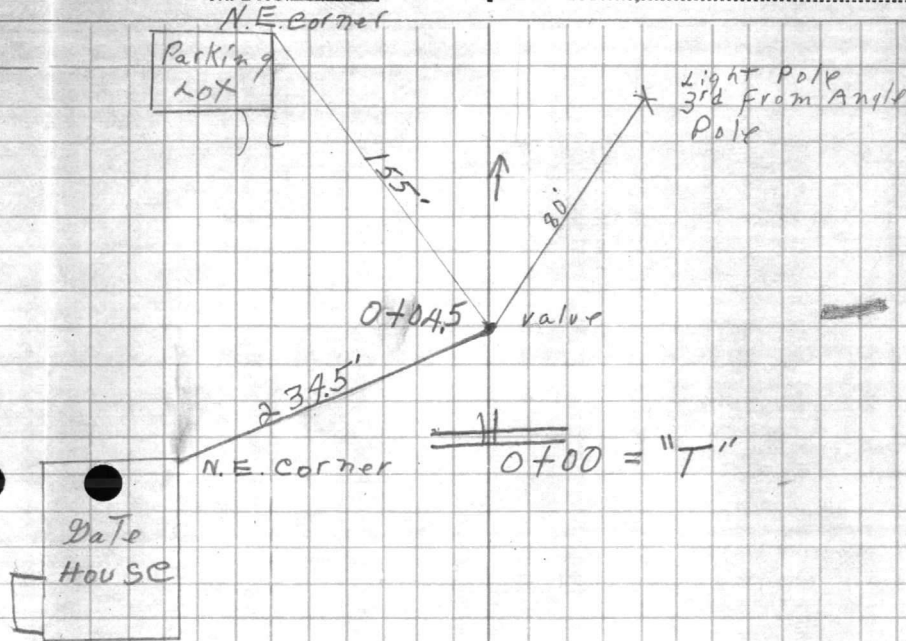

11-15

FIELD PART
IN THE
OFFICE
DATE
BY

SUBJECT

RECEIVED
NOV 15 1953
U.S. DEPARTMENT OF
THE BUREAU OF
LAND MANAGEMENT



5000

VALUABLE

RETURN TO
PUBLIC WORKS
OFFICE
CAMP LEJEUNE
NEW RIVER, N. C.


SUBJECT Profile + location
on water line back
gate House to
Midway Park

FIELD PARTY
Turlington
IN CHARGE
INSTRUMENT
NOTES
TAPE READ
TAPE OR ROD
TAPE OR ROD
INSTRUMENT NO.
TAPE NO.

WEATHER
CLEAR SNOW
CLOUDY HOT
WINDY MODERATE
RAIN COLD
FAIR FOG



FILE No. 120-13
FLDR. No. _____
FIGURED BY _____ SHEET 2 of 2
NOTES CHECKED BY _____
PLOTTED BY _____ DATE 5-22 19 45
Quad. No. 120-100

STATION	DIST.	ANGLE "	+	H. I.	VER. ANG. DIFF.	ELEVATION
+ 88						
+ 92						
BM 340				313		

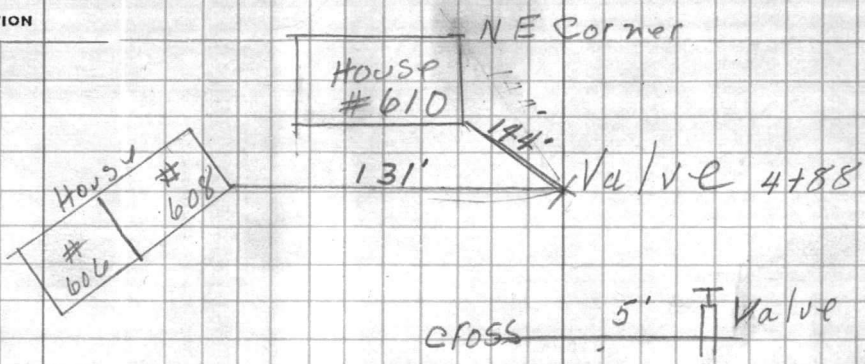

AVAILABLE
FOR
REPRODUCTION
BY
THE
PUBLIC
WORKS
OFFICE
OF
THE
FEDERAL
GOVERNMENT

SUBJECT

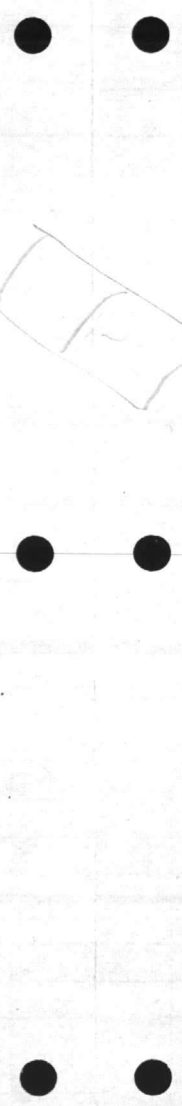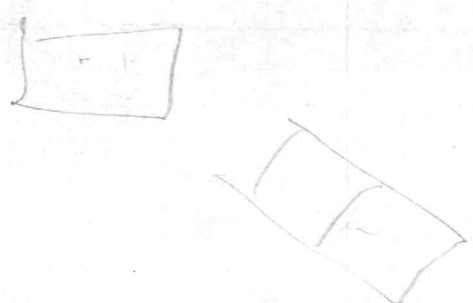

VALUABLE

RETURN TO
PUBLIC WORKS
OFFICE
CAMP LEJEUNE
NORTH CAROLINA

SUBJECT

Location Water Line
Front Bldg. # 33

FIELD PARTY

Morton IN CHARGE
____ INSTRUMENT
____ NOTES
____ TAPE READ
____ TAPE OR ROD
____ TAPE OR ROD
____ INSTRUMENT NO.
____ TAPE NO.

WEATHER

CLEAR
CLOUDY
WINDY
RAIN
RAIN
FAIR

SNOW
HOT
MODERATE
COLD
FOG

FILE No. 20B

FLDR. No. _____

SHEET 1 of 2

DATE 8/20 1956

Quad. No. _____

STATION	DIST.	ANGLE ° ' "	+	H. I. BEARING	VER. ANG. DIFF.	ELEVATION
---------	-------	----------------	---	------------------	--------------------	-----------

Bld. To Jacksonville ↑

Drive To Midway Park →

23.5'

37'

4" X 4" Tee

Holcum

Bldg # 33

STATION
DATE
TIME
ELEVATION
WIND
TEMP
PRESS
HUMIDITY
VISIBILITY
CLOUDS
WEATHER

STATION
DATE
TIME
ELEVATION
WIND
TEMP
PRESS
HUMIDITY
VISIBILITY
CLOUDS
WEATHER

FIELD PARTY
IN CHARGE
DATE
TIME
ELEVATION
WIND
TEMP
PRESS
HUMIDITY
VISIBILITY
CLOUDS
WEATHER

WEATHER
CLEAR
PARTLY
CLOUDY
WINDY
RAINY
FOG
THUNDER
STORM
HAIL
ICE
MIST
SMOG
DUST
SMOKE
VOLCANIC
ASH

TEMP
PRESS
HUMIDITY
WIND
CLOUDS
WEATHER

TEMP
PRESS
HUMIDITY
WIND
CLOUDS
WEATHER

TEMP
PRESS
HUMIDITY
WIND
CLOUDS
WEATHER

VALUABLE

SUBJECT _____

RETURN TO
PUBLIC WORKS
OFFICE
CAMP LEJEUNE
NORTH CAROLINA

FIELD PARTY

IN CHARGE

INSTRUMENT

NOTES

TAPE READ

TAPE OR ROD

TAPE OR ROD

INSTRUMENT No.

TAPE No. _____

WEATHER

CLEAR
CLOUDY
WINDY
RAIN
FAIR
SNOW
HOT
MODERATE
COLD
FOG
FIGURED BY _____
NOTES CHECKED BY _____
PLOTTED BY _____

FILE NO. _____

FLDR. No. _____

SHEET 2 of 2

DATE 8/20 1950

Quad. No. _____

STATION	DIST.	ANGLE ° ' "	+	H. I. BEARING	VER. ANG. DIFF.	ELEVATION
B11		7.78		34.88		27.1
					8.10	26.78
B11					7.78	27.10

Inv. 18" R.C.P Int. Hole in Bldg
at Drive in front Bldg # 33
Top 4" X 4" Tee

$$\begin{array}{r} 34.88 \\ 8.10 \\ \hline 26.78 \end{array}$$

VALUABLE

Subject

Return
Public Works
Office
Grant
Grant
Grant

Station
Date
Time
Altitude
Elevation

FIELD PARTY

in Charge
Instrument
Notes

WATER
Level
Clouds
Wind
Rain
Temp

LINE No.

Station


Notes

Date

Time

Altitude

Elevation

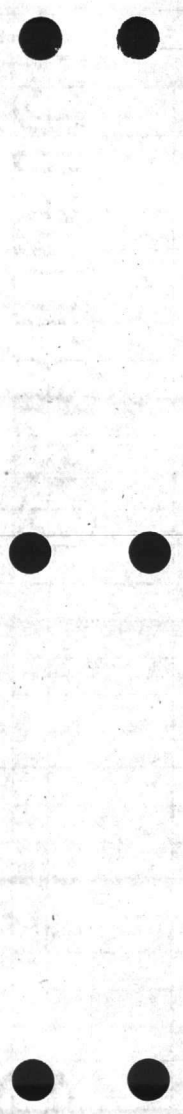

AVAILABLE

Return To
Public Works
Office
Camp Johnson
North Carolina

SUBJECT

FIELD PARTY

To Charge _____
Instrument _____
Notes _____
Tape Read _____
Tape on Rod _____
Tape of Rod _____

WEATHER

Clear _____
Cloudy _____
Wind _____
Moderate _____
Cold _____
Rain _____
Fog _____

Field No. _____

Speed _____

Date _____

Grid No. _____

Station _____ Dist. _____ Angle _____
H. Sighting _____ V. Ang. Elevation _____
D. _____

