

**VALUABLE**

RETURN TO  
 CARR & J. E.  
 GREINER CO.  
 JACKSONVILLE,  
 N. C.

SUBJECT Approximate Location of  
Ridge in Real of Post Troops Area  
of Water Tank

**FIELD PARTY**

\_\_\_\_\_  
 IN CHARGE  
 \_\_\_\_\_  
 INSTRUMENT  
 \_\_\_\_\_  
 NOTES  
 \_\_\_\_\_  
 TAPE READ  
 \_\_\_\_\_  
 TAPE OR ROD  
 \_\_\_\_\_  
 TAPE OR ROD  
 \_\_\_\_\_  
 INSTRUMENT NO.  
 \_\_\_\_\_  
 TAPE NO.

**WEATHER**

CLEAR  
 CLOUDY  
 WINDY  
 RAIN  
 FAIR

SNOW  
 HOT  
 MODERATE  
 COLD  
 FOG


FILE NO. <sup>725</sup> <sup>1200'</sup>

FLDR. NO. \_\_\_\_\_

SHEET \_\_\_\_\_

DATE \_\_\_\_\_ 19\_\_\_\_

STATION	DIST.	ANGLE		+	H. I.	-	ELEVATION	
		°	' "				VER. ANG. DIFF.	
#1		7.85	31.21				23.36	
#2						5.3	25.9	
#3						5.1	26.1	
#4						14.1	17.1	

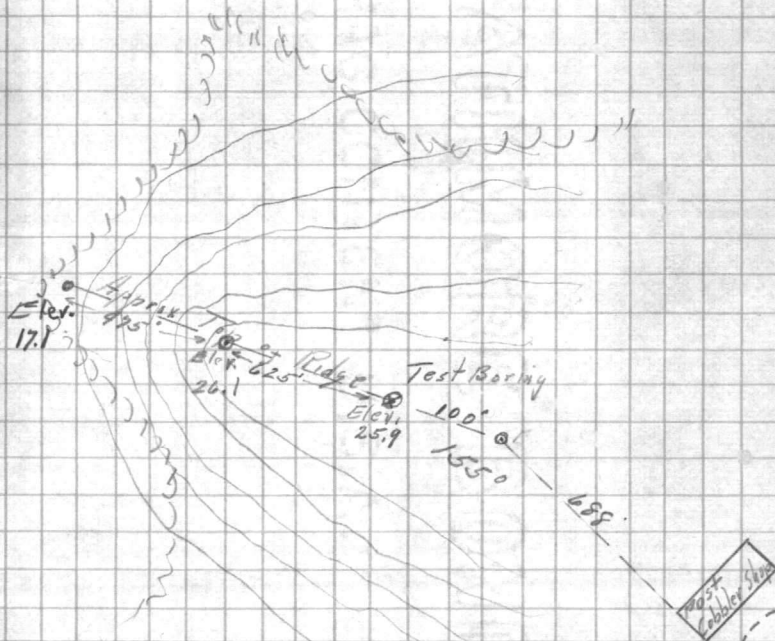

M.S.P.

FILE NO.

SUBJECT

DATE

TO

FROM

RE

BY

CLASS

SECRET

NO. 100-100000



**VALUABLE**

SUBJECT \_\_\_\_\_

RETURN TO

CARR & J. E.  
GREINER CO.  
JACKSONVILLE,  
N. C.

## FIELD PARTY

 \_\_\_\_\_ IN CHARGE  
 \_\_\_\_\_ INSTRUMENT  
 \_\_\_\_\_ NOTES  
 \_\_\_\_\_ TAPE READ  
 \_\_\_\_\_ TAPE OR ROD  
 \_\_\_\_\_ TAPE OR ROD  
 \_\_\_\_\_ INSTRUMENT NO.  
 \_\_\_\_\_ TAPE NO.

## WEATHER

 CLEAR SNOW  
 CLOUDY HOT  
 WINDY MODERATE  
 RAIN COLD  
 FAIR FOG

FILE No. \_\_\_\_\_

FLDR. No. \_\_\_\_\_

FIGURED BY \_\_\_\_\_ SHEET \_\_\_\_\_

NOTES CHECKED BY \_\_\_\_\_

PLOTTED BY \_\_\_\_\_ DATE \_\_\_\_\_ 19\_\_

STATION	DIST.	ANGLE	+	H. I.	— VER: ANG. DIFF.	ELEVATION
---------	-------	-------	---	-------	-------------------------	-----------

Start at P.I. 688' from Cobbler Shop

# 1 202' 74° 20'

# 2 334' 157° 0'

# 3 527' 186° 15'

# 4 900' " "

# 5 1350' 186° 25'

# 6 1380' 190° 40'

# 7 1210' 217° 40'

# 8 1100' 223° 40'

# 9 920' 242°

# 10 860' 257°

# 11 680' 268° 40'

# 12 668' 279°

# 13 750' 295° 30'

Counter-clock-wise

307° 45' to Water Tank

+150' To top of Ravine  
 100' at Right Angles to top of Ravine  
 80' " " " " " "

Top of Ravine

" " "

" " "

Top of Ditch  
 Edge of Woods

Ed:

Have gone over to the  
 Glider Base: Will try and be back  
 at Noon

Dillon

