

VALUABLE

Return To
Public Works
Office
Camp LeJeune
North Carolina

SUBJECT Locatio Bldg. at Rifle
Range at Peer

FIELD PARTY

_____ In Charge
_____ Instrument
_____ Notes
_____ Tape Read
_____ Tape or Rod
_____ Tape or Rod
_____ Instrument No.
_____ Tape No.


WEATHER

Clear _____
Cloudy _____
Windy _____
Rain _____
Fair _____
Snow _____
Hot _____
Moderate _____
Cold _____
Fog _____

FILE No. 198-W
Fldr. No. _____
Sheet 1 of 1
Date 6-15 1949

Figured By _____
Notes Checked By _____
Plotted By _____
Quad. No. 198

Station	Dist.	Angle	H. I.	Ver: Ang.	Elevation
		° ' "	Bearing	Diff.	

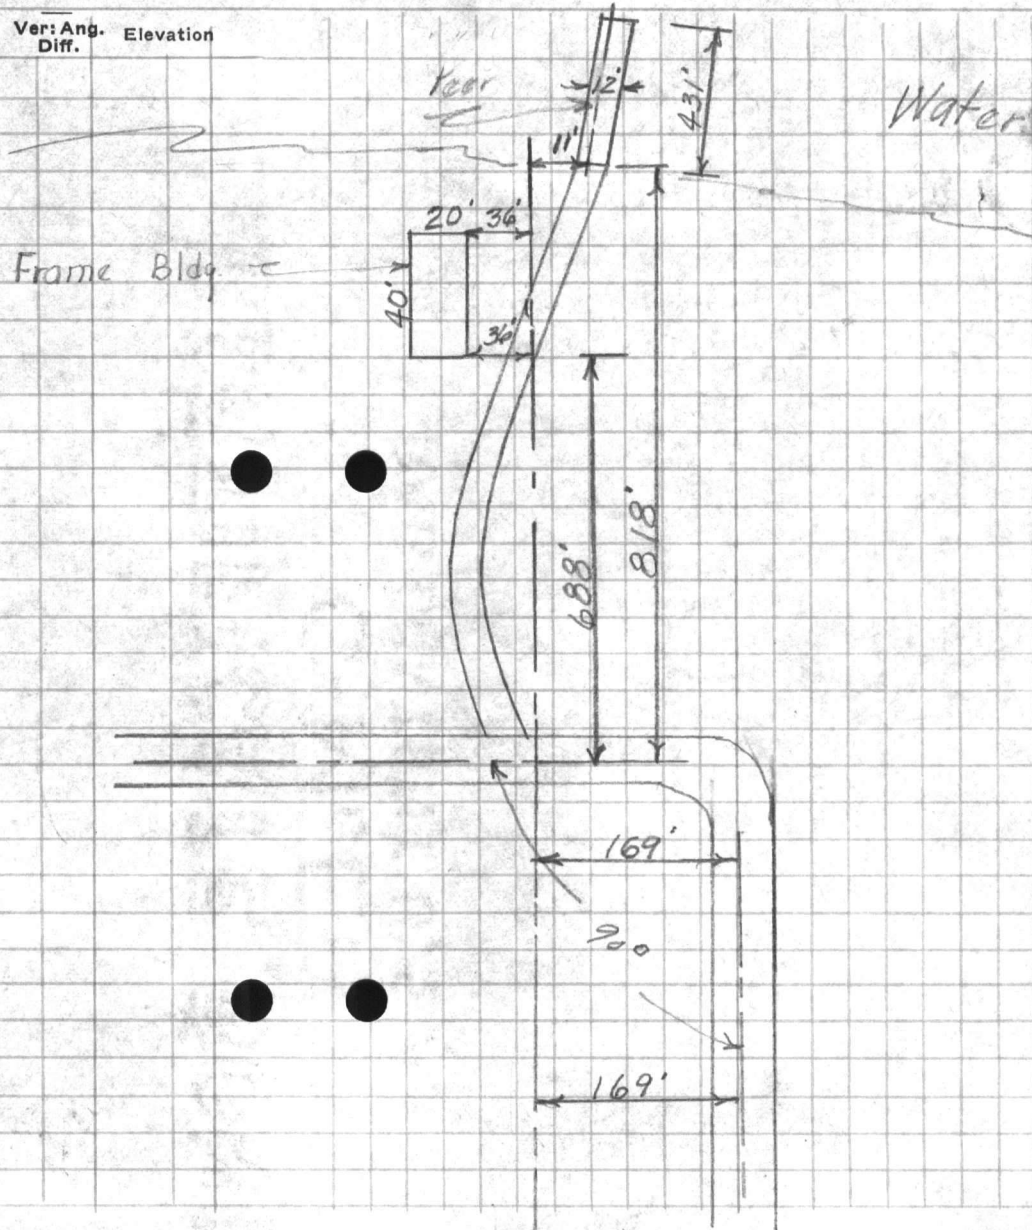

AVAILABLE

SUBJECT

Return to
Public Works
Office
Camp Lathrop
North Carolina

Station

Class

And

Permit

Ver. And - Elected
C.R.

FIELD PARTY

In Charge

Station

Notes

App. Rate

App. of Rod

Time on Rod

Time on Rod

Time on Rod

WEATHER

Clear

Cloudy

Windy

Rain

Fog

Temperature

Notes

Notes

Notes

FILE NO.

Field No.

Station

Date