












REVISIONS			
NO.	DESCRIPTION	DATE	BY
1	GENERAL REVISION	2/15/66	GF
2	REVISED AS BUILT	10/6/90	GRA

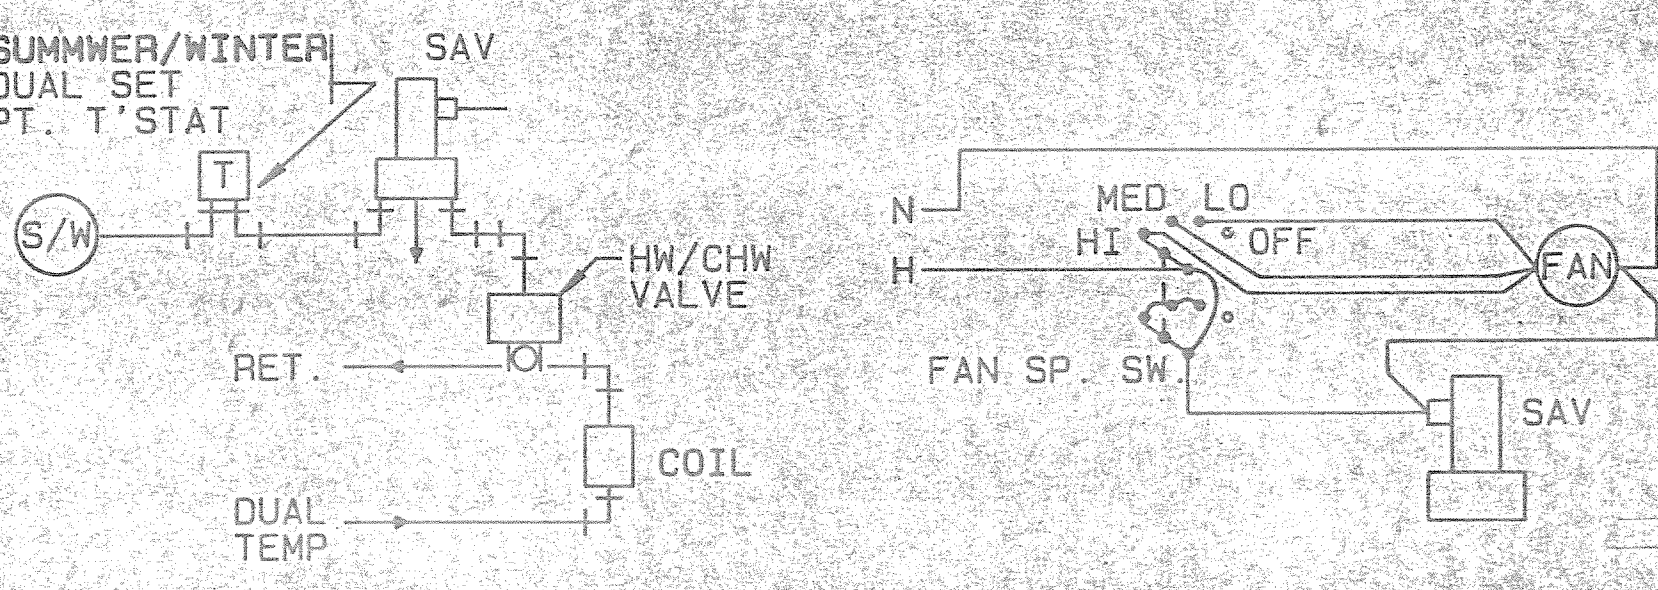


FAN COIL UNIT CONTROLS

NOTE: WHEN FAN IS OFF HW/CHW VALVE GOES TO CLOSED POSITION.

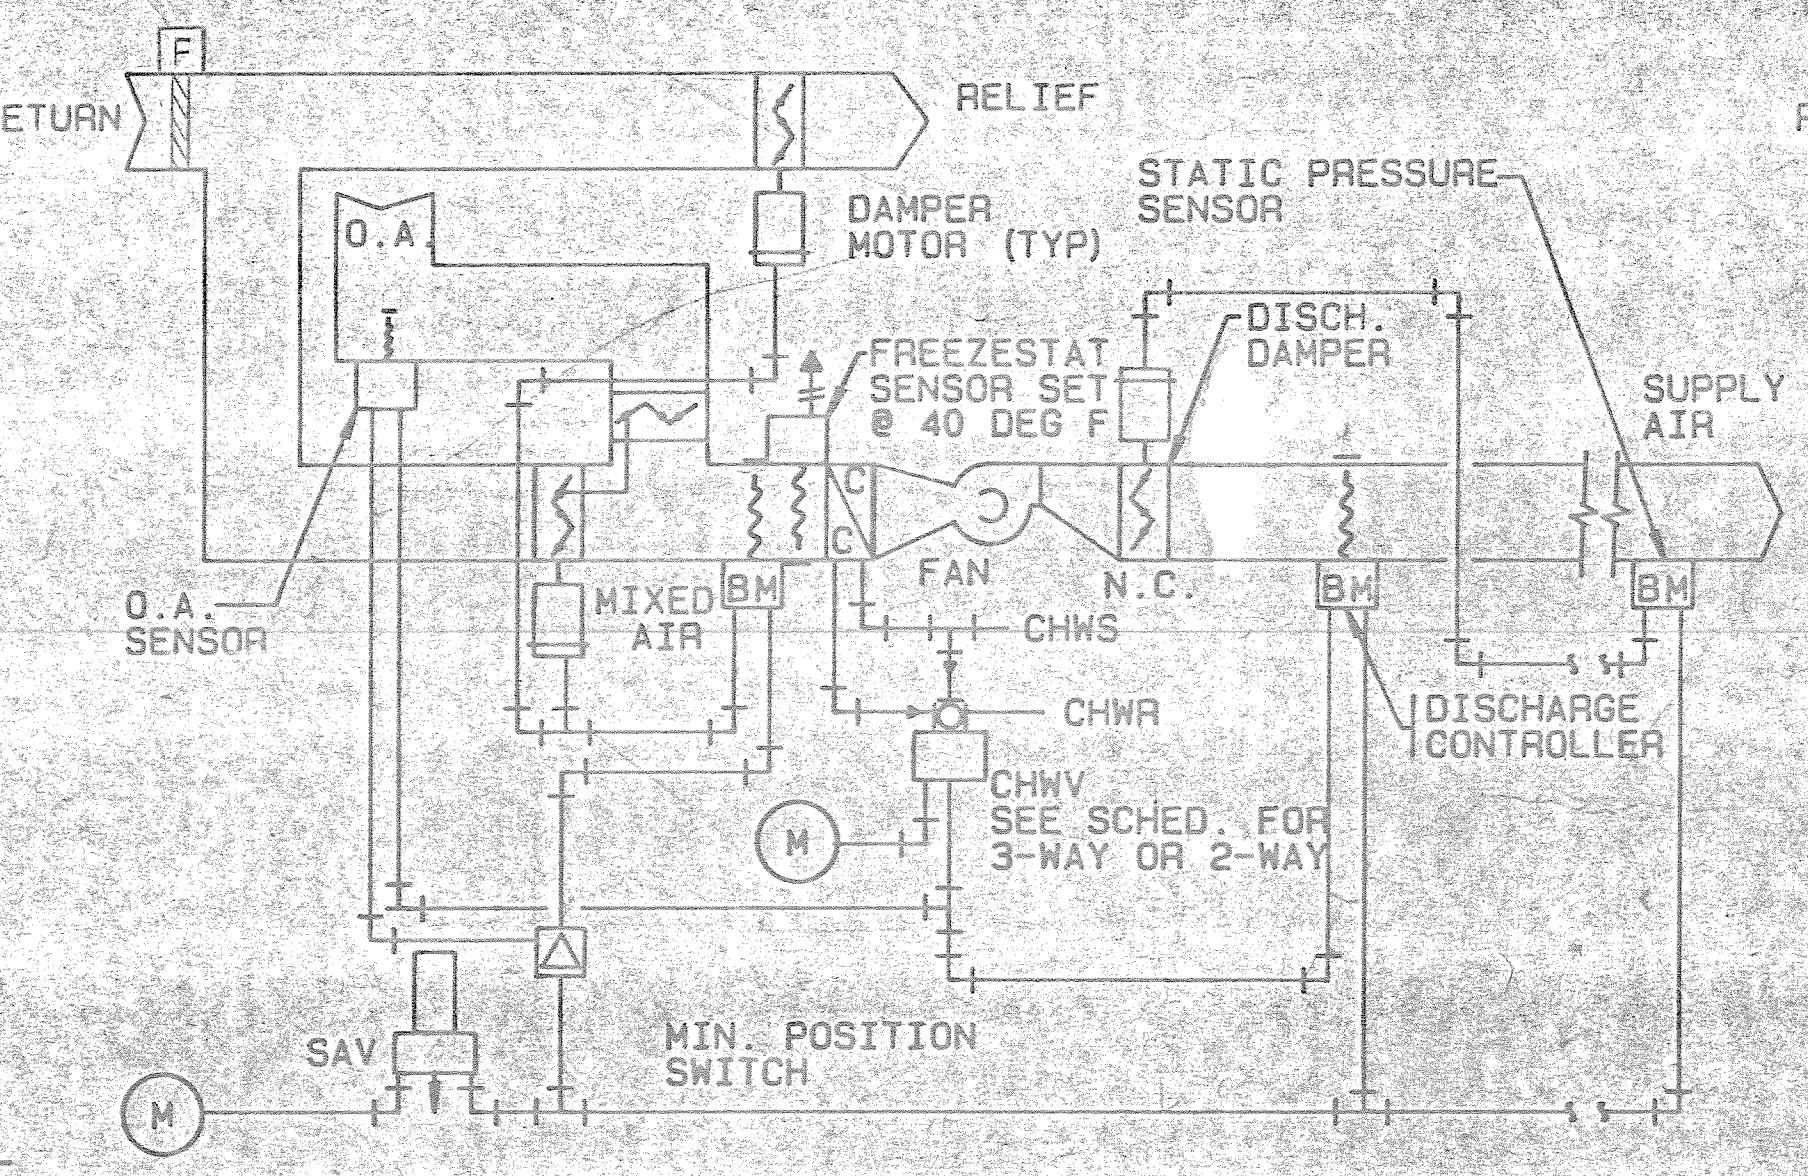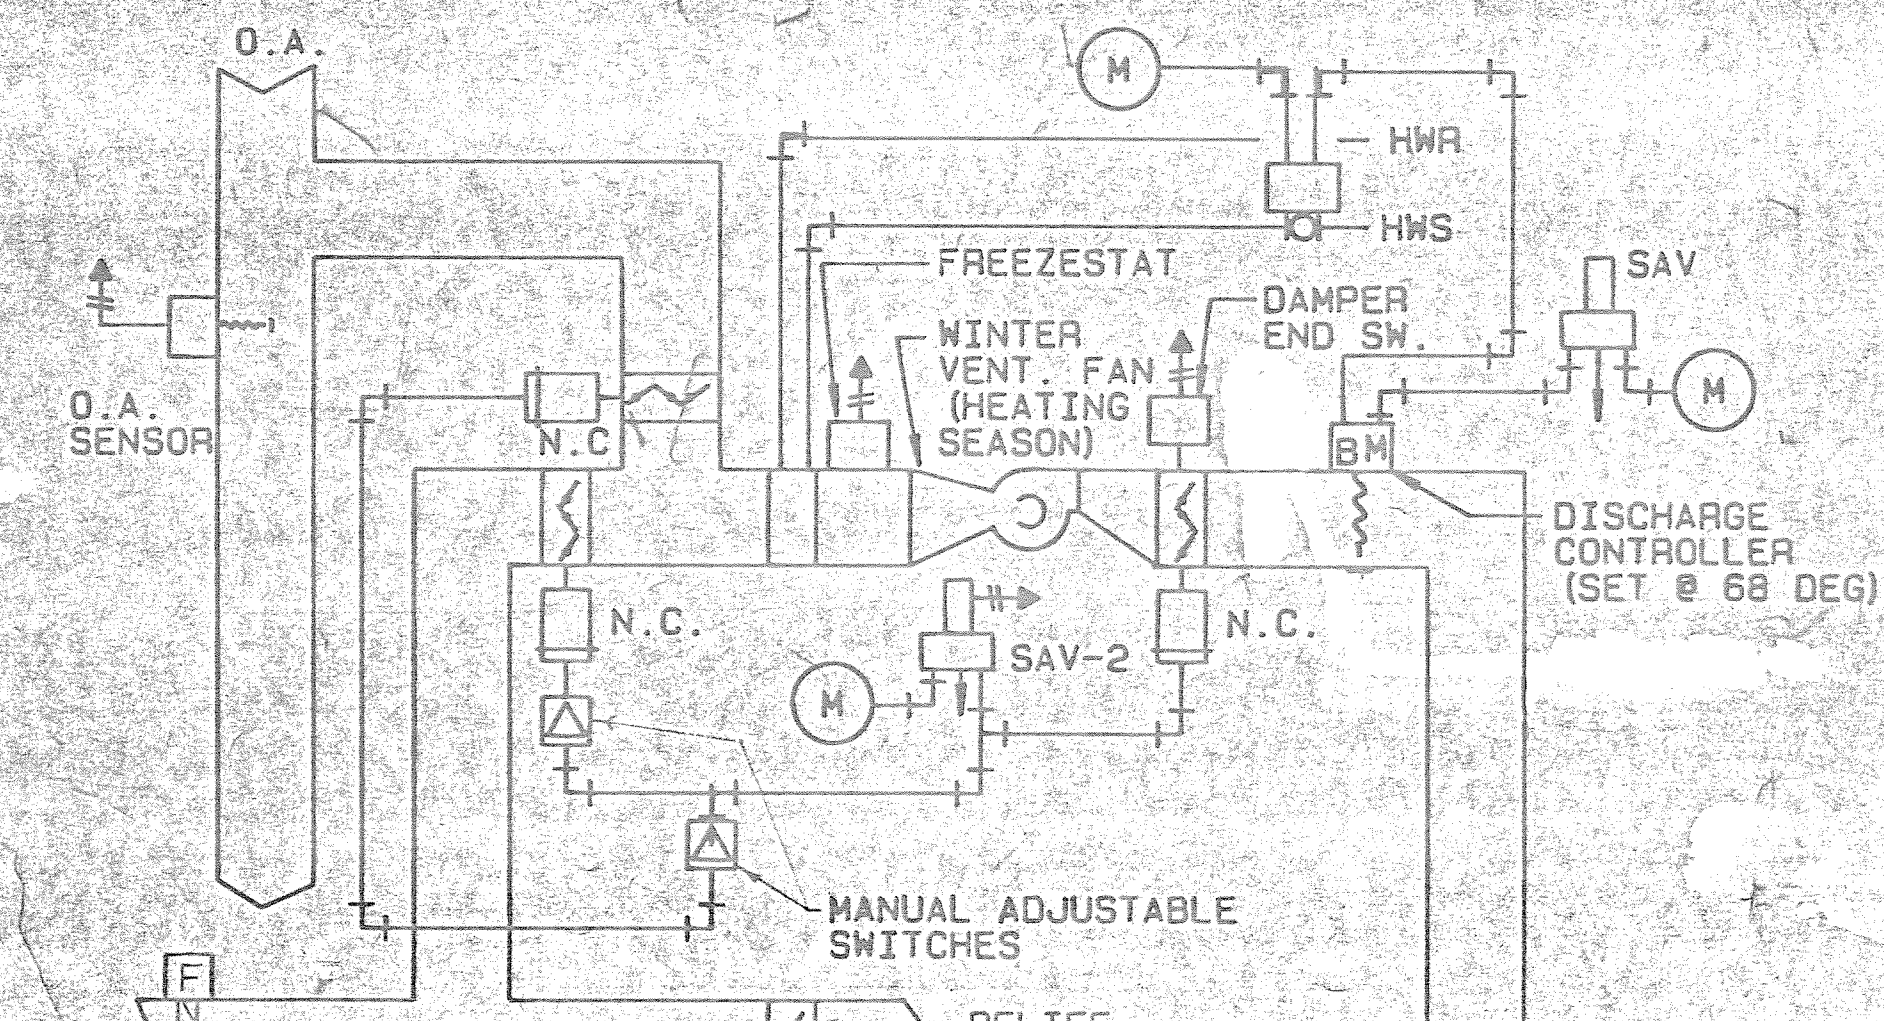


TYPICAL VARIABLE VOLUME AHU CONTROL (WITHOUT WINTER VENTILATION FAN)

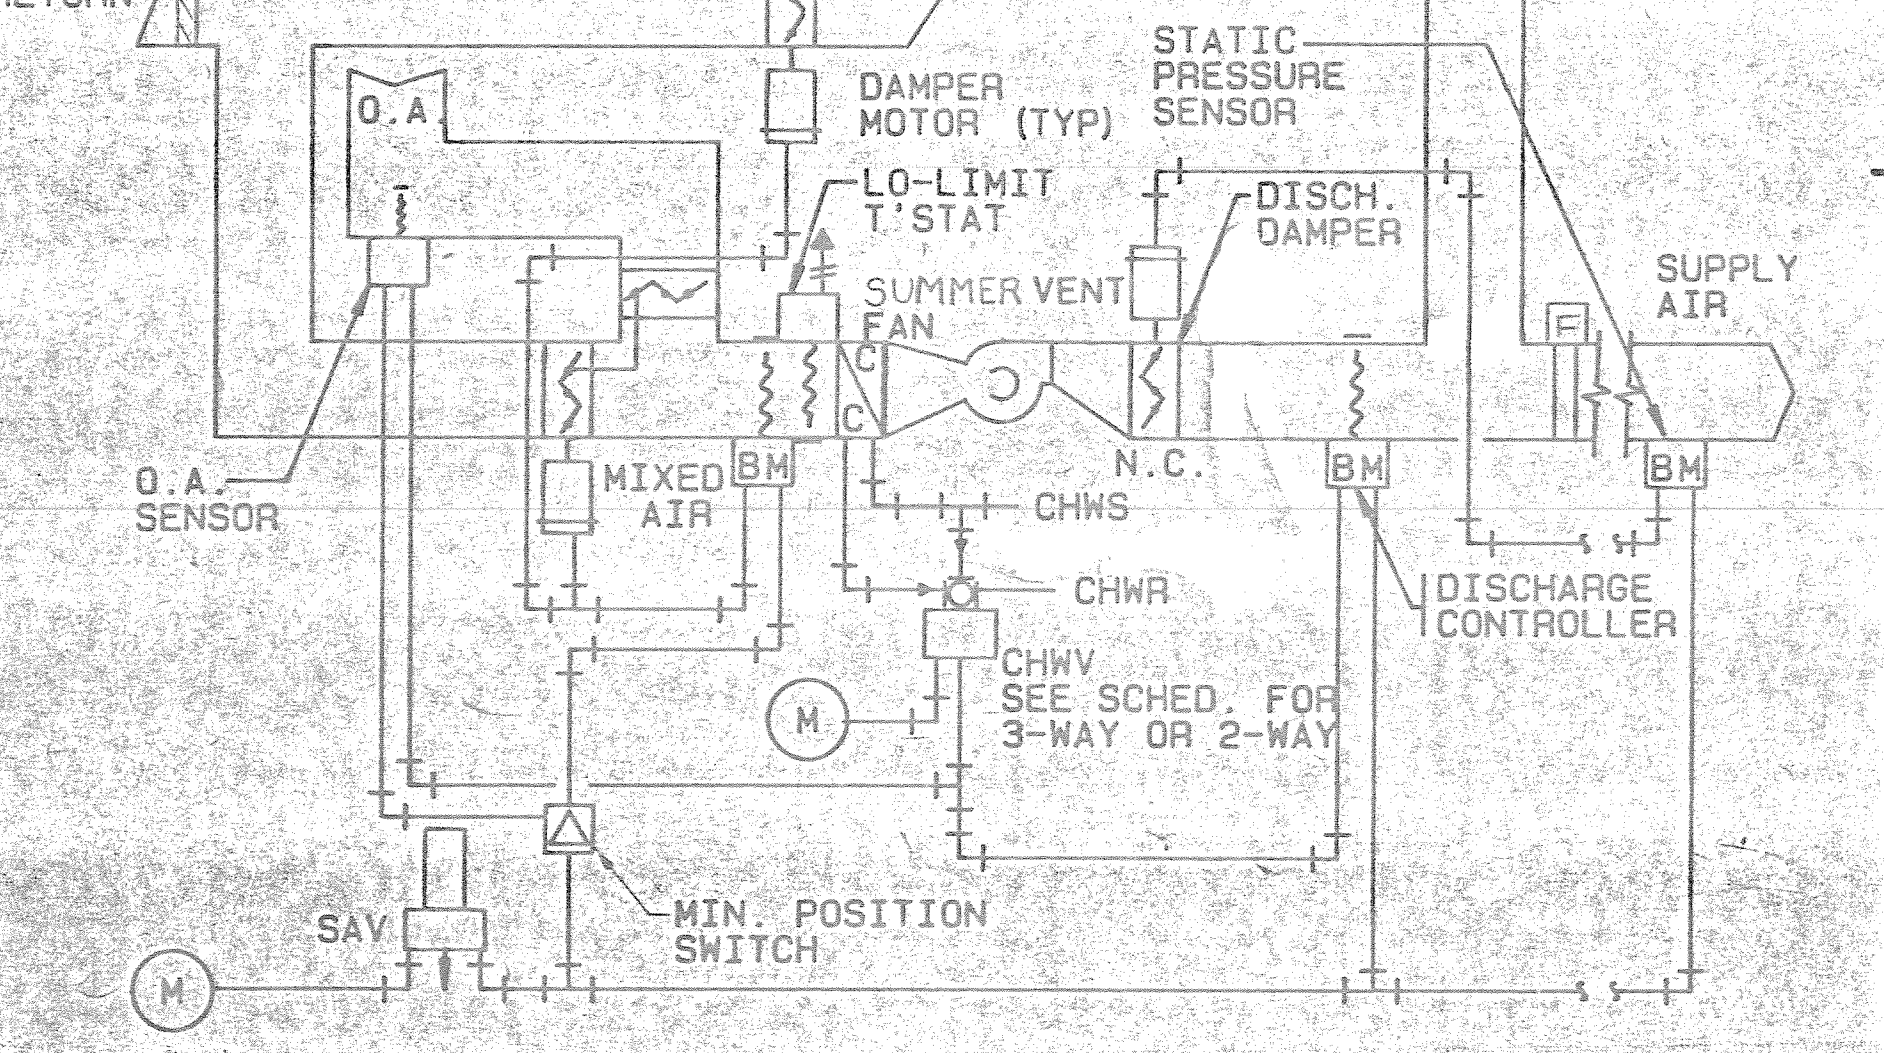


TYPICAL VARIABLE VOL. AHU CONTROL (WITH WINTER VENTILATION FAN)

AHU-1AS, 1BN, 1BS, 1CN, 1CS, 2CN, 2CS, 1DN, 1DS, 2DS, 3ES, 1FN, 1FS, 2CN, 2ES, 1GN, 1GS, 2GN, 2GS, 1HS, 2HN, 2HS, 1IN, 1IS

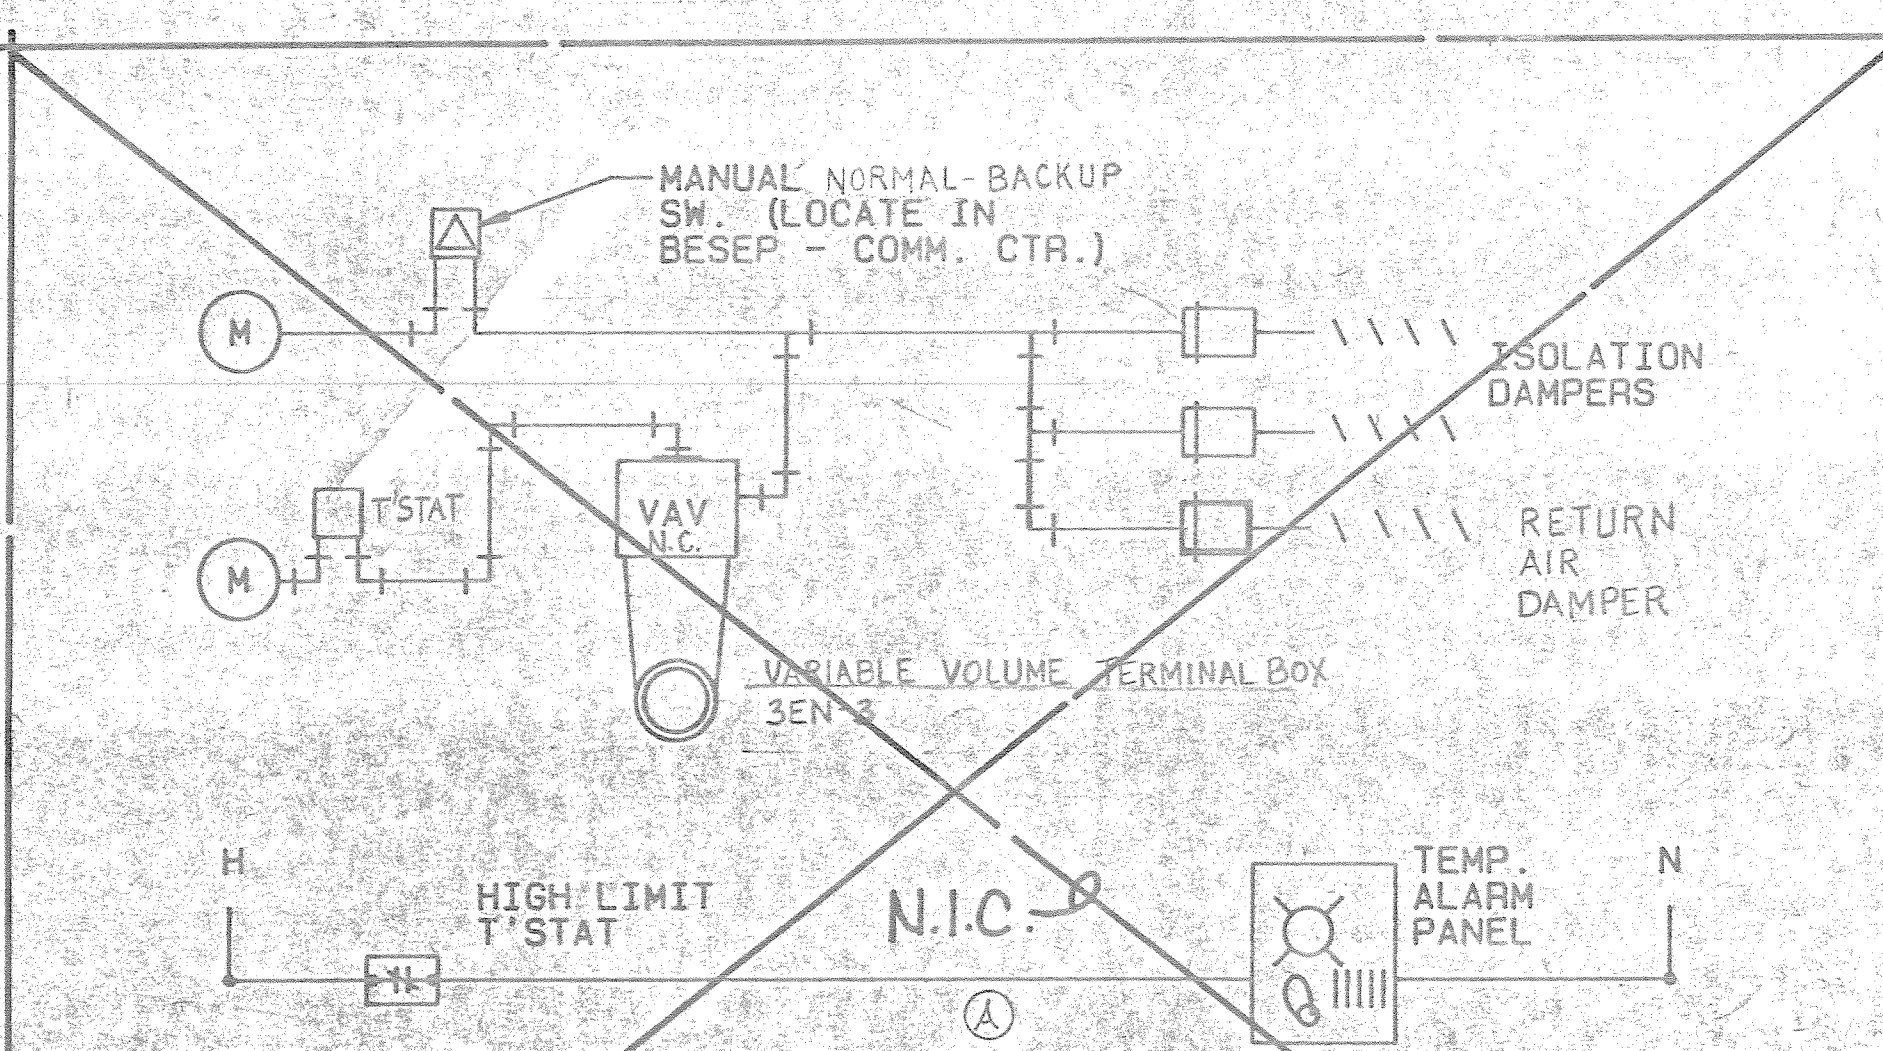


(AC-1) AIR CONDITIONING BACK-UP FOR BESEP-COMM. CTR.


- NOTES
1. FURNISH FIRESTATS AS SHOWN.
  2. THERE SHALL BE ONLY FIRESTATS FURNISHED FOR MECHANICAL EQUIPMENT. (NO SMOKE DETECTORS)
  3. THE CONTROL DIAGRAM AND SPECIFICATIONS REFER TO DTC CONTACTS TO PROGRAM EQUIPMENT "ON" OR "OFF" AND TO INDEX CERTAIN EQUIPMENT BASED ON OUTSIDE OR OTHER AIR TEMPERATURES. SINCE THE BASE WIDE ENDS WILL NOT BE OPERATIONAL AT COMPLETION OF THIS PROJECT, THE DTC CONTACTS SHALL BE INSTALLED IN SERIES WITH DTC RLY'S AT CONTACT TO PROGRAM THE EQUIPMENT.
  4. SECONDARY CHILLED WATER PUMP (P.C.-ES, P.C.-EN, AND P.C.-G) SHALL RUN IN THE SUMMER AND WINTER SEASON; WHEREAS, THE REMAINING CHILLED WATER SECONDARY PUMPS SHALL ONLY RUN IN THE SUMMER. THE SECONDARY CHILLED WATER PUMPS SHALL INTERLOCK WITH THEIR RESPECTIVE PRIMARY PUMP (SUMMER OR WINTER).
  5. THE PRIMARY HOT WATER PUMP SHALL RUN FROM ITS OUTSIDE AIR CONTROLLER AT 60°F AND BELOW AND DOES NOT REQUIRE ELECTRICAL INTERLOCK WITH SECONDARY PUMPS.

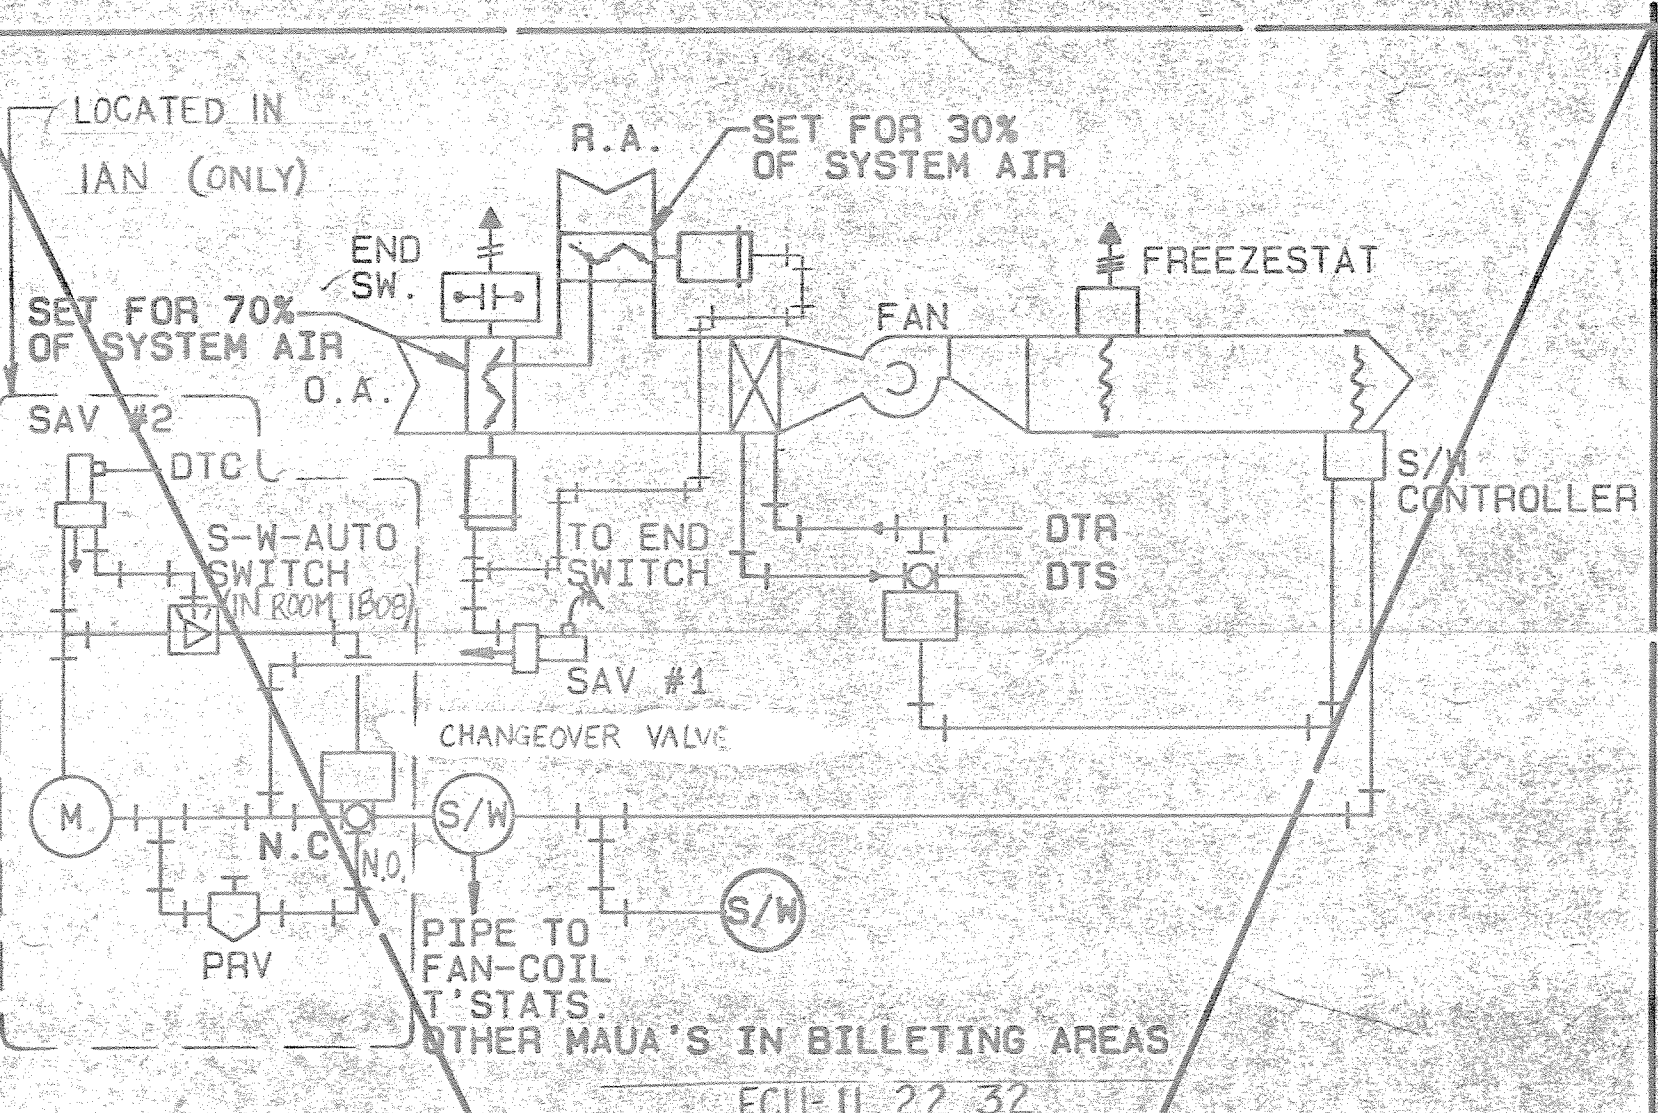

MAKEUP AIR UNIT (MUAU) BILLETING AREA

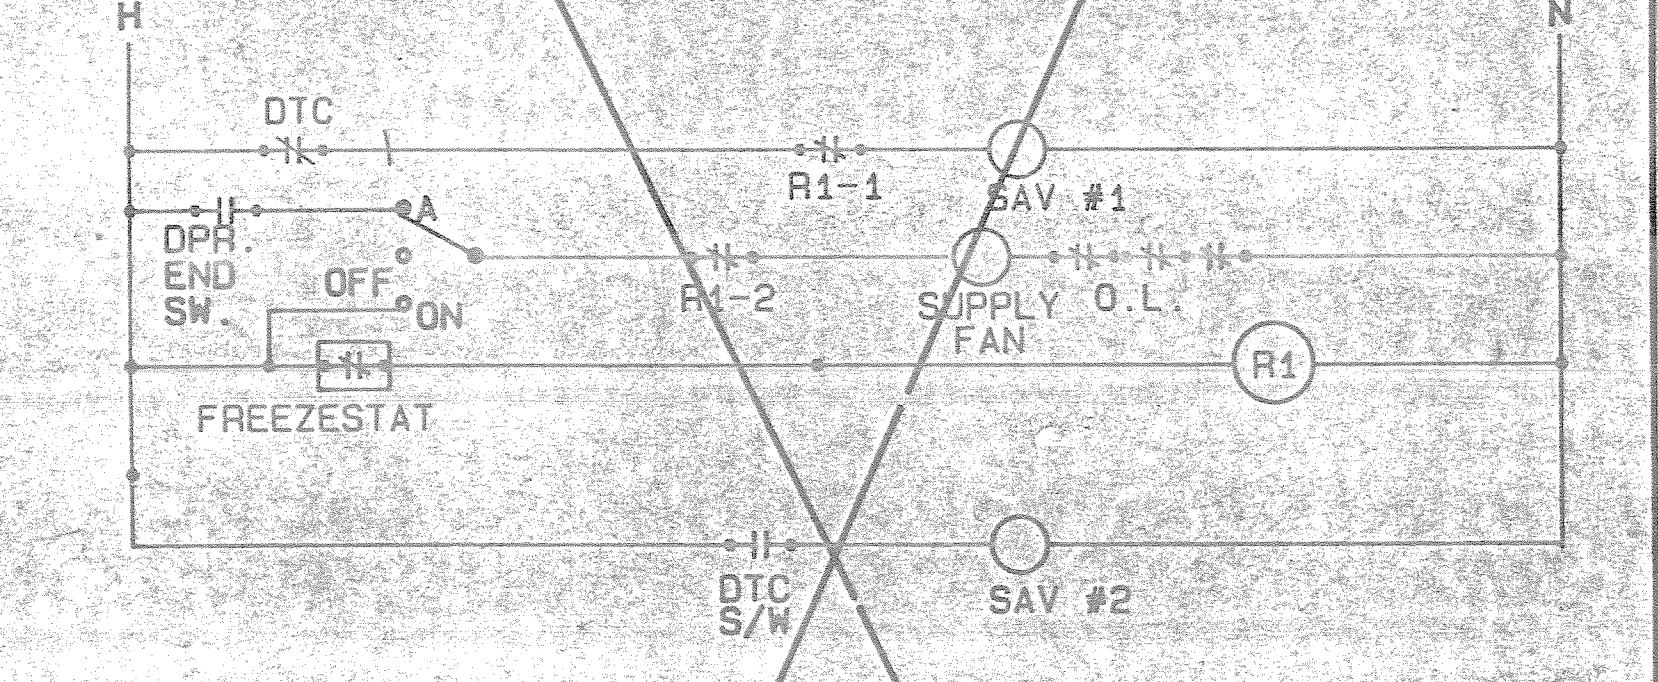

TYPICAL MUAU CONTROL

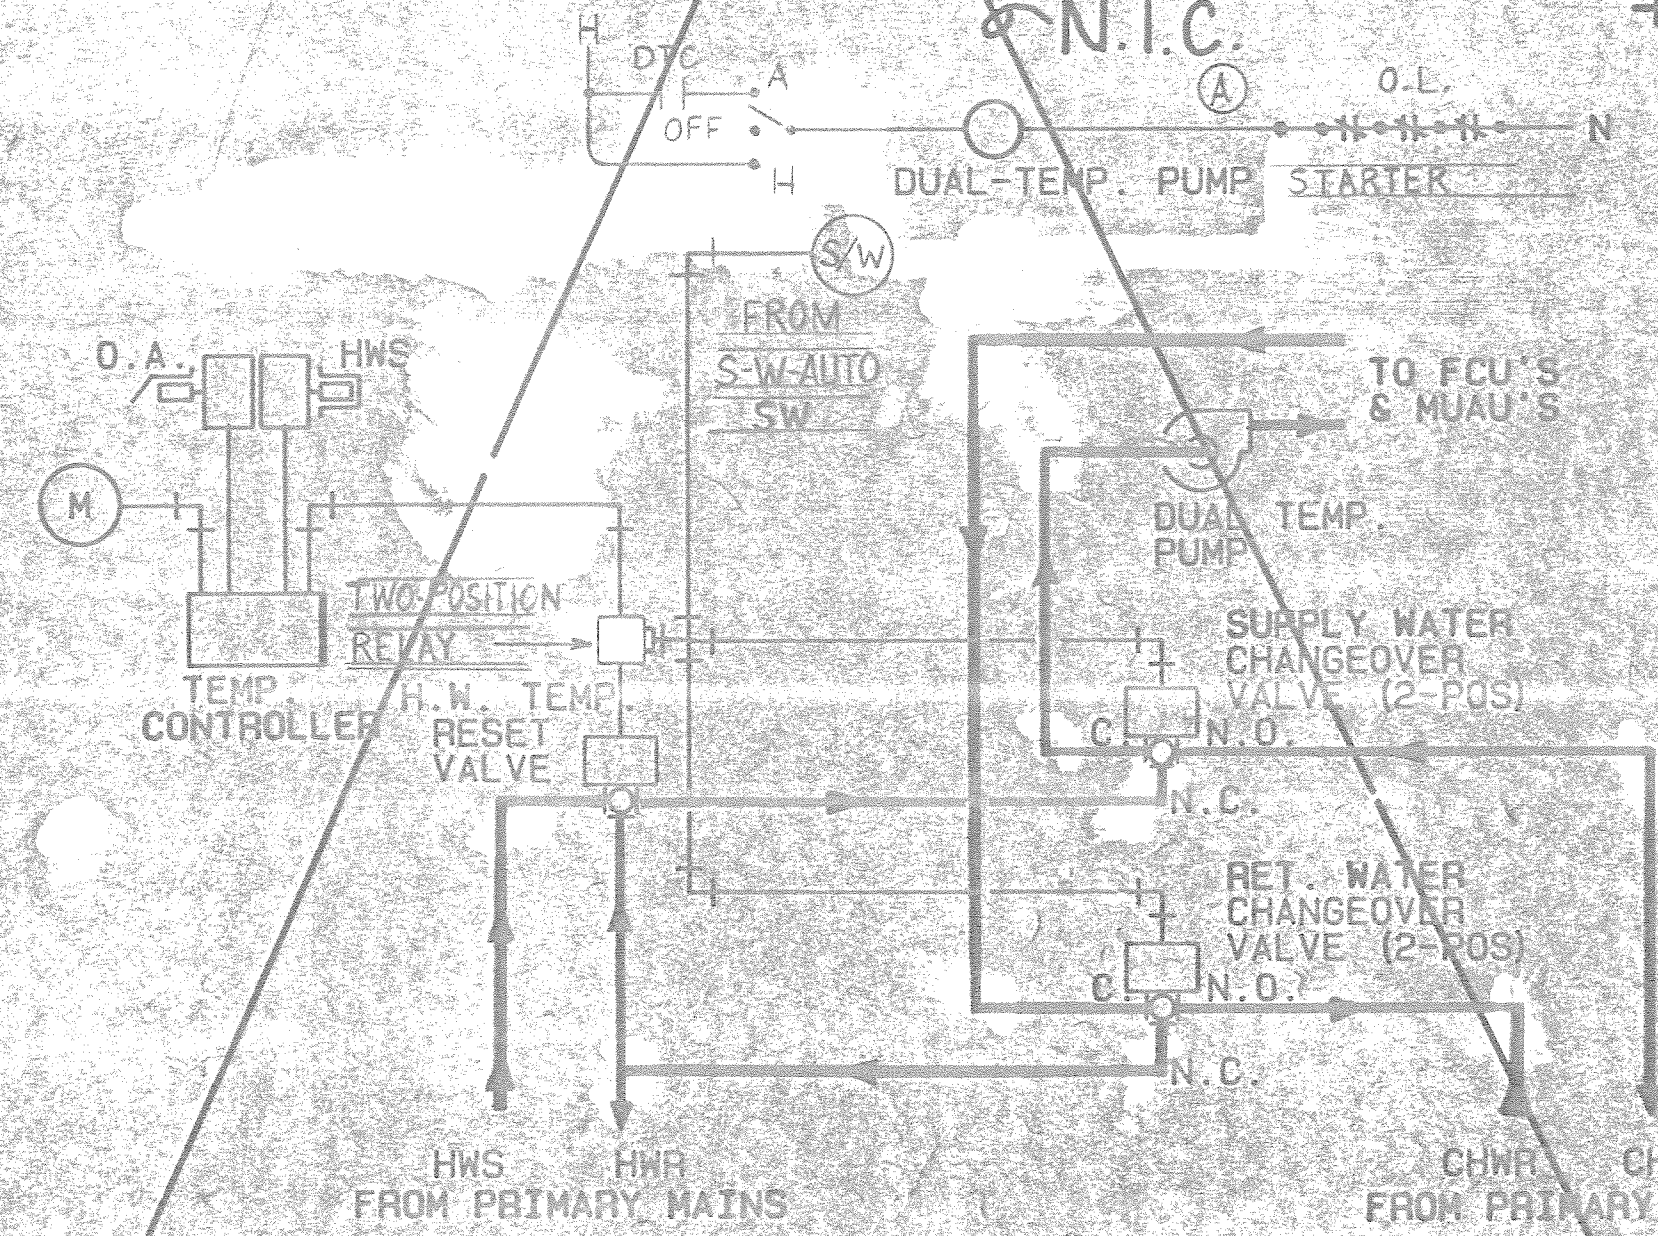

H.W. RESET & CHANGEOVER BILLETING AREA

<b>RECORD DRAWING</b> LETTER DATED AUG 10 1960		<b>M-35</b>	
FEREBEE, WALTERS & ASSOCIATES ENGINEERS ARCHITECTS 1000 EAST 10TH STREET CHARLOTTE, NORTH CAROLINA		DEPARTMENT OF THE NAVY ATLANTIC DIVISION MARINE CORPS BASE, CAMP LEJEUNE, NORTH CAROLINA	
DRAWING NO. 4124303 DATE 2/15/66 BY GF		NAVFAC DRAWING NO. 4124303 CONSTR. CONTR. NO. N62470-82-B-2243	
APPROVED: [Signature] DATE: 2/15/66		OFFICE IN CHARGE: [Signature] DATE: 2/15/66	




H-117-A-Wilday 224303










REVISIONS			
NO.	DESCRIPTION	PREP'D BY	DATE
1	GENERAL REVISION	GHS	2/15/86
2	REVISED AS BUILT	DC	10/1/90

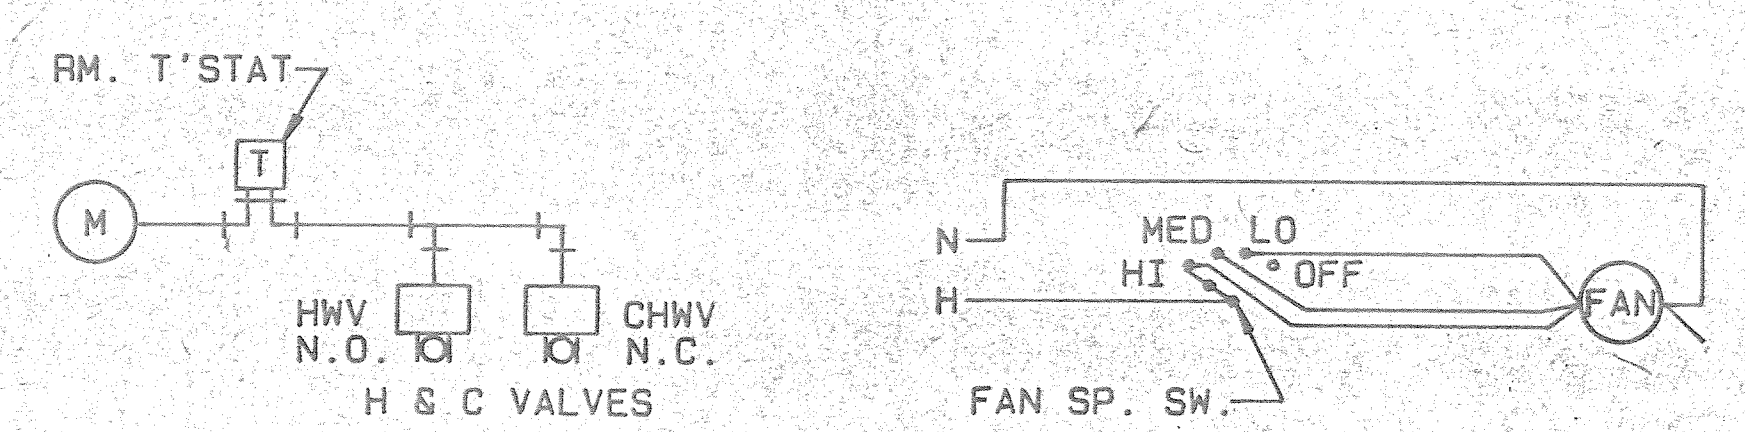



FAN-COIL UNIT CONTROL FOR: CANTEEN

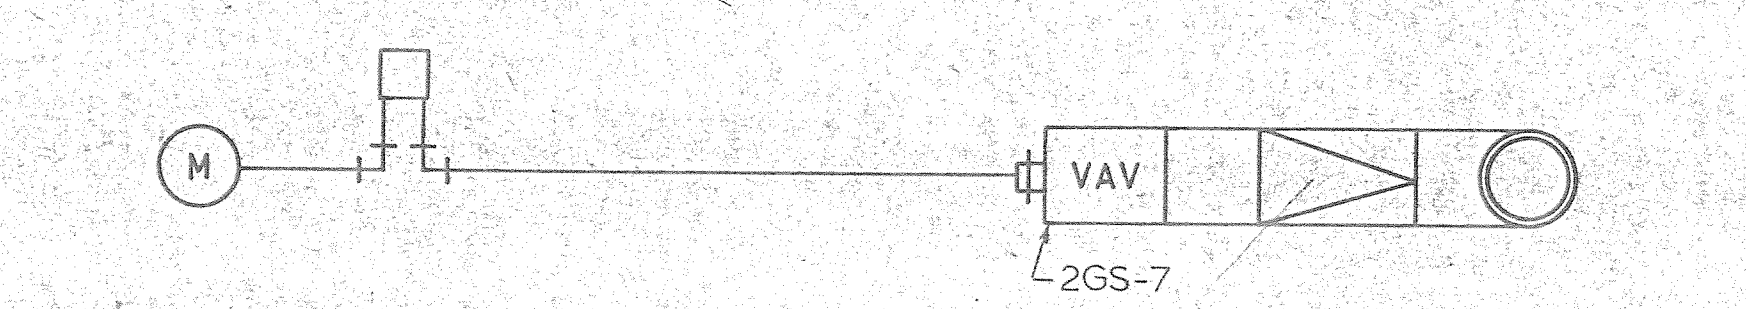


SUPPLEMENTAL/ BACK-UP COOLING FOR COMPUTER RM. A.C. UNIT(AC-2) SSO/SSCT AREA

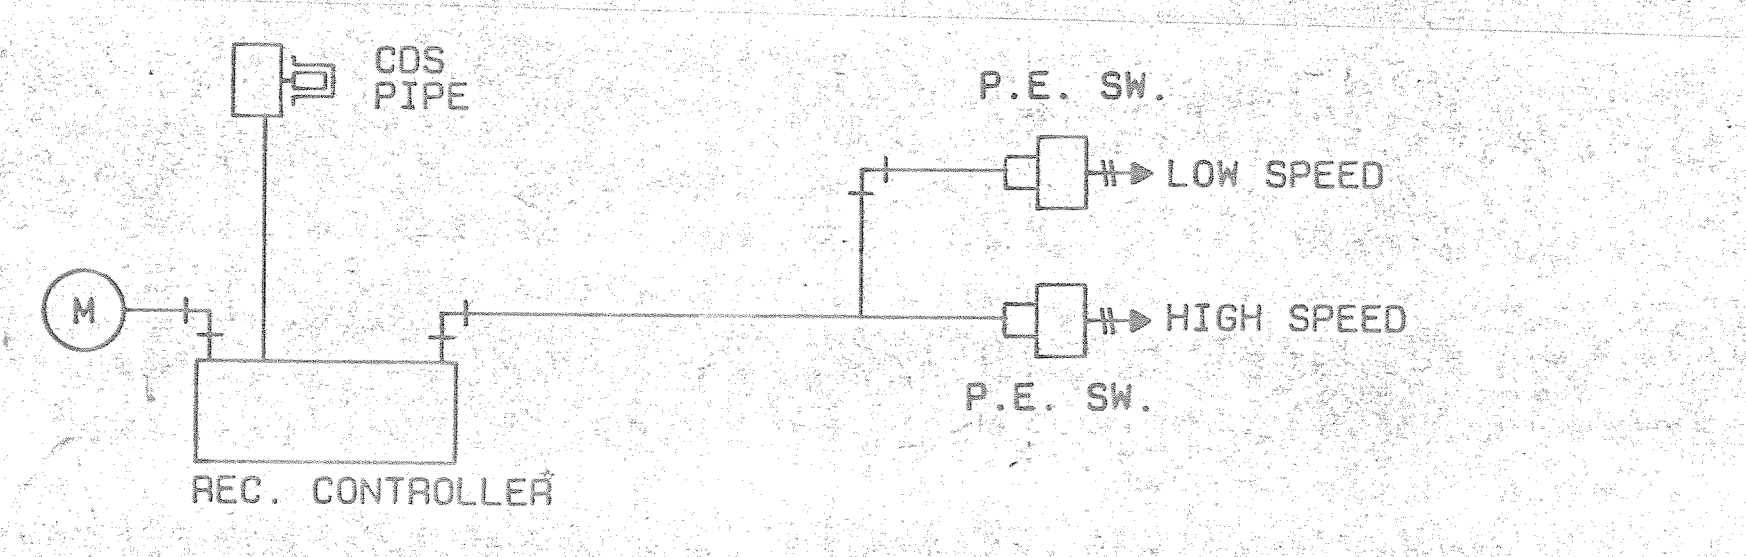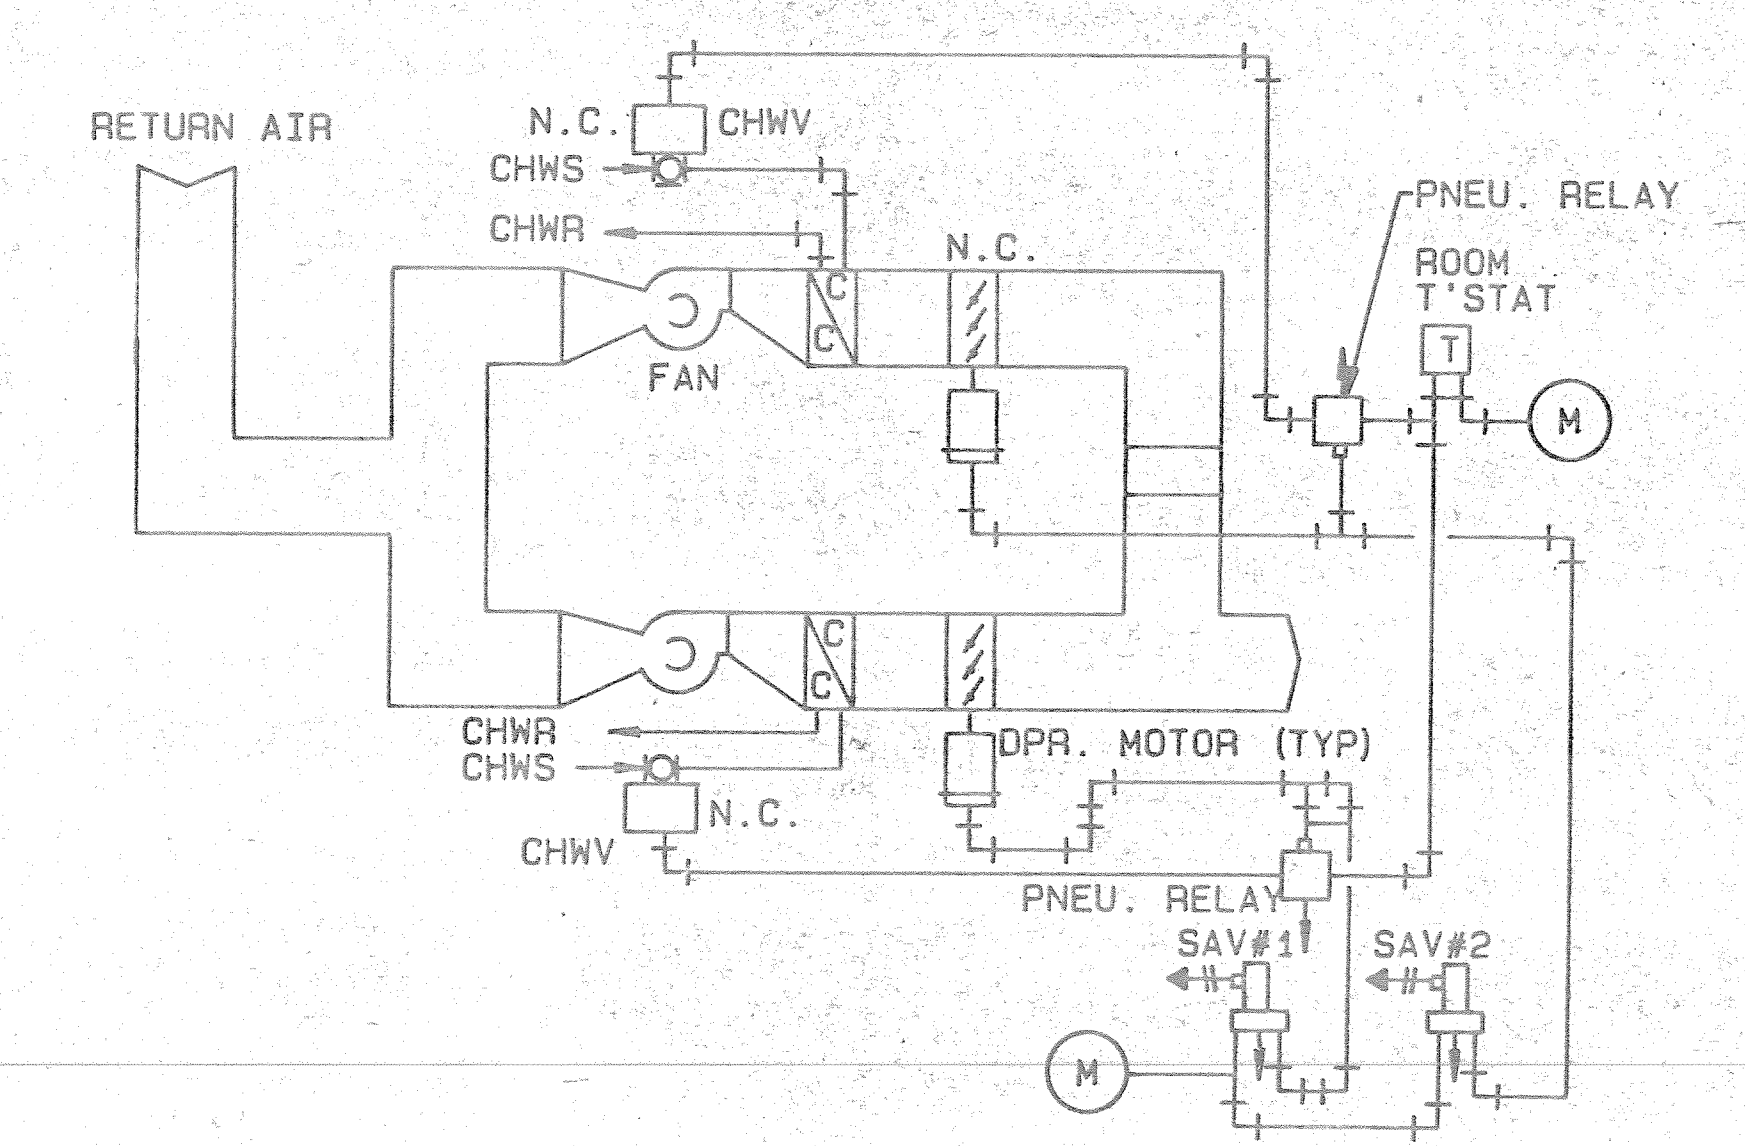


(CT-1, CT-2) TOWER FAN CONTROL (TYPICAL FOR 2)

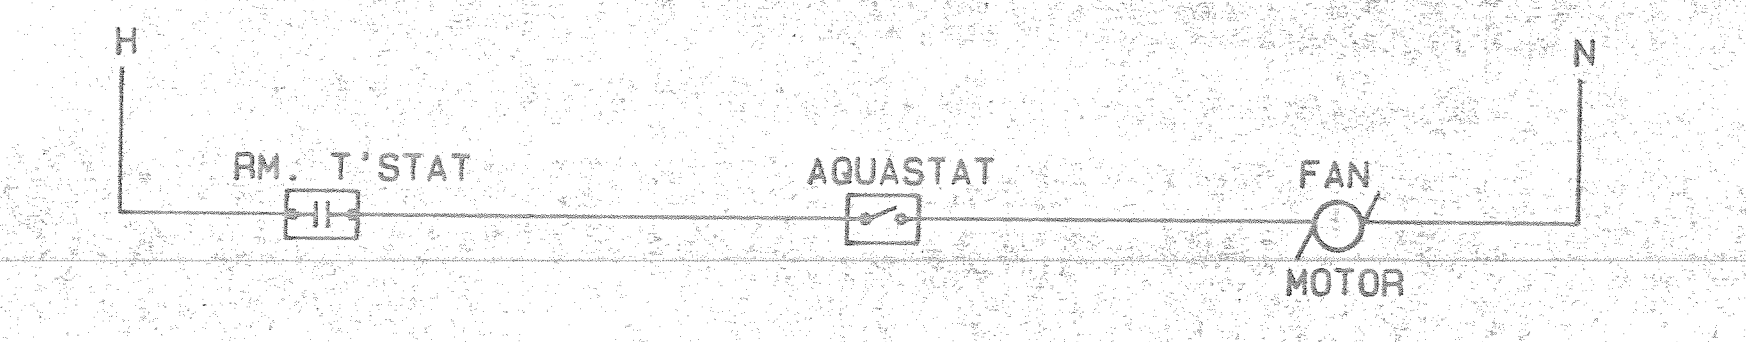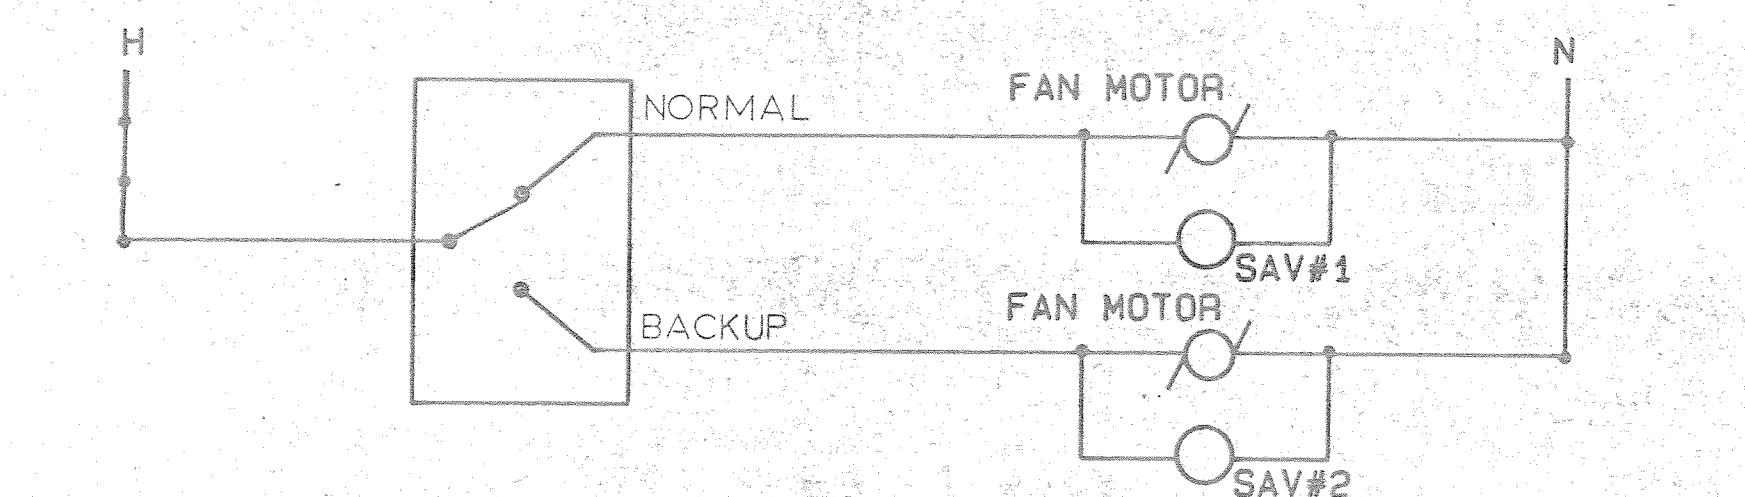


U.H. CONTROL

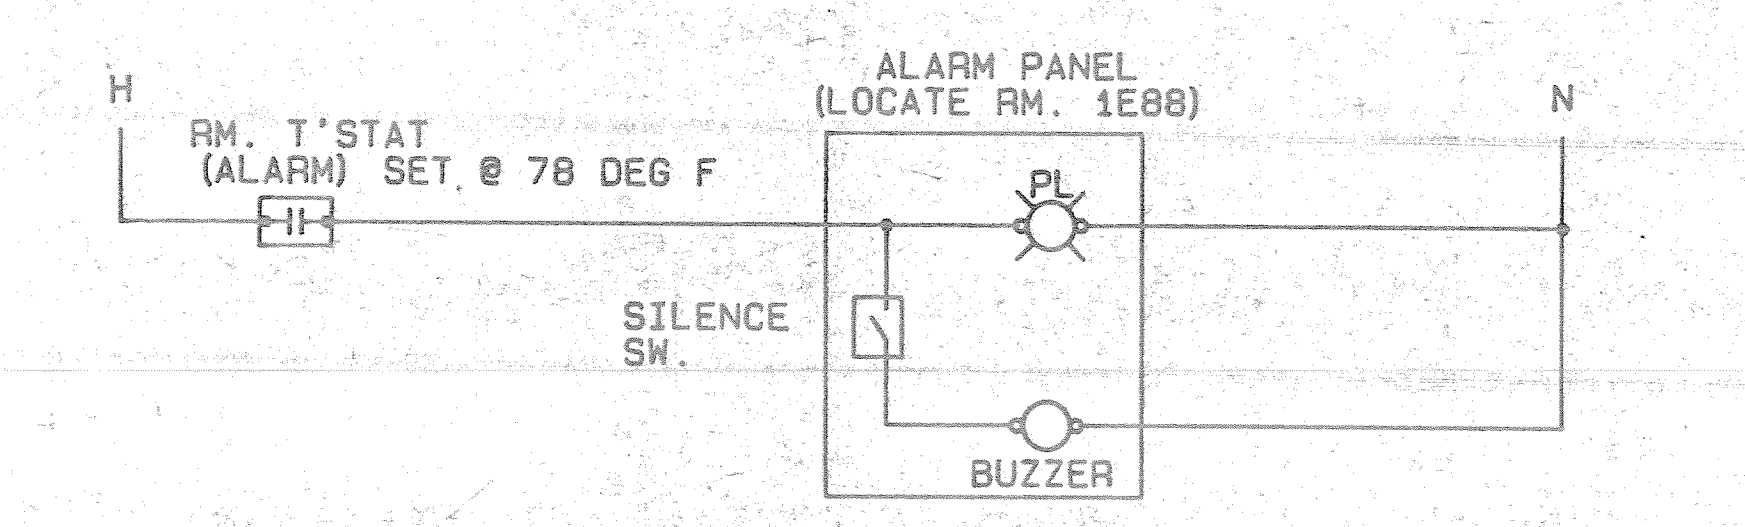


(AHU-1EST) TELEPHONE EQUIPMENT RM. UNITS

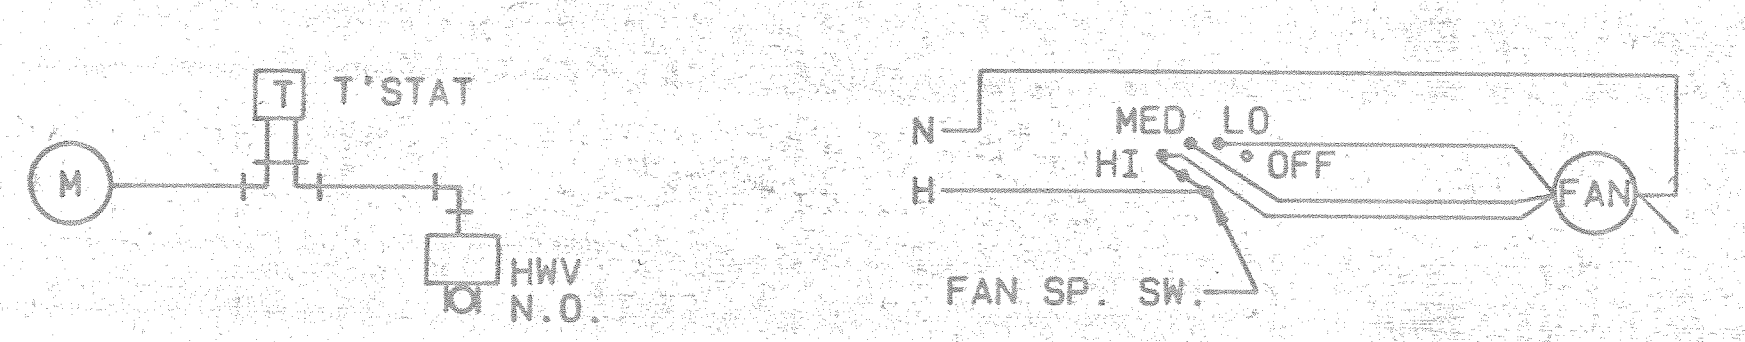



CABINET U.H.'S

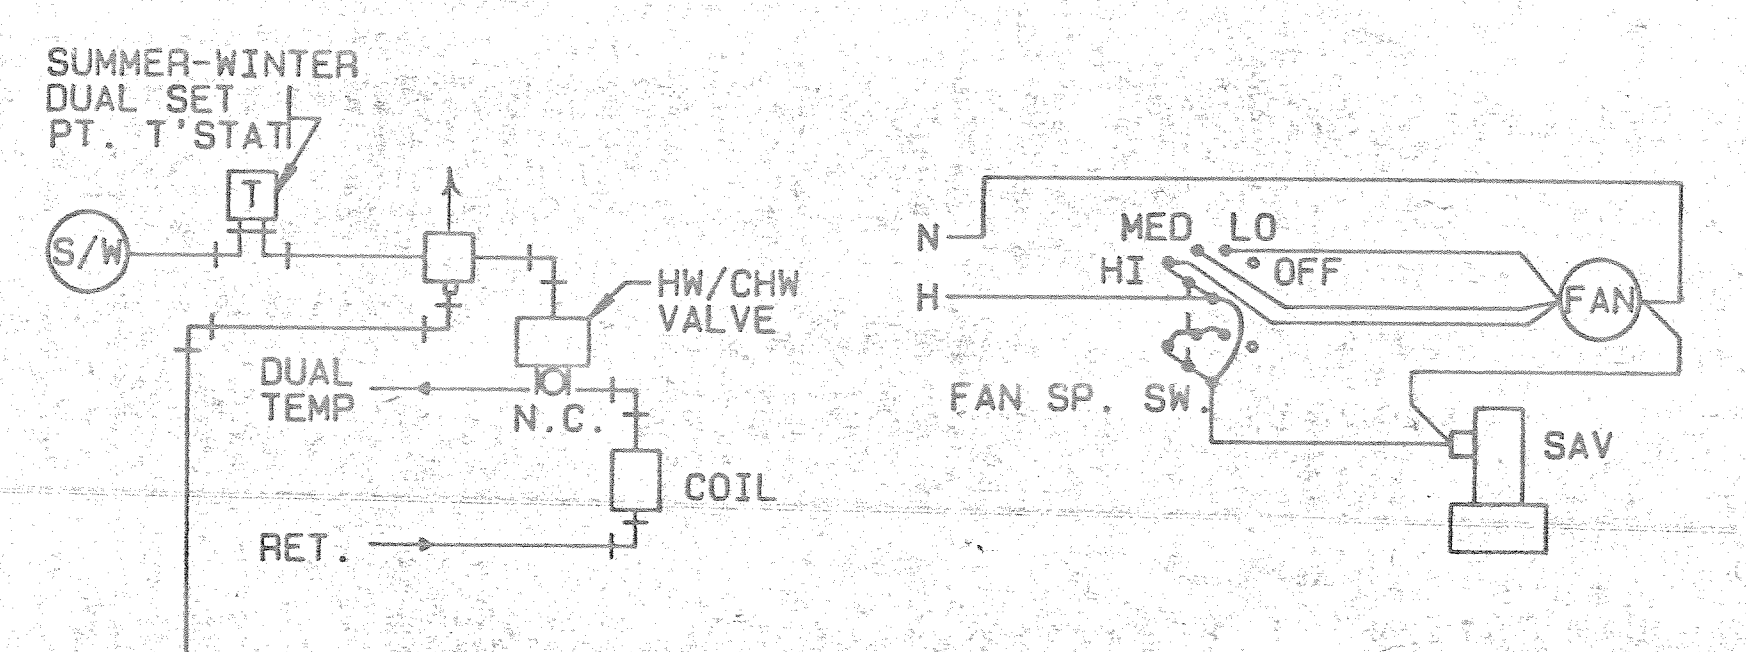


TYPICAL F.C.U. 8,9 CONTROL

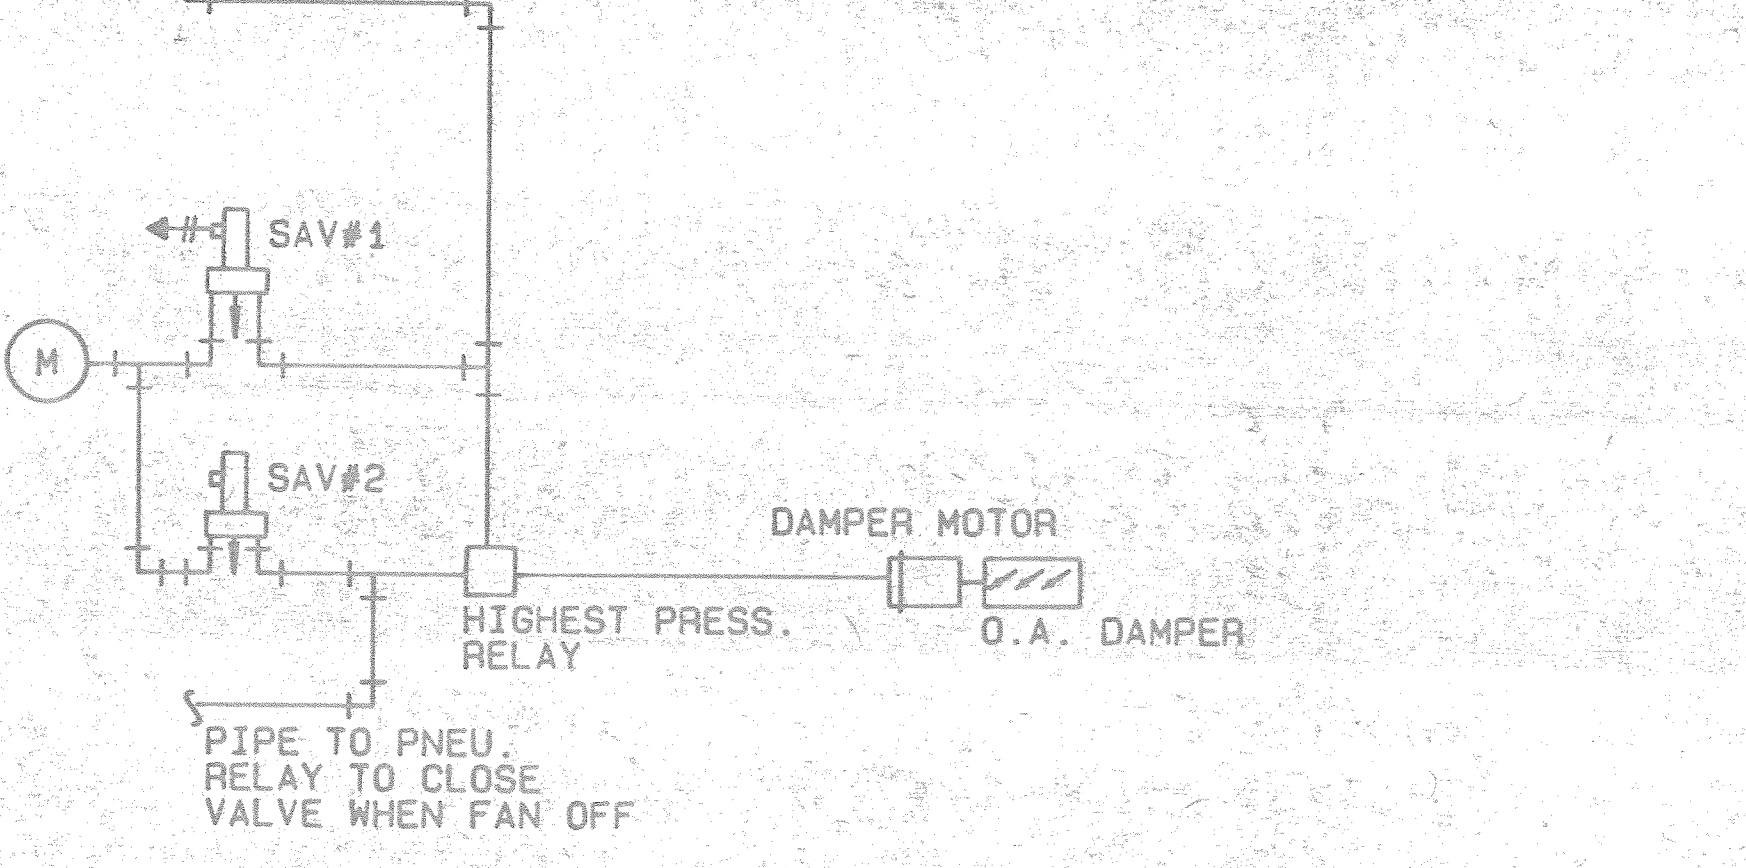


O.A. INTAKE FOR F.C.U.'S No.9 & 10

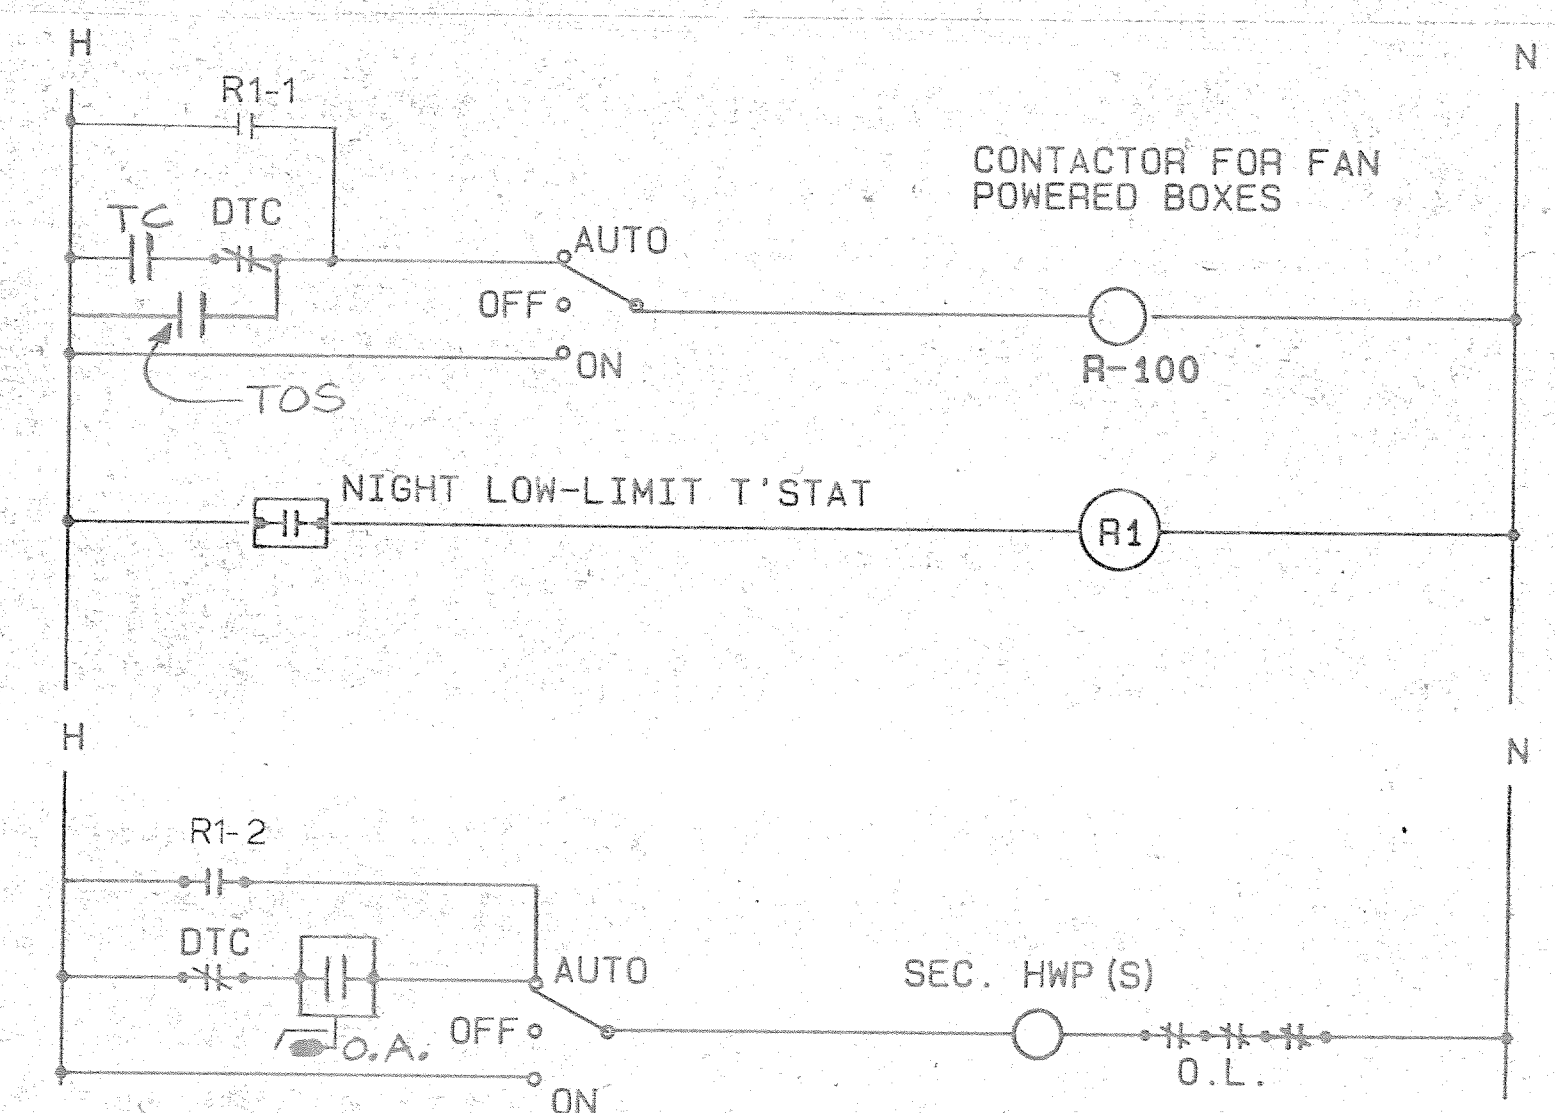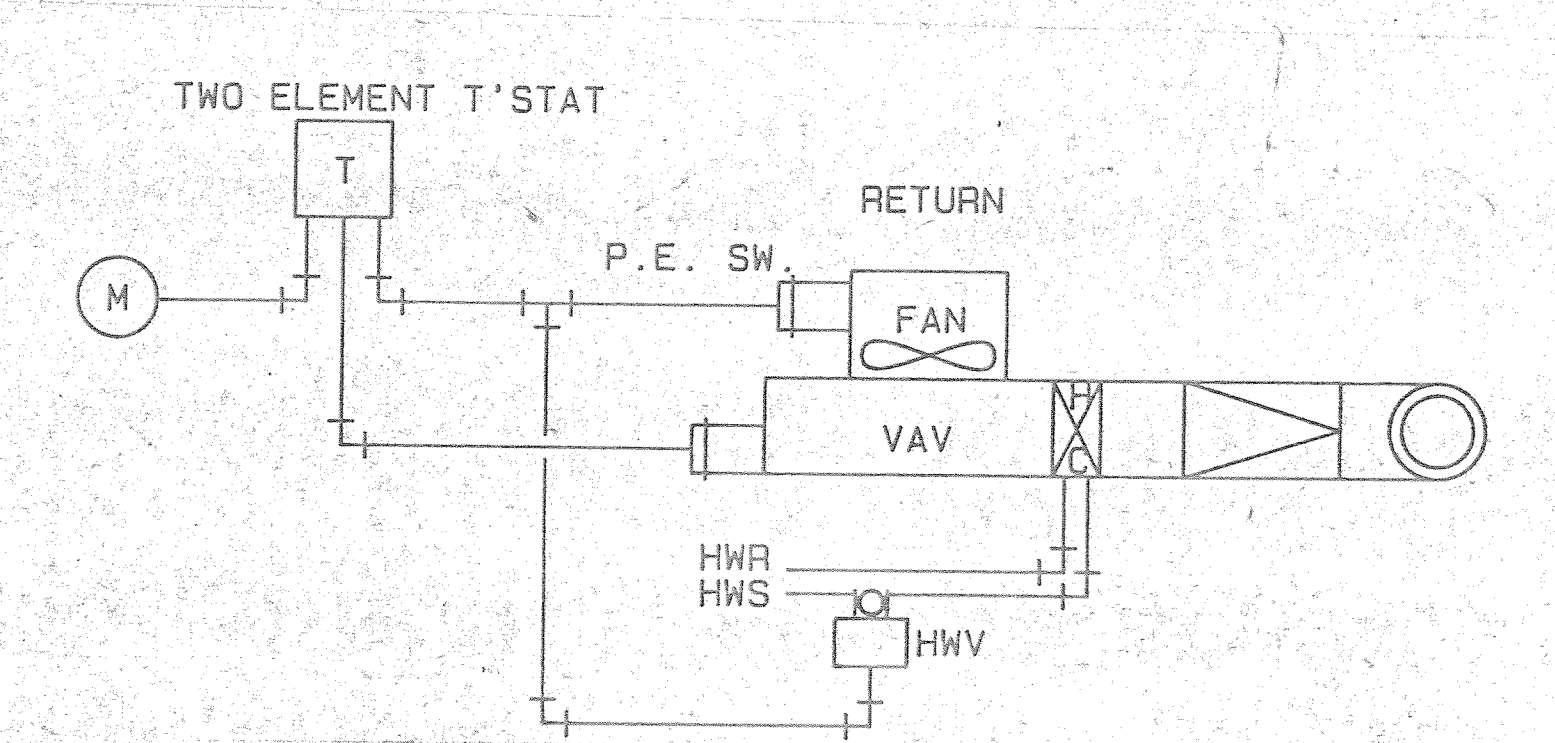


TYPICAL FAN POWERED BOX & SEC PUMP ZONE CONTROL

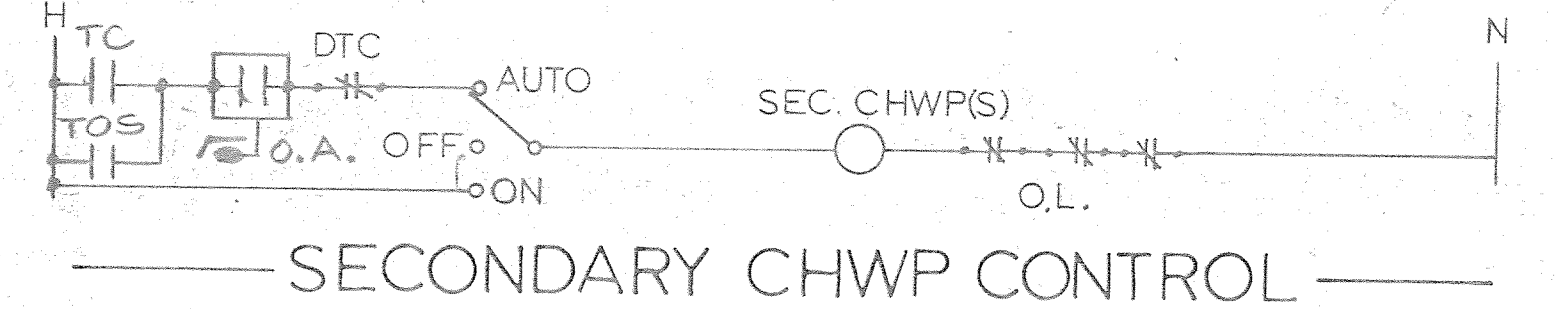


SECONDARY CHWP CONTROL

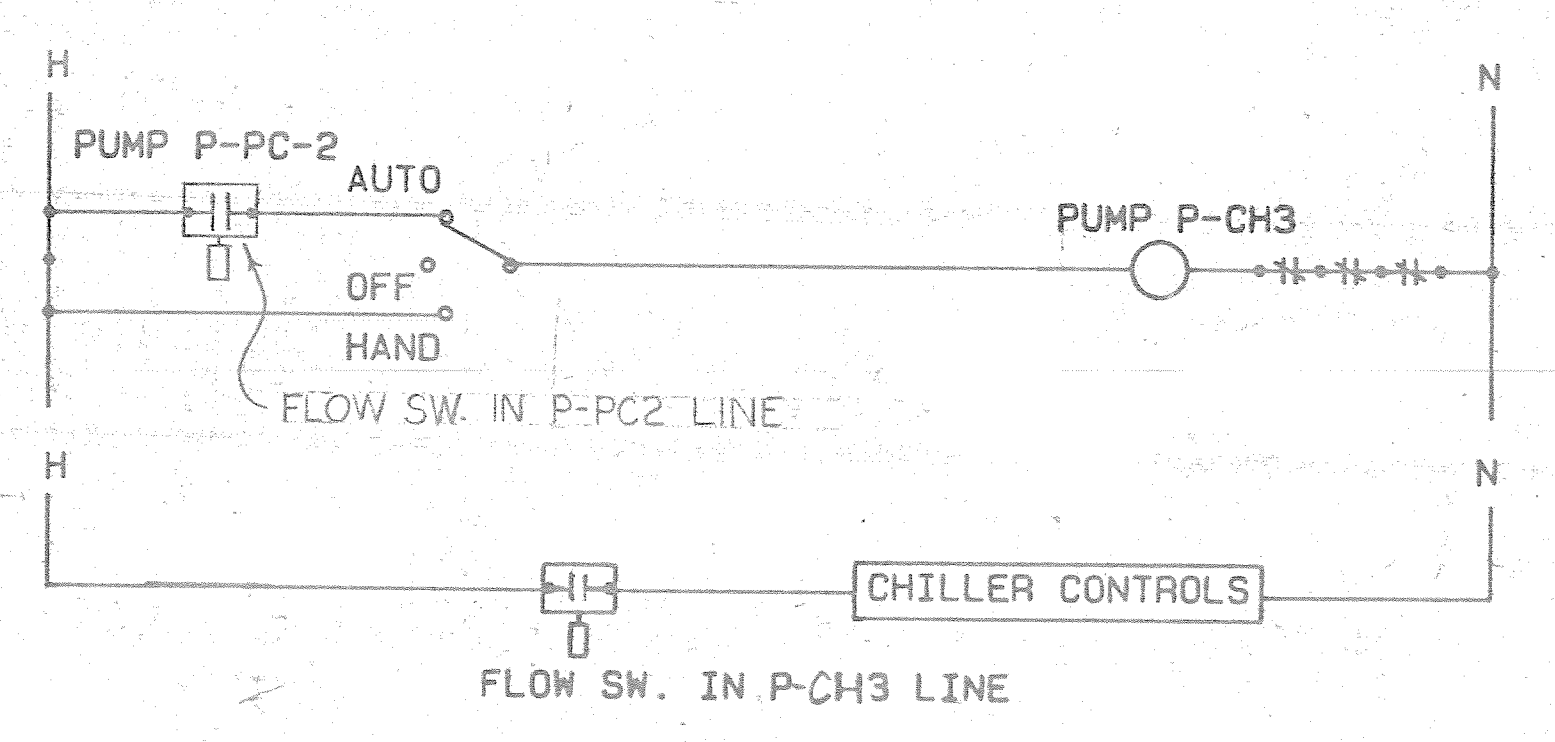


AIR COOLED CHILLER INTERLOCK

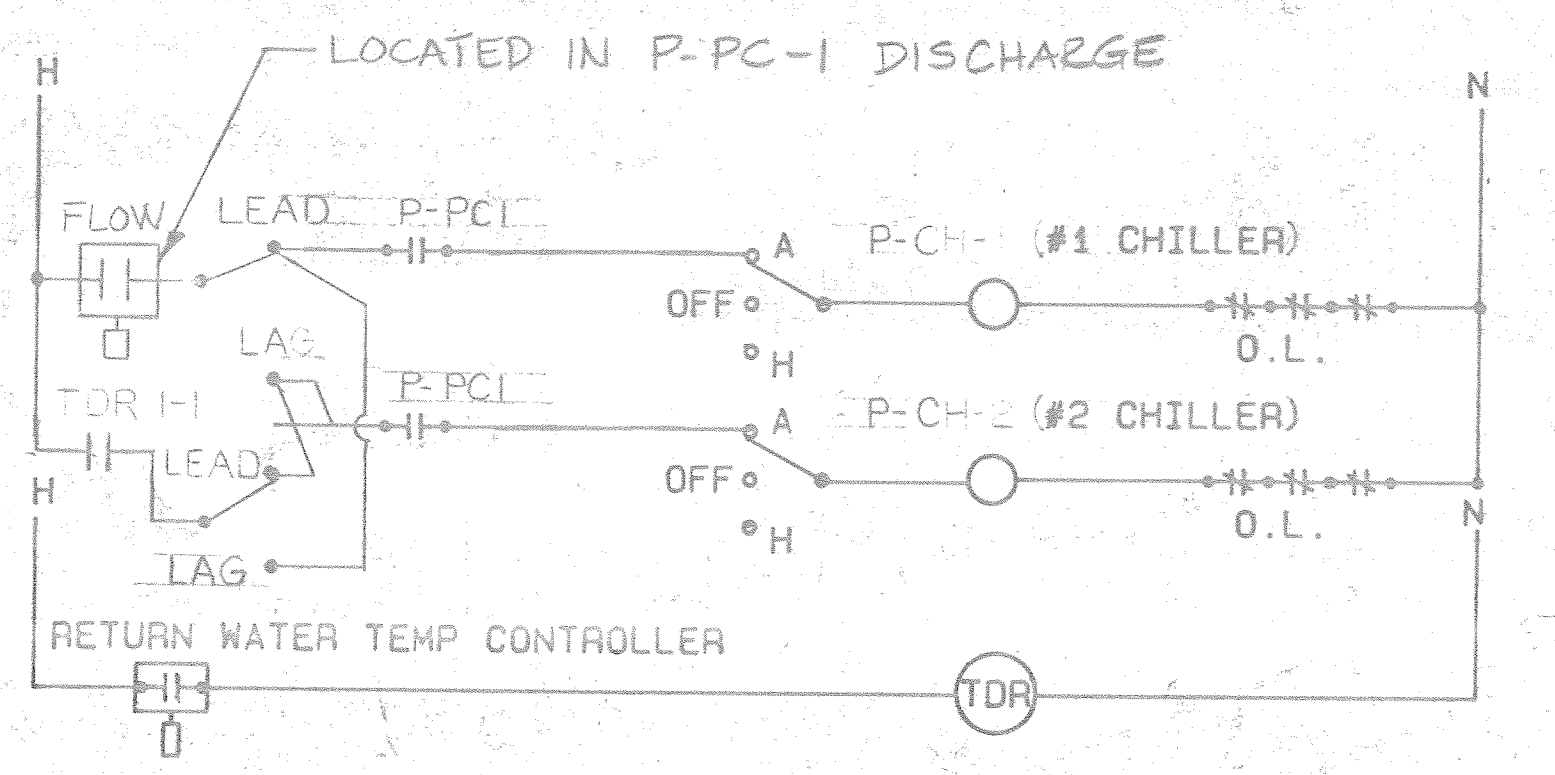


STAGING FOR CHILLERS 1&2

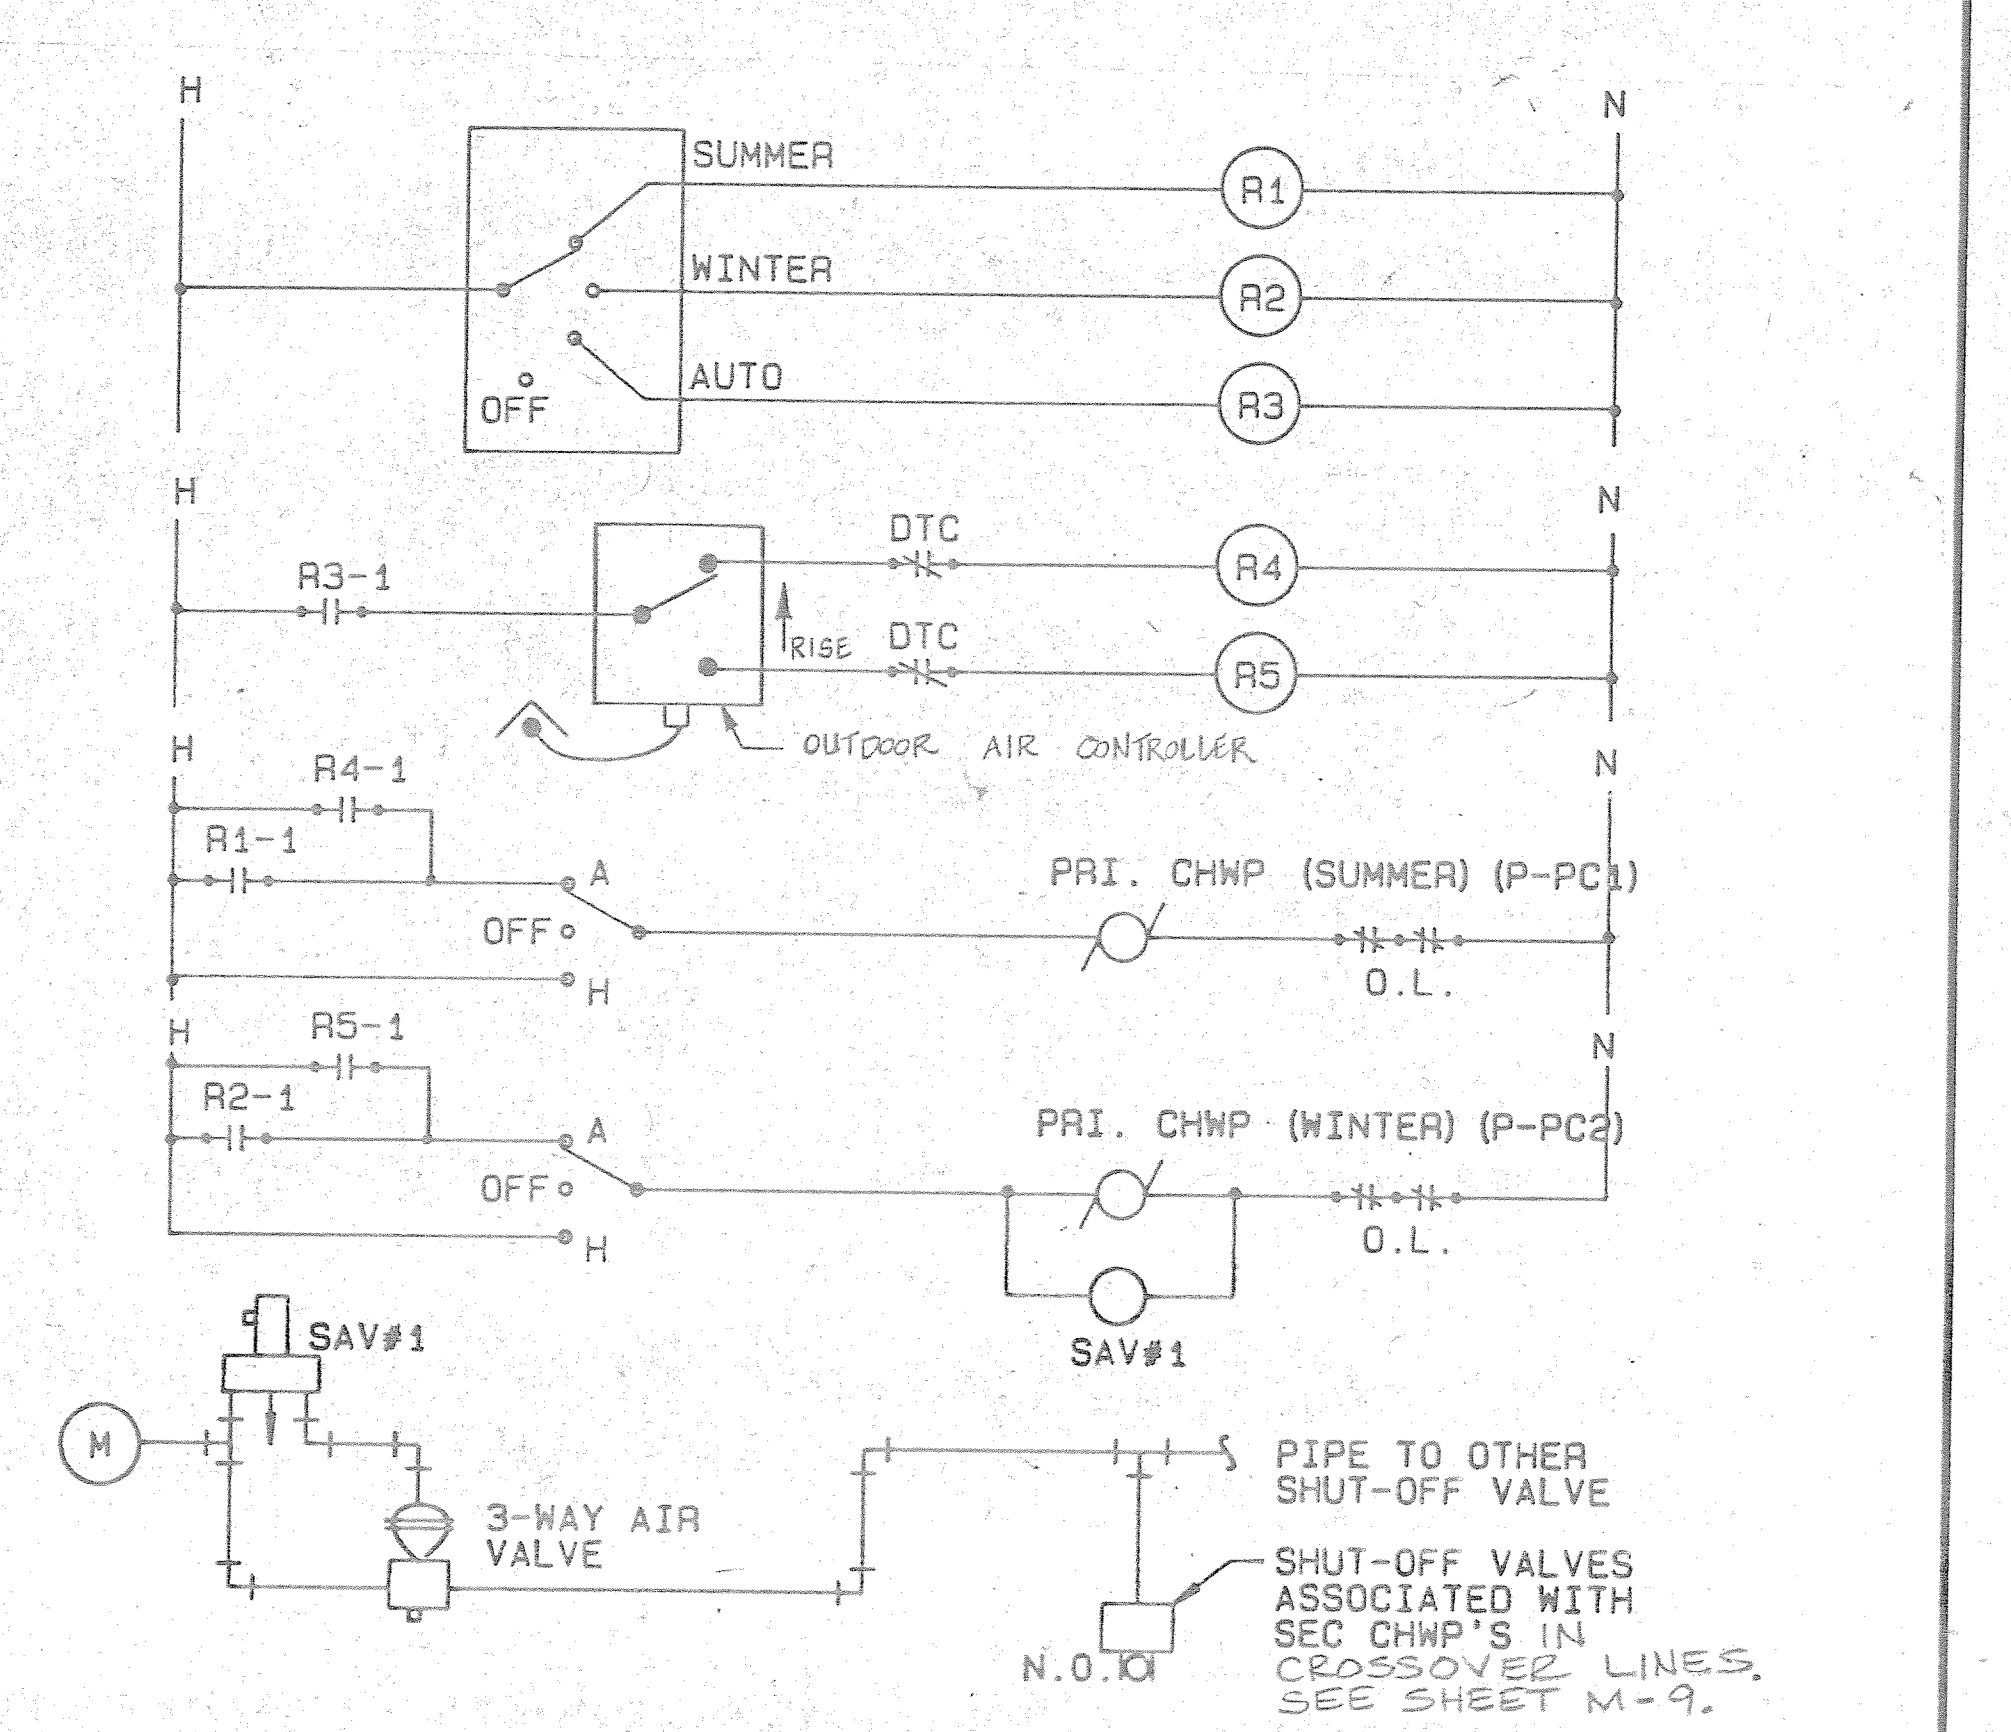

PRIMARY CHWP CONTROL

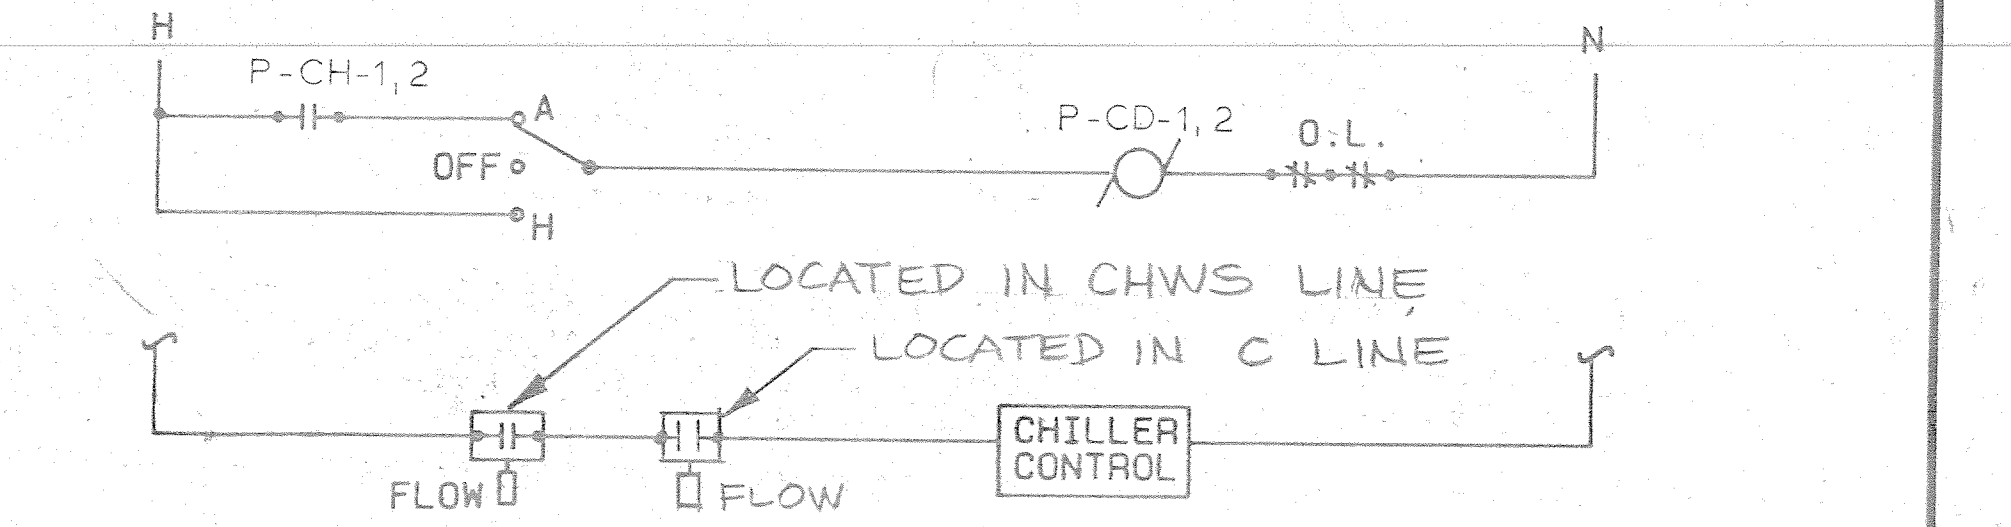


TYPICAL CWP/CHILLER 1&2 INTERLOCK

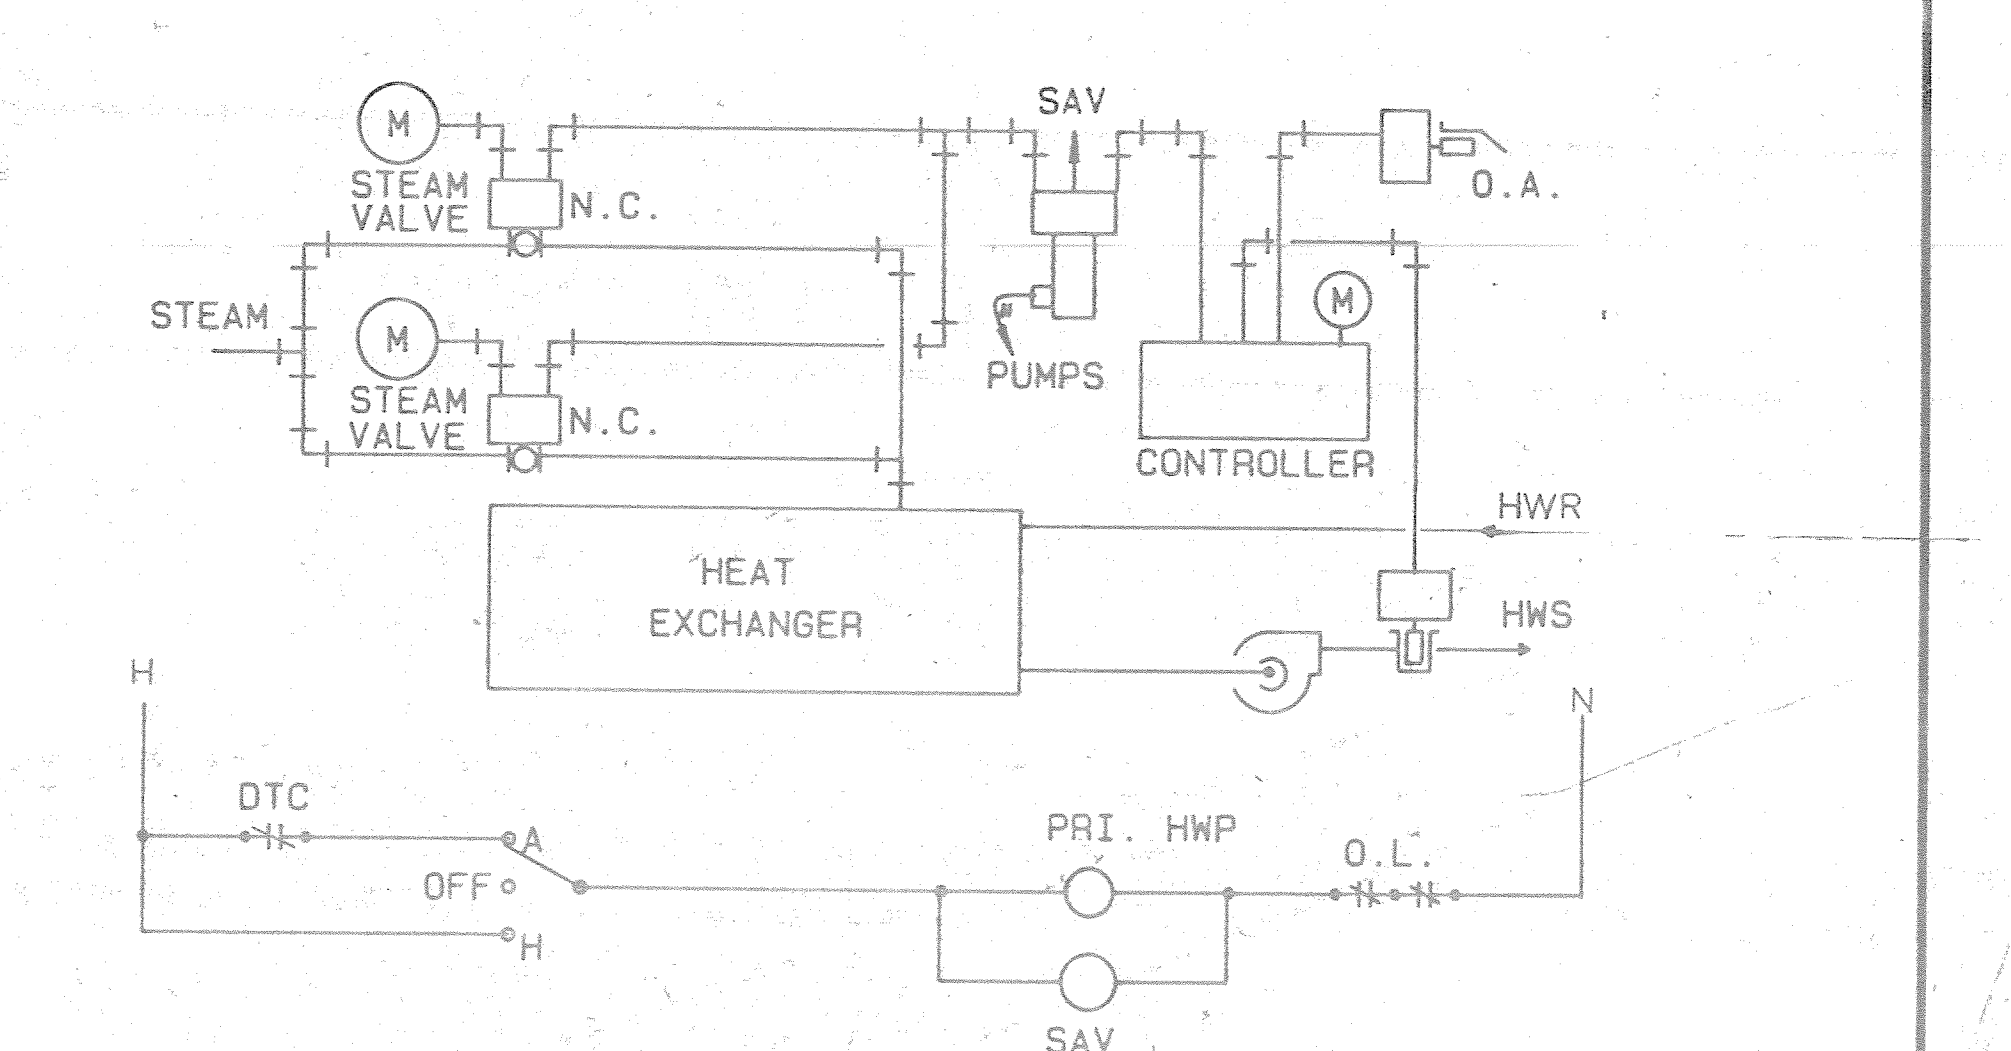

HEAT EXCHANGER CONTROL

<b>RECORD DRAWING</b>		<b>LETTER DATED AUG 10 1980</b>		<b>M-36</b>	
FEREBEE, WALTERS & ASSOCIATES ARCHITECTURE PLANNING CHARLOTTE NORTH CAROLINA		DEPARTMENT OF THE NAVY NAVAL FACILITIES ENGINEERING COMMAND ATLANTIC DIVISION NAVAL STATION NORFOLK, VIRGINIA		CONVERT HOSPITAL TO DIVISION HEADQUARTERS MECHANICAL - TEMPERATURE CONTROLS	
DESIGNED BY: G. H. S. [Signature]		CHECKED BY: [Signature]		DATE: 12/14/85	
SUBMITTED BY: [Signature]		DATE: 12/14/85		OFFICE IN CHARGE: [Signature]	
FIRM NUMBER: 1007		NO. 80091		DATE: 12/14/85	
APPROVED BY: [Signature]		DATE: 12/14/85		SCALE: AS NOTED (VIC 05-82-2243 (REV.))	
DRAWING NO. 4124304		CONSTR. CONTR. NO. N62470-82-B-2243		SHEET 149 OF 213	

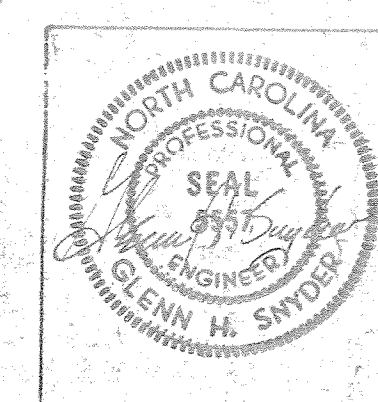

H-1-A-Wing















**AIR HANDLING UNIT SCHEDULE**

REVISIONS			
NO.	DESCRIPTION	PREP BY	DATE
1	GENERAL REVISION	GHE	2/15/86
2	REVISED AS BUILTS	DC	10/1/90

TAG (A.H.U. - )	FAN SECTION																								COOLING COIL SECTION				FILTER SECTION				MIXING BOX SECTION							
	IAS	IBN	1B5	1CN	1CS	2CN	2CS	1DN	1DS	2DS	1ES	1EST	2EN	2EN(SB)	2ES	3EN	3ENG	3ES	1FN	1FS	2FN	2FS	1GN	1GS	2GN	2GS	2GS5	1LN	1LS	2LN	2LS	1JN	1JS	MUAU-1						
FAN ARRANGEMENT	FC/NO																								FC/YES				FC/NO				FC/YES							
TYPE/TSD DISCHARGE DAMPER	FC/NO																								FC/YES				FC/NO				FC/YES							
MAX. SUPPLY CFM	5070	6891	8110	5970	6770	7100	6160	4330	7620	6650	8080	2323	3080	1436	7340	2304	4710	6990	6190	4450	5800	5900	6070	6350	6140	4680	NOT USED	6330	4070	5930	6700	6820	7010	23240						
MIN. OA. CFM	754	1112	1210	709	1015	946	981	770	1182	918	1113	116	329	1000	1578	618	733	1366	993	1007	973	961	970	786	787	892	USED	807	858	777	821	800	811	23240						
MOTOR HP	7.5	10.0	10.0	7.5	10.0	10.0	7.5	7.5	10.0	10.0	10.0	2.0	5.0	1.0	0.0	3.0	5.0	10.0	7.5	7.5	7.5	7.5	7.5	7.5	7.5	4.0	7.5	7.5	10.0	7.5	10.0	10.0	20.0							
TSP (IN. WC.)	3.8	4.2	4.0	4.2	4.1	4.0	4.0	3.9	4.2	4.0	4.2	2.4	4.0	4.3	2.7	2.4	3.9	4.1	4.2	4.0	4.0	4.1	4.1	4.1	4.0	4.2	4.2	4.0	4.1	3.9	4.1	3.0								

- LEGEND:**
- AHU-1AS - AIR HANDLING UNIT SERVING WING 1AS, ETC.
  - DT - DRAW THRU
  - FC - FORWARD CURVED BLADE
  - APD - AIR PRESSURE DROP
  - EWT - ENTERING WATER TEMPERATURE
  - LWT - LEAVING WATER TEMPERATURE
  - AADS - ASHRAE AVERAGE ATMOSPHERIC DUST SPOT TEST
  - TSD - TIGHT SHUT OFF DAMPERS, OPPOSED BLADE IN SHORT DIMENSION (0.75% LEAKAGE @ 5" W.C.)
  - \* - TWO UNITS REQUIRED

- NOTES:**
- PROVIDE INTERNAL SPRING VIBRATION ISOLATORS ON ALL AHU'S EXCEPT 1EST, 2EN(SB), 3EN, 2GS, & 2GS5. THE REMAINING AHU'S SHALL BE PROVIDED WITH 2" DEFLECTION SPRING VIBRATION ISOLATORS.
  - PROVIDE A FIRESTAT IN EACH AHU RETURN DUCT FOR ALL AIR HANDLING UNITS.
  - PROVIDE ELECTRICAL DISCONNECTS FOR AHU'S 2CN, 2CS, 2DS, 2FN, 2FS, 2GN, 2GS, 2HN, & 2HS.
  - PROVIDE A CONDENSATE LINE FROM AHU COOLING COIL TO FLOOR DRAIN FOR ALL UNITS. SEE PLANS FOR LINE SIZES. PROVIDE PLUG WHERE COND. LINE CHANGES DIRECTION FOR CLEANING PURPOSES.
  - SEE PREHEAT COIL SCHEDULE ON SHEET M-40.

**FAN COIL UNITS**

No	COOLING						HEATING		GENERAL				NOTES					
	T.L. MBH	T.S. MBH	NOM. CFM	W.C. CFM	ESP IN. WC	EAT DB/WB	EWT °F	WTD °F	FLOW GPM	COIL ROWS	MAX. W.P.D.	TH MBH		EWT °F	FLOW GPM	MOTOR POWER	ELEC. DATA	
FCU-1	23.9	19.1	1000	805	0.15	80/67	45	8	6.5	3	15.0	18.5	120	6.5	280 W	277/1	1-3	
FCU-2	8.7	7.5	400	322				10	2.0	3		3.6		2.0	145 W			
FCU-3	7.0	5.8	400	270				12	1.5	3		3.6		1.5				
FCU-4	8.2	6.5	400	270				10	2.0	3		4.4		2.0				
FCU-5	9.0	7.7	400	270				10	2.0	4		3.9		2.0				
FCU-6	7.0	5.9	400	270				12	1.5	3		3.9		1.5				
FCU-7	11.0	9.4	600	396				10	2.5	3		4.0		2.5	260 W			
FCU-8	10.7	9.3	400	322				8	2.5	3		2.2		1.5	145 W			
FCU-9	41.5	26.5	1200	1000	0.95			8	10.5	4		22.7		1.5	1/2 HP		1, 5, 6	
FCU-10	32.9	26.9	1200	1000	0.95	80/67		8	10.5	4		12.6		1.5	1/2 HP		1, 5, 6	
FCU-11	71.0	30.0	2000	2000	1.10	83/71		16	9.0	4		50.2		7.0	3/4 HP	460/3	1, 5, 6	
FCU-12	18.0	14.2	800	635	0.15	80/67		10	4.0	3		9.9		4.0	270 W	277/1	1-3	
FCU-13	9.8	8.4	400	322				10	2.0	3		4.6		2.0	145 W			
FCU-14	6.9	5.6	400	270				12	1.5	3		3.6		1.5				
FCU-15	8.7	7.3	400	322				10	2.0	3		3.4		2.0				
FCU-16	7.3	5.7	400	270				12	1.5	3		4.2		1.5				
FCU-17	9.6	7.6	400	322				10	2.0	3		8.0		2.0				
FCU-18	7.6	6.3	400	270				12	1.5	3		3.6		1.5				
FCU-19	6.2	4.9	300	193				8	2.0	3		3.6		2.0	110 W			
FCU-20	10.2	8.7	400	267				10	2.0	4		4.6		2.0	145 W			
FCU-21	7.1	5.8	400	270	0.15	80/67		12	1.5	3		4.1		1.5	145 W		1, 5, 6	
FCU-22	80.7	33.6	2000	2000	1.10	84/72		15	11.0	4		67.1		11.0	3/4 HP	460/3	1, 5, 6	
FCU-23	8.7	7.3	400	322	0.15	80/67		10	2.0	3		3.4		2.0	145 W	277/1	1-3	
FCU-24	7.6	6.3	400	270				12	1.5	3		3.6		1.5				
FCU-25	6.7	5.6	400	270				12	1.5	3		3.6		1.5				
FCU-26	7.6	6.3	400	270				12	1.5	3		3.6		1.5				
FCU-27	11.8	9.8	600	396				8	3.5	3		8.0		3.5	260 W			
FCU-28	7.3	5.7	400	270				12	1.5	3		4.2		1.5	145 W			
FCU-29	9.2	7.4	400	322				10	2.0	3		5.6		2.0	145 W			
FCU-30	9.5	8.1	400	267				10	2.0	4		4.2		2.0	145 W			
FCU-31	23.4	19.6	1000	805	0.15	80/67		8	6.5	3		11.3		6.5	280 W	277/1	1-3	
FCU-32	83.0	36.0	2000	2000	1.10	84/72		15	11.0	4		68.3	120	11.0	3/4 HP	460/3	1, 5, 6	
FCU-33	14.0	10.9	800	552	0.25	80/67		14	2.0	4		6.5	180	1.0	270 W	277/1	1-4	
FCU-34	80.0	34.4	2000	2000	1.24	80/67		15	11.0	4		24.9	180	2.0	3/4 HP	460/3	1, 5, 6	
FCU-35	58.3	10.0	1600	1600	0.82	79/67	45	8	DELETED	4.5		15.0	13.5	180	3.0	1/2 HP	277/1	1, 5, 6
FCU-36	HEAT ONLY											24.4	180	2.0				
FCU-37	HEAT ONLY											16.3	180	2.0				

- LEGEND:**
- T.L. TOTAL LOAD
  - T.S. TOTAL SENSIBLE
  - NOM. NOMINAL
  - W.C. WET COIL
  - ESP EXTERNAL STATIC PRESSURE
  - EAT ENTERING AIR TEMPERATURE
  - EWT ENTERING WATER TEMPERATURE
  - WTD WATER TEMPERATURE DIFFERENCE
  - W.P.D. WATER PRESSURE DROP (FT. WG.)
  - TH TOTAL HEATING
  - W WATTS
  - HP HORSEPOWER

- NOTES:**
- PROVIDE INSULATED DRAIN PAN AUXILIARY DRAIN PAN AND DRIP LEG.
  - PROVIDE PERMANENT SPLIT CAPACITOR, 3-SPEED MOTOR.
  - PROVIDE AN INSULATED RETURN AIR PLENUM AND FILTER.
  - PROVIDE 4-ROW COIL (3-ROWS COOLING AND 1-ROW HEATING IN REHEAT POSITION).
  - PROVIDE ADJUSTABLE BELT DRIVE UNIT WITH THROWAWAY FILTER, VIBRATION ISOLATORS, FLEXIBLE CONNECTIONS, DRAIN PAN AND AUXILIARY DRAIN PAN.
  - AIR PRESSURE DROP IS TOTAL STATIC PRESSURE IN LIEU OF E.S.P. SHOWN.
  - SEE PLANS TO DETERMINE THE NUMBER OF EACH UNIT REQUIRED.
  - PROVIDE ELECTRICAL DISCONNECTS TO ALL FCU'S.

**ROOFTOP AIR CONDITIONING UNITS**

TAG NO.	ESP IN. WG	TL MBH	TS MBH	IFM HP	OFM QTY/FLA	COMPR. QTY/RLA	ELEC V/F	NOTES	
									CFM
RTAC-1	1200	0.74	37.4	27.1	1/1.5	1/7.4	460/3	1, 2, 4, 5	
RTAC-2	2000	0.82	61.4	46.1	1/1.5	1/10.4	460/3	1, 2, 4, 5	
RTAC-3	1000	0.79	29.0	21.0	1/1.5	1/13.5	200/3	1, 2, 4, 5	
RTAC-4	2250	0.61	62.4	46.1	1/1.5	1/10.4	460/3	1, 2, 4, 5	
RTAC-5	10,000	1.00	360.0	258.0	10	3/3.3	2/27.5	460/3	1, 2, 4, 5
RTAC-6	10,000	1.00	360.0	258.0	10	3/3.3	2/27.5	460/3	1, 2, 4, 5
RTAC-7	2250	0.61	62.4	46.1	1/1.5	1/10.4	460/3	1, 2, 4, 5	
RTAC-8	1400	0.65	48.4	33.7	3/4	1/1.5	1/8.8	460/3	1, 2, 4, 5

- LEGEND:**
- ESP - EXTERNAL STATIC PRESSURE
  - TL - TOTAL LOAD
  - TS - TOTAL SENSIBLE
  - IFM - INDOOR FAN MOTOR
  - OFM - OUTDOOR FAN MOTOR
  - COMPR. - COMPRESSOR
  - \* - PROVIDE FIRESTAT
  - PROVIDE ELEC. DISCONNECT

- NOTES:**
- PROVIDE 14" HIGH ROOF CURB FOR FLAT ROOF
  - PROVIDE ECONOMIZER CYCLE WITH RELIEF DAMPER
  - PROVIDE ECONOMIZER CYCLE WITHOUT RELIEF DAMPER
  - PROVIDE 2" THICK, PLEATED FILTERS WITH 30% EFFICIENCY
  - CAPACITIES BASED ON 95°F AMBIENT & EAT = 80 DB/67 WB

**AIR DISTRIBUTION SCHEDULE**

TAG	SERVICE	TYPE	FRAME	DAMPERS	P-REMARKS
A	SUPPLY	CEILING	T-BAR	NO	4-WAY THRU LOUVER FACED 24"X24" PANEL EQUALIZER GRID
B	SUPPLY	CEILING	T-BAR	NO	2-WAY THRU LOUVER FACED 24"X24" PANEL EQUALIZER GRID
C	SUPPLY	CEILING	T-BAR	NO	2-WAY THRU LOUVER FACED 24"X24" PANEL, EQUALIZER GRID
D	SUPPLY	CEILING	T-BAR	NO	1-WAY THRU LOUVER FACED 24"X24" PANEL, EQUALIZER GRID
E	RETURN	SIDENALL	PLASTER	NO	0" DEFLECTION VERTICAL BARS 28" SPACING STEEL CONSTRUCTION
F	SUPPLY	SIDENALL	PLASTER	NO	DOUBLE DEFLECTION HORIZONTAL BARS 28" SPACING STEEL CONSTRUCTION
G	RETURN	CEILING	T-BAR	NO	12"X12"X1/2" EXTRUDED ALUMINUM EGGSHELL, 22-22-NEUT, 1/2" SPACING
H	SUPPLY	SIDENALL	NO	NO	SAME AS "F"
J	RET/EXH.	SIDENALL	NO	NO	SAME AS "E"
K	RETURN	CEILING	T-BAR	NO	PERFORATED GRILLE BAKED OFF-WHITE FINISH
L	SUPPLY	CEILING	NO	YES	SAME AS "K" EXCEPT SUPPLIE MOUNTED
M	RETURN	CEILING	NO	NO	SAME AS "K" EXCEPT SUPPLIE MOUNTED
N	RET/EXH.	CEILING	NO	YES	PARALLEL BLADES, 45° DEFLECTION 28" ON 28" SPACING, SUPPLIE MOUNTED
P	SUPPLY	CEILING	NO	YES	ADJUSTABLE ROUND OFF-WHITE FINISH
R	SUPPLY	CEILING	T-BAR	NO	PERFORATED GRILLE BAKED OFF-WHITE FINISH
S	SUPPLY	CEILING	NO	YES	SLOT TYPE TO FIT IN LAY-IN CEILING

- NOTES:**
- PROVIDE LOCKING TYPE DAMPERS 4'-0" FROM ALL SUPPLY OUTLETS.
  - NECK SIZES & CFM VALUES ARE SHOWN ON PLANS.

**REFRIGERATION - WATER CHILLERS**

LEGEND	No. 1			No. 2			No. 3			REMARKS
	QTY	TYPE	NOM. SIZE (TDS)	QTY	TYPE	NOM. SIZE (TDS)	QTY	TYPE	NOM. SIZE (TDS)	
QUANTITY	1	CENTRIFUGAL	320	1	CENTRIFUGAL	320	1	WATER COOLED	RECIPROCATING - NO. 3	
TYPE									SEE NOTES 1 & 2	
NOM. SIZE (TDS)	320			320			320			
COOLER GPM	512			512			512			
COOLER EWT/LWT (DEG.F)	57/42			57/42			57/42			
MAX. COOLER PRESS. DROP (FT.)	15.0			15.0			15.0			
CONDENSER EWT/LWT (DEG.F)	95/85			95/85			95/85			
MAX. CONDENSER PRESSURE DROP (FT.)	15.0			15.0			15.0			
COMPRESSOR(S) QUNTY	1			1			1			
COMPRESSOR FULL HP	210/480/3			210/480/3			210/480/3			
STARTER TYPE	STAR DELTA			STAR DELTA			WOUND-THE-ROTOR			
CONDENSER GPM	316			316						
FILLING FACT. COOLER/CONDENSER	0.0005			0.0005			0.0005			
OPERATING WEIGHT	19,000#			19,000#			3,780			

- NOTES:**
- PROVIDE HOT GAS BYPASS
  - CAPACITY BASED ON 95°F AMBIENT
  - PROVIDE ELECTRICAL DISCONNECT

**COOLING TOWER'S**

QUANTITY	CF-1		CF-2	
	INDUCED DRAFT	INDUCED DRAFT	INDUCED DRAFT	INDUCED DRAFT
TYPE	916	916	916	916
GPM (EA.)	95/85</			







TERMINAL UNIT SCHEDULE

REVISIONS			
NO.	DESCRIPTION	PREP BY	DATE
1	GENERAL REVISION	GHS	2/1/86
2	REVISED - AS BUILTS	DC	10/1/90

AREA SERVED	UNIT No.	TAG No.	INLET SIZE	MAX. CFM		MIN. CFM	FAN CFM	HP-ELEC	HOT WATER		PIPE CONN.		
				ESP	TSP				ROWS	WPD			
IAS	1	IAS-1	8	121/31	94	550/21	1/4-277/1	1	.03	11.9	1.0	0.8	1/2"
IAS	2	IAS-2	14	210/38	272	1600/35	1/2-277/1	1	.12	27.5	1.0	1.0	1/2"
IAS	3	IAS-3	12	181/31	242	1420/31	1/2-277/1	1	.09	31.7	1.5	2.0	1/2"
IAS	4	IAS-4	12	185/31	146	850/21	1/2-277/1	1	.07	20.6	1.0	1.0	1/2"
IBN	1	IBN-1	12	147/31	156	1070/25	1/2-277/1	1	.06	16.3	1.0	1.0	1/2"
IBN	2	IBN-2	12	142/36	155	1070/25	1/2-277/1	1	.06	17.2	1.0	1.0	1/2"
IBN	3	IBN-3	12	145/36	160	1100/28	1/2-277/1	1	.06	22.3	1.0	1.0	1/2"
IBN	4	IBN-4	8	85/32	70	480/24	1/4-277/1	1	.05	12.6	1.0	0.8	1/2"
IBN	5	IBN-5	14	205/30	222	1510/28	1/2-277/1	1	.09	14.6	1.0	1.0	1/2"
IBN	6	IBN-6	8	219/33	89	480/24	1/4-277/1	1	.04	11.2	1.0	0.8	1/2"
IBN	7	IBN-7	10	164/33	105	700/25	1/4-277/1	1	.05	12.4	1.0	0.8	1/2"
IBN	8	IBN-8	14	205/33	221	1510/28	1/2-277/1	1	.09	14.6	1.0	1.0	1/2"
IBS	1	IBS-1	12	171/32	148	880/25	1/2-277/1	1	.07	14.8	1.0	1.0	1/2"
IBS	2	IBS-2	12	150/29	204	1100/24	1/2-277/1	1	.05	13.0	1.0	1.0	1/2"
IBS	3	IBS-3	8	85/33	112	480/25	1/4-277/1	1	.05	13.1	1.0	0.8	1/2"
IBS	4	IBS-4	6	515/32	70	390/22	1/4-277/1	1	.05	7.7	1.0	0.8	1/2"
IBS	5	IBS-5	6	441/32	61	340/22	1/4-277/1	1	.03	5.7	1.0	0.8	1/2"
IBS	6	IBS-6	12	151/35	215	1180/27	1/2-277/1	1	.06	21.6	1.0	0.8	1/2"
IBS	7	IBS-7	12	144/31	201	1100/28	1/2-277/1	1	.06	21.1	1.0	1.0	1/2"
IBS	8	IBS-8	12	147/31	199	1100/28	1/2-277/1	1	.06	22.9	1.0	1.0	1/2"
ICN	1	ICN-1	12	104/39	117	900/25	1/2-277/1	1	.04	20.7	1.0	1.0	1/2"
ICN	2	ICN-2	12	112/25	112	870/26	1/2-277/1	1	.05	14.4	1.0	1.0	1/2"
ICN	3	ICN-3	12	112/31	112	870/24	1/2-277/1	1	.05	14.4	1.0	1.0	1/2"
ICN	4	ICN-4	8	245/31	82	480/24	1/4-277/1	1	.03	12.3	1.0	0.8	1/2"
ICN	5	ICN-5	6	519/33	50	390/23	1/4-277/1	1	.05	9.1	1.0	0.8	1/2"
ICN	6	ICN-6	12	115/33	112	870/25	1/2-277/1	1	.05	14.4	1.0	1.0	1/2"
ICN	7	ICN-7	8	488/32	62	470/24	1/4-277/1	1	.05	10.2	1.0	0.8	1/2"
ICS	1	ICS-1	10	172/36	133	760/26	1/4-277/1	1	.05	14.8	1.0	0.8	1/2"
ICS	2	ICS-2	12	154/31	175	1000/27	1/2-277/1	1	.05	17.6	1.0	1.0	1/2"
ICS	3	ICS-3	14	185/34	245	1400/30	1/2-277/1	1	.07	27.5	1.0	1.0	1/2"
ICS	4	ICS-4	12	136/32	174	1000/24	1/2-277/1	1	.04	17.0	1.0	1.0	1/2"
ICS	5	ICS-5	12	187/35	177	1000/26	1/2-277/1	1	.05	21.6	1.0	1.0	1/2"
ICS	6	ICS-6	10	852/31	111	640/23	1/4-277/1	1	.05	16.3	1.0	0.8	1/2"
ICN	1	ICN-1	8	805/32	90	600/23	1/4-277/1	1	.04	5.6	1.0	0.8	1/2"
ICN	2	ICN-2	12	156/36	190	1140/28	1/2-277/1	1	.06	22.7	1.0	1.0	1/2"
ICN	3	ICN-3	12	142/32	162	1080/25	1/2-277/1	1	.07	18.1	1.0	1.0	1/2"
ICN	4	ICN-4	12	159/35	179	1200/28	1/2-277/1	1	.06	19.1	1.0	1.0	1/2"
ICN	5	ICN-5	6	349/28	39	260/20	1/4-277/1	1	.03	3.5	1.0	0.8	1/2"
ICN	6	ICN-6	8	442/30	72	480/22	1/4-277/1	1	.04	8.1	1.0	0.8	1/2"
ICN	7	ICN-7	12	114/32	132	870/25	1/2-277/1	1	.04	13.4	1.0	1.0	1/2"
ICN	8	ICN-8	10	105/34	102	680/26	1/4-277/1	1	.05	10.8	1.0	0.8	1/2"
ICS	1	ICS-1	12	141/35	146	800/25	1/2-277/1	1	.04	13.4	1.0	1.0	1/2"
ICS	2	ICS-2	12	149/31	125	1000/27	1/2-277/1	1	.05	19.1	1.0	1.0	1/2"
ICS	3	ICS-3	12	149/35	192	1050/25	1/2-277/1	1	.05	19.7	1.0	1.0	1/2"
ICS	4	ICS-4	8	721/31	94	510/23	1/4-277/1	1	.04	8.3	1.0	0.8	1/2"
ICS	5	ICS-5	10	1215/31	130	710/24	1/4-277/1	1	.05	12.7	1.0	0.8	1/2"
ICS	6	ICS-6	12	124/35	160	870/25	1/2-277/1	1	.04	16.3	1.0	1.0	1/2"
ICS	7	ICS-7	6	580/33	74	410/25	1/4-277/1	1	.05	11.0	1.0	0.8	1/2"
IDN	1	IDN-1	6	448/32	78	310/22	1/4-277/1	1	.03	8.3	1.0	0.8	1/2"
IDN	2	IDN-2	12	121/36	211	850/26	1/2-277/1	1	.04	33.0	2.0	2.7	1/2"
IDN	3	IDN-3	8	574/34	100	400/23	1/4-277/1	1	.03	13.8	1.0	0.8	1/2"
IDN	4	IDN-4	6	447/32	78	310/22	1/4-277/1	1	.03	7.2	1.0	0.8	1/2"
IDN	5	IDN-5	10	1057/35	183	740/26	1/4-277/1	1	.05	19.8	1.0	0.8	1/2"
IDN	6	IDN-6	8	612/31	120	480/22	1/4-277/1	1	.04	8.7	1.0	0.8	1/2"
IDN	7	IDN-7	6	316/36	50	280/25	1/4-277/1	1	.03	5.9	1.0	0.8	1/2"
IDN	8	IDN-8	10	1081/34	136	750/25	1/4-277/1	1	.05	15.8	1.0	0.8	1/2"
IDN	9	IDN-9	16	1491/41	307	1100/38	1/4-277/1	1	.14	30.0	1.0	1.0	1/2"
IDN	10	IDN-10	12	1549/32	195	1080/25	1/2-277/1	1	.06	18.0	1.0	1.0	1/2"
IDN	11	IDN-11	6	547/30	69	380/21	1/4-277/1	1	.03	10.0	1.0	0.8	1/2"
IDN	12	IDN-12	10	1132/31	143	800/25	1/4-277/1	1	.06	14.6	1.0	0.8	1/2"
IDN	13	IDN-13	10	1193/34	125	700/26	1/4-277/1	1	.05	14.4	1.0	0.8	1/2"
IDN	14	IDN-14	8	853/32	107	600/23	1/4-277/1	1	.04	11.6	1.0	0.8	1/2"
IDN	15	IDN-15	8	644/31	72	450/20	1/4-277/1	1	.03	6.8	1.0	0.8	1/2"
IDN	16	IDN-16	8	838/32	100	620/23	1/4-277/1	1	.04	10.5	1.0	0.8	1/2"
IDN	17	IDN-17	10	1187/32	133	850/25	1/4-277/1	1	.06	13.5	1.0	0.8	1/2"
IDN	18	IDN-18	4	105/36	120	750/26	1/4-277/1	1	.05	12.6	1.0	0.8	1/2"
IDN	19	IDN-19	10	1036/31	116	720/24	1/4-277/1	1	.05	13.0	1.0	0.8	1/2"
IDN	20	IDN-20	6	1016/30	123	710/23	1/4-277/1	1	.05	12.7	1.0	0.8	1/2"
IDN	21	IDN-21	8	818/31	99	610/23	1/4-277/1	1	.04	11.3	1.0	0.8	1/2"
IDN	22	IDN-22	12	1178/34	135	740/26	1/4-277/1	1	.05	14.0	1.0	0.8	1/2"
IES	1	IES-1	8	771/35	100	580/25	1/4-120/1	1	.04	11.0	1.0	0.8	1/2"
IES	2	IES-2	6	553/34	69	400/23	1/4-120/1	1	.03	11.4	1.0	0.8	1/2"
IES	3	IES-3	10	884/44	115	—	—	—	—	—	—	—	—
IES	4	IES-4	10	1071/41	118	680/27	1/4-120/1	1	.05	20.9	1.0	0.8	1/2"
IES	5	IES-5	8	772/36	101	580/25	1/4-120/1	1	.04	11.1	1.0	0.8	1/2"
IES	6	IES-6	8	679/35	88	510/25	1/4-120/1	1	.04	9.1	1.0	0.8	1/2"
IES	7	IES-7	10	872/35	114	654/26	1/4-120/1	1	.05	13.0	1.0	0.8	1/2"
IES	8	IES-8	6	452/31	59	—	—	—	—	—	—	—	—
IES	9	IES-9	12	1089/38	181	1040/29	1/2-120/1	1	.06	23.6	1.0	1.0	1/2"
IES	10	IES-10	12	1471/38	188	—	—	—	—	—	—	—	—
ZEN	1	ZEN-1	12	1521/37	166	1140/30	1/2-120/1	1	.06	16.9	1.0	1.0	1/2"
ZEN	2	ZEN-2	6	514/34	56	310/23	1/4-120/1	1	.03	6.6	1.0	0.8	1/2"
ZEN	3	ZEN-3	10	1082/36	107	740/27	1/4-120/1	1	.05	13.5	1.0	0.8	1/2"
ZES	1	ZES-1	12	1125/37	229	840/28	1/2-120/1	1	.04	21.3	1.0	1.0	1/2"
ZES	2	ZES-2	8	1107/35	226	—	—	—	—	—	—	—	—
ZES	3	ZES-3	8	571/32	114	430/22	1/4-120/1	1	.03	12.8	1.0	0.8	1/2"
ZES	4	ZES-4	10	1151/37	147	710/28	1/4-120/1	1	.05	15.8	1.0	0.8	1/2"
ZES	5	ZES-5	10	1171/37	147	540/23	1/4-120/1	1	.04	15.2	1.0	0.8	1/2"
ZES	6	ZES-6	8	615/35	126	460/24	1/4-120/1	1	.03	10.5	1.0	0.8	1/2"
ZES	7	ZES-7	6	340/29	69	—	—	—	—	—	—	—	—
ZES	8	ZES-8	10	1201/41	190	—	—	—	—	—	—	—	—
ZES	9	ZES-9	10	851/32	174	640/25	1/4-120/1	1	.05	18.6	1.0	0.8	1/2"
ZES	10	ZES-10	6	501/33	103	330/25	1/4-120/1	1	.05	11.2	1.0	0.8	1/2"
ZEN	1	ZEN-1	12	1026/41	163	1000/31	1/2-120/1	1	.06	17.7	1.0	1.0	1/2"
ZEN	2	ZEN-2	12	1481/38	181	1110/29	1/2-120/1	1	.06	21.0	1.0	1.0	1/2"
ZEN	3	ZEN-3	14	2371/28	0	—	—	—	—	—	—	—	—
ZES	1	ZES-1	12	1159/34	222	870/26	1/2-120/1	1	.06	21.2	1.0	1.0	1/2"
ZES	2	ZES-2	8	712/31	137	530/22	1/4-120/1	1	.04	14.7	1.0	0.8	1/2"
ZES	3	ZES-3	10	1031/36	174	680/27	1/4-120/1	1					







EXHAUST FAN SCHEDULE

TAG NO.	CFM	S.P.	MOTOR	NOTES	LOCATION	SERVICE
1	500	.25	1/20-120/1	5,6,8	IAM	T
2	760	.25	1/20-120/1	5,6,8		T
3	443	.25	1/20-120/1	5,6,8	IAB	T
4	400	.125	1/20-120/1	5,11	DELETED (A)	M
5	443	.25	1/20-120/1	6,8	IBH	T
6	400	.125	1/20-120/1	11	IBH	T
7	201	.25	1/20-120/1	6,8		T
8	443	.25	1/20-120/1	6,8	IBS	T
9	400	.25	1/20-120/1	11		M
10	200	.25	1/15-120/1	4,5,8	DELETED	LAUNDRY
11	443	.25	1/20-120/1	5,6,8	IBH	T
12	549	.25	1/20-120/1	5,6,8		T
13	405	.25	1/20-120/1	5,6,8	2BS	T
14	349	.25	1/20-120/1	5,6,8		T
15	370	.25	1/20-120/1	6,8	ICN	T
16	400	.125	1/20-120/1	11		M
17	443	.25	1/20-120/1	6,8	ICS	T
18	400	.125	1/20-120/1	11		M
19	443	.25	1/20-120/1	6,8	2CN	T
20	400	.125	1/20-120/1	11		M
21	33	.125	1/15-120/1	4,5,8		T
22	443	.25	1/20-120/1	6,8	2CS	T
23	400	.125	1/20-120/1	11		M
24	186	.125	1/40-120/1	5,6,8		T
25	186	.125	1/40-120/1	5,6,8		T
26	526	.25	1/20-120/1	5,6,8	IDN	T
27	1920	.125	1/20-120/1	5,11		M
28	550	.125	1/20-120/1	11		M
29	443	.25	1/20-120/1	6,8	IDS	T
30	400	.125	1/20-120/1	11		M
31	33	.125	1/15-120/1	4,5,8	IDS	T
32	443	.25	1/20-120/1	6,8	2DS	T
33	400	.125	1/20-120/1	11		M
34	443	.25	1/20-120/1	5,6,8	IEN (GALLEY)	T
35	78	.125	1/20-120/1	5,6,8		T
36	59	.125	1/15-120/1	4,5,8	DELETED	T
37	443	.25	1/20-120/1	5,6	2EH	T
38	158	.125	1/40-120/1	5,6,8		T
39	501	.25	1/20-120/1	5,6,8	3EH	T
40	3100	.25	1/20-120/1	5,12	3EN	M
41	677	.25	1/20-120/1	6,8	IES	T
42	1165	.5	1/4-120/1	6,9	2ES	T
43	926	.125	1/20-120/1	6,9		M
44	973	.375	1/20-120/1	6,9	3ES	T
45	793	.125	1/20-120/1	6,8		M
46	400	.125	1/20-120/1	11	IFH	M
47	400	.125	1/20-120/1	11	IFS	M
48	443	.25	1/20-120/1	6,8	2FH	T
49	192	.25	1/15-120/1	5,6,8		T
50	145	.25	1/15-120/1	5,6,8		T
51	400	.125	1/20-120/1	11		M
52	183	.25	1/15-120/1	5,6,8	2FS	T
53	186	.25	1/15-120/1	5,6,8		T
54	143	.25	1/20-120/1	6,8		T
55	400	.125	1/20-120/1	11	IGN	M
56	400	.125	1/20-120/1	11	IGS	M
57	400	.125	1/20-120/1	11	IGS	M
58	443	.25	1/20-120/1	6,8	2GN	T
59	184	.25	1/15-120/1	5,6,8		T
60	186	.25	1/15-120/1	5,6,8		T
61	400	.125	1/20-120/1	11		M
62	186	.25	1/15-120/1	5,6,8	2GS	T
63	186	.25	1/15-120/1	5,6,8		T
64	411	.25	1/20-120/1	6,8		T
65	110	.25	1/20-120/1	5,6,7	IEN(G) GAN WASH	T
66	400	.125	1/20-120/1	11	2GS	M
67	400	.125	1/20-120/1	11	IHN	DELETED
68	186	.25	1/15-120/1	5,6,8	IHS	T
69	400	.125	1/20-120/1	11		M
70	443	.25	1/20-120/1	6,8	2HN	T
71	400	.125	1/20-120/1	11		M
72	443	.25	1/20-120/1	6,8	2HS	T
73	400	.125	1/20-120/1	11		M
74	416	.25	1/20-120/1	6,8	IJH	T
75	400	.125	1/20-120/1	11		M
76	416	.25	1/20-120/1	6,8	IJS	T
77	400	.125	1/20-120/1	11		M
78	460	.125	1/20-120/1	1,5	IAB	CORRIDOR
79	1334	.125	1/4-120/1	1,5	IB-C & 2B-C	CORRIDOR
80	1334	.125	1/4-120/1	1,5	1C-D & 2C-D	CORRIDOR
81	1334	.125	1/4-120/1	1,5	1D-E	CORRIDOR
82	600	.125	1/20-120/1	1,5	1ES(MIC/ES/E)	CORRIDOR
83	600	.125	1/20-120/1	1,5	2ES(MIC/ES/E)	CORRIDOR
84	1276	.125	1/4-120/1	1,5	1F-G & 2F-G	CORRIDOR
85	1276	.125	1/4-120/1	1,5	1G-H & 2G-H	CORRIDOR
86	2250	1.5	2 160/3	2,5	IEN (GALLEY)	CAFÉ
87	5485	1.5	2 460/3	2,5	DELETED	BAKERY
88	1200	.25	1/20-120/1	1,5		REF WASHING
89	1545	.25	1/8 160/3	2,5	3EN	GALLEY HOODS
90	4500	1.0	8 160/3	3,5		SERVICES AREA
91	1500	.375	1/2 160/3	2,5	IEN (IHH)	
92	700	.375	1/2 160/3	2,5		DISH WASH
93	950	.25	1/20-120/1	5,6,7	IEN	TUNNEL
94	1334	.125	1/4-120/1	1,5	1E-F & 2E-F	DELETED
95	260	.125	1/20-120/1	1	2BN	LAUNDRY
96	260	.125	1/20-120/1	1	2BS	LAUNDRY
97	443	.25	1/20-120/1	5,6,8	IEN	T
98	443	.25	1/20-120/1	5,6,8	IFC	T
99	443	.25	1/20-120/1	5,6,8	IGN	T
100	405	.25	1/20-120/1	5,6,8	IGS	T

WINTER VENTILATION FAN SCHEDULE

TAG NO.	CFM	S.P.	H.W. COIL MAX VEL. 800 FPM	FILTER (GTY) SIZE	HTGLD (MBH)	EWT (°F) (MAX)	WATER FLOW (GPM)	ELEC. DATA HP-V/Ø/HZ
WVF-1AS	1090	0.75		20x25x2	32.3	32.3	2.5	1/2-120/1/60
IBN	1590			20x25x2	52.0	4.0	DELETED	
IBS	1730			20x25x2	56.6	4.0		
ICN	1010			20x25x2	33.2	2.5		
ICS	1450			20x25x2	47.5	3.0		
2CN	1351			20x25x2	44.3	3.0		
2CS	1400			20x25x2	45.9	3.0		
IDN	1100			20x25x2	36.0	2.5		
IDS	1610			20x25x2	53.0	3.5		
2DS	1310			20x25x2	43.0	3.0		
3ES	2250			20x25x2	73.8	4.0		3/4-120/1/60
1FN	1420			20x25x2	46.5	3.0		1/2-120/1/60
1FS	1440			20x25x2	46.5	3.0		
2FN	1390			20x25x2	47.1	3.0		
2FS	1370			20x25x2	45.0	3.0		
1GN	1390			20x25x2	45.4	3.0		
IGS	1410			20x25x2	46.1	3.0		
2GN	1410			20x25x2	46.1	3.0		
IHN	1150		DELETED	20x25x2	37.0	2.5		
IHS	1230			20x25x2	40.1	3.0		
2HN	1110			20x25x2	36.4	2.5		
2HS	1170			20x25x2	38.4	2.5		
IJN	1150			20x25x2	37.4	2.5		
IJS	1160			20x25x2	38.0	2.5		
2GS	1270			20x25x2	41.5	3.0		1/2-120/1/60

NOTE - ALL WVF COILS HAVE A MAXIMUM WATER P.D. OF 15 FEET AND MAX. A.P.D. = 0.15 IN. W.C. NO ELECTRICAL DISCONNECT REQUIRED ON WVF FANS.

HEAT EXCHANGER NOTES:  
 1. HE-1 AND HE-2 SHALL BE PROVIDED UNDER THE PLUMBING WORK.  
 2. HE-3 SHALL BE PROVIDED WITH THE FOLLOWING FEATURES:  
 a. A MOUNTING SADDLE.  
 b. ALL CONNECTIONS 4" AND LARGER SHALL BE FLANGED; SMALLER CONNECTIONS MAY BE THREADED.  
 c. INSULATION STOP PLATES AT EACH REMOVABLE HEAD TO ALLOW SERVICES WITHOUT REINSULATING.

HEAT EXCHANGER SCHEDULE

NO.	HE-1	HE-2	HE-3
SERVICE	DOM.H.W.	DOM.H.W.	SPACE HEAT
TUNNEL LOCATION	BDG-E	BDG-E	BET. F & G
TUBE WATER GPM/FT. HD	38/4.8	20/1.3	647/1.8
STEAM (#/HE - PSIG)	1388-10	625-10	8960-10
CAPACITY, OUTPUT (MBH)	1333	600	8602
WATER TEMP. (IN/OUT)	50°F/120°F	120°F/180°F	153°F/180°F
NO. PASSES/TUBE VEL.	4 / 6.0 FPS	4 / 3.3 FPS	2 / 5.0 FPS
FOULING FACTOR (TUBE/SHELL)	.0005/.0005	.0005/.0005	.0005/.0005
SHELL SIZE (DIA X LENGTH)	6" x 48"	6" x 48"	18" x 60"
MAT'L S TUBES/SHELL	CU / STEEL	CU / STEEL	CU / STEEL

PRESSURE REDUCING STATION SCHEDULE

SYMBOL	PRV #1	PRV #2	PRV #3
SERVICE	STEAM	STEAM	STEAM
ARRANGEMENT	SINGLE	SERIES	SINGLE
TOTAL CAP. LB./HR. (4)	1388	8960	625
INLET PRESS. (PSIG)	100 PSIG	100 PSIG	100 PSIG
INTERMEDIATE PRESS. (PSIG)	-	65 PSIG	-
OUTLET PRESS. (PSIG)	10 PSIG	15 PSIG	10 PSIG
RELIEF VALVE LB./HR. NO. 1	1388	8960	625
NO. 2	-	8960	-
NOTES	1,2,4	1,3,4	1,2,4

NOTES:  
 1. PROVIDE STRAINERS & RELIEF VS AS PARTS OF PRV STATIONS.  
 2. THE PRESSURE REGULATOR VALVE SHALL SENSE DOWNSTREAM PRESSURE & TEMPERATURE.  
 3. PROVIDE 2 VALVES PIPED IN PARALLEL, WITH APPROX. 1/3 CAPACITIES.  
 4. TOTAL CAPACITIES LISTED ARE AT FINAL (LOW) PRESSURE RATING.

EXHAUST FAN NOTES:  
 1. SIDEWALL CENTR., BDD, BS, IG (MAX. TIP SPEED = 3720 FPM).  
 2. UPBLAST, ROOF MOUNTED ON PREFAB CURB, DISCONNECT, BIRDSCREEN, BACKDRAFT DAMPER.  
 3. UPBLAST, BASE MOUNTED BELT DRIVE.  
 4. CEILING MOUNTED FAN WITH BACKDRAFT DAMPER.  
 5. PROVIDE DISCONNECT SWITCH.  
 6. INLINE CENTRIFUGAL EXHAUSTER WITH BACKDRAFT DAMPER, VIBRATION ISOLATORS  
 7. INLET GUARD  
 8. PROVIDE ROOF CAP WITH MAX 900 CFM @ 600 FPM.  
 9. PROVIDE ROOF CAP WITH MAX 1250 CFM @ 600 FPM.  
 10. PROVIDE ROOF CAP WITH MAX 1800 CFM @ 600 FPM.  
 11. DIRECT DRIVE PROPELLER FAN.  
 12. BELT DRIVE, WALL COLLAR, BDD, IG (MAX. TIP SPEED = 5200 FPM)  
 M = MECHANICAL, T = TOILET, BDD = BACKDRAFT DMPR., BS = BIRDSCREEN, IG = INLET GUARD

EXHAUST FAN SCHEDULE (CONT.)

TAG NO.	CFM	S.P.	MOTOR	NOTES	LOCATION	SERVICE
EF-101	445	.25	1/20-120/1	5,6,8	IHN	T
102	443	.25	1/20-120/1	5,6,8	IHS	T
103	186	.25	1/20-120/1	6,8	2DS	T
104	1334	.125	1/4-120/1	1	2D-E	CORRIDOR
105	1900	.25	1/8-120/1	5,6,7	IEN	TUNNEL
106	2000	.25	1/4-120/1	5,12	IDN	M

PUMP SCHEDULE

TAG NO.	SERVICE	TYPE	GPM(EA)	HEAD	HP	RPM	NOTES
P-CH-1	CH. W.	DSBM	580	34'	7.5	1750	1
P-CH-3	CH. W.	IN-LINE	55	18'	0.5	1750	
P-CD-1E2	COND. W.	DSBM	916	50'/52'	20	1150	1
P-FC-1	CH. W.	"	136.5	30'	1.5	1150	1,3
P-FC-2		END SUCTION	410	10'	2	1150	3
P-G-AG		IN-LINE	121	5'	0.5	1750	7
P-C-C			155	57'	0.5	7	
P-C-D			111	66'	0.5	7	
P-C-EN			111	57'	0.5	7	
P-C-ES			154	43'	0.5	7	
P-C-F			147	57'	0.5	7	
P-C-G			145	62'	0.5	7	
P-C-H			135	60'	0.5	7	
P-C-J			83	49'	0.5	7	
P-BFAB	DUAL T		181	93'	10	7	
P-PH	H.W. PRI.	DSEM	647	55'	15	1,7	
P-H-AB	H.W. SEC.	IN-LINE	76	63'	0.5	7	
P-H-C			68	62'	0.5	7	
P-H-D			57	59'	0.5	7	
P-H-EN			22	61'	1.5	7	
P-H-ES			64	59'	2	7	
P-H-F			70	59'	3	7	
P-H-G			72	60'	3	7	
P-H-H			68	59'	3	7	
P-H-J			30</				




Pelotau



CONTROL VALVE SCHEDULE (CONT.)

REVISIONS			
SYM	DESCRIPTION	PREP'D BY	DATE
1	GENERAL REVISION	GHS	2/15/86

S	SERVICE	FLOW		PRESSURE DROP		LINE SIZE	FLUID	REMARKS	TAG	SERVICE	FLOW		PRESSURE DROP		LINE SIZE	FLUID	REMARKS
		#/HR	GPM	PSI	CV						#/HR	GPM	PSI	CV			
151	TU-105-2		1.0	5.0		1/2"	HW	2-WAY	V-221	TU-16N-1		1.0	5.0		1/2"	HW	2-WAY
152									222								3-
153									223								2-
154									224								2-
155									225								2-
156									226								2-
157									227								2-
158	205-1								228	165-1							2-
159									229								2-
160									230								2-
161									231								2-
162									232								2-
163									233			1.5					2-
164									234			1.0					3-
165									235	26N-1							2-
166	1ES-1								236								2-
167									237								2-
168									238								3-
169									239								2-
170									240								2-
171									241								2-
172									242	265-1							2-
173	2EN-1								243								2-
174									244								2-
175									245								2-
176	2ES-1		1.0						246								2-
177									247								2-
178			1.0						248								3-
179									249	11N-1							2-
180									250								2-
181									251								2-
182									252								2-
183	3EN-1								253								3-
184									254								2-
185	3ES-1								255								2-
186			1.5						256	145-1							2-
187									257								2-
188			1.0						258								2-
189									259								3-
190									260								2-
191									261								2-
192									262								2-
193	1FN-1								263	24N-1							2-
194									264								2-
195									265								2-
196									266								2-
197									267								3-
198									268								2-
199									269	245-1							2-
200	1FS-1								270								2-
201									271								2-
202									272								2-
203									273								2-
204									274								3-
205									275	11N-1							2-
206									276								2-
207	2FN-1								277								3-
208									278								2-
209									279								2-
210									280								2-
211									281								2-
212									282	145							2-
213									283								2-
214	2FS-1								284								3-
215									285								2-
216									286								2-
217									287								2-
218									288								2-
219																	2-
220																	3-

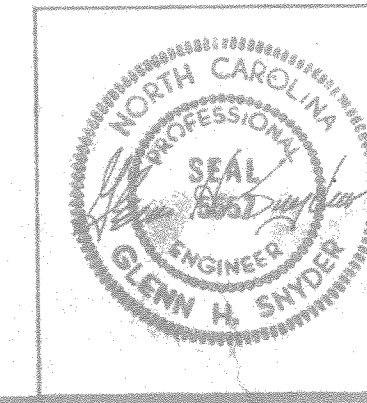

FEREBEE, WALTERS & ASSOCIATES ARCHITECTURE PLANNING CHARLOTTE NORTH CAROLINA		DEPARTMENT OF THE NAVY NAVAL STATION ATLANTIC DIVISION NORFOLK, VIRGINIA	
DES: A105 DR: 2105 CHK: JHS PROJ MGR: ASD ICH: ENGR: JHS SUBMITTED BY: Charles E. Snyder DATE: 1/17/86 FIRM MEMBER: [Signature] PRINCIPAL		MARINE CORPS BASE, CAMP LEJEUNE, NORTH CAROLINA CONVERT HOSPITAL TO DIVISION HEADQUARTERS MECHANICAL VALVE SCHEDULE	
APPROVED: [Signature] DATE: 2/17/86 OFFICER IN CHARGE	SIZE: F CODE IDENT. NO.: 80091	NAVAFAC DRAWING NO.: 4124317 CONSTR. CONTR. NO. N62470-82-B-2243 SHEET 162 of 223	
FOR EFG, P&S COMMANDER, NAVAFAC		SCALE: NO SCALE SPEC: 05-82-2243 (REV.)	

M-49








REVISIONS					
SYM	DESCRIPTION	PREP'D BY	DATE	APPROVED	
1	GENERAL REVISION	GHS	2/15/84	JHL	

ADDITIVE NO. 1 INCLUDES ALL HVAC WORK SHOWN ON THE PLANS ASSOCIATED WITH AIR CONDITIONING AND HEATING WINGS IAN AND IAS. IF ADDITIVE NO. 1 IS ACCEPTED ALL WORK SHOWN ON THIS SHEET SHALL BE DELETED. OTHERWISE, ALL WORK SHOWN HEREON SHALL BE REQUIRED TO ENABLE EXISTING SYSTEMS IN IAN & IAS TO OPERATE.


- SHEET M-2
- THE HPS AND PUMPED CONDENSATE LINES FROM WING "A" TO TUNNEL RACK NO. 61 SHALL REMAIN IN USE. THE EXISTING CONDENSATE PUMPS AT "A" WING AND THE FAN ROOM IN THE BASEMENT OF WING "D" SHALL REMAIN IN PLACE FOR FUTURE USE. REPAIR ALL TRAPS IN THE DRIP ASSEMBLIES SERVING THE HPS MAIN. REPLACE ALL CONDENSATE PIPING FROM THESE TRAPS AND RUN TO THE NEAREST CONDENSATE PUMP. THESE TRAPS OCCUR APPROXIMATELY AT TUNNEL RACKS 20 AND 33. CAP ALL RUNOUTS FROM THE HPS MAIN BETWEEN "A" WING AND RACK NO. 61, EXCEPT TO THE PRV LOCATED AT RACK NO. 3 WHICH SHALL REMAIN IN SERVICE.
  - ALL STEAM AND CONDENSATE LINES SERVING "A" WING SHALL REMAIN IN SERVICE. NO DEMOLITION WORK IS REQUIRED IN IAN AND IAS.
  - THE STEAM RADIATORS AND ASSOCIATED PIPING SERVING THE CORRIDOR BETWEEN "A" WING AND "B" WING SHALL BE DEMOLISHED. CAP LINES ADJACENT TO WHERE THEY CONNECT TO EXISTING ACTIVE STEAM AND CONDENSATE LINES.
  - REPLACE ALL EXPANSION JOINTS IN THE HPS MAIN AND THE PUMPED CONDENSATE RETURN AS FOLLOWS:

LOCATION RACK NO.	HPS		PC	
	SIZE	TRAVERSE	SIZE	TRAVERSE
32	4"	4"	2"	4"
33	5"	8"	2 1/2"	4"

NOTE -  
LOCATE P-CP-5 @ TUNNEL RACK 21 AND  
P-CP-6 @ TUNNEL RACK 32

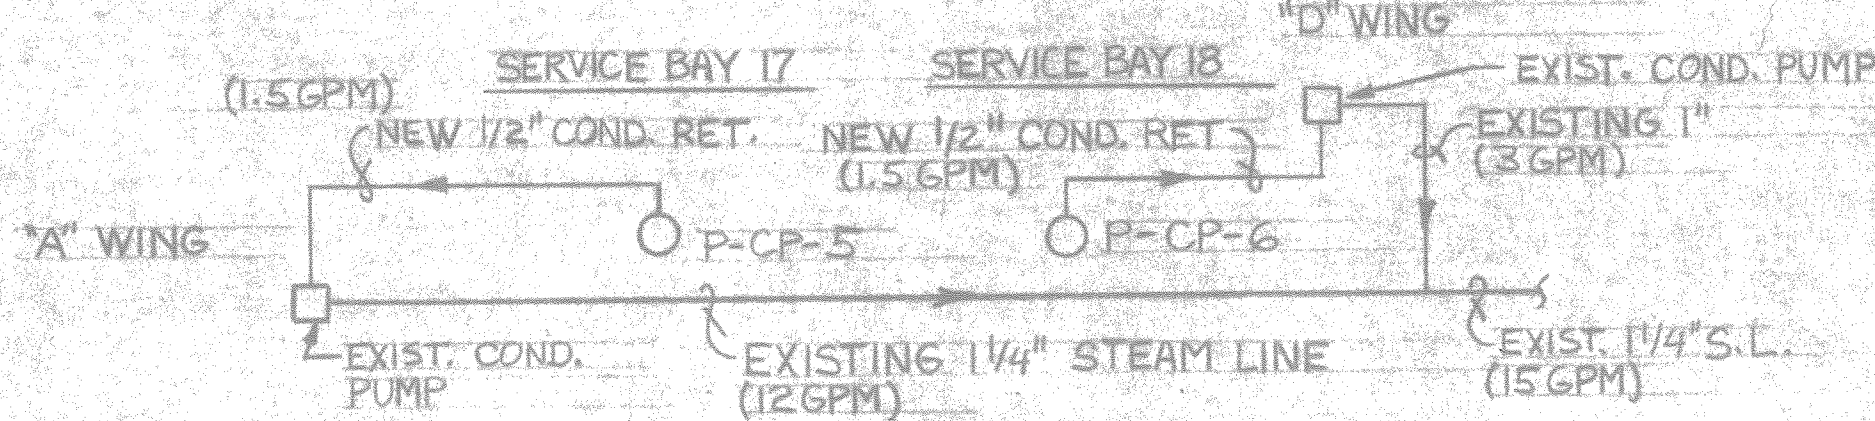

D EXISTING H. P. CONDENSATE RETURN  
NO SCALE

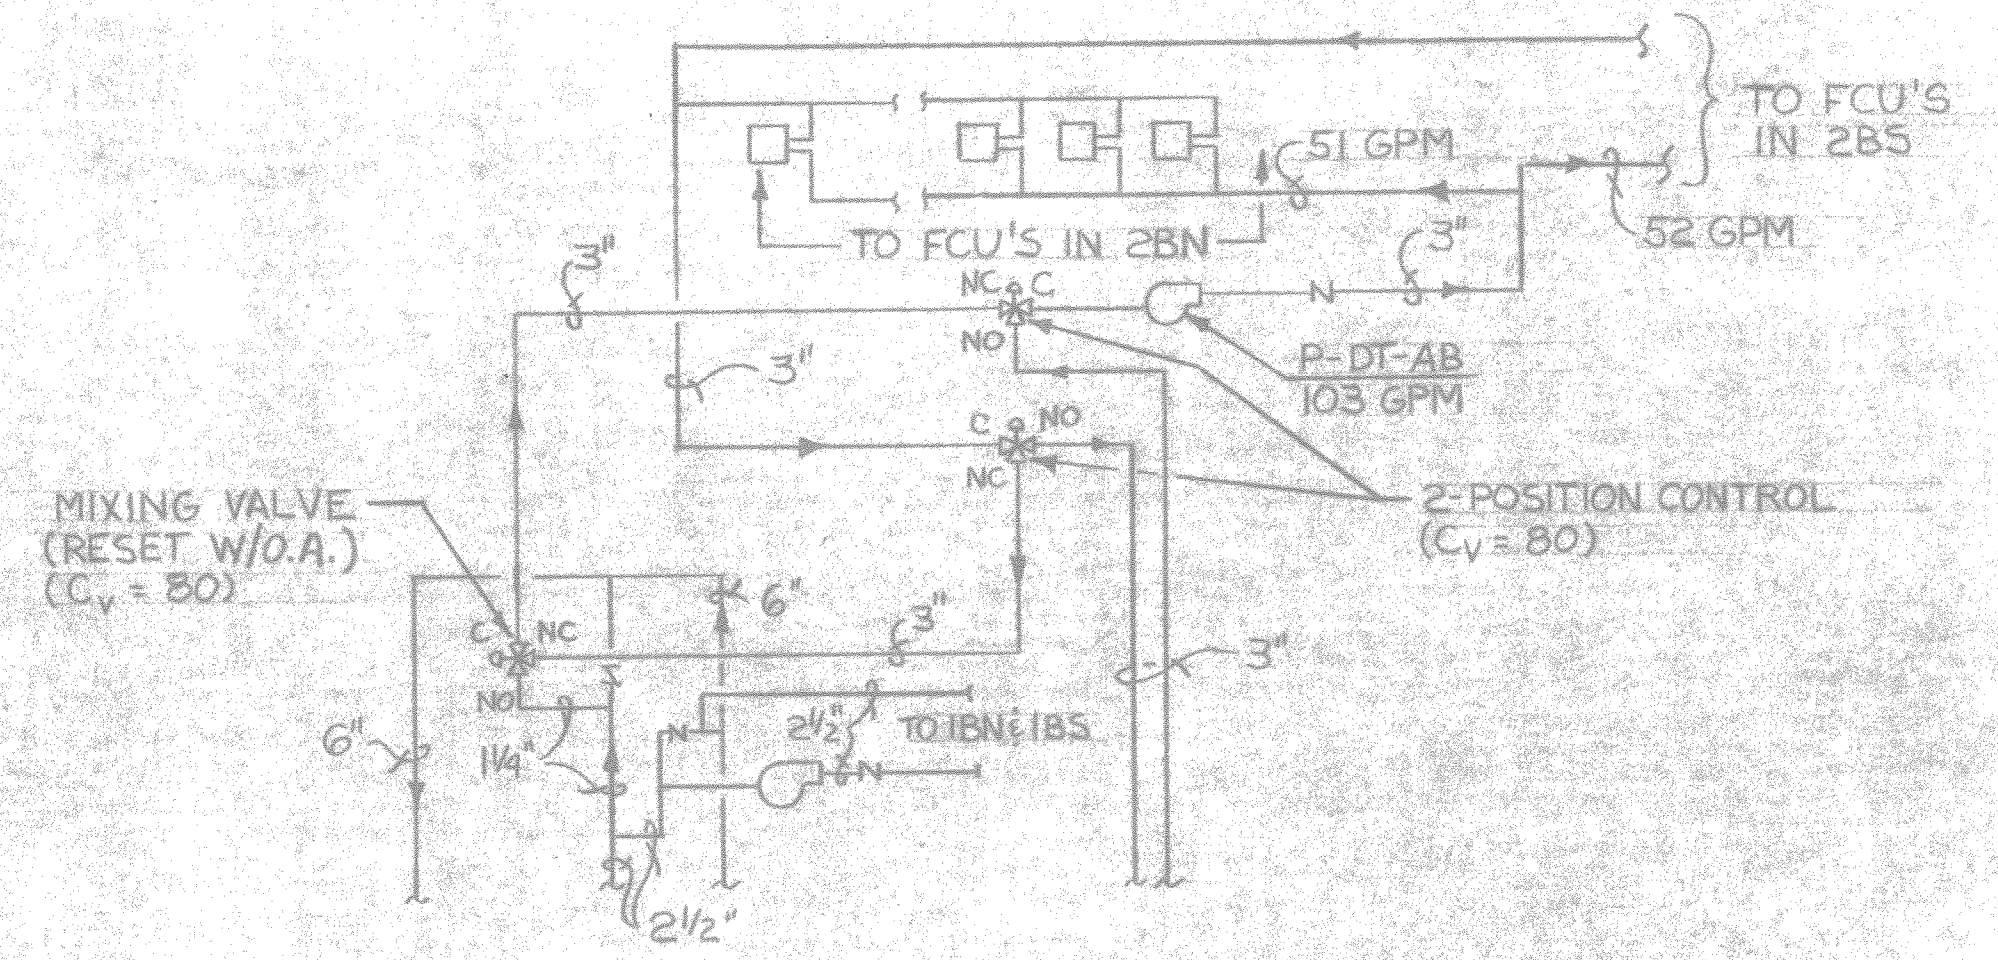

A DETAIL #1 "P-DT-AB" PIPING CHANGES  
NO SCALE

SHEET M-3  
THERE SHALL BE NO DEMOLITION WORK DONE TO WINGS IAN & IAS. DO REMOVE THE STEAM RADIATORS AND ASSOCIATED PIPING IN THE CORRIDOR BETWEEN "A" AND "B" WINGS.

SHEET M-9  
THE PIPING TO PUMP "P-DT-AB" CHANGES AS SHOWN IN DETAIL #1 AT THE RIGHT. THE WATER QUANTITY OF PUMP "P-C-AB" BECOMES 89 GPM AND FLOWS TO ONLY 2BN AND 2BS.

SHEET M-10  
THE TUNNEL PIPING TO WING "A" CHANGES AS SHOWN IN DETAIL #2 AT THE RIGHT.

SHEET M-11  
IN LIEU OF THE HW PIPING SHOWN IN THE CORRIDOR BETWEEN "A" WING AND "B" WING CHANGE IT AS SHOWN IN DETAIL #3 AT THE RIGHT.

SHEET M-38  
DELETE AIR HANDLING UNIT "AHU-IAS" AND FAN COIL UNIT TYPES "FCU-1, FCU-2, FCU-3, FCU-4, FCU-5, FCU-6, FCU-7, FCU-8, FCU-9, AND FCU-10" FROM THEIR RESPECTIVE SCHEDULES.

SHEET M-39  
DELETE TERMINAL UNITS "IAS-1 THROUGH IAS-4" FROM SCHEDULE.

SHEET M-40  
1. DELETE EXHAUST FANS "EF-1, EF-2, EF-3, AND EF-4" FROM SCHEDULE.  
2. DELETE WINTER VENTILATION FAN "WVF-IAS" FROM SCHEDULE.  
3. REVISE PUMP SCHEDULE ENTRIES AS FOLLOWS:


TAG NO.	SERVICE	TYPE	GPM (EA.)	HEAD	HP	RPM	NOTES
P-C-AB	CHW	INLINE	89	50 FT.	3-460	1750	7
P-DT-AB	DUAL-T	"	103	75 FT.	5-460	"	7
P-H-AB	H.W. SEC.	"	60	55 FT.	3-460	"	7
P-CP-5	STEAM COND.	CENTRIFUGAL	1.5	10 PSI	1/3-120	"	7,8
P-CP-6	"	"	1.5	10 PSI	1/3-120	"	7,8

SHEET M-41 - DELETE MECH. ROOM IAS.


SHEET M-48  
DELETE VALVES "V-1, V-33, V-58, V-59, V-60, V-61, V-62, V-63, V-64, V-65, V-66, AND V-67" FROM SCHEDULE.

SHEET M-45  
LINE SIZES SHOWN IN THE PIPE RACK SCHEDULE FOR RACK NOS. I-II SHALL BE REVISED AS FOLLOWS:

RACK NO. WING A	PIPE NUMBER					
	1	2	3	4	5	6
1	DTS	HWR	HWS	DTS	CHWR	CHWS
4		1/2	1/2			
5			1/2			
6			1			
7						
10		1/2				
11		1	1			

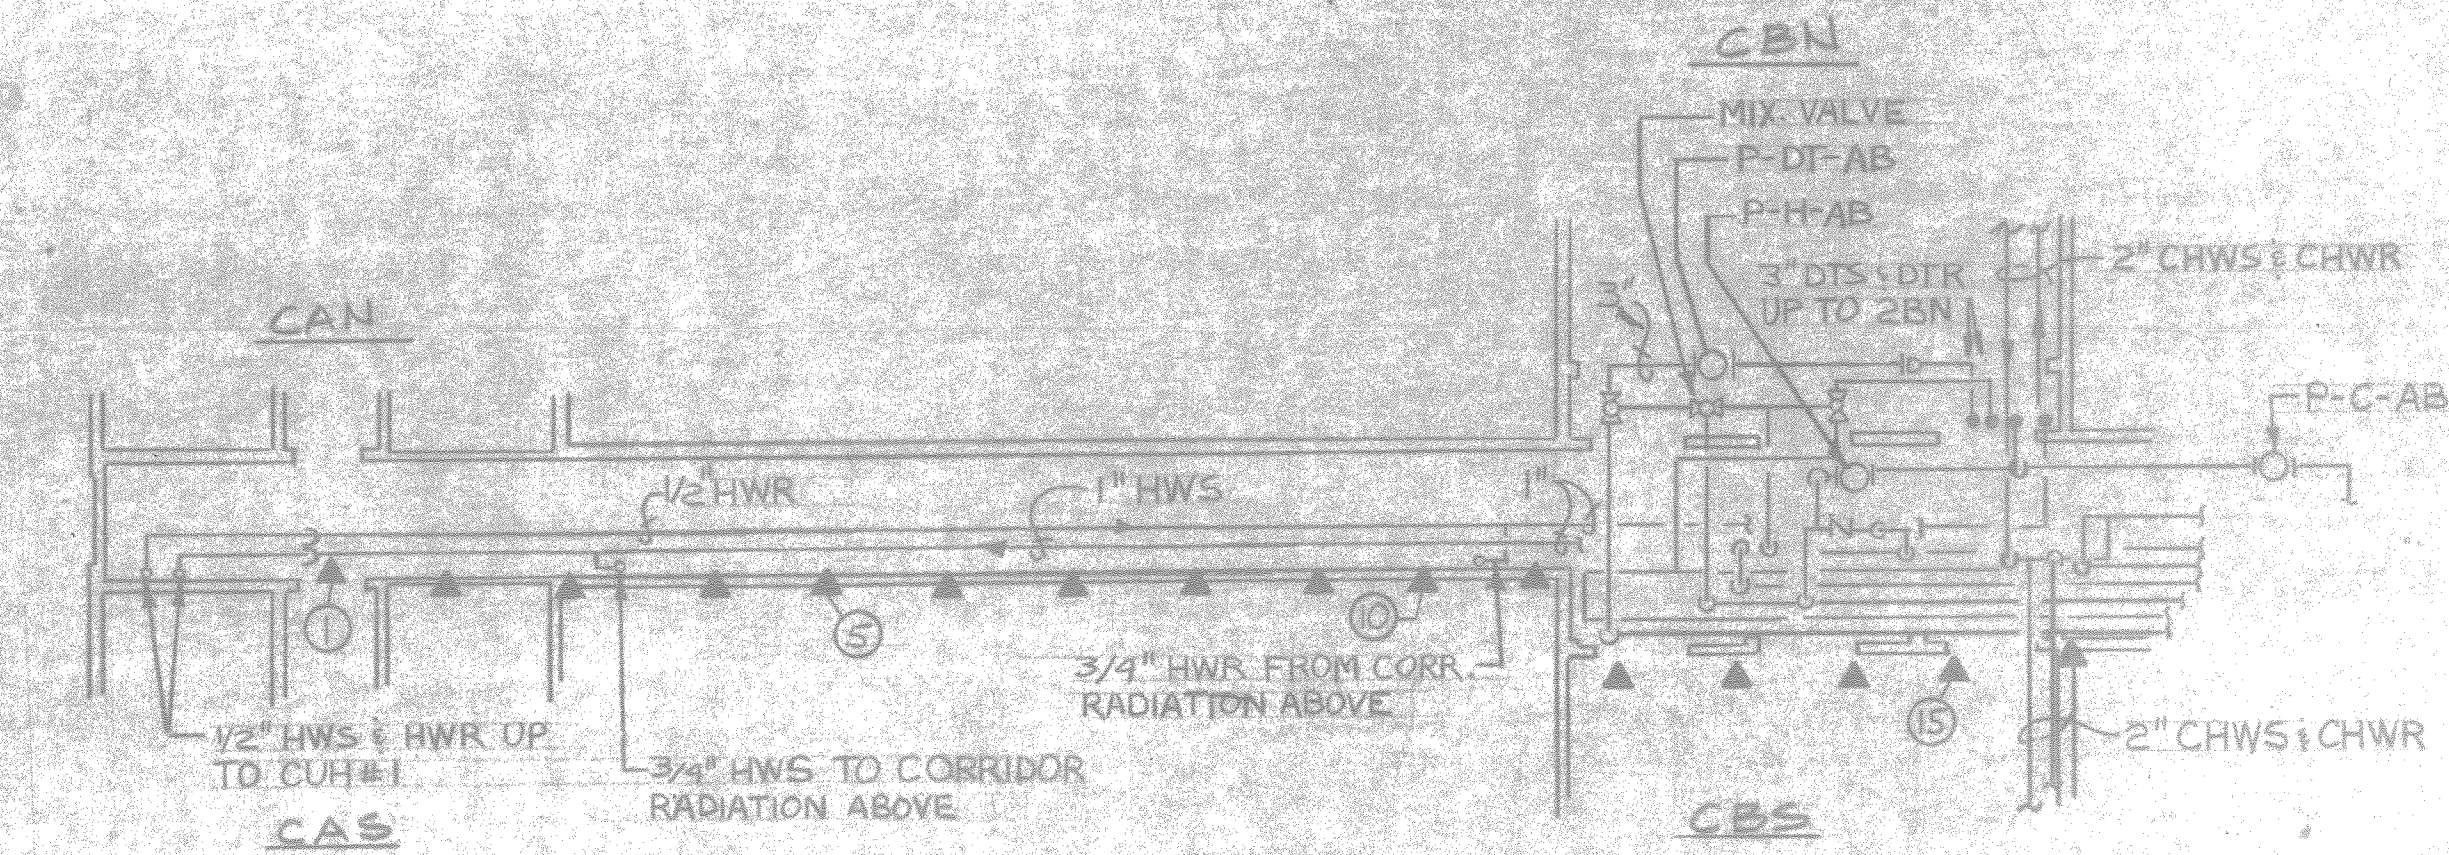


B DETAIL #2 TUNNEL PIPING CHANGES  
NO SCALE

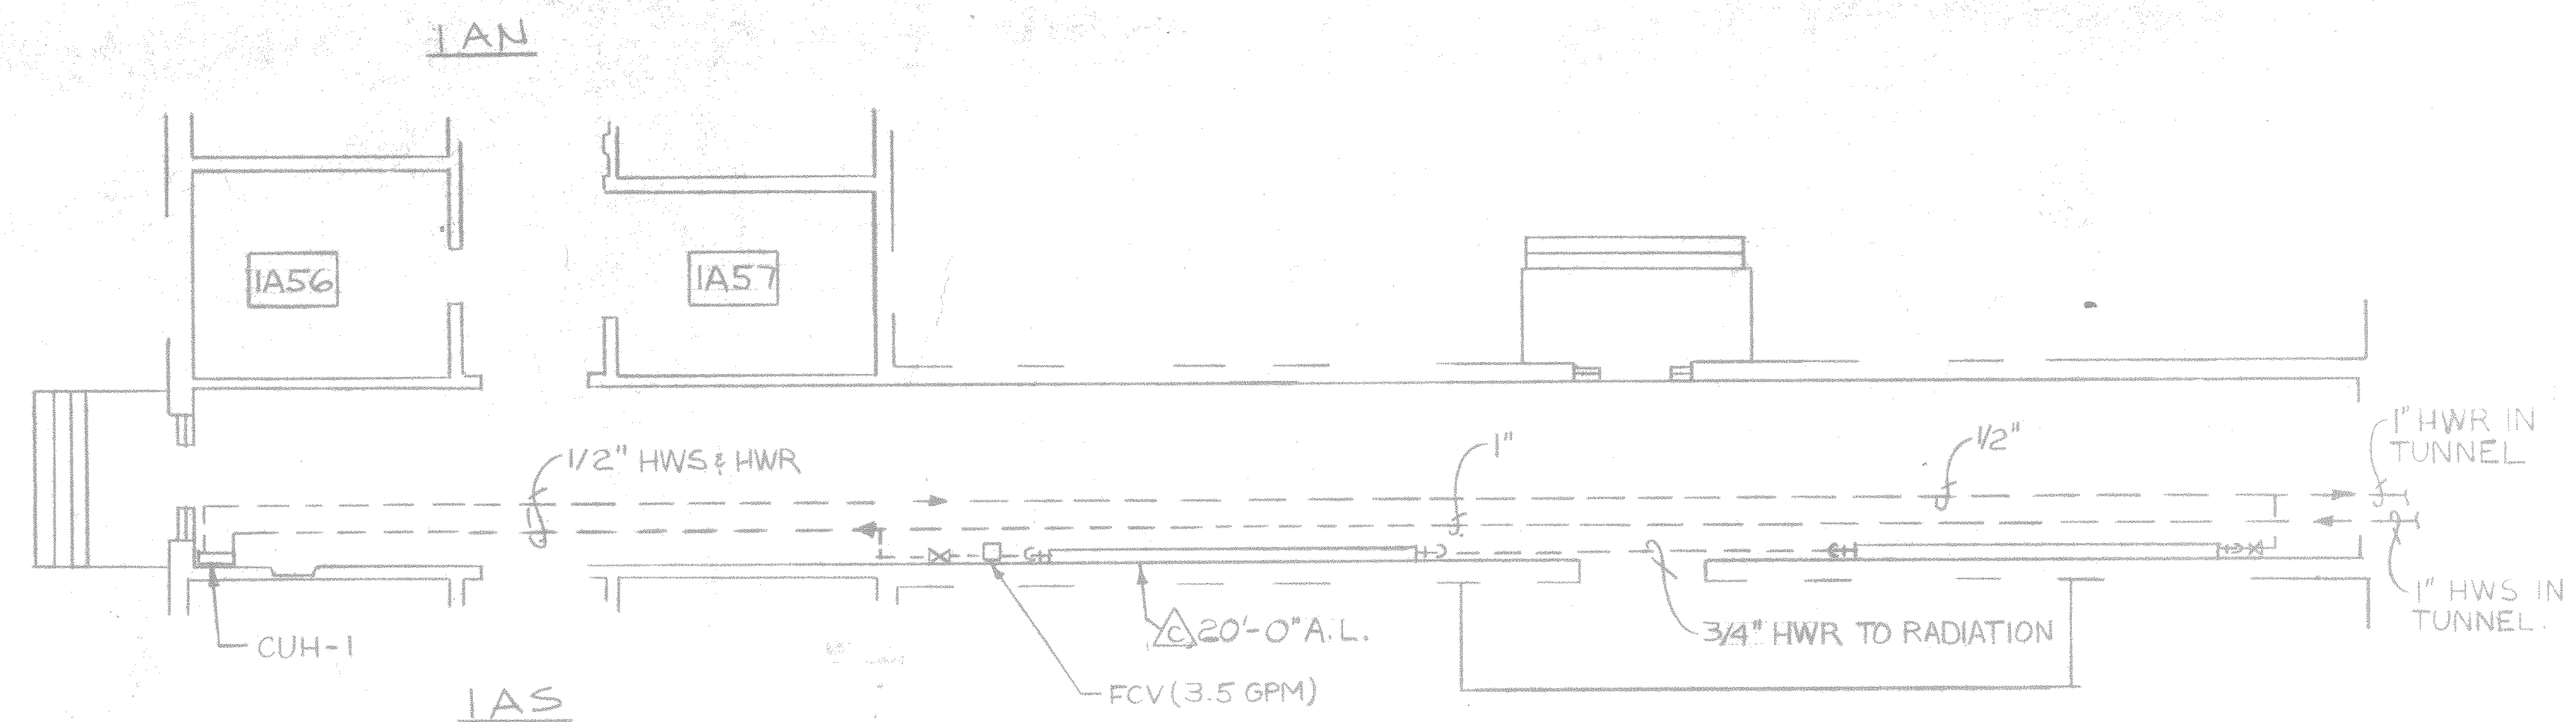

C DETAIL #3 CORRIDOR PIPING CHANGES  
NO SCALE

NOTE: ALL WORK SHOWN ON THIS SHEET SHALL BE DELETED IF ADDITIVE #1 IS ACCEPTED.

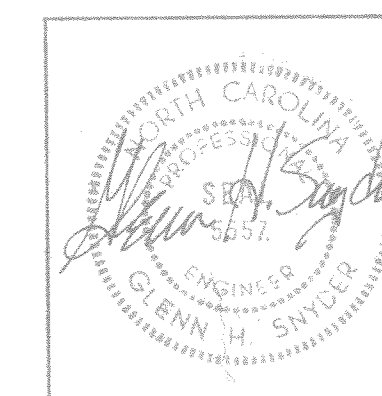

FEREBEE, WALTERS & ASSOCIATES ARCHITECTURE PLANNING LANDSCAPE DESIGN INTERIOR DESIGN CHARLOTTE NORTH CAROLINA		DEPARTMENT OF THE NAVY NAVAL FACILITIES ENGINEERING COMMAND	M-50
DIS: GHS DR: MDE CHK: GHS PROJ. MGR. / OCC. / CH. ENGR. / LIAISON SUBMITTED BY: [Signature] ITEM MEMBER: [Signature] PRINCIPAL		NAVAL STATION ATLANTIC DIVISION MARINE CORPS BASE, CAMP LEJEUNE, NORTH CAROLINA	
APPROVED: [Signature] DATE: 17 July 85		NAVFAC DRAWING NO. 4124318	
OFFICER IN CHARGE: [Signature] DATE: 17 July 85		CONSTR. CONTR. NO. N62470-82-B-22A	
FOR EFD FOR COMMANDER, NAVFAC		SCALE: 1/8" = 1'-0" SPEC. 05-82-22AS (REV.) SHEET 163 OF 242	











