




REV	CO. NO.	DATE	DESCRIPTION	CHK	APR
A	3723	8-8-75	RELEASED		
B	WJG	2-10-76	CUST'S. CHANGES		
C	WJG	9-13-76	AS BUILT		
D	WJG	8-8-77	COST CHANGES		

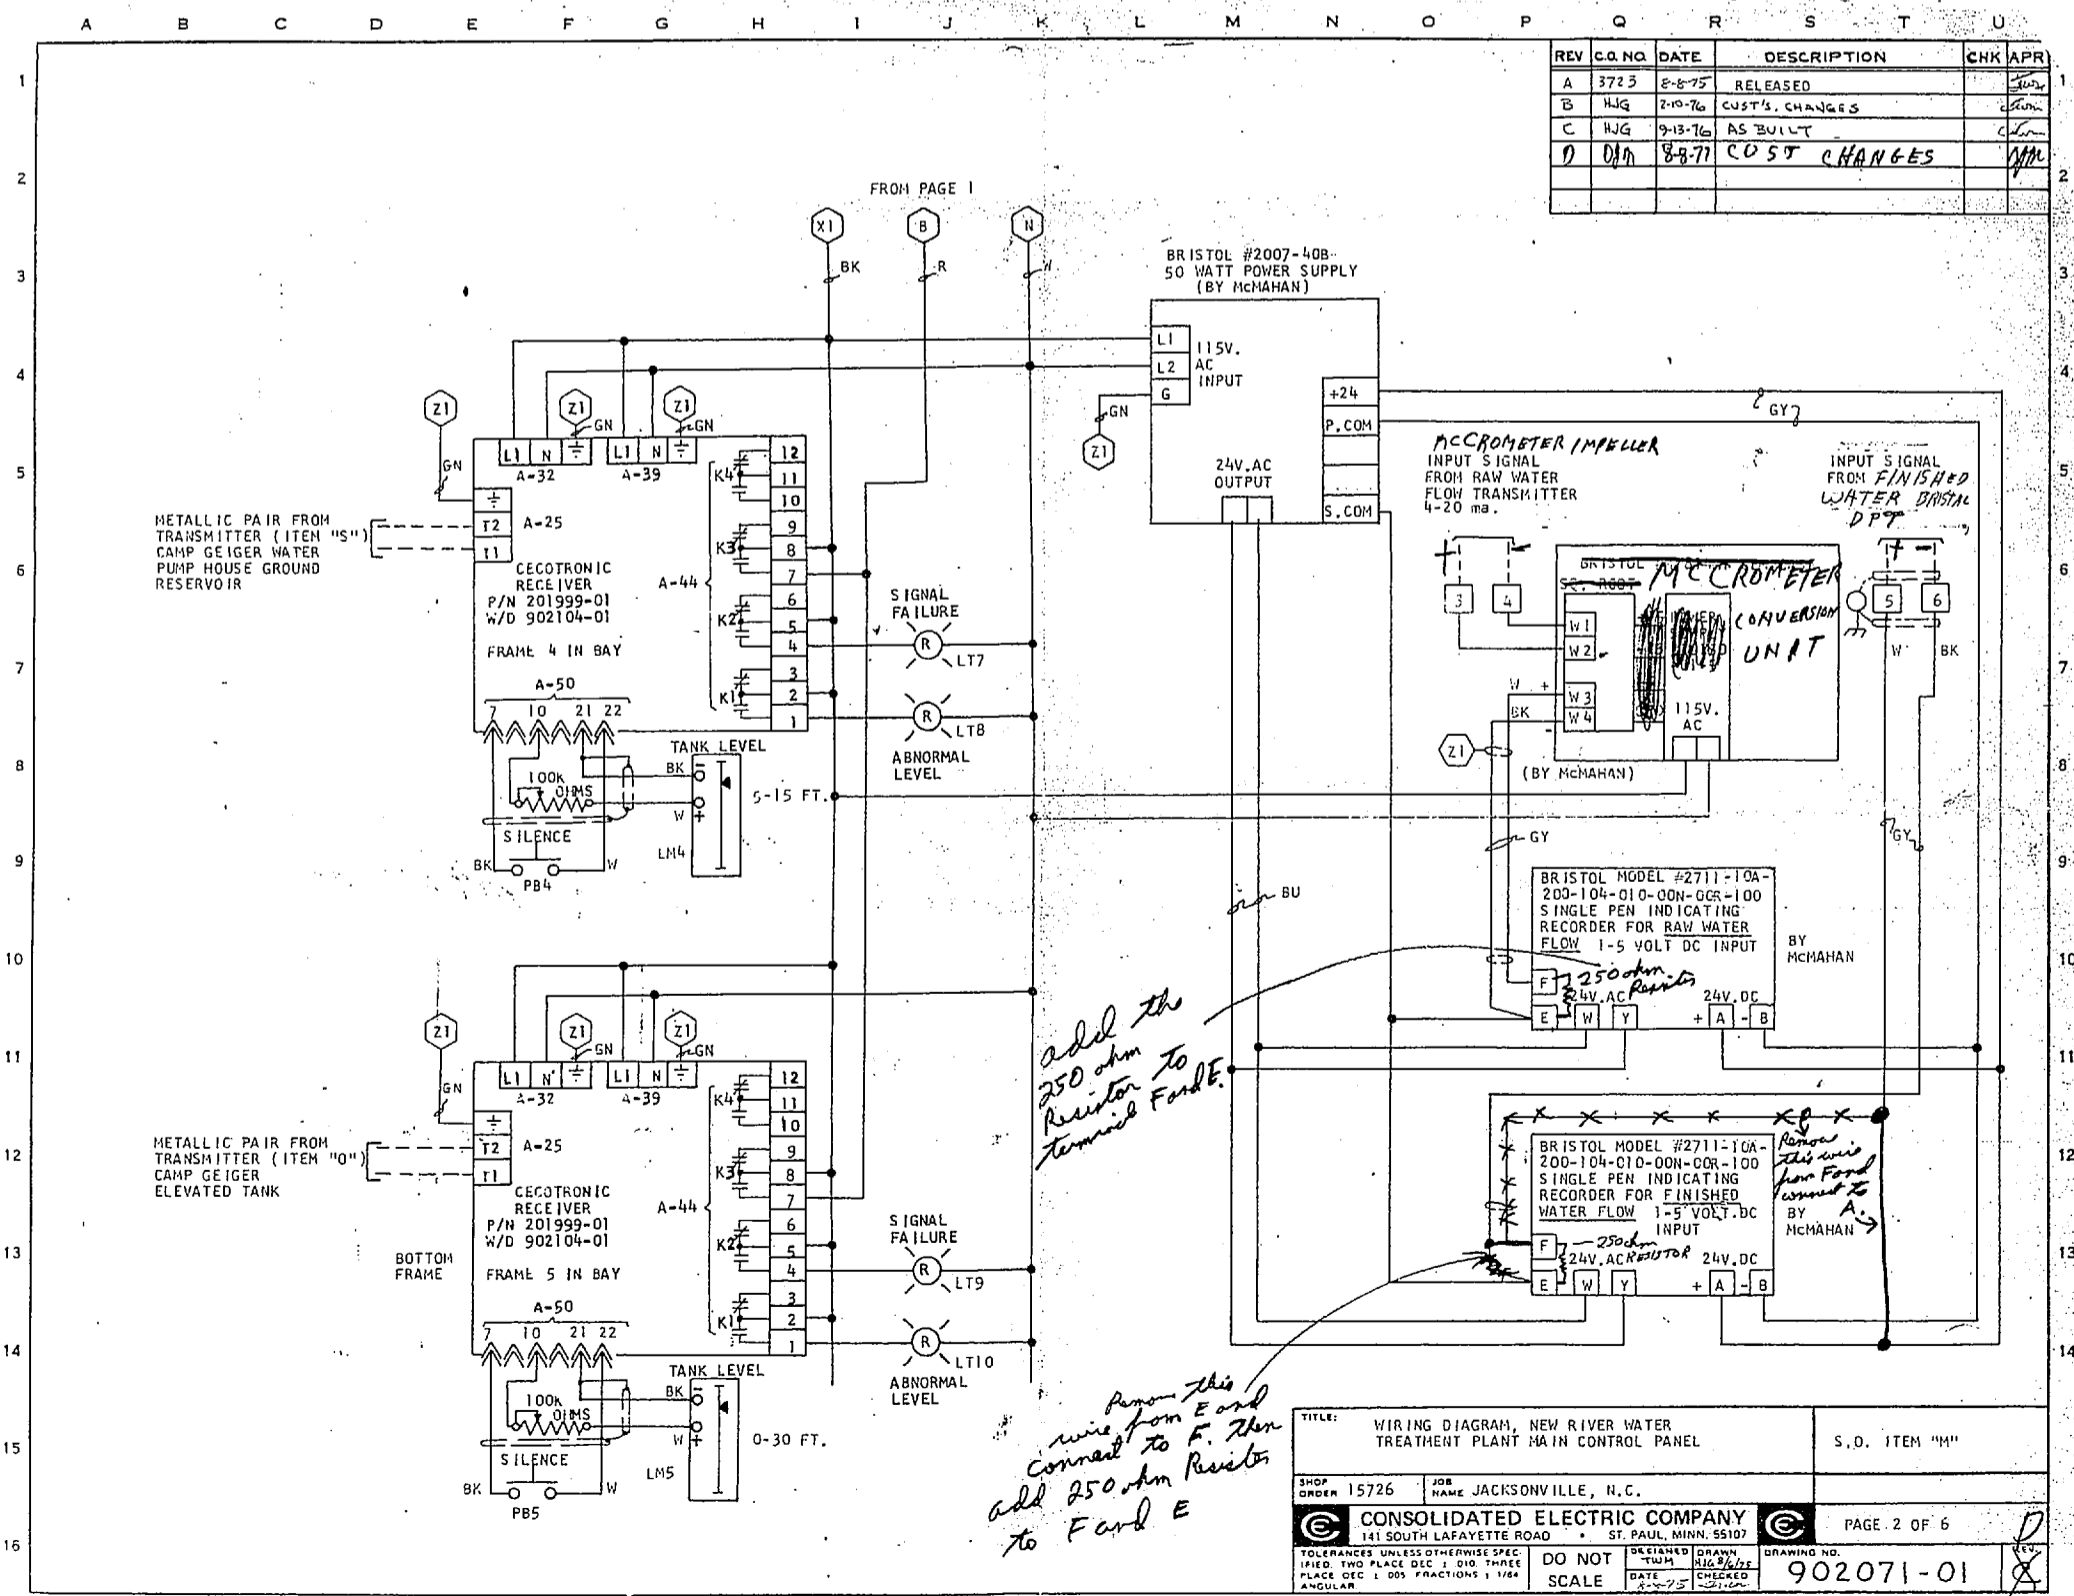

TITLE: WIRING DIAGRAM, NEW RIVER WATER TREATMENT PLANT MAIN CONTROL PANEL S.D. ITEM "M"

SHOP ORDER 15726 JOB NAME JACKSONVILLE, N.C.

CONSOLIDATED ELECTRIC COMPANY
141 SOUTH LAFAYETTE ROAD • ST. PAUL, MINN. 55107

PREPARED DRAWING DATE 8-8-75 CHECKED DATE 8-8-75

TOLERANCES UNLESS OTHERWISE SPECIFIED: 1/16" PLACE DEC. 1/100 FRACTIONS 1/16" ANGULAR


DO NOT SCALE

DRAWING NO. 902071-01

PAGE 2 OF 6



REV	C.O. NO.	DATE	DESCRIPTION	CHK	APR
A	3723	8-8-75	RELEASED		
B	436	2-10-76	CUSTOMER CHANGES		

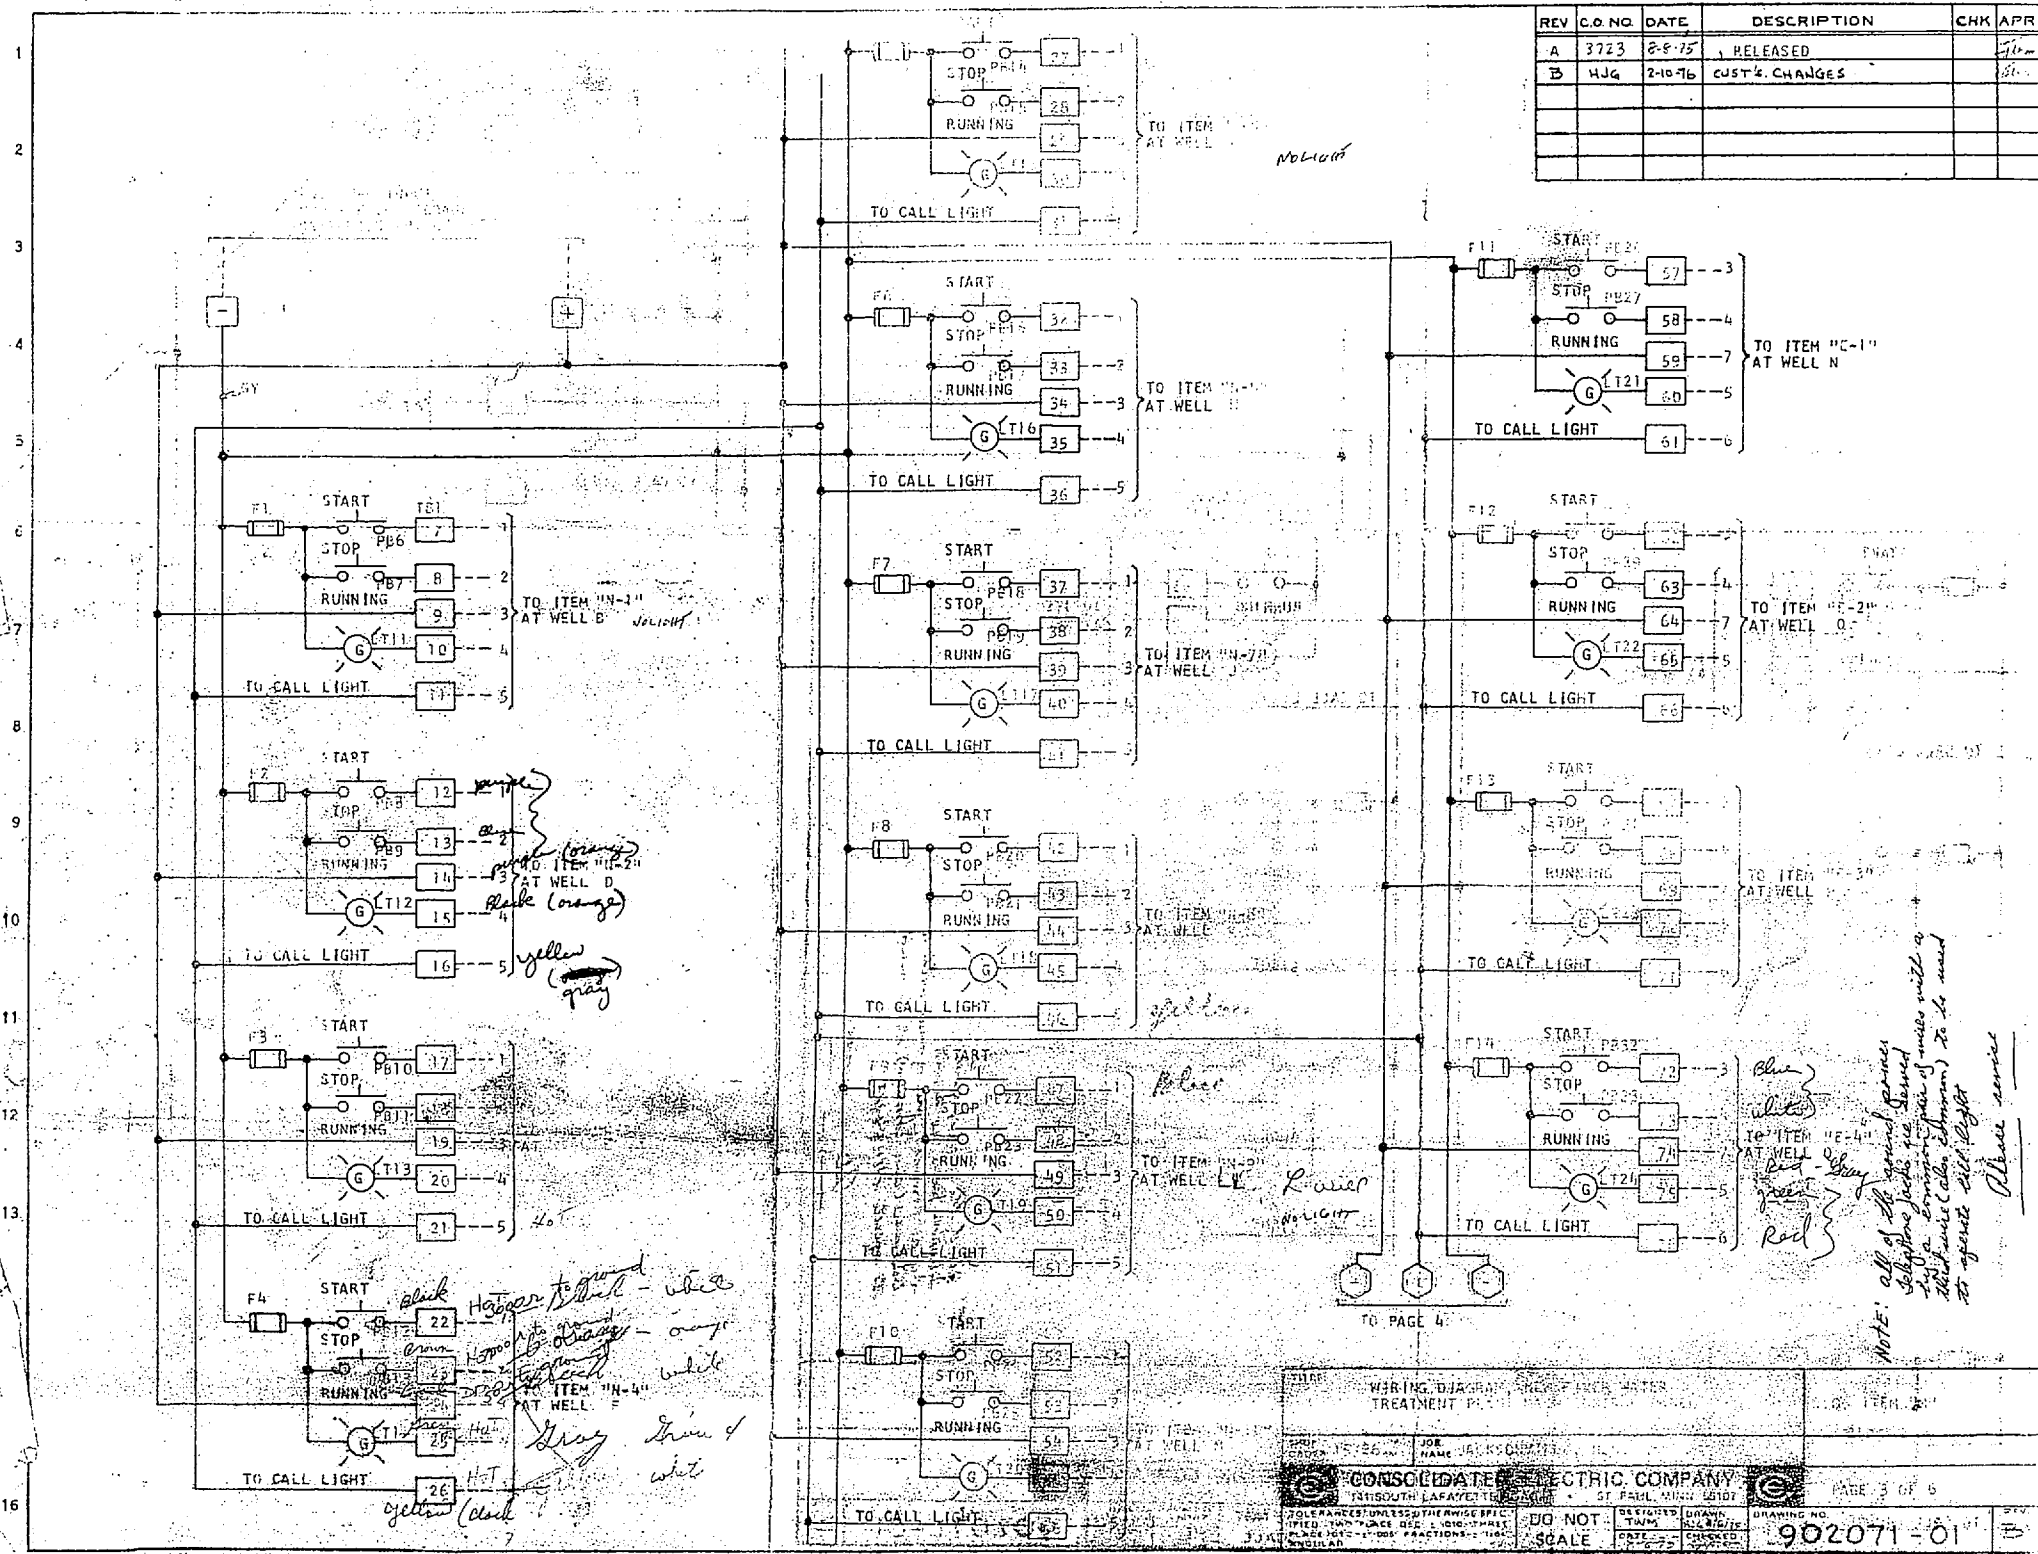

WIRING DIAGRAM OF WATER TREATMENT PLANT

 
CONSOLIDATED ELECTRIC COMPANY
 215 SOUTH LARAMIE STREET, ST. PAUL, MINN. 55107


DATE: 3 OF 8

DRAWING NO. 902071-01

SCALE: AS SHOWN

DO NOT SCALE



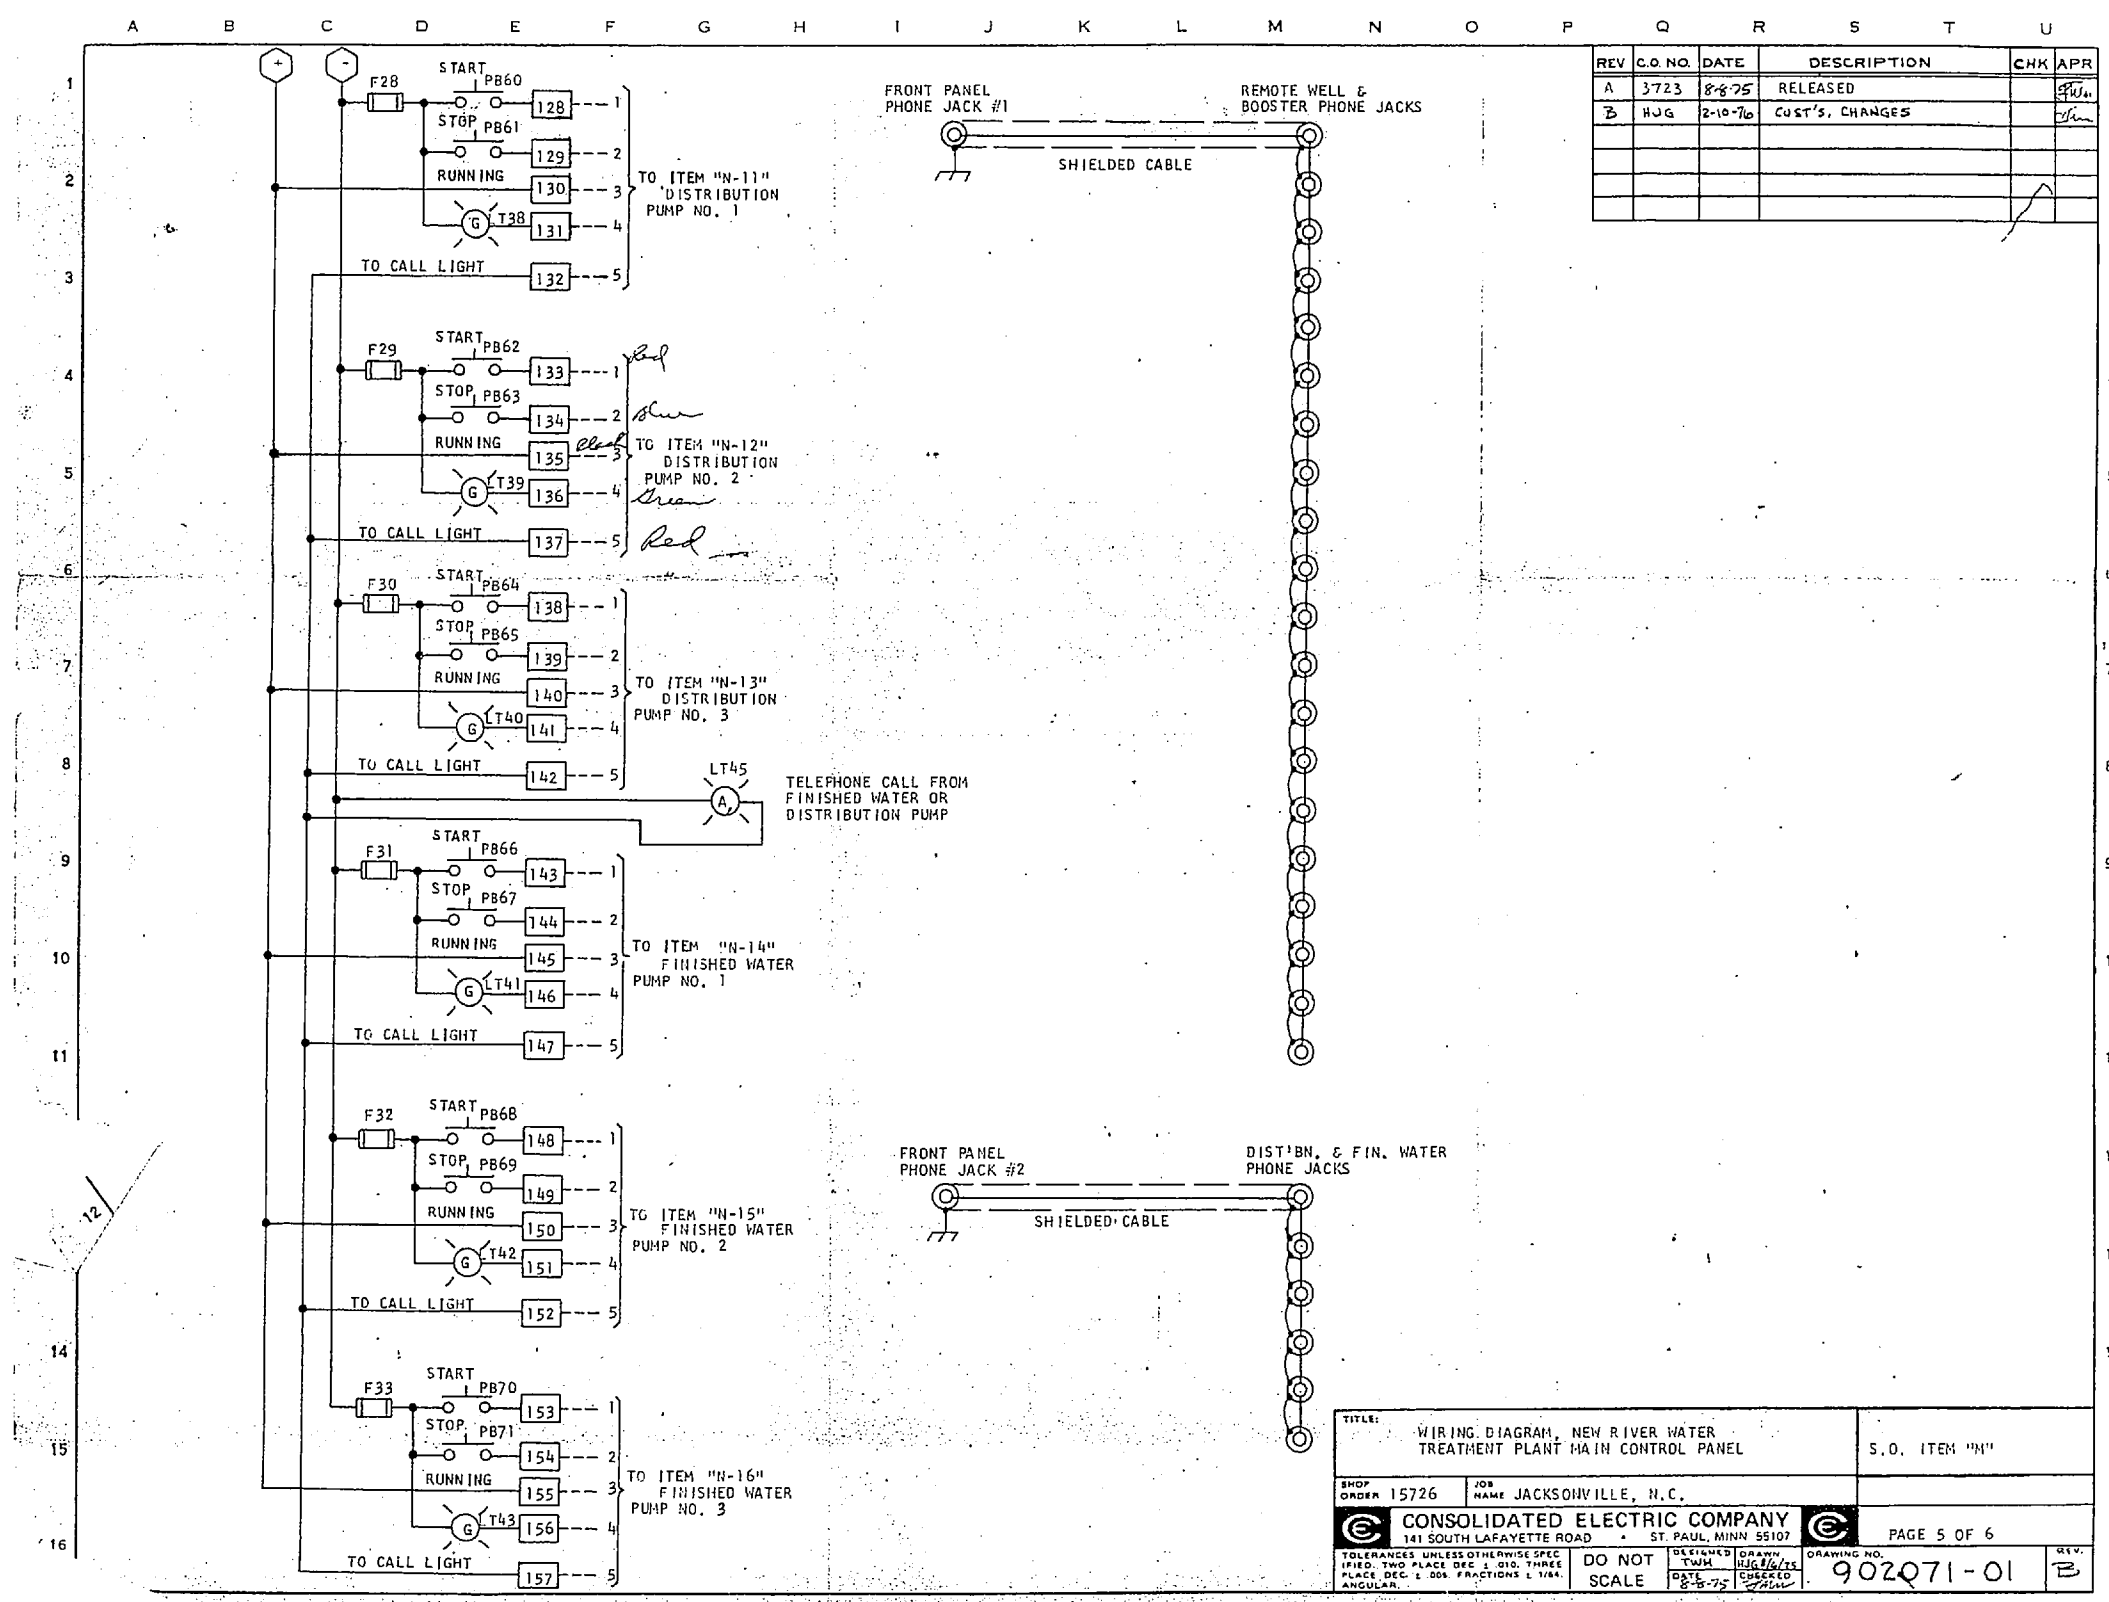

REV	C.O. NO.	DATE	DESCRIPTION	CHK	APR
A	3723	8-6-75	RELEASED		
B	HJG	2-10-76	CUST'S. CHANGES		

TITLE: WIRING DIAGRAM, NEW RIVER WATER TREATMENT PLANT MAIN CONTROL PANEL S.O. ITEM "M"

SHOP ORDER: 15726 JOB NAME: JACKSONVILLE, N.C.

 
CONSOLIDATED ELECTRIC COMPANY
141 SOUTH LAFAYETTE ROAD ST. PAUL, MINN. 55107

TOLERANCES UNLESS OTHERWISE SPECIFIED: TWO PLACE DEC. & ONE THIRDS PLACE DEC. & ONE FRACTIONS & VAR. ANGULAR.


DO NOT SCALE

DRAWING NO. 902071-01

PAGE 5 OF 6



REV	C.O. NO.	DATE	DESCRIPTION	CHK	APR
A	3723	8-8-75	RELEASED		
B	HJK	2-10-76	CUST'S. CHANGES		

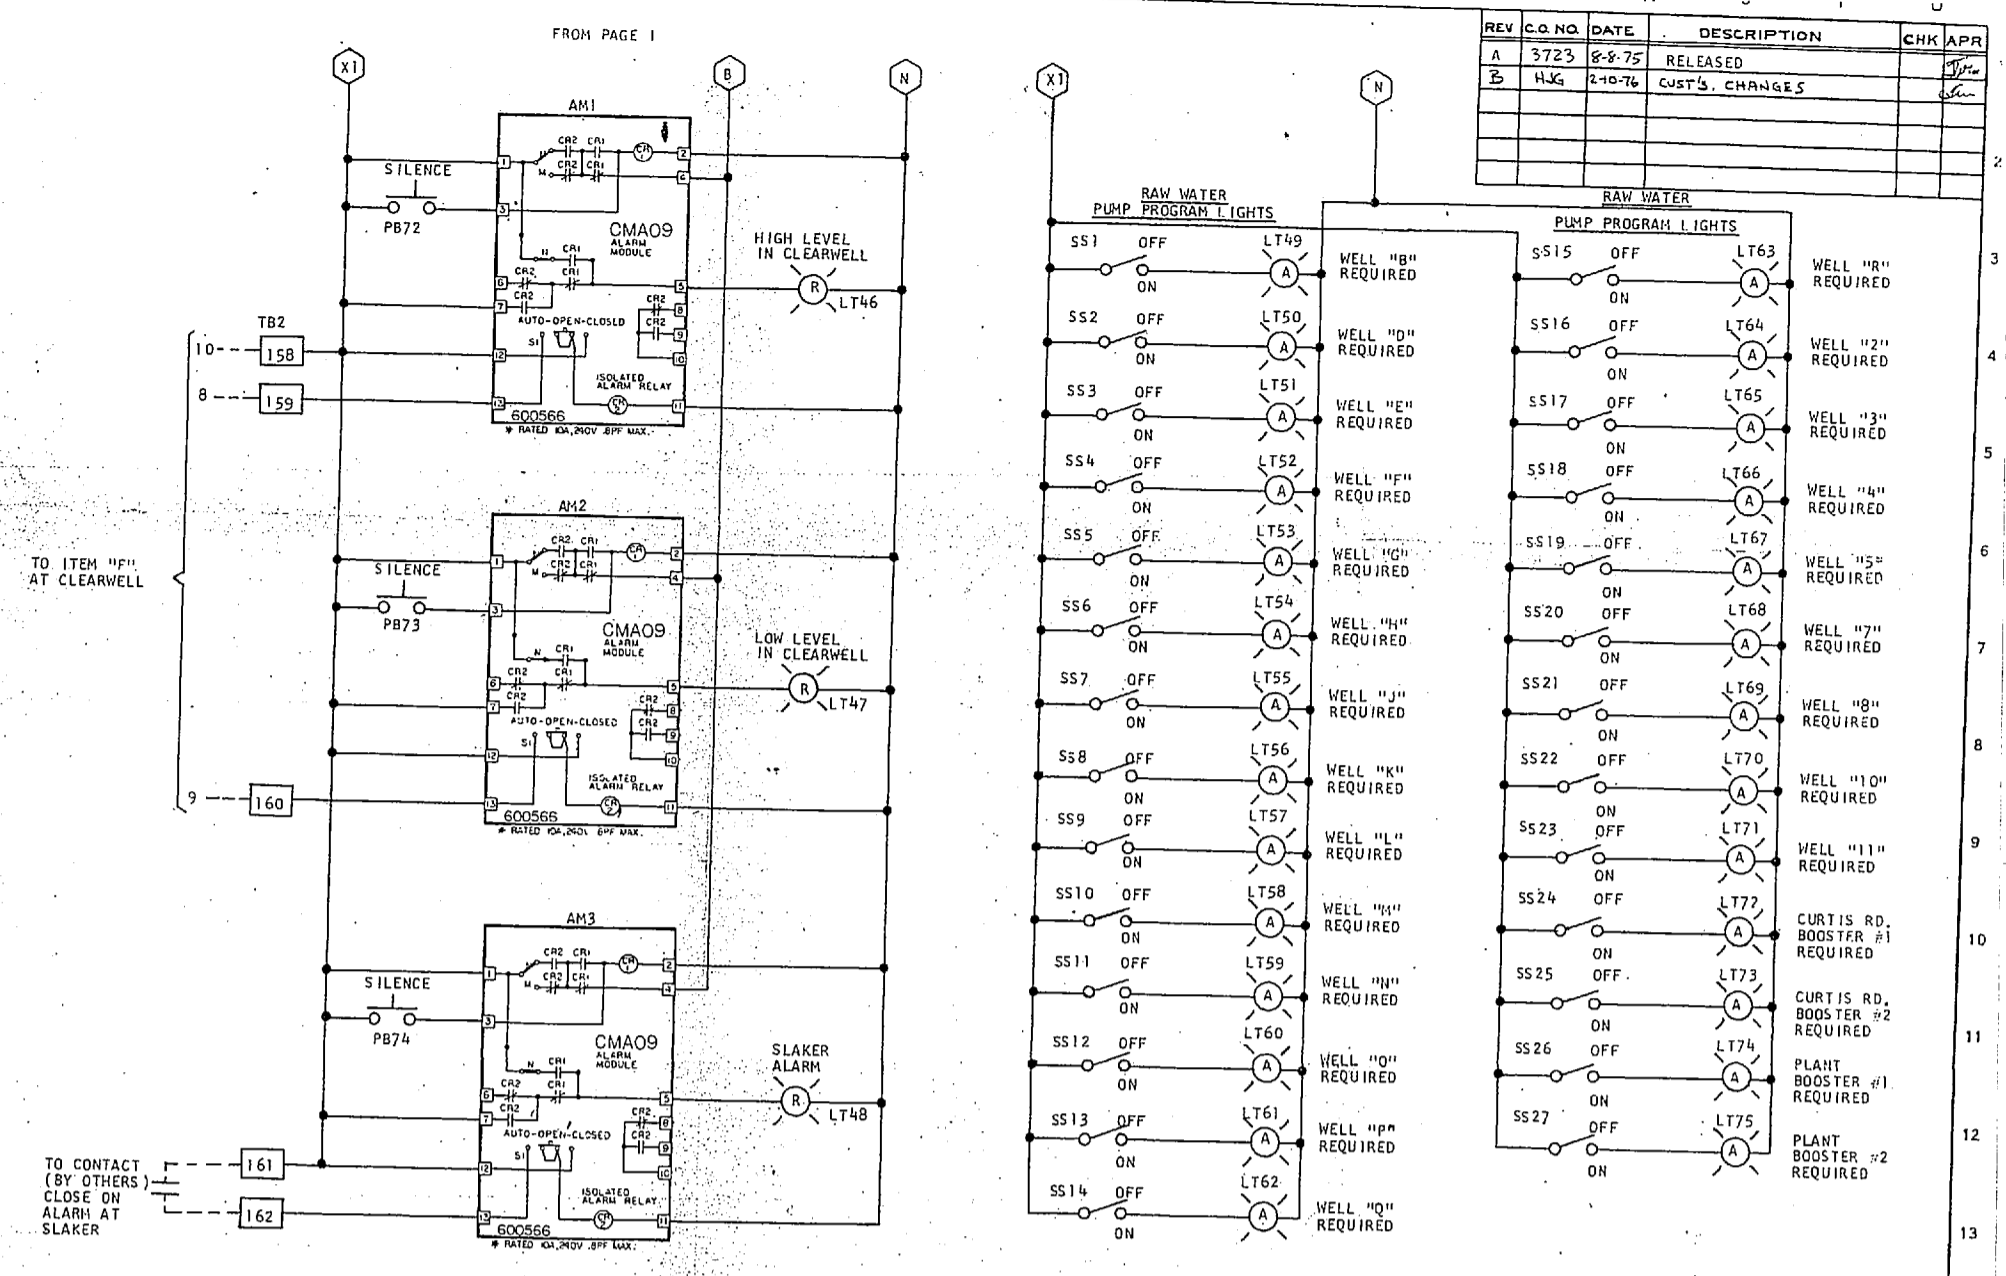

TITLE: WIRING DIAGRAM, NEW RIVER WATER TREATMENT PLANT MAIN CONTROL PANEL		S.O. ITEM #41
SHOP ORDER 15726	JOB NAME JACKSONVILLE, N.C.	
CONSOLIDATED ELECTRIC COMPANY 141 SOUTH LAFAYETTE ROAD • ST. PAUL, MISS. 38105		PAGE 6 OF 6
TOLERANCES UNLESS OTHERWISE SPECIFIED: TWO PLACE DEC. 1/100 THREE PLACE DEC. 1/1000 FRACTIONS 1/16" ANGULAR.	DO NOT SCALE	DRAWING NO. 902071-01

