

VALUABLE

RETURN TO
PUBLIC WORKS
OFFICE
CAMP LEJEUNE
NORTH CAROLINA

SUBJECT

X-sects. on
Colorado Ave. Beginning
AT Stone St.

FIELD PARTY

IN CHARGE _____
INSTRUMENT _____
NOTES _____
TAPE READ _____
TAPE OR ROD _____
TAPE OR ROD _____
STRUMENT NO. _____
TAPE NO. _____

WEATHER

CLEAR _____ SNOW _____
CLOUDY _____ HOT _____
WINDY _____ MODERATE _____
RAIN _____ COLD _____
FAIR _____ FOG _____
FIGURED BY _____
NOTES CHECKED BY _____
PLOTTED BY _____

FILE No. 120 P

FLDR. No. _____

SHEET 1 of _____

DATE 1-31-1961

Quad. No. _____

STATION	DIST.	ANGLE ° ' "	+	H. I. BEARING	VER: ANG. DIFF.	ELEVATION
B.M.				A 16 35.54		35.78
T.B.M.				4.67 37.45	2 56 32.70	32.94
0+00				(37.3)	(37.6)	
0+62						
0+74						
0+82						26.66
1+0						26.0
2+0						26.6
2+94						27.96
3+0						26.12
3+10						
3+24						28.00

ON STOOP of well house # 614
Power pole # C-57

20	0	12	20
6.1	7.2	6.7	5.8
31.5	30.4	30.9	31.8
BANK			BANK
20	15	8	0
6.1	8.8	10.4	10.7
31.5	28.8	27.8	27.6
			10.0
			5.9
			31.6

20	15	0	20
6.6	10.9	11.5	10.6
31.6	26.8	26.1	26.9
			6.2
			31.7
0	100	200	
11.6	10.9	10.7	10.9
25.9	26.6	26.8	26.6
26.0	26.7	26.9	26.7

Sections plotted on Print Copied
 by McIlwain & Dillon 2/8/61
 (Print Retained)

VALUABLE

RETURN TO
PUBLIC WORKS
OFFICE
CAMP LEJEUNE
NORTH CAROLINA

SUBJECT X-sections on
Colorado Ave. contd.

Bring H. I. from Sheet #1

FIELD PARTY

IN CHARGE _____
INSTRUMENT _____
NOTES _____
TAPE READ _____
TAPE OR ROD _____
TAPE OR ROD _____
INSTRUMENT NO. _____
TAPE NO. _____

WEATHER

CLEAR _____ SNOW _____
CLOUDY _____ HOT _____
WINDY _____ MODERATE _____
RAIN _____ COLD _____
FAIR _____ FOG _____
FIGURED BY _____
NOTES CHECKED BY _____
PLOTTED BY _____

FILE No. _____
FLDR. No. _____
SHEET 2 of _____
DATE 1-31 1961

Quad. No. _____

STATION	DIST.	ANGLE ° ' "	+	H. I. BEARING	VER. ANG. DIFF.	ELEVATION
4+00				37.45 <u>37.5</u>	<u>37.6</u>	
5+0					11.1	26.5 26.4
5+19				top of water	11.0	26.6 26.5
6+0						
6+15		44' Lft.			9.60	28.01 27.87
6+49		44' Lft.			9.60	28.01 27.87
7+0					11.3	26.3 26.6
7+18				begin water pocket	11.5	26.1 26.0 <small>TOP of water</small>
8+0						
T.P.				79 68 10.16	9.98	63 27.77
8+56				37.63 <u>37.7</u>	<u>37.8</u>	26.2 26.1
9+0				top of water	11.6	26.2 26.1
					10.9	26.9 26.8

BANK						BANK
22	18	12	0	17	21	
6.6	9.9	11.0	11.0	9.8	6.6	
30.9	27.6	26.5	26.5	27.7	30.9	
31.0	27.7	26.6	26.6	27.8	31.0	

END of water

BANK						BANK
24	20	0	20	25		
6.4	10.8	10.4	9.2	7.3		
31.1	26.7	27.1	28.3	30.2		
31.2	29.8	27.2	28.4	30.3		

TOP of DROP INLET

BANK						BANK
22	18	15	0	18	23	
7.0	10.0	11.4	11.7	10.4	5.7	
30.5	27.5	26.1	25.8	27.1	31.8	
30.6	27.6	26.2	25.9	27.2	31.9	

END of water pocket

RECEIVED
POSTAL SERVICE
WASHINGTON, D.C.

SUBJECT

DATE

TIME

PLACE AND
ELEVATION

BEARING

DISTANCE

REMARKS

FIELD PARTY
NAME
POSITION
INDEX
TAP READ
TAP ON FOR
TAP ON FOR

WEATHER
CLEAR
CLOUDS
WINDY
RAIN
FOG
THUNDER
LIGHTNING

DATE
TIME
PLACE
ELEVATION
BEARING
DISTANCE
REMARKS

44
45
46

47
48

49
50

VALUABLE

SUBJECT X-sections on
Colorado Ave. contd.

RETURN TO
PUBLIC WORKS
OFFICE
CAMP LEJEUNE
NORTH CAROLINA

FIELD PARTY

____ IN CHARGE
____ INSTRUMENT
____ NOTES
____ TAPE READ
____ TAPE OR ROD
____ TAPE OR ROD
____ INSTRUMENT NO.
____ TAPE NO.

WEATHER

CLEAR
CLOUDY
WINDY
RAIN
FAIR
SNOW
HOT
MODERATE
COLD
FOG

FILE No. _____

FLDR. No. _____

SHEET 3 of

DATE 1-31-1961

FIGURED BY _____

NOTES CHECKED BY _____

PLOTTED BY _____

Quad. No. _____

H.I. from sheet 2

STATION	DIST.	ANGLE ° ' "	+	H. I. BEARING	VER. ANG. DIFF.	ELEVATION
9+43	44' left			37.73	9.76	28.03 27.92
9+73	44' left				9.76	24.03 27.92
10+0						
R.M.					3.70	34.09 33.73 <u>33.98</u>

top of Drop Inlet

top of Drop Inlet

BANK

BANK


27	20	0	22	26
6.3	10.8	11.1	10.5	6.6
31.4	26.9	26.6	27.2	31.1
31.5	27.0	26.7	27.3	31.2

Stake marked Fl. El. House = 268

VALLEJO
PUBLIC WORKS
OFFICE
DAM COLUMN
NORTH CAROLINA

FIELD PARTY
IN CHARGE
PROJECT
NOTES
DATE READ
TAPES OR ROLLS
THUNDER NO.
TAPES
WEATHER
CLEAR
CLOUDY
WINDY
RAIN
FOG
THUNDER BY
NOTES CHECKED BY
PLATES BY
DATE
CITY
PROPERTY

STATION
COUNT
AND
ELEVATION
BE IN
M
FEET ABOVE

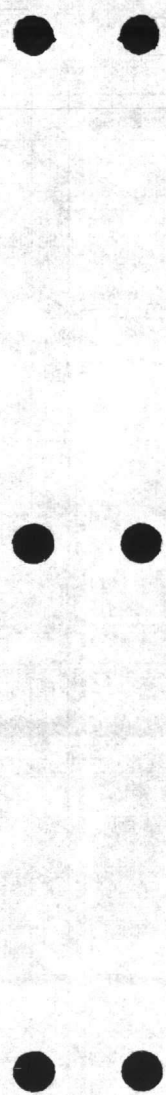

VALUABLE

SUBJECT _____

RETURN TO
PUBLIC WORKS
OFFICE
CAMP LEJEUNE
NORTH CAROLINA

FIELD PARTY

IN CHARGE

INSTRUMENT

NOTES

TAPE READ

TAPE OR ROD

TAPE OR ROD

INSTRUMENT NO.

TAPE NO.

WEATHER

CLEAR
CLOUDY
WINDY
RAIN
FAIR
SNOW
HOT
MODERATE
COLD
FOG
FIGURED BY _____
NOTES CHECKED BY _____
PLOTTED BY _____

FILE No. _____

FLDR. No. _____

SHEET. 104

DATE _____ 19__

Quad. No. _____

4.16 35.49 31.33 Stoop on Well #614

STATION	DIST.	ANGLE ° ' "	H. I. BEARING	VER. ANG. DIFF.	ELEVATION	
B.M.		3 05	35 85	2.50	32.78	NAIL IN P.P. # C-57
T.P.		3 49	35 61	.76 3 71	32.12	
					34.13	(33.98) there (34.08) ours
					1 63 33 78	SIDE SHOT ON FINISH GRADE # 268
B.M.		3 29	35 57	.74 3 31	32.34	NAIL IN P.P. INT. COLORADO & FLORIDA
T.P.		4 90	36 25	.20 4 44	31.15	
B.M.		3 26	32 77	.94	32.78	(32.93) NAIL IN P.P. # C-57
					32.45	Colorado + Florida
Sewer Const. B.M.		3.18	35.63		32.49	sts. 206 + 35

RECEIVED
POSTAL WORKS
DIVISION
WASHINGTON
D.C.

STATION DATE

TIME

SEARCHED

INDEXED

FILED

FIELD PARTY

IN CHARGE

THE SURVEY

NOTE

TASK ROAD

DATE OF ROAD

DATE OF ROAD

DATE OF ROAD

DATE OF ROAD

WEATHER

CLEAR

WINDY

RAIN

FAIR

WINDY

WINDY

WINDY

WINDY


FILE NO.

FILE NO.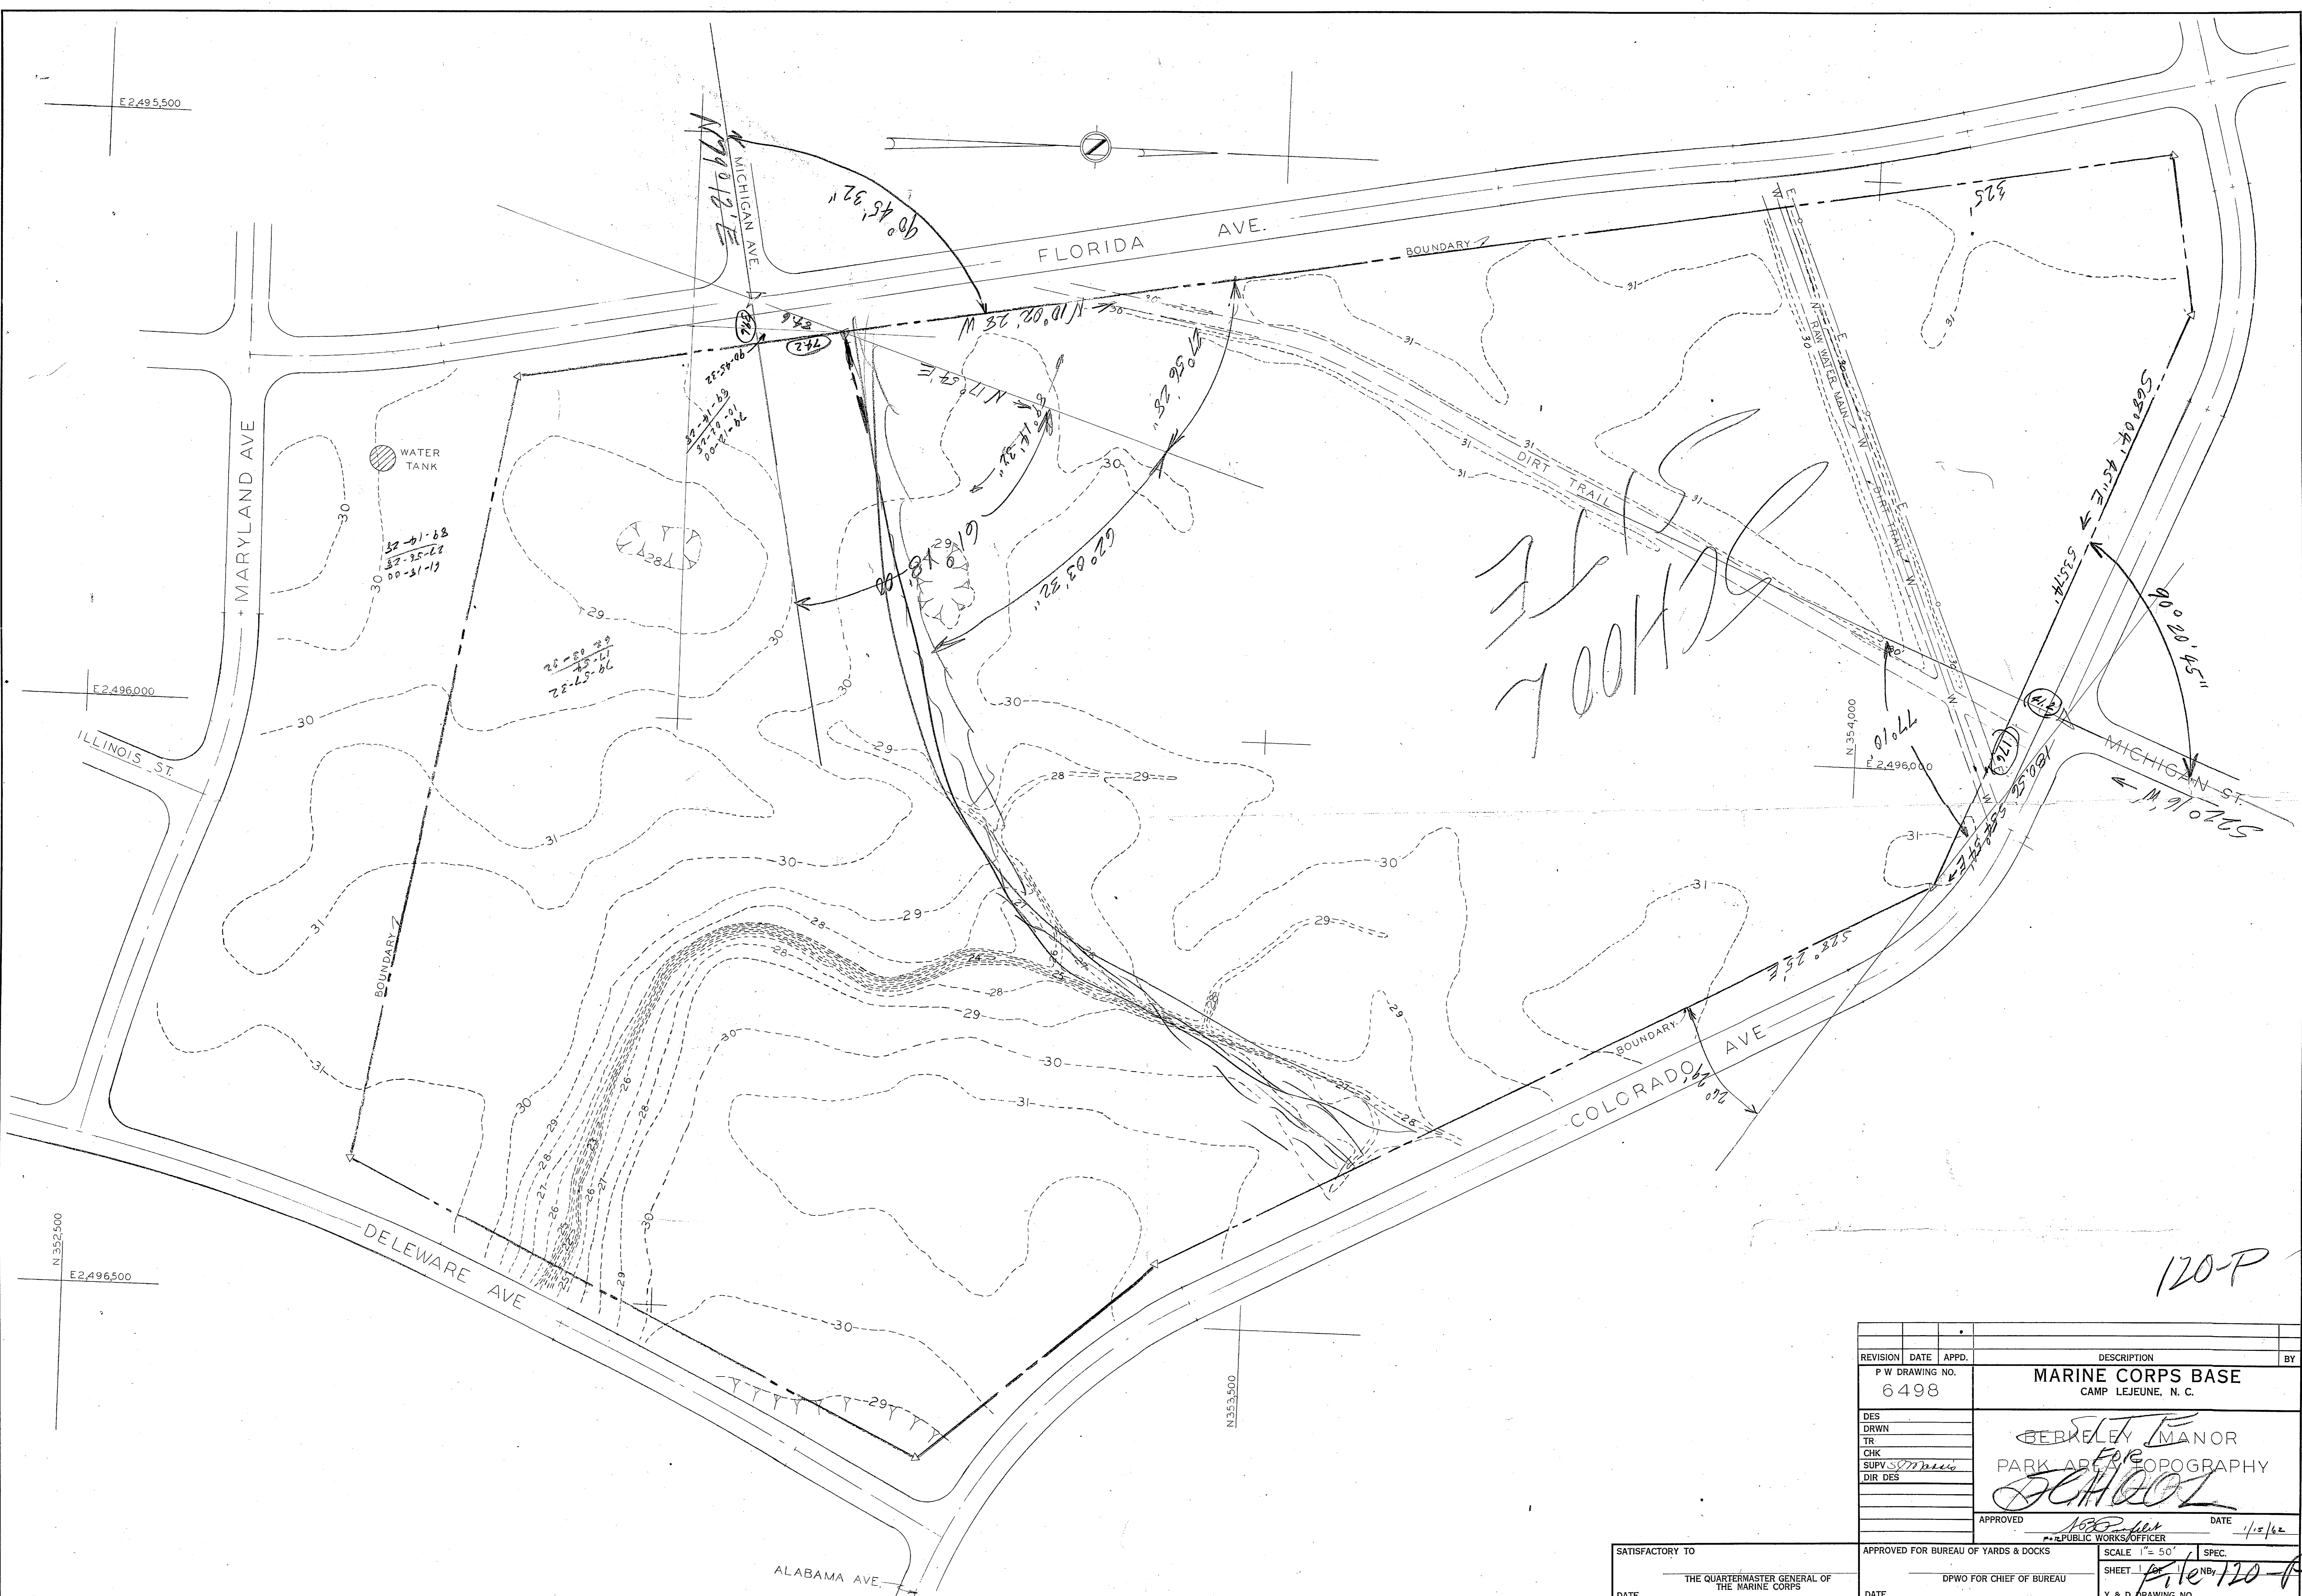

SCHOOL

120-P

REVISION	DATE	APPD.	DESCRIPTION	BY
			MARINE CORPS BASE CAMP LEJEUNE, N. C.	
P W DRAWING NO. 6498				
DES			BERKELEY MANOR PARK ART SCHOOL TOPOGRAPHY	
DRWN				
TR				
CHK				
SUPV				
DIR DES				
APPROVED			DATE	1/15/62
PUBLIC WORKS OFFICER				
SATISFACTORY TO		APPROVED FOR BUREAU OF YARDS & DOCKS		SCALE 1" = 50'
THE QUARTERMASTER GENERAL OF THE MARINE CORPS		DPWO FOR CHIEF OF BUREAU		SHEET 1 of 1
DATE		DATE		FILE 120-P
			Y & D DRAWING NO.	



11

11