



EXIST. SHELTER

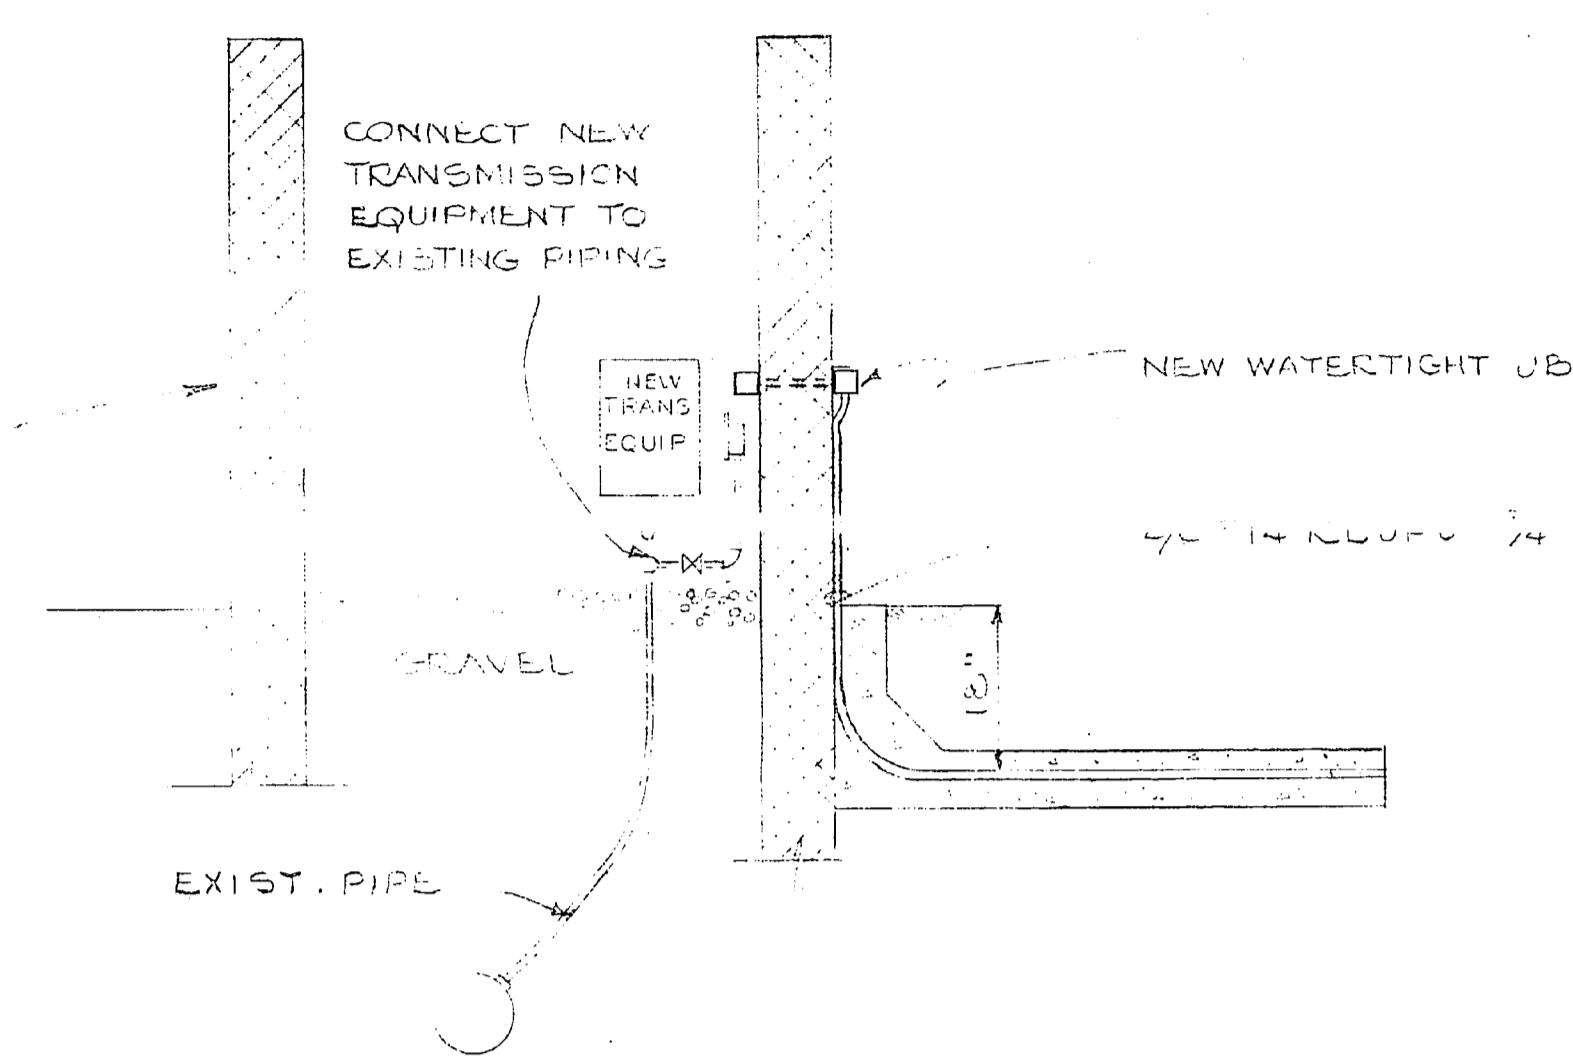


DETAILS OF WATER LEVEL TRANSMITTER  
SHELTER & PIPING  
Scale 1/2"=1'-0"

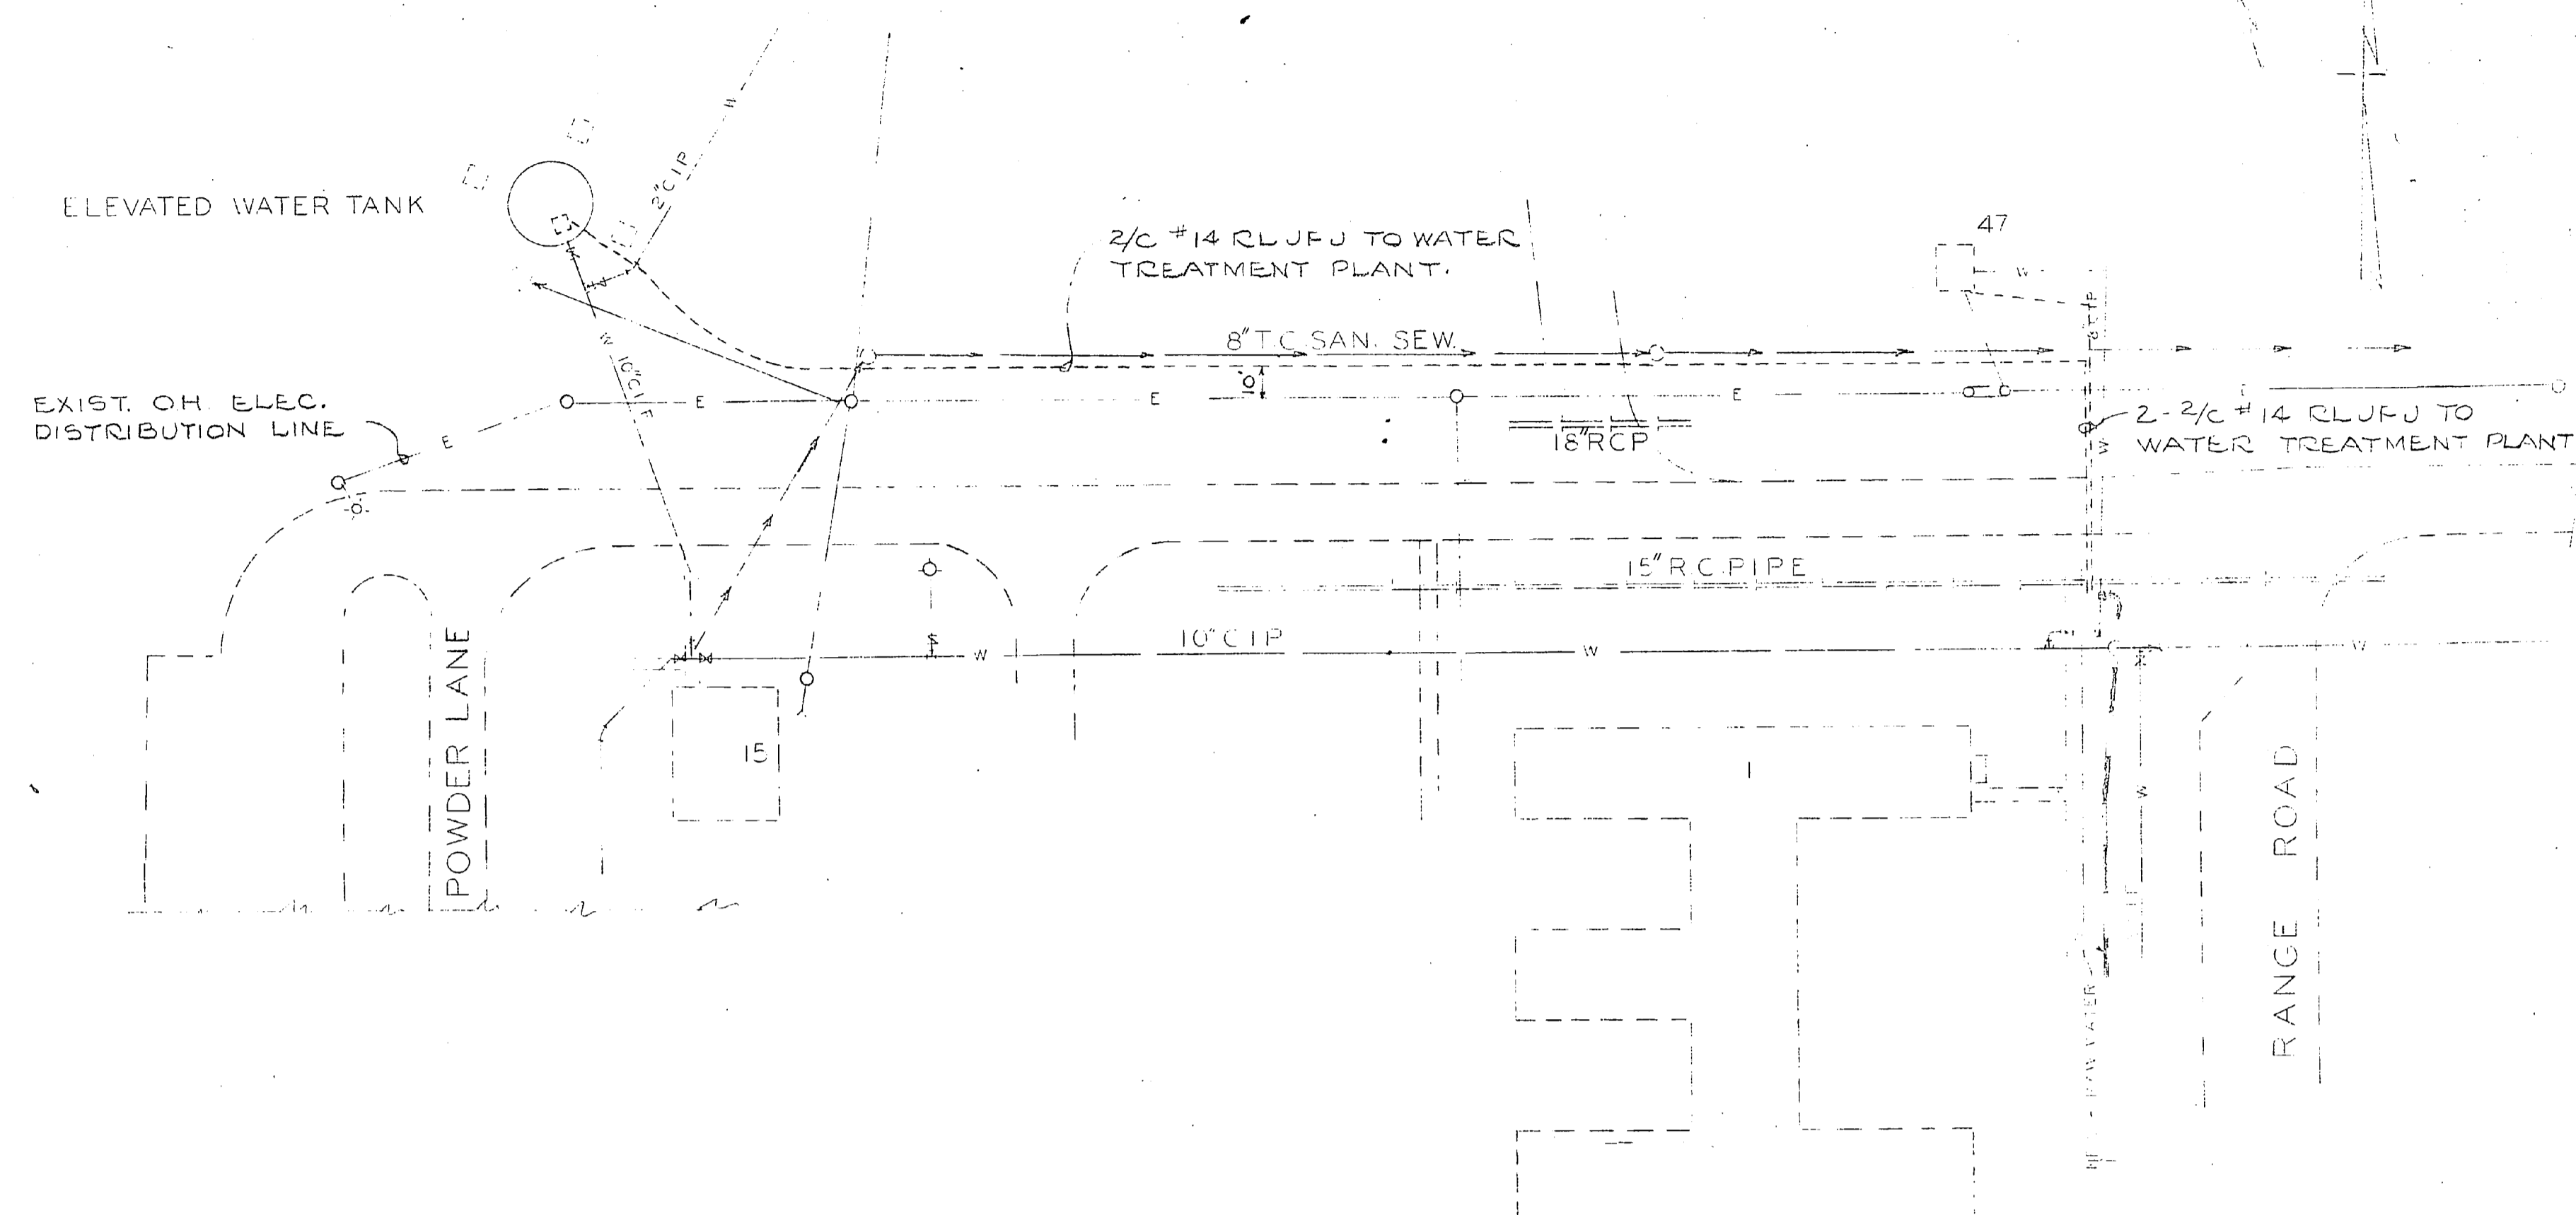


PLAN - WATER TANK & WELL 47  
Scale 1"=50'

LOCATION TRANSMITTER SHELTER ELEV. WATER TANK


NTS

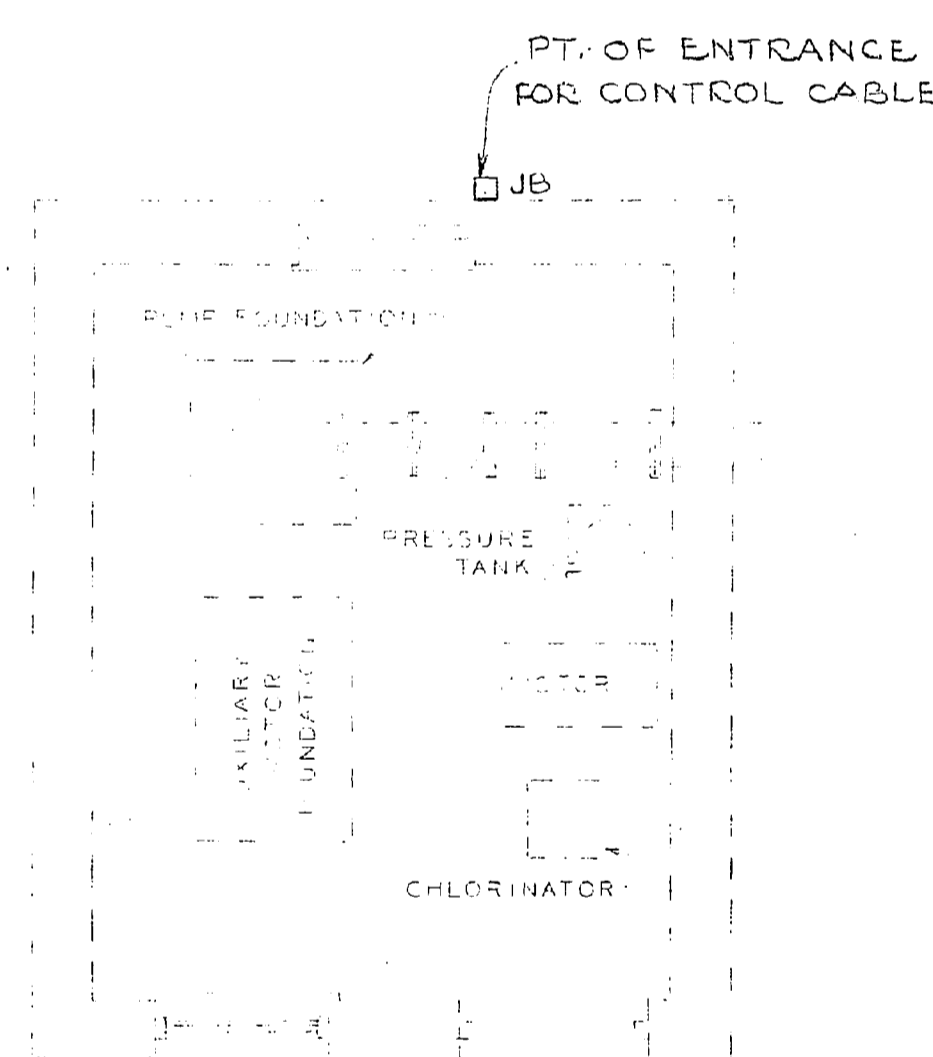


WELL — 45  
Scale 1/4"=1'-0"

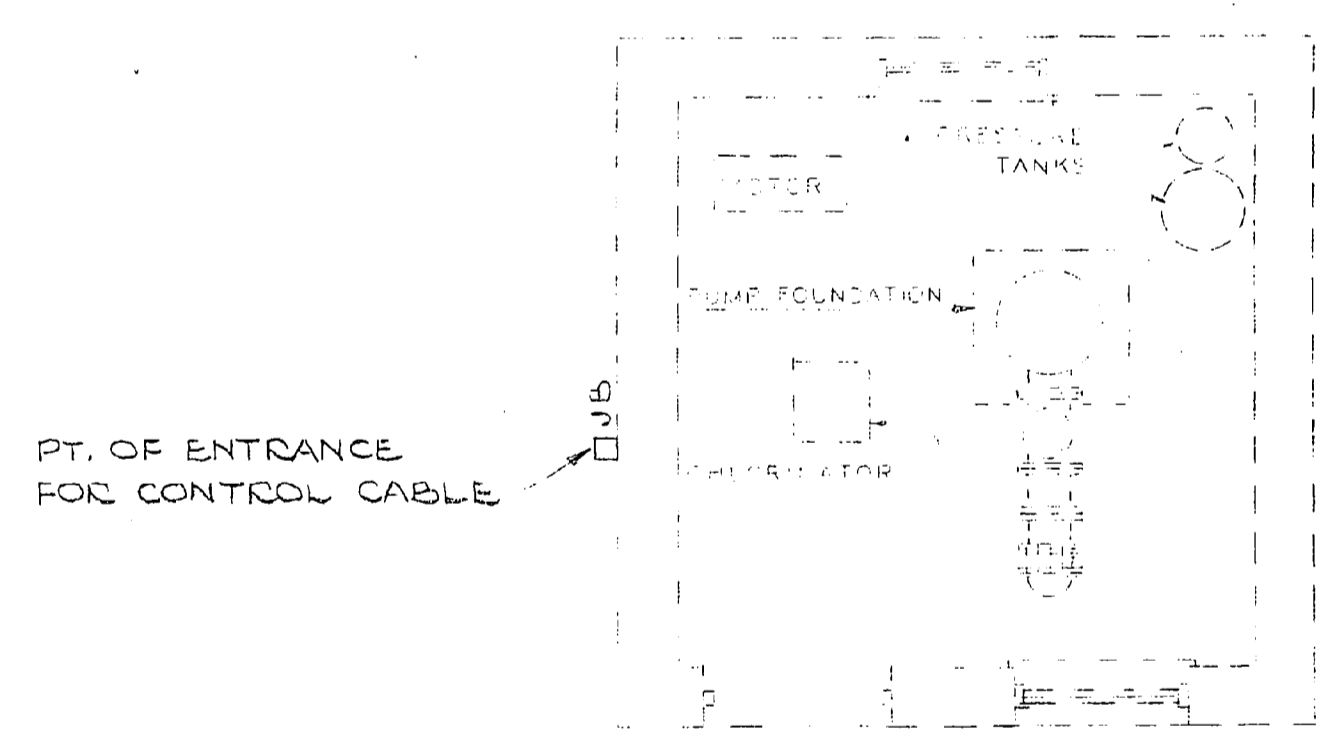


WELL — 47  
Scale 1/4"=1'-0"

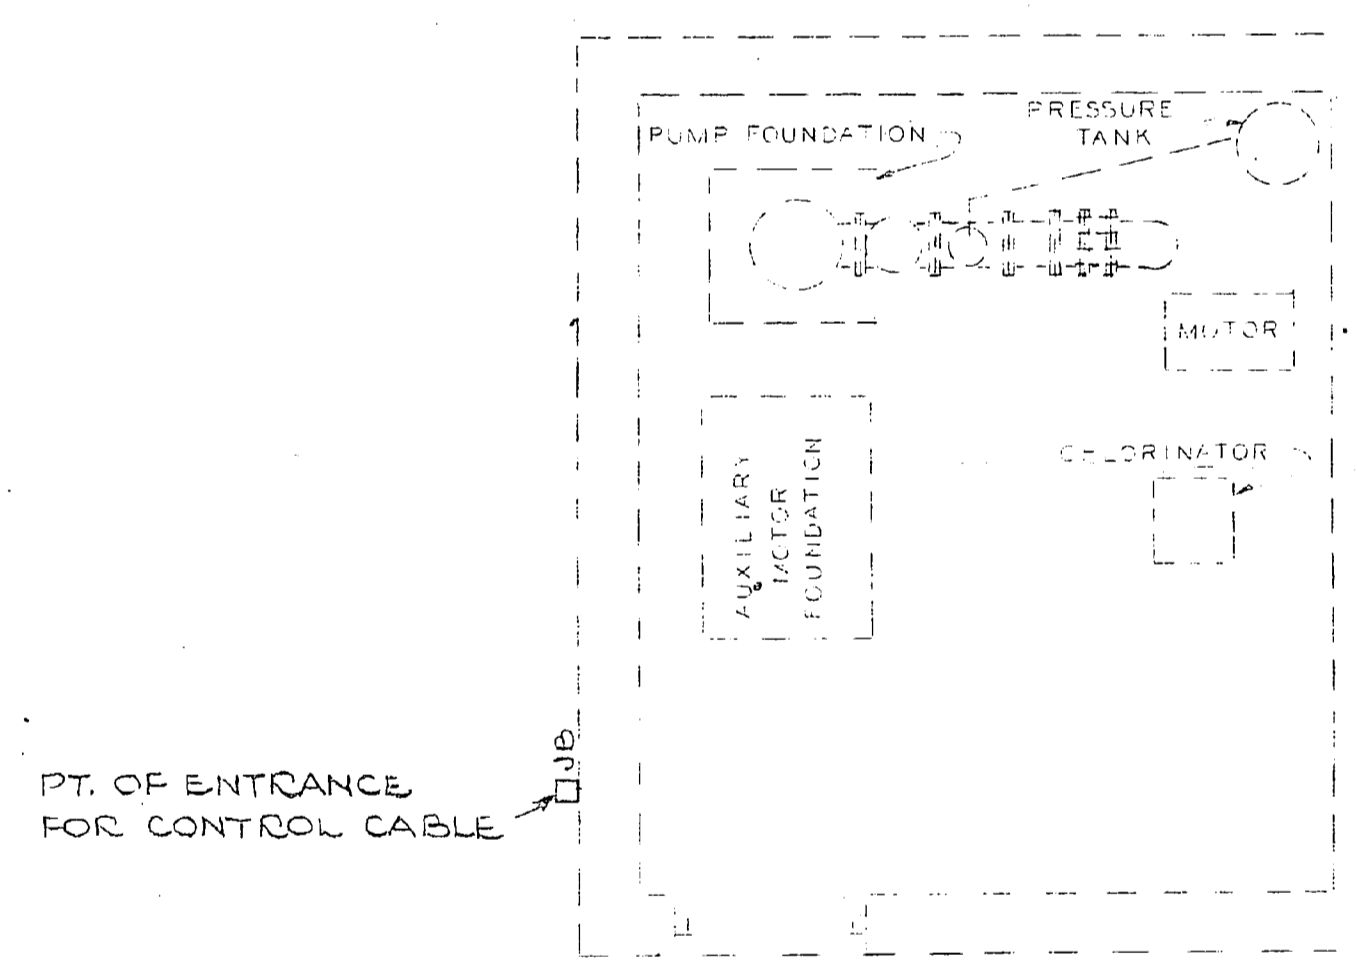

WELL — 227  
Scale 1/4"=1'-0"

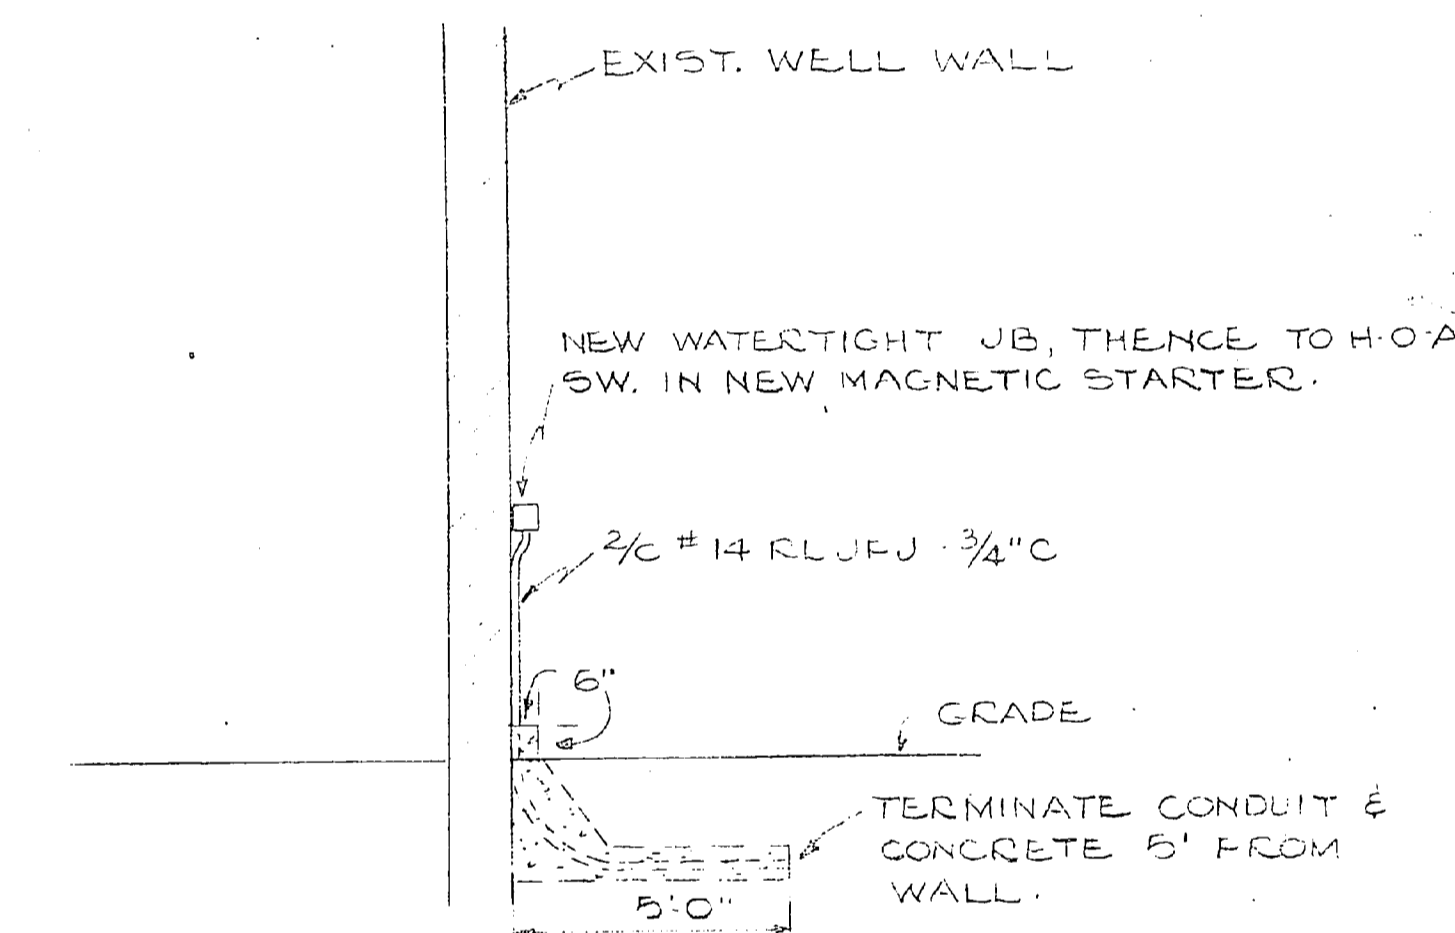

TYPICAL DETAIL OF ENTRANCE  
FOR TELEMETERING CABLE  
NTS

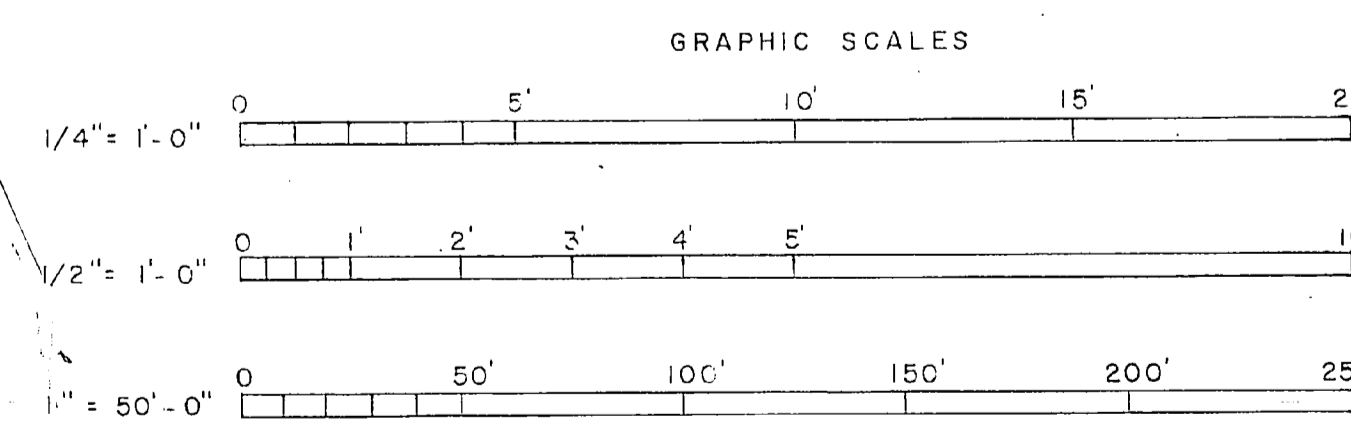

CATEGORY CODE NO. 84150 & 2000

SATISFACTORY TO  
THE COMMANDING GENERAL  
MARINE CORPS BASE, CAMP LEJEUNE, N.C.  
DATE 10 July 1963

SATISFACTORY TO  
THE QUARTERMASTER GENERAL OF  
THE MARINE CORPS  
DATE

REVISION	DATE	APPD.	DESCRIPTION	BY
A	42665		AS BUILT	ZEB
P W DRAWING NO.		MARINE CORPS BASE		
12517		CAMP LEJEUNE, N. C.		
		ATLANTIC DIV., BUREAU OF YARDS & DOCKS, NORFOLK II, VA.		
DES. <i>A. C. ...</i>		WATER TREATMENT & STORAGE		
DRWN. <i>A. C. ...</i>		FACILITIES, WEAPONS TRAINING FACILITY		
TR. <i>A. C. ...</i>		WELLS & MISCELLANEOUS CONTROLS		
CHK. <i>A. C. ...</i>		APPROVED <i>[Signature]</i>		
DIR. DES. <i>[Signature]</i>		DATE 10 July 63		
APPROVED FOR BUREAU OF YARDS & DOCKS		SCALE GRAPHIC	SPEC 5407763	
FOR DRLAN DOCKS FOR CHIEF OF BUREAU		SHEET 18 OF 19	NBY 54077	
DATE		Y & D DRAWING NO.	957517	

