




REVISIONS			
SYM	DESCRIPTION	DATE	APPROVED
①	REVISED AS-BUILT	7-21-86	JFB

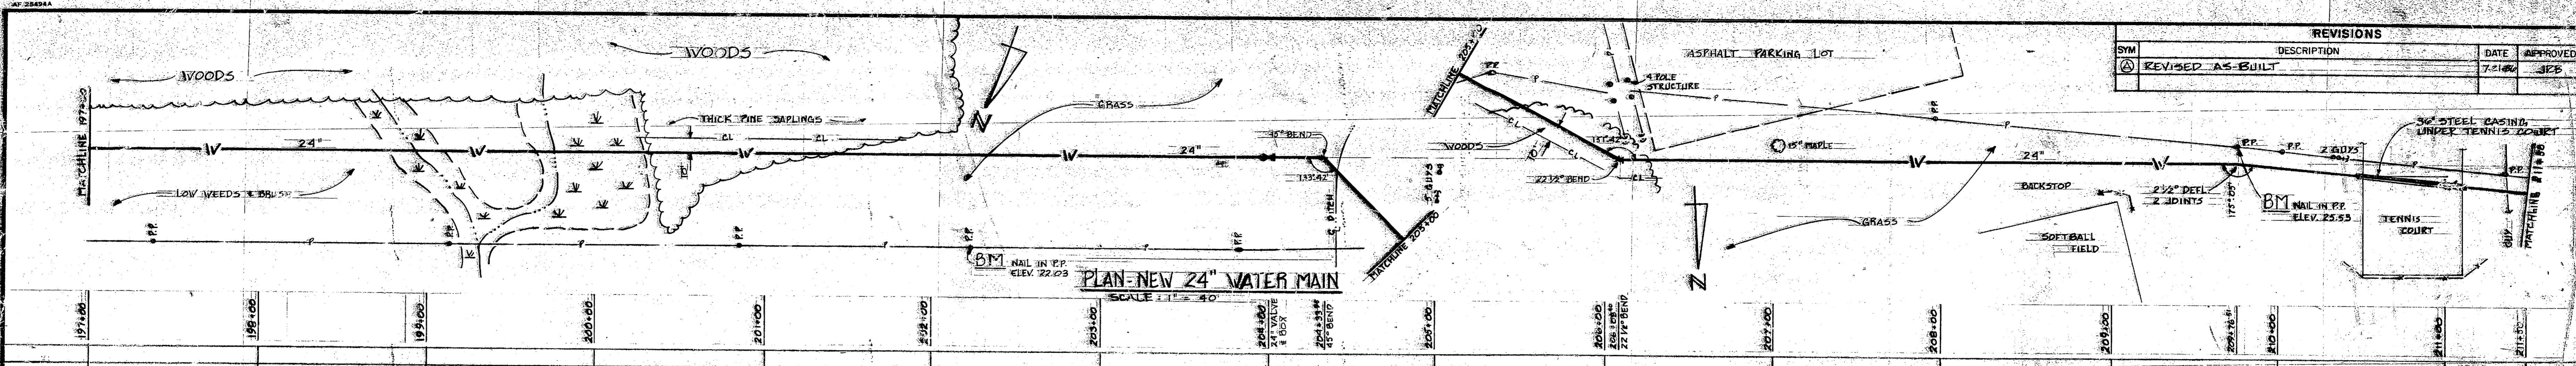


PLAN-NEW 24" WATER MAIN
SCALE: 1" = 40'

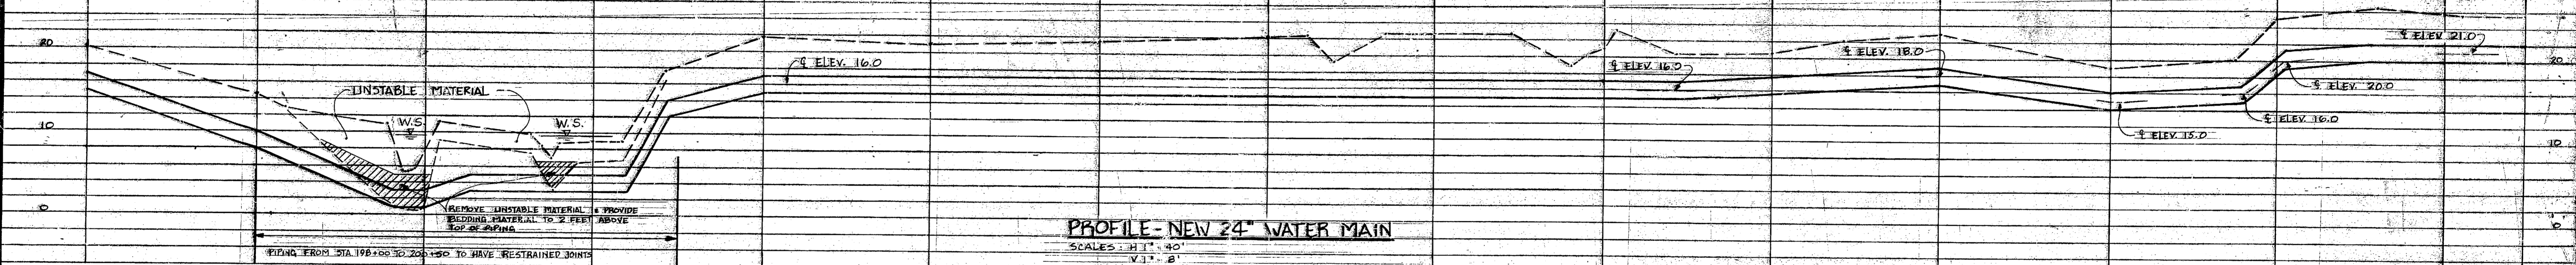

PROFILE-NEW 24" WATER MAIN
SCALE: 1" = 10' V, 1" = 40' H

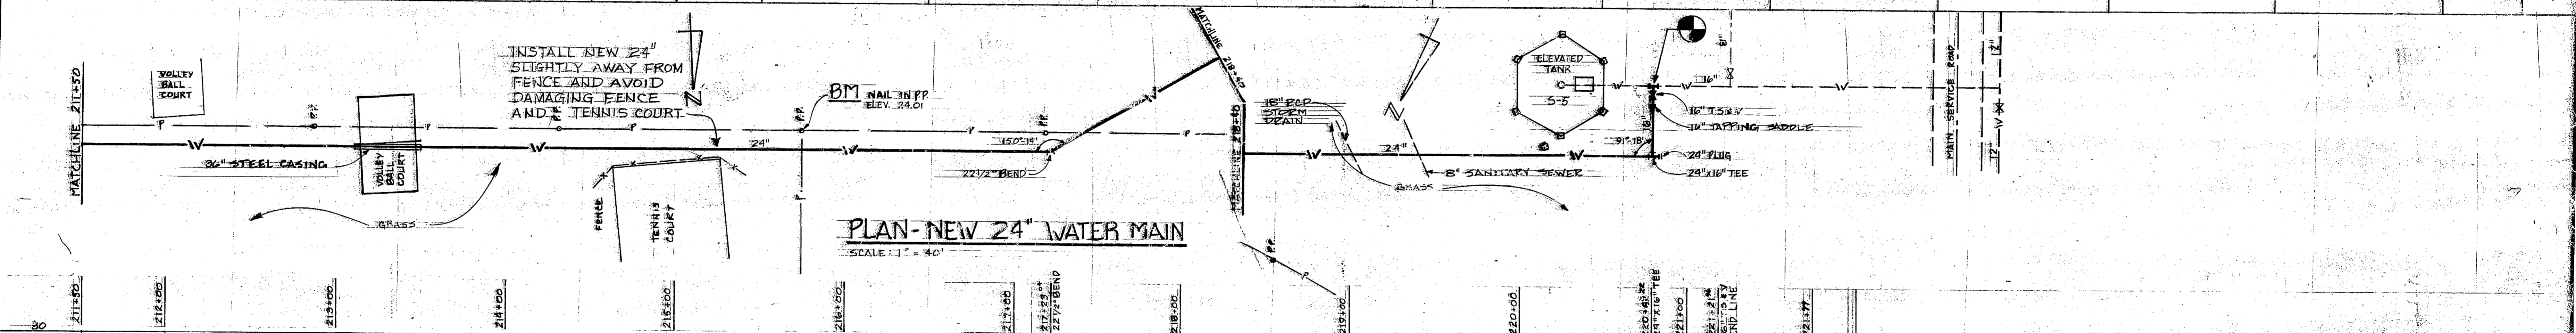


PLAN-NEW 24" WATER MAIN
SCALE: 1" = 40'

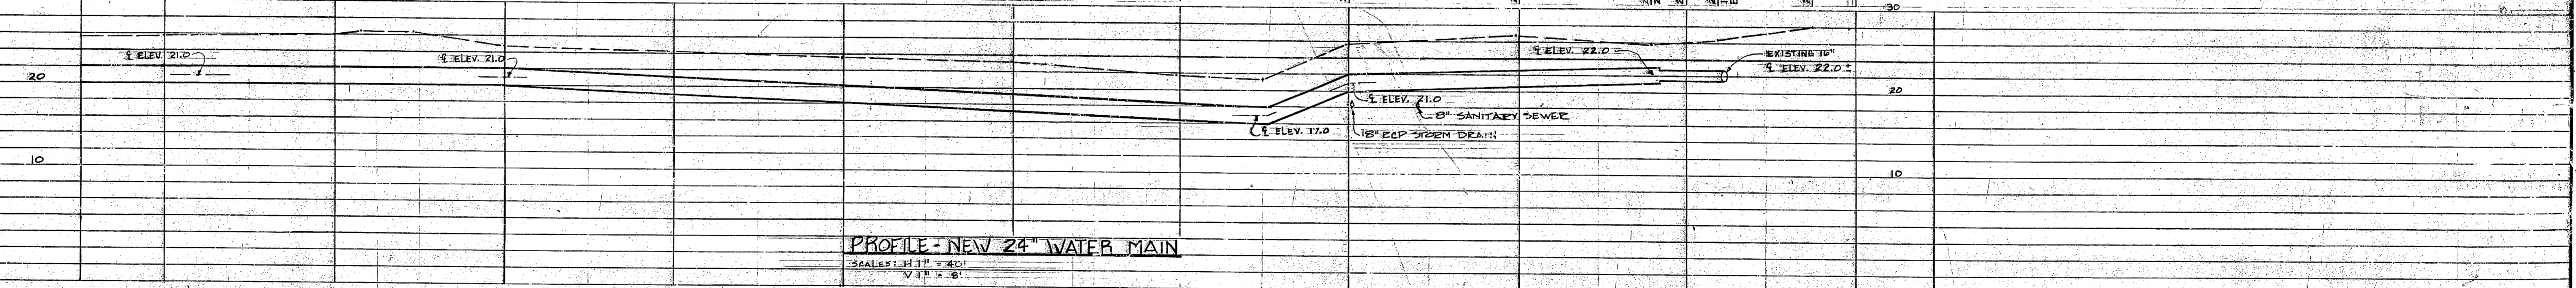


PROFILE-NEW 24" WATER MAIN
SCALE: 1" = 10' V, 1" = 40' H


NOTE:
SEE SHEET C-1 FOR LEGEND

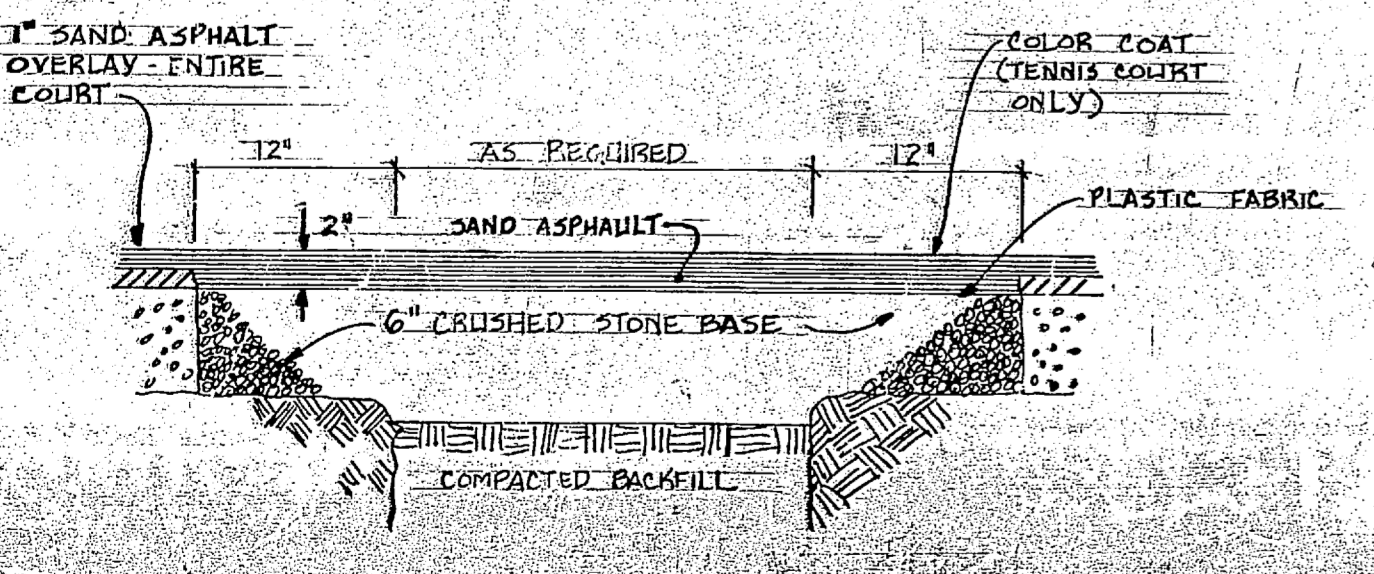

TENNIS/VOLLEY BALL REPAIR DETAIL
NO SCALE





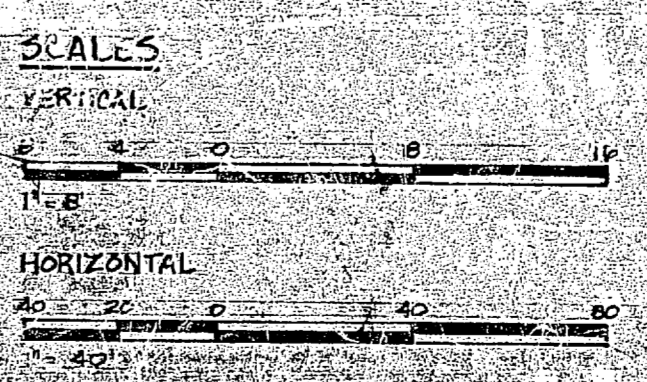


RECORD DRAWING LETTER DATED JUN 23 1986		C-2	
HENRY VON OESCH AND ASSOCIATES CONSULTING ENGINEERS AND PLANNERS WILMINGTON, NORTH CAROLINA		DEPARTMENT OF THE NAVY - NAVAL FACILITIES ENGINEERING COMMAND ATLANTIC DIVISION NORFOLK, VIRGINIA	
DES. JRB DR. KHB CHK. JRB PROJ. MGR. JRB CH. ENGR. JRB		NAVAL STATION CAMP LEJEUNE NORTH CAROLINA	
SUBMITTED BY: <i>[Signature]</i> DATE: <i>[Date]</i> FIRM MEMBER: <i>[Signature]</i> PRINCIPAL REV. JRB RVD C.C.S. HD. JRB DIR. JRB		WATER MAIN FOR TREATMENT FACILITY PLAN & PROFILE	
APPROVED: <i>[Signature]</i> DATE: <i>[Date]</i> ACTIVITY SATISFACTORY TO: <i>[Signature]</i> FOR FIELD FOR COMMANDER NAVFAC		SIZE: CODE IDENT. NO. NAVFAC DRAWING F 90091 412374 SHEET NO. 1 OF 1 SPEC. 02-20-5119	




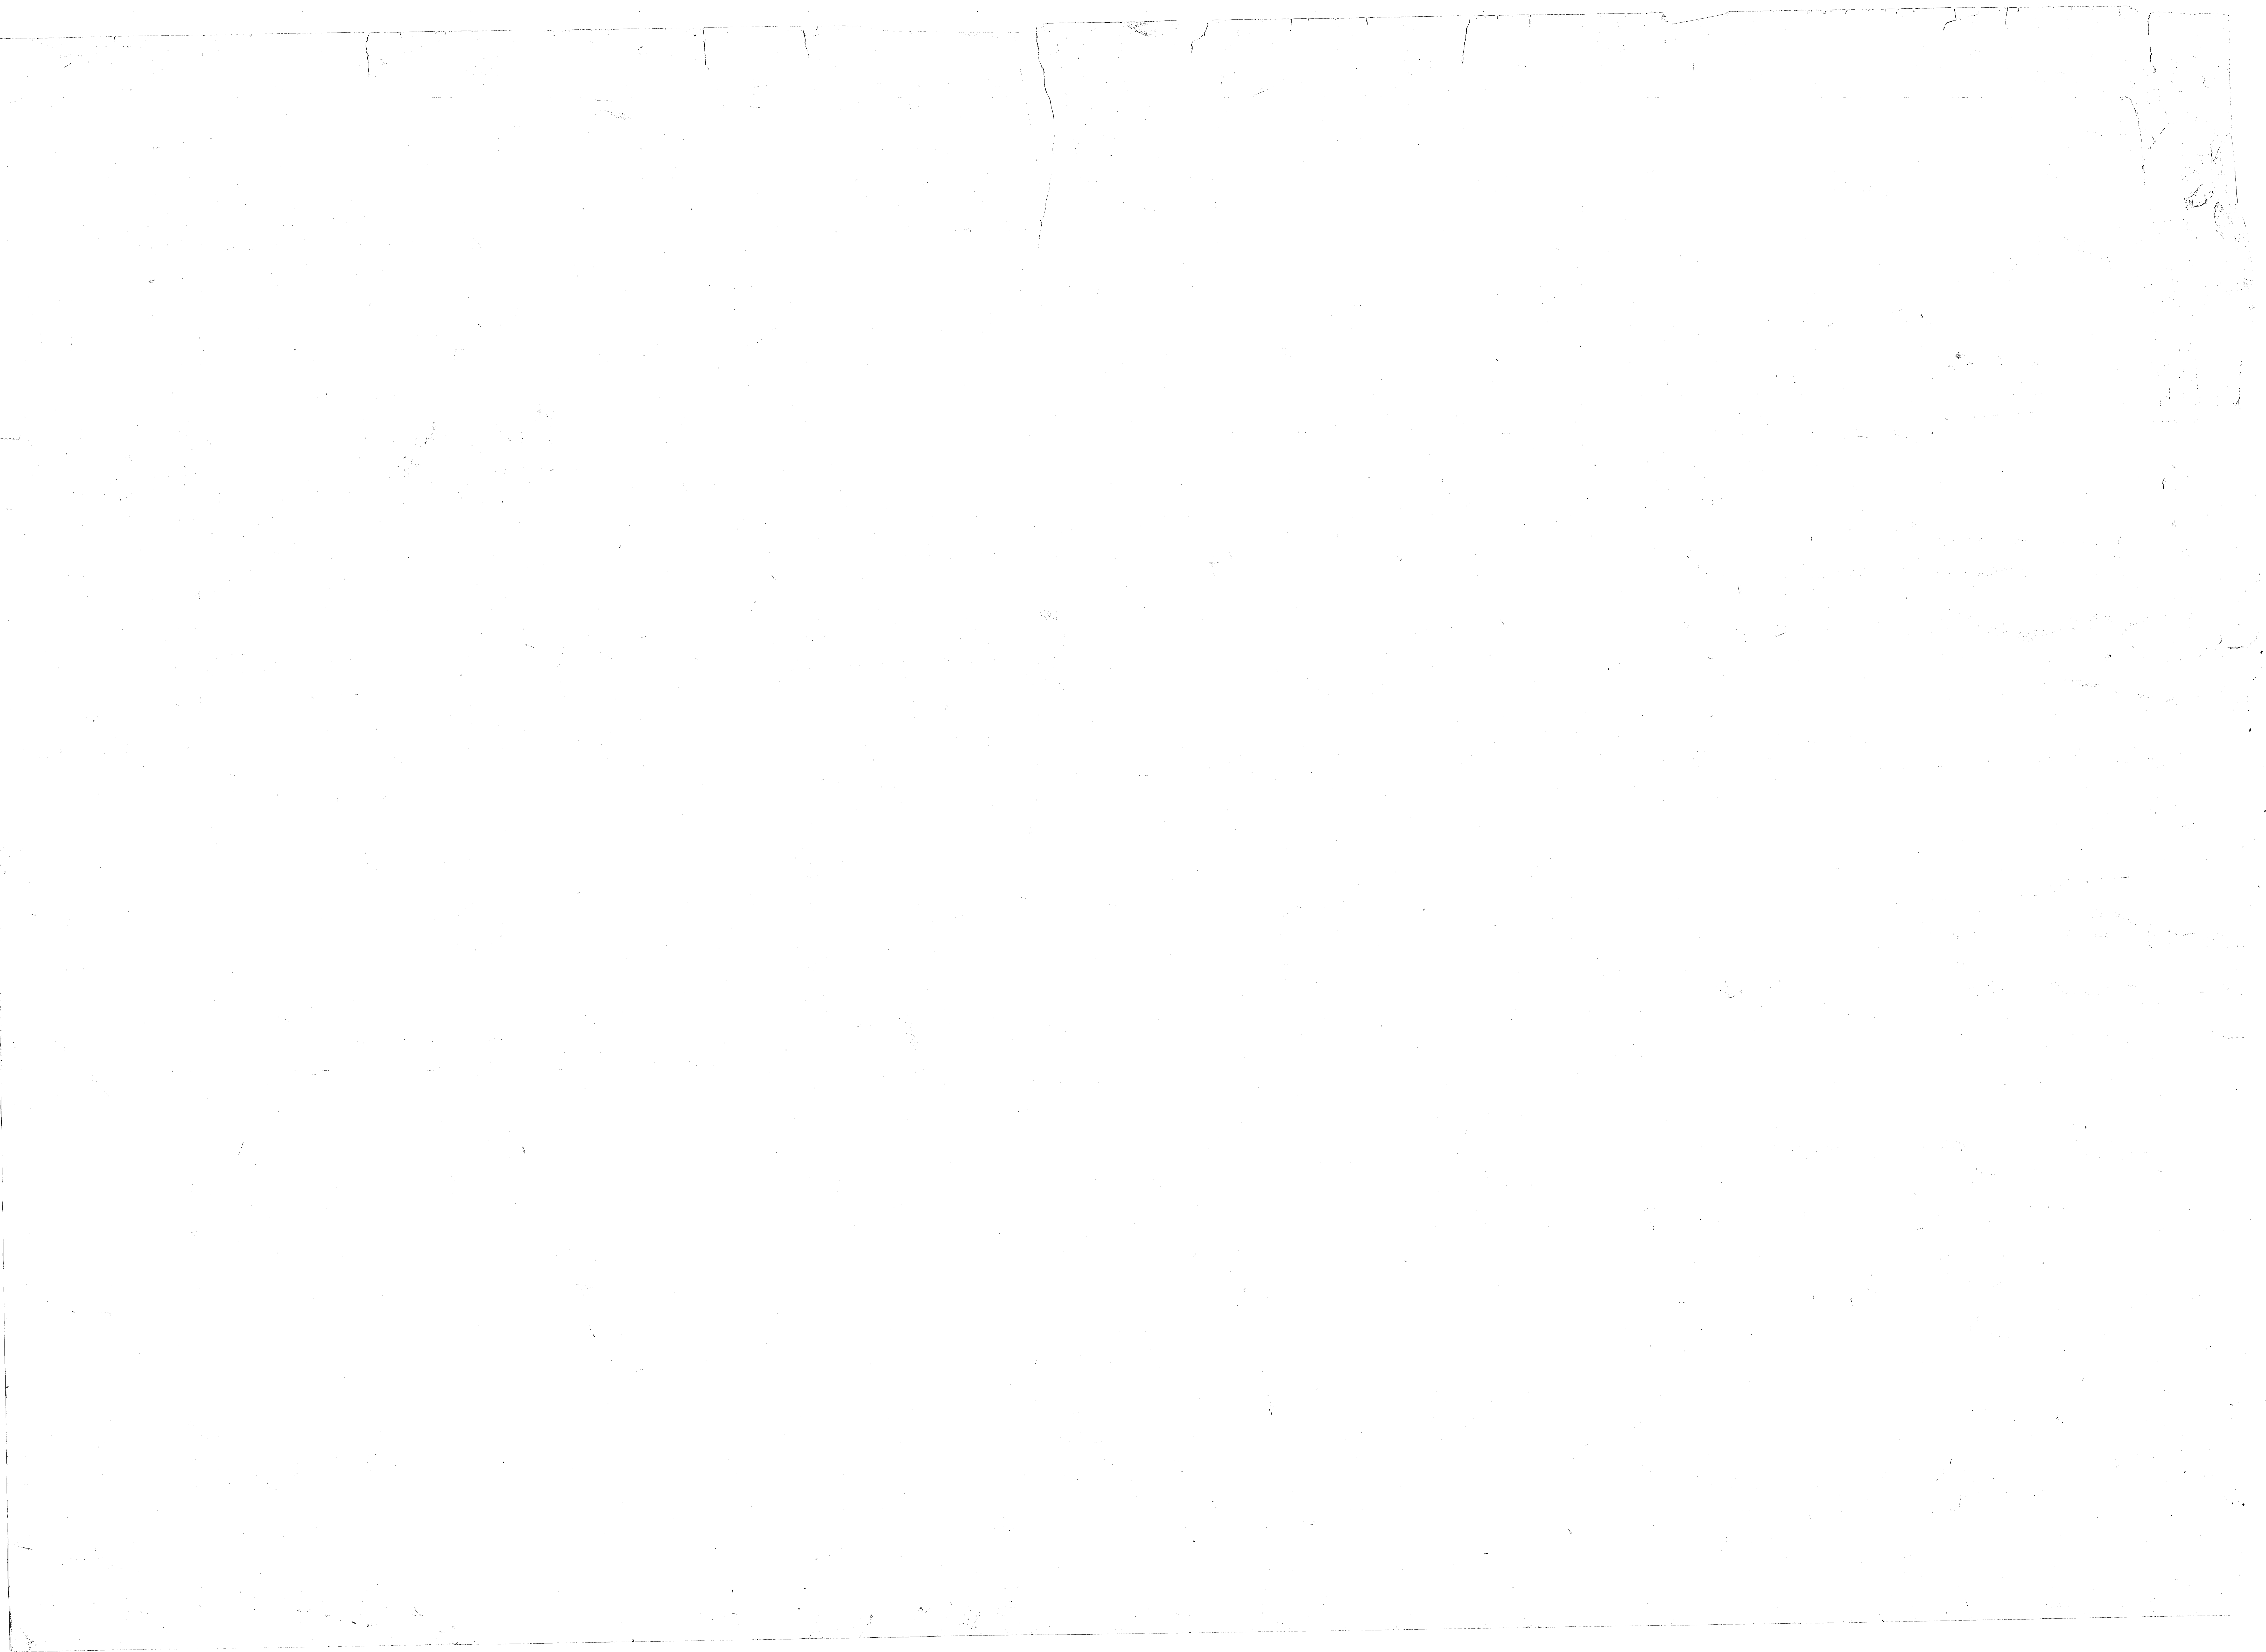


Some parts re-located for new Commissary Complex

REVISIONS			
SYM	DESCRIPTION	DATE	APPROVED
(C)	REVISED AS BUILT	7-31-86	JFB

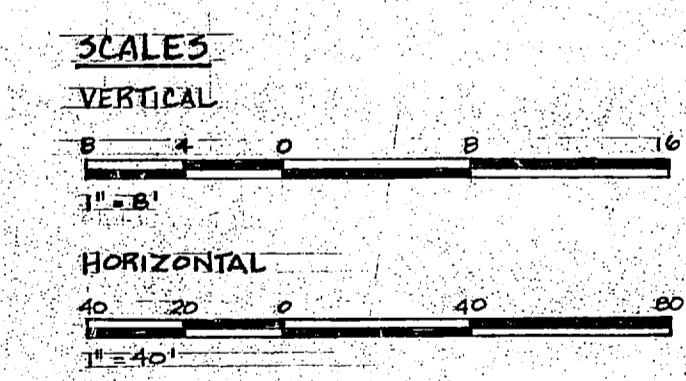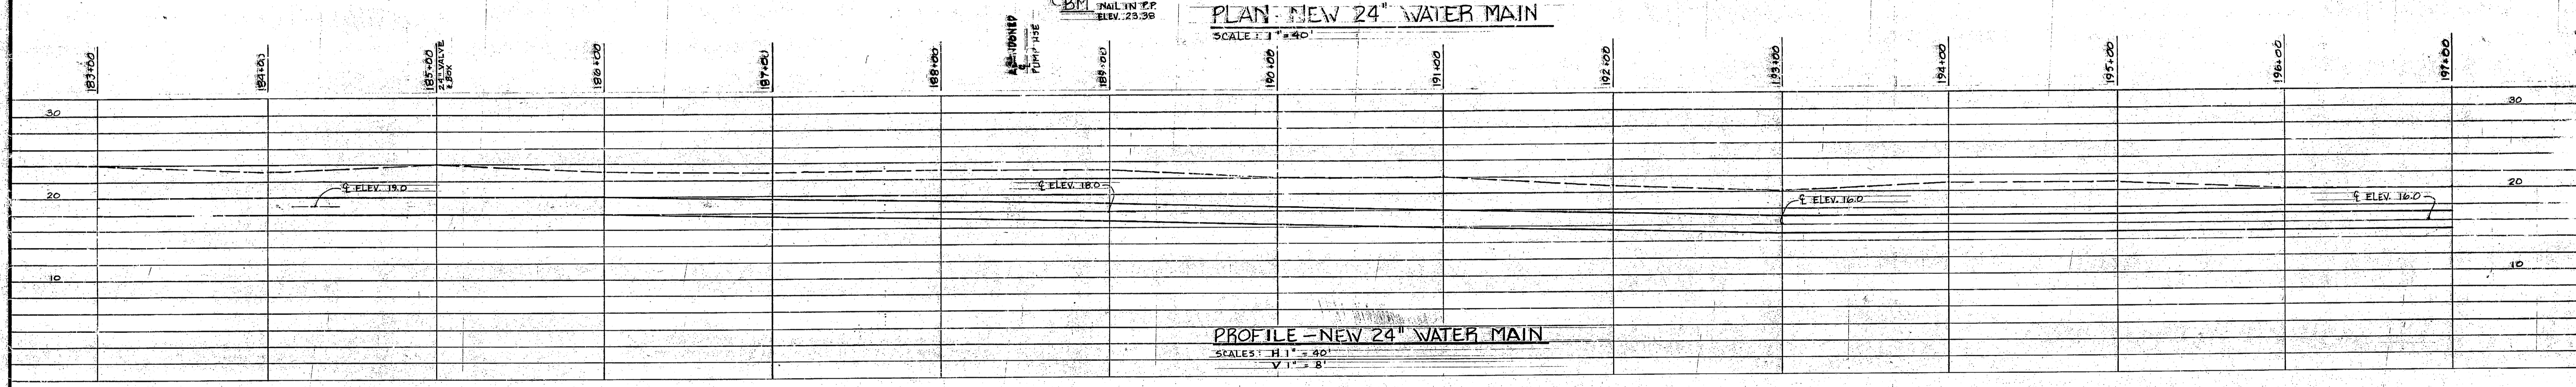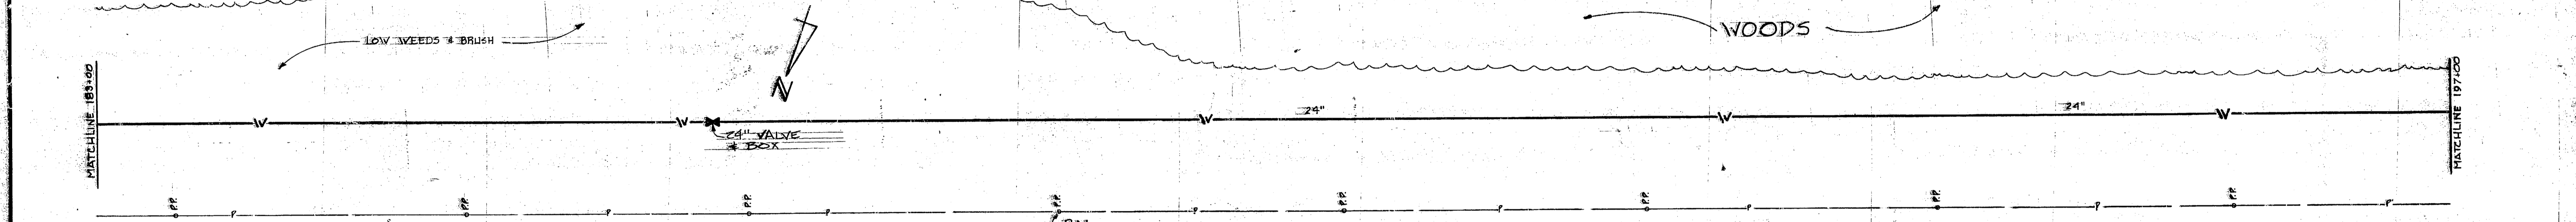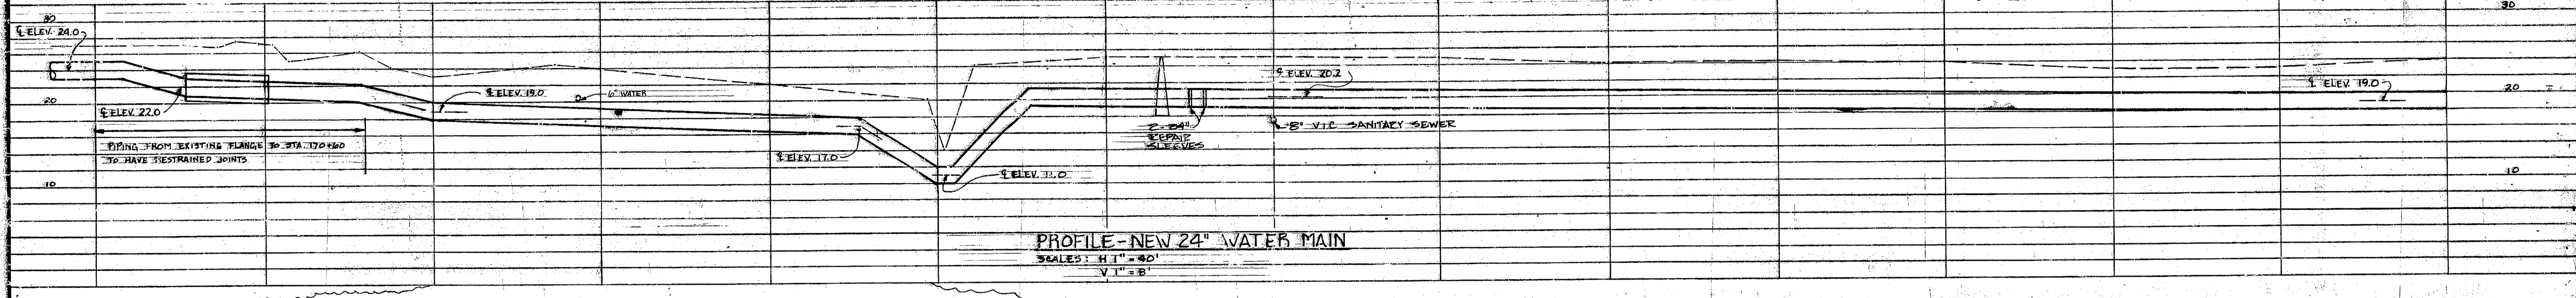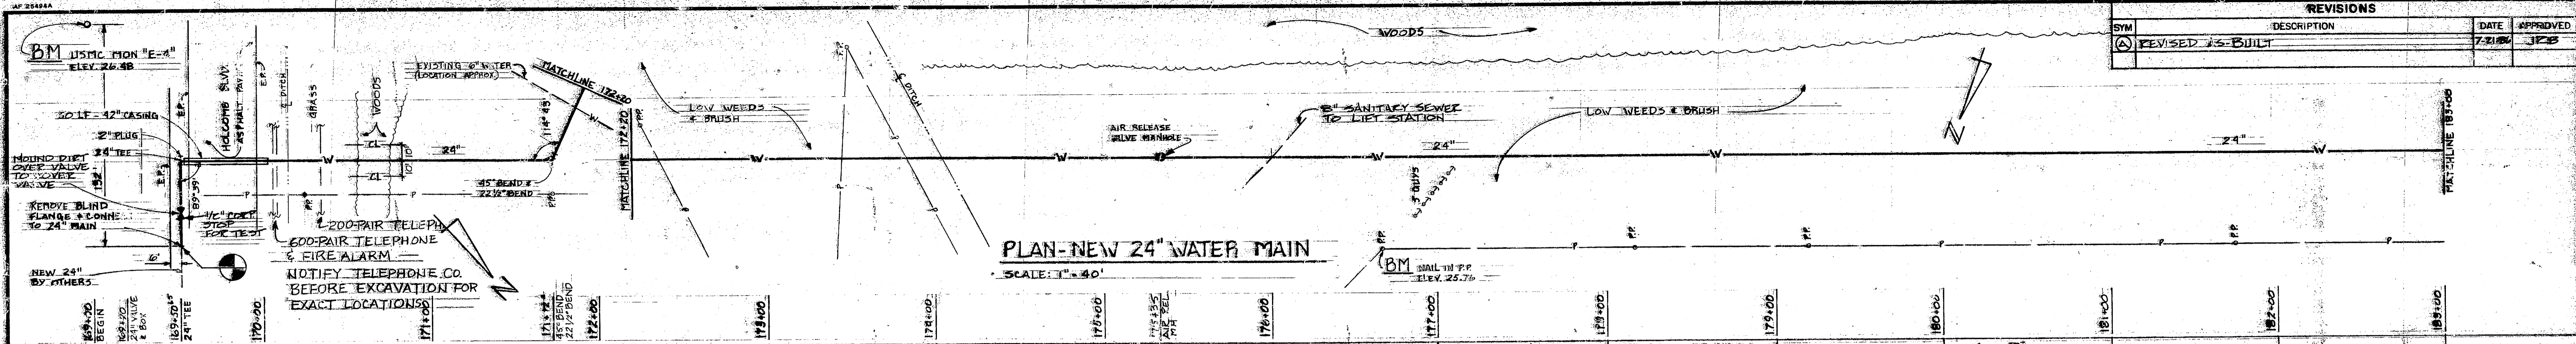

LEGEND	
NEW WATER W/ VALVE	— W —
EXISTING WATER	— W —
CLEARING LIMIT	— CL —
DITCH	— D —
EXISTING OVERHEAD POWER LINES W/ POWER POLES	— P —
CONNECTION TO EXIST. WATER MAIN	— X —
FENCE	— F —

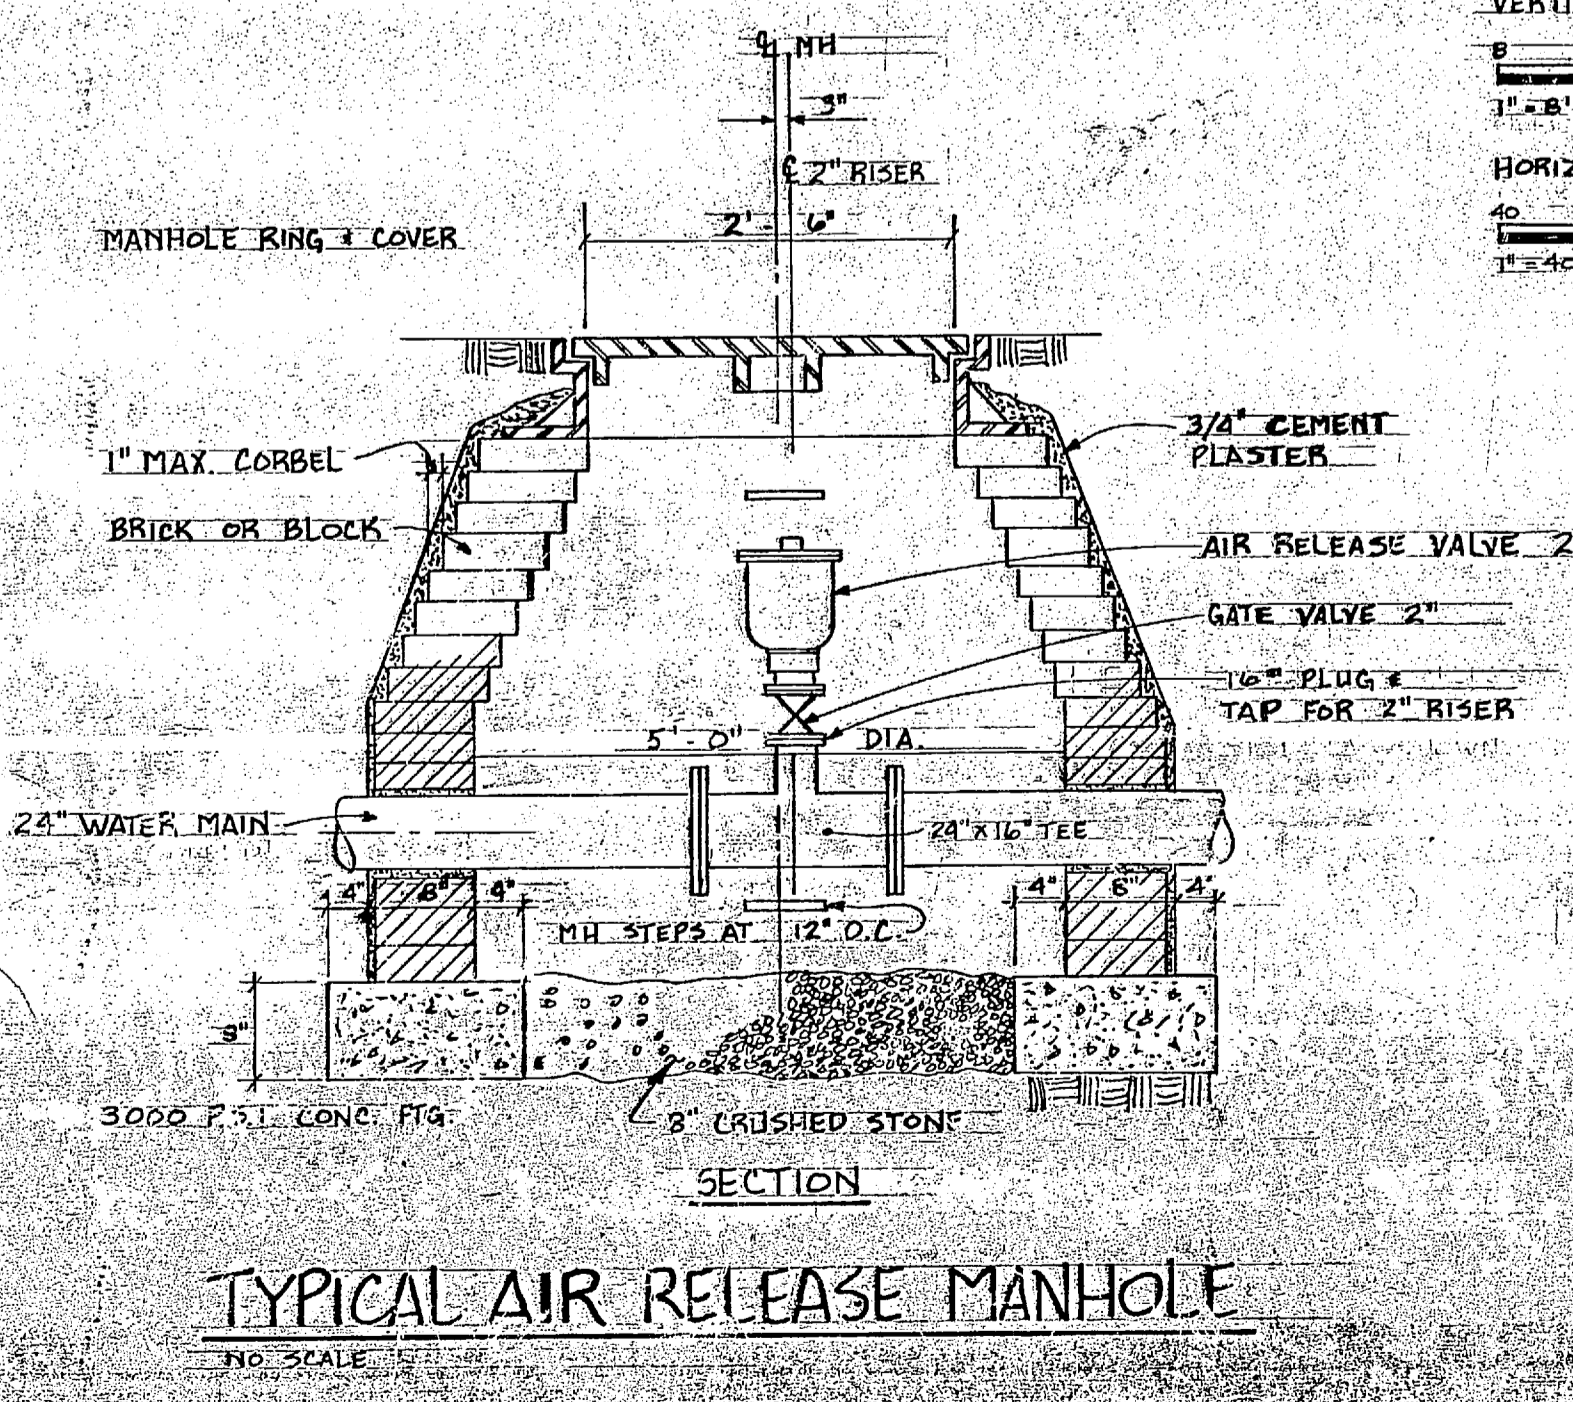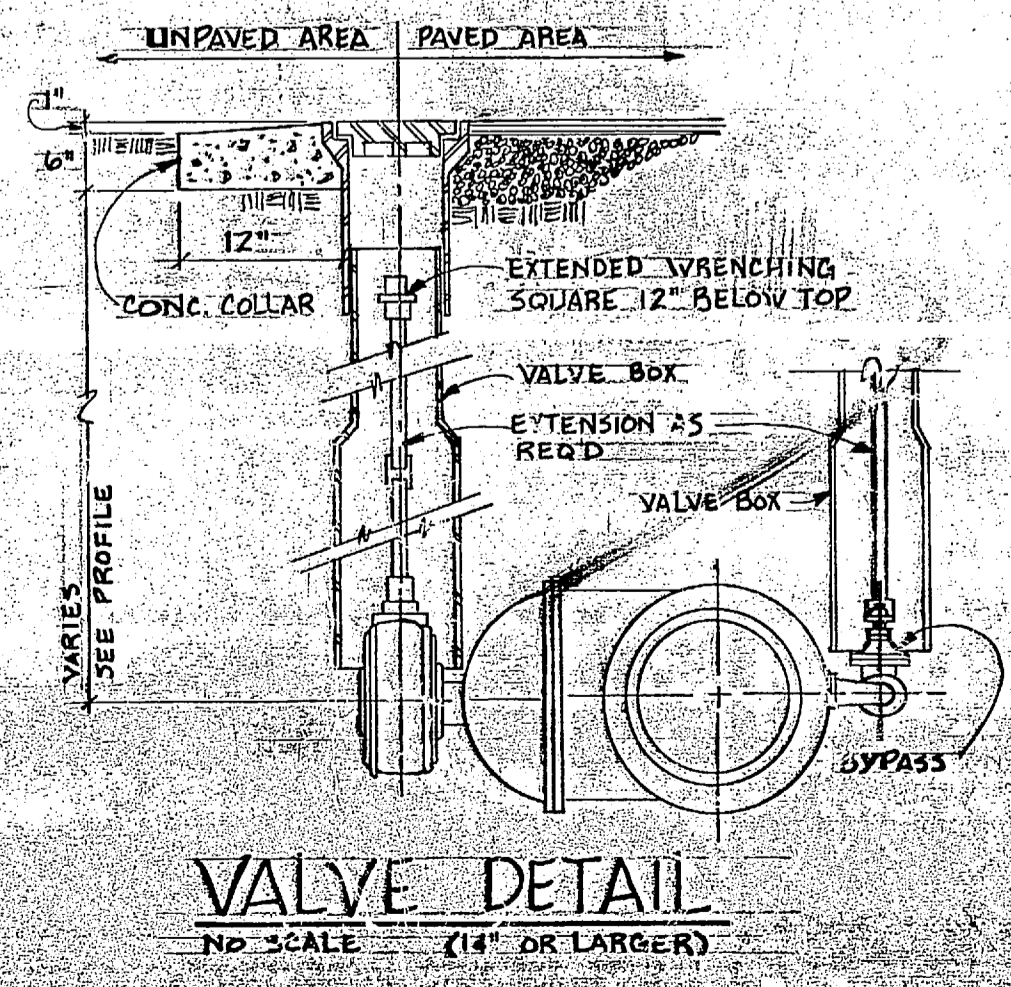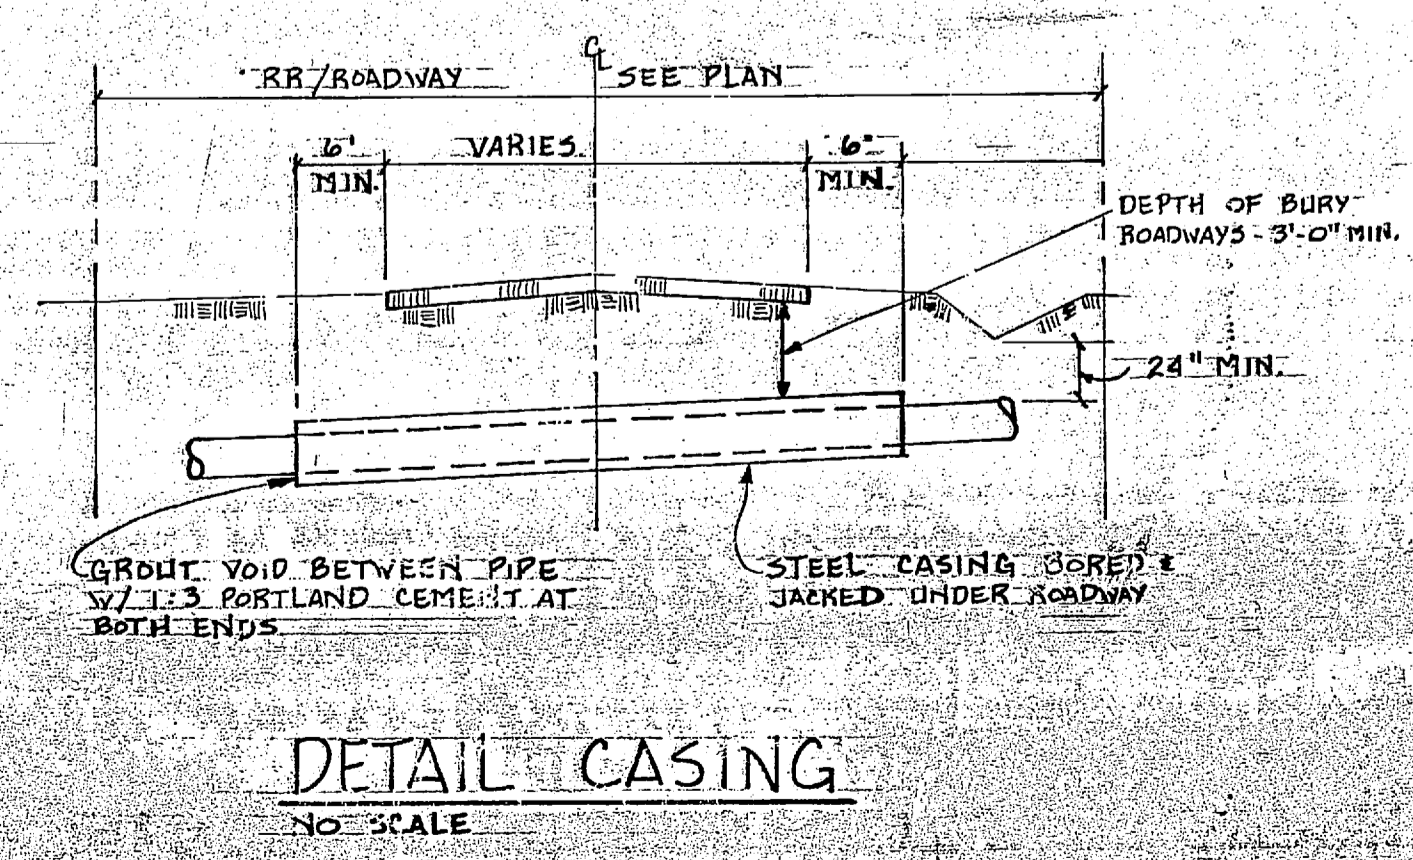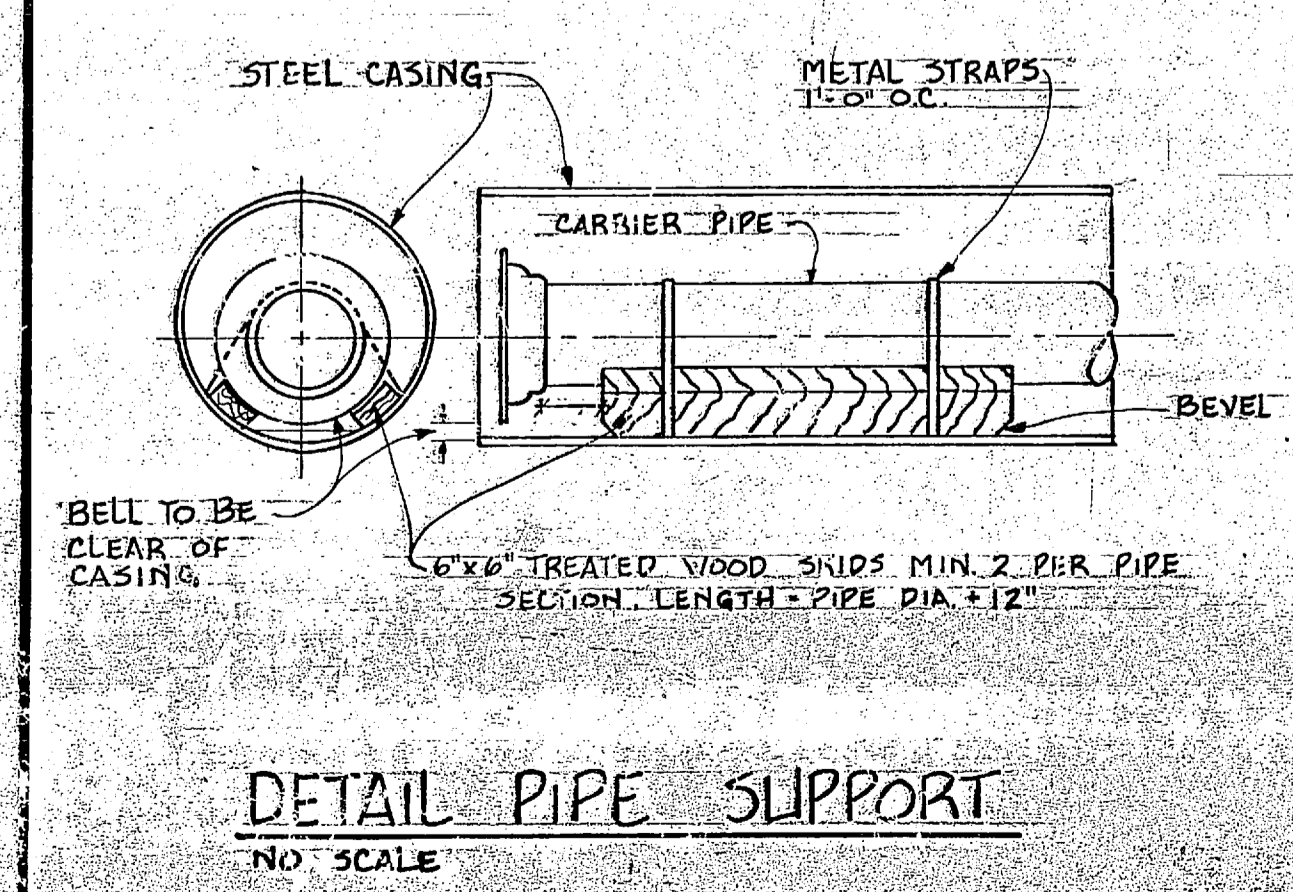

RECORD DRAWING LETTER DATED JUN 23 1986		C-1
HENRY VON DESEN AND ASSOCIATES CONSULTING ENGINEERS AND PLANNERS WILMINGTON, NORTH CAROLINA		DEPARTMENT OF THE NAVY NAVAL FACILITIES ENGINEERING COMMAND ATLANTIC DIVISION NORFOLK, VIRGINIA
DES. JRB DR. KHB CHK. JRB PROJ. MGR. JRB CH. ENGR. JRB		NAVAL STATION CAMP LEJEUNE NORTH CAROLINA
SUBMITTED DATE: 11/28/85 FIRM NUMBER: 111111 EFF. DATE: 11/28/85 REV. DATE: 11/28/85		WATER MAIN FOR TREATMENT FACILITY
ACTIVITY: SATISFACTORY TO DATE		PLAN & PROFILE
SIZE: 80091	CONSTR. CONTR. NO.: 4123748	SHEET 2 OF 5
SCALE: AS SHOWN SPEC: 05-85-5119		SHEET NO.: 223748

Handwritten notes in the top left corner, possibly including a date and some illegible text.