

VALUABLE

RETURN TO
PUBLIC WORKS
OFFICE
CAMP LEJEUNE
NORTH CAROLINA

SUBJECT Loc. of observation
Well #613
OW-3

FIELD PARTY

____ IN CHARGE
____ INSTRUMENT
____ NOTES
____ TAPE READ
____ TAPE OR ROD
____ TAPE OR ROD
____ INSTRUMENT NO.
____ TAPE NO.

WEATHER

CLEAR
CLOUDY
WINDY
RAIN
FAIR

SNOW
HOT
MODERATE
COLD
FOG

FILE No. 120³R
FLDR. No. _____
FIGURED BY _____ SHEET _____
NOTES CHECKED BY _____
PLOTTED BY _____ DATE 11-9 1959
Quad. No. _____

STATION	DIST.	ANGLE		+	H. I. BEARING	VER. ANG. DIFF.	ELEVATION
		°	' "				



B.M.							21.14
					51 26.65		
						4.0	22.6

FLOOR ELEV. well House #613

Ground at observation well site #613

FLOOR ELEV.
Well House #613

21.14

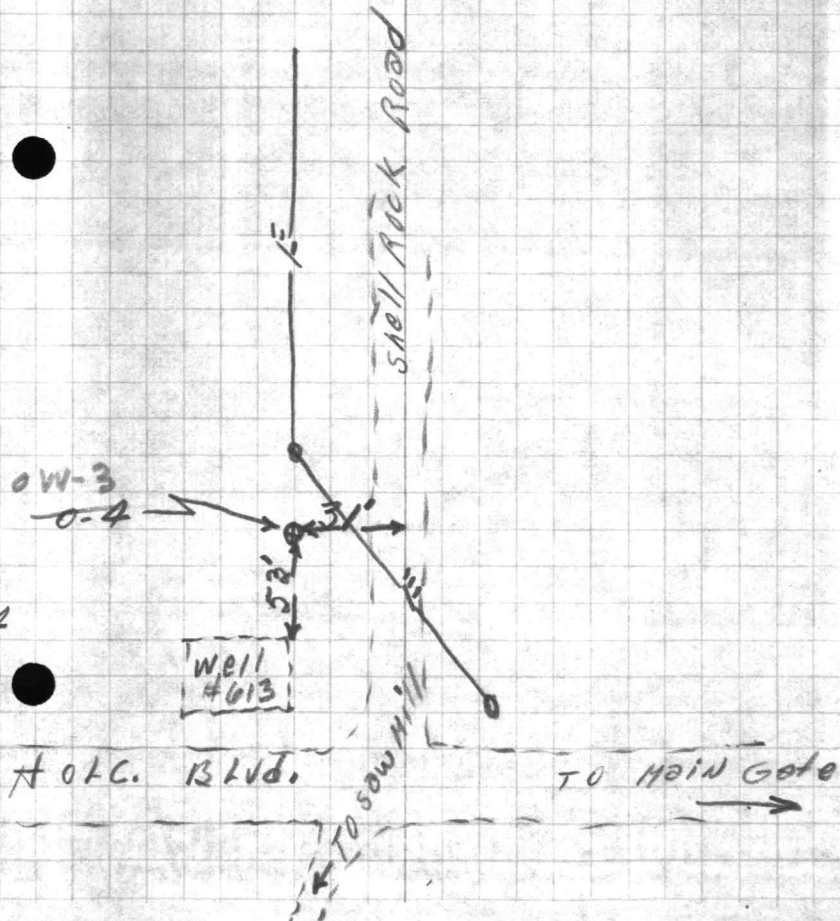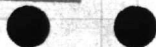

U.S. No.

WEATHER
CLEAR
WINDY
TEMP.
MOON
TIDE

FIELD PARTY
IN CHARGE
INSTRUMENT

NOTE
TACK READ
NAME OF BOAT
NAME OF BOY
NAME OF BOY

FOOTING
TACK CHECKED BY
SIGHTING

STATION
DATE
TIME
MILES
SPEED
DIRECTION

VALUABLE

RETURN TO
PUBLIC WORKS
OFFICE
CAMP LEJEUNE
NORTH CAROLINA

SUBJECT LOCATION & FLOOR
BLDG. # 1927 NEAR
WELL HOUSE # 617
SAWMILL AREA


FIELD PARTY
DENNIS IN CHARGE
INSTRUMENT _____
NOTES _____
TAPE READ _____
TAPE OR ROD _____
TAPE OR ROD _____
INSTRUMENT NO. _____
TAPE NO. _____

WEATHER
CLEAR _____ SNOW _____
CLOUDY _____ HOT _____
WINDY _____ MODERATE _____
RAIN _____ COLD _____
FAIR _____ FOG _____

FIGURED BY _____ SHEET 1 of 2
NOTES CHECKED BY _____
PLOTTED BY _____ DATE 1-14-58

FILE No. 120-R

Quad. No. _____

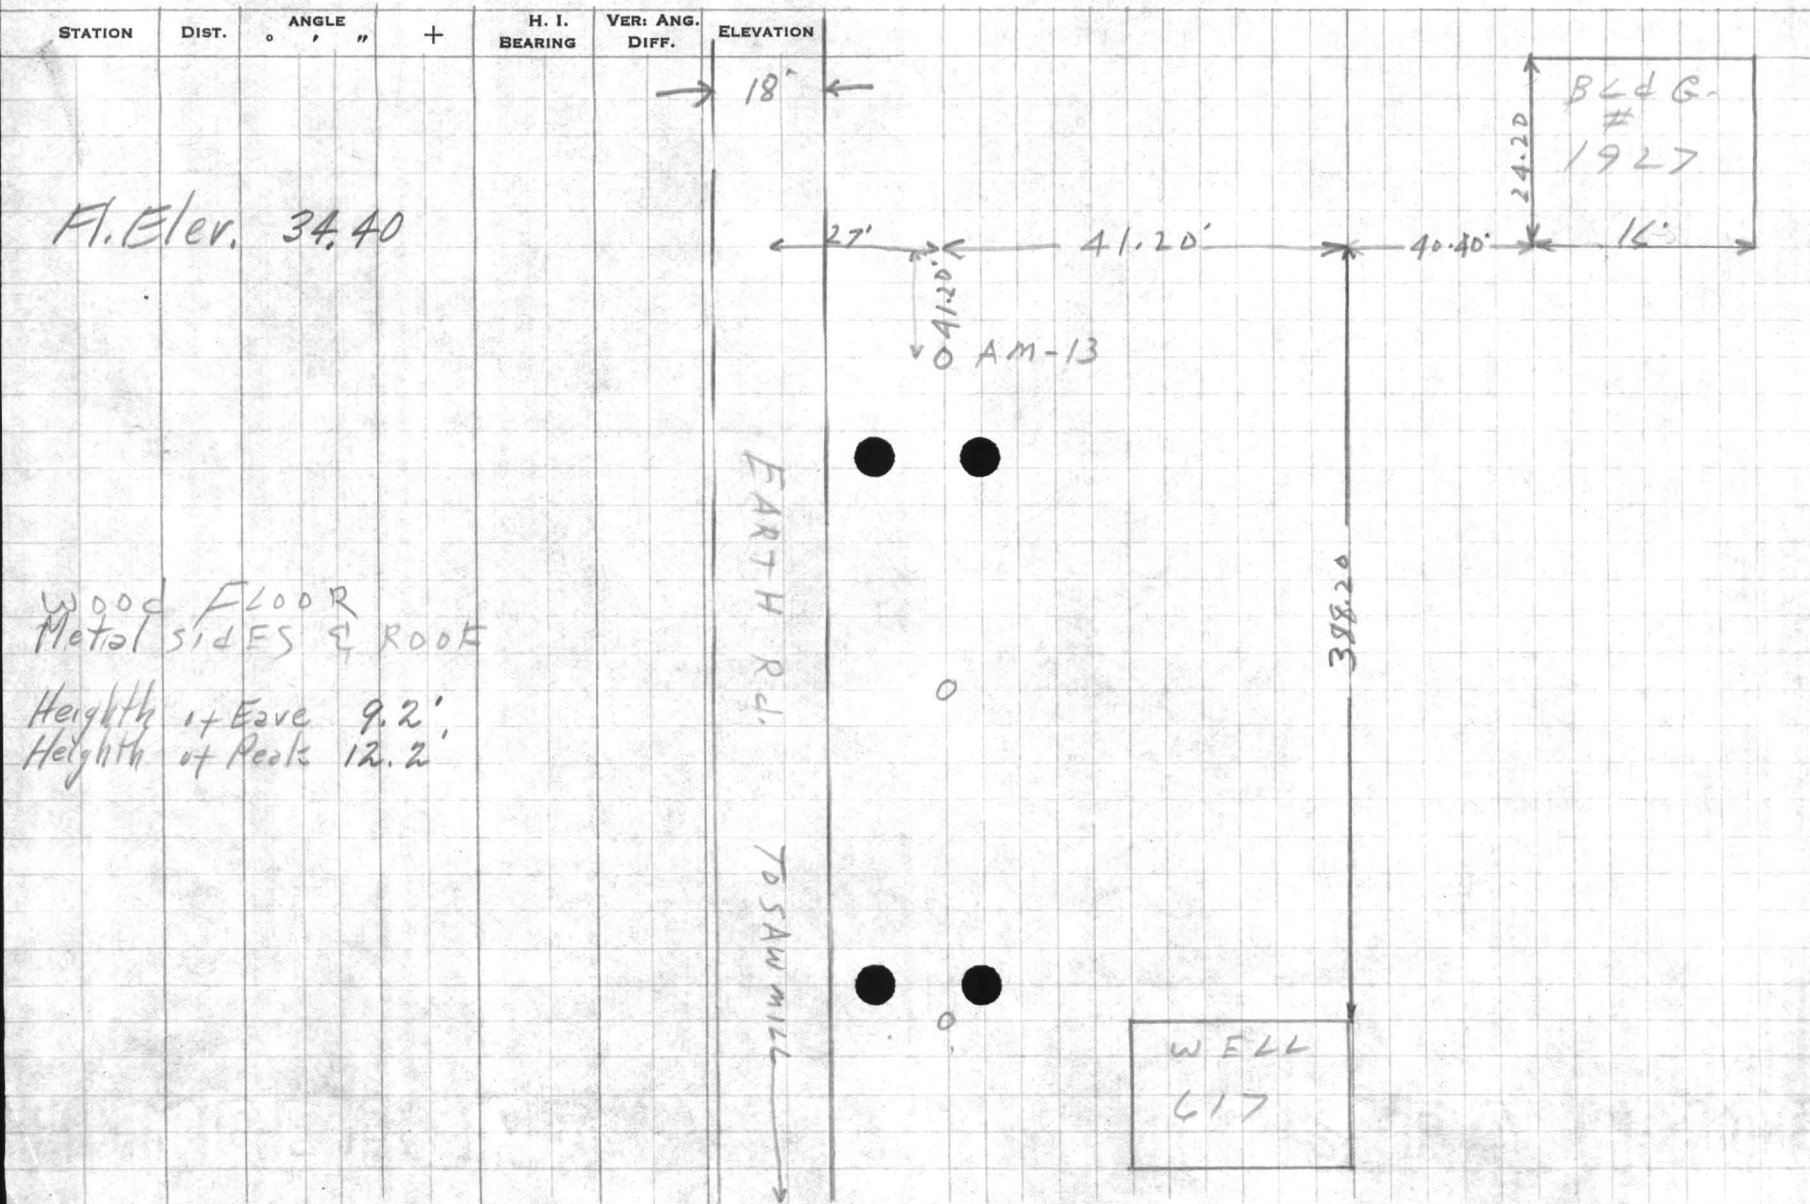

UNITED STATES
DEPARTMENT OF AGRICULTURE
BUREAU OF PLANT INDUSTRY
WASHINGTON, D. C.

SUBJECT
PLANT

DATE AND TIME OF OBSERVATION
PLACE AND ELEVATION

FIELD PARTY
LEADER
MEMBERS
LOCALITY
COUNTRY
STATE
COUNTY
TOWNSHIP
SECTION
RANGE
TERRITORY

WEATHER
TEMPERATURE
WIND
HUMIDITY
CLOUDS
MOON
STARS
PLANETS
COMETS
METEORS

PLANT
SPECIES
VARIETY
CULTIVAR
COLLECTOR
DATE
TIME