

VALUABLE

SUBJECT: Relocation of Water Tank
and Elevation of Same
(Reg. Area #5)


RETURN TO
 CARR & J. E.
 GREINER CO.
 JACKSONVILLE,
 N. C.

FIELD PARTY
Powers IN CHARGE
E. Moore INSTRUMENT
 _____ NOTES
Ellis TAPE READ
Allen TAPE OR ROD
 _____ TAPE OR ROD
 INSTRUMENT NO. _____
 TAPE NO. _____

WEATHER
 CLEAR _____ SNOW _____
 CLOUDY _____ HOT _____
 WINDY _____ MODERATE _____
 RAIN _____ COLD _____
 FAIR _____ FOG _____
 FIGURED BY _____
 NOTES CHECKED BY _____
 PLOTTED BY _____

FILE No. _____
 FLDR. No. _____
 SHEET 1 of 1
 DATE 5-2 1942

STATION	DIST.	ANGLE ° ' "	+	H. I.	VER. ANG. DIFF.	ELEVATION
BM Bldg 5-29		4 58		29 022		24 442
TP		5 27		32 432	1 86	27 162
VOID						
Water Tank Relocation (Ground)		4 9		27 5		
TP		1 92		29 082	5 27	27 162
BM #623				7 09		21 992
BM for Bldg #5-29		5 04		29 482		24 442
TP		5 69		32 482	2 69	26 792
New Location		4 9		27 6		
TP		2 87		29 662	5 69	26 792
BM for Bldg #5-29				5 22		24 442

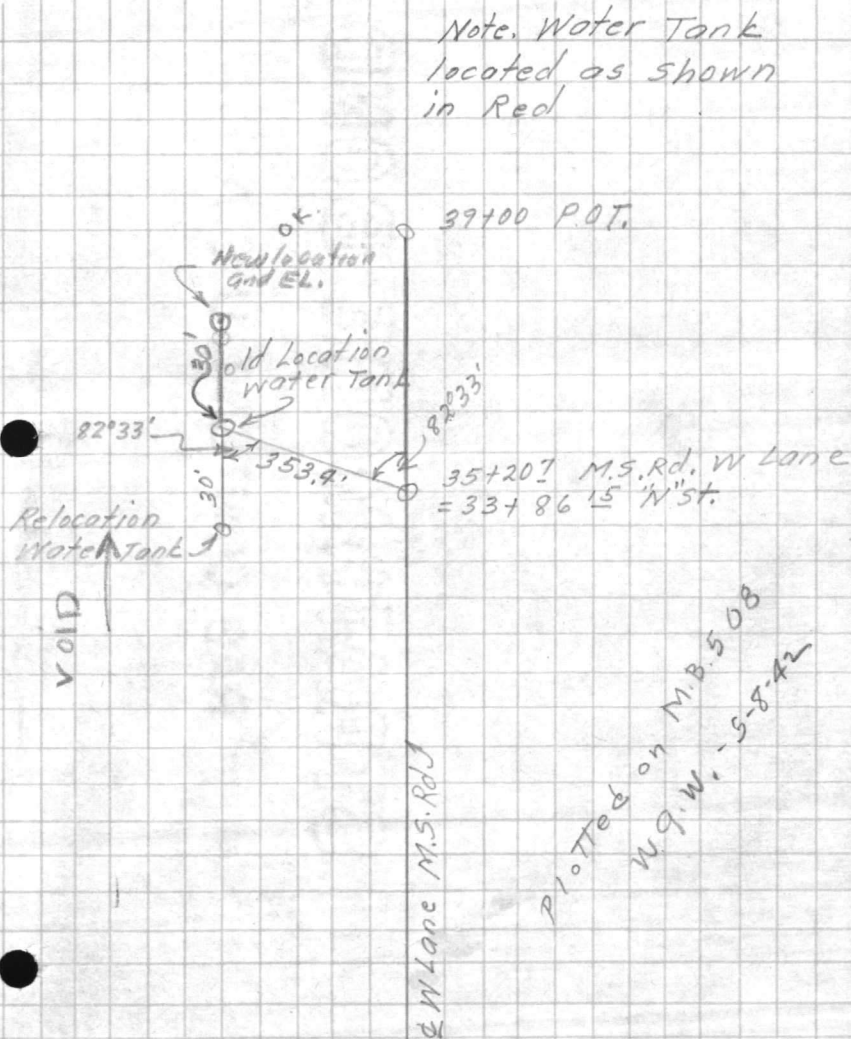

LINE NO. _____
DATE _____ 19__

WEATHER
CLEAR _____
WIND _____
MOON _____
TEMP _____
HUMID _____
PRESS _____
STATE _____

STATION NO. _____
ELEVATION _____
TIME _____
DATE _____

STATION NO. B 0 11

HAS QUANTITY

ELEVATION

DATE

SUBJECT

AVAILABLE