

VALUABLE

SUBJECT _____

RETURN TO
PUBLIC WORKS
OFFICE

CAMP LEJEUNE
NEW RIVER, N. C.

FIELD PARTY

____ IN CHARGE
____ INSTRUMENT
____ NOTES
____ TAPE READ
____ TAPE OR ROD
____ TAPE OR ROD
____ INSTRUMENT NO.
____ TAPE NO.

WEATHER

CLEAR SNOW
CLOUDY HOT
WINDY MODERATE
RAIN COLD
FAIR FOG

FILE No.

FLDR. No.


FIGURED BY _____ SHEET _____

NOTES CHECKED BY _____

PLOTTED BY _____ DATE _____ 19__

Quad. No. 160 B1 & B2

STATION	DIST.	ANGLE "	+	H. I.	VER. ANG. DIFF.	ELEVATION
Fl. Elev.			1.7	32.0		30.3
8" x 4" Tee		"Water"				
= 0+00 f" line to Infirmary						
0+56				9.7		22.3
1+73 Inlet at Bldg.				7.9		24.1
Inlet of Pipe				11.52		20.5
Outlet				12.6		19.4

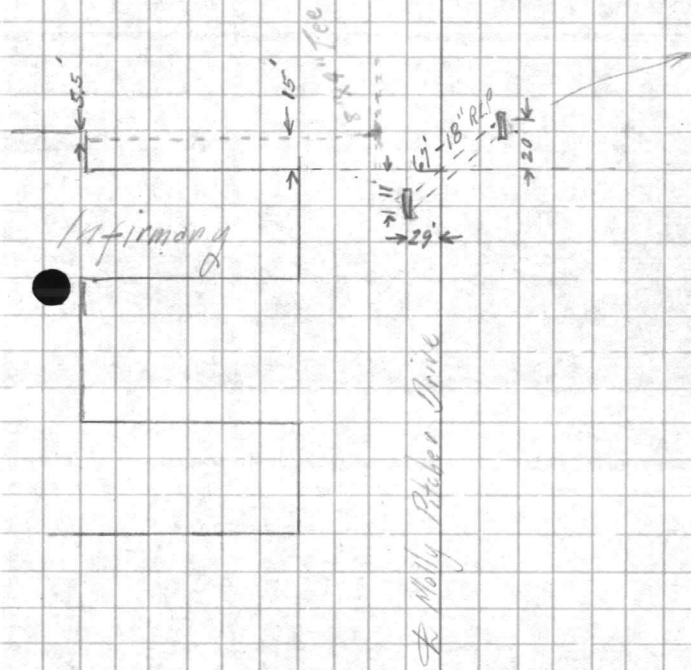

M. A. R.

Plotted 4/17/43
WRC.

