



- Notes:
- See Site Planning Drawings 33-20, Sheets 1 and 2 for planting of ornamental trees and shrubbery.
 - All planting to be in accordance with the T-1 Specifications except as modified in seeding specifications letter, Morris to Coffey, June 26, 1958.
 - Farm Road to be 14' wide with a 10' surface. Surfacing to be either slag from the steam plant applied at the rate of 800 cu.yds. per mile, or crushed stone according to sect 205 at the rate of 500 cu.yds. per mile. Details of location and drainage by field.
 - GRASS BARRIER; To prevent the bermuda grass from spreading into the plant beds, a light galvanized steel barrier is to be placed between the shrub and grass areas and in a 4-foot diameter around each tree. The barrier is not required when shrubbery is adjacent to roads, curbs or sidewalks. See detail, this drawing.
 - Prior to planting operations, the entire area shall be shaped to conform to the grades shown on the plans.
 - Field to locate and construct terrace ditches as required to aid in controlling erosion.
 - Areas sprigged with Bermuda that has died to be replanted. Specs. for type of grass etc. later.
 - All areas designated for planting in Ky. 31 fescue grass shall have the soil prepared in time to permit seeding to be completed not later than Sept. 15, 1958. Specifications for grassing are as follows - Fertilizer: 15-15-15 or equivalent applied uniformly at the rate of 300 lbs per acre and disked into the soil. Seeding: 60 lbs. Ky. 31 fescue grass and 3 lbs. white dutch clover per acre.

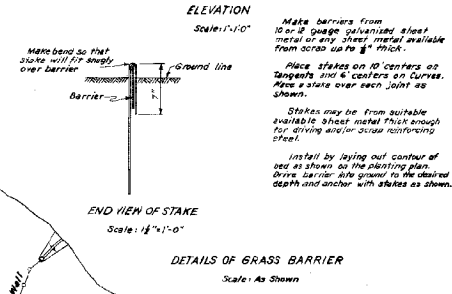

Slopes in these areas that show signs of eroding are to be repaired and terraced before planting.

All constr. bligs removed in areas 18 & 19

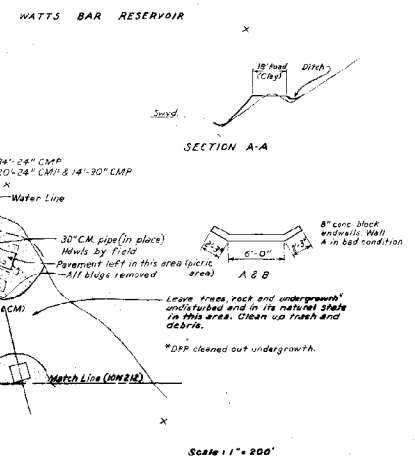

LEGEND

Tifton 127 Bermuda Sprigs (Area A)	(Note 7)
Meadow Grass (Area B)	
Tree Planting (Area C)	
Lespedeza Sericea (Area D)	

DATE	BY	CHKD.	APP.
10/21/58	J.M.	J.M.	J.M.
11/10/58	J.M.	J.M.	J.M.
11/10/58	J.M.	J.M.	J.M.
PROJECT LAYOUT

PLANTING AND SITE IMPROVEMENT - PLAN SHEET 2

KINGSTON STEAM PLANT
TENNESSEE VALLEY AUTHORITY
DIVISION OF DESIGN

SUBMITTED	RECOMMENDED	APPROVED
<i>[Signature]</i>	<i>[Signature]</i>	<i>[Signature]</i>
KNOXVILLE	9-8-54	36 C 4 10N213 R8

RECORD DRAWING AS CONSTRUCTED

7-25-61