




A  
B  
C  
D  
E  
F  
G  
H

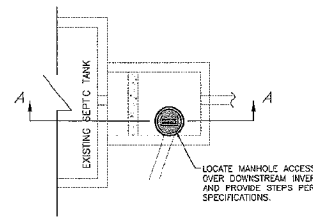

PLAN

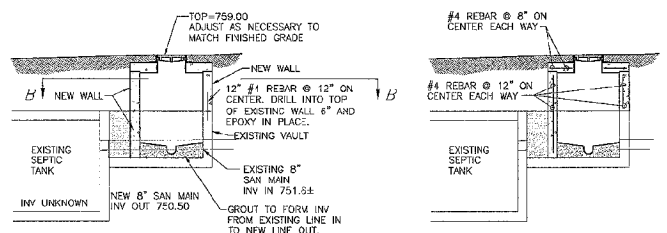

SECTION A-A

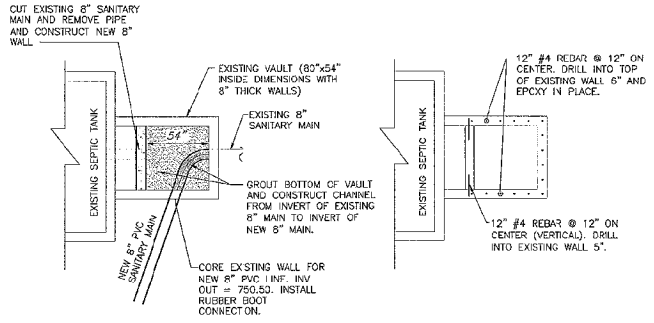

SECTION B-B

NOTE:  
CONTRACTOR SHALL BE RESPONSIBLE FOR ALL MODIFICATIONS REQUIRED TO BRING EXISTING VAULT INTO COMPLIANCE WITH SPECIFICATIONS. FINISHED MANHOLE SHALL PASS TESTING PER SPECIFICATIONS.

REV	DATE	DESC	BY	CHKD	DATE	APPD	JOB	PROJECT	AS SHOWN	36
SCALE: 1"=20'										
YARD										
SITE DETAILS										
DESIGNED BY	DRAWN BY	CHECKED BY	SUPERVISED BY	REVISIONS BY	APPROVED BY	ISSUED ON				
W. H. B. BOWEN	W. H. B. BOWEN	E. J. BOWEN, JR.	M. L. PERRY	R. L. PURNEY	J. C. ADAR					
KINGSTON FOSSIL PLANT TENNESSEE VALLEY AUTHORITY FOSSIL AND HYDRO ENGINEERING										
AUTOCAD R 14	SAR	36	C	10W418-8			R 1			

AS-BUILT 8-12-02  
FOR COMPANION DRAWINGS  
SEE SHEET 10W418-1



319 SIMONS RD, SUITE K • BIRMINGHAM, TENNESSEE 37622 • PH: 888-971-2281

10  
N.T.S.  
MANHOLE #6 DETAIL

TASK COMPLETED BY: REV NO.

PLOT FACTOR: XX  
K.T.V.A.  
C.A.D. DRAWING  
DO NOT ALTER MANUALLY