

RECORD DRAWINGS

TEST EMBANKMENT PROGRAM

KINGSTON FOSSIL PLANT

HARRIMAN, ROANE COUNTY, TENNESSEE

PREPARED FOR

TENNESSEE VALLEY AUTHORITY

PREPARED FOR

PREPARED BY



VICINITY MAP
1000 0 2000 4000 FEET
GRAPHIC SCALE



Stantec Consulting Services Inc.
1409 N. Forbes Rd.
Lexington, Kentucky
40511-2050
Tel. 859.422.3000
Fax 859.422.3100
www.stantec.com



INDEX OF SHEETS

1	COVER SHEET
2	INITIAL SITE CONDITIONS
3	BASE OF WORKING PLATFORM
4	INTERIM CONFIGURATION 1
5	TOP OF WORKING PLATFORM
6	INTERIM CONFIGURATION 2
7	INTERIM CONFIGURATION 3
8	INTERIM CONFIGURATION 4
9	INTERIM CONFIGURATION 5
10	INTERIM CONFIGURATION 6
11	INTERIM CONFIGURATION 7
12	FINAL GRADING PLAN

RECORD DRAWING

	<p>YARD</p> <p>DREDGE CELL</p> <p>TEST EMBANKMENT PROGRAM</p> <p>COVER SHEET</p>													
	<table border="0" style="width: 100%;"> <tr> <td>DESIGNED BY:</td> <td>DRAWN BY:</td> <td>CHECKED BY:</td> <td>SUPERVISED BY:</td> <td>REVIEWED BY:</td> <td>APPROVED BY:</td> <td>ISSUED BY:</td> </tr> <tr> <td>K. LINDQUIST</td> <td>D. GRAHAM</td> <td>K. LINDQUIST</td> <td>M. STEELE</td> <td>M. STEELE</td> <td>M. STEELE</td> <td>T. JOHNSON</td> </tr> </table> <p style="text-align: center;">KINGSTON FOSSIL PLANT TENNESSEE VALLEY AUTHORITY FOSSIL AND HYDRO ENGINEERING</p>	DESIGNED BY:	DRAWN BY:	CHECKED BY:	SUPERVISED BY:	REVIEWED BY:	APPROVED BY:	ISSUED BY:	K. LINDQUIST	D. GRAHAM	K. LINDQUIST	M. STEELE	M. STEELE	M. STEELE
DESIGNED BY:	DRAWN BY:	CHECKED BY:	SUPERVISED BY:	REVIEWED BY:	APPROVED BY:	ISSUED BY:								
K. LINDQUIST	D. GRAHAM	K. LINDQUIST	M. STEELE	M. STEELE	M. STEELE	T. JOHNSON								

PLOT DATE: 04/23/10 USER: JONSON, TRACY V:\158\ACTIVE\178680\ENVIRONMENTAL DRAWINGS\TEST_EMBANKMENT\RECORD D\027-01-ROWING

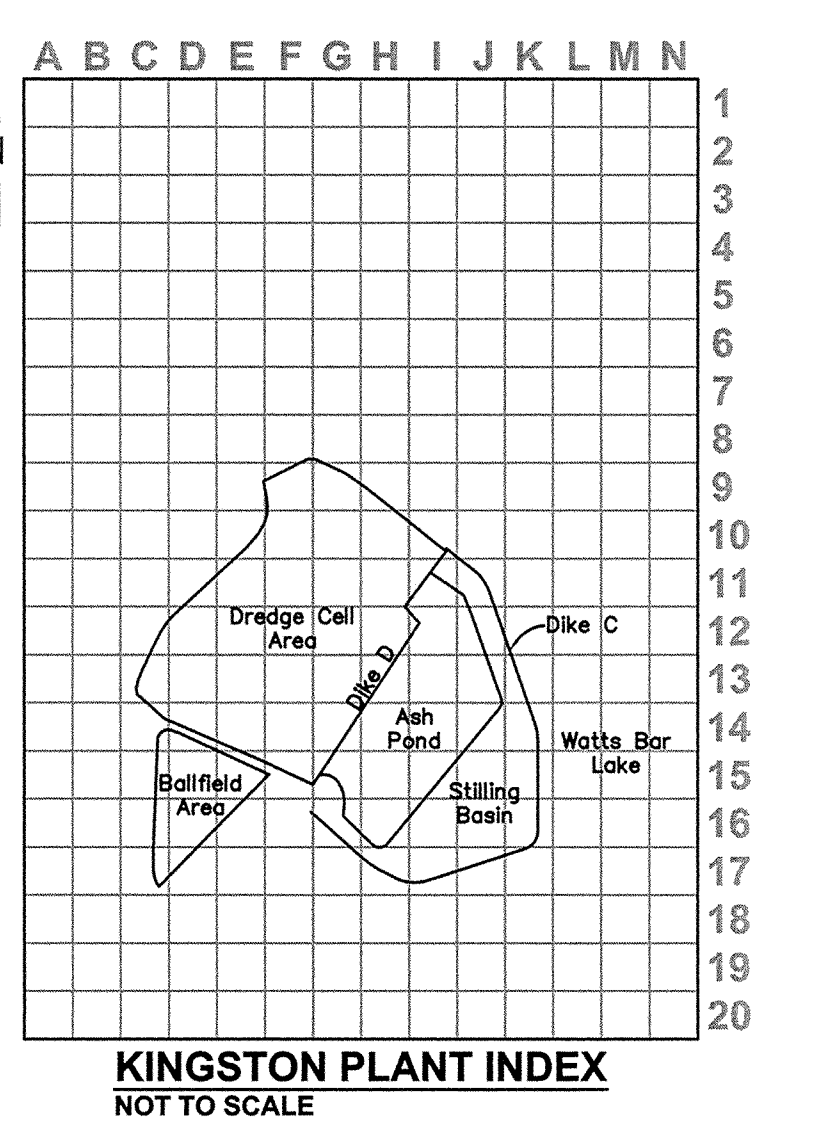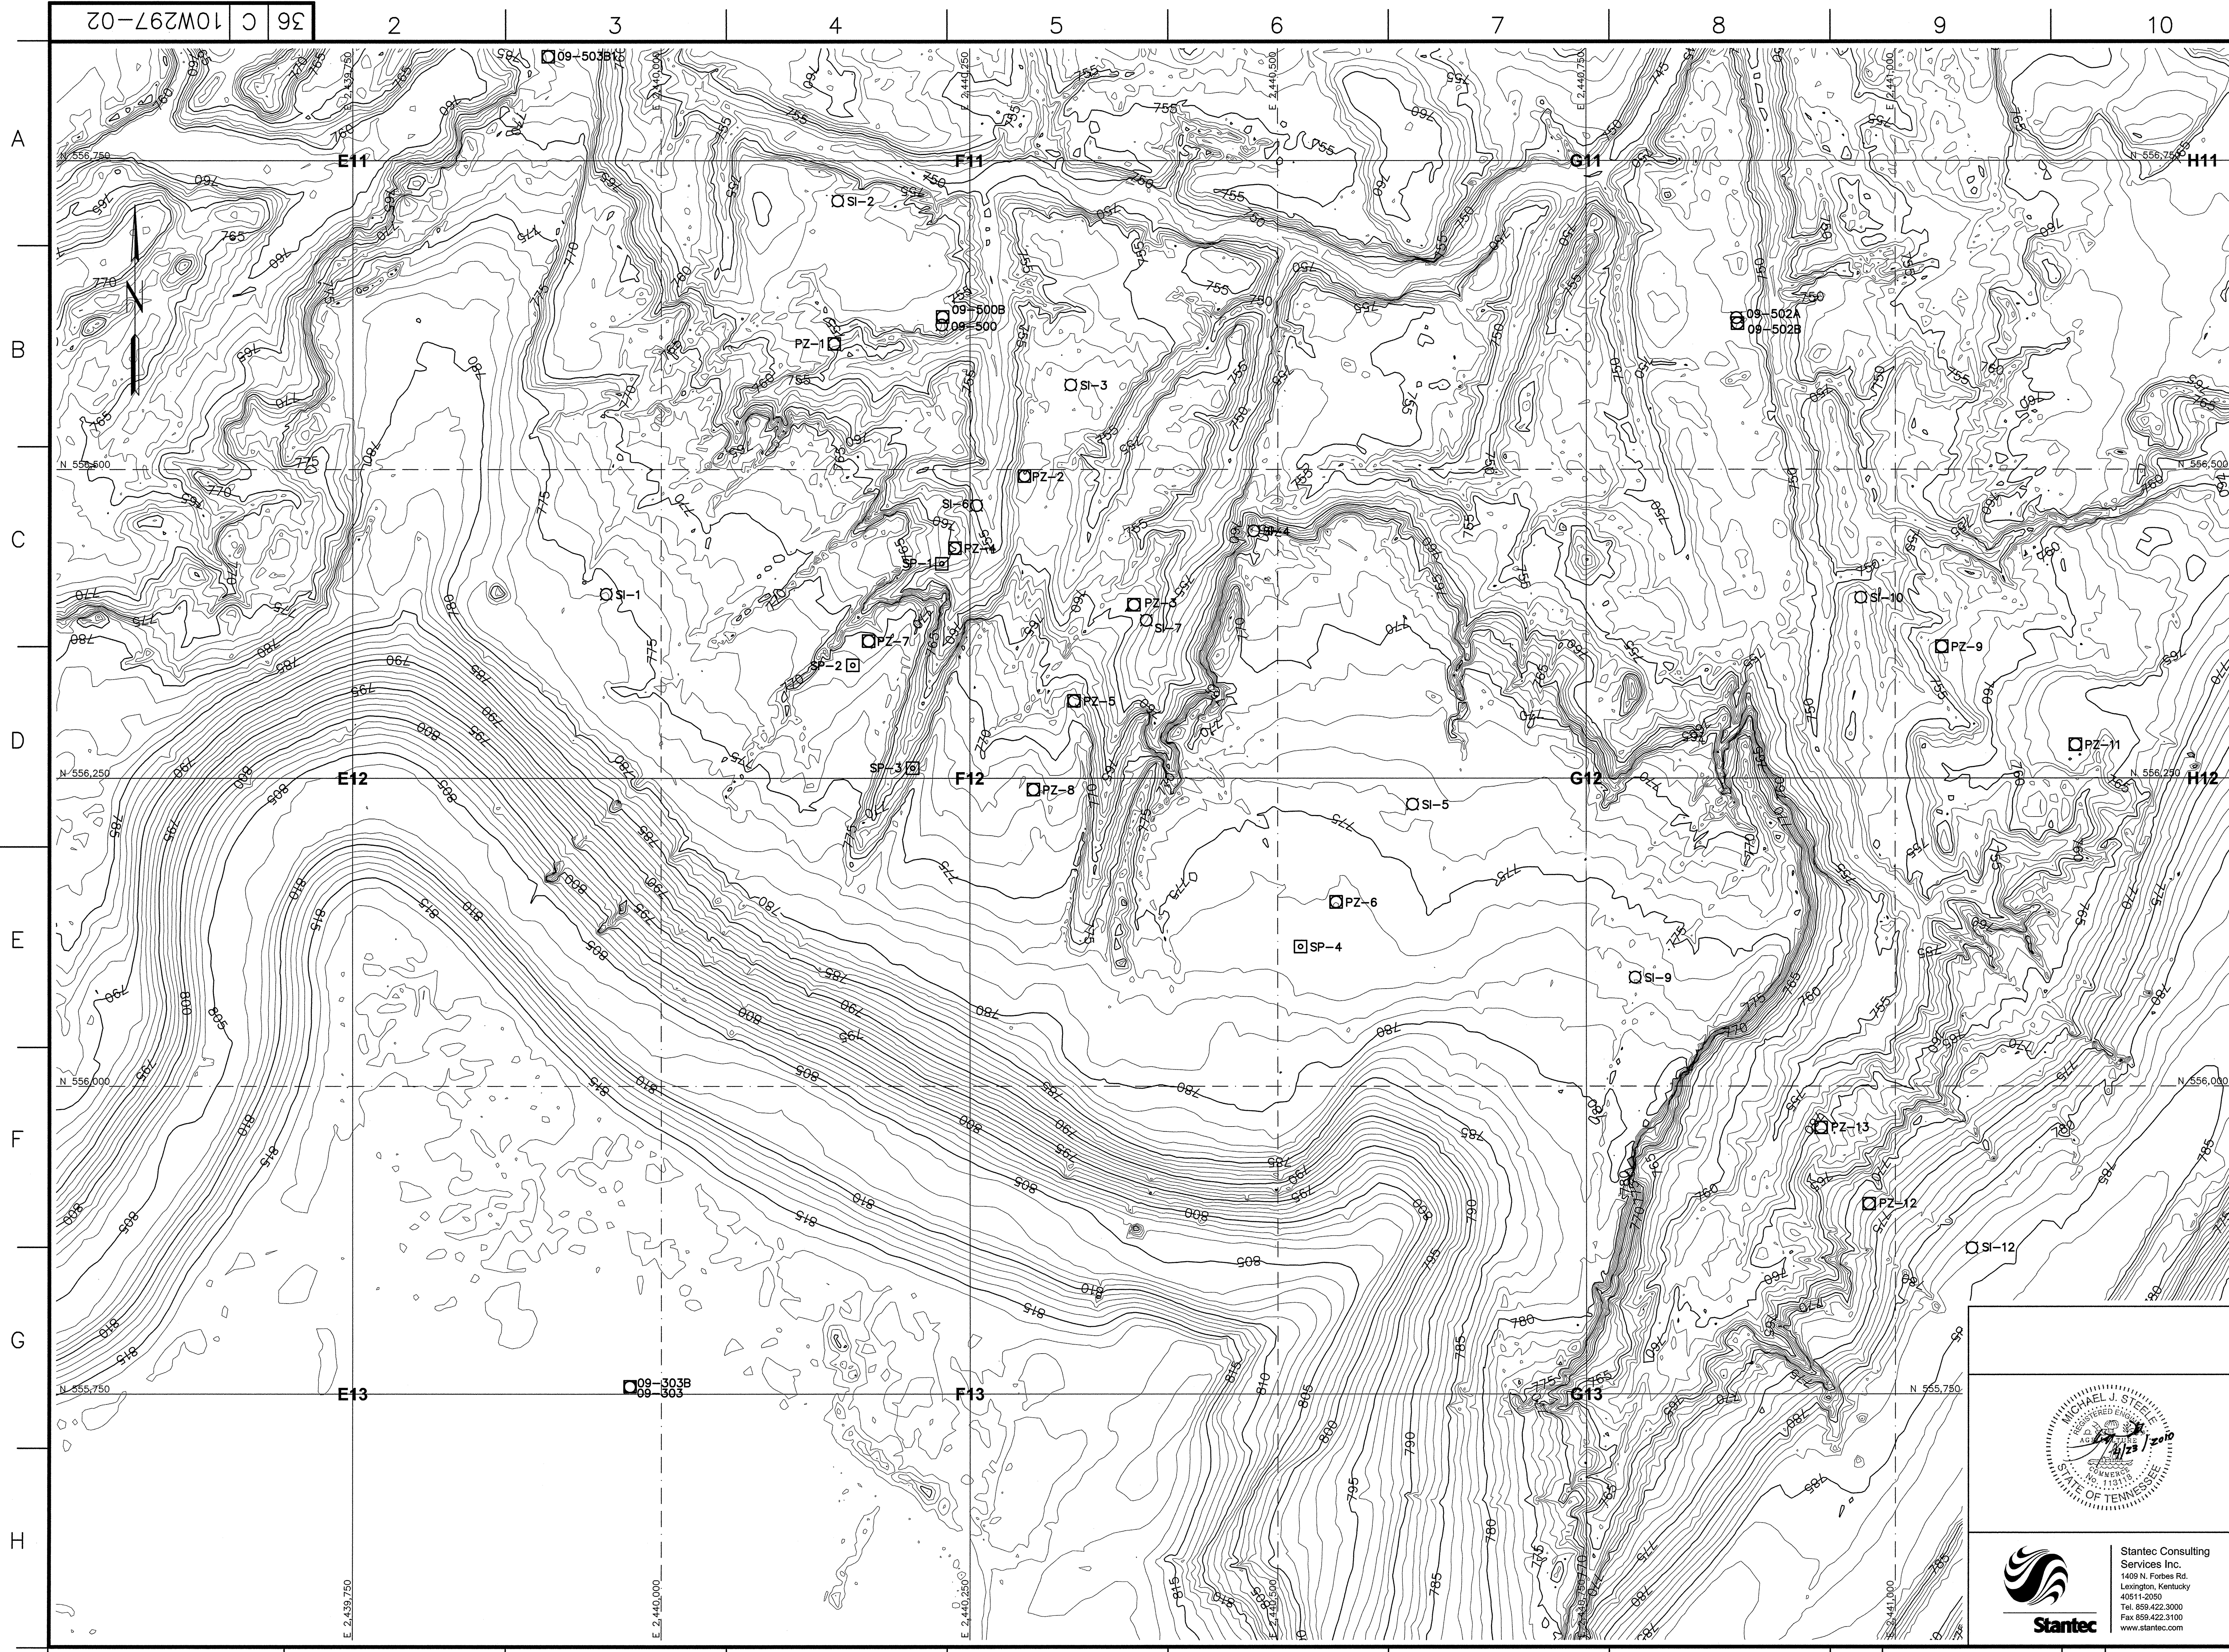

NOTE:
 Topographic mapping was generated from a LIDAR survey performed on June 12, 2009 by Tuck Mapping Solutions, Inc.



- LEGEND**
- SI-1 Slope inclinometer (SI)
 - PZ-2 Piezometer (PZ)
 - SP-3 Settlement Platform (SP)
 - Index Contour (June 12, 2009)
 - Intermediate Contour (June 12, 2009)

RECORD DRAWING

25 0 50 100 FEET
 GRAPHIC SCALE: 1" = 50'
 CONTOUR INTERVAL = 1 FOOT

Stantec Consulting Services Inc.
 1409 N. Forbes Rd.
 Lexington, Kentucky
 40511-2050
 Tel. 859.422.3000
 Fax 859.422.3100
 www.stantec.com

REV	NO.	DATE	DSGN	DRWN	CHKD	SUPV	RWMD	APPR	ISSD	PROJECT	AS COMST	ISSD BY
R	0	04/23/10	KDL	DMG	KDL	MJS	MJS	MJS	TJ			
RECORD DRAWING												
SCALE: 1"=50' EXCEPT AS NOTED												
YARD												
DREDGE CELL												
TEST EMBANKMENT PROGRAM												
INITIAL SITE CONDITIONS												
DESIGNED BY:	DRAWN BY:	CHECKED BY:	SUPERVISED BY:	REVIEWED BY:	APPROVED BY:	ISSUED BY:						
K. LINDQUIST	D. GRAHAM	K. LINDQUIST	M. STEELE	M. STEELE	M. STEELE	T. JOHNSON						
KINGSTON FOSSIL PLANT TENNESSEE VALLEY AUTHORITY FOSSIL AND HYDRO ENGINEERING												
AUTOCAD R 2000	DATE	36	C	10W297-02	R 0							

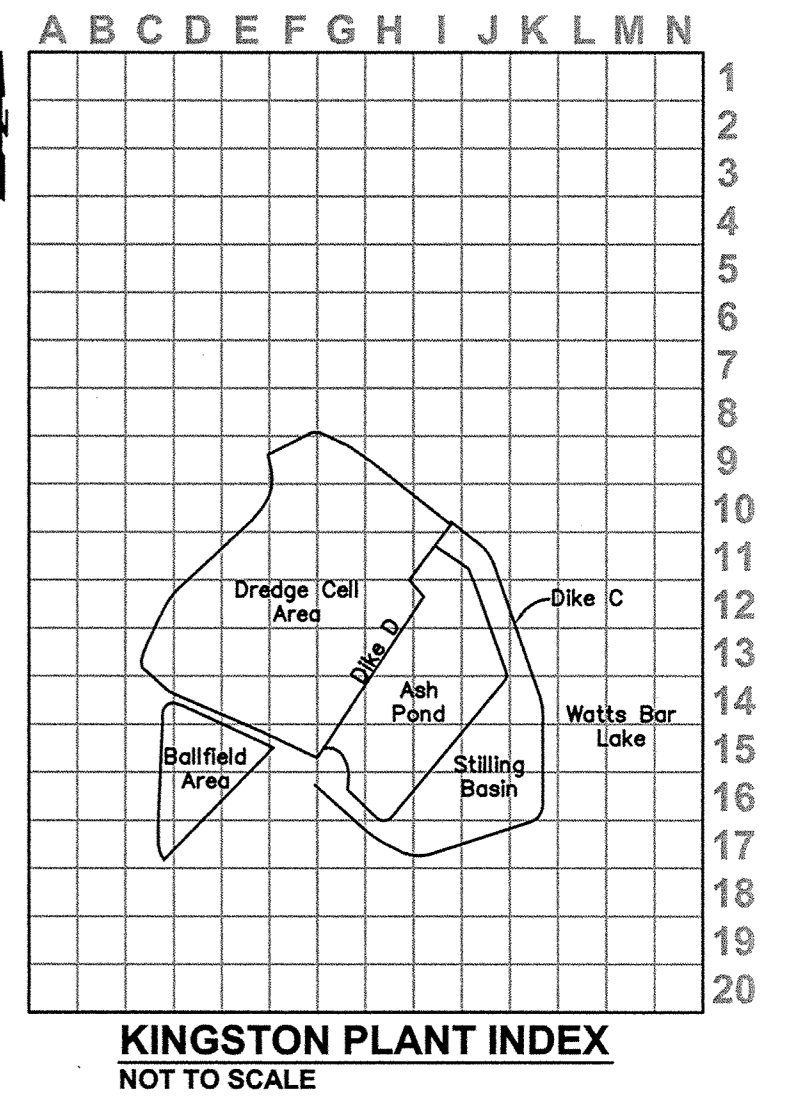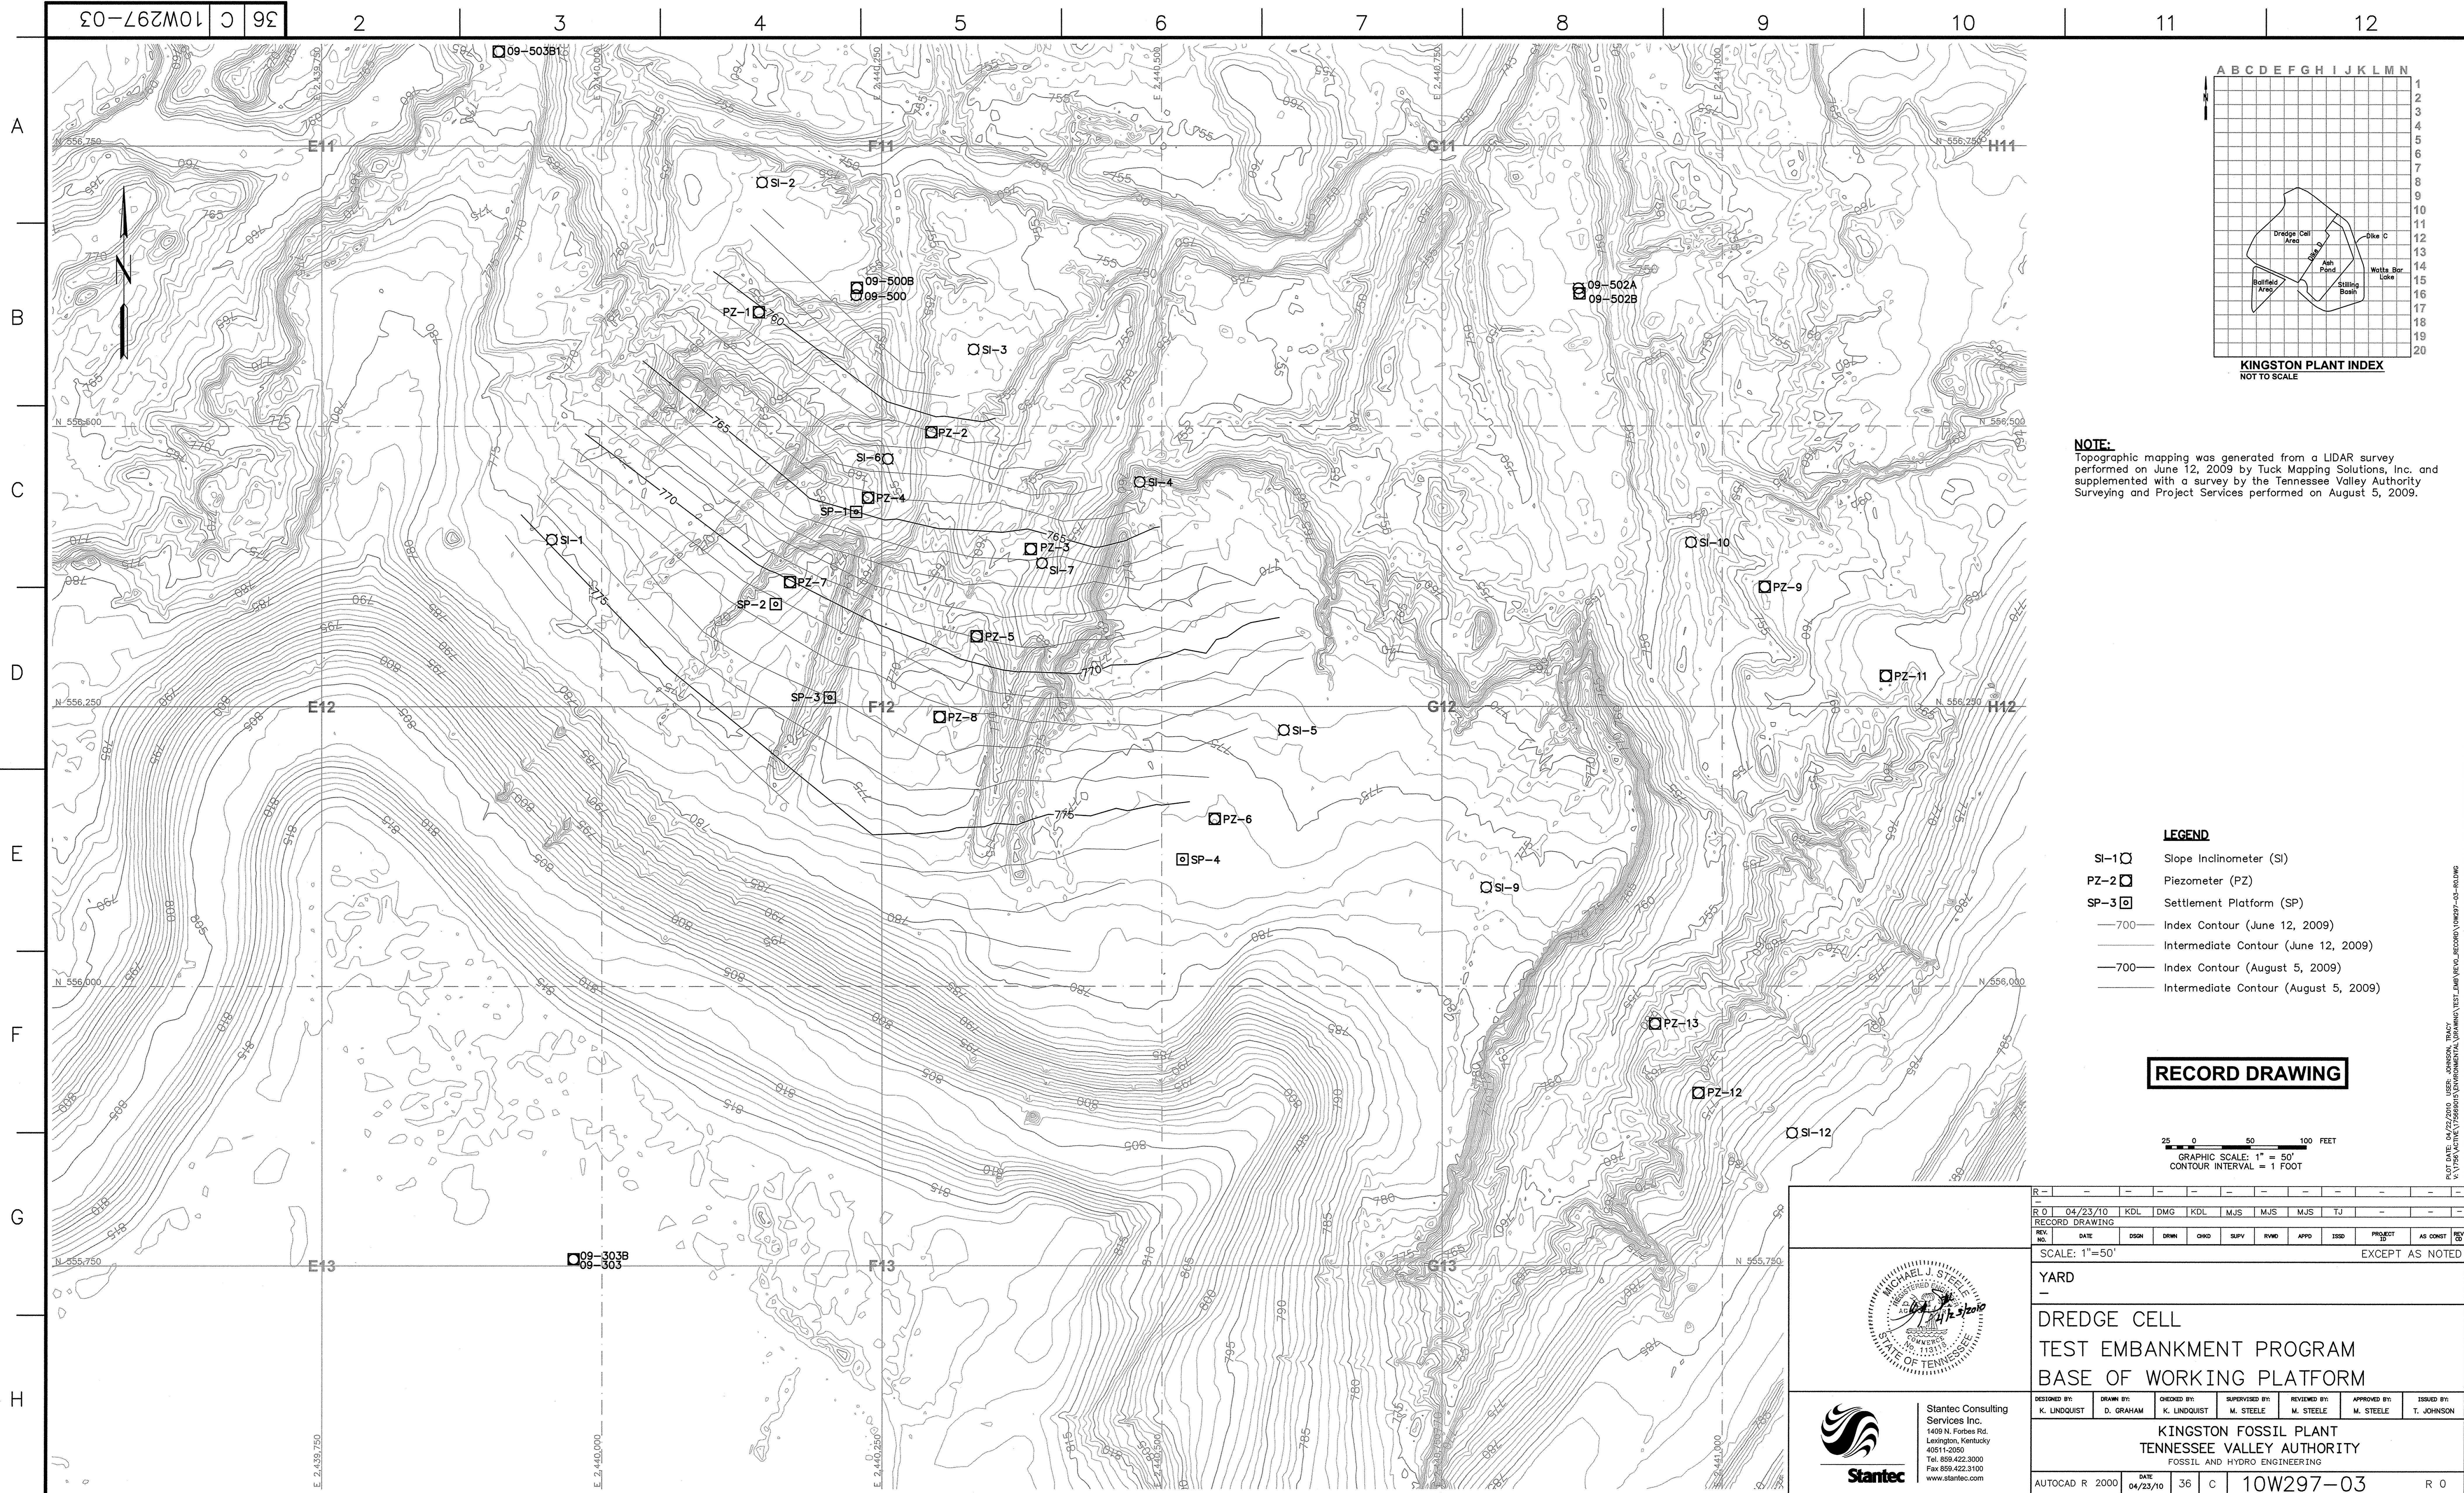


NOTE:
 Topographic mapping was generated from a LIDAR survey performed on June 12, 2009 by Tuck Mapping Solutions, Inc. and supplemented with a survey by the Tennessee Valley Authority Surveying and Project Services performed on August 5, 2009.

- LEGEND**
- SI-1 □ Slope Inclinometer (SI)
 - PZ-2 □ Piezometer (PZ)
 - SP-3 □ Settlement Platform (SP)
 - 700— Intermediate Contour (June 12, 2009)
 - 700— Intermediate Contour (August 5, 2009)



RECORD DRAWING

25 0 50 100 FEET
 GRAPHIC SCALE: 1" = 50'
 CONTOUR INTERVAL = 1 FOOT

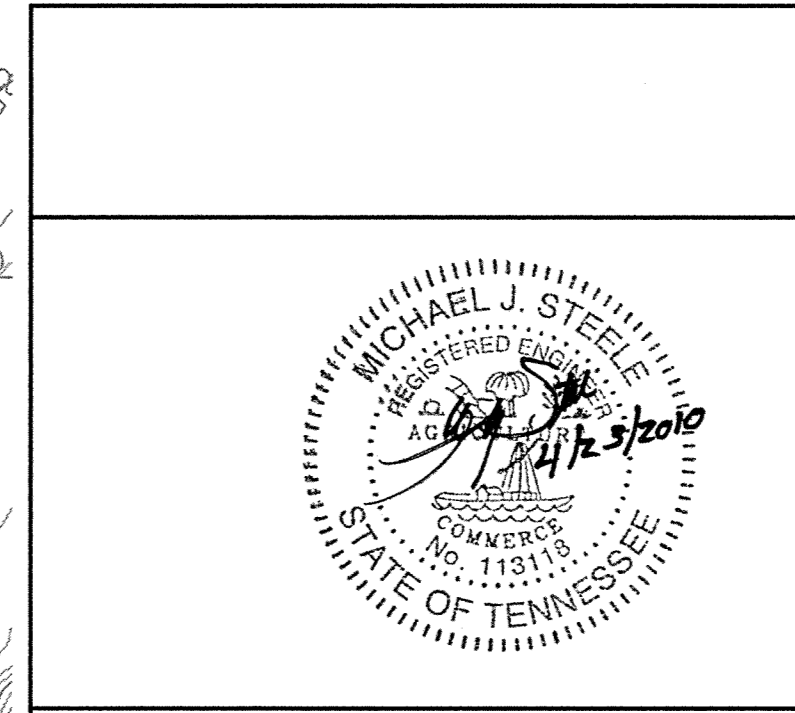

Stantec
 Stantec Consulting Services Inc.
 1409 N. Forbes Rd.
 Lexington, Kentucky 40511-2050
 Tel. 859.422.3000
 Fax 859.422.3100
 www.stantec.com

REV	NO.	DATE	DSGN	DRWN	CHKD	SUPV	RYMD	APPR	ISSD	PROJECT ID	AS CONST	REV
R	0	04/23/10	KDL	DMG	KDL	MJS	MJS	MJS	TJ			
RECORD DRAWING												
EXCEPT AS NOTED												
YARD												
DREDGE CELL												
TEST EMBANKMENT PROGRAM												
BASE OF WORKING PLATFORM												
DESIGNED BY:	DRAWN BY:	CHECKED BY:	SUPERVISED BY:	REVIEWED BY:	APPROVED BY:	ISSUED BY:						
K. LINDQUIST	D. GRAHAM	K. LINDQUIST	M. STEELE	M. STEELE	M. STEELE	T. JOHNSON						
KINGSTON FOSSIL PLANT												
TENNESSEE VALLEY AUTHORITY												
FOSSIL AND HYDRO ENGINEERING												
AUTOCAD R 2000	DATE	36	C	10W297-03	R 0							

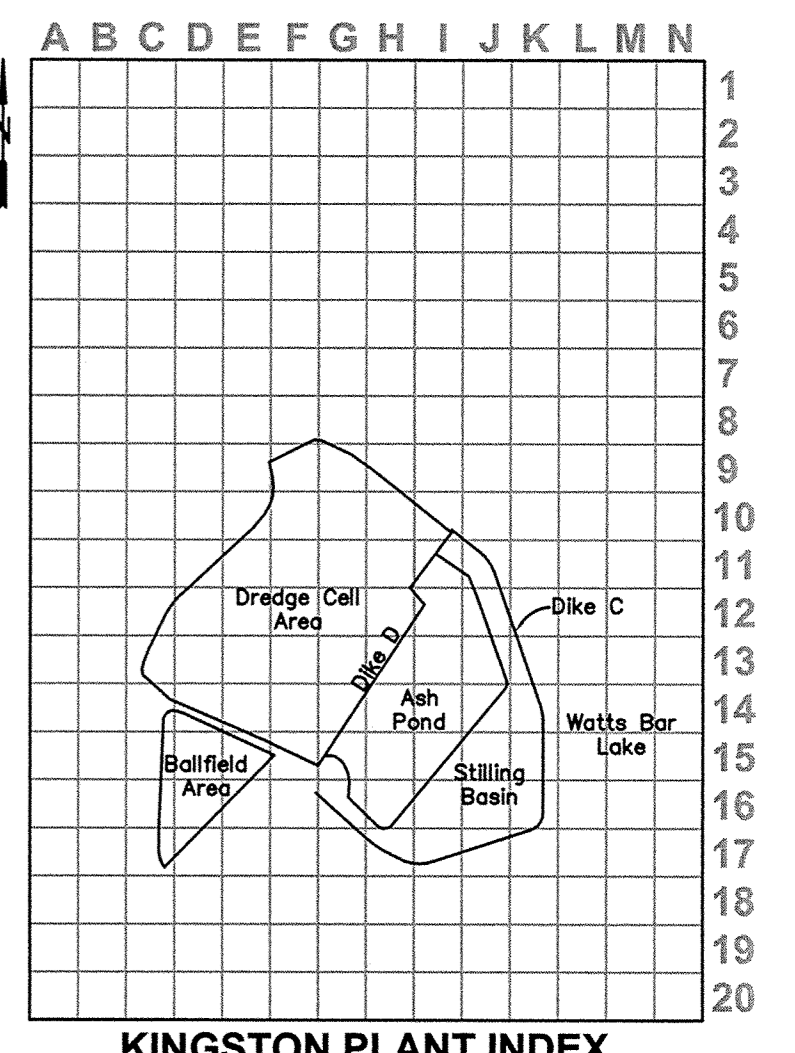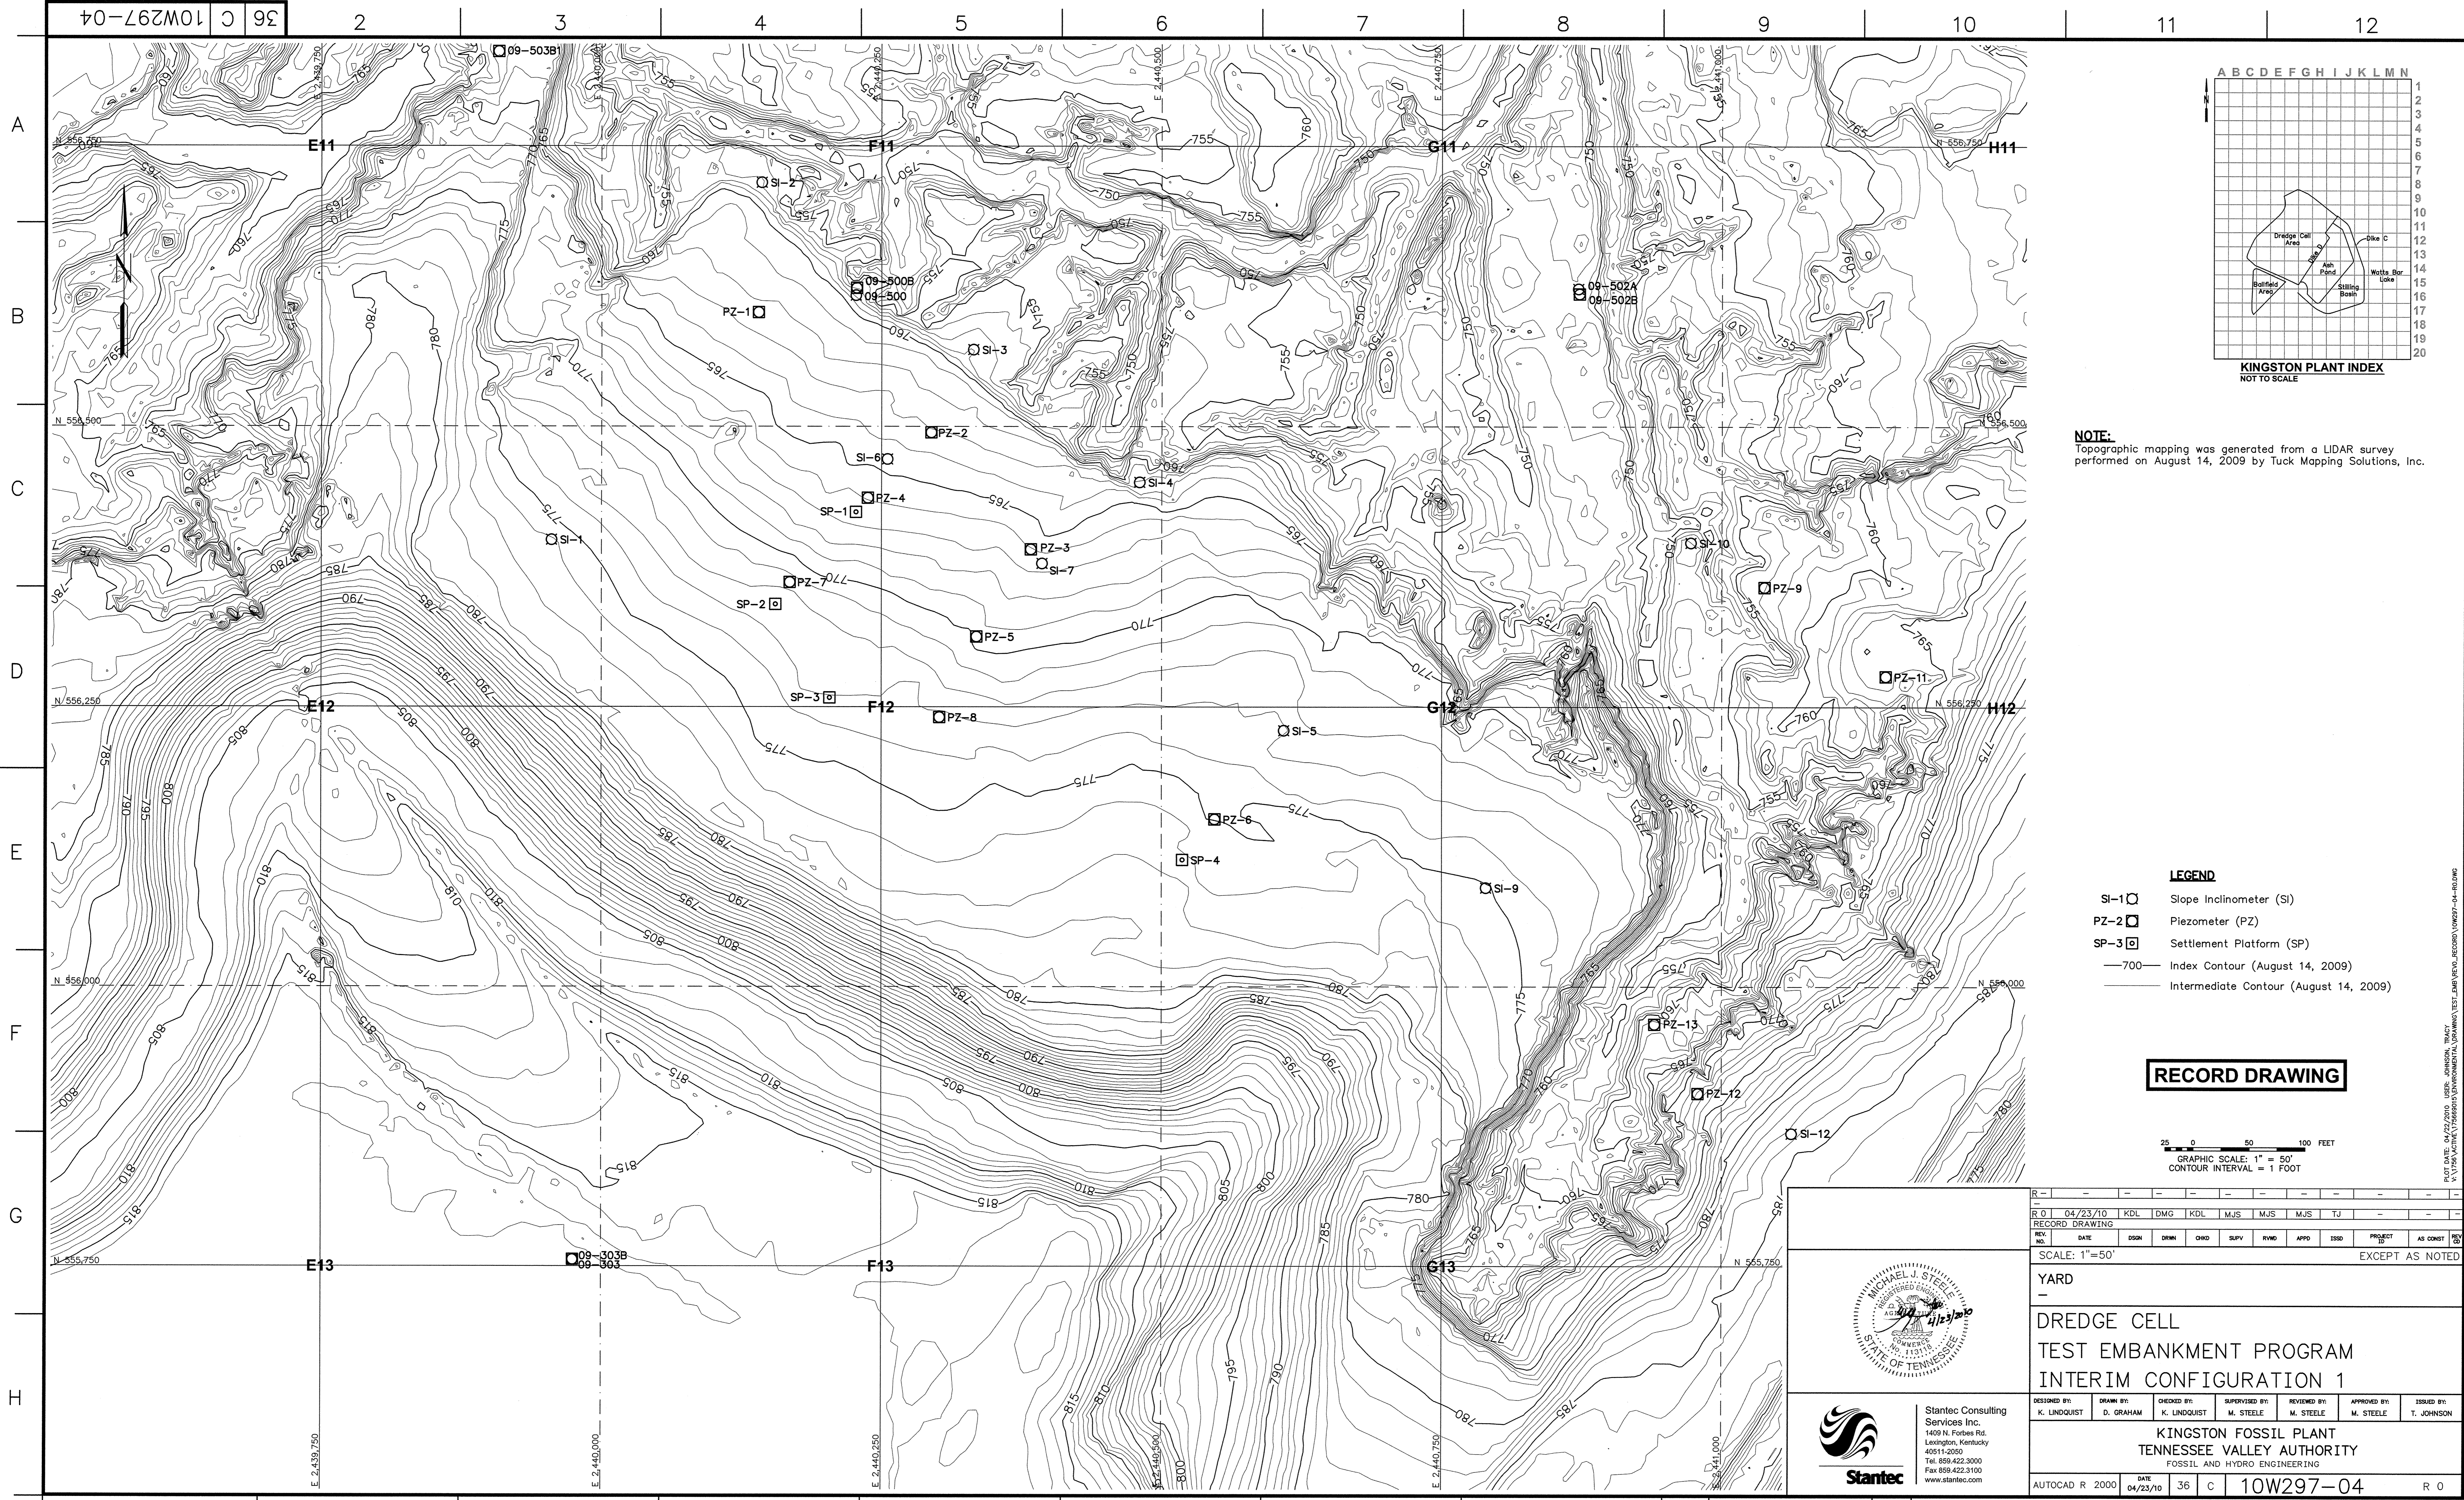



NOTE:
Topographic mapping was generated from a LIDAR survey performed on August 14, 2009 by Tuck Mapping Solutions, Inc.

- LEGEND**
- SI-1 □ Slope Inclinator (SI)
 - PZ-2 □ Piezometer (PZ)
 - SP-3 □ Settlement Platform (SP)
 - 700— Index Contour (August 14, 2009)
 - Intermediate Contour (August 14, 2009)

RECORD DRAWING

25 0 50 100 FEET
GRAPHIC SCALE: 1" = 50'
CONTOUR INTERVAL = 1 FOOT

<p>STANTEC Stantec Consulting Services Inc. 1409 N. Forbes Rd. Lexington, Kentucky 40511-2050 Tel: 859.422.3000 Fax: 859.422.3100 www.stantec.com</p>																																	
<p>REVISIONS</p> <table border="1"> <tr> <th>NO.</th> <th>DATE</th> <th>DSGN</th> <th>DRWN</th> <th>CHKD</th> <th>SUPV</th> <th>RVWD</th> <th>APPD</th> <th>ISSD</th> <th>PROJECT</th> <th>AS CONST</th> <th>REV</th> </tr> <tr> <td>0</td> <td>04/23/10</td> <td>KDL</td> <td>DMG</td> <td>KDL</td> <td>MJS</td> <td>MJS</td> <td>MJS</td> <td>TJ</td> <td></td> <td></td> <td></td> </tr> </table>										NO.	DATE	DSGN	DRWN	CHKD	SUPV	RVWD	APPD	ISSD	PROJECT	AS CONST	REV	0	04/23/10	KDL	DMG	KDL	MJS	MJS	MJS	TJ			
NO.	DATE	DSGN	DRWN	CHKD	SUPV	RVWD	APPD	ISSD	PROJECT	AS CONST	REV																						
0	04/23/10	KDL	DMG	KDL	MJS	MJS	MJS	TJ																									
<p>SCALE: 1"=50' EXCEPT AS NOTED</p>																																	
<p>YARD</p>																																	
<p>DREDGE CELL TEST EMBANKMENT PROGRAM INTERIM CONFIGURATION 1</p>																																	
<p>DESIGNED BY: K. LINDQUIST DRAWN BY: D. GRAHAM CHECKED BY: K. LINDQUIST SUPERVISED BY: M. STEELE REVIEWED BY: M. STEELE APPROVED BY: M. STEELE ISSUED BY: T. JOHNSON</p>																																	
<p>KINGSTON FOSSIL PLANT TENNESSEE VALLEY AUTHORITY FOSSIL AND HYDRO ENGINEERING</p>																																	
<p>AUTOCAD R 2000 DATE: 04/23/10 36 C 10W297-04 R 0</p>																																	

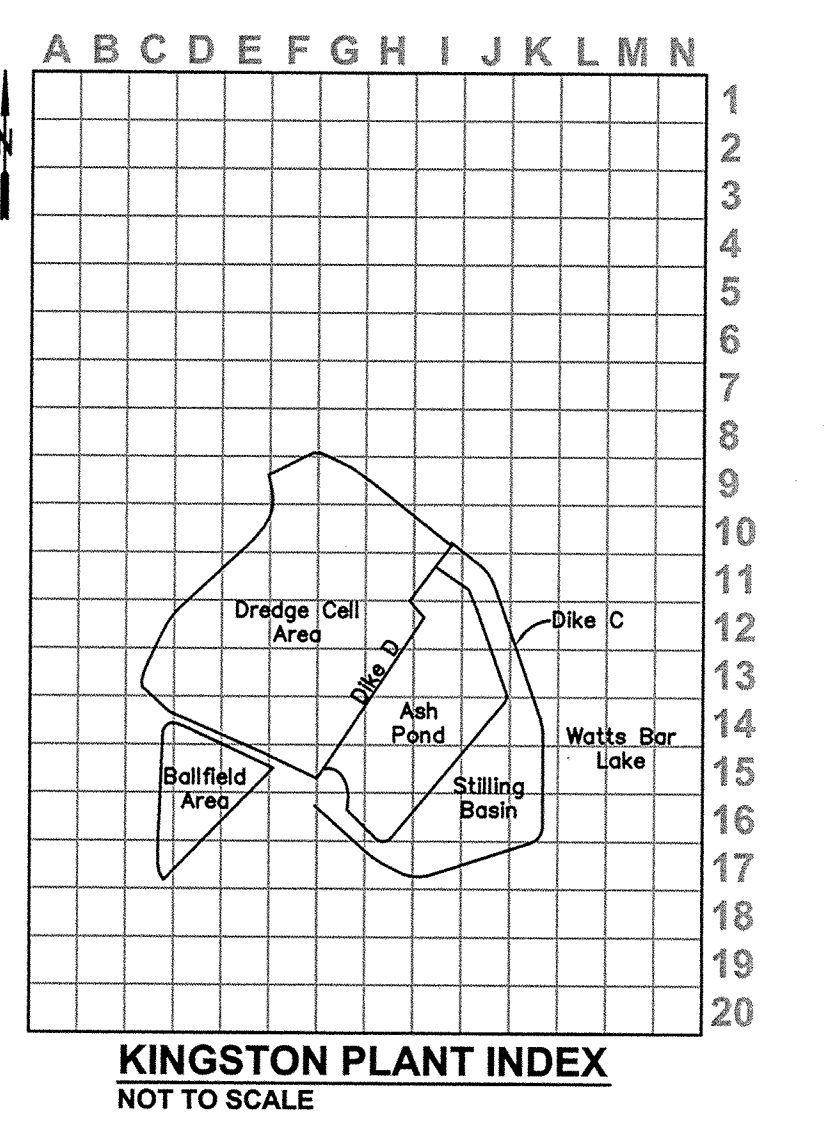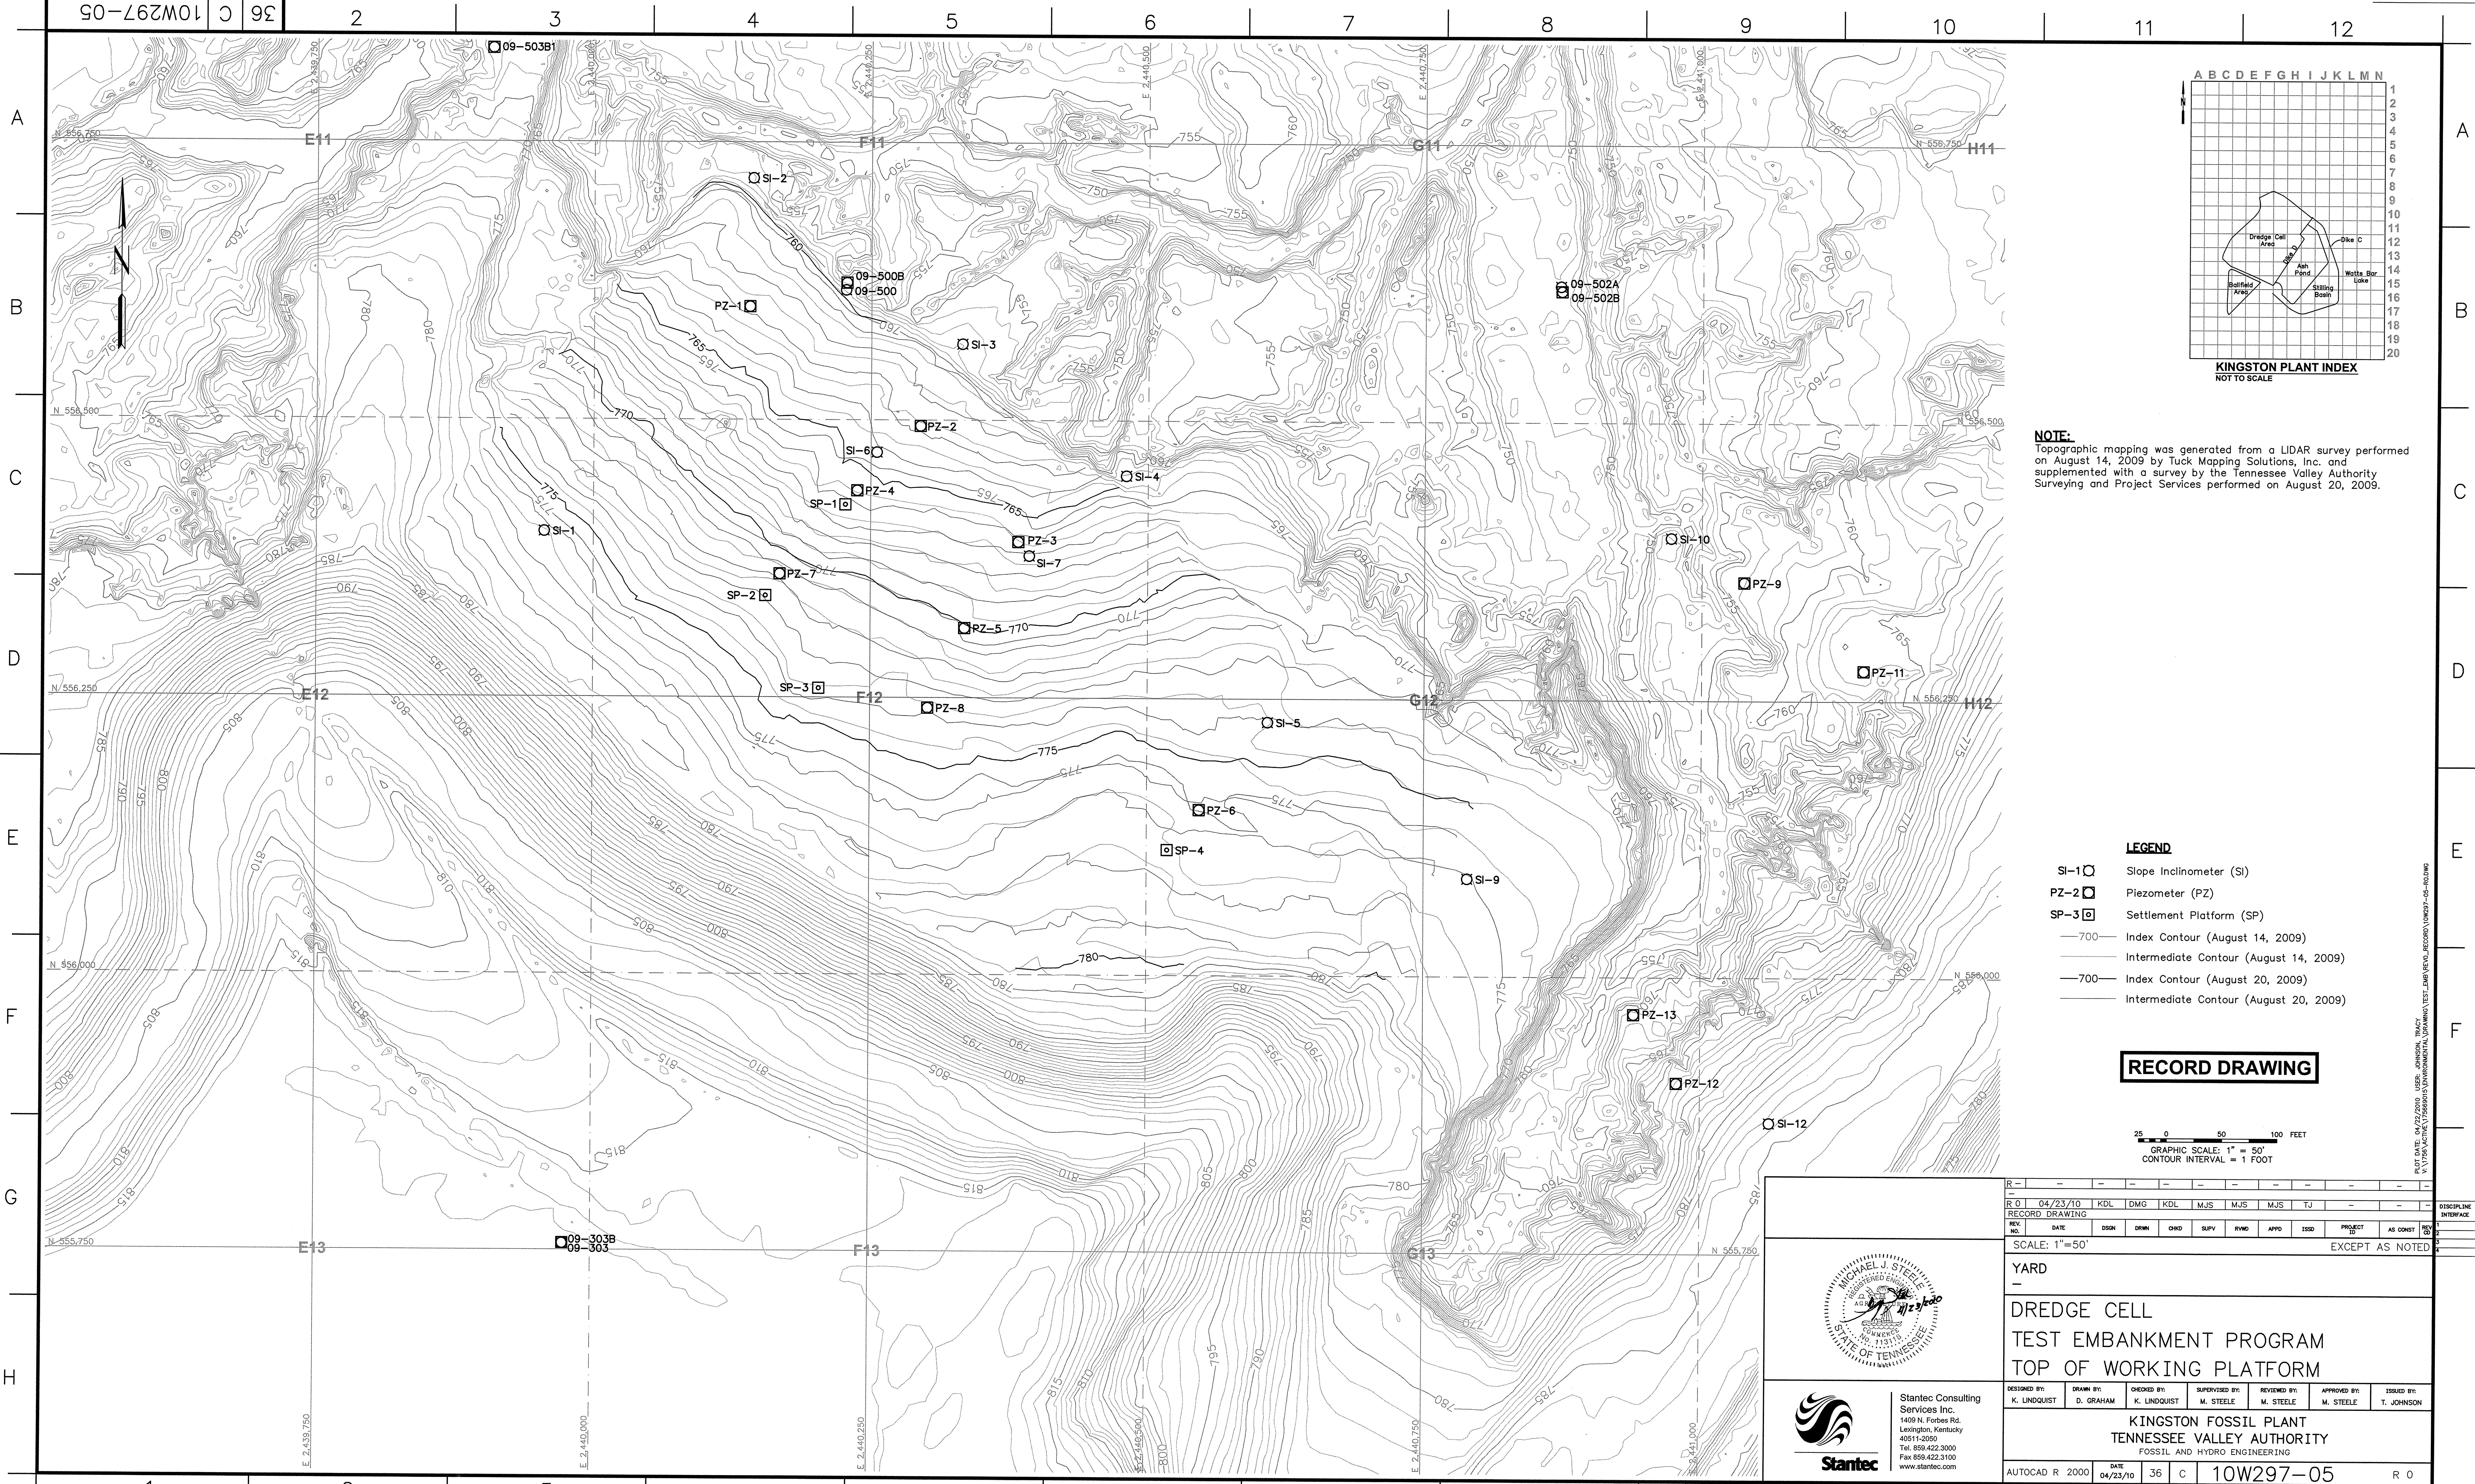



NOTE:
 Topographic mapping was generated from a LIDAR survey performed on August 14, 2009 by Tuck Mapping Solutions, Inc. and supplemented with a survey by the Tennessee Valley Authority Surveying and Project Services performed on August 20, 2009.

- LEGEND**
- SI-1 Slope Inclinator (SI)
 - PZ-2 Piezometer (PZ)
 - SP-3 Settlement Platform (SP)
 - Index Contour (August 14, 2009)
 - Intermediate Contour (August 14, 2009)
 - Index Contour (August 20, 2009)
 - Intermediate Contour (August 20, 2009)

RECORD DRAWING

25 0 50 100 FEET
 GRAPHIC SCALE: 1" = 50'
 CONTOUR INTERVAL = 1 FOOT

	<table border="1"> <tr> <td>R</td><td>-</td><td>-</td><td>-</td><td>-</td><td>-</td><td>-</td><td>-</td><td>-</td><td>-</td><td>-</td> </tr> <tr> <td>R</td><td>0</td><td>04/23/10</td><td>KDL</td><td>DMG</td><td>KDL</td><td>MJS</td><td>MJS</td><td>MJS</td><td>TJ</td><td>-</td> </tr> <tr> <td>REV.</td><td>NO.</td><td>DATE</td><td>DSGN</td><td>DRWN</td><td>CHKD</td><td>SUPV</td><td>RVMD</td><td>APPD</td><td>ISSD</td><td>PROJECT</td> </tr> <tr> <td></td><td></td><td></td><td></td><td></td><td></td><td></td><td></td><td></td><td></td><td>AS CONST</td> </tr> <tr> <td></td><td></td><td></td><td></td><td></td><td></td><td></td><td></td><td></td><td></td><td>REV</td> </tr> <tr> <td></td><td></td><td></td><td></td><td></td><td></td><td></td><td></td><td></td><td></td><td>CD</td> </tr> </table>										R	-	-	-	-	-	-	-	-	-	-	R	0	04/23/10	KDL	DMG	KDL	MJS	MJS	MJS	TJ	-	REV.	NO.	DATE	DSGN	DRWN	CHKD	SUPV	RVMD	APPD	ISSD	PROJECT											AS CONST											REV											CD
	R	-	-	-	-	-	-	-	-	-	-																																																																	
R	0	04/23/10	KDL	DMG	KDL	MJS	MJS	MJS	TJ	-																																																																		
REV.	NO.	DATE	DSGN	DRWN	CHKD	SUPV	RVMD	APPD	ISSD	PROJECT																																																																		
										AS CONST																																																																		
										REV																																																																		
										CD																																																																		
<p>SCALE: 1"=50' EXCEPT AS NOTED</p>																																																																												
<p>YARD</p> <p>DREDGE CELL TEST EMBANKMENT PROGRAM TOP OF WORKING PLATFORM</p>																																																																												
<table border="1"> <tr> <td>DESIGNED BY:</td> <td>DRAWN BY:</td> <td>CHECKED BY:</td> <td>SUPERVISED BY:</td> <td>REVIEWED BY:</td> <td>APPROVED BY:</td> <td>ISSUED BY:</td> </tr> <tr> <td>K. LINDQUIST</td> <td>D. GRAHAM</td> <td>K. LINDQUIST</td> <td>M. STEELE</td> <td>M. STEELE</td> <td>M. STEELE</td> <td>T. JOHNSON</td> </tr> </table>										DESIGNED BY:	DRAWN BY:	CHECKED BY:	SUPERVISED BY:	REVIEWED BY:	APPROVED BY:	ISSUED BY:	K. LINDQUIST	D. GRAHAM	K. LINDQUIST	M. STEELE	M. STEELE	M. STEELE	T. JOHNSON																																																					
DESIGNED BY:	DRAWN BY:	CHECKED BY:	SUPERVISED BY:	REVIEWED BY:	APPROVED BY:	ISSUED BY:																																																																						
K. LINDQUIST	D. GRAHAM	K. LINDQUIST	M. STEELE	M. STEELE	M. STEELE	T. JOHNSON																																																																						
<p align="center">KINGSTON FOSSIL PLANT TENNESSEE VALLEY AUTHORITY FOSSIL AND HYDRO ENGINEERING</p>																																																																												
<p>AUTOCAD R 2000 DATE 04/23/10 36 C 10W297-05 R 0</p>																																																																												

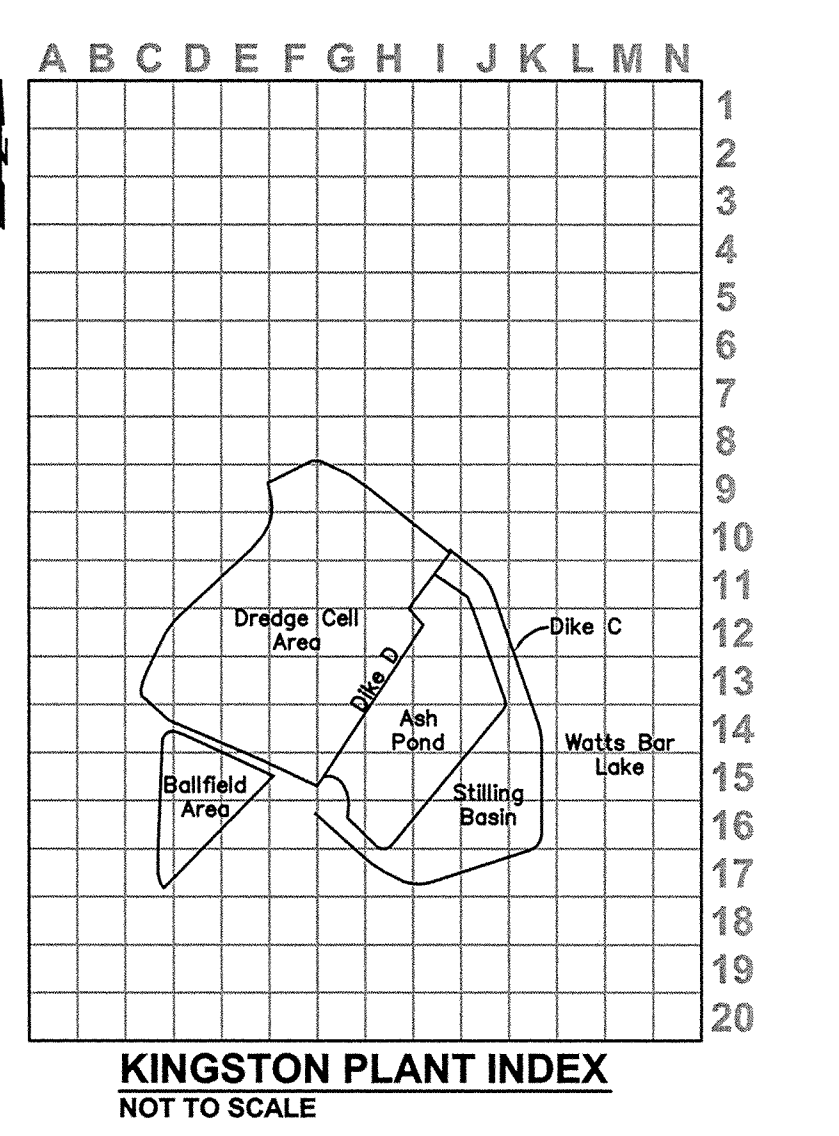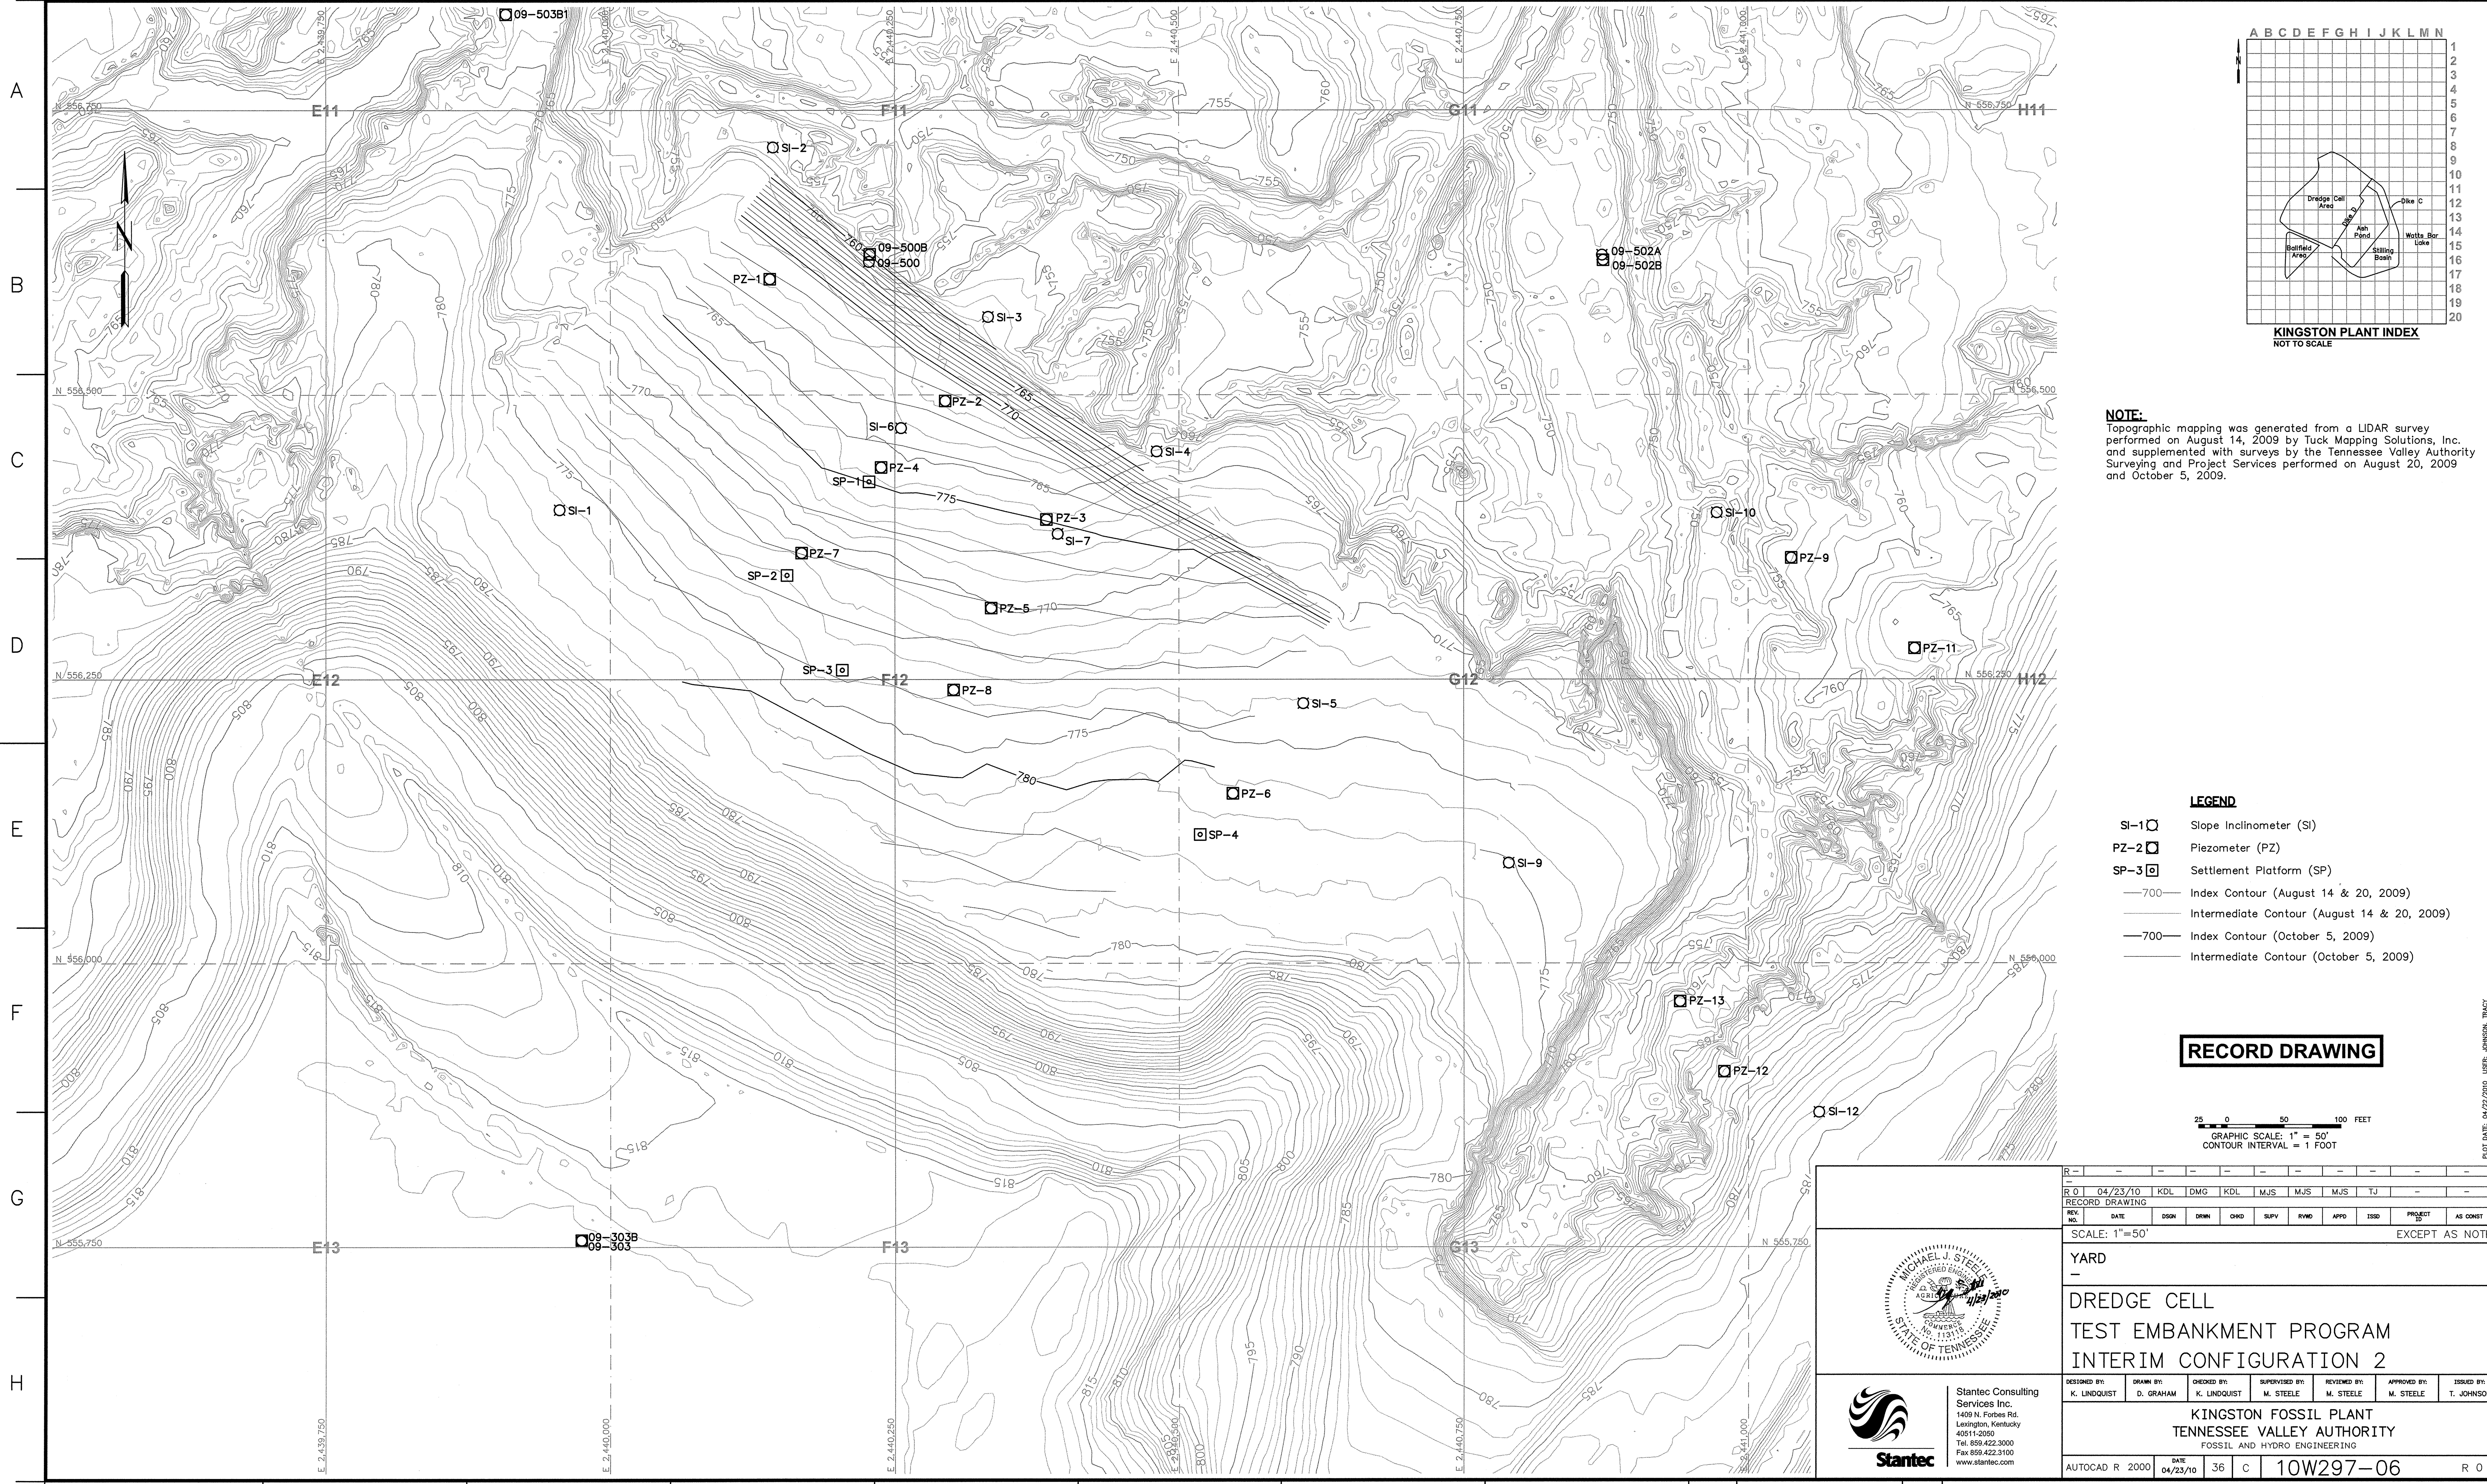

NOTE:
 Topographic mapping was generated from a LIDAR survey performed on August 14, 2009 by Tuck Mapping Solutions, Inc. and supplemented with surveys by the Tennessee Valley Authority Surveying and Project Services performed on August 20, 2009 and October 5, 2009.

- LEGEND**
- SI-1 □ Slope Inclinometer (SI)
 - PZ-2 □ Piezometer (PZ)
 - SP-3 □ Settlement Platform (SP)
 - 700— Intermediate Contour (August 14 & 20, 2009)
 - 700— Index Contour (August 14 & 20, 2009)
 - 700— Intermediate Contour (October 5, 2009)
 - 700— Index Contour (October 5, 2009)



RECORD DRAWING

25 0 50 100 FEET
 GRAPHIC SCALE: 1" = 50'
 CONTOUR INTERVAL = 1 FOOT

Stantec Consulting Services Inc.
 1409 N. Forbes Rd.
 Lexington, Kentucky 40511-2050
 Tel: 859.422.3000
 Fax: 859.422.3100
 www.stantec.com

DESIGNED BY:	DRAWN BY:	CHECKED BY:	SUPERVISED BY:	REVIEWED BY:	APPROVED BY:	ISSUED BY:
K. LINDQUIST	D. GRAHAM	K. LINDQUIST	M. STEELE	M. STEELE	M. STEELE	T. JOHNSON
KINGSTON FOSSIL PLANT TENNESSEE VALLEY AUTHORITY FOSSIL AND HYDRO ENGINEERING						
AUTOCAD R 2000	DATE: 04/23/10	36	C	10W297-06	R 0	

PLOT DATE: 04/23/2010 USER: JOHNSON, TRACY
 V:\1756\MCTE\17566915\ENVIRONMENTAL DRAWING\TEST_LAMP\REV\10W297-06-RECORD

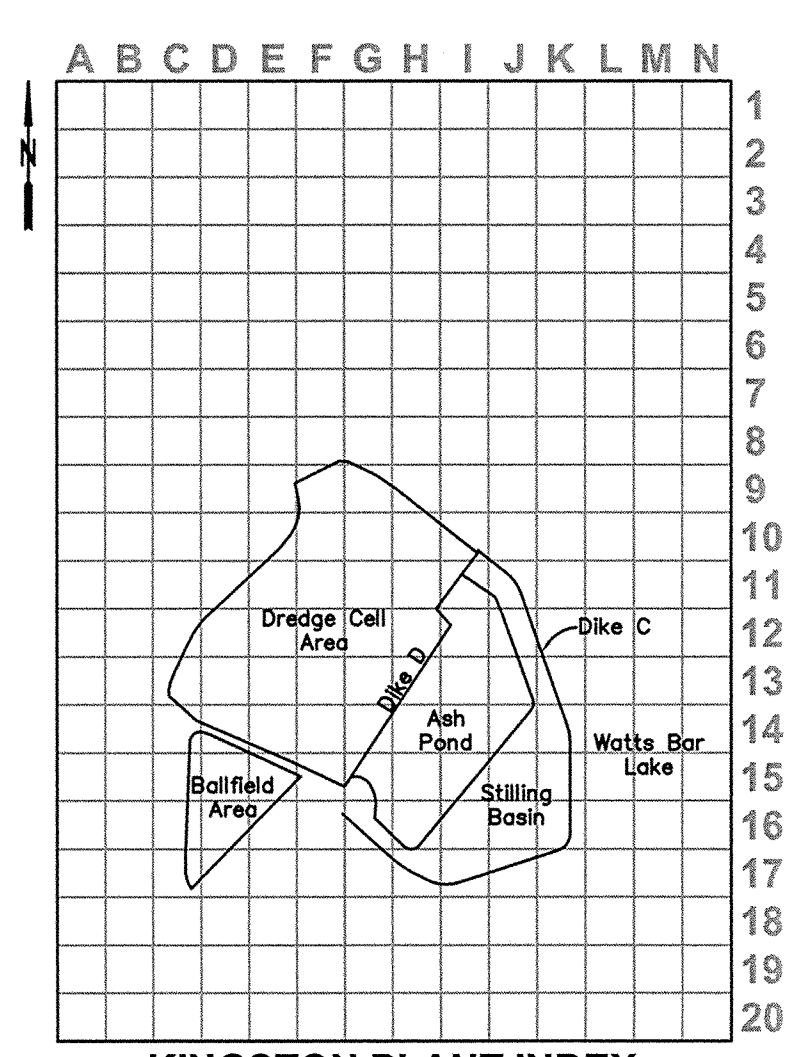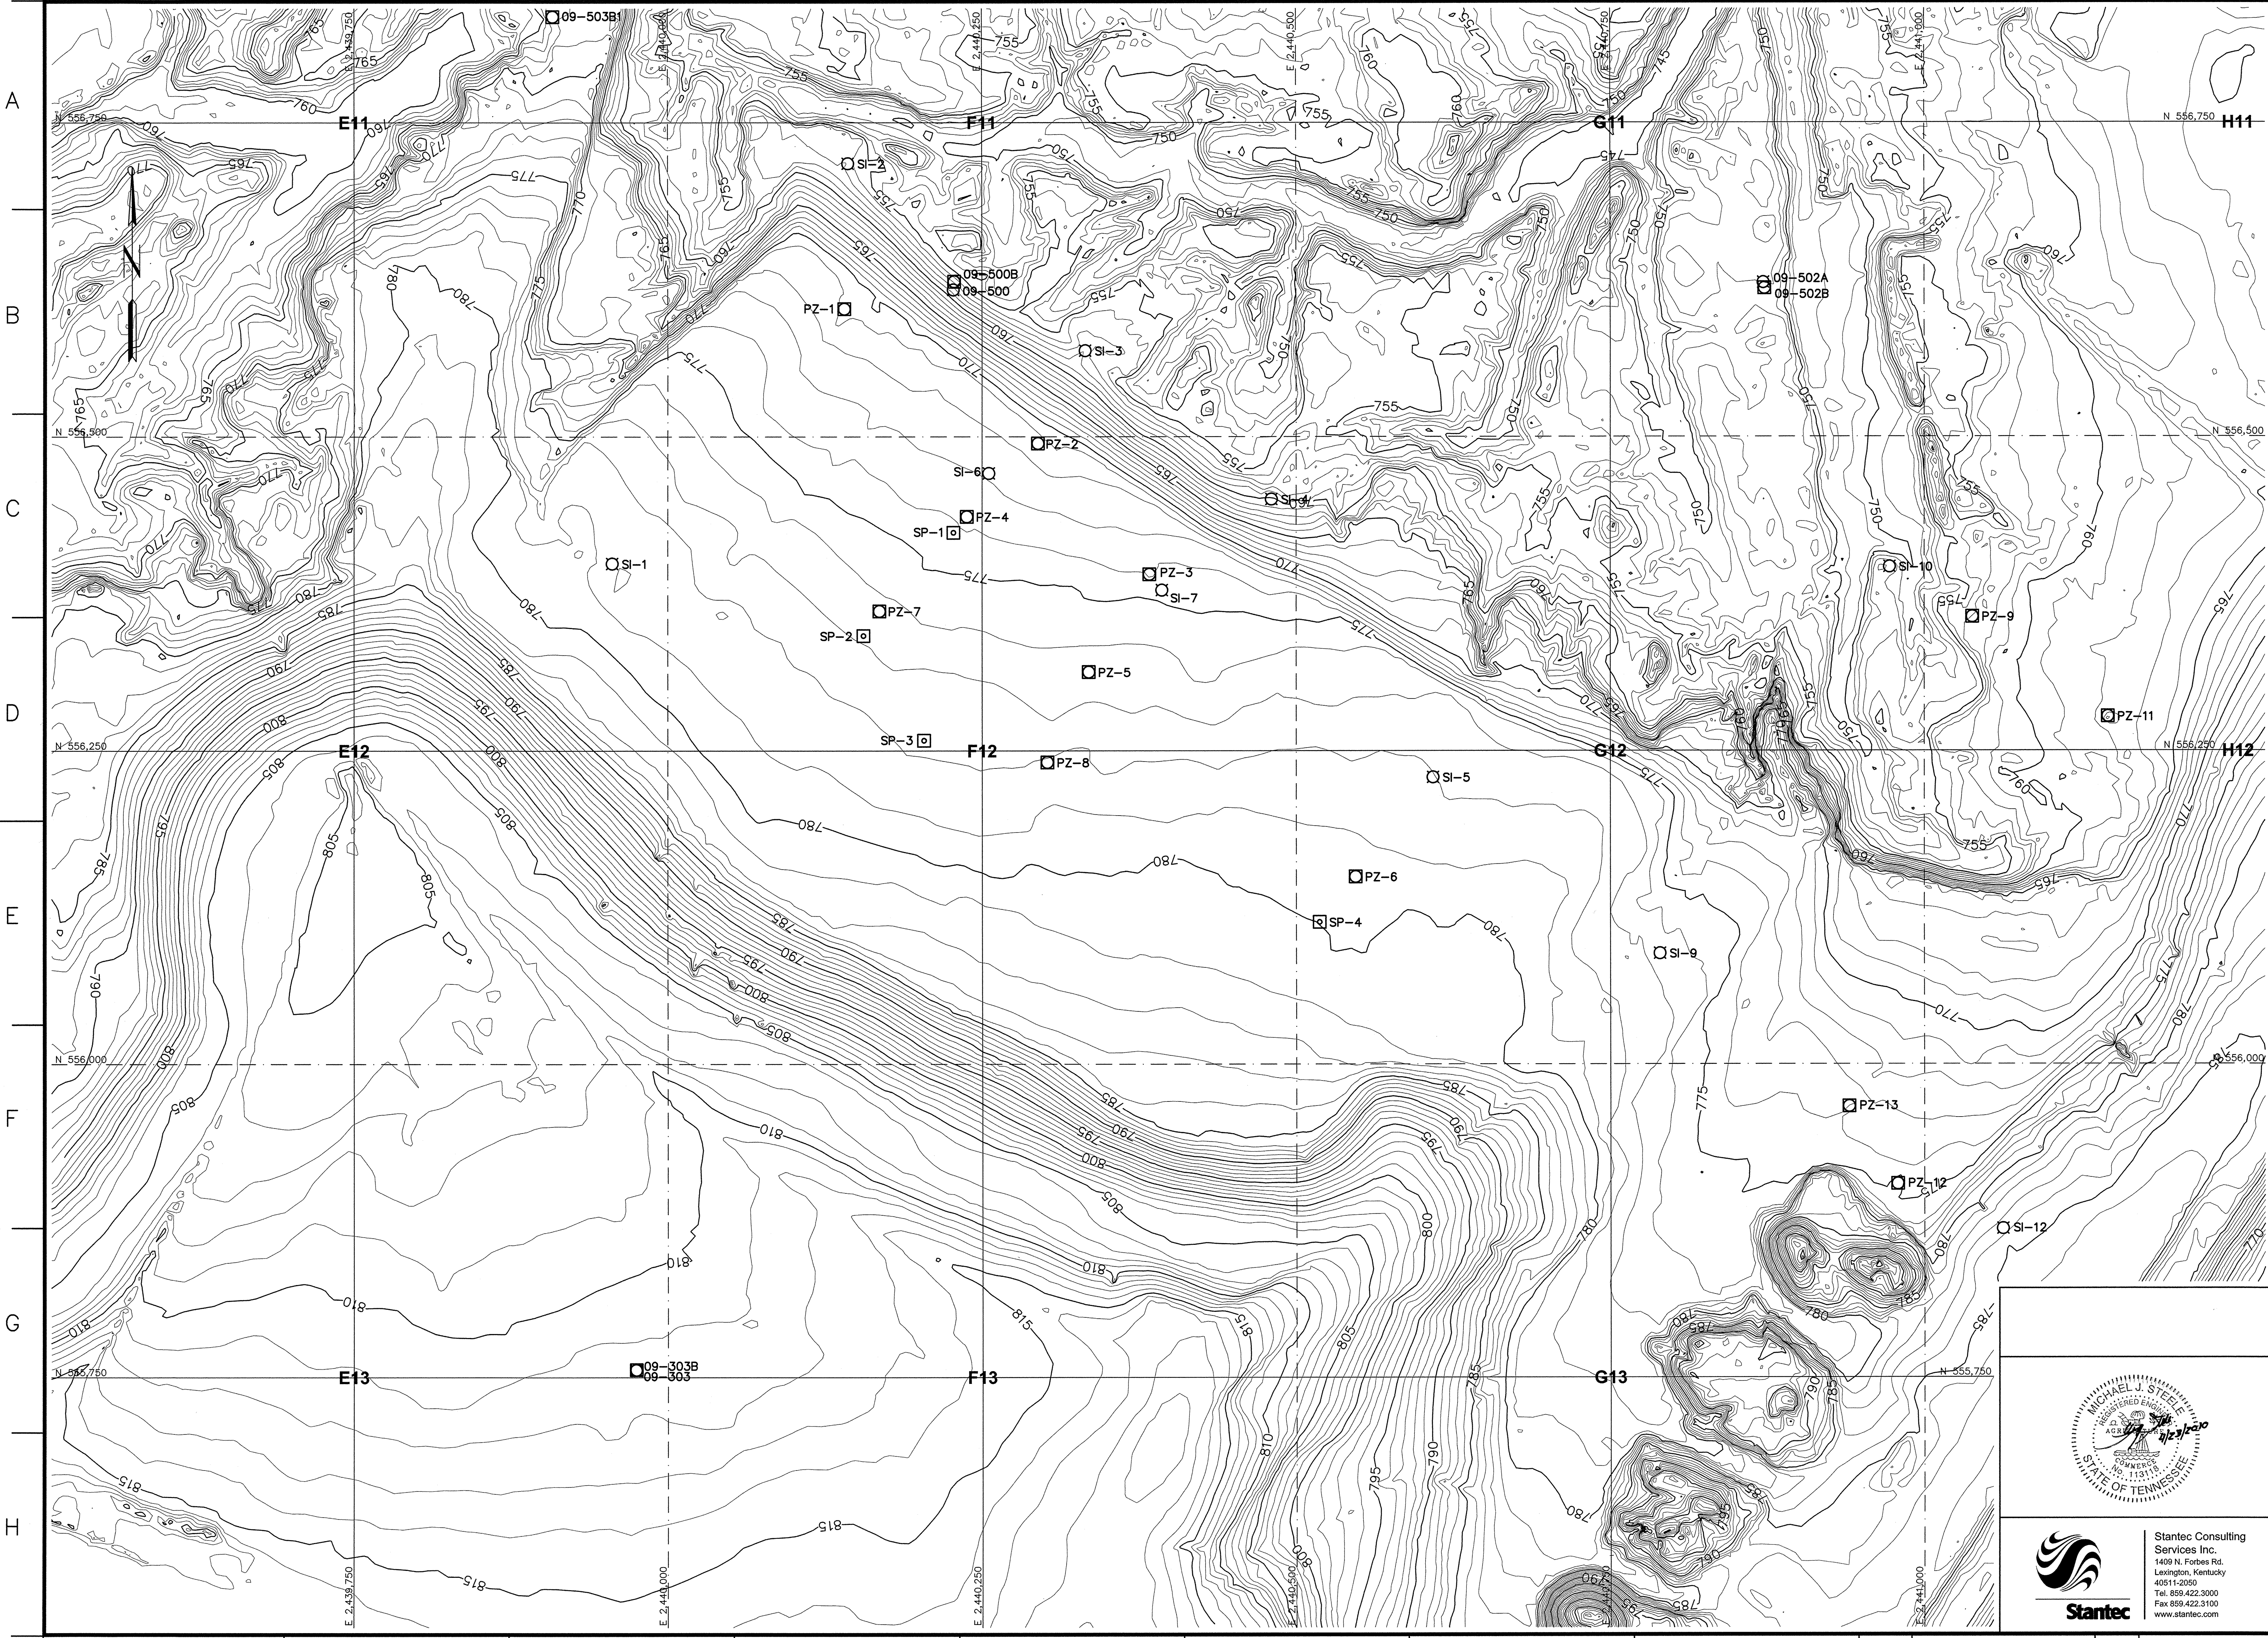

KINGSTON PLANT INDEX
NOT TO SCALE

NOTE:
Topographic mapping was generated from a LIDAR survey performed on October 8, 2009 by Tuck Mapping Solutions, Inc.

- LEGEND**
- SI-1 Slope Inclinometer (SI)
 - PZ-2 Piezometer (PZ)
 - SP-3 Settlement Platform (SP)
 - 700— Index Contour (October 8, 2009)
 - Intermediate Contour (October 8, 2009)



RECORD DRAWING

25 0 50 100 FEET
GRAPHIC SCALE: 1" = 50'
CONTOUR INTERVAL = 1 FOOT

Stantec Consulting Services Inc.
1409 N. Forbes Rd.
Lexington, Kentucky
40511-2090
Tel: 859.422.2000
Fax: 859.422.3100
www.stantec.com

R 0	04/23/10	KDL	DMG	KDL	MJS	MJS	MJS	TJ	—	—	—	—	—	—	DISCIPLINE INTERFACE
RECORD DRAWING															
REV. NO.	DATE	DSGN	DRWN	CHKD	SUPV	RVMD	APPD	ISSD	PROJECT ID	AS CONST	ISSD	EXCEPT AS NOTED			
SCALE: 1"=50'															
YARD															
DREDGE CELL TEST EMBANKMENT PROGRAM INTERIM CONFIGURATION 3															
DESIGNED BY:	DRWN BY:	CHECKED BY:	SUPERVISED BY:	REVIEWED BY:	APPROVED BY:	ISSUED BY:									
K. LINDQUIST	D. GRAHAM	K. LINDQUIST	M. STEELE	M. STEELE	M. STEELE	T. JOHNSON									
KINGSTON FOSSIL PLANT TENNESSEE VALLEY AUTHORITY FOSSIL AND HYDRO ENGINEERING															
AUTOCAD R 2000	DATE	36	C	10W297-07				R 0							
PLOT FACTOR: XX W_TVA C.A.D. DRAWING DO NOT ALTER MANUALLY															

STANTEC 0
TASK COMPLETED BY: REV. NO.

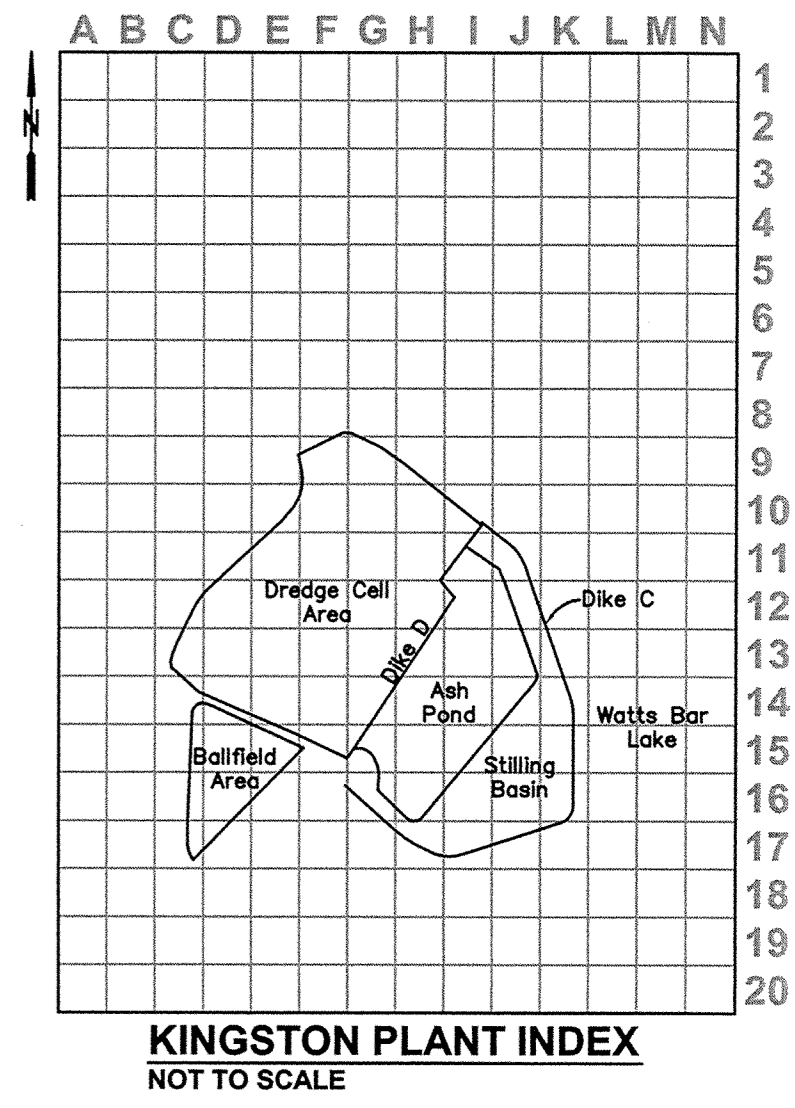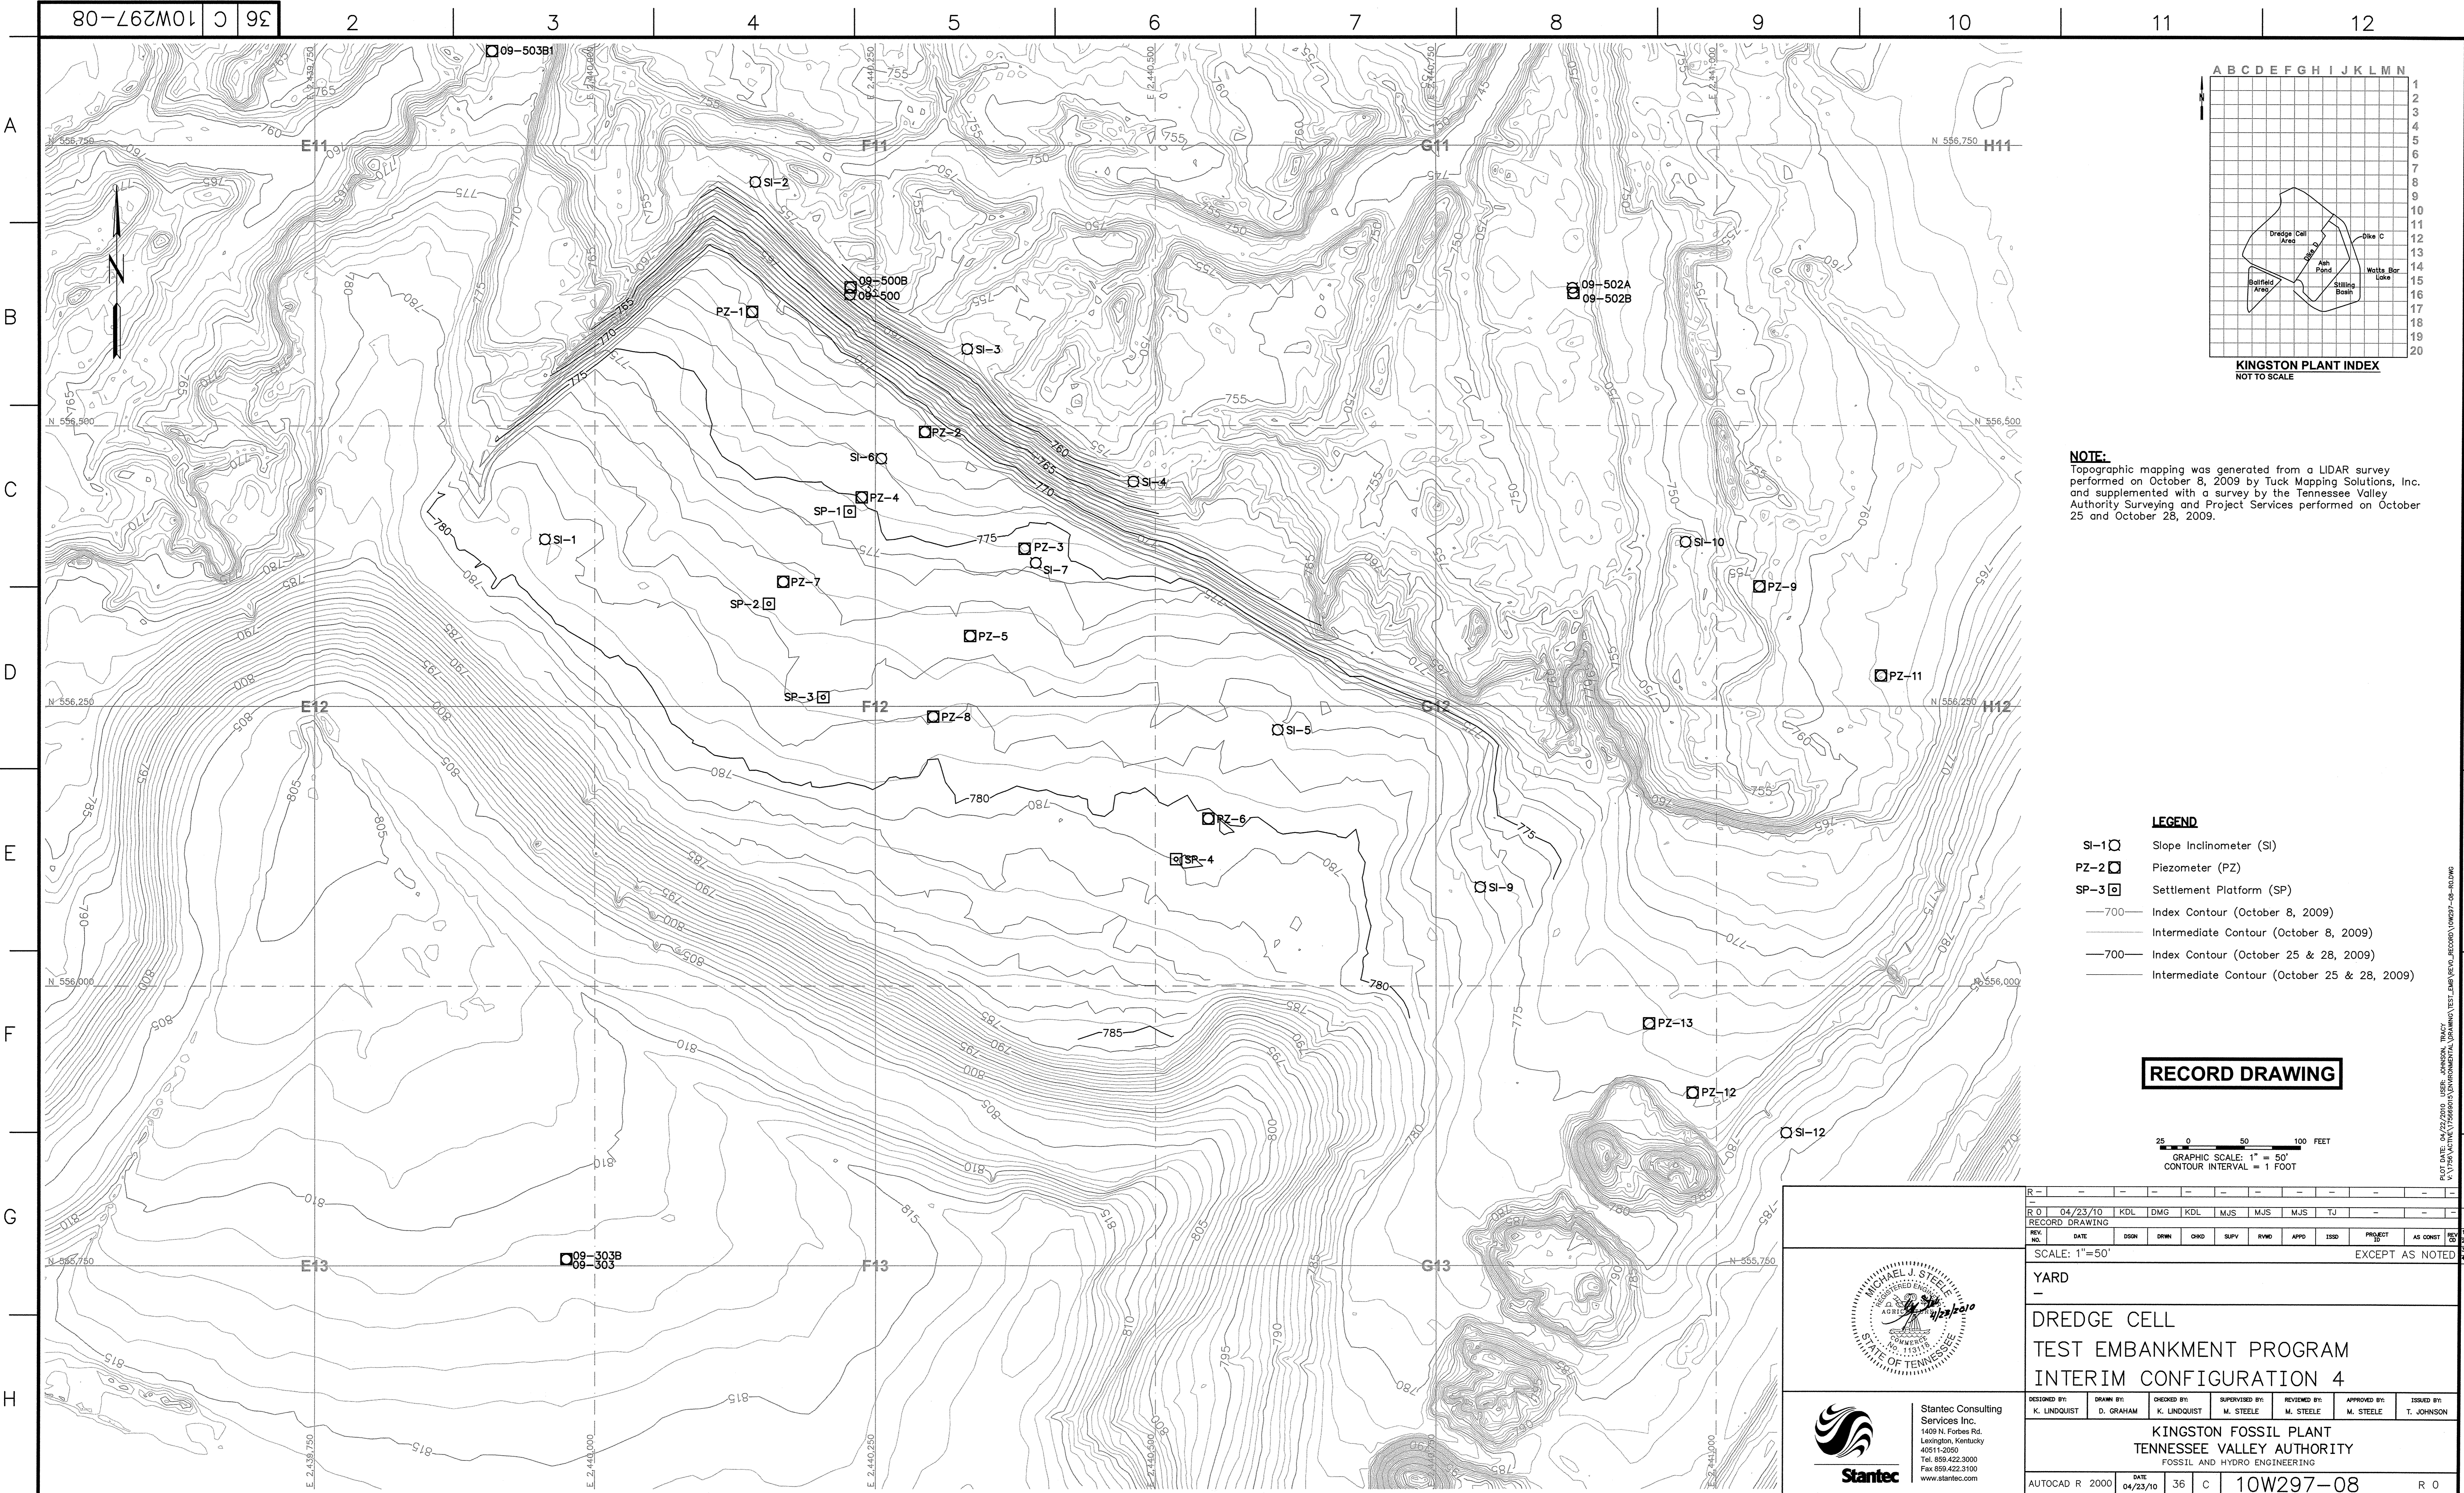



NOTE:
 Topographic mapping was generated from a LIDAR survey performed on October 8, 2009 by Tuck Mapping Solutions, Inc. and supplemented with a survey by the Tennessee Valley Authority Surveying and Project Services performed on October 25 and October 28, 2009.

- LEGEND**
- SI-1 Slope Inclinometer (SI)
 - PZ-2 Piezometer (PZ)
 - SP-3 Settlement Platform (SP)
 - 700 Index Contour (October 8, 2009)
 - Intermediate Contour (October 8, 2009)
 - 700 Index Contour (October 25 & 28, 2009)
 - Intermediate Contour (October 25 & 28, 2009)

RECORD DRAWING

25 0 50 100 FEET
 GRAPHIC SCALE: 1" = 50'
 CONTOUR INTERVAL = 1 FOOT

Stantec Consulting Services Inc. 1409 N. Forbes Rd. Lexington, Kentucky 40511-2050 Tel. 859.422.3000 Fax 859.422.3100 www.stantec.com									
YARD DREDGE CELL TEST EMBANKMENT PROGRAM INTERIM CONFIGURATION 4									
DESIGNED BY:	DRAWN BY:	CHECKED BY:	SUPERVISED BY:	REVIEWED BY:	APPROVED BY:	ISSUED BY:	PROJECT NO. 10W297-08 DATE 04/23/10 SHEET 36 OF 36		
K. LINDQUIST	D. GRAHAM	K. LINDQUIST	M. STEELE	M. STEELE	M. STEELE	T. JOHNSON	KINGSTON FOSSIL PLANT TENNESSEE VALLEY AUTHORITY FOSSIL AND HYDRO ENGINEERING		
AUTOCAD R 2000 DATE 04/23/10 SHEET 36 OF 36 PROJECT NO. 10W297-08 R 0									

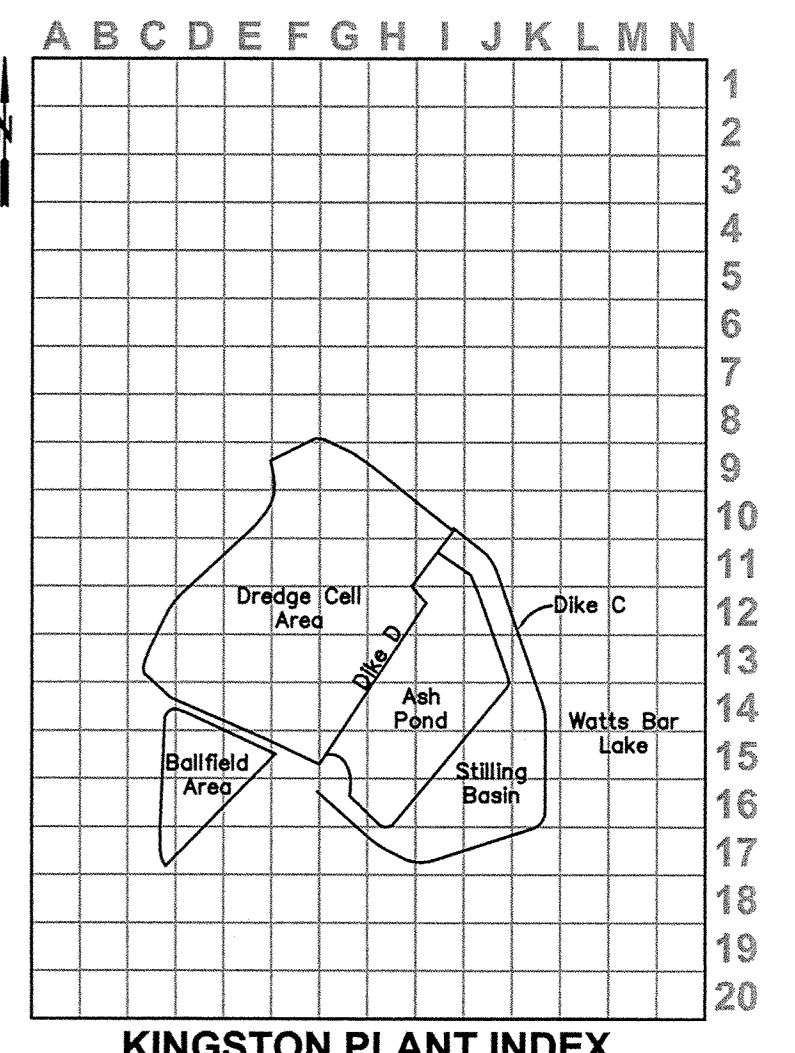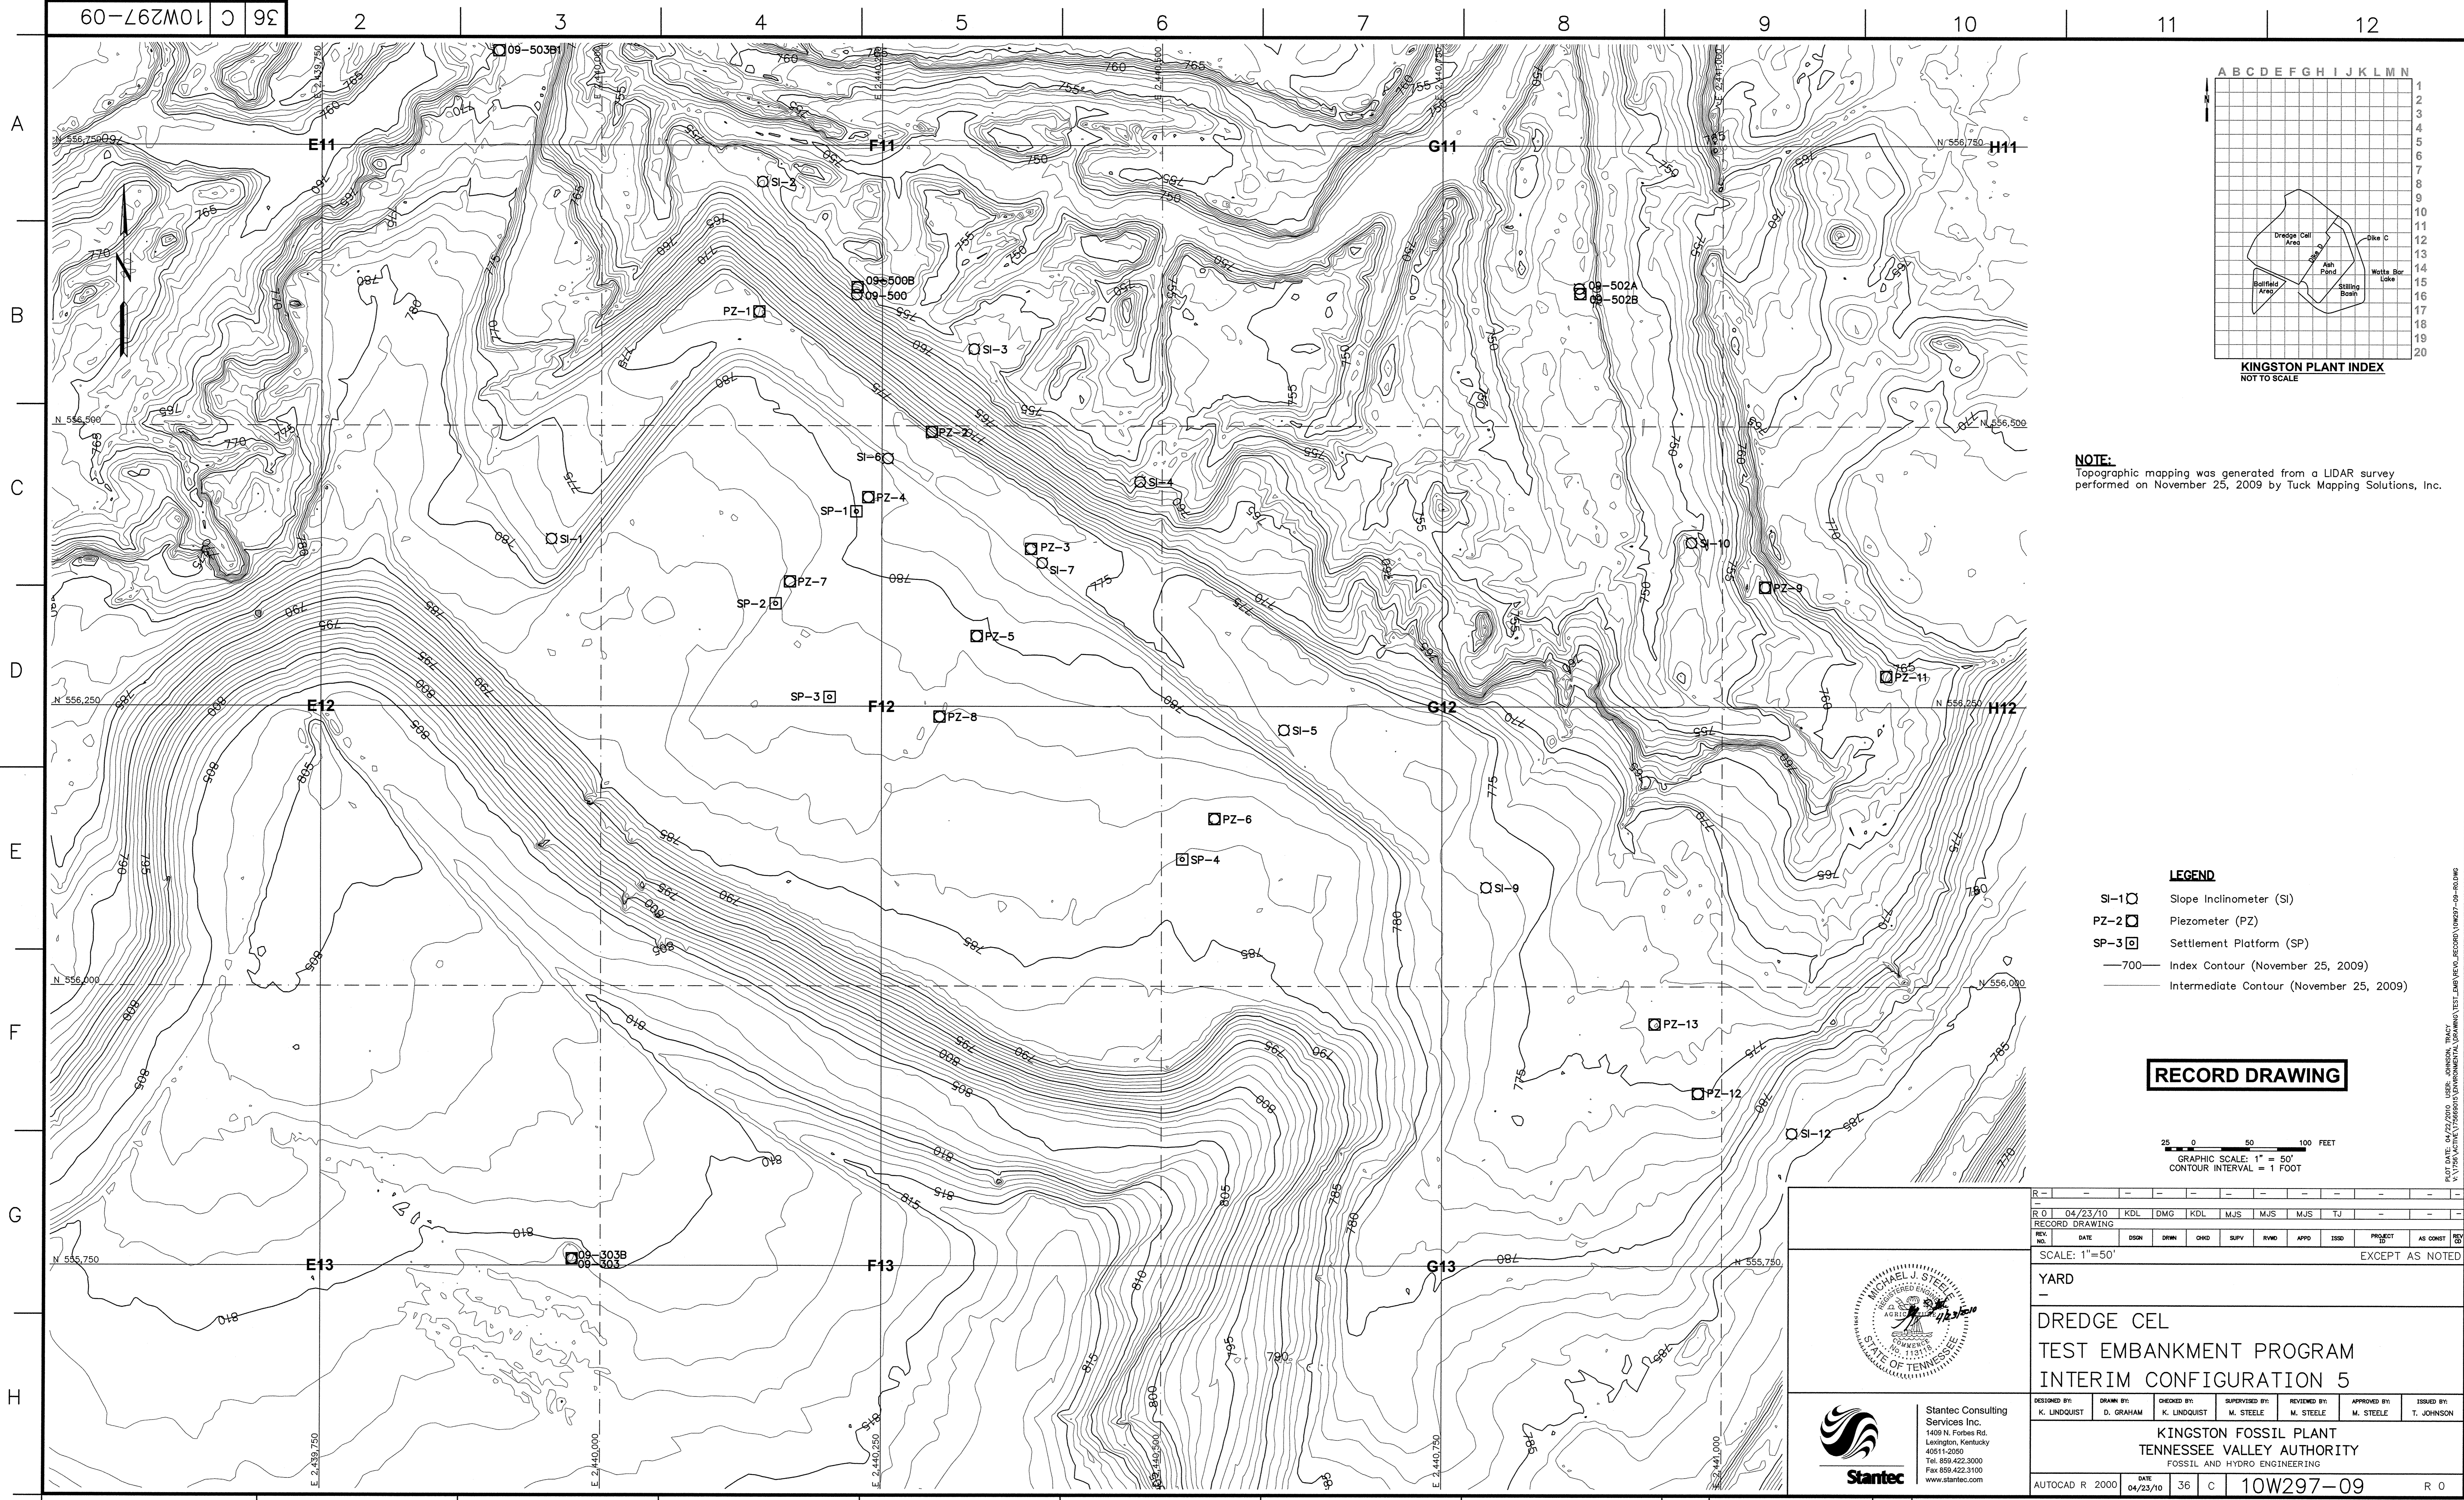



NOTE:
Topographic mapping was generated from a LIDAR survey performed on November 25, 2009 by Tuck Mapping Solutions, Inc.

- LEGEND**
- SI-1 □ Slope Inclinator (SI)
 - PZ-2 □ Piezometer (PZ)
 - SP-3 □ Settlement Platform (SP)
 - 700— Index Contour (November 25, 2009)
 - Intermediate Contour (November 25, 2009)

RECORD DRAWING

25 0 50 100 FEET
GRAPHIC SCALE: 1" = 50'
CONTOUR INTERVAL = 1 FOOT


		<table border="1"> <tr> <td>DESIGNED BY:</td> <td>DRAWN BY:</td> <td>CHECKED BY:</td> <td>SUPERVISED BY:</td> <td>REVIEWED BY:</td> <td>APPROVED BY:</td> <td>ISSUED BY:</td> </tr> <tr> <td>K. LINDQUIST</td> <td>D. GRAHAM</td> <td>K. LINDQUIST</td> <td>M. STEELE</td> <td>M. STEELE</td> <td>M. STEELE</td> <td>T. JOHNSON</td> </tr> </table>		DESIGNED BY:	DRAWN BY:	CHECKED BY:	SUPERVISED BY:	REVIEWED BY:	APPROVED BY:	ISSUED BY:	K. LINDQUIST	D. GRAHAM	K. LINDQUIST	M. STEELE	M. STEELE	M. STEELE	T. JOHNSON
DESIGNED BY:	DRAWN BY:	CHECKED BY:	SUPERVISED BY:	REVIEWED BY:	APPROVED BY:	ISSUED BY:											
K. LINDQUIST	D. GRAHAM	K. LINDQUIST	M. STEELE	M. STEELE	M. STEELE	T. JOHNSON											
		<p>Stantec Consulting Services Inc. 1409 N. Forbes Rd. Lexington, Kentucky 40511-2050 Tel: 859.422.3000 Fax: 859.422.3100 www.stantec.com</p>															
<p>PROJECT: KINGSTON FOSSIL PLANT TENNESSEE VALLEY AUTHORITY FOSSIL AND HYDRO ENGINEERING</p>		<p>DATE: 04/23/10 36 C 10W297-09 R 0</p>															

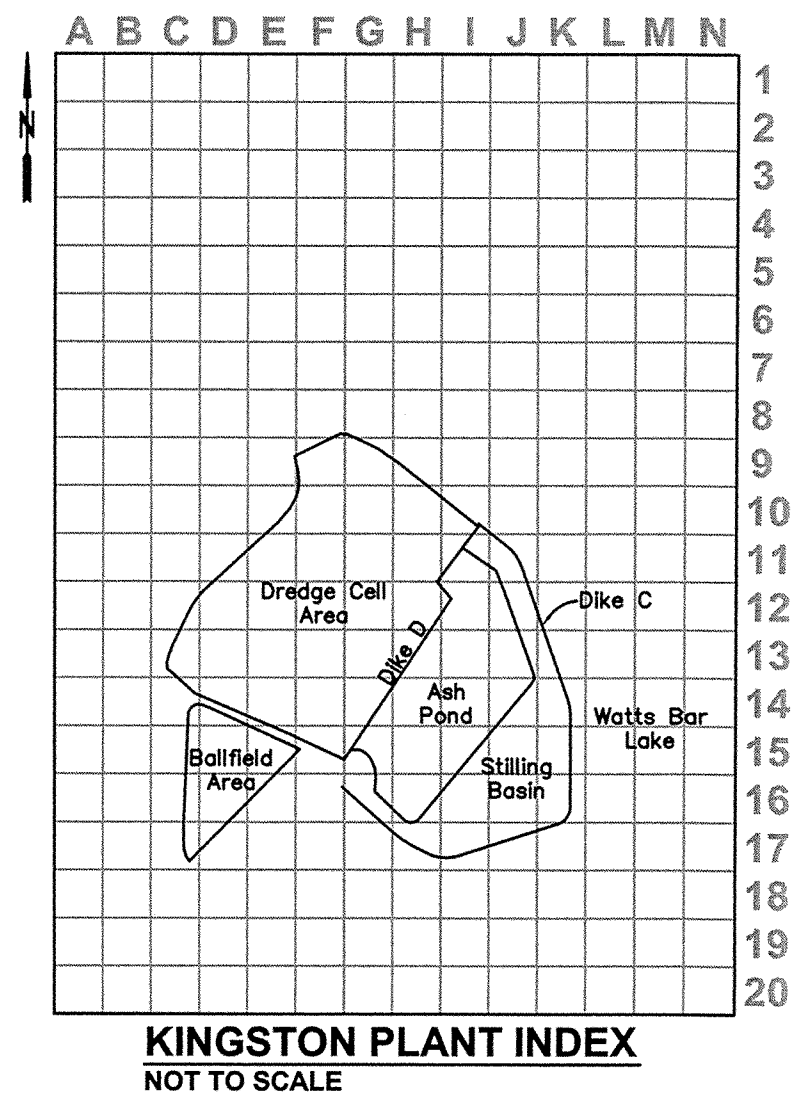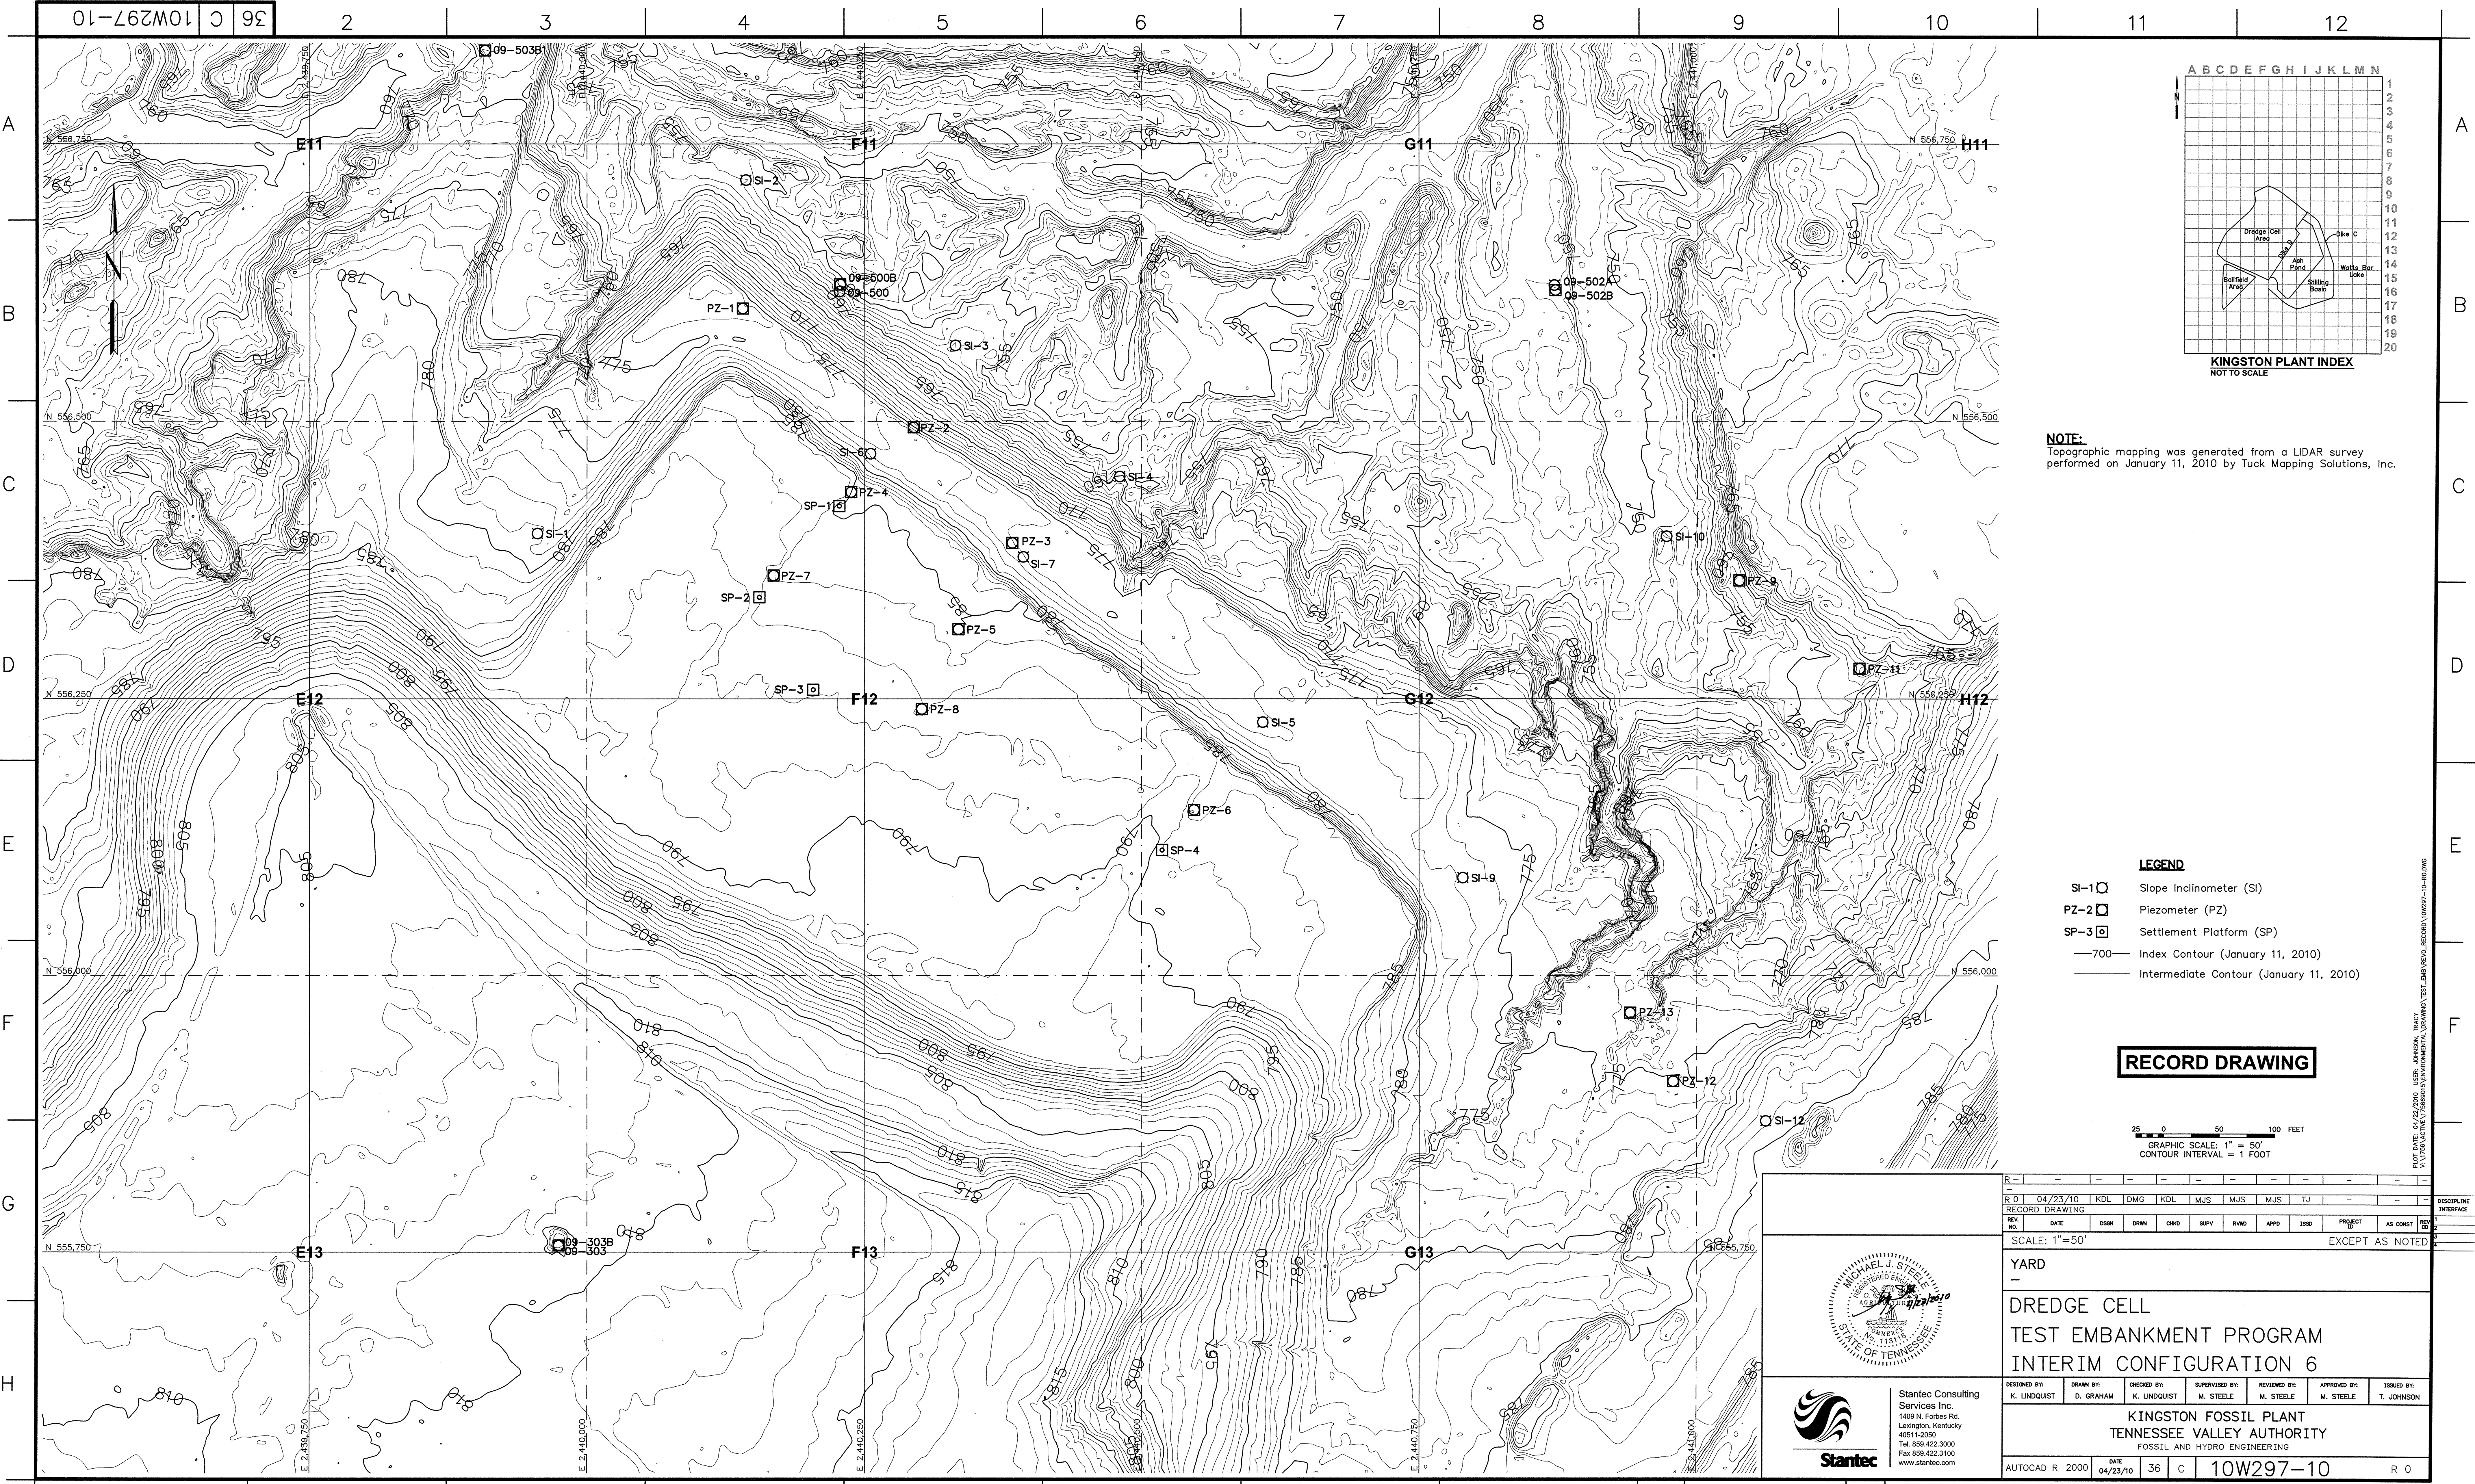

NOTE:
Topographic mapping was generated from a LIDAR survey performed on January 11, 2010 by Tuck Mapping Solutions, Inc.



- LEGEND**
- SI-1 Slope Inclinerometer (SI)
 - PZ-2 Piezometer (PZ)
 - SP-3 Settlement Platform (SP)
 - 700— Index Contour (January 11, 2010)
 - Intermediate Contour (January 11, 2010)

RECORD DRAWING

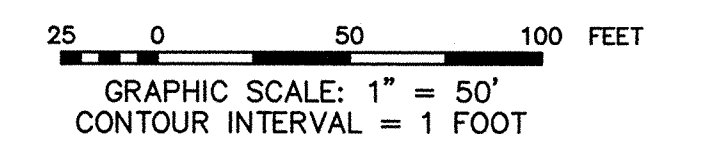

<p>YARD</p> <p>DREDGE CELL</p> <p>TEST EMBANKMENT PROGRAM</p> <p>INTERIM CONFIGURATION 6</p>									
DESIGNED BY:	DRAWN BY:	CHECKED BY:	SUPERVISED BY:	REVIEWED BY:	APPROVED BY:	ISSUED BY:	DISCIPLINE		
K. LINDQUIST	D. GRAHAM	K. LINDQUIST	M. STEELE	M. STEELE	M. STEELE	T. JOHNSON	INTERFACE		
<p>KINGSTON FOSSIL PLANT</p> <p>TENNESSEE VALLEY AUTHORITY</p> <p>FOSSIL AND HYDRO ENGINEERING</p>									
AUTOCAD R 2000	DATE	36	C	10W297-10		R 0	PLOT FACTOR: XX		
STANTEC		0		TASK COMPLETED BY:		REV NO.		C.A.D. DRAWING	
								DO NOT ALTER MANUALLY	

FILE DATE: 04/23/10, 10:55 AM, USER: MSTEEL, WORKSPACE: C:\WORKSPACE\ENVIRONMENTAL\DRAWING\TEST_DRAWING_RECORD\10W297-10-R0.DWG

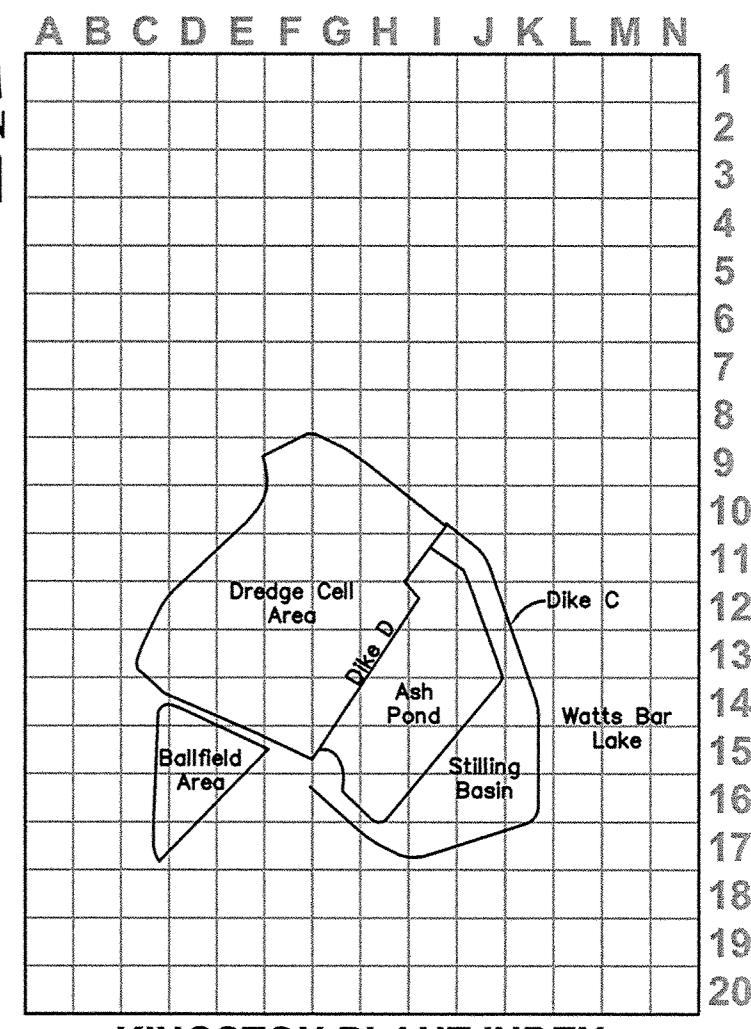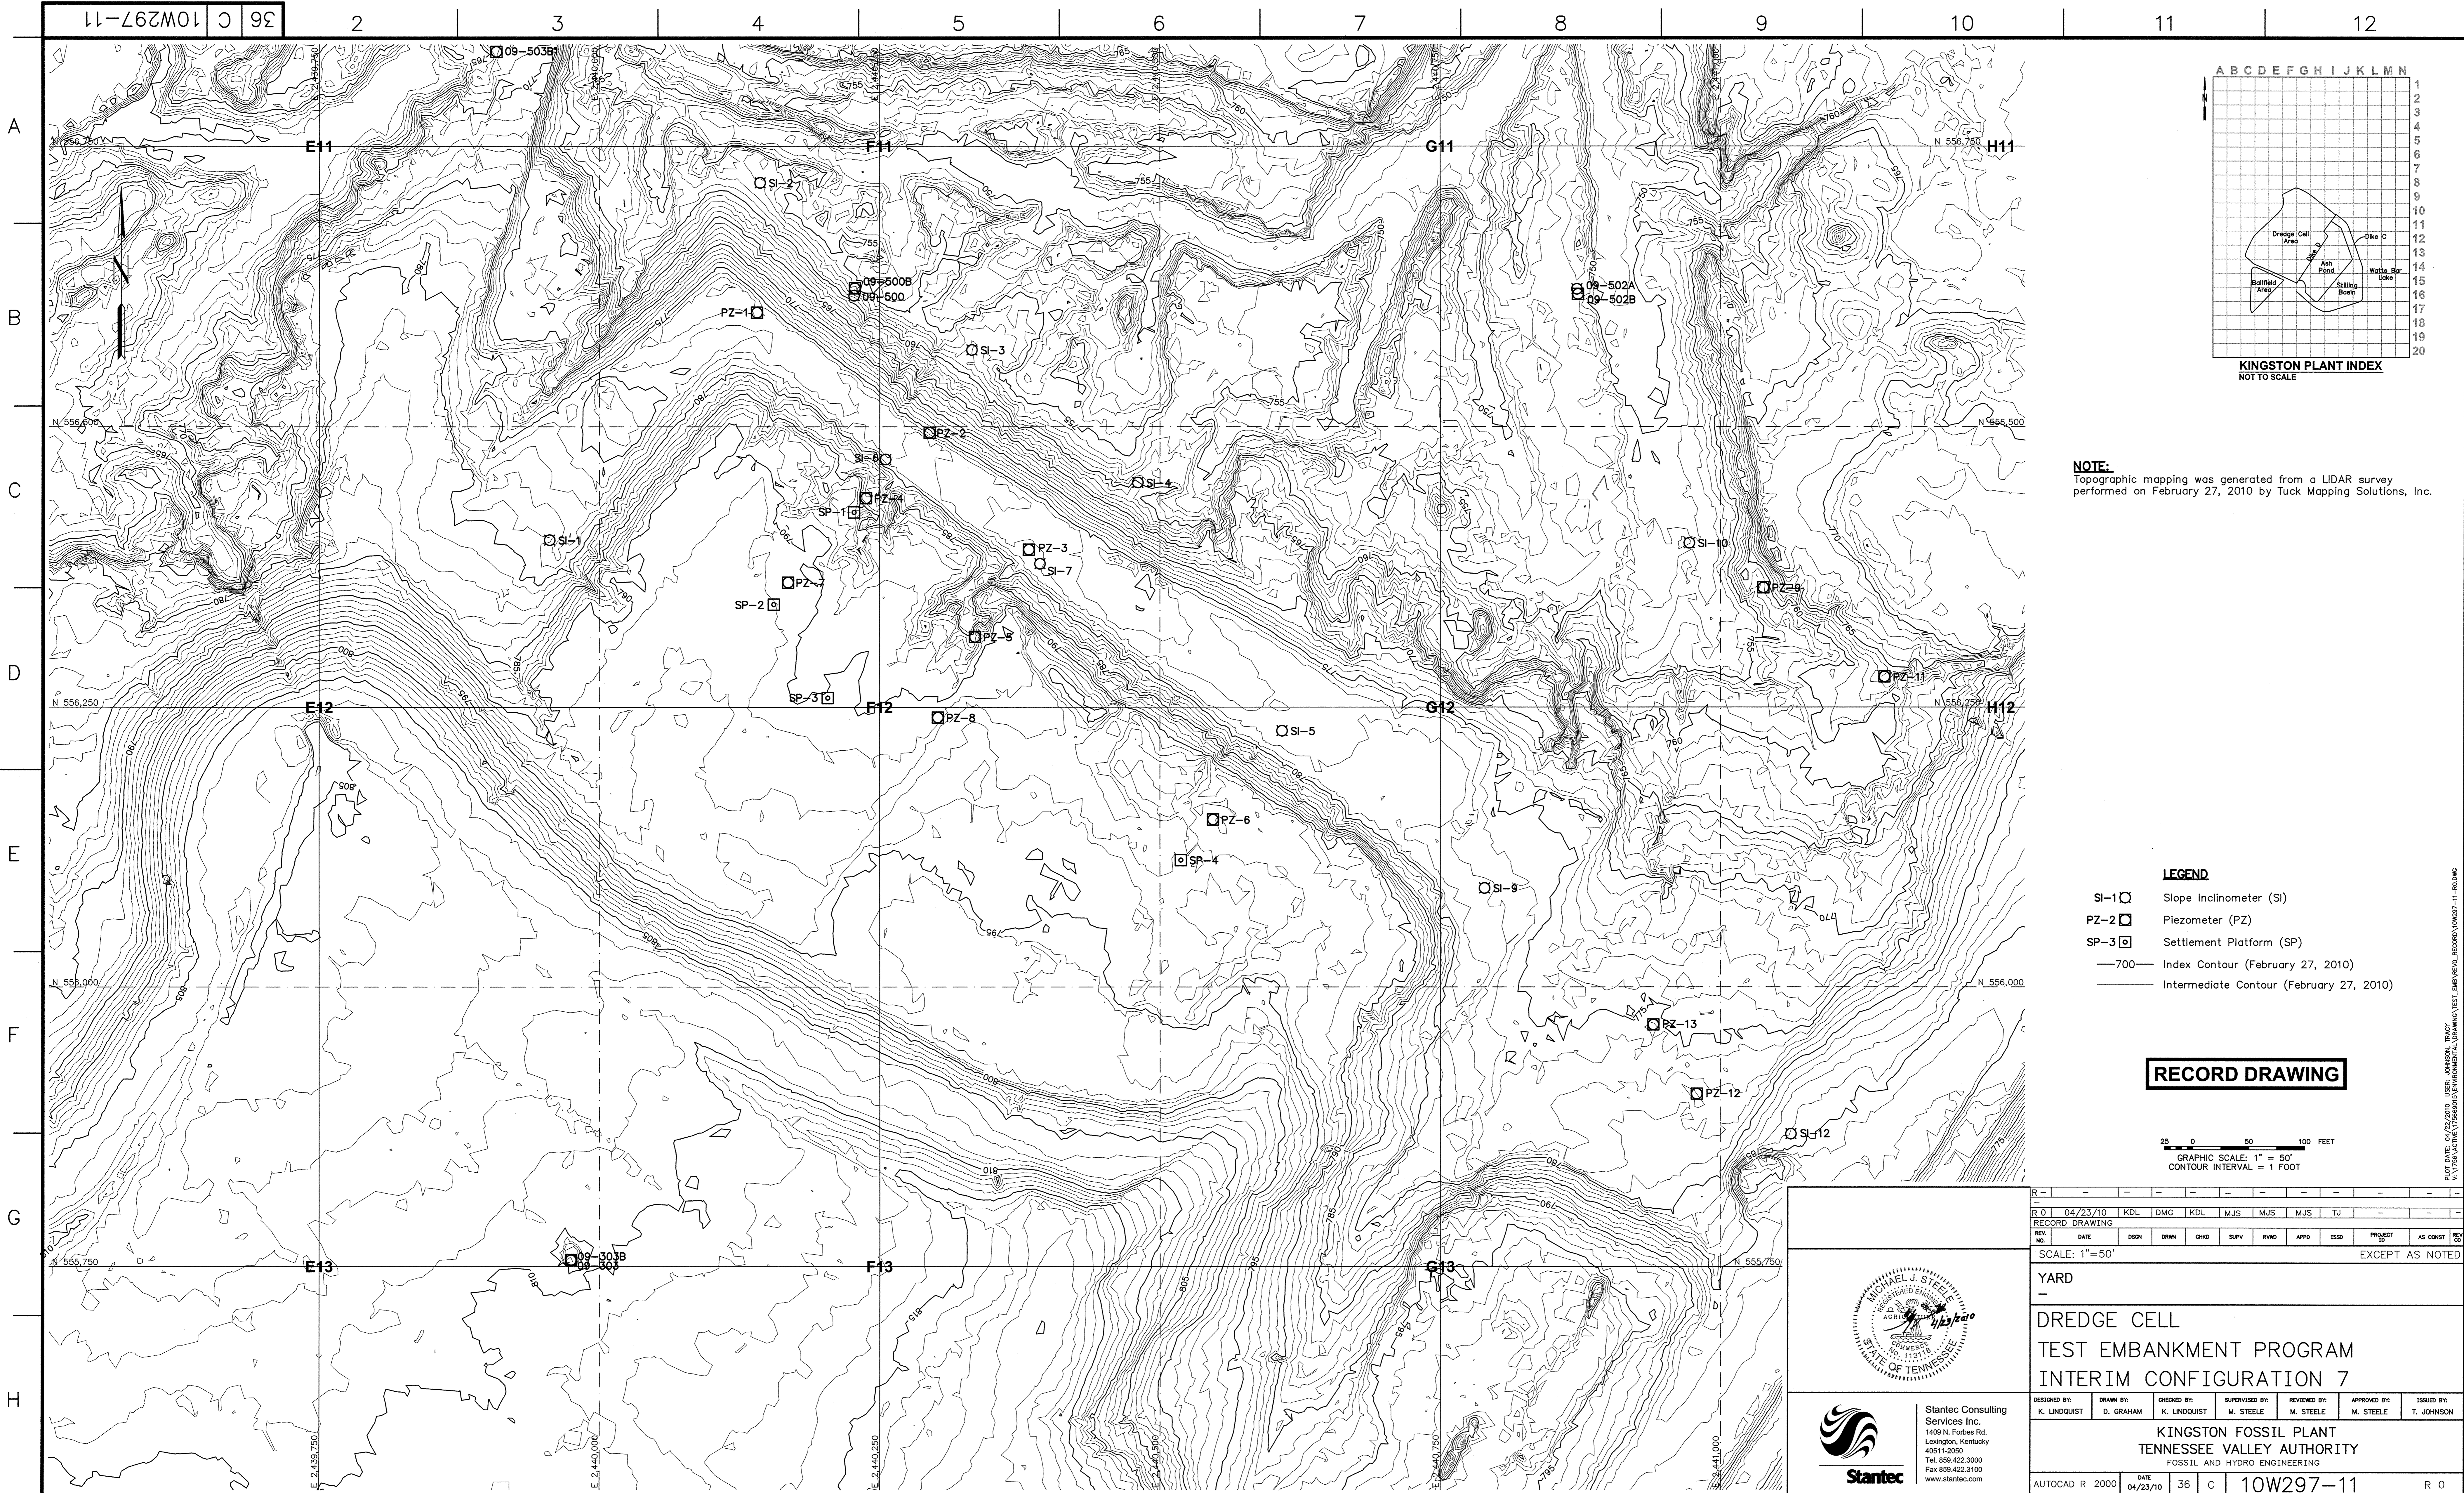

NOTE:
Topographic mapping was generated from a LIDAR survey performed on February 27, 2010 by Tuck Mapping Solutions, Inc.

- LEGEND**
- SI-1 Slope inclinometer (SI)
 - PZ-2 Piezometer (PZ)
 - SP-3 Settlement Platform (SP)
 - 700— Index Contour (February 27, 2010)
 - Intermediate Contour (February 27, 2010)



RECORD DRAWING

25 0 50 100 FEET
GRAPHIC SCALE: 1" = 50'
CONTOUR INTERVAL = 1 FOOT

Stantec Consulting Services Inc.
1409 N. Forbes Rd.
Lexington, Kentucky 40511-2050
Tel: 859.422.3000
Fax: 859.422.3100
www.stantec.com

REVISION	NO.	DATE	BY	DESCRIPTION					
R 0	04/23/10	KDL	DMG	KDL	MJS	MJS	MJS	TJ	
RECORD DRAWING									
SCALE: 1"=50'									
EXCEPT AS NOTED									
YARD									
DREDGE CELL									
TEST EMBANKMENT PROGRAM									
INTERIM CONFIGURATION 7									
DESIGNED BY:	DRAWN BY:	CHECKED BY:	SUPERVISED BY:	REVIEWED BY:	APPROVED BY:	ISSUED BY:			
K. LINDQUIST	D. GRAHAM	K. LINDQUIST	M. STEELE	M. STEELE	M. STEELE	T. JOHNSON			
KINGSTON FOSSIL PLANT									
TENNESSEE VALLEY AUTHORITY									
FOSSIL AND HYDRO ENGINEERING									
AUTOCAD R 2000	DATE:	36	C	10W297-11	R 0				
STANTEC		0		PLOT FACTOR: XX					
TASK COMPLETED BY:		REV NO.		W_TVA		C.A.D. DRAWING DO NOT ALTER MANUALLY			

PLOT DATE: 04/23/2010 USER: JOHNSON, TRACY P:\1705\ACTIVE\1705000\ENVIRONMENTAL\DRAWING\TEST_LAMB\REV\RECORD\10W297-11-RECORD

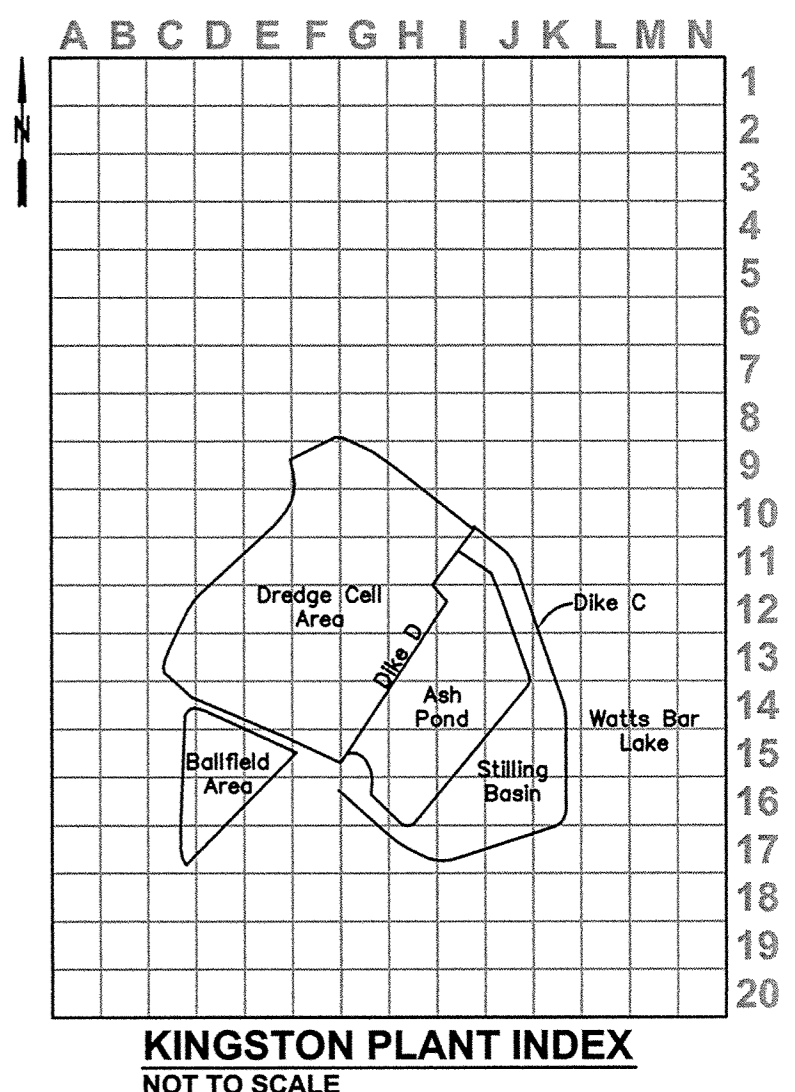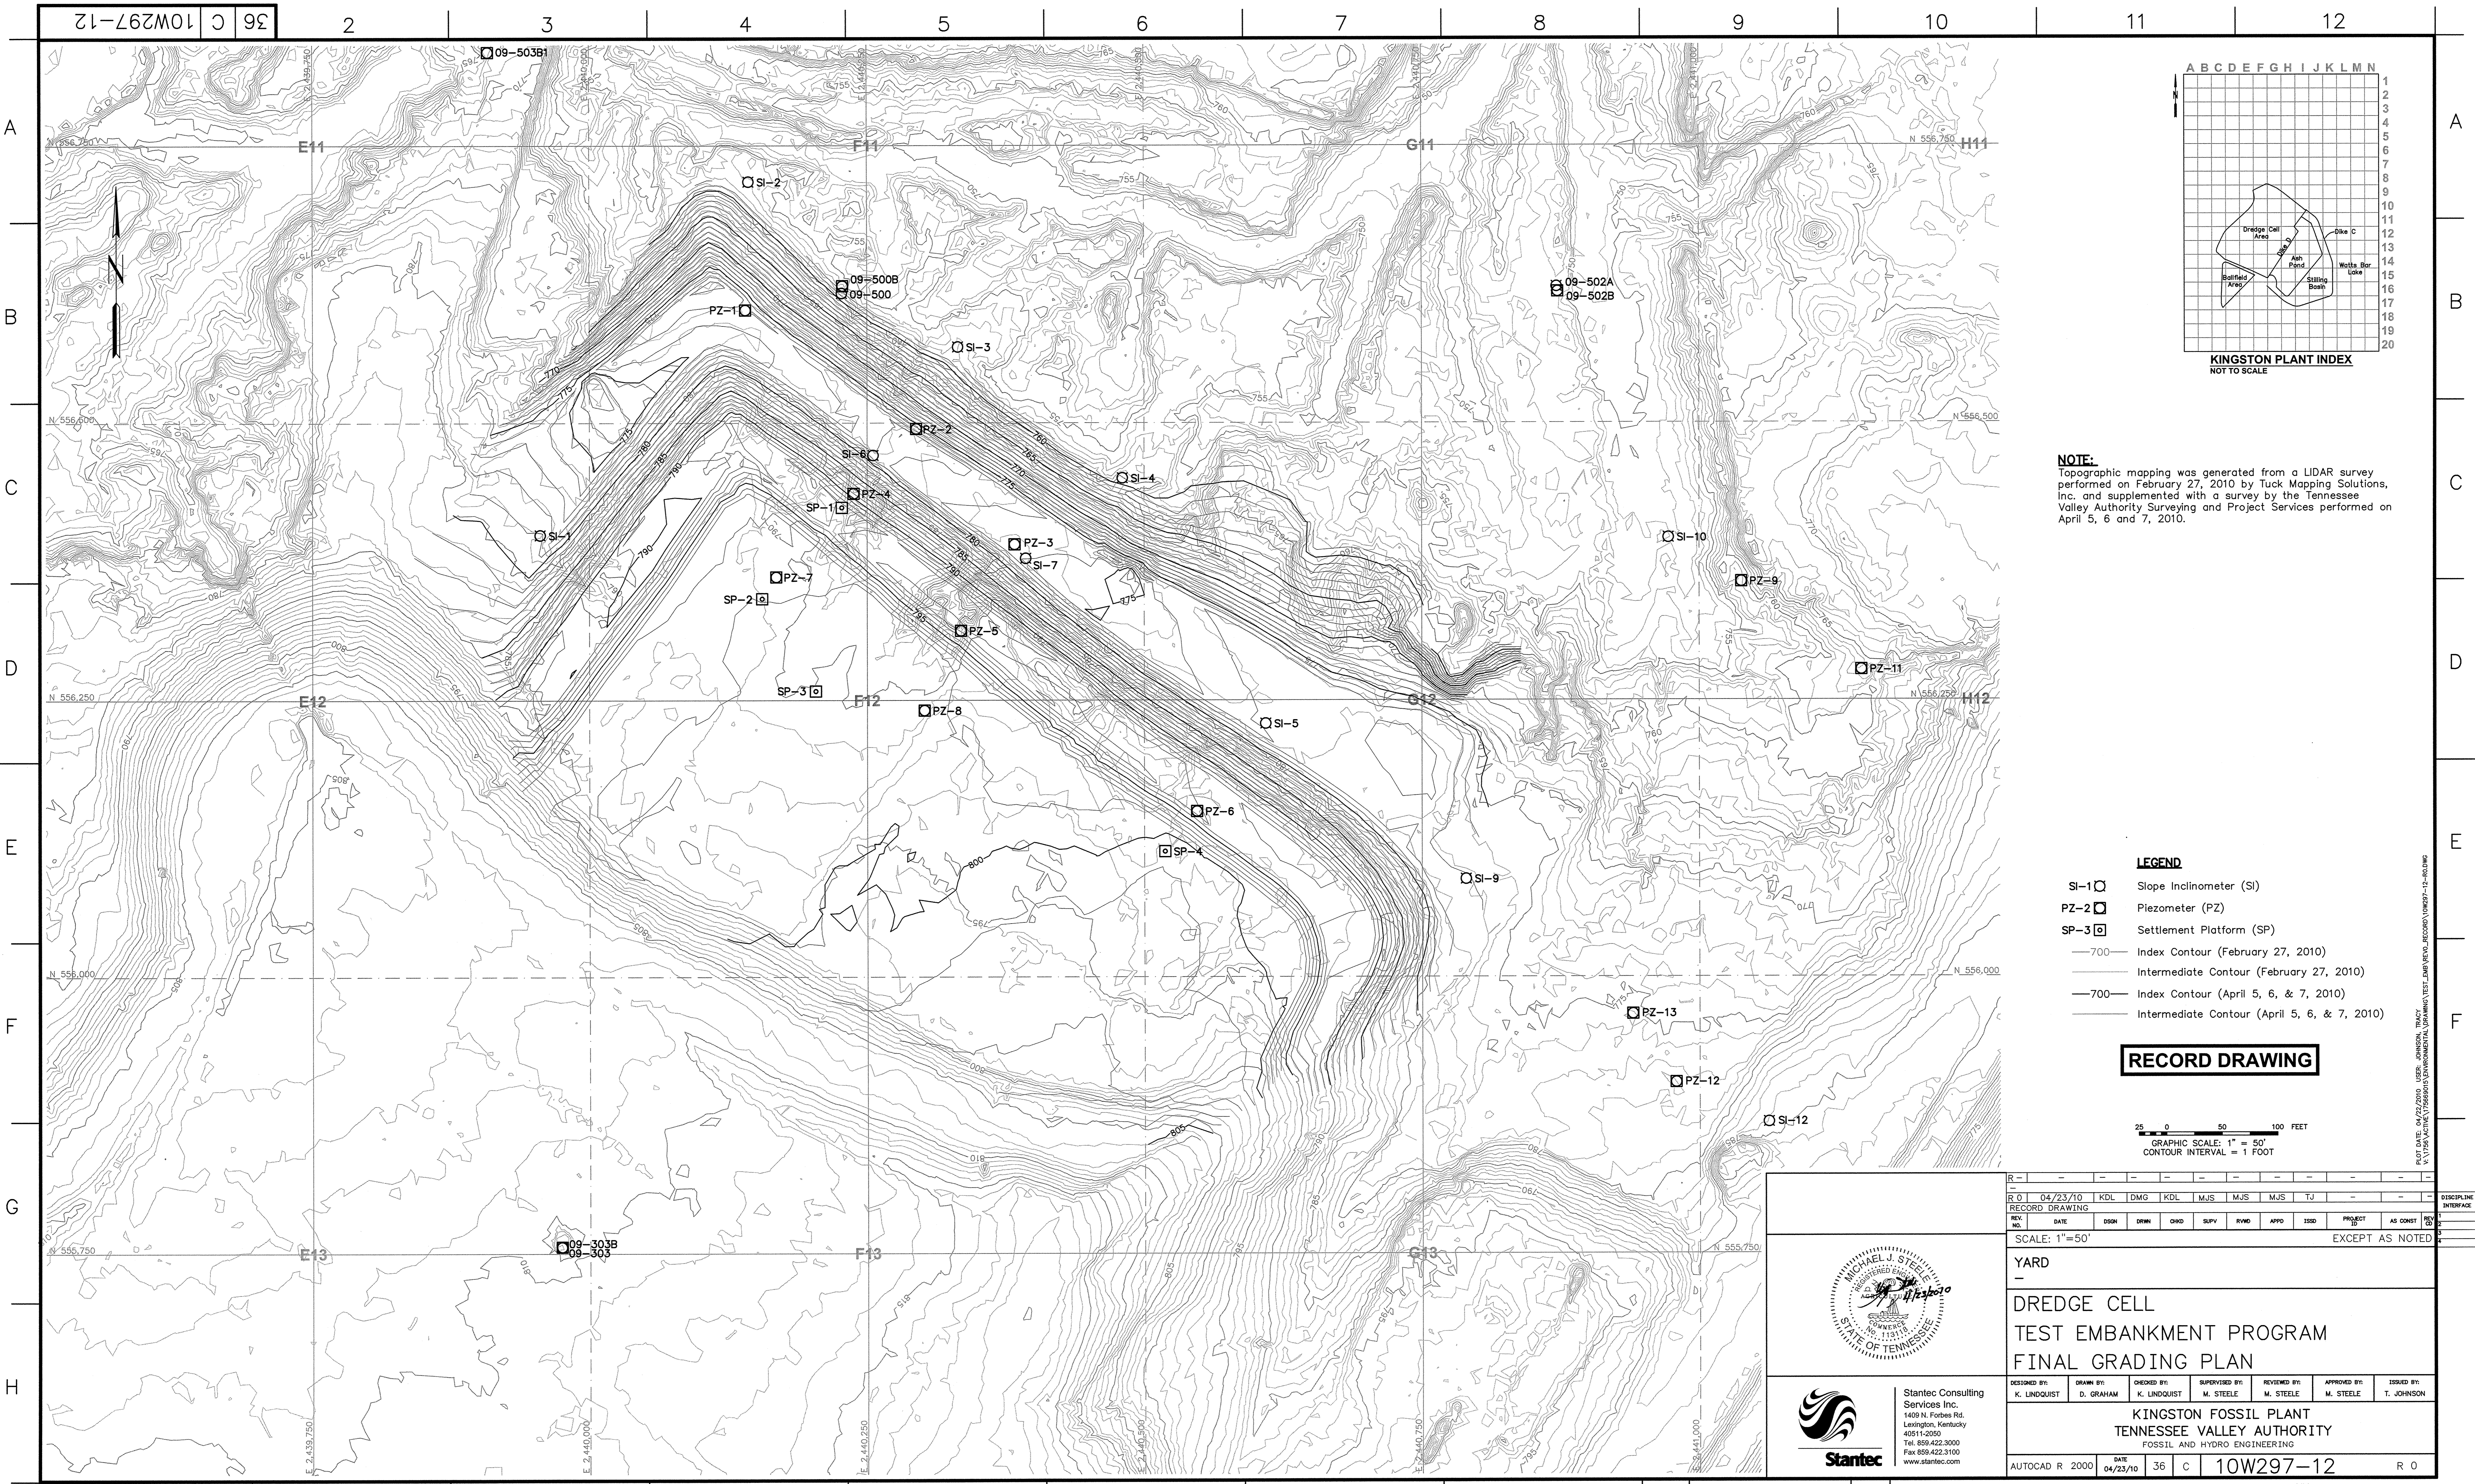


NOTE:
 Topographic mapping was generated from a LIDAR survey performed on February 27, 2010 by Tuck Mapping Solutions, Inc. and supplemented with a survey by the Tennessee Valley Authority Surveying and Project Services performed on April 5, 6 and 7, 2010.

- LEGEND**
- SI-1 Slope Inclinator (SI)
 - PZ-2 Piezometer (PZ)
 - SP-3 Settlement Platform (SP)
 - 700— Index Contour (February 27, 2010)
 - Intermediate Contour (February 27, 2010)
 - 700— Index Contour (April 5, 6, & 7, 2010)
 - Intermediate Contour (April 5, 6, & 7, 2010)

RECORD DRAWING

25 0 50 100 FEET
 GRAPHIC SCALE: 1" = 50'
 CONTOUR INTERVAL = 1 FOOT

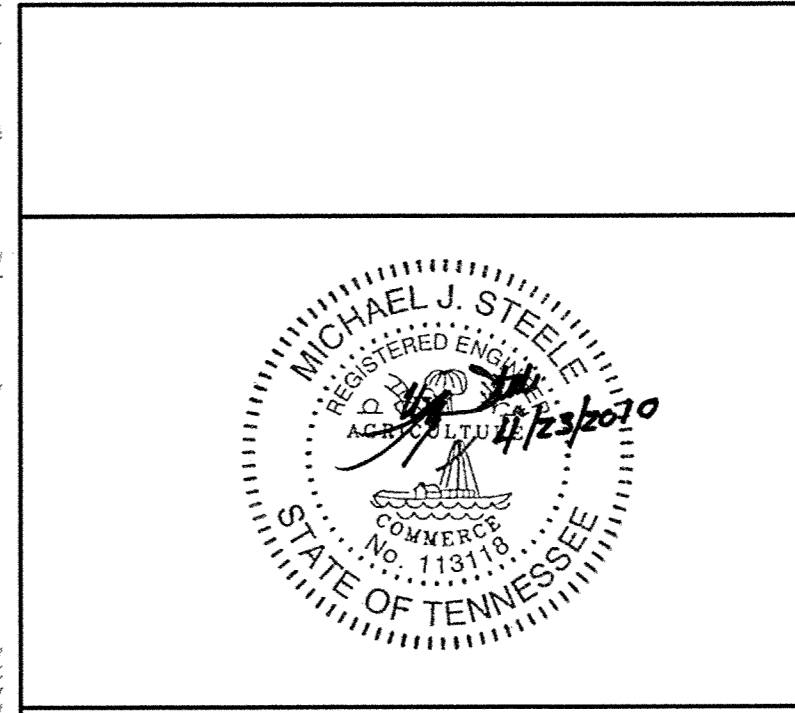

Stantec
 Stantec Consulting Services Inc.
 1409 N. Forbes Rd.
 Lexington, Kentucky 40511-2050
 Tel. 859.422.3000
 Fax 859.422.3100
 www.stantec.com

REV. NO.	DATE	DSGN	DRWN	CHKD	SUPV	RVSD	APPD	ISSD	PROJECT ID	AS CONST	DISCIPLINE INTERFACE
0	04/23/10	KDL	DMG	KDL	MJS	MJS	MJS	TJ			
SCALE: 1"=50' EXCEPT AS NOTED											
YARD											
DREDGE CELL											
TEST EMBANKMENT PROGRAM											
FINAL GRADING PLAN											
DESIGNED BY:	DRWN BY:	CHKD BY:	SUPVISED BY:	REVIEWED BY:	APPROVED BY:	ISSUED BY:					
K. LINDQUIST	D. GRAHAM		M. STEELE	M. STEELE	M. STEELE	T. JOHNSON					
KINGSTON FOSSIL PLANT											
TENNESSEE VALLEY AUTHORITY											
FOSSIL AND HYDRO ENGINEERING											
AUTOCAD R 2000	DATE	36	C	10W297-12	R 0						
PLOT FACTOR: XX W_TVA C.A.D. DRAWING DO NOT ALTER MANUALLY											

STANTEC 0
 TASK COMPLETED BY: REV NO.