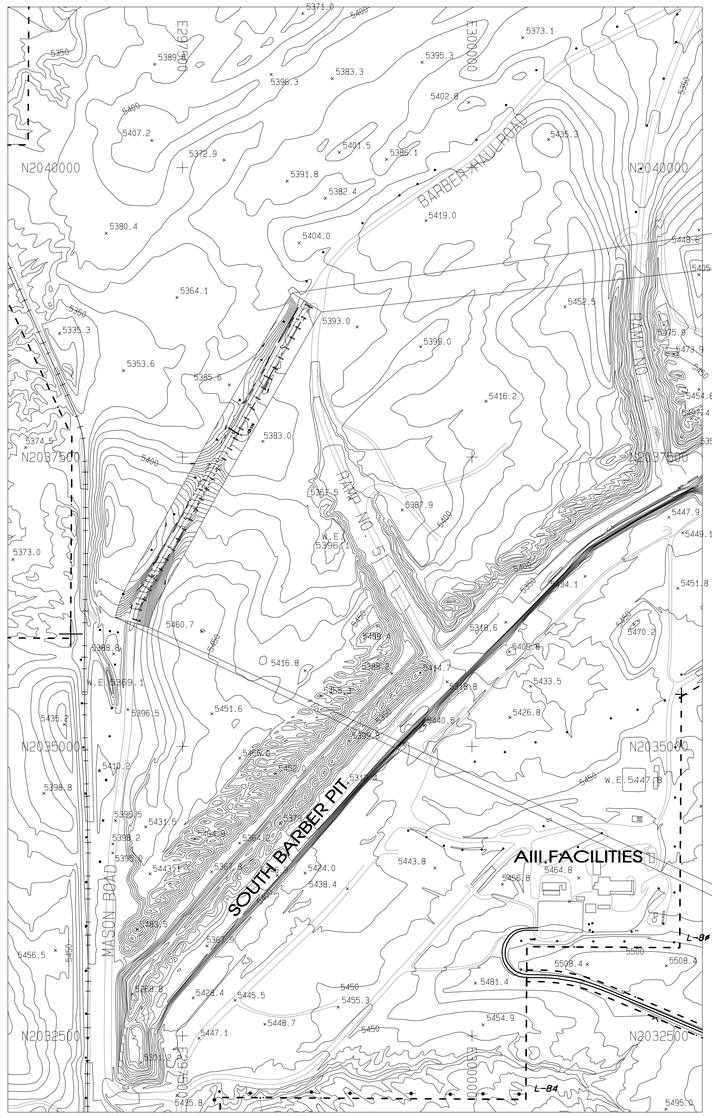

PLAN VIEW
SCALE: 1" = 500'

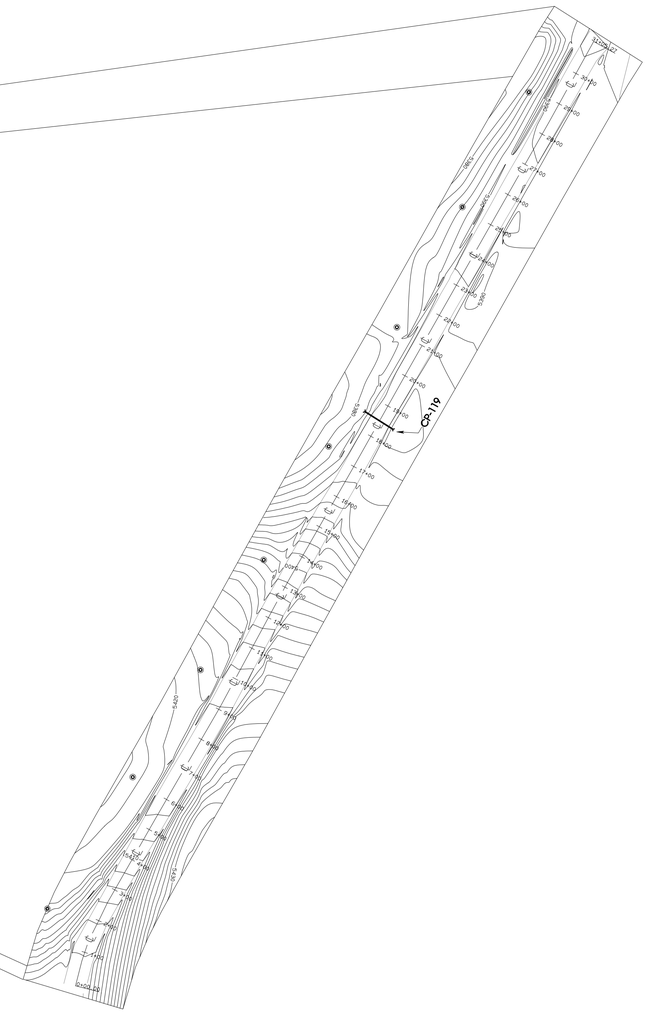

BARBER HAULROAD MODIFICATION
SCALE: 1" = 200'

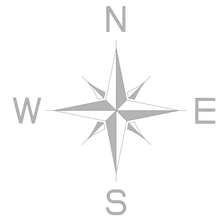

LEGEND

- ROAD
- LEASE LINE
- BUILDING
- FENCE
- IRRIGATION LINE
- CULVERT
- DAM
- DRAINAGE
- RAILROAD
- TREES
- POWERLINE
- ×5338.5 SPOT ELEVATION
- 5300 INDEX CONTOUR
- 5298 INTERMEDIATE CONTOUR
- 218 5422.45 L-30 LEASE CORNER

NOTES

1. For hydrology and design information refer to Appendix 11-?? in the approved PAP.

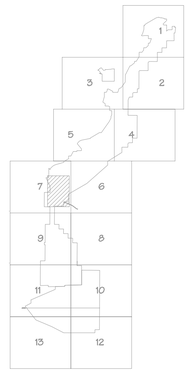

LEONARD RAYMOND
NEW MEXICO
6600
REGISTERED PROFESSIONAL ENGINEER

CERTIFICATION STATEMENT

I, Leonard Raymond, hereby certify that this drawing was reviewed by me and that the information shown is accurate and complete to the best of my knowledge.

EXHIBIT 11-129A

BARBER HAULROAD MODIFICATION
AS-BUILT

DRAWING

SHEET 1 OF 3

LOCATION

BHP-NAVAJO COAL CO.
PO BOX 155, FRUITLAND, NEW MEXICO, 87416

PROJECT MANAGER: GREG PERKINS
ENGR. of RECORD: LEONARD RAYMOND
REG. NO. 6600
SRVYR of RECORD: REG. NO.

REVISION	DATE
1	
2	
3	
4	
5	

ACCOUNT:
DATE: 10/09/09
DESIGNED BY: BEN MOSKIE
DRAWN BY: BEN MOSKIE
CHECKED BY: LEONARD RAYMOND
APPROVED BY: LEONARD RAYMOND

Project Desc.: Path: G:\Departments\GIS\GIS_SRVR\PEL_PROJ\CM_11_PAP Exhibit\11-129-BARBER HAULROAD\ASBUILT\11_129A.prm Plot time: Wed Aug 17 08:45:30 2005