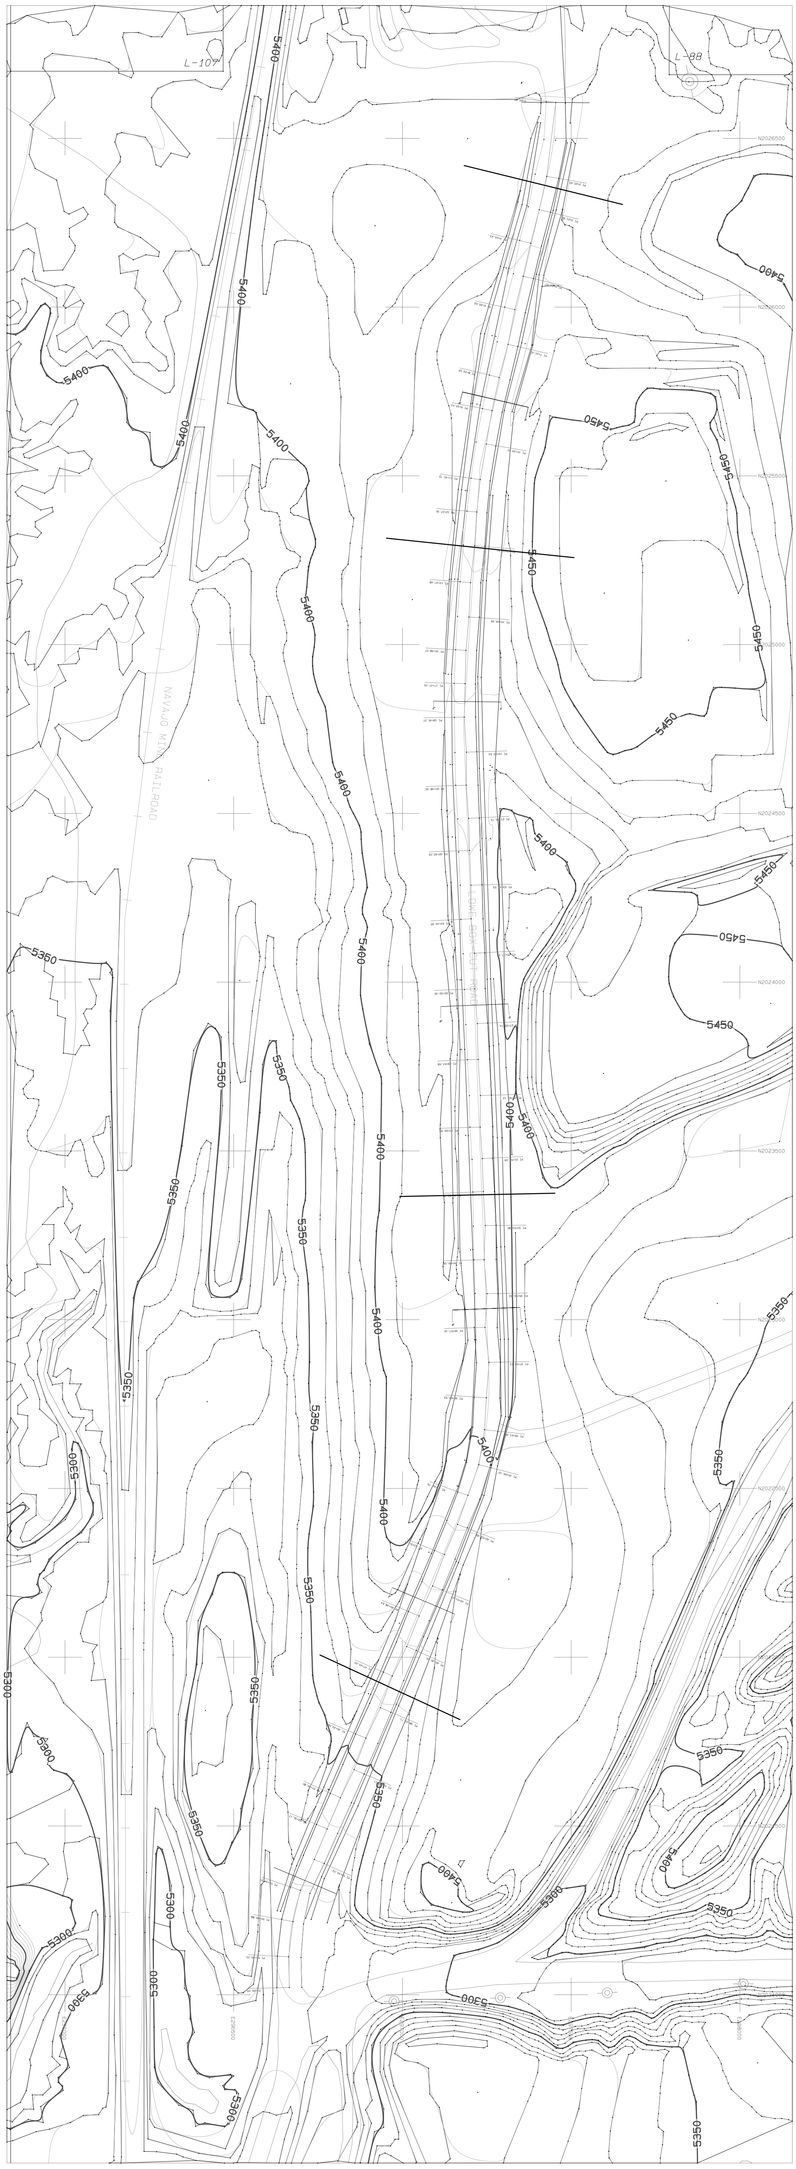

LOWE PIT HAULROAD

AS-BUILT MINING HAULROADS

(PRJD_proj_name2)

PLAN & PROFILE

ACCOUNT: PRJD_151N/185N
DATE: June 7, 1995
DESIGNED BY: D RAWSON/BTSAMBIRSKY
DRAWN BY: PJFOSTER
CHECKED BY: BTSAMBIRSKY/LEONARD RAYMOND
APPROVED BY: LEONARD RAYMOND

BHP-NAVAJO COAL CO.

PO BOX 155, FRUITLAND, NEW MEXICO, 87416

PROJECT MANAGER: L. RAYMOND/PE/NMReg. No. 8
ENGR. of RECORD: BTSAMBIRSKY/PJFOSTER
REG. NO: None
SRVYR of RECORD: ROBERT BENALLY
REG. NO: 11362

REVISION	DATE
1	
2	
3	
4	
5	

SHEET 1 OF 1

Project Desc.: LOWE BOX-CUT ROAD AS-BUILT Path: G:\Departments\Ga\UGM_SUBWPER_PROG\CH_11_PAP EXHIBITS\11-103-LOWE BOX-Cut HAULRD\EXHIBITS\11-103D_H.PRO Plot time: Thu Aug 04 11:46:32 2005