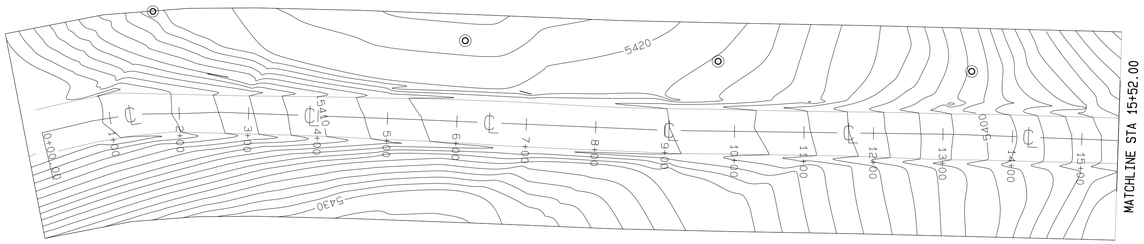

PLAN VIEW
SCALE: 1′ = 100′

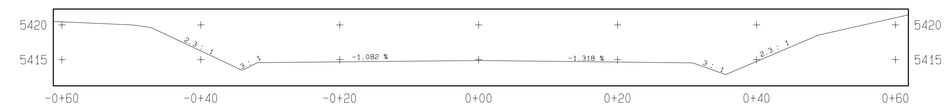

STATION 6+00
SCALE: 1" = 10′

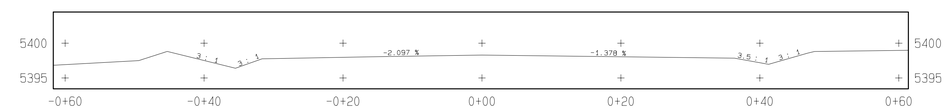

STATION 14+00
SCALE: 1" = 10′

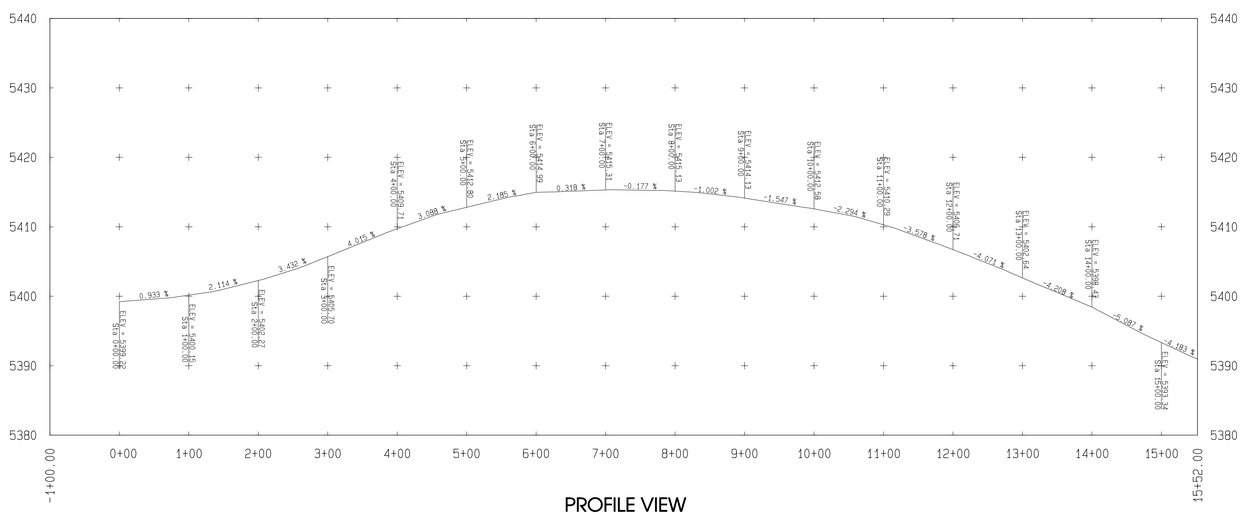

PROFILE VIEW
HORZ. SCALE: 1" = 100′
VERT. SCALE: 1" = 10′

EXHIBIT 11-129B

BARBER HAULROAD MODIFICATION
AS-BUILT

LEONARD RAYMOND
NEW MEXICO
6600
REGISTERED PROFESSIONAL ENGINEER

CERTIFICATION STATEMENT

I, Leonard Raymond, hereby certify that this drawing was reviewed by me and that the information shown is accurate and complete to the best of my knowledge.

REVISION	DATE
1	
2	
3	
4	
5	

PROJECT MANAGER: GREG PERKINS
ENGR. of RECORD: LEONARD RAYMOND
REG. NO. 6600
SRVYR of RECORD:
REG. NO.

BHP-NAVAJO COAL CO.
PO BOX 155, FRUITLAND, NEW MEXICO, 87416

ACCOUNT: 11/05/09
DATE: 11/05/09
DESIGNED BY: BEN HOSKIE
DRAWN BY: BEN HOSKIE
CHECKED BY: LEONARD RAYMOND
APPROVED BY: LEONARD RAYMOND

PLAN & PROFILE

DRAWING

SHEET 2 OF 2

PROJECT DESC: PATH: G:\Departments\GOR_Surveyor\Projects\11_Jobs\EXHIBIT11-129-BARBER HAULROAD\ASBUILT\11_129A.prp PLOT TIME: Wed Aug 17 08:42:17 2005