BHP MINERALS INTERNATIONAL INC.

NAVAJO MINE

AREA II SHOP/OFFICE
ACCESS ROAD

INDEX OF DRAWINGS

EXH. 11-112A PLAN & PROFILE, STA. 0+00 TO 6+74

EXH. 11-112B PLAN & PROFILE, STA. 0+00 TO 30+00

EXH. 11-112C PLAN & PROFILE, STA. 30+00 TO 45+17

EXH. 11-112D TYPICAL CROSS-SECTION

EXH. 11-112E CATTLE CROSSING PLAN VIEW (CP-66)

EXH. 11-112F CATTLE CROSSING CROSS-SECTION (CP-66)

EXH. 11-112G CUT SECTION, C-C

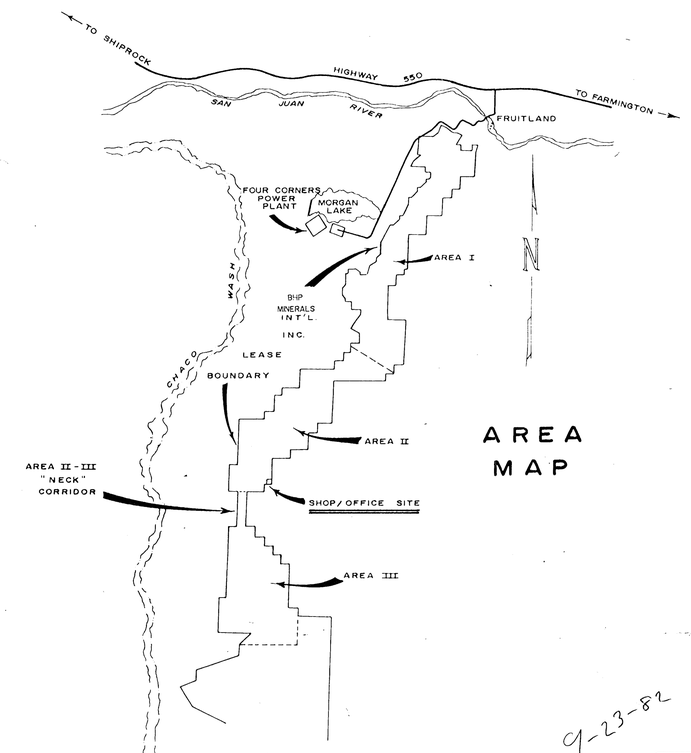

AREA MAP

MAR 1996 APPROVED

NO 8304 REGISTERED PROFESSIONAL

9-23-82

REV.	DATE	DESCRIPTION
3	03-08-1996	ADDED EXHIBIT NUMBER.
REV.-2	11-11-82	AS BUILTS
REV. 1	10-1-82	ISSUED FOR PAVING CONSTRUCT.
REV-0	9-23-82	ISSUED FOR PAVING BIDDING

EXHIBIT 11-112

BHP MINERALS INTERNATIONAL INC.

NAVAJO MINE

FRUITLAND, NEW MEXICO

INDEX SHEET

DRAWN BY	SCALE	
APPROVED BY	DATE	
DRAWING NO.		LOCATION NO.