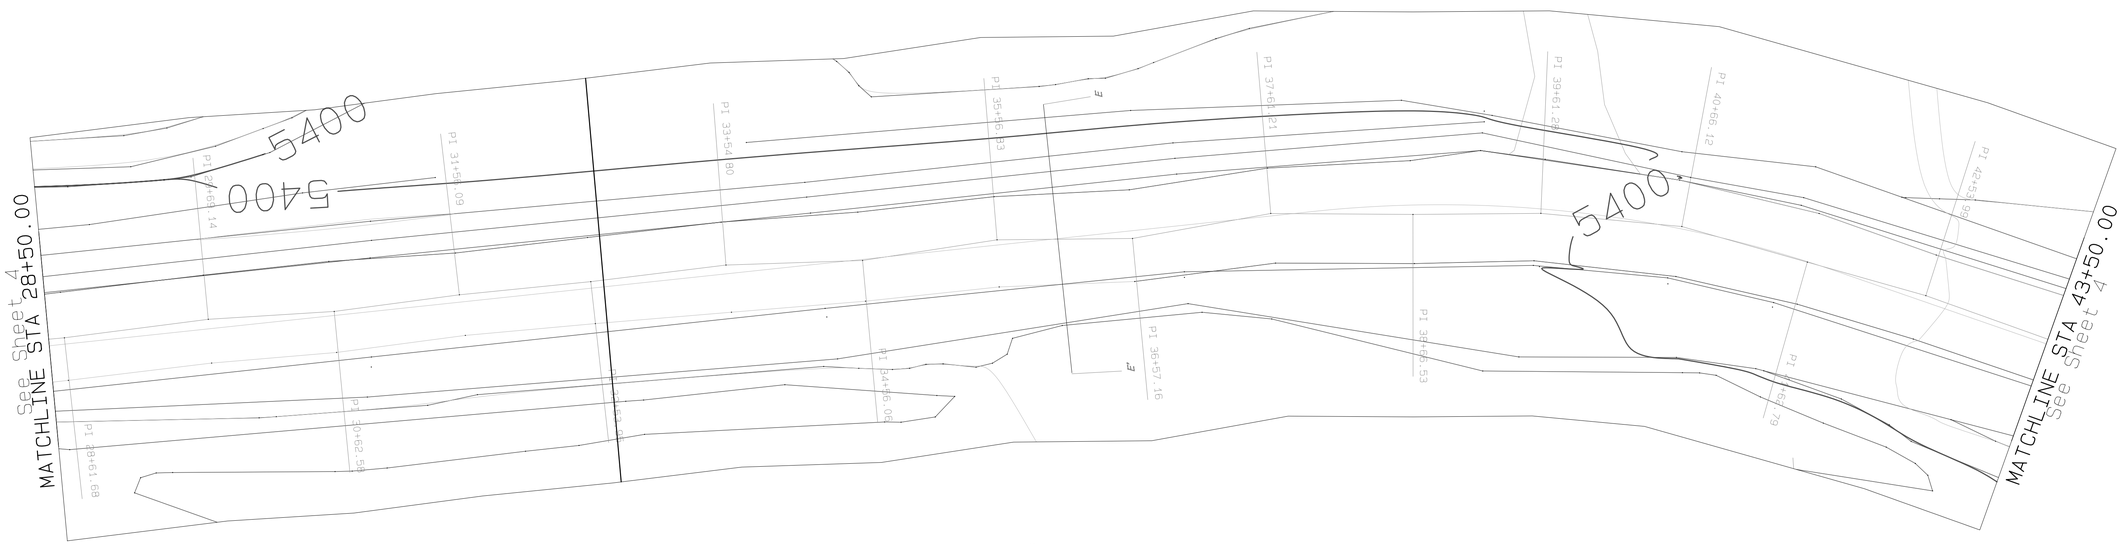

CL

PLAN VIEW

Hztl. Scale: 1" = 50'

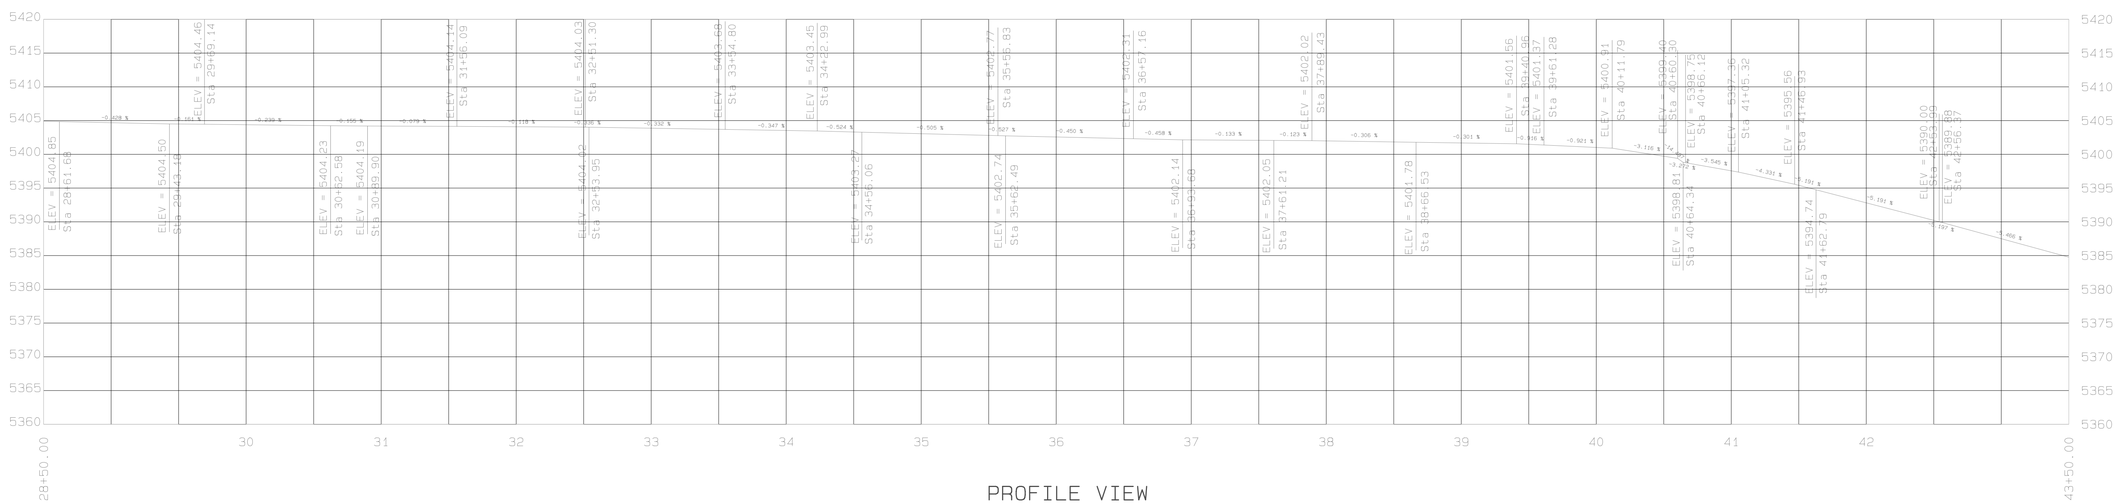

PROFILE VIEW

Vert. Scale: 1" = 10'

REGISTERED PROFESSIONAL ENGINEER
LEONARD RAYMOND
NEW MEXICO
6600

REVISION	DATE
1	
2	
3	
4	
5	

PROJECT MANAGER: L. RAYMOND/R. TURNER, INC.
ENGR of RECORD: STEVE/DAVID/JAY/JOSH
REG. NO. None
SRVYR of RECORD: ROBERT BENALLY
REG. NO. None

BHP-NAVAJO COAL CO.

PO Box 155, FRUITLAND, NEW MEXICO, 87416

ACCOUNT: PRJD_FEIN/IBSN
DATE: JUN 27, 1996
REVISED BY: R.RAYMOND/S.SMALTSKY
DRAWN BY: P.JFOSTER
CHECKED BY: B'SAMEJTSKY/L'EONARD RAYMOND
APPROVED BY: LEONARD RAYMOND

PLAN & PROFILE

LOWE PIT HAULROAD

AS-BUILT MINING HAULROADS

(PRJD_proj_name2)

DRAWING P-3

SHEET 3 OF 4

Project Desc.: LOWE BOX-CUT ROAD AS-BUILT Path: G:\Departments\GIS\DGN_SUBMIT\PDF_PROJECTS\LOWE BOX-CUT HAULROAD\EXHIBIT\11-103-LOWE BOX-CUT HAULROAD\EXHIBIT\11-103_P1.PRD Plot time: Thu Aug 04 11:48:43 2005