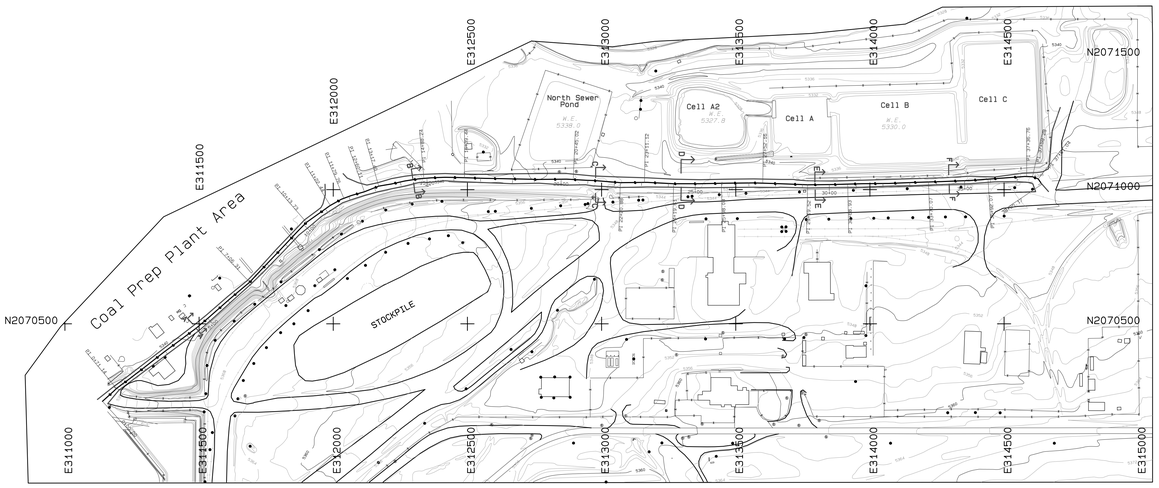

LOCATION MAP
SCALE: 1" = 200'

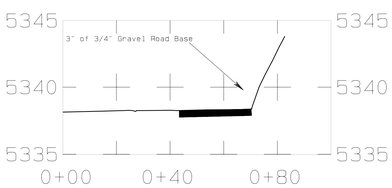

Section A - A

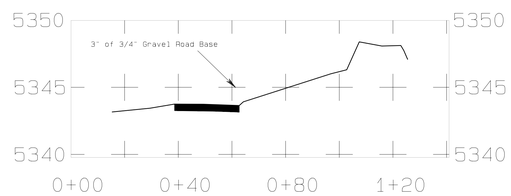

Section C - C

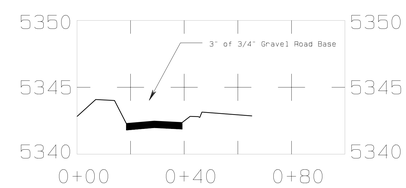

Section E - E

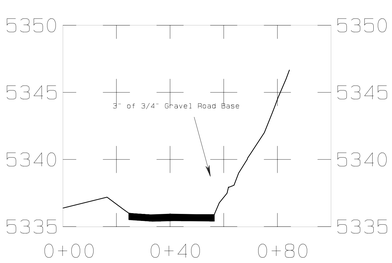

Section B - B

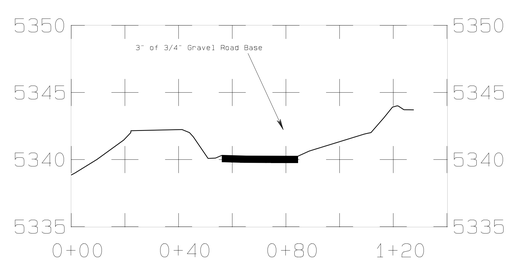

Section D - D

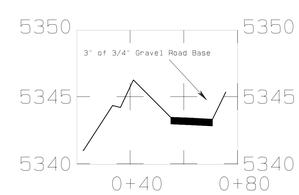

Section F - F

CROSS SECTIONAL SCALES
VERTICAL: 1" = 5'
HORIZONTAL: 1" = 20'

LEGEND

- PAVED ROAD
- DIRT ROAD
- HAUL ROAD
- TRAIL
- BUILDING
- FENCE
- IRRIGATION LINE
- CULVERT
- DAM
- DRAINAGE
- RAILROAD
- POWERLINE
- × 5338.5 SPOT ELEVATION
- 5300 INDEX CONTOUR
- INTERMEDIATE CONTOUR
- 218 5422.45 HORIZ. & VERT. CONTROL
- L-30 LEASE CORNER
- LEASE BOUNDARY
- CENTER LINE

NOTES

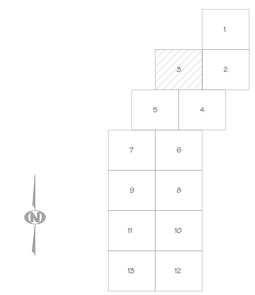

CERTIFICATION STATEMENT

I, Leonard Raymond, hereby certify that this drawing was reviewed by me and that the information shown is accurate and complete to the best of my knowledge.

LEONARD RAYMOND
NEW MEXICO
6600
REGISTERED PROFESSIONAL ENGINEER

REV. No.	DATE	DRAFT. BY	REVISION DESCRIPTION	ENG.	E.G.	P.E.	P.S.	CHIEF ENG.
A	10/8/96	VAH	SUBMITTED TO OSM					

APPROVALS

EXHIBIT 11-122A

NAVAJO COAL COMPANY

NAVAJO MINE

P.O. BOX 155 FRUITLAND, NEW MEXICO 87416

AREA I

"AS-BUILT"

COAL PLANT ROAD

PREPARED BY VAH	DRAWN BY VAH	SCALE AS NOTED
APPROVED BY LR	DATE 10/8/96	REF DWG EX. 11-80
DWG LOC C:\VIC\PROJ\CLPLNTRD\ASBUILD.PRO		SHEET 1 OF 4