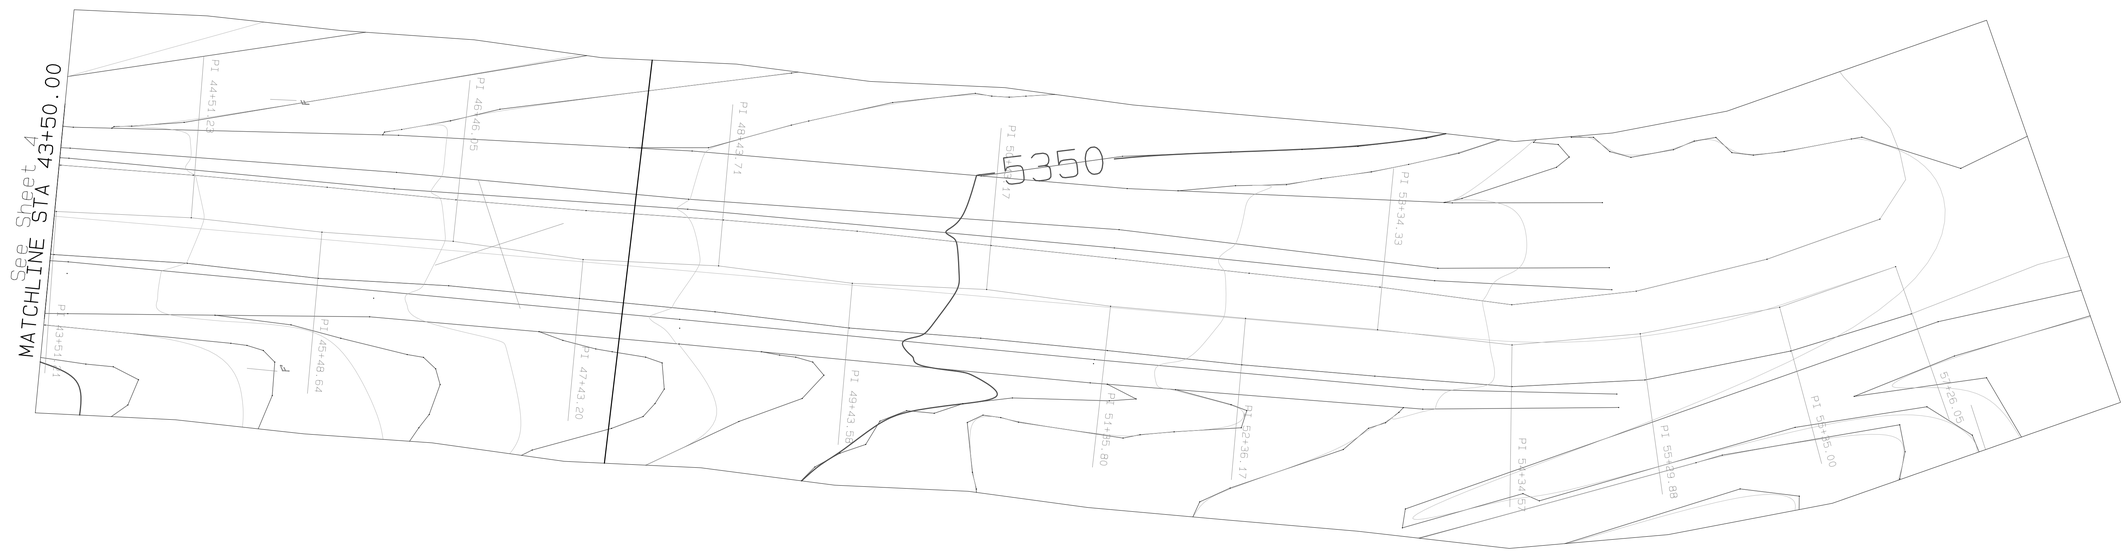

PLAN VIEW

Hztl. Scale: 1" = 50'

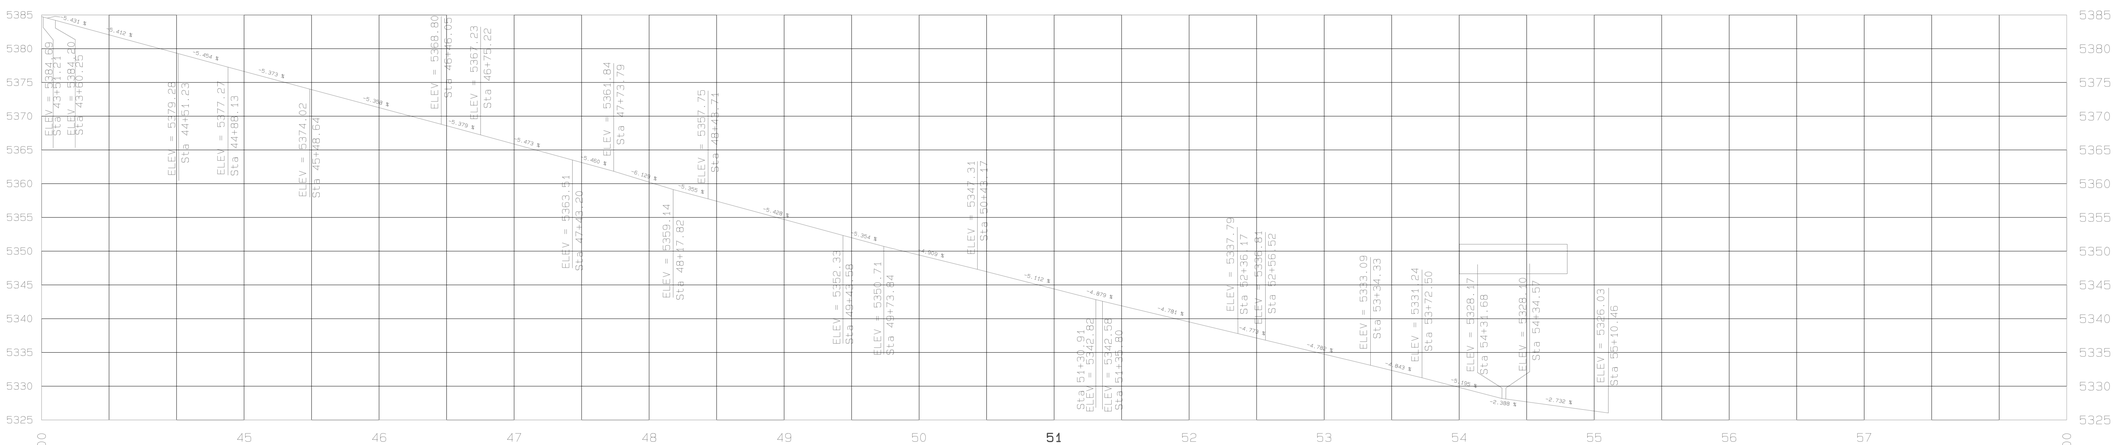

PROFILE VIEW

Vert. Scale: 1" = 10'

LEONARD RAYMOND
NEW MEXICO
6600
REGISTERED PROFESSIONAL ENGINEER

BHP-NAVAJO COAL CO.

PO BOX 155, FRUITLAND, NEW MEXICO, 87416

PROJECT MANAGER: L. RAYMOND/PE/PMP, Inc.
ENGR of RECORD: BISMARCK/LAFORCE
REG. NO. None
SRVYR of RECORD: ROLBERT BENALLY
REG. NO. None

	REVISION	DATE
1		
2		
3		
4		
5		

ACCOUNT: PRJD_151N/18SW
DATE: June 1998
DESIGNED BY: D.HARRIS/BISMARCK
DRAWN BY: PJFOSTER
CHECKED BY: BISMARCK/LEONARD RAYMOND
APPROVED BY: LEONARD RAYMOND

PLAN & PROFILE

LOWE PIT HAULROAD

AS-BUILT MINING HAULROADS

(PRJD_proj_name2)

DRAWING P-4

SHEET 4 OF 4

PROJECT DESC.: LOWE BOX-CUT ROAD AS-BUILT PATH: G:\DEPARTMENTS\GIS\BCR_SERVER_PROJ\CP_13_PMP EXHIBIT\151-103-LOWE BOX-CUT HAULROD\EXHIBIT\151-103_P1.PRD PLOT TIME: Thu Aug 04 11:49:39 2005