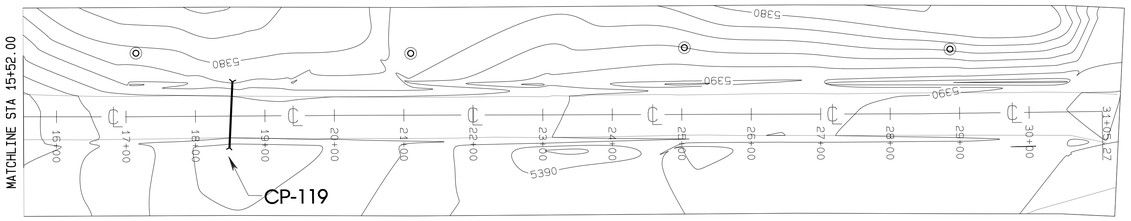

PLAN VIEW
SCALE: 1" = 100'

STATION 20+00
SCALE: 1" = 10'

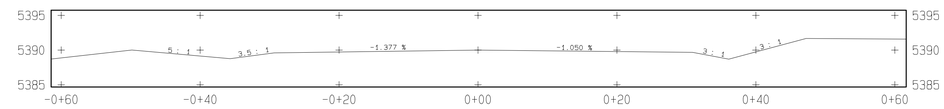

STATION 27+00
SCALE: 1" = 10'

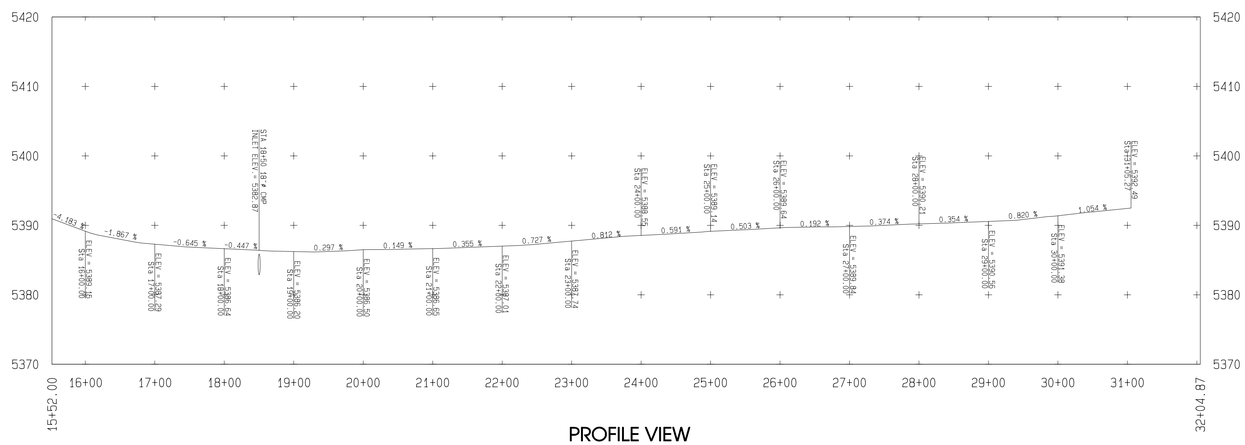

PROFILE VIEW
HORZ. SCALE: 1" = 100'
VERT. SCALE: 1" = 10'

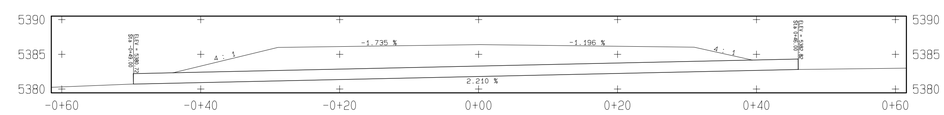

STATION 18+50
CP-119 CROSS SECTION
SCALE: 1" = 10'

CERTIFICATION STATEMENT

I, Leonard Raymond, hereby certify that this drawing was reviewed by me and that the information shown is accurate and complete to the best of my knowledge.

LEONARD RAYMOND
NEW MEXICO
6600
REGISTERED PROFESSIONAL ENGINEER

EXHIBIT 11-129C

BARBER HAULROAD MODIFICATION
AS-BUILT

DRAWING

SHEET
OF

REVISION | DATE
1 | 2 | 3 | 4 | 5

PROJECT MANAGER: GREG PERKINS
ENGR. of RECORD: LEONARD RAYMOND
REG. NO. 6600
SRVYR of RECORD:
REG. NO.

BHP-NAVAJO COAL CO.
PO BOX 155, FRUITLAND, NEW MEXICO, 87416

PLAN & PROFILE

ACCOUNT:
DATE: 10/09/08
DESIGNED BY: BEN HOSKTE
DRAWN BY: BEN HOSKTE
CHECKED BY: LEONARD RAYMOND
APPROVED BY: LEONARD RAYMOND

PROJECT DESC.: PATH: G:\DEPARTMENTS\DSM_SUBMODEL_PROD\DM_11_PAP EXHIBIT11-129-BARBER HAUL ROAD\AS-BUILT\11_129A.DPG PLOT TIME: WED AUG 17 08:44:46 2005