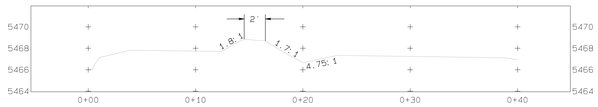

STATION 2+00

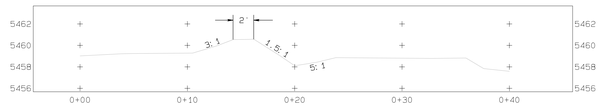

STATION 6+00

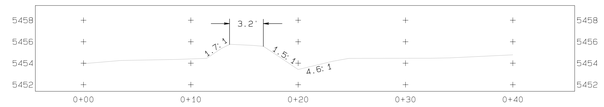

STATION 10+00

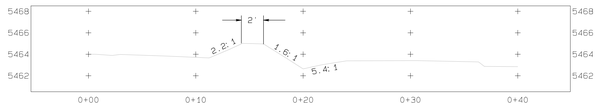

STATION 4+00

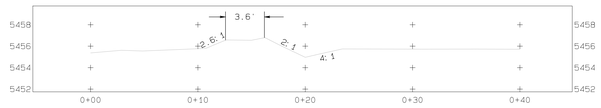

STATION 8+00

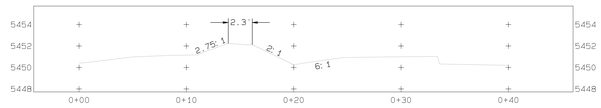

STATION 12+00

SECTIONS
SCALE: 1" = 5'

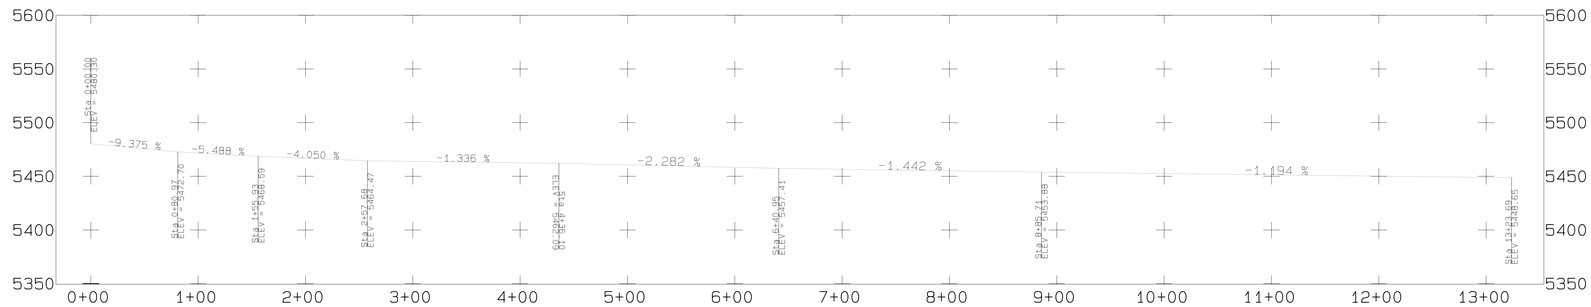

PROFILE
SCALE: 1" = 50'

PLAN
SCALE: 1" = 50'

LEGEND

- PAVED ROAD
- DIRT ROAD
- HAUL ROAD
- TRAIL
- BUILDING
- FENCE
- IRRIGATION LINE
- CULVERT
- DAM
- DRAINAGE
- RAILROAD
- TREES
- POWERLINE
- ×5339.5 SPOT ELEVATION
- 5300 INDEX CONTOUR
- 5299 INTERMEDIATE CONTOUR
- 218 5482.45 L-30 LEASE CORNER

NOTES

1. For hydrology and design information refer to Appendix 11-2 in the approved PAP.

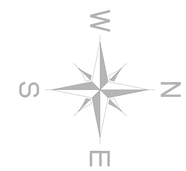

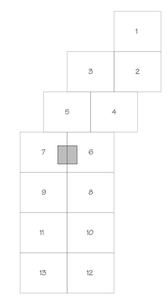

CERTIFICATION STATEMENT

I, Leonard Raymond, hereby certify that this drawing was reviewed by me and that the information shown is accurate and complete to the best of my knowledge.

LEONARD RAYMOND NEW MEXICO 6600 REGISTERED PROFESSIONAL ENGINEER

REV. No.	DATE	DRAFT. BY	REVISION DESCRIPTION	ENG.	E.S.	P.E.	P.S.	CHIEF ENG.
A	8/97	BH	SUBMITTED TO OSM FOR REVIEW					

APPROVALS

EXHIBIT 11-116A

NAVAJO COAL COMPANY

NAVAJO MINE — SAFETY PAYS

P.O. BOX 155 FRUITLAND, NEW MEXICO 87416

AREA III

"AS BUILT"

AREA III TEMPORARY DIVERSION

PREPARED BY BH	DRAWN BY BH	SCALE AS NOTED
APPROVED BY LR	DATE 8/07/97	REF DWG
DWG LOC G:\Departments\Gs\OSM_SUBM\PER_PROG\CH_11_PAP		