CATTLE CROSSING
(CP-66)
PLAN VIEW

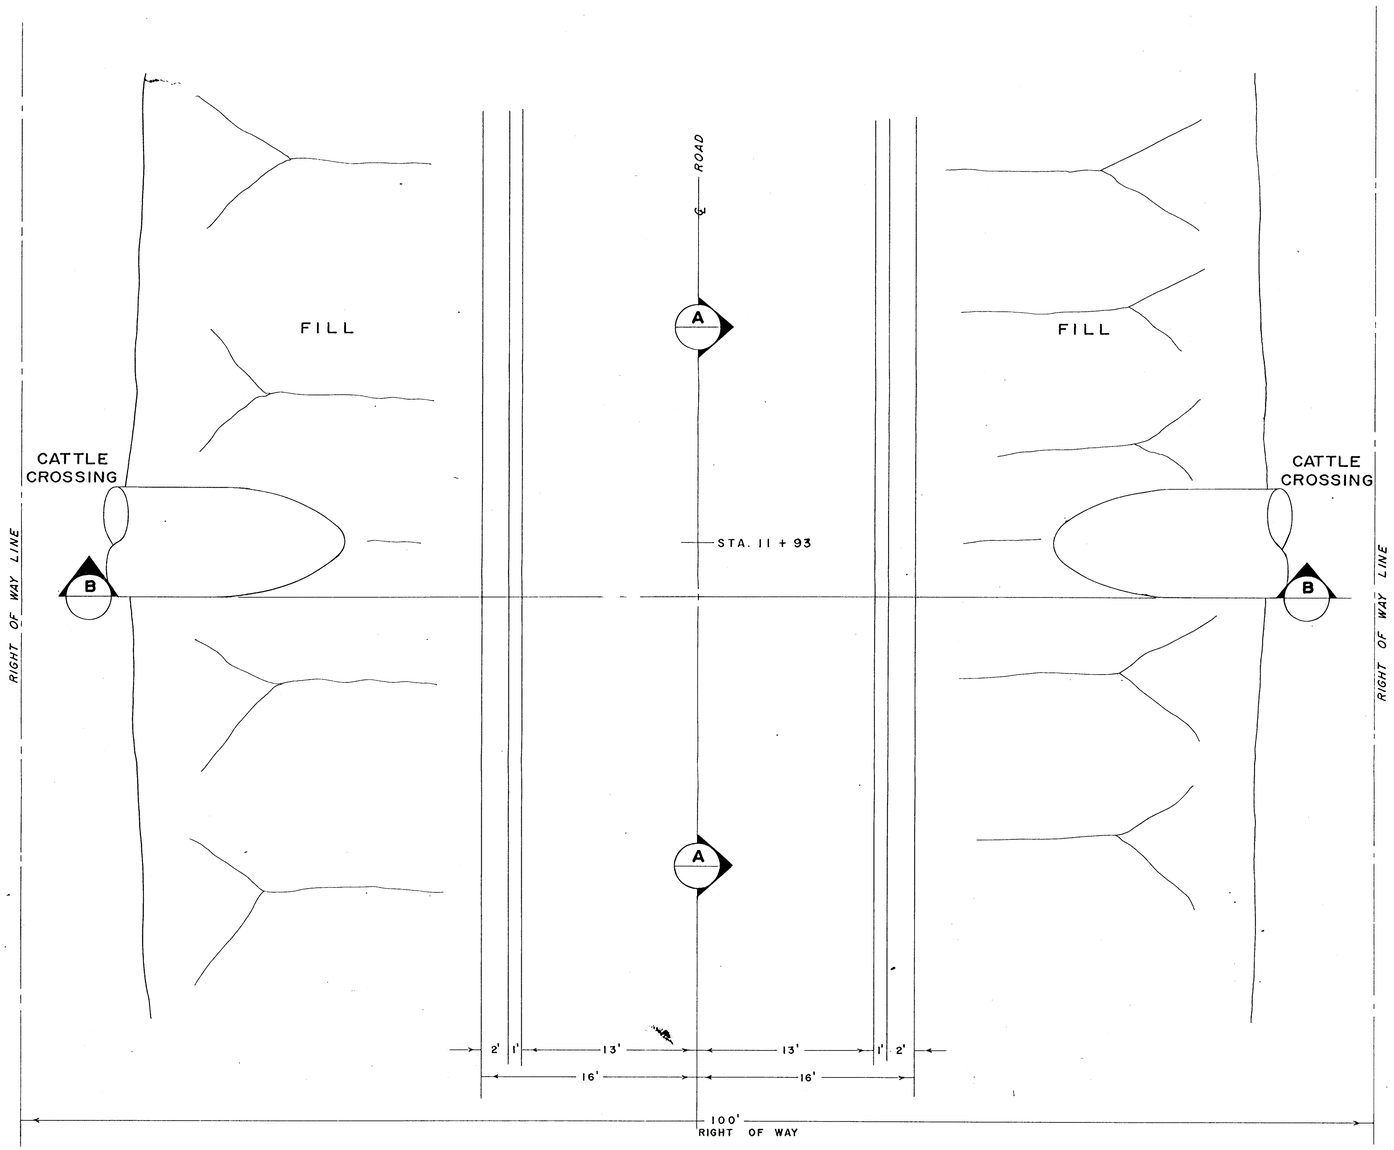

NOTES:

1. FOR ROAD PLAN AND PROFILE SEE EXH. 8-112A THRU 8-112C.
2. FOR TYPICAL CROSS SECTION SEE EXH.8-112D.
3. CATTLE CROSSING IS TO BE CORRUGATED METAL PIPE, 86 FT. LONG, 12 GAUGE, 3 x 1 CORRUGATIONS, BITUMINOUS COATED.
4. FOR CUT SECTION C-C SEE EXH.8-112G.

MAR 1996 APPROVED

LEONARD NAVENONA NEW MEXICO 6800 REGISTERED PROFESSIONAL ENGINEER

EXHIBIT 11-112E

BHP MINERALS INTERNATIONAL INC.

NAVAJO MINE

FRUITLAND, NEW MEXICO

SHOP/OFFICE ACCESS ROAD
CATTLE CROSSING
PLAN VIEW

DRAWN BY J.GOLBE	SCALE AS SHOWN	
APPROVED BY	DATE 6/3/82	
DRAWING NO.		LOCATION NO.

REV. 1	03-08-1996	"AS-BUILT"	