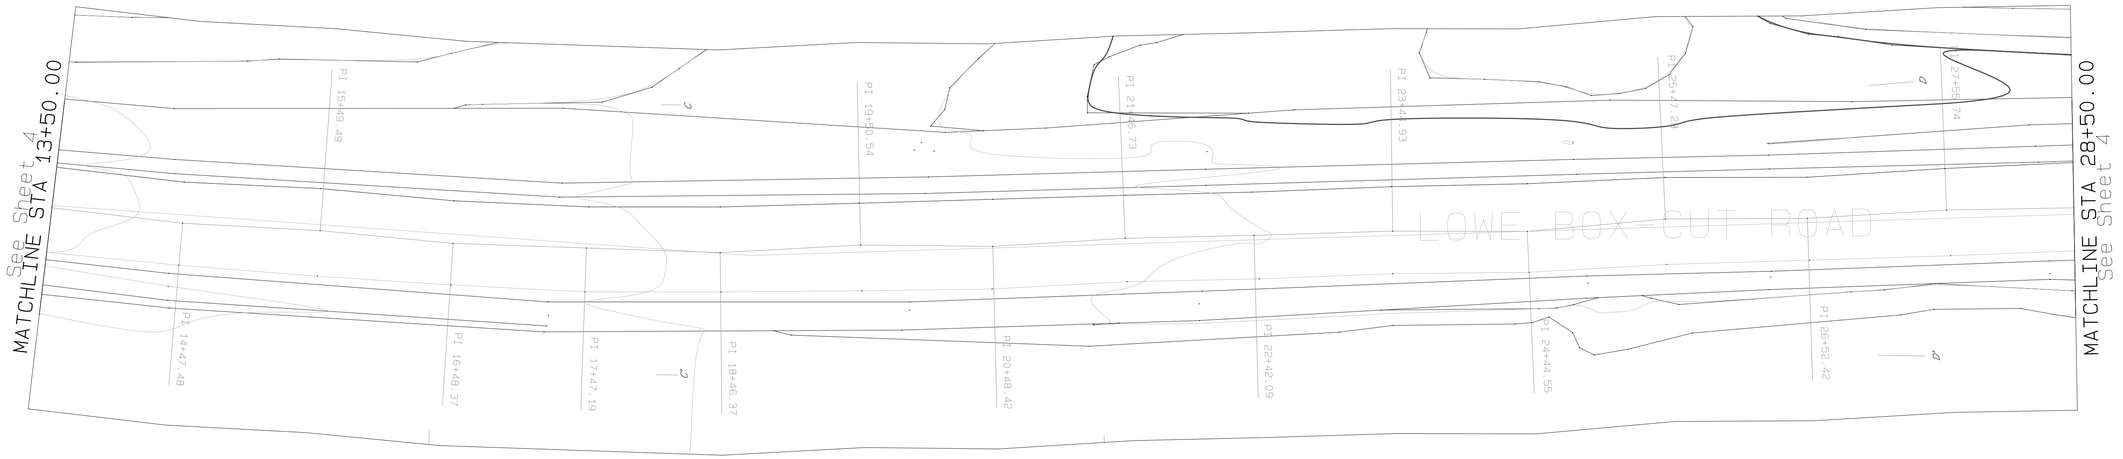

CL

PLAN VIEW

Hztl. Scale: 1" = 50'

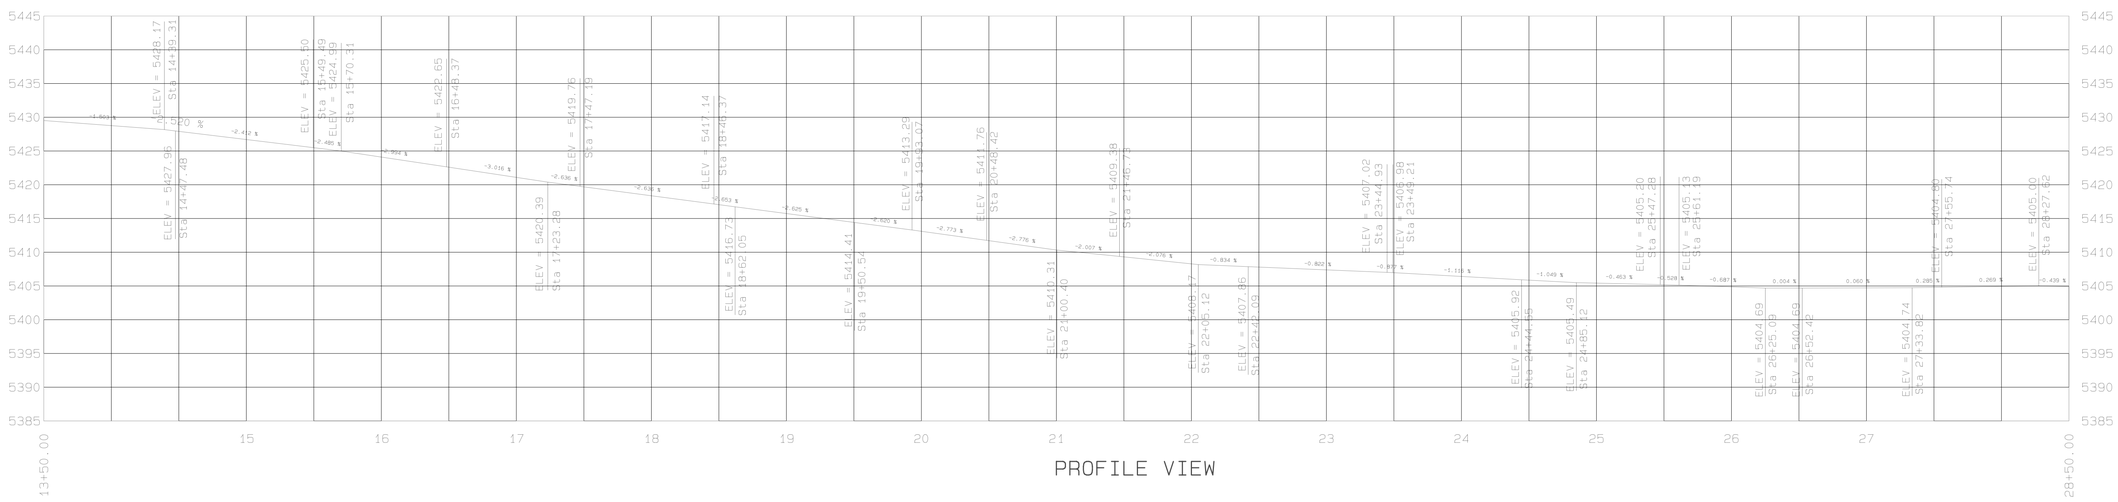

PROFILE VIEW

Vert. Scale: 1" = 10'

REVISION	DATE
1	
2	
3	
4	
5	

PROJECT MANAGER: L. RAYMOND/WC/TRANS, INC.
ENGR of RECORD: STANDARD/LAYOUTS
REG. NO: None
SRVYR of RECORD: ROBERT BENALLY
REG. NO: None

BHP-NAVAJO COAL CO.

PO BOX 155, FRUITLAND, NEW MEXICO, 87416

ACCOUNT: PRJD_151N/19SN
DATE: June 1996
DESIGNED BY: DAVID/GRAMBRISKY
DRAWN BY: PJFOSTER
CHECKED BY: BISMBRISKY/LEONARD RAYMOND
APPROVED BY: LEONARD RAYMOND

PLAN & PROFILE

LOWE PIT HAULROAD

AS-BUILT MINING HAULROADS

(PRJD_proj_name2)

DRAWING P-2

SHEET 2 OF 4

PROJECT DESC.: LOWE BOX-CUT ROAD AS-BUILT PATH: G:\DEPARTMENTS\GIS\BCR_SUBMITS\PRJD\CD_13_DWG EXH\B11\11-103-LOWE BOX-CUT HAULRD\EXH\B11S11-103D_P1.DWG PLOT TIME: Thu Aug 04 11:47:50 2005