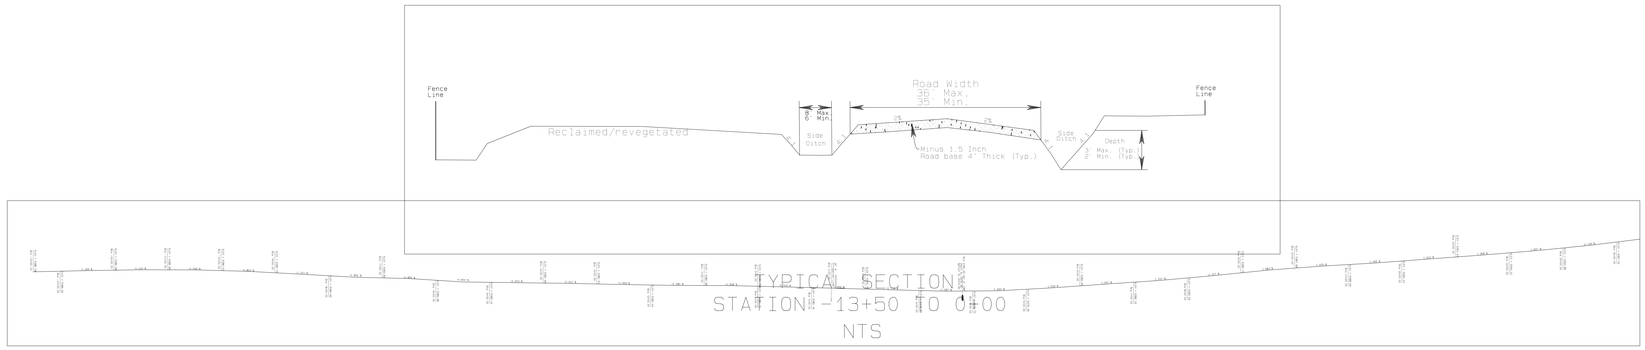

TYPICAL SECTION
STATION -13+50 TO 0+00
NTS

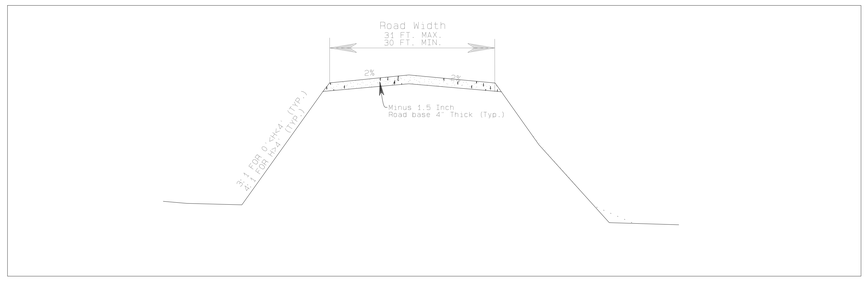

TYPICAL SECTION
STATION 0+00 TO 37+75
NTS

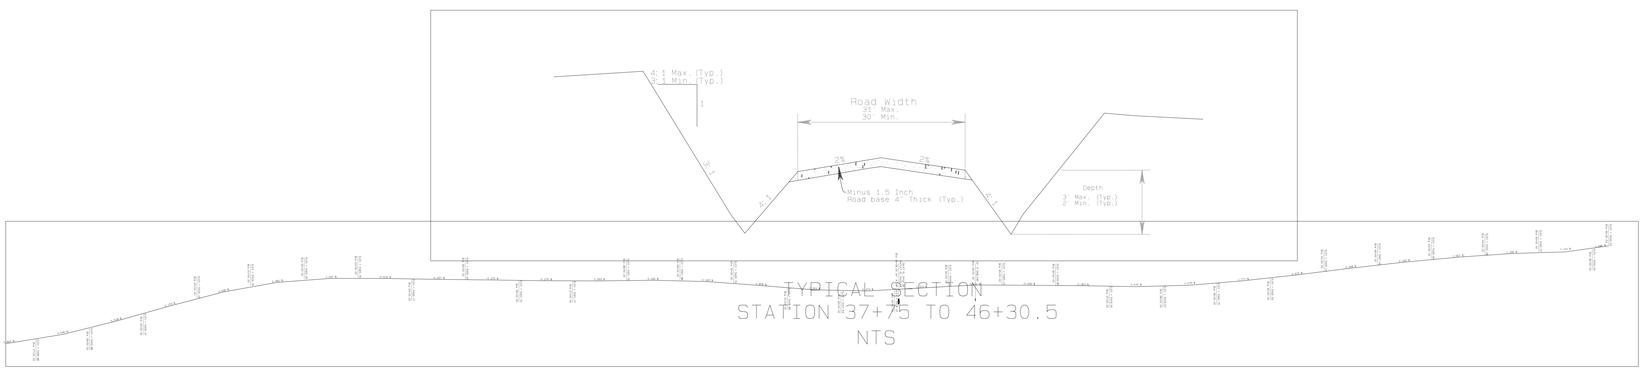

TYPICAL SECTION
STATION 37+75 TO 46+30.5
NTS

LEGEND

- ROAD
- WATERSHED
- BUILDING
- FENCE
- IRRIGATION LINE
- CULVERT
- DAM
- DRAINAGE
- RAILROAD
- TREES
- POWERLINE
- ×5338.5 SPOT ELEVATION
- 5300 INDEX CONTOUR
- 5298 INTERMEDIATE CONTOUR
- 218 5422.45 LEASE CORNER
- L-30

NOTES

1. For hydrology and design information refer to Appendix II-AA in the approved PAP.

N
W E
S

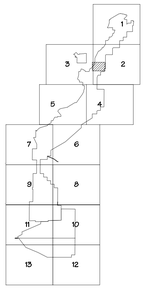

CERTIFICATION STATEMENT

I, Leonard Raymond, hereby certify that this drawing was reviewed by me and that the information shown is accurate and complete to the best of my knowledge.

LEONARD RAYMOND
NEW MEXICO
6600
REGISTERED PROFESSIONAL ENGINEER

REV. No.	DATE	DRAFT BY	REVISION DESCRIPTION	ENG.	E & P	P.S.	CHIEF ENGR. APPROVALS
A	06/19/98	RY	ASBUILT				

EXHIBIT 11-119F

NAVAJO COAL COMPANY

NAVAJO MINE

P.O. BOX 155 FRUITLAND, NEW MEXICO 87416

ASBUILT
RAMP 7 RE ALIGNMENT
CROSS SECTION MAP

PREPARED BY RY	DRAWN BY RY	AS NOTED
APPROVED BY LR	DATE 06/19/98	REF DWG
DWG LOC	G:\Departments\Ds\DSM_SUBM\PER_PROD\CH_11_PAP EXHIBIT\11-119-RAMP	