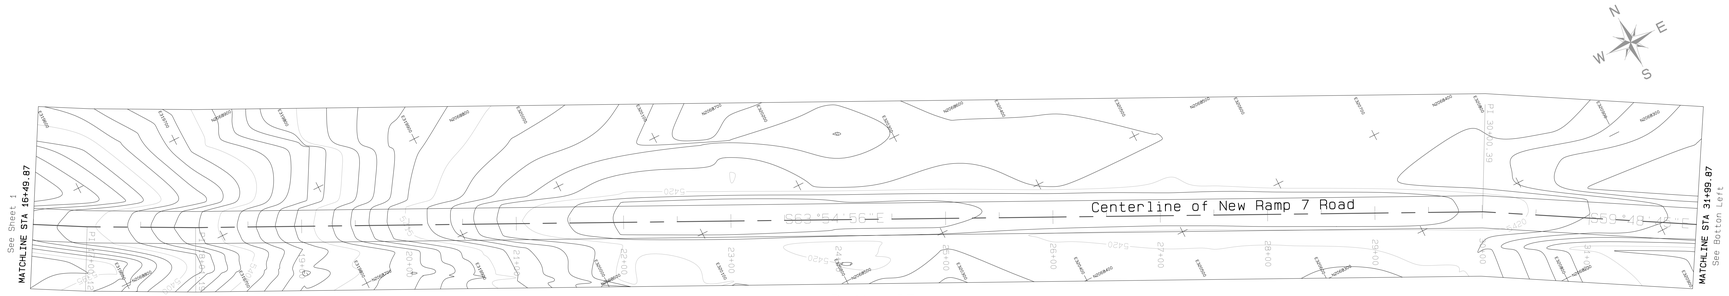

PLAN VIEW
Scale 1"=50 FT.

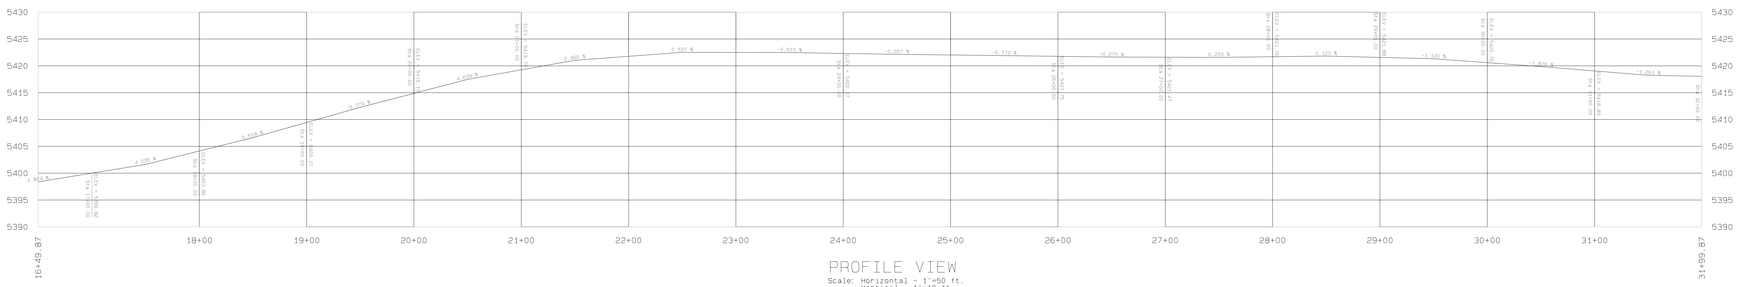

PROFILE VIEW
Scale: Horizontal - 1"=50 ft.
Vertical - 1"=10 ft.

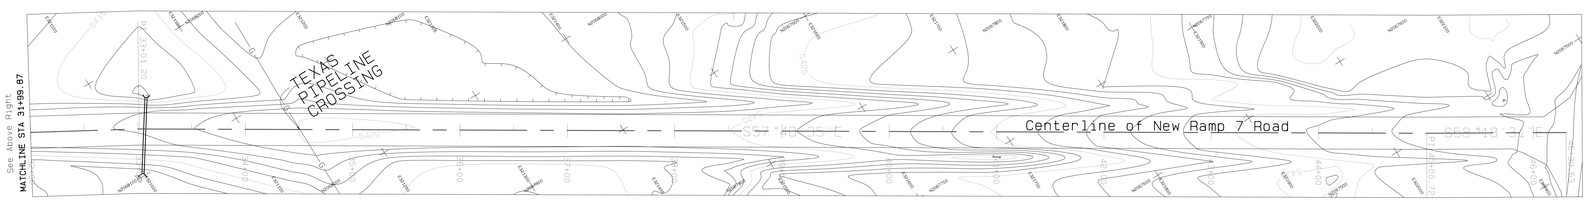

PLAN VIEW
Scale 1"=50 FT.

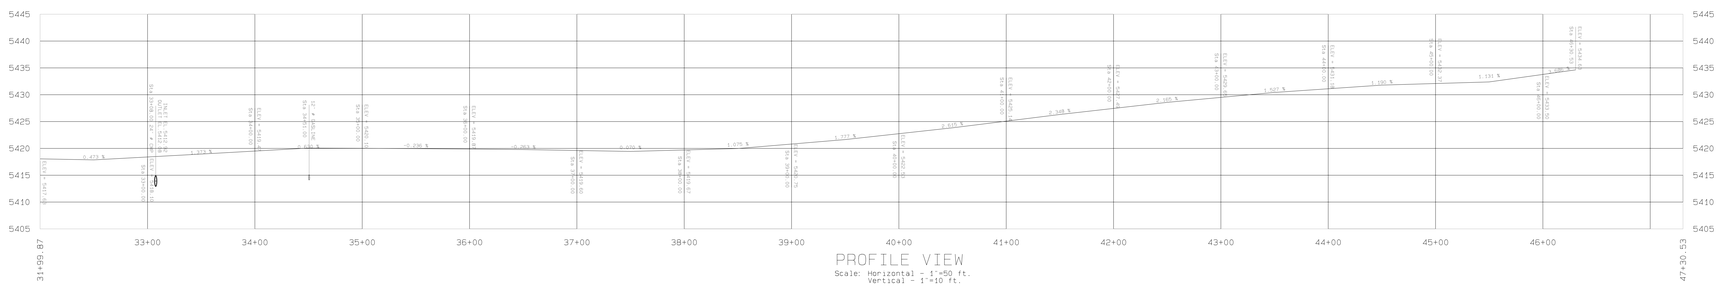

PROFILE VIEW
Scale: Horizontal - 1"=50 ft.
Vertical - 1"=10 ft.

LEGEND

- ROAD
- WATERSHED
- BUILDING
- FENCE
- IRRIGATION LINE
- CULVERT
- DAM
- DRAINAGE
- RAILROAD
- TREES
- POWERLINE
- ×5338.5 SPOT ELEVATION
- 5300 INDEX CONTOUR
- 5298 INTERMEDIATE CONTOUR
- 218 5422.45 LEASE CORNER
- L-30

NOTES

1. For hydrology and design information refer to Appendix 11-2 in the approved PAP.

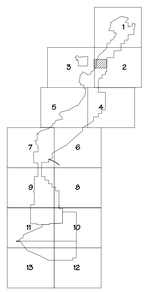

CERTIFICATION STATEMENT

I, Leonard Raymond, hereby certify that this drawing was reviewed by me and that the information shown is accurate and complete to the best of my knowledge.

LEONARD RAYMOND JOHNSON NEW MEXICO 6600 REGISTERED PROFESSIONAL ENGINEER

REV. No.	DATE	DRAFT. BY	REVISION DESCRIPTION	ENG.	E.G.	P.E.	P.S.	CODE APPROVALS
A	06/19/98	RY	ASBUILT					

EXHIBIT 11-119E

NAVAJO COAL COMPANY

NAVAJO MINE — SAFETY PRIDE EFFICIENCY PAYS

P.O. BOX 100 · FRUITLAND, NEW MEXICO 87416

ASBUILT
RAMP 7 ROAD REALIGNMENT
PLAN / PROFILE

PREPARED BY RY	DRAWN BY RY	SCALE AS NOTED
APPROVED BY LR	DATE 06/19/98	REF DWG
DWG LOC G:\Departments\Ds\DSM_SUBM\PER_PROT\CH_11_PAP EXHIBIT\11-119.DWG		