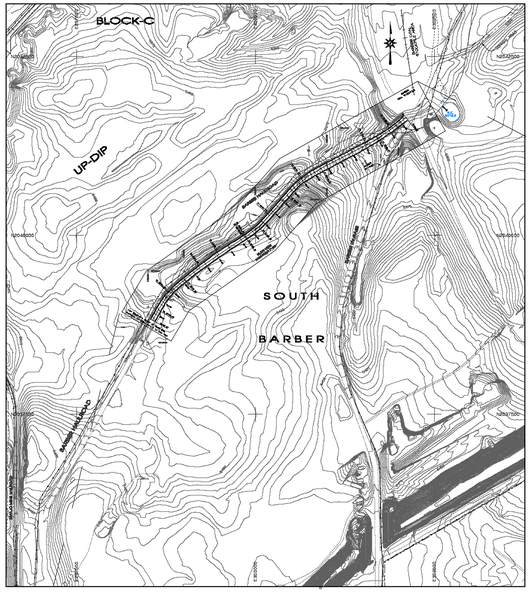

LOCATION MAP
SCALE: 1"=1000 '

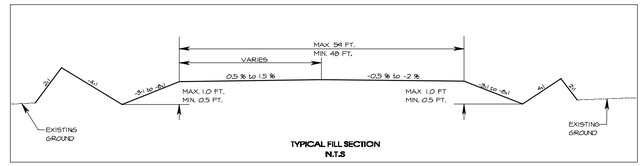

TYPICAL FILL SECTION
N.T.S

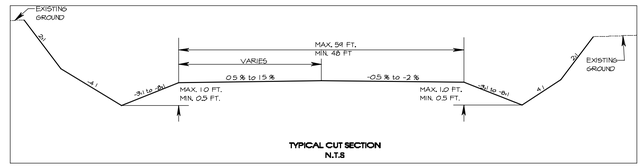

TYPICAL CUT SECTION
N.T.S

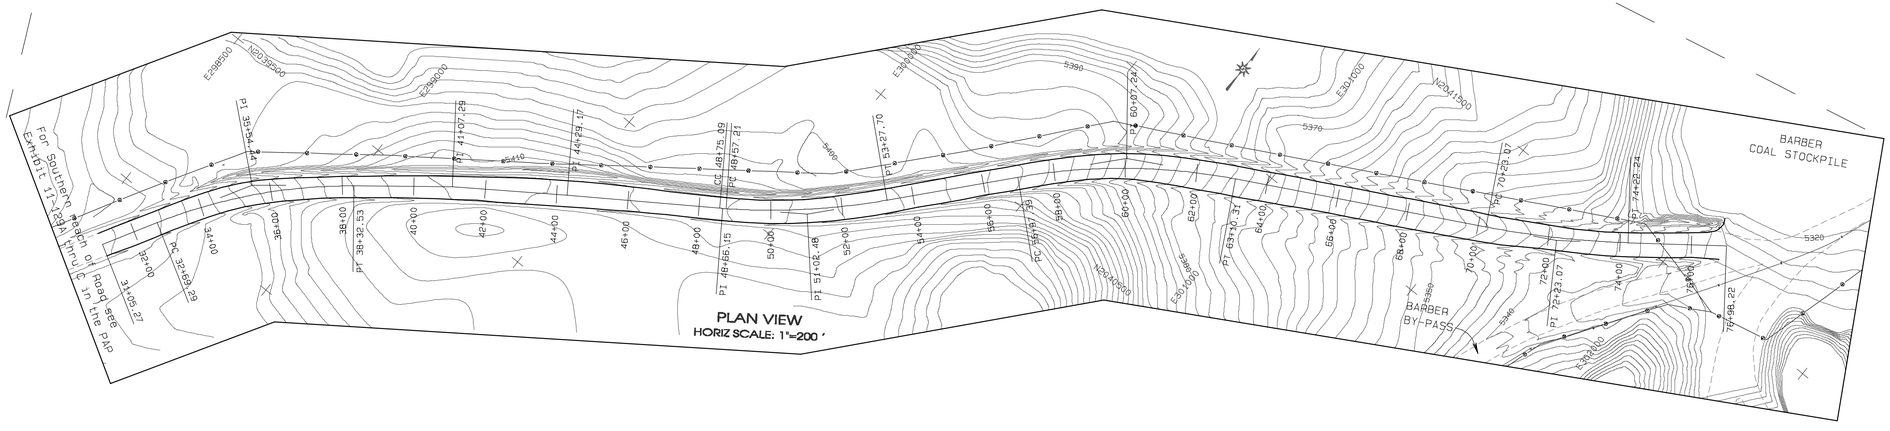

PLAN VIEW
HORIZ SCALE: 1"=200 '

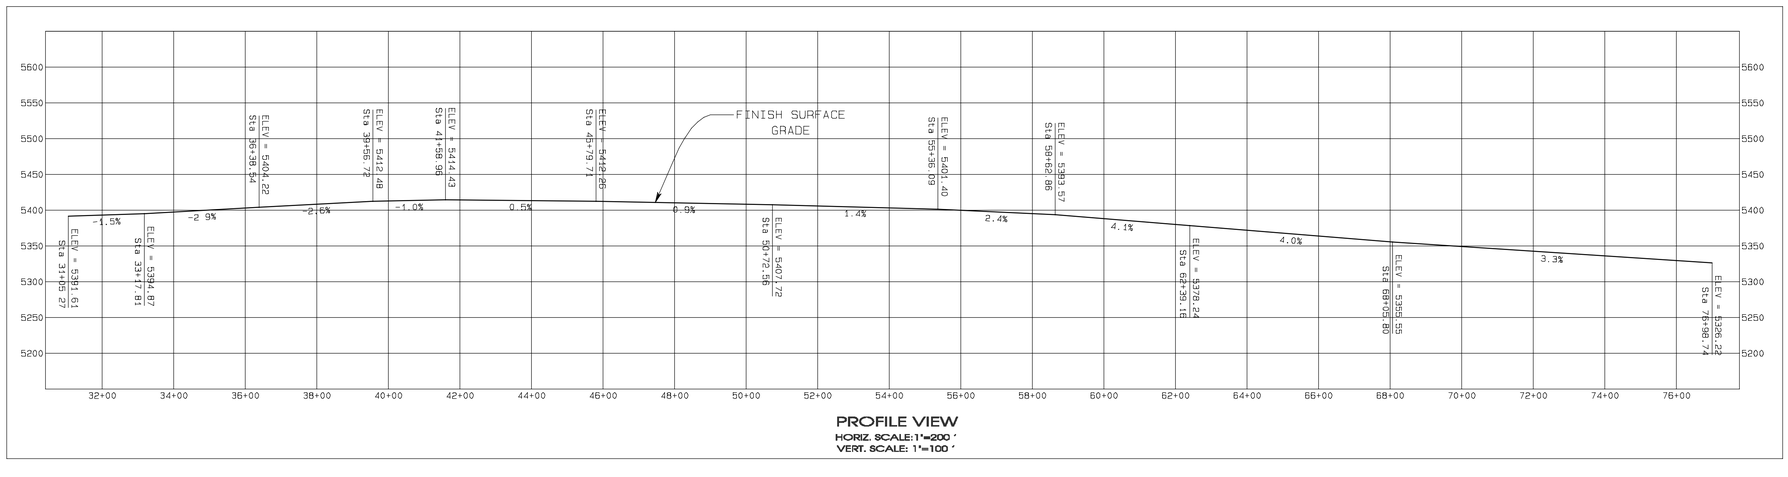

PROFILE VIEW
HORIZ. SCALE:1"=200 '
VERT. SCALE: 1"=100 '

LEGEND

- ROAD
- WATERSHED
- BUILDING
- FENCE
- IRRIGATION LINE
- CULVERT
- DAM
- DRAINAGE
- RAILROAD
- TREES
- POWERLINE
- ×5338.5 SPOT ELEVATION
- 5300 INDEX CONTOUR
- 5298 INTERMEDIATE CONTOUR
- 218 / 5402.45
- L-30 LEASE CORNER
- LEASE/PERMIT BOUNDARY

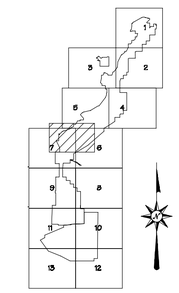

REV. No.	DATE	DRAFT BY	REVISION DESCRIPTION	ENG.	E.G.	P.E.
0&A	3-05-09	PJF	SUBMITTED TO DRM FOR REVIEW AND APPROVAL	RVV	VB	RVV

APPROVALS

CERTIFICATION STATEMENT

I, Ron C. Van Valkenburg, hereby certify that this drawing was reviewed by me and that the information shown is complete and accurate to the best of my knowledge.

RON C. VAN VALKENBURG
NEW MEXICO
9263
LICENSED PROFESSIONAL ENGINEER

EXHIBIT 11-129D

NAVAJO COAL COMPANY

P.O.BOX 1717 FARMINGTON, NEW MEXICO 87416/PHONE 505-598-4200/FAX 505-598-3361

AREA–II
BARBER HAULROAD
AS–BUILT
LOCATION MAP

PREPARED BY PJF	DRAWN BY PJF	AS NOTED
APPROVED BY RVV	DATE 3-04-09	

Path: G:\Departments\Gs\DSM_SUBM\PER_PROG\CH_11_PAP EXHIBITS\11-129-BARBER HAULROAD\ASBUILT\EXH 11-129D.pro
PJFoster \Plot time: Fri Mar 06 10:54:41 2009