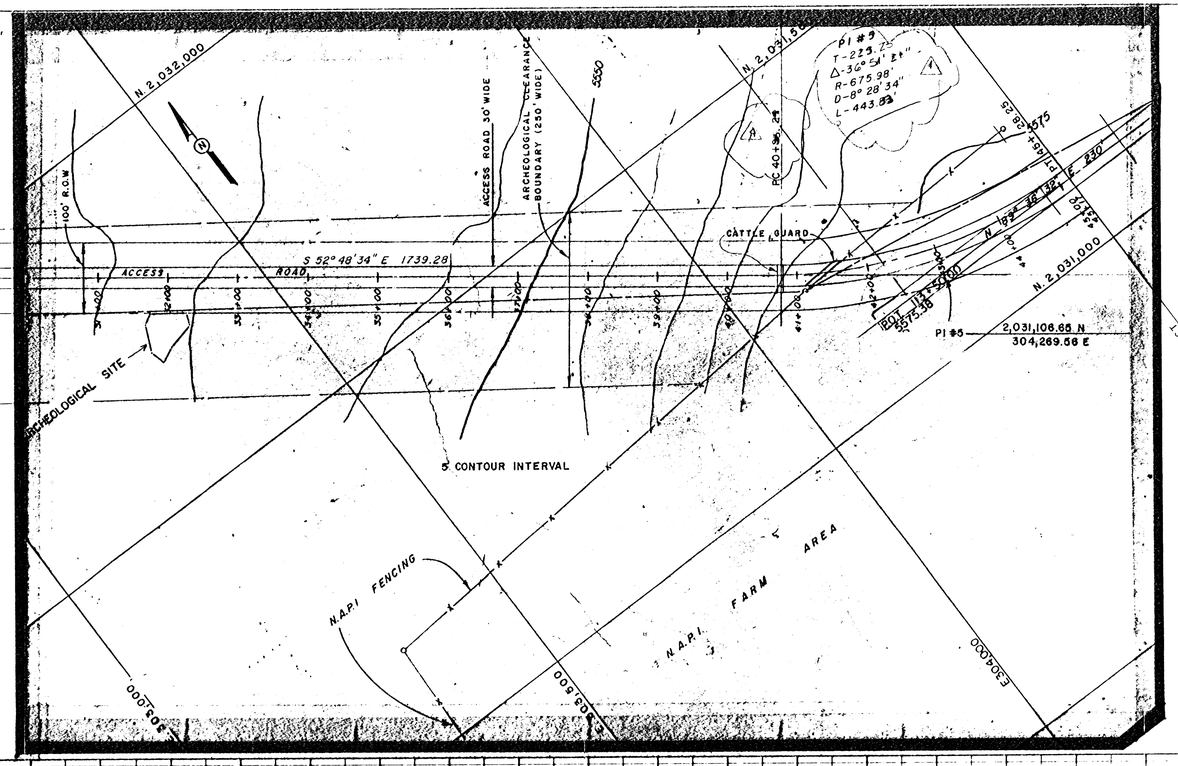

NOTES:

1. FOR TYPICAL CROSS SECTION SEE EXH. II-112D.
2. FOR CATTLE CROSSING STRUCTURE SEE EXH. II-112E & II-112F. (BY OTHERS) △
3. FINAL ROAD CENTER LINE MARKINGS AND SHOULDER MARKINGS SHALL BE EQUIVALENT TO MARKINGS ON EXISTING N-4000 SERIES ROADS.
4. CATTLE GUARDS SHALL BE CONSTRUCTED AND INSTALLED AS PER BUREAU OF INDIAN AFFAIRS SPECIFICATIONS FOR HEAVY DUTY, TYPE CATTLE GUARDS. (BY OTHERS) △
5. FOR CUT SECTION C-C SEE EXH. II-112G.
6. TOPSOIL, AS IDENTIFIED ON LEASE AND STAKED IN THE FIELD, IS TO BE RELOCATED AS DIRECTED BY OWNER'S CONSTRUCTION MANAGER. (BY OTHERS) △

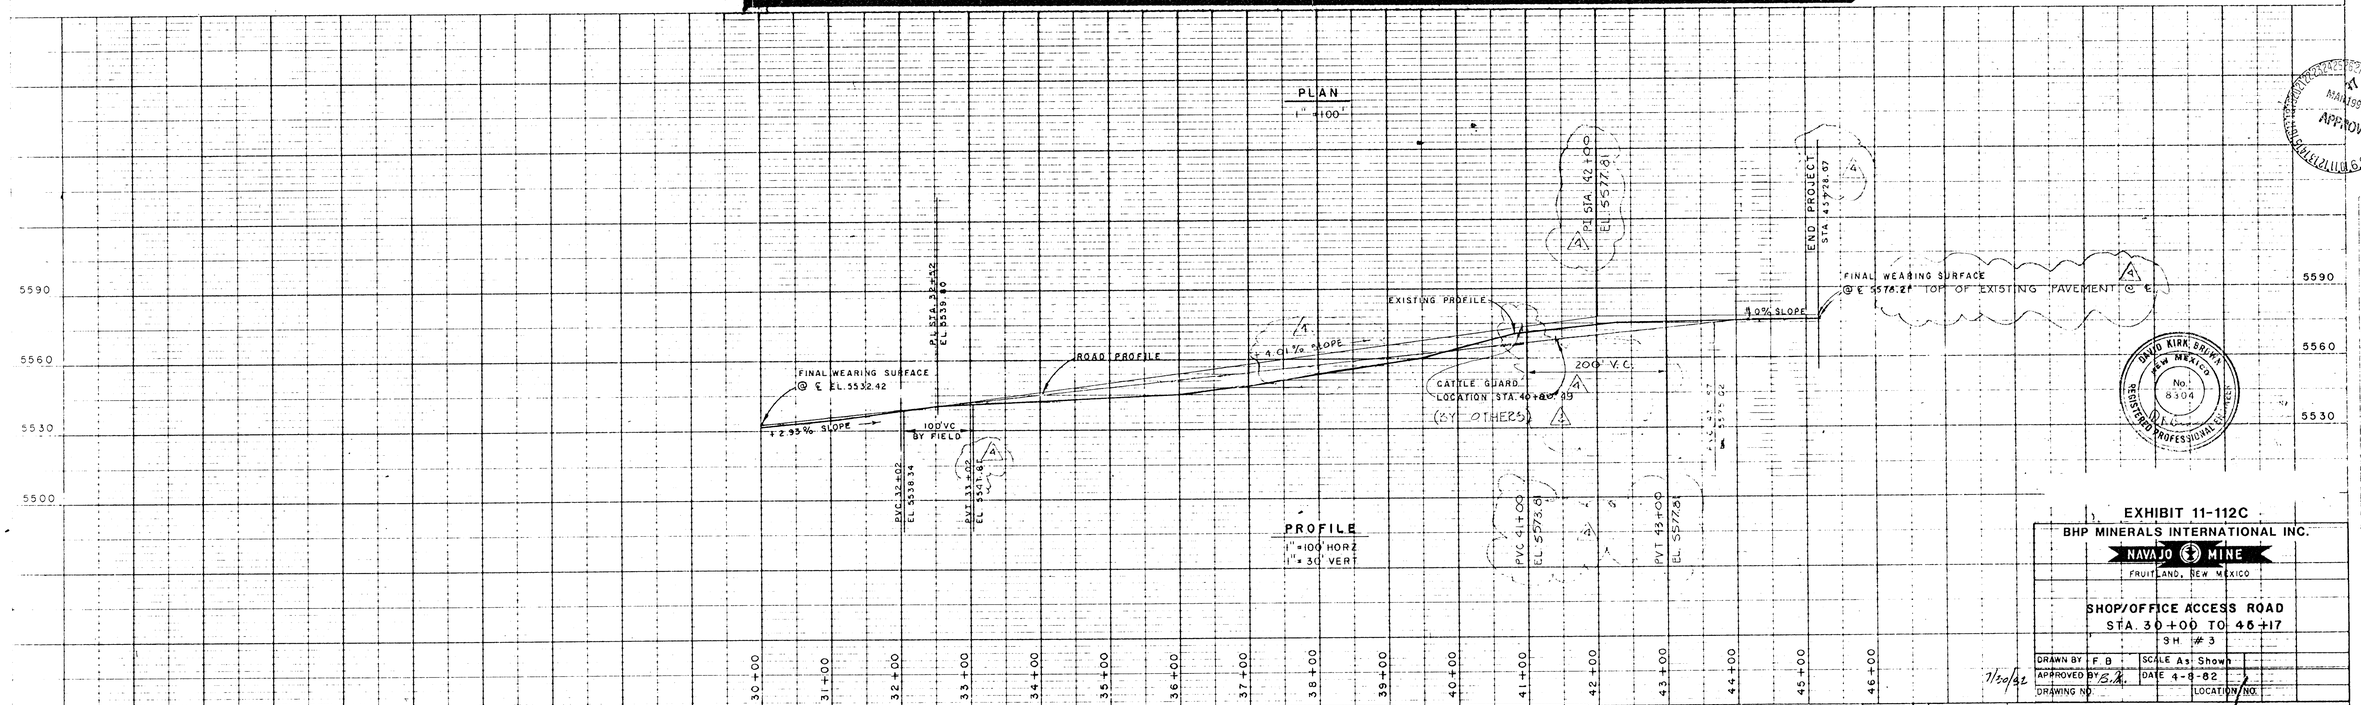

APPROVED MAR 1995

DAVID KIRK BROWN NEW MEXICO No. 8304 REGISTERED PROFESSIONAL ENGINEER

EXHIBIT 11-112C

BHP MINERALS INTERNATIONAL INC.

NAVAJO MINE

FRUITLAND, NEW MEXICO

SHOP/OFFICE ACCESS ROAD

STA. 30+00 TO 46+17

SH. #3

DRAWN BY	F.B.	SCALE	As Shown
APPROVED BY	B.A.	DATE	4-8-82
DRAWING NO.		LOCATION NO.	

7/30/82

REV. 5	03-08-1996	ADDED EXHIBIT NUMBER.	REV. 1	7-19-82	
REV. 4	11-11-1982	As Builts	REV. 2	9-23-82	ISSUED FOR PAVING BIDDING
			REV. 3	10-1-82	ISSUED FOR PAVING CONSTRUCT.

BLUE LINE
BROWN LINE
MAUVE LINE
BLUE LINE
PLAN
PROFILE
CONTROL
MAPS
DRAWING
