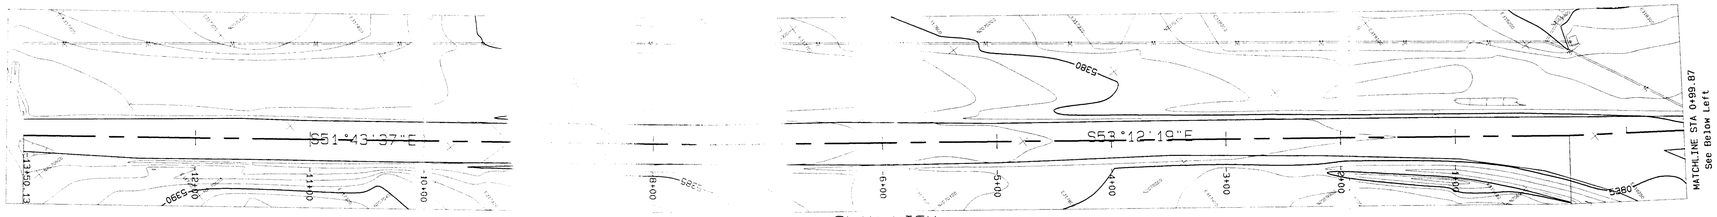

PLAN VIEW
Scale 1"=50 FT.

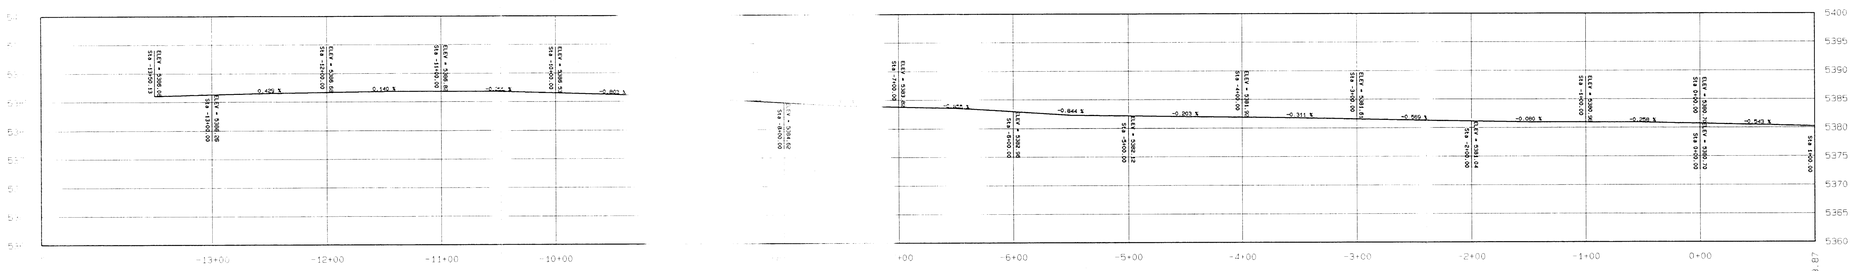

PROFILE VIEW
Scale: Horizontal - 1"=50 ft.
Vertical - 1"=10 ft.

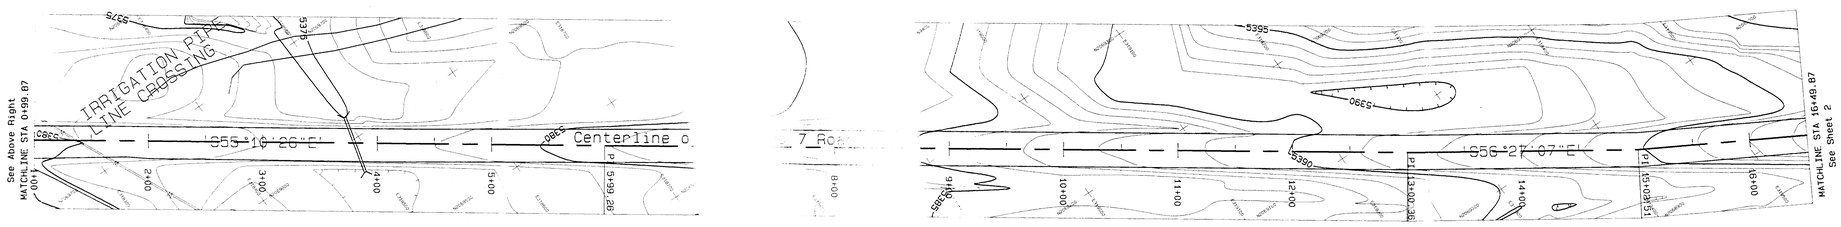

PLAN VIEW
Scale 1"=50 FT.

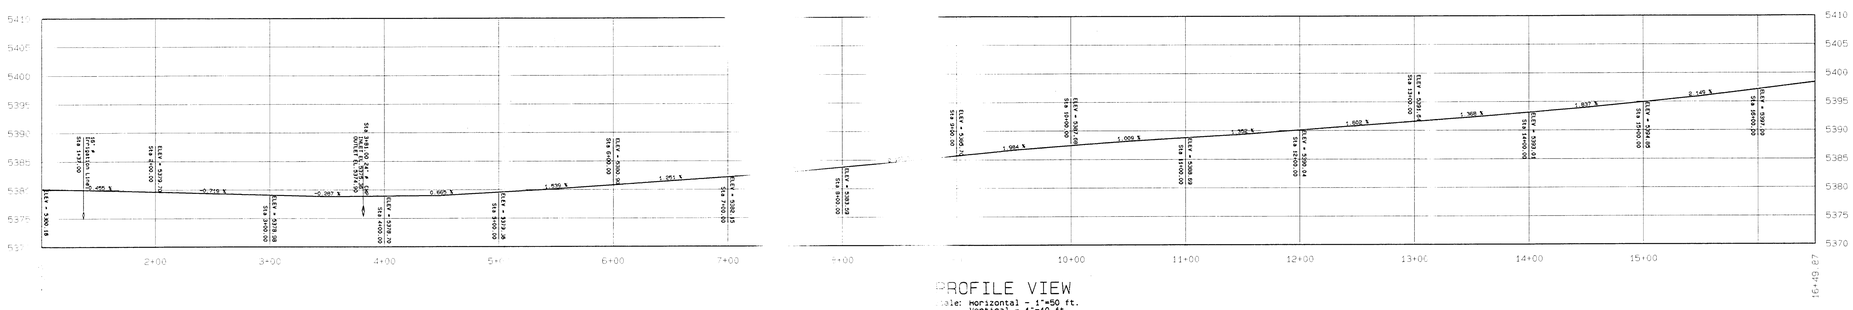

PROFILE VIEW
Scale: Horizontal - 1"=50 ft.
Vertical - 1"=10 ft.

LEGEND

- ROAD
- WATERSHED
- BUILDING
- FENCE
- IRRIGATION LINE
- CULVERT
- DAM
- DRAINAGE
- RAILROAD
- TREES
- POWERLINE
- ×5338.5 — SPOT ELEVATION
- 5300 — INDEX CONTOUR
- 5298 — INTERMEDIATE CONTOUR
- 218 / 5422.45 — LEASE CORNER
- L-30 — LEASE CORNER

NOTES

1. For hydrology and design information refer to Appendix 11-2 in the approved PAP.

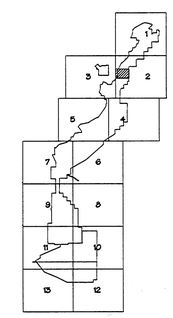

CERTIFICATION STATEMENT

I, Leonard Raymond, hereby certify that this drawing was reviewed by me and that the information shown is accurate and complete to the best of my knowledge.

REV. NO.	DATE	DRAFT. BY	REVISION DESCRIPTION	ENG.	E.G.	P.E.	P.S.	CHIEF ENG.
A	06/19/98	RY	ASBUILT					

APPROVALS

EXHIBIT 11-119D

NAVAJO COAL COMPANY

NAVAJO MINE — SAFETY PAYS

P.O. BOX 155 FRUITLAND, NEW MEXICO 87416

ASBUILT
RAMP 7 ROAD REALIGNMENT
PLAN / PROFILE

PREPARED BY RY	DRAWN BY RY	SCALE AS NOTED
APPROVED BY LR	DATE 06/19/98	REF DWG
DWG LOC	J:\OSM_SUBM\PER_PROG\Ch_11\11-119\asbuilt\Exhibits\ASBUILT.prp	