CL

PLAN VIEW

Hztl. Scale: 1" = 50'

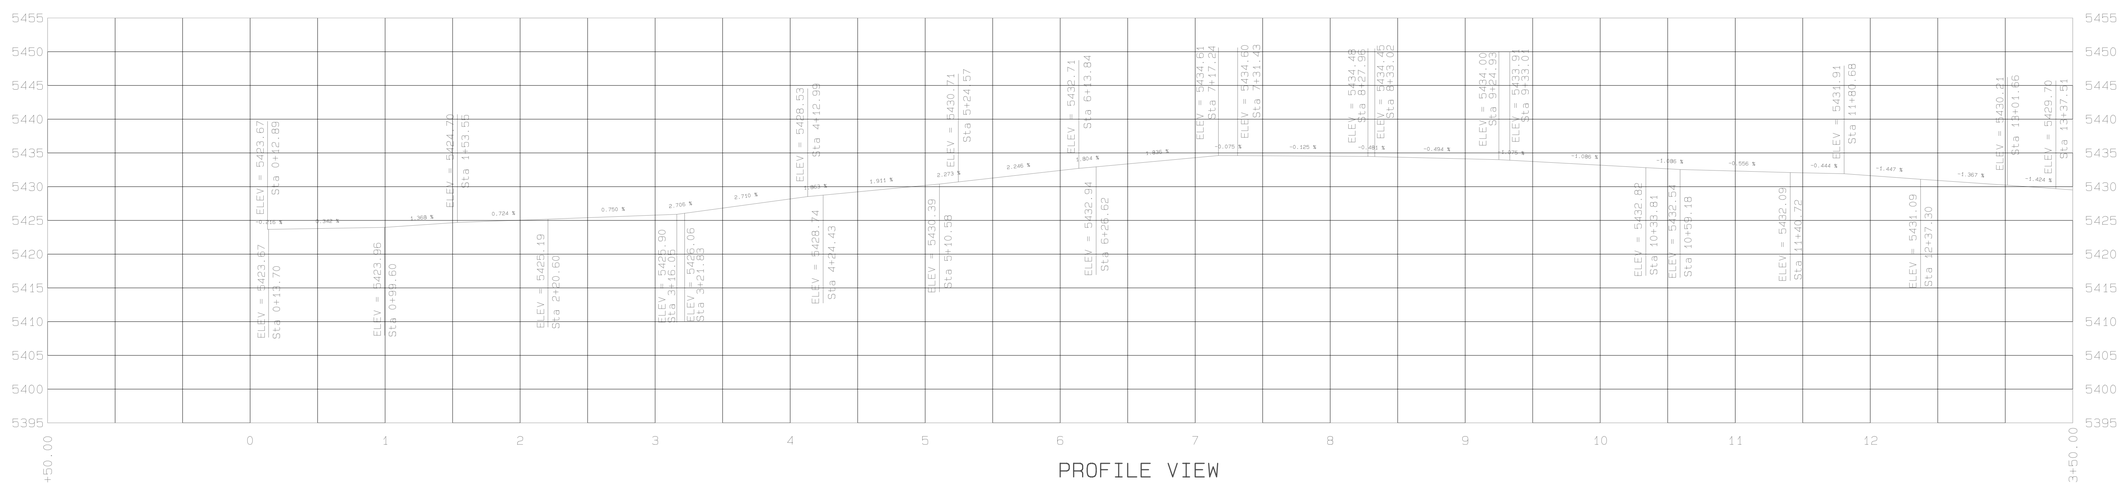

PROFILE VIEW

Vert. Scale: 1" = 10'

REVISION	DATE
1	
2	
3	
4	
5	

PROJECT MANAGER: L. RAYMOND/R. TORREY, INC.
ENGR of RECORD: STEVEN BRADLEY
REG. NO: None
SRVYR of RECORD: ROLBERT BENALLY
REG. NO: None

BHP-NAVAJO COAL CO.

PO BOX 155, FRUITLAND, NEW MEXICO, 87416

ACCOUNT: PRJD_FSTN/IBSN
DATE: JUN 27, 1995
DESIGNED BY: P.RAYMOND/B.SMATRSKY
DRAWN BY: P.POSTER
CHECKED BY: B.SMATRSKY/L.EDWARD RAYMOND
APPROVED BY: EDWARD RAYMOND

PLAN & PROFILE

LOWE PIT HAULROAD
AS-BUILT MINING HAULROADS
(PRJD_proj_name2)

DRAWING
P-1

SHEET 1
OF 4

Project Desc.: LOWE BOX-CUT ROAD AS-BUILT Path: G:\Departments\GIS\DGN_JOBS\PROJECTS\PRODUCTS\PLAN EXHIBITS\11-103-LOWE BOX-CUT HAULROD\EXHIBIT5\11-103_P1.PRD Plot time: Thu Aug 04 11:46:15 2005