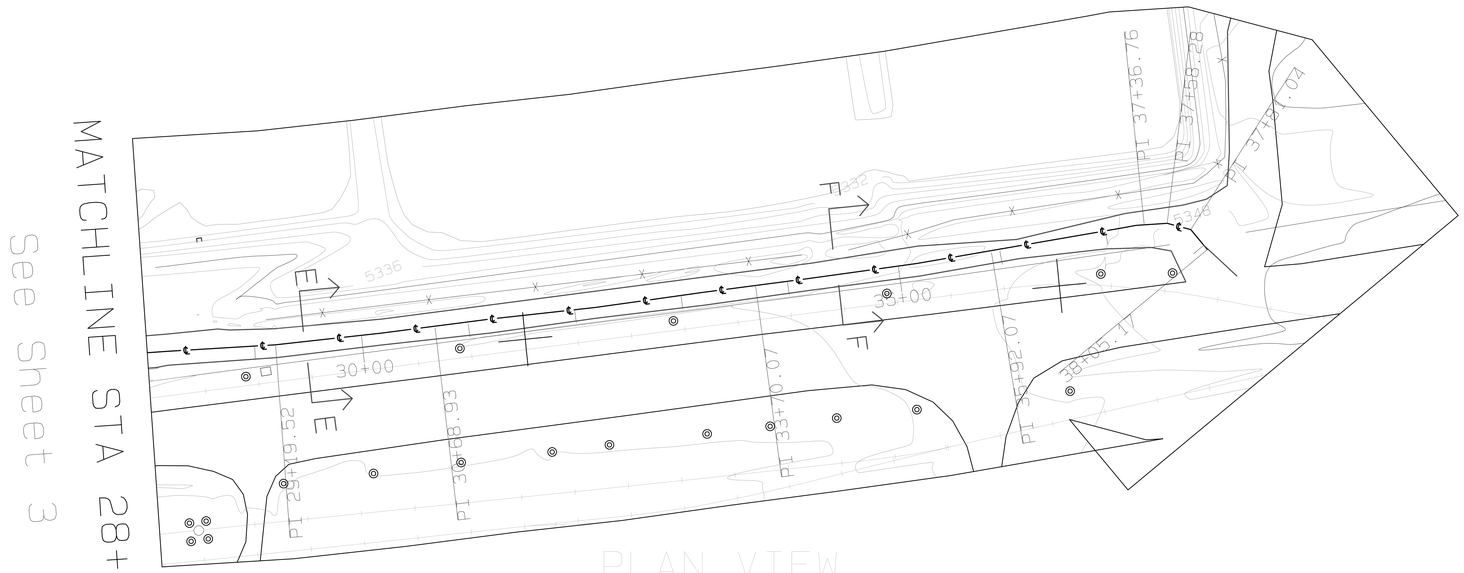

PLAN VIEW

Hztl. Scale: 1" = 50'

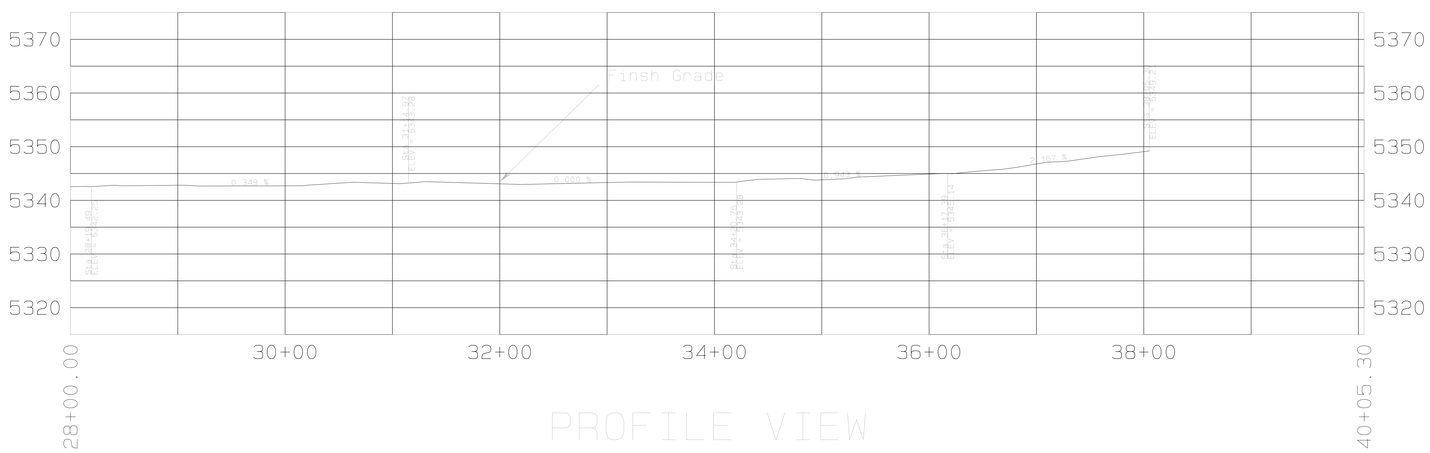

PROFILE VIEW

Vert. Scale: 1" = 10'

LEGEND

- PAVED ROAD
- DIRT ROAD
- HAUL ROAD
- TRAIL
- BUILDING
- FENCE
- IRRIGATION LINE
- CULVERT
- DAM
- DRAINAGE
- RAILROAD
- POWERLINE
- 5338.5 SPOT ELEVATION
- 5300 INDEX CONTOUR
- INTERMEDIATE CONTOUR
- 218 5422.45 HORIZ. & VERT. CONTROL
- L-30 LEASE CORNER
- LEASE BOUNDARY
- CENTER LINE

NOTES

CERTIFICATION STATEMENT

I, Leonard Raymond, hereby certify that this drawing was reviewed by me and that the information shown is accurate and complete to the best of my knowledge.

LEONARD RAYMOND NEW MEXICO 6600 REGISTERED PROFESSIONAL ENGINEER

REV. No.	DATE	DRAFT. BY	REVISION DESCRIPTION	ENG.	E.S.	P.E.	P.S.	CHIEF ENG.
A	10/8/96	VAH	SUBMITTED TO OSM					

APPROVALS

EXHIBIT 11-122D

NAVAJO COAL COMPANY

NAVAJO MINE — SAFETY PAYS

P.O. BOX 155 FRUITLAND, NEW MEXICO 87416

AREA I

"AS-BUILT"

COAL PLANT ROAD

PREPARED BY VAH	DRAWN BY VAH	SCALE AS NOTED
APPROVED BY LR	DATE 10/8/96	REF DWG EX. 11-80
DWG LOC C:\VIC\PROJ\CLPLNTRD\ASBUILD.PRO		SHEET 4 OF 4