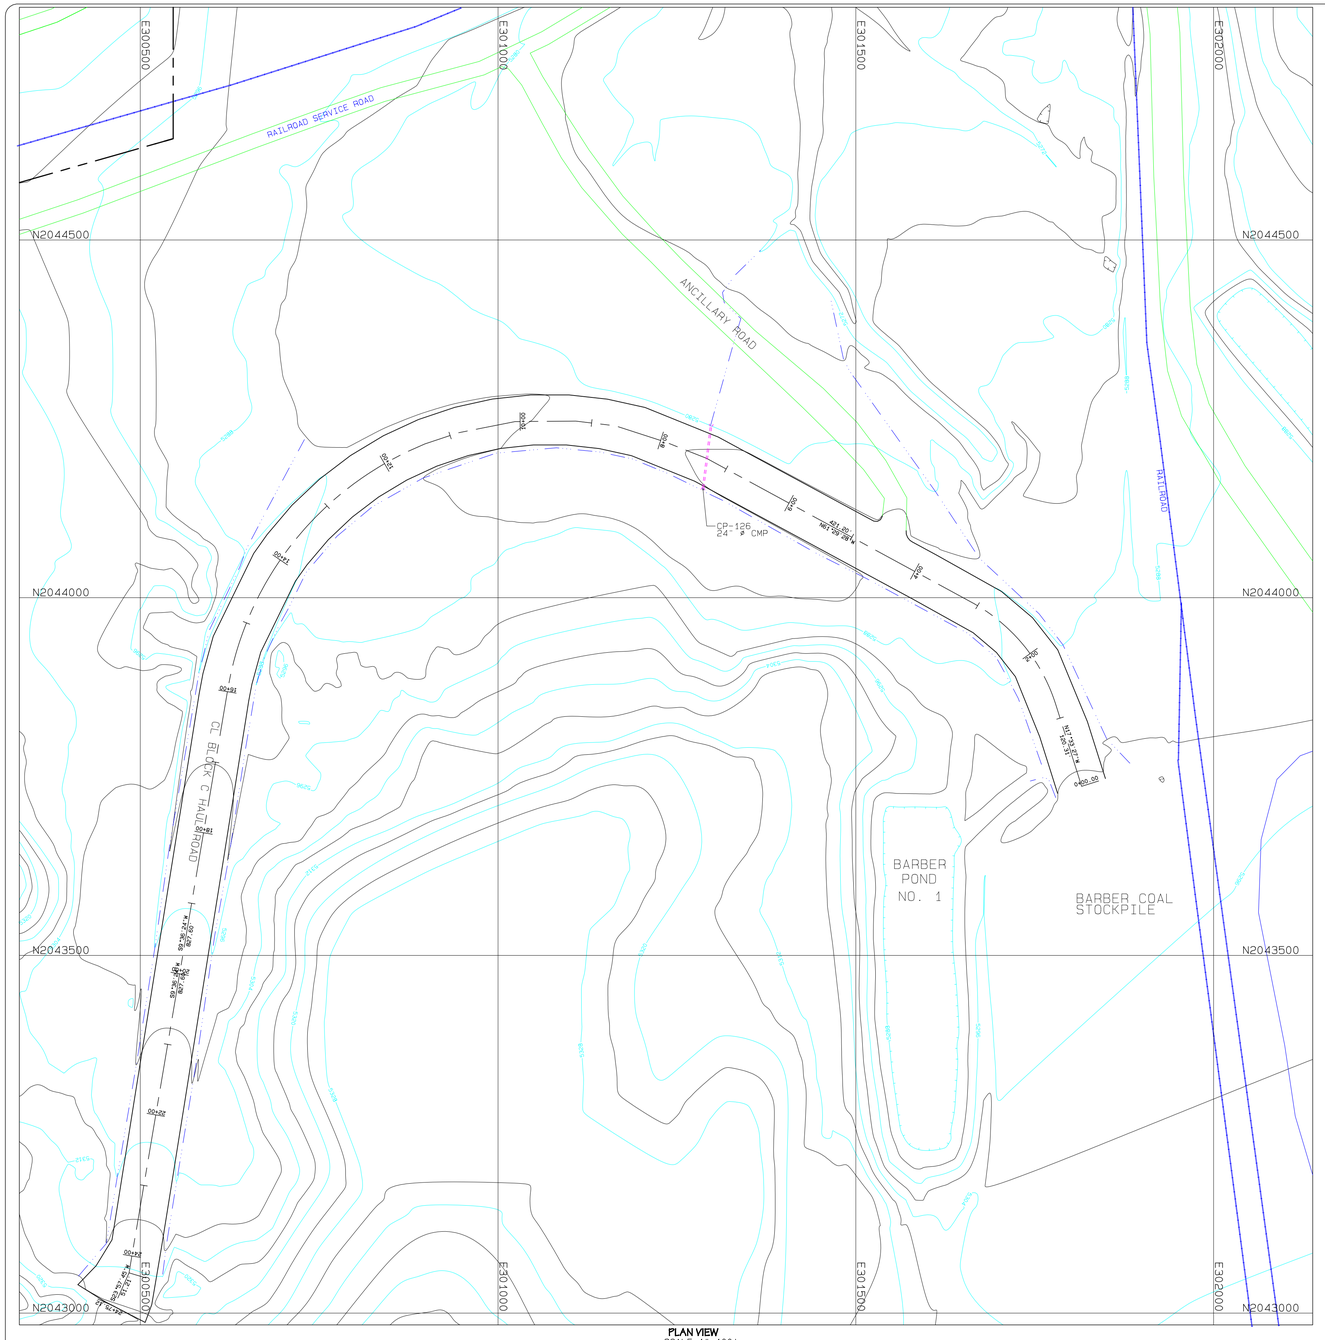

PLAN VIEW
SCALE: 1"=100'

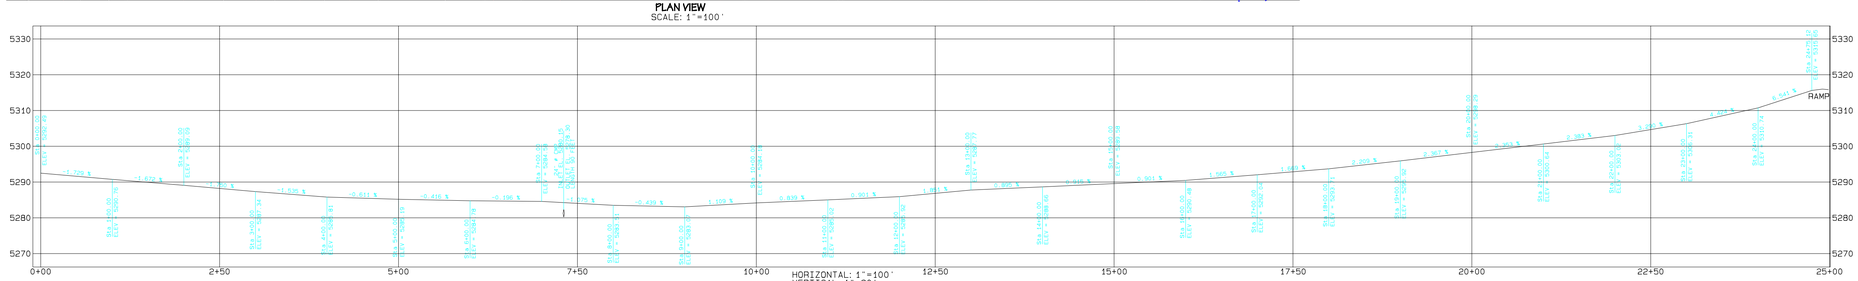

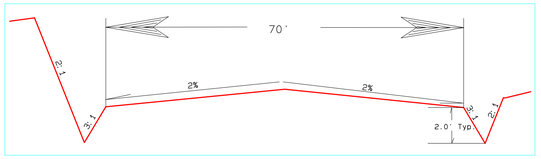

TYPICAL CUT SECTION
NTS

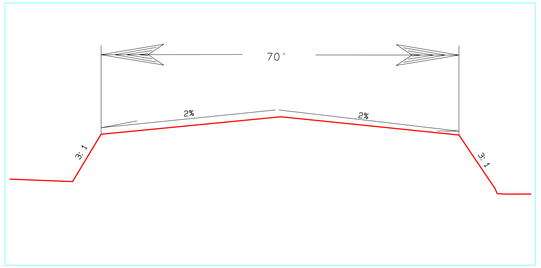

TYPICAL FILL SECTION
NTS

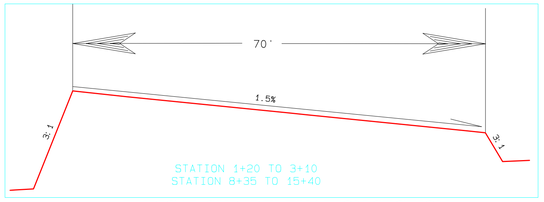

STATION 1+20 TO 3+10
STATION 8+35 TO 15+40

TYPICAL SUPERELEVATION SECTION
NTS

LEGEND

- ROAD
- TRAIL
- BUILDING
- FENCE
- IRRIGATION LINE
- CULVERT
- DAM
- DRAINAGE
- RAILROAD
- TREES
- POWERLINE
- ×5338.5 SPOT ELEVATION
- 5300 INDEX CONTOUR
- 5298 INTERMEDIATE CONTOUR
- 218 5422.45
- L-30 LEASE CORNER

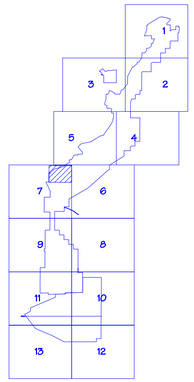

NOTES

1. For hydrology and design information refer to Appendix 11-MM in the approved PAP.

CERTIFICATION STATEMENT

I, Leonard Raymond, hereby certify that this haulroad has been constructed in accordance with the approved design plans and that the information shown is complete and accurate to the best of my knowledge.

LEONARD RAYMOND
NEW MEXICO
6600
REGISTERED PROFESSIONAL ENGINEER

REVISION	DATE
1 AS-BUILT	11/29/99
2	
3	
4	
5	

PROJECT MANAGER COREY NELSON
ENGR. of RECORD LEONARD RAYMOND
REG. NO. 6600
SRVYR of RECORD
REG. NO.

BHP-NAVAJO COAL CO.
PO BOX 150, FRUITLAND, NEW MEXICO, 87416

ACCOUNT:
DATE: January 22, 1999
DESIGNED BY: R. YAZZIE
DRAWN BY: R. YAZZIE
CHECKED BY: L.R.
APPROVED BY: L.R.

EXHIBIT 11-136A
PLAN, PROFILE & SECTIONS

Block C Haulroad
Asbuilt

DRAWING

SHEET 1 OF 1

Project Date: Path: J:\DGN_SURVEYER_PROJ\CH_11\11-136\ch-haul\blk-c haulroad Asbuilt.pro Plot time: Thu Apr 17 12:06:42 2003