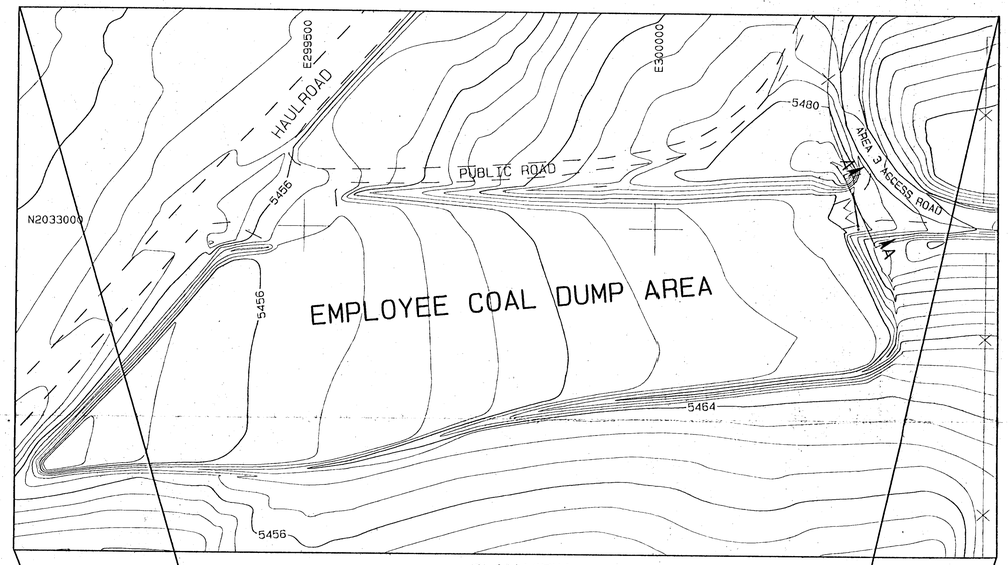

PLAN VIEW
SCALE: 1"=100'

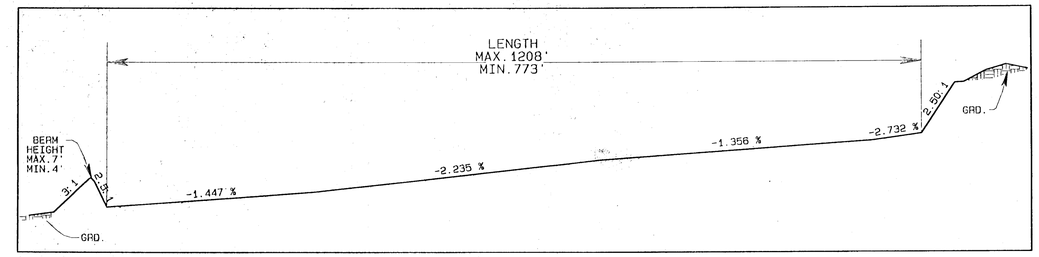

TYPICAL LONGITUDINAL SECTION
NTS

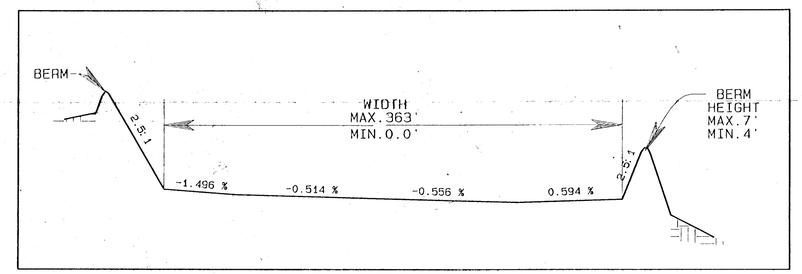

TYPICAL TRANSVERSE SECTION
NTS

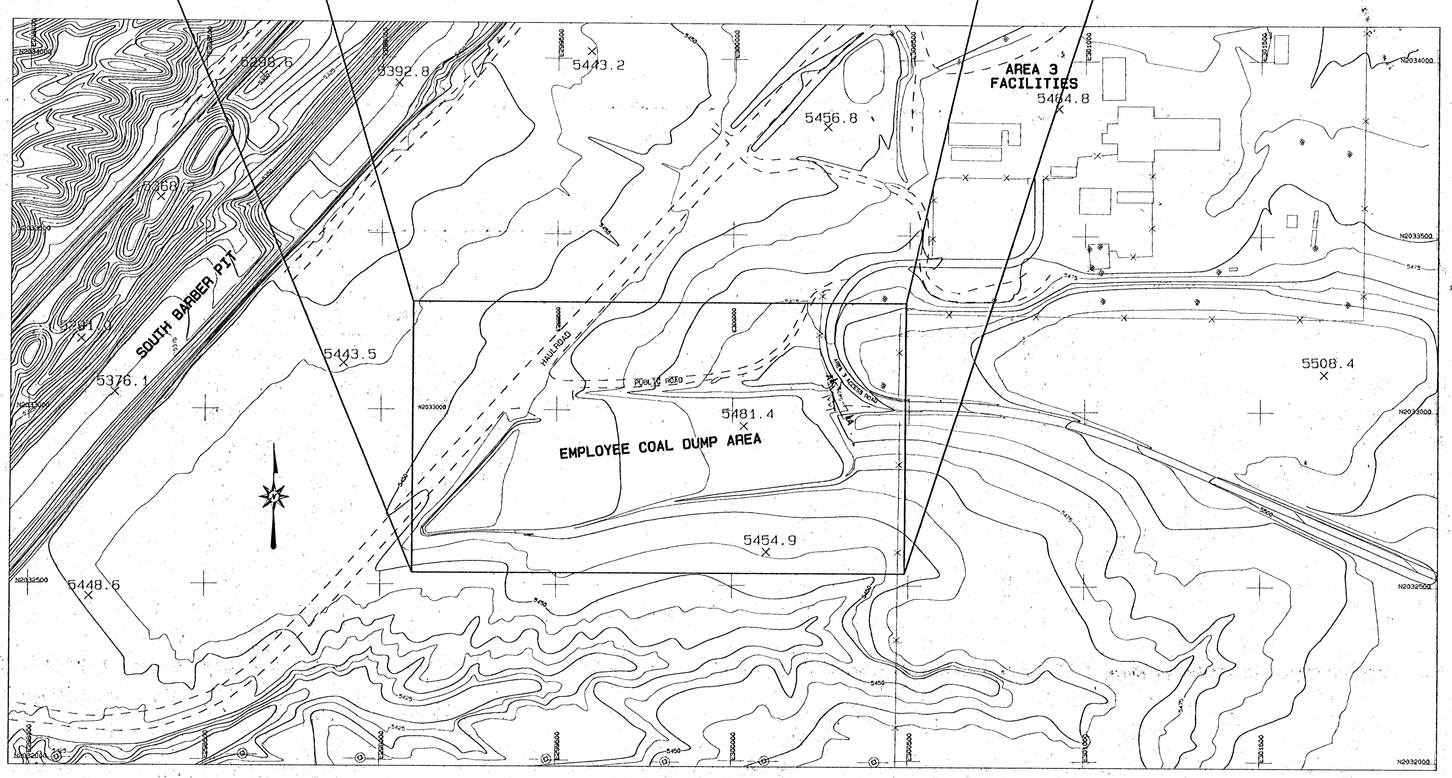

LOCATION MAP
SCALE: 1"=200'

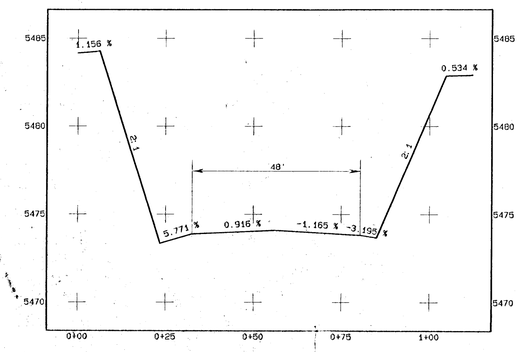

SECTION A-A
HORIZONTAL: 1"=20'
VERTICAL: 1"=4'

LEGEND

- ROAD DIRT
- ROAD PAVED
- TRAIL
- BUILDING
- FENCE
- IRRIGATION LINE
- CULVERT
- DAM
- DRAINAGE
- RAILROAD
- TREES
- POWERLINE
- 5338.5 SPOT ELEVATION
- 5300 INDEX CONTOUR
- 5298 INTERMEDIATE CONTOUR
- 218 5422.45
- L-30 LEASE CORNER

NOTES

1. For hydrology and design information refer to Appendix 11-AA in the approved PAP.

STAGE STORAGE DATA

ELEV feet	AREA acres	VOLUME ac-ft	CUM. VOLUME ac-ft
5452	0.06	0.00	0.00
5454	0.34	0.40	0.40
5456	1.12	1.45	1.85
5458	2.15	3.27	5.12

CERTIFICATION STATEMENT

I, Leonard Raymond, hereby certify that this public coal dump area has been constructed in accordance with the approved design plans and that the information shown is complete and accurate to the best of my knowledge.

REGISTERED LEONARD RAYMOND NEW MEXICO 6600 PROFESSIONAL ENGINEER
2-3-00

APPROVED FEB 2000

REVISION		DATE
1	SUBMITTED TO OSM	02/02/00
2		
3		
4		
5		

PROJECT MANAGER: Corey Nelson
ENGR. of RECORD: Leonard Raymond REG. NO. 6600
SRVYR of RECORD: REG. NO.

BHP-NAVAJO COAL CO.
PO BOX 159, FRUITLAND, NEW MEXICO, 87416

ACCOUNT: NAVAJO
PROJECT: February 2, 2000
DESIGNED BY: FJ
DRAWN BY: RY
CHECKED BY: LR
APPROVED BY: LR

PLAN, PROFILE & SECTIONS

EXHIBIT 11-132A
EMPLOYEE COAL DUMP RELOCATION
AS-BUILT

DRAWING

SHEET 1 OF 1

Project Dwg.: Path: J:\NSM_SUBMITTED_PROJ\CH_11\11-132A\NEW_AsBuilt.dwg Plot time: Wed Feb 02 12:12:38 2000