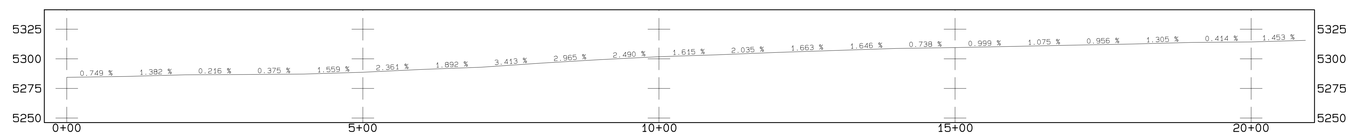

PROFILE OF WEST DRAIN DITCH

HORIZONTAL SCALE: 1"=100'
VERTICAL SCALE: 1"=50'

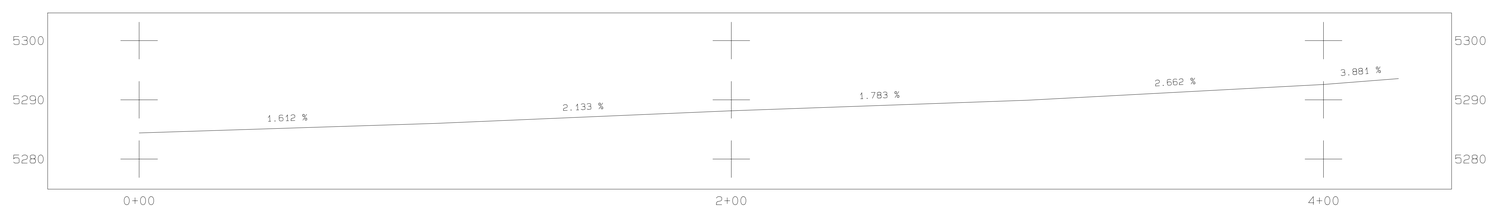

PROFILE OF NORTH DRAIN DITCH

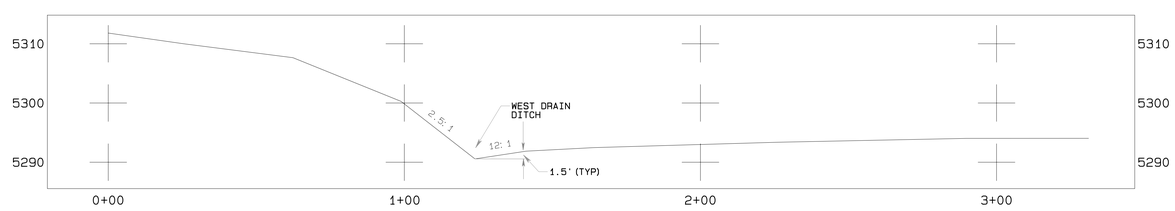

TYPICAL SECTION C - C

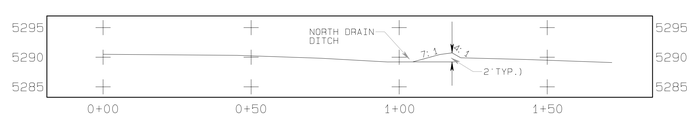

TYPICAL SECTION D - D

HORIZONTAL SCALE: 1"=20'
VERTICAL SCALE: 1"=10'

LEGEND

- ROAD
- LEASE LINE
- WATERSHED
- BERM
- IRRIGATION LINE
- CULVERT
- DAM
- DRAINAGE
- RAILROAD
- TREES
- POWERLINE
- ×5338.5 — SPOT ELEVATION
- 5300 — INDEX CONTOUR
- 5298 — INTERMEDIATE CONTOUR
- 218 5422.45 — L-30 — LEASE CORNER

NOTES

1. For hydrology and design information refer to Appendix 11-AA in the approved PAP.
2. Refer to Table 11-5AI for additional data.
3. Refer to Exhibit 11-13C and 11-13D for watershed information.
4. Gauge Post Base Elevation : 5264.08

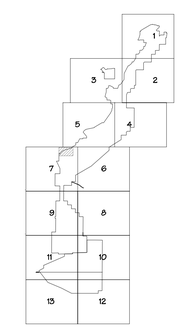

CERTIFICATION STATEMENT

I, Leonard Raymond, hereby certify that this impoundment has been constructed in accordance with the approved design plans and that this information shown is complete and accurate to the best of my knowledge.

LEONARD RAYMOND — NEW MEXICO — 6600 — REGISTERED PROFESSIONAL ENGINEER

REV. No.	DATE SUBMITTED	DRAFT. BY	REVISION DESCRIPTION	ENG.	E.G.	P.E.	P.S.	DATE APPROV'D BY OSM
A	6/6/02	LR	SUBMITTED TO OSM FOR REVIEW	RY	MC	LR		

APPROVALS

EXHIBIT 11-135B

NAVAJO COAL COMPANY

NAVAJO MINE — SAFETY PAYS

P.O. BOX 155 FRUITLAND, NEW MEXICO 87416

BLOCK C POND 3

TYPICAL SECTION AND PROFILE OF MODIFIED SURFACE DRAINAGE

AS-BUILT

PREPARED BY RY	DRAWN BY RY	SCALE AS NOTED
APPROVED BY LR	DATE 06/06/02	REF DWG
DWG LOC	G:\Departments\Ds\OSM_SUBM\PER_PROG\CH_11_PAP EXHIBIT\11-133, 134, &135-BLK-C	

03_Asbuilt.pro