LEGEND

- ROAD
- TRAIL
- BUILDING
- FENCE
- IRRIGATION LINE
- CULVERT
- DAM
- DRAINAGE
- RAILROAD
- TREES
- POWERLINE
- ×5338.5 SPOT ELEVATION
- 5300 INDEX CONTOUR
- 5298 INTERMEDIATE CONTOUR
- 218 5422.45 CONTROL
- LEASE
- RIPRAP DROP STRUCTURE

NOTES

1. For hydrology and design information refer to Appendix 11-V in the approved PAP.
2. Refer to Exhibit 11-12C and 11-12C-1 for culvert watershed information.

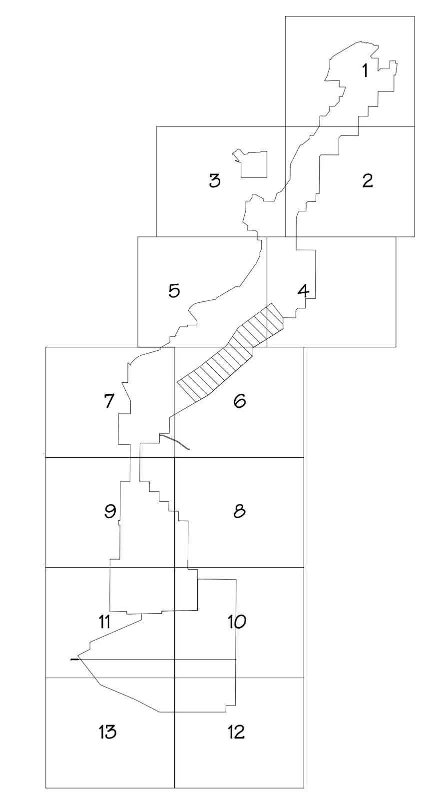

LOCATION MAP
SCALE 1"=400'

CERTIFICATION STATEMENT

I, Leonard Raymond, hereby certify that this road has been constructed in accordance with the approved design plans and that the information shown is complete and accurate to the best of my knowledge, except as noted. See Exhibit 11-141E for notes.

REVISION	DATE
1 AS-BUILT	12/06/00
2	
3	
4	
5	

PROJECT MANAGER: COREY NELSON
ENGR. of RECORD: LEONARD RAYMOND
REG. NO: 6600
SRVYR of RECORD:
REG. NO:

BHP-NAVAJO COAL CO.

PO BOX 155, FRUITLAND, NEW MEXICO, 87416

ACCOUNT:
DATE: December 06, 2000
DESIGNED BY: BEN HOSKIE
DRAWN BY: RAY YAZZIE
CHECKED BY: LR
APPROVED BY:

PLAN

EXHIBIT 11-141C
HOSTEEN/YAZZIE ROAD
AS-BUILT

DRAWING
SHEET 1 OF 3

Project Desc.: Path: G:\Departments\Gs\OSM_SUBM\PER_PROG\CH_11_PAP EXHIBIT\11-141-HOSTEEN-YAZZIE HAULRD\HOSTEEN-YAZZIE RD\exhibits\hY_Road_Asbuilt.pro Plot time: Tue Aug 16 11:32:43 2005